


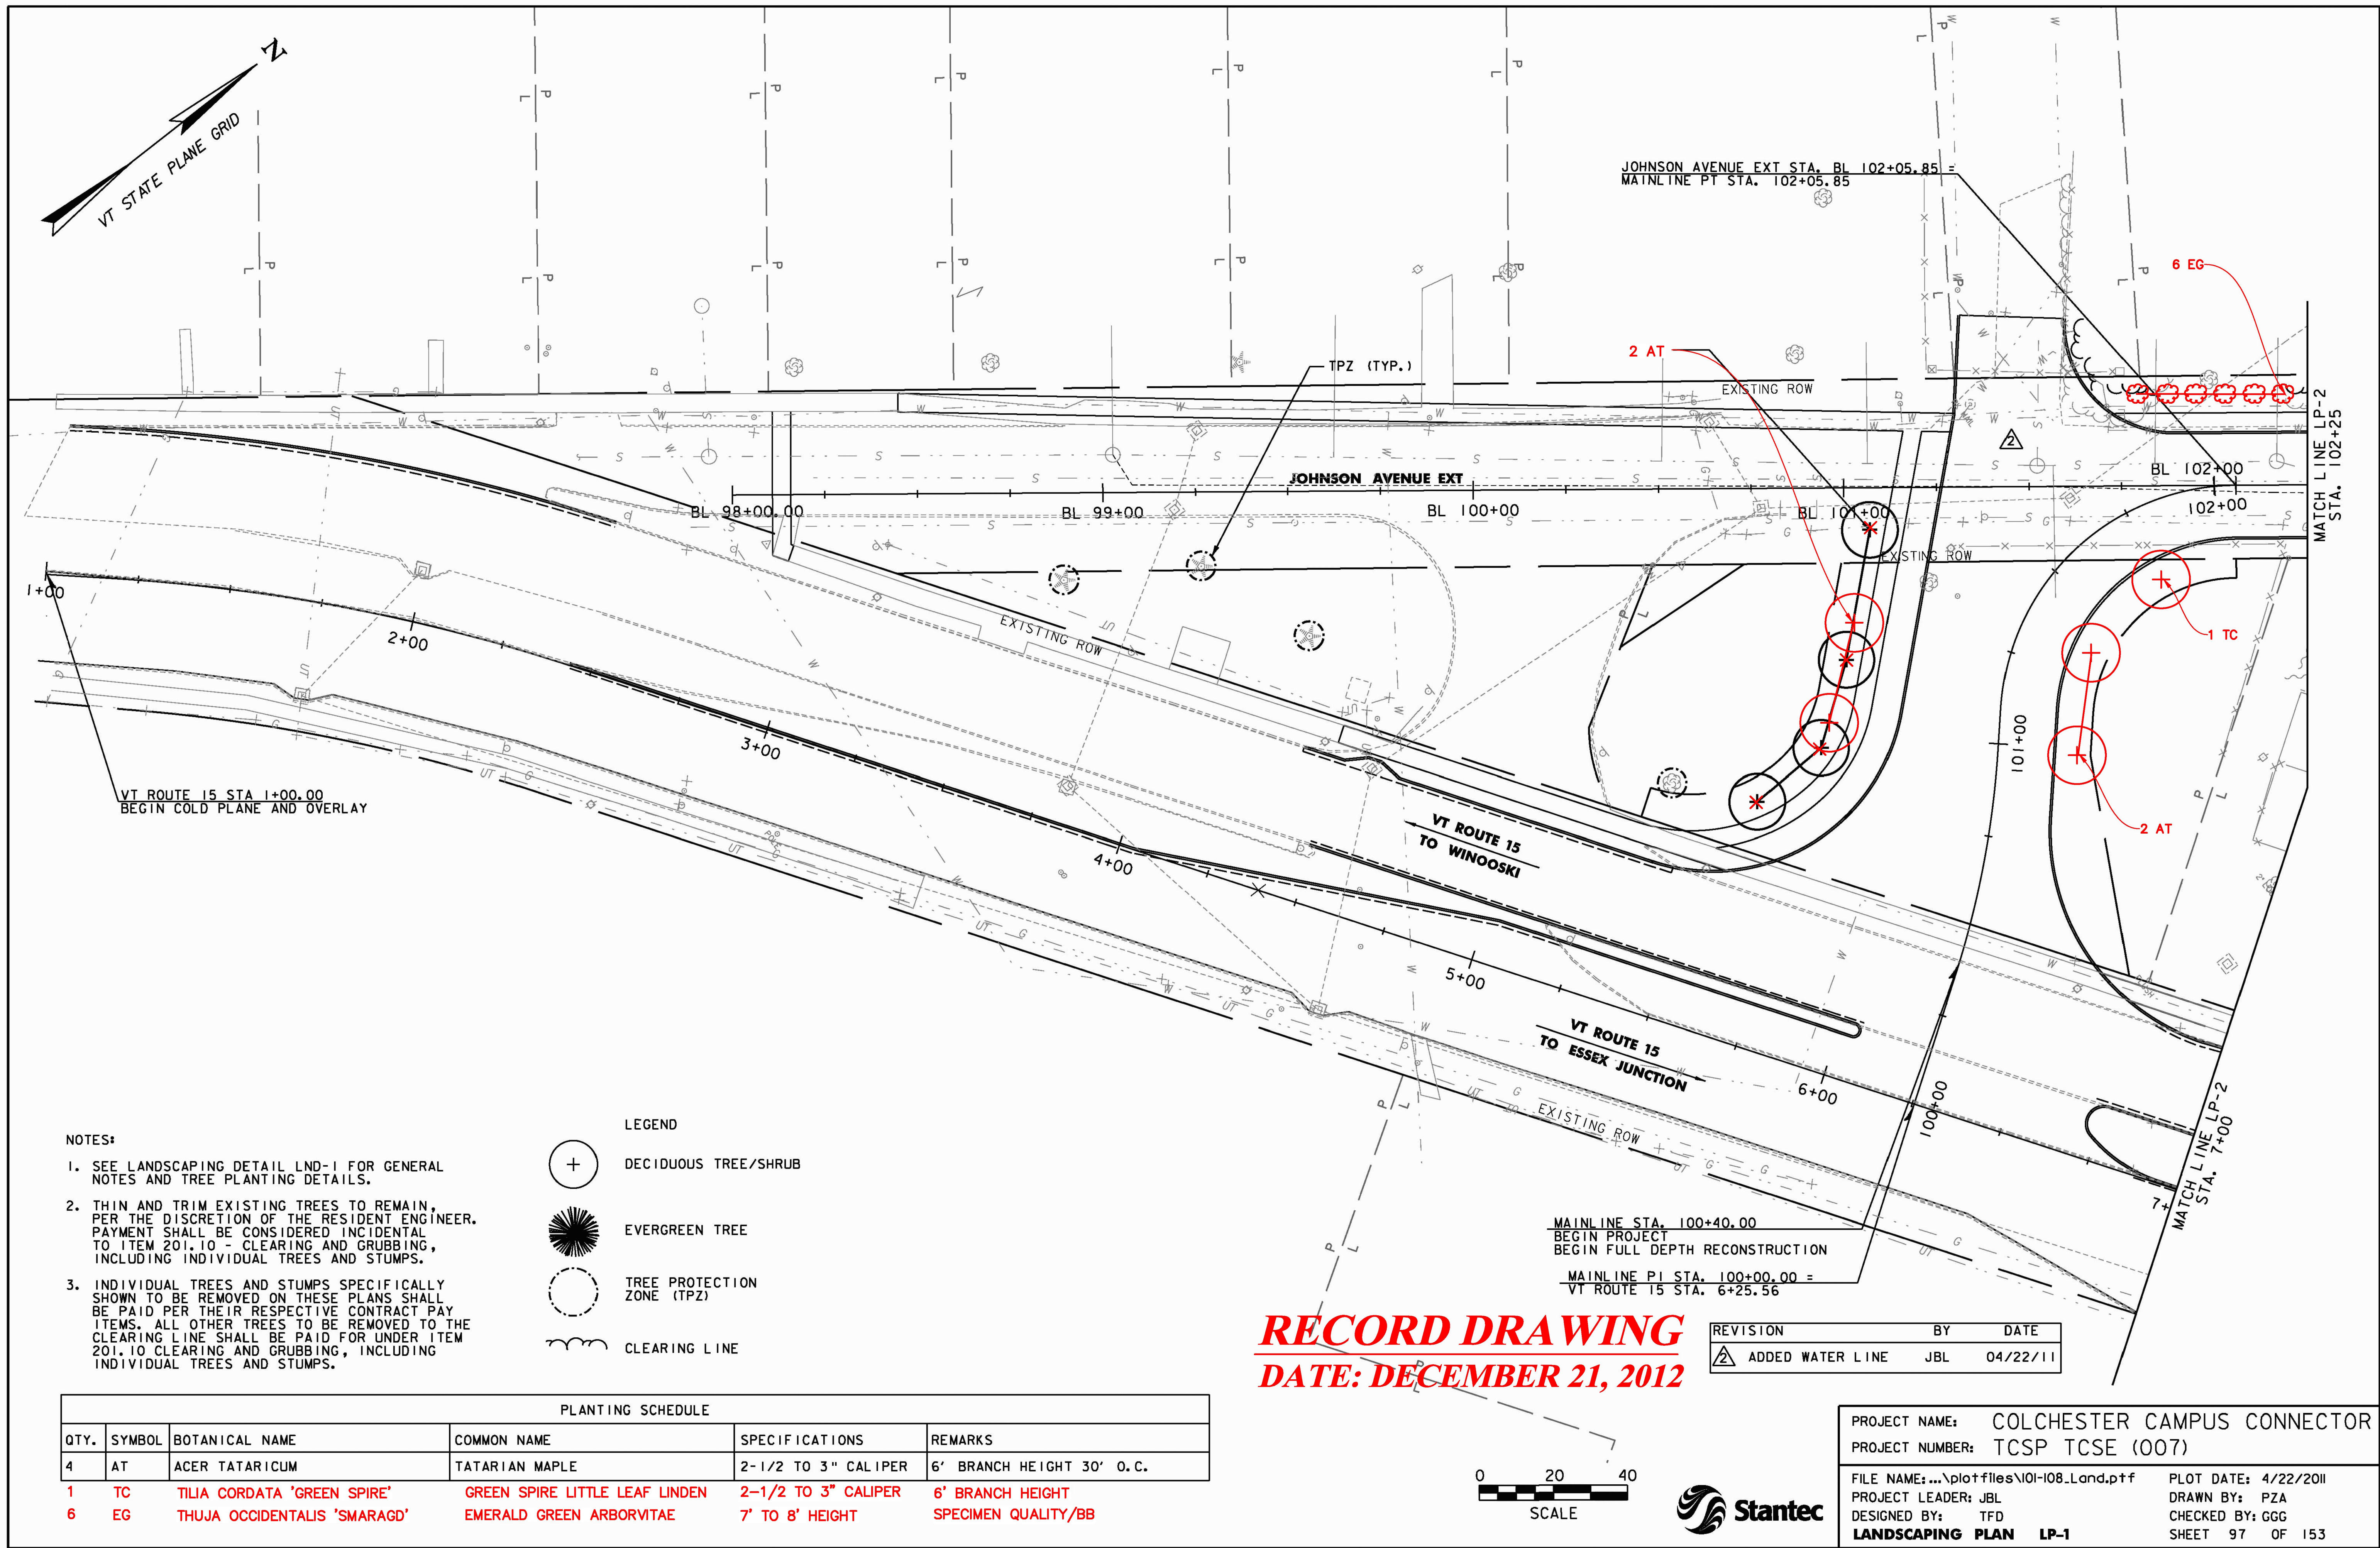

NOTES:


- 1. SEE LANDSCAPING DETAIL LND-1 FOR GENERAL NOTES AND TREE PLANTING DETAILS.
- 2. THIN AND TRIM EXISTING TREES TO REMAIN, PER THE DISCRETION OF THE RESIDENT ENGINEER. PAYMENT SHALL BE CONSIDERED INCIDENTAL TO ITEM 201.10 - CLEARING AND GRUBBING, INCLUDING INDIVIDUAL TREES AND STUMPS.
- 3. INDIVIDUAL TREES AND STUMPS SPECIFICALLY SHOWN TO BE REMOVED ON THESE PLANS SHALL BE PAID PER THEIR RESPECTIVE CONTRACT PAY ITEMS. ALL OTHER TREES TO BE REMOVED TO THE CLEARING LINE SHALL BE PAID FOR UNDER ITEM 201.10 CLEARING AND GRUBBING, INCLUDING INDIVIDUAL TREES AND STUMPS.

LEGEND

- (+) DECIDUOUS TREE/SHRUB
- (*) EVERGREEN TREE
- (○) TREE PROTECTION ZONE (TPZ)
- (---) CLEARING LINE

PLANTING SCHEDULE					
QTY.	SYMBOL	BOTANICAL NAME	COMMON NAME	SPECIFICATIONS	REMARKS
4	AT	ACER TATARICUM	TATARIAN MAPLE	2-1/2 TO 3" CALIPER	6' BRANCH HEIGHT 30' O.C.
1	TC	TILIA CORDATA 'GREEN SPIRE'	GREEN SPIRE LITTLE LEAF LINDEN	2-1/2 TO 3" CALIPER	6' BRANCH HEIGHT
6	EG	THUJA OCCIDENTALIS 'SMARAGD'	EMERALD GREEN ARBORVITAE	7' TO 8' HEIGHT	SPECIMEN QUALITY/BB

RECORD DRAWING
DATE: DECEMBER 21, 2012

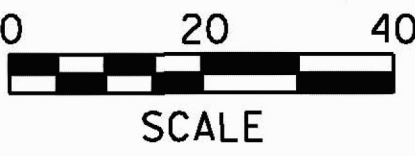

REVISION	BY	DATE
1. ADDED WATER LINE	JBL	04/22/11



PROJECT NAME: COLCHESTER CAMPUS CONNECTOR	
PROJECT NUMBER: TCSP TCSE (007)	
FILE NAME: ...\\plotfiles\\101-108.Land.plt	PLOT DATE: 4/22/2011
PROJECT LEADER: JBL	DRAWN BY: PZA
DESIGNED BY: TFD	CHECKED BY: GGG
LANDSCAPING PLAN LP-1	
SHEET 97 OF 153	