

HVCTRL #1

STANDARD DISC STAMPED

"TF18"

N = 731358.8400

E = 1674319.6600

ELEV. = 812.8300

GENERAL LOCATION, HARDWICK, VT TO REACH FROM THE JUNCTION OF VT ROUTE'S 14 AND 15 IN HARDWICK VILLAGE (BLINKING LIGHT) , GO WEST ON VT ROUTE 15 FOR 0.15 MI (0.24 KM) TO THE MARK ON THE RIGHT. THE MARK IS SET ON THE SOUTHEAST BRIDGE ABUTMENT ON THE WEST CHURCH STREET BRIDGE OVER THE LAMOILLE RIVER. IT IS 31 FT (9.4 M) NORTH OF THE CENTERLINE OF VT ROUTE 15, 16 FT (4.9 M) EAST OF THE CENTERLINE OF WEST CHURCH STREET, AND 5 FT (1.5 M) NORTH OF POWER AND TELEPHONE POLE NUMBER 3.

HVCTRL #2

STANDARD DISC STAMPED

"TF 18 AZ MK"






N = 732546.8900

E = 1673595.0300






ELEV. = 808.0400

GENERAL LOCATION, HARDWICK, VT. OWNERSHIP, MRS BROCHU OR THE VILLAGE OF HARDWICK. TO REACH FROM THE JUNCTION OF VT ROUTE'S 14 AND 15 IN HARDWICK VILLAGE (BLINKING LIGHT) , GO WEST ON VT ROUTE 15 FOR 0.45 MI (0.72 KM) TO THE MARK ON THE LEFT. THE MARK IS A STATE OF VERMONT SURVEY DISK SET IN A 12 IN CONCRETE MONUMENT EVEN WITH THE GROUND SURFACE. IT IS 68 FT (20.7 M) NORTHWEST OF POWER AND TELEPHONE POLE L 8-1/8/1H, 39 FT (11.9 M) NORTH OF UNION STREET CENTERLINE, 31 FT (9.4 M) WEST OF VT ROUTE 15 CENTERLINE, 9 FT (2.7 M) NORTH OF A FIRE HYDRANT, AND 4.5 FT (1.4 M) WEST OF THE FACE OF A GRANITE WALL.

* DESCRIPTION PROVIDED BY VERMONT AGENCY OF TRANSPORTATION GEODETIC SURVEY UNIT

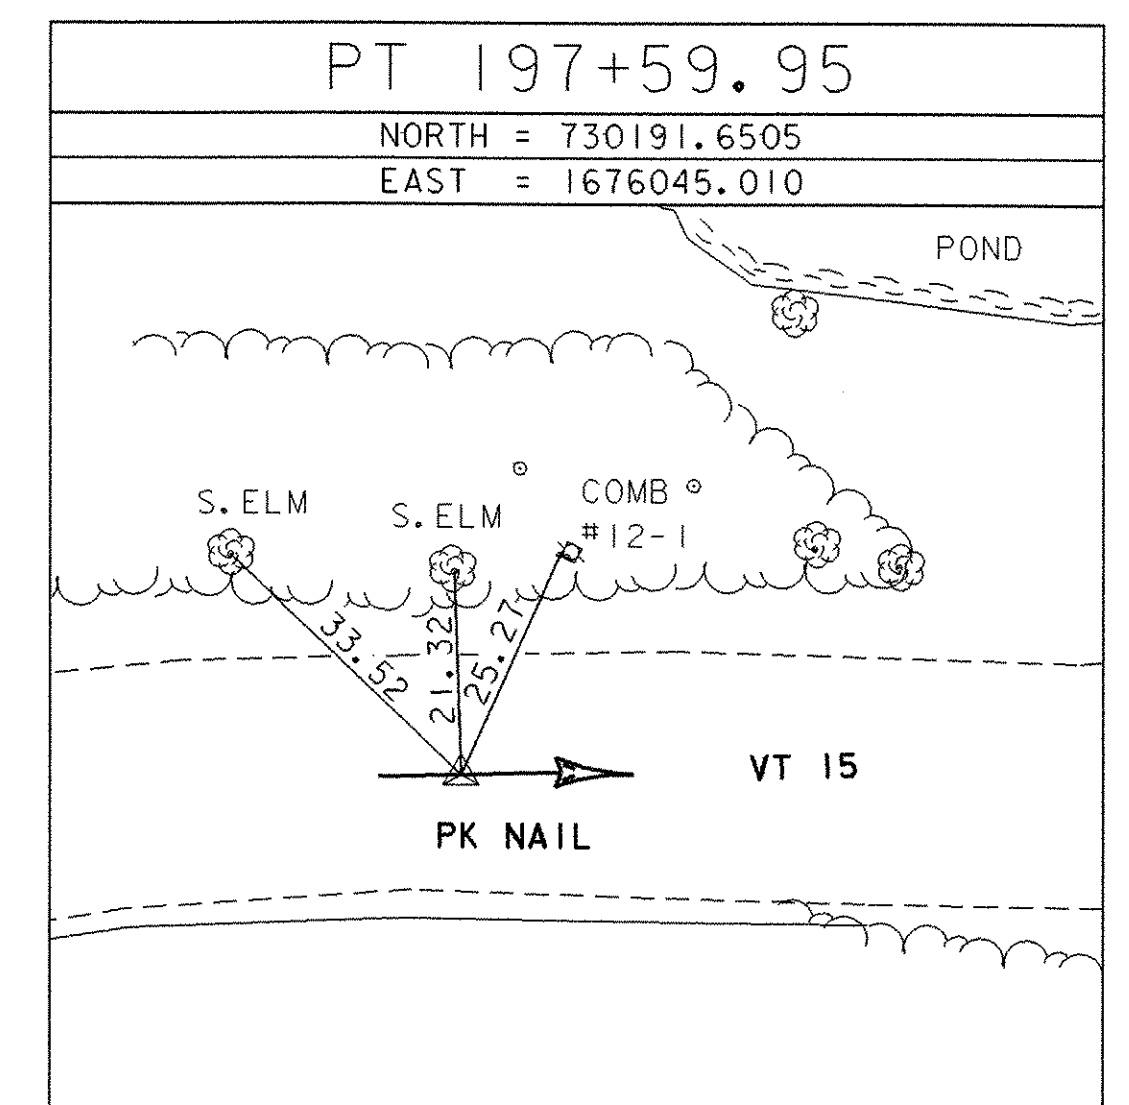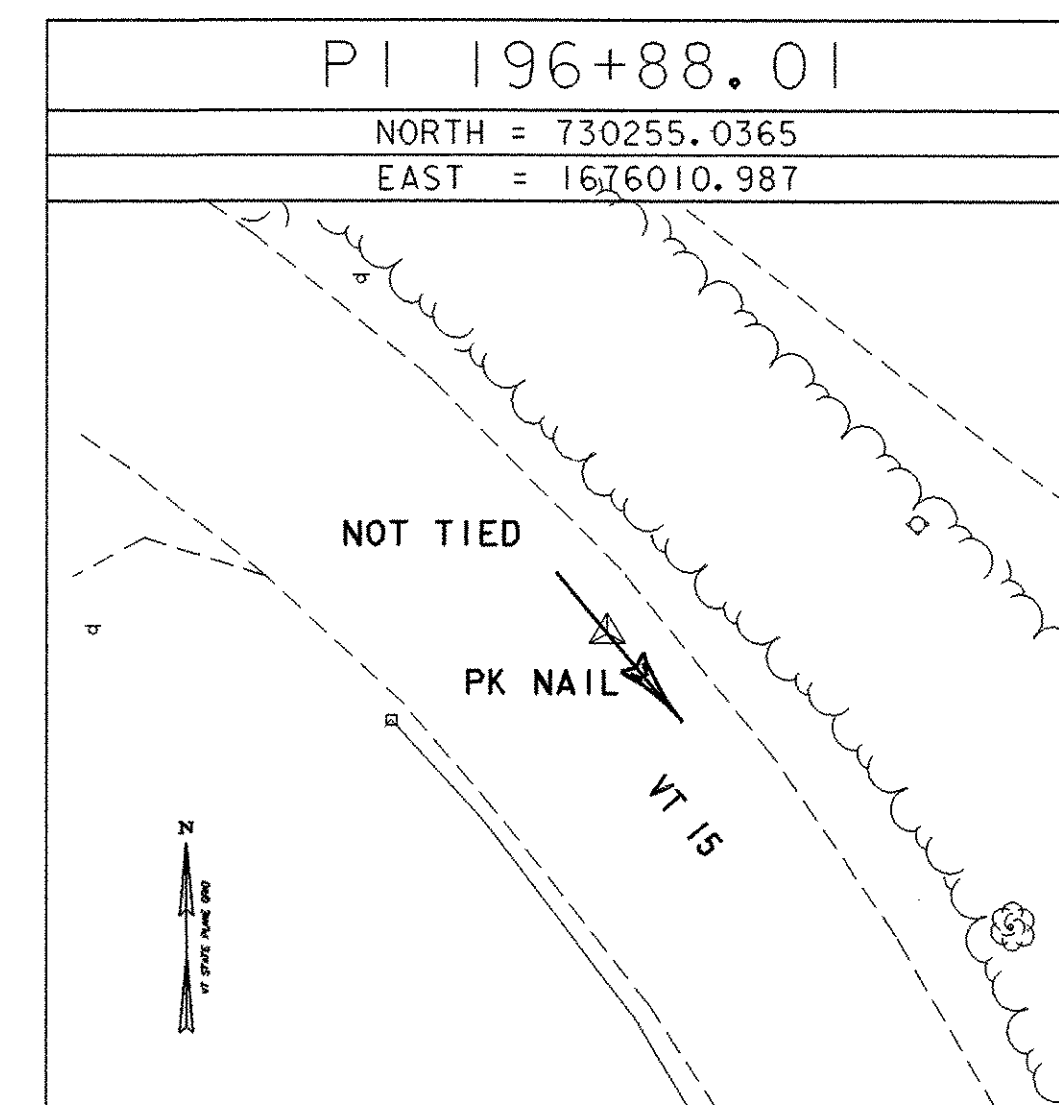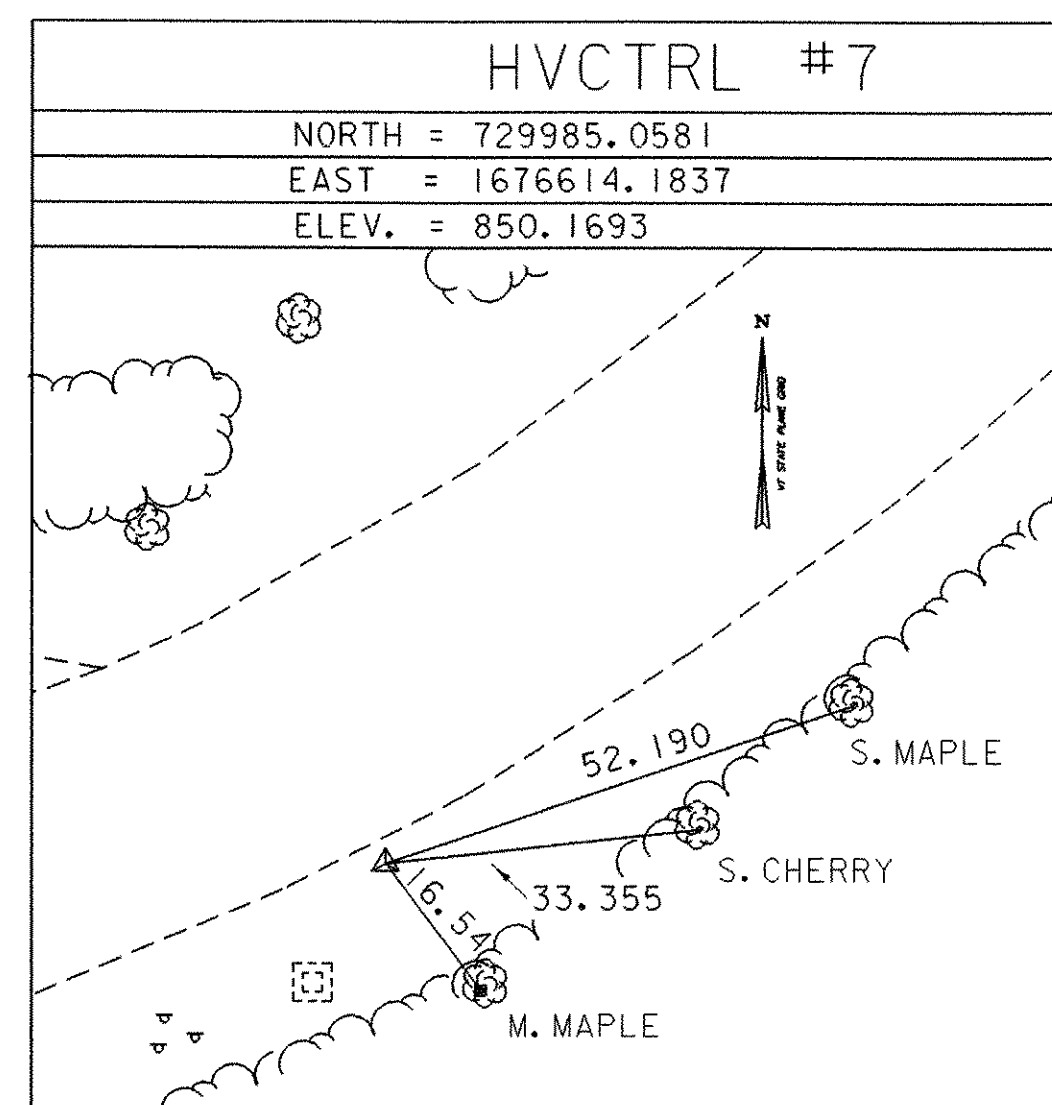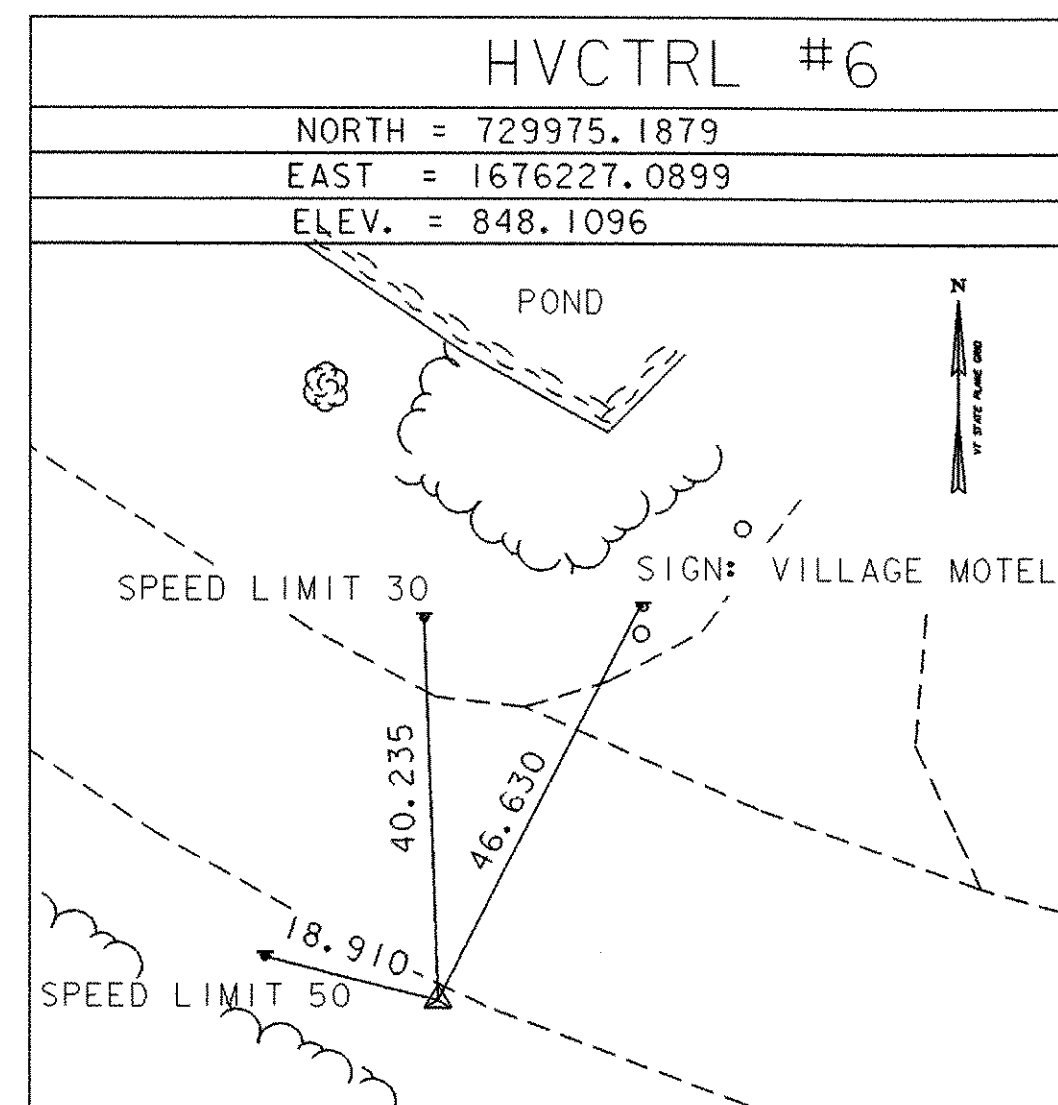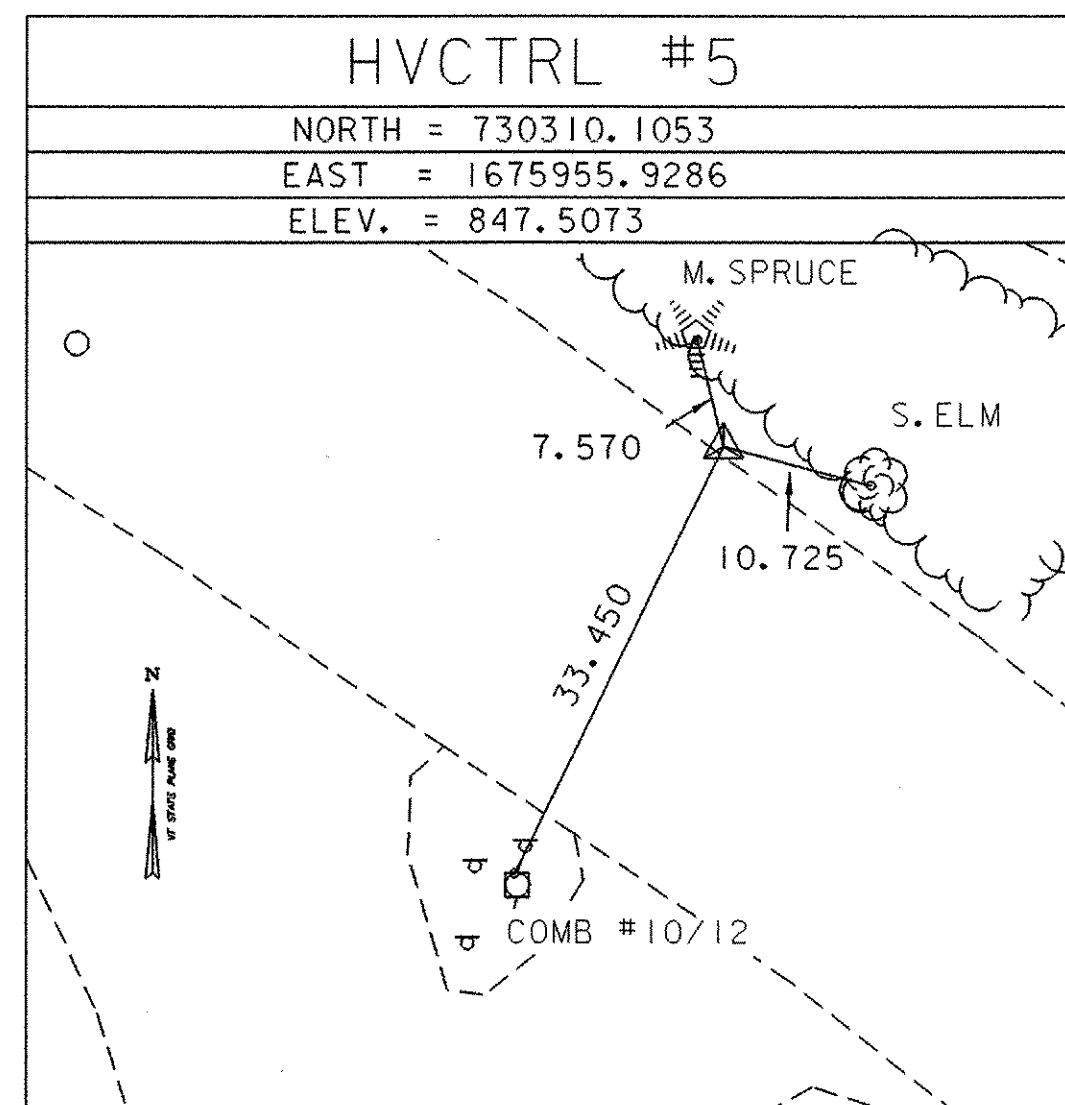

* MAIN TRAVERSE COMPLETED: MAY 2, 2004 BY R.GILMAN PC, P.WINTERS

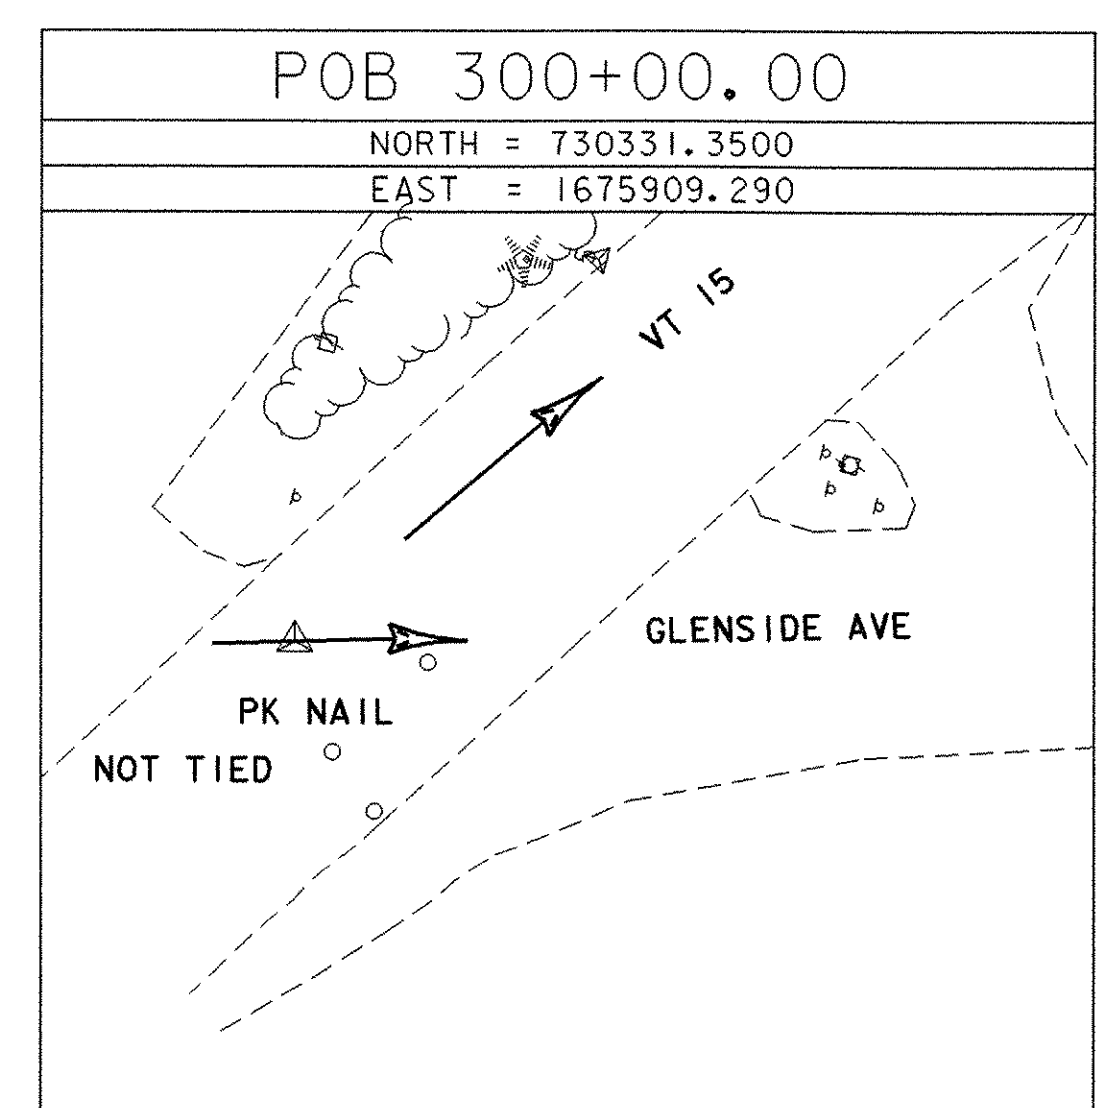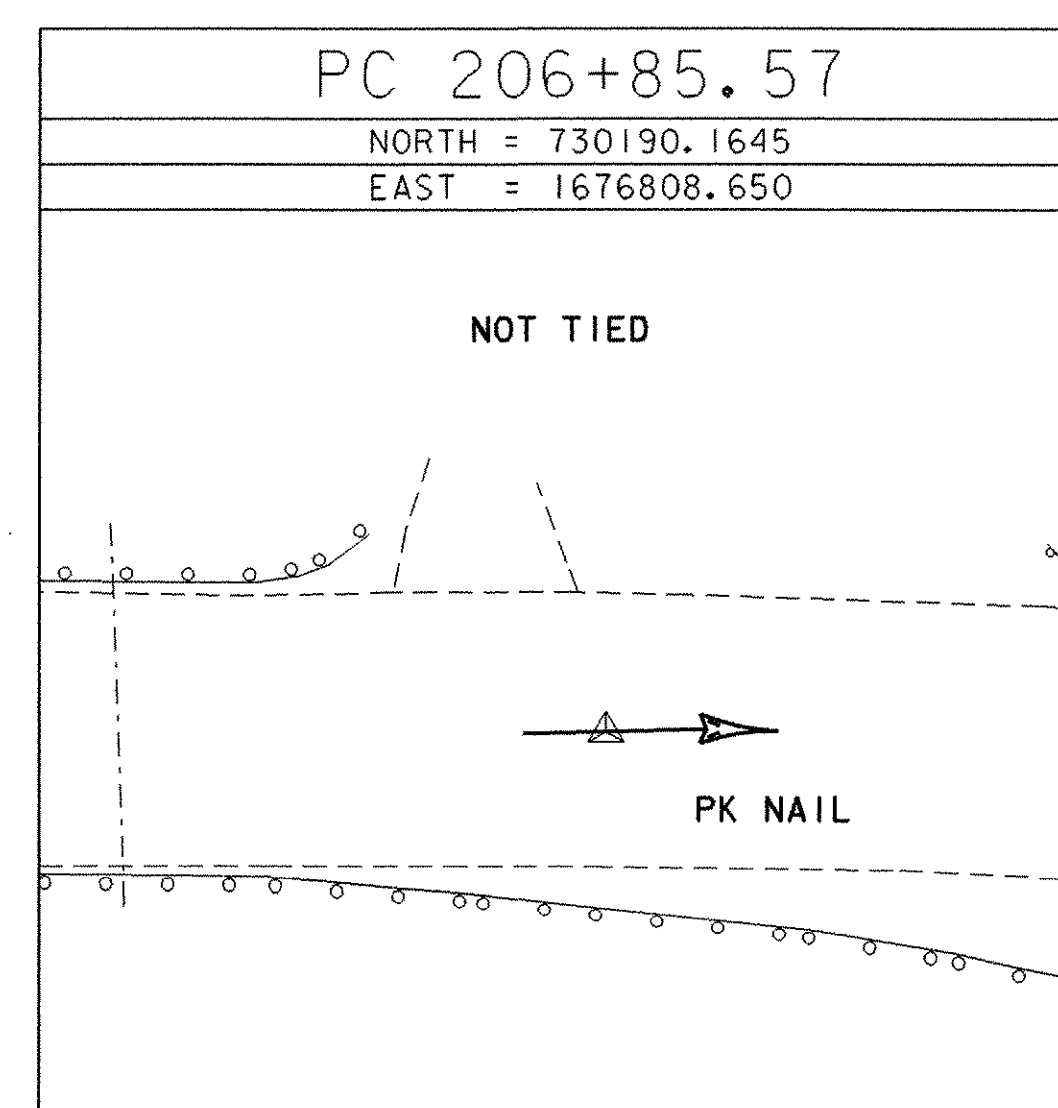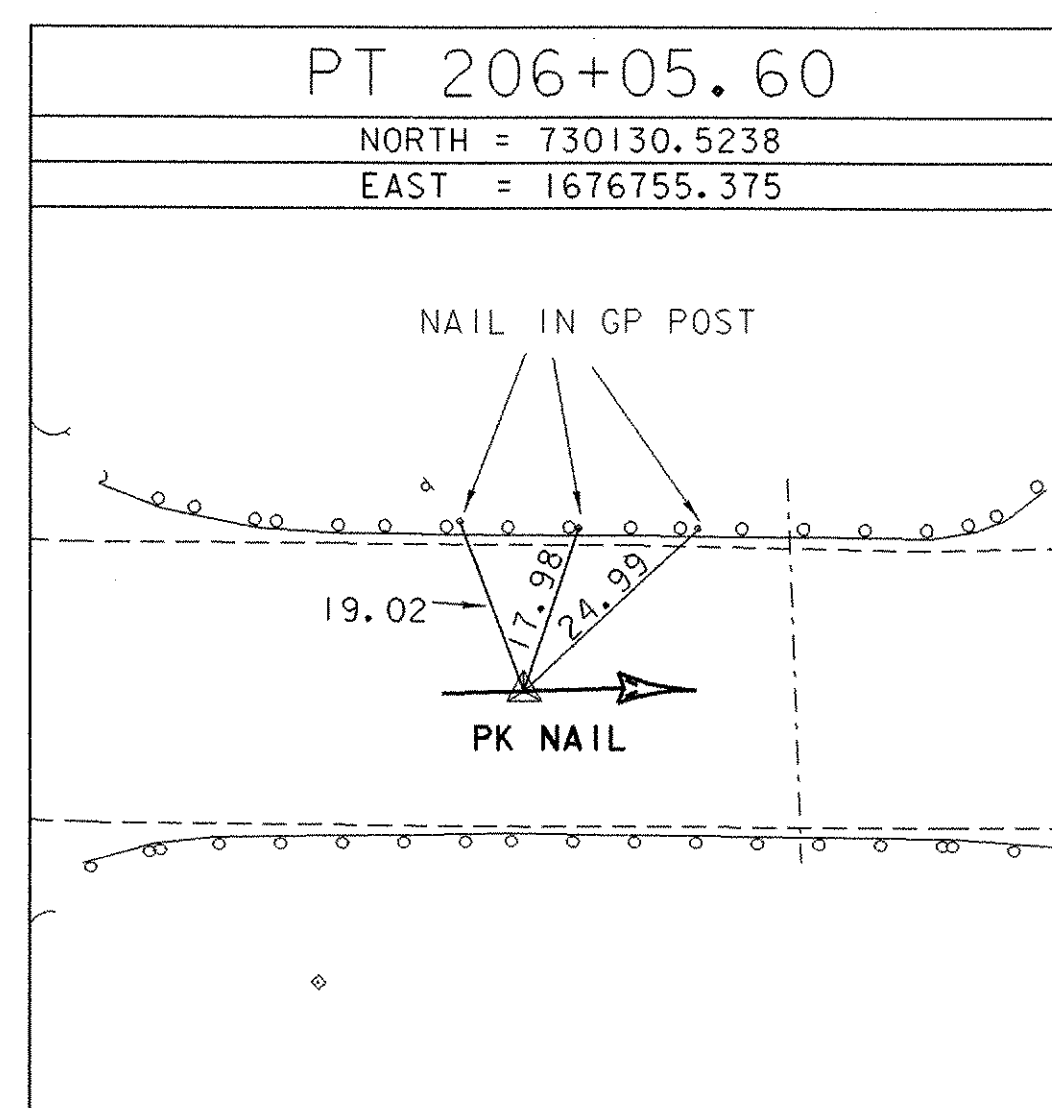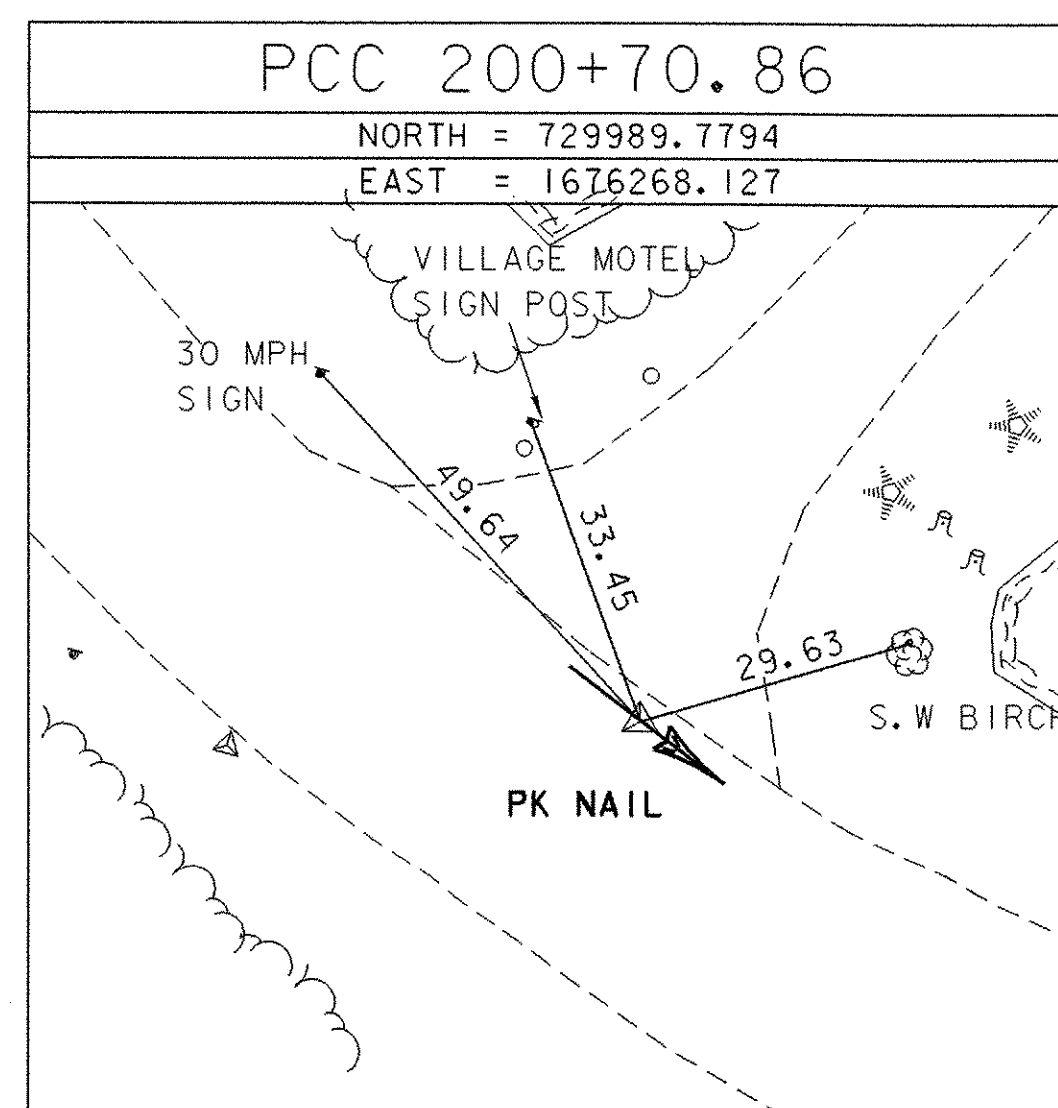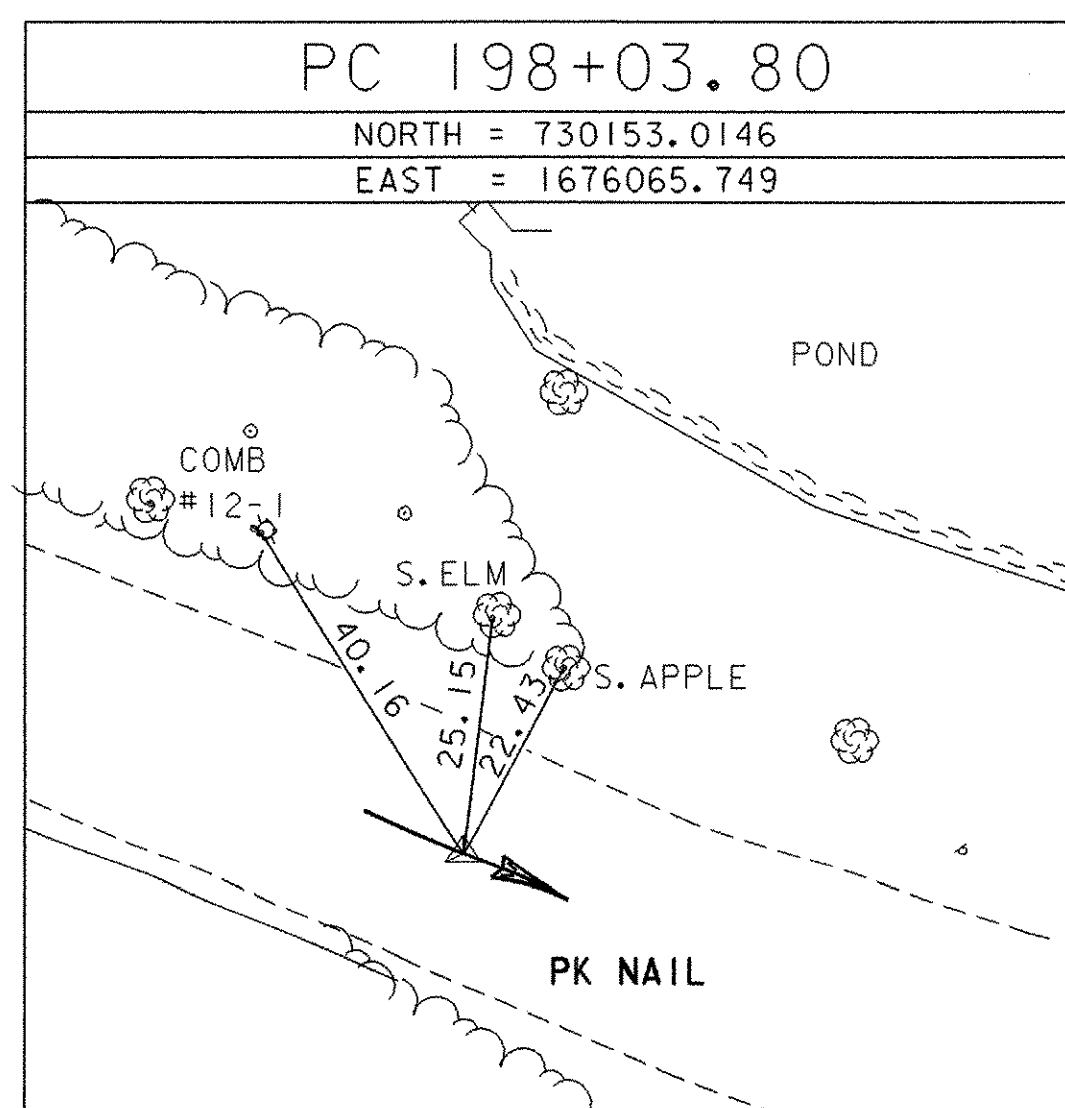

DATUM

VERTICAL NAVD 88

HORIZONTAL NAD 83(96)

ADJUSTMENT COMPASS

* ALIGNMENT STAKED: MARCH 30, 2005 BY: R.GILMAN, P.WINTERS & D.BREER

PROJECT NAME: HARDWICK

PROJECT NUMBER: STP ST 030-3(4)

FILE NAME: x04e060t1.dgn

PROJECT LEADER:

DESIGNED BY:

PLOT DATE: 18-OCT-2005

DRAWN BY: J.HULETT

CHECKED BY: P.BEYOR

SHEET 12 OF 63