
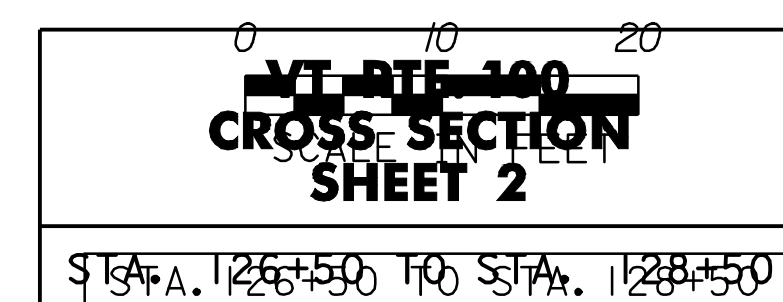
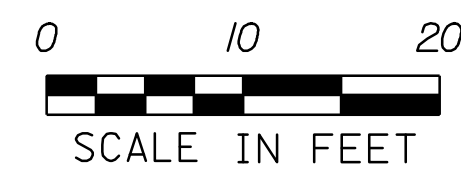
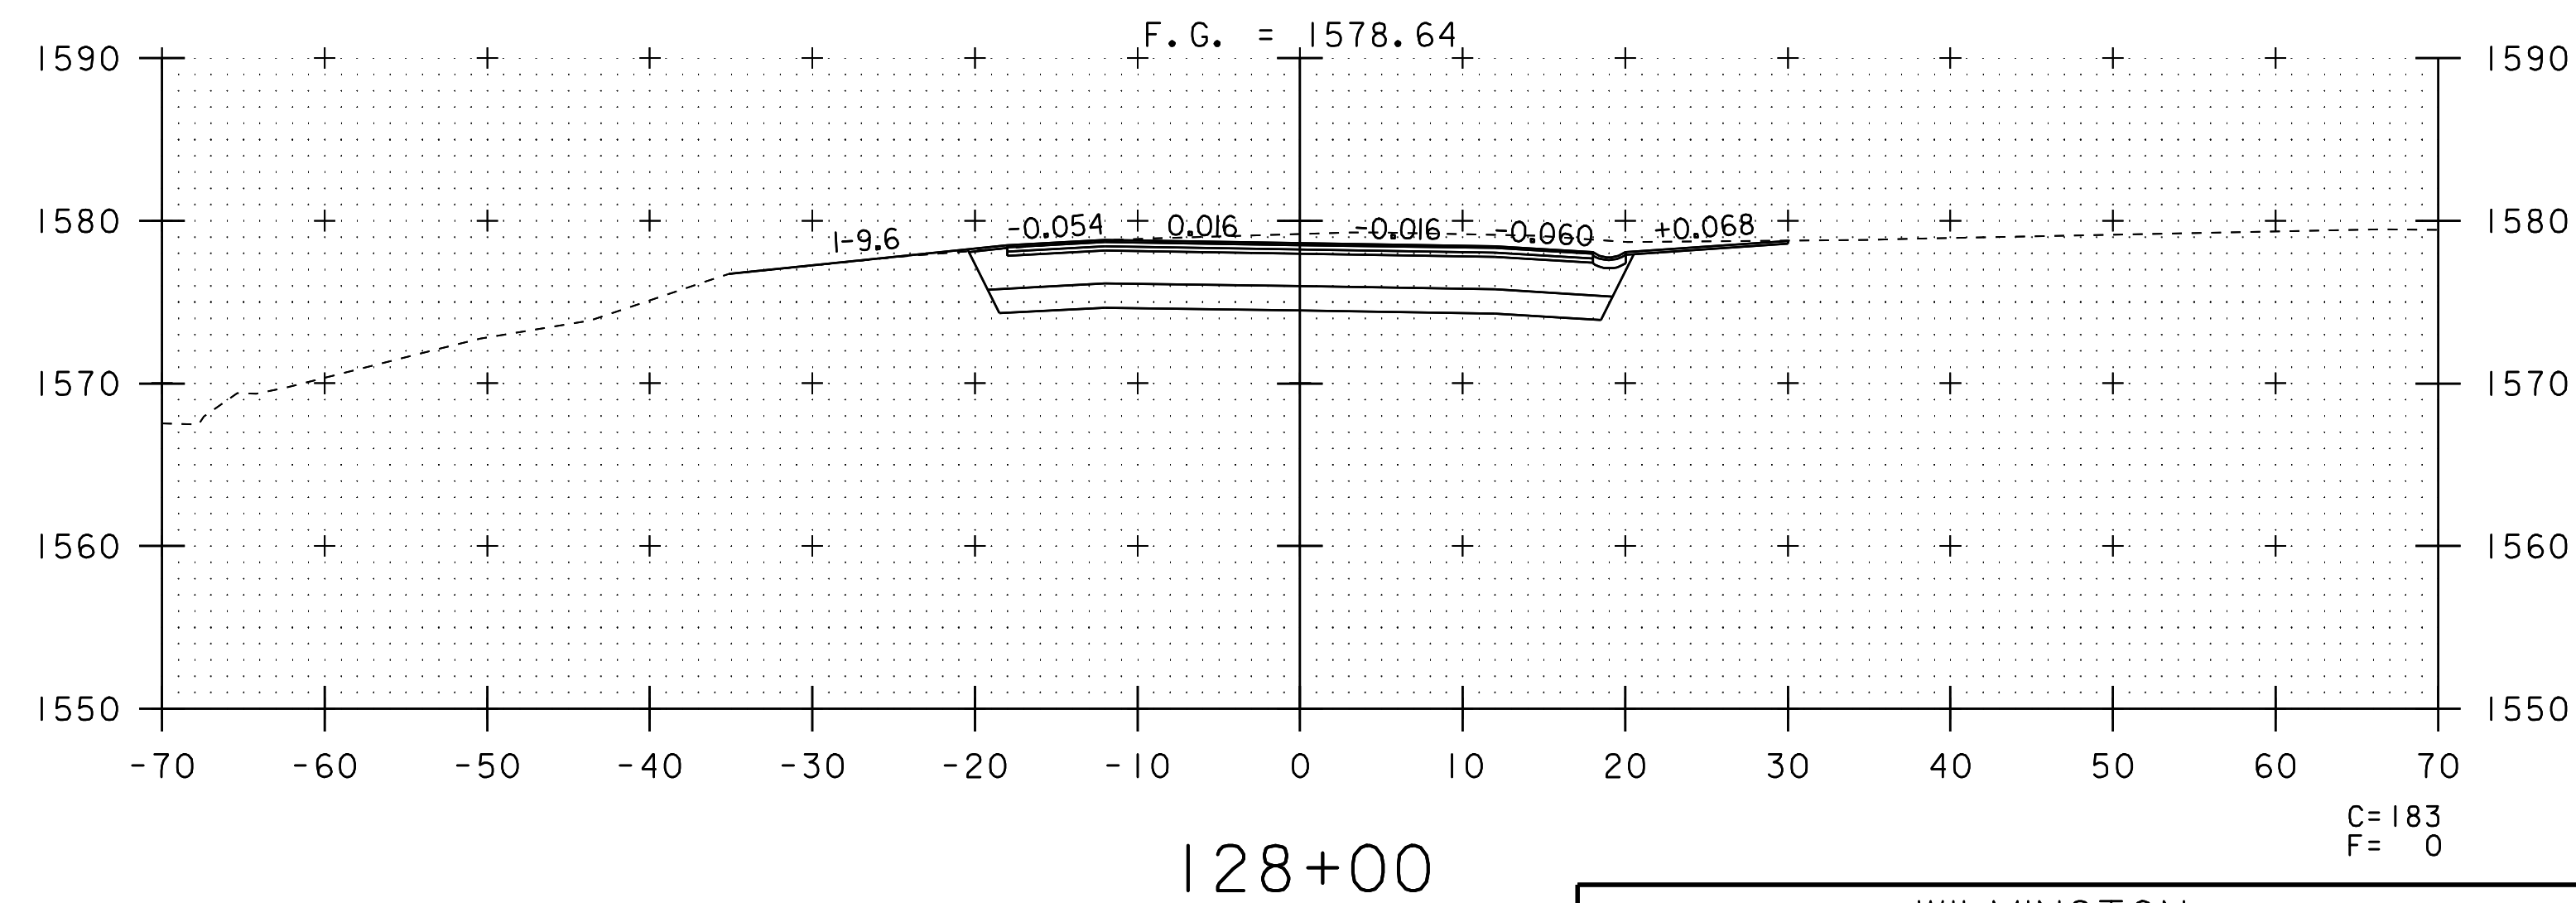
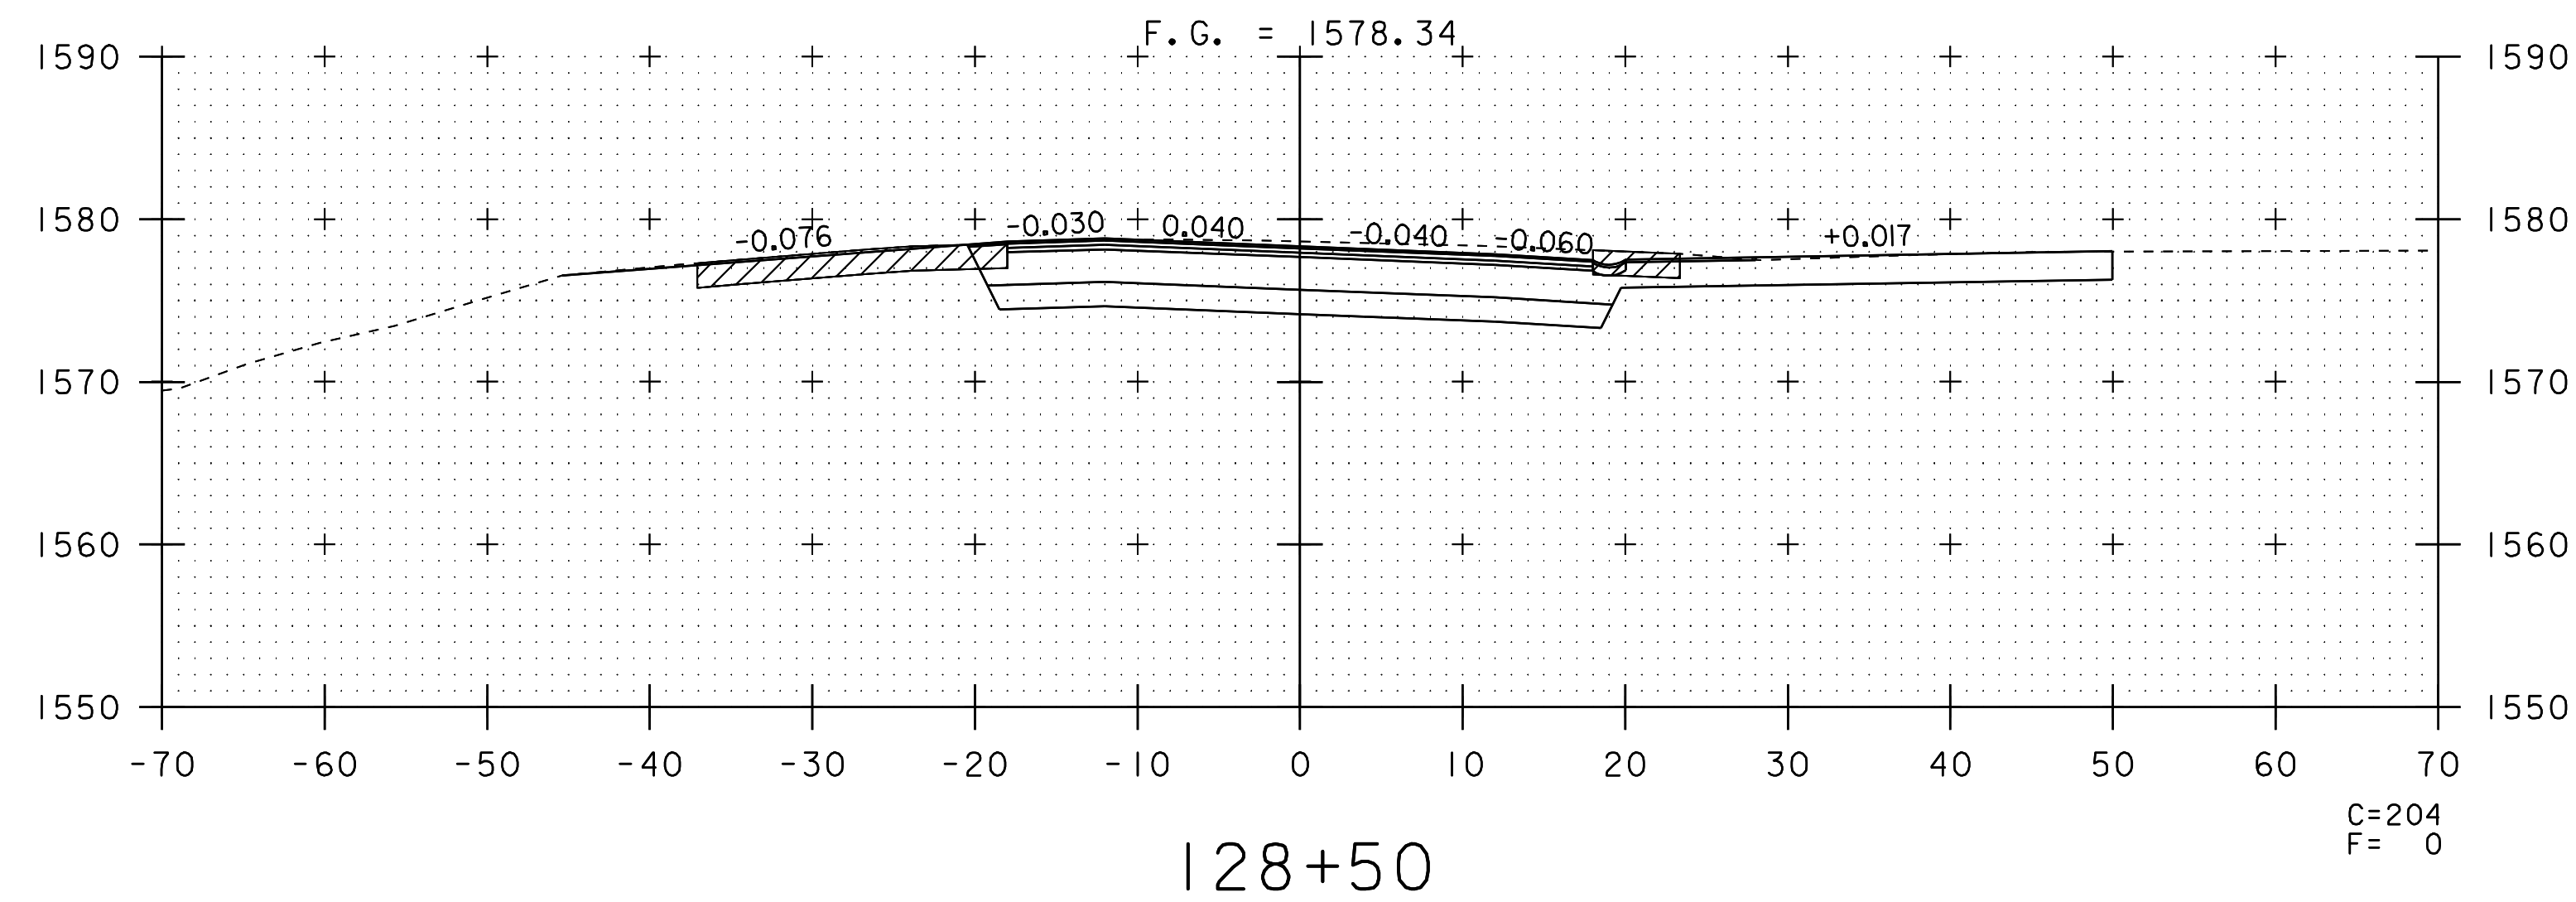
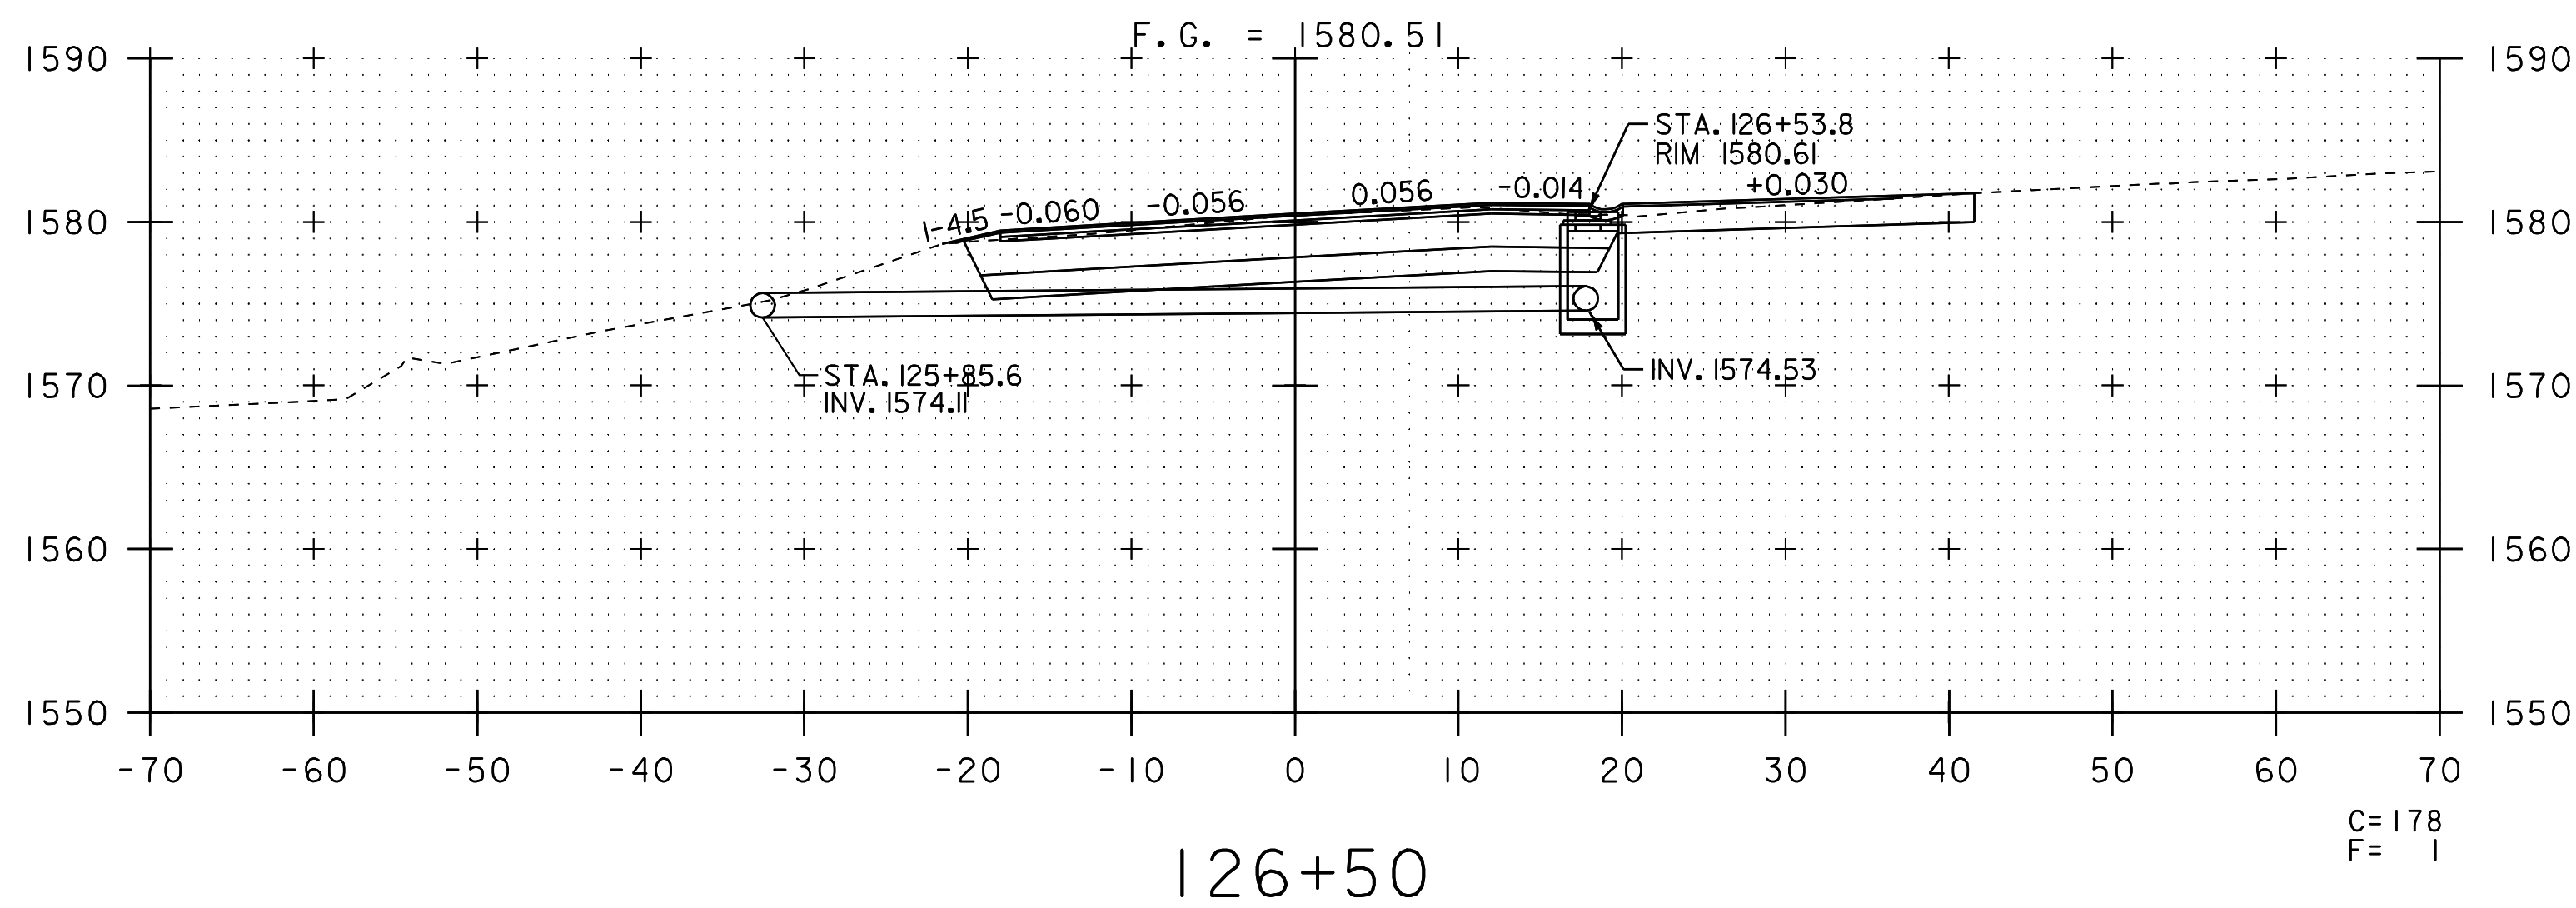
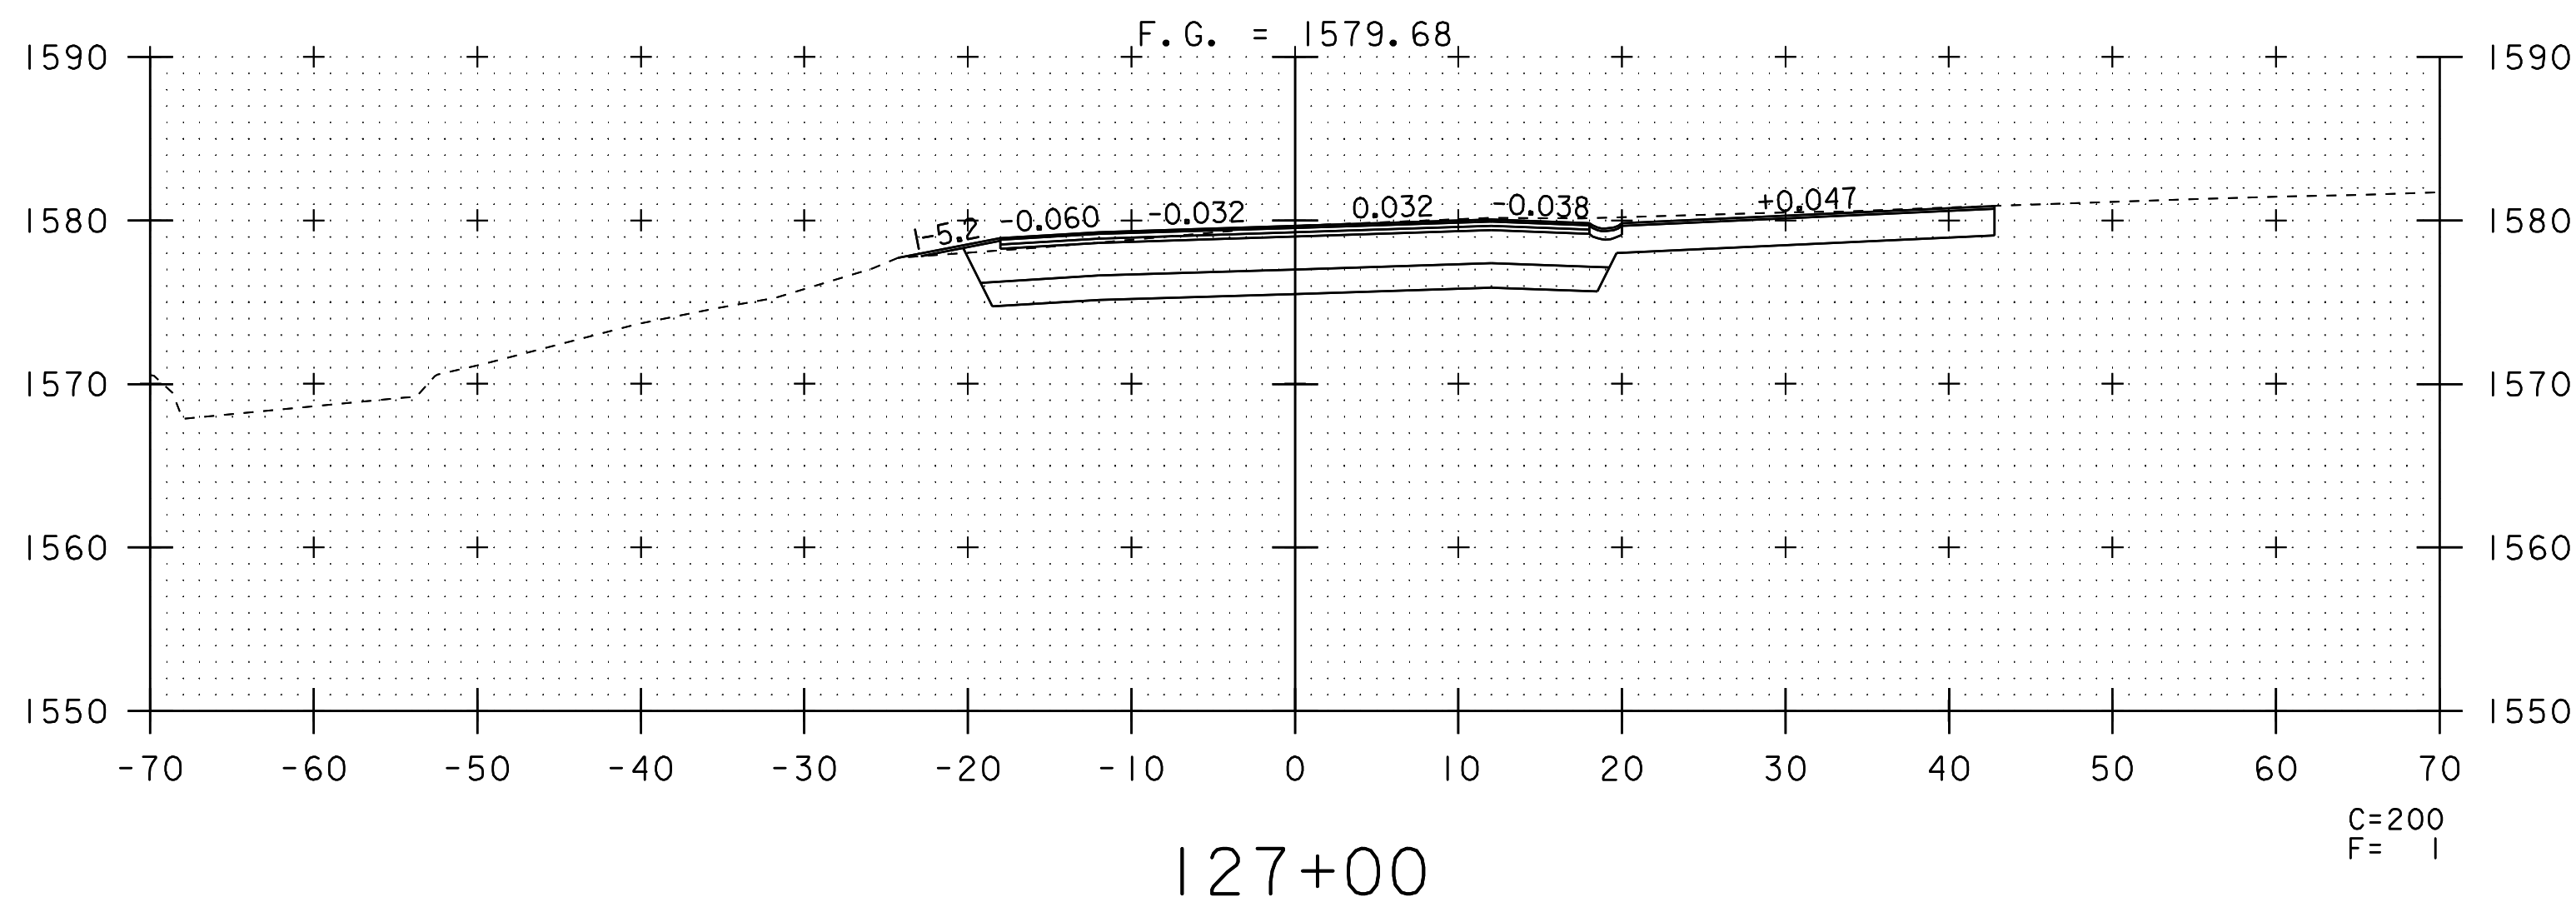


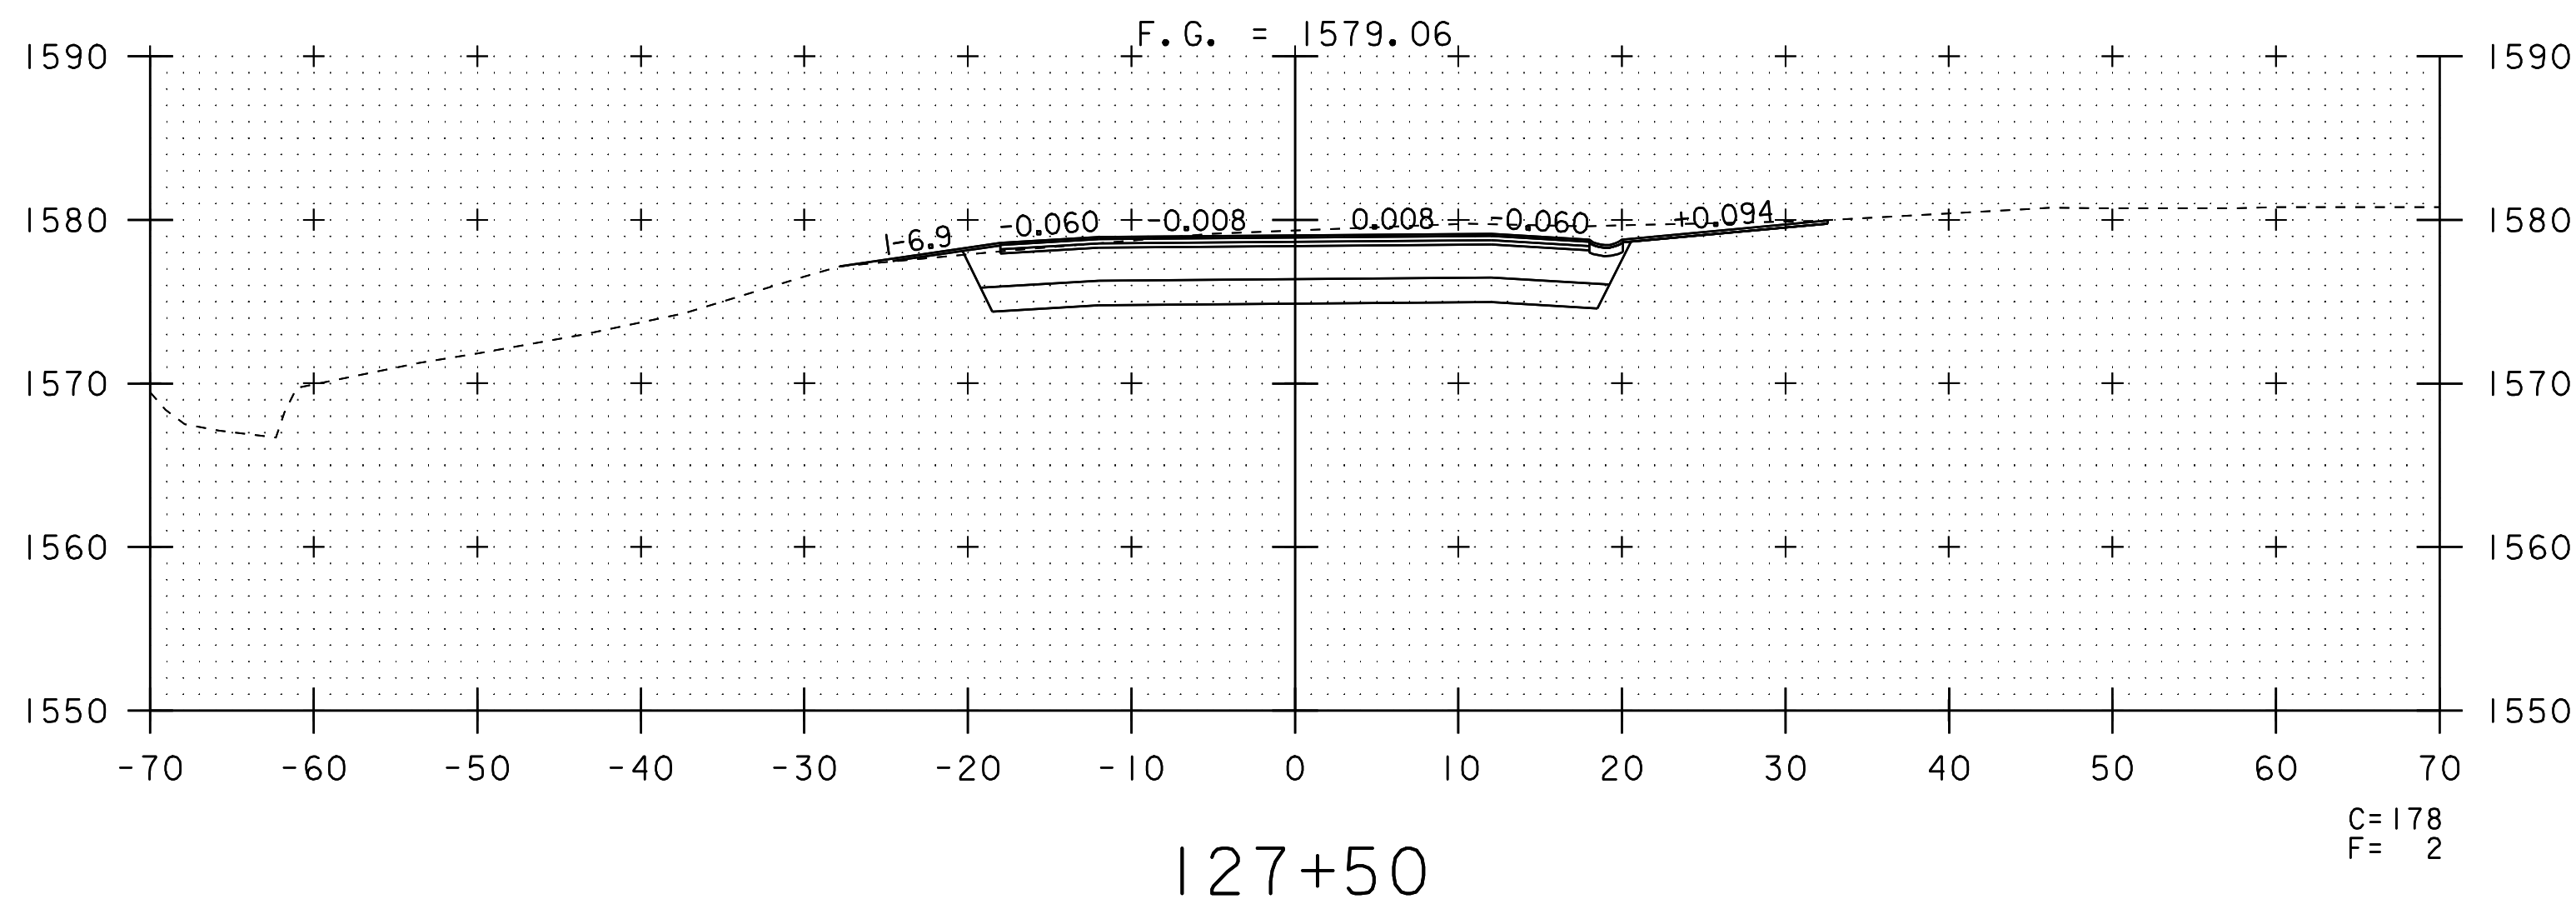

PROJECT NAME: WILMINGTON	
PROJECT NUMBER: HES_OIO-1(38)	
FILE NAME: Q5c324.dgn	PLOT DATE: 23-APR-2024
PROJECT LEADER: DEG	DRAWN BY: CAK
DESIGNED BY: DWE	CHECKED BY: DWE
VI.ROUTE_100_CROSS_SECTIONS_XS-2	SHEET 119 OF 125