




FILE NAME = U:\1762\CADD\NST\STP 2506\p05b048.Convect Plans.dgn
DATE/TIME = 12/20/2012
USER = 4966

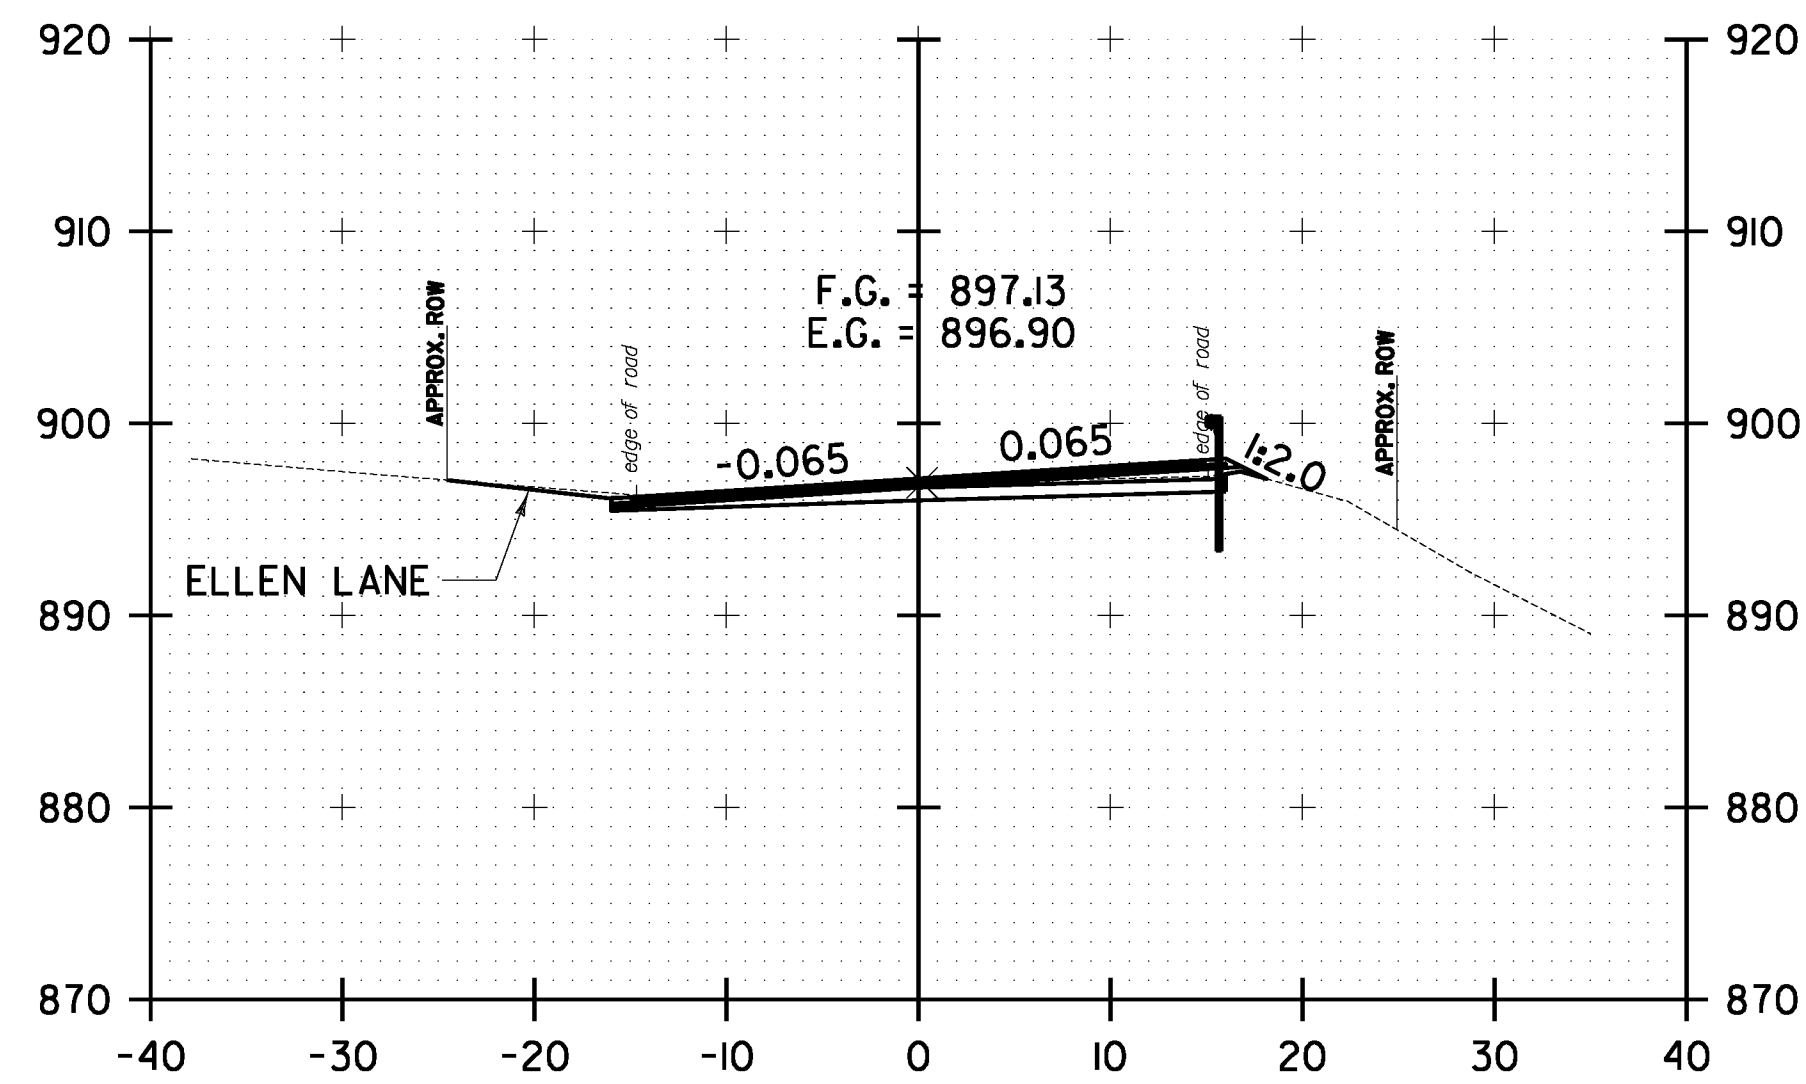


233+50.00

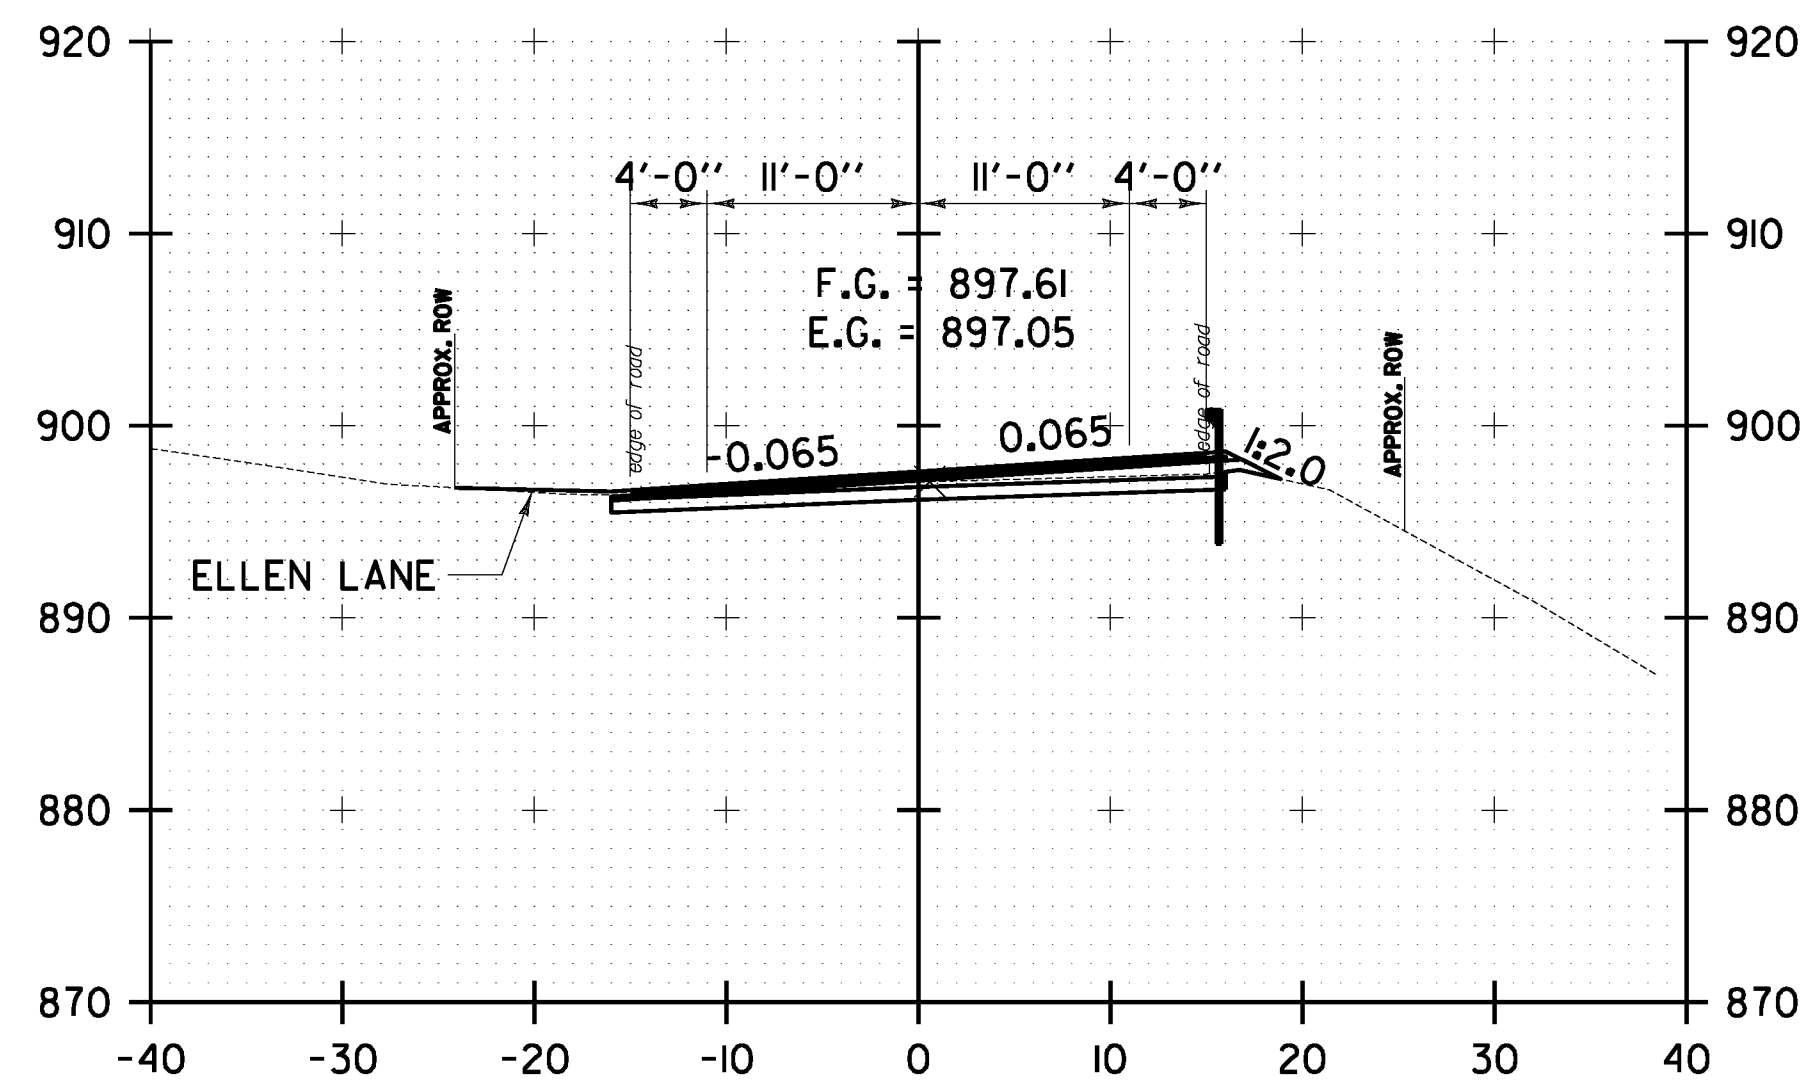


233+00.00

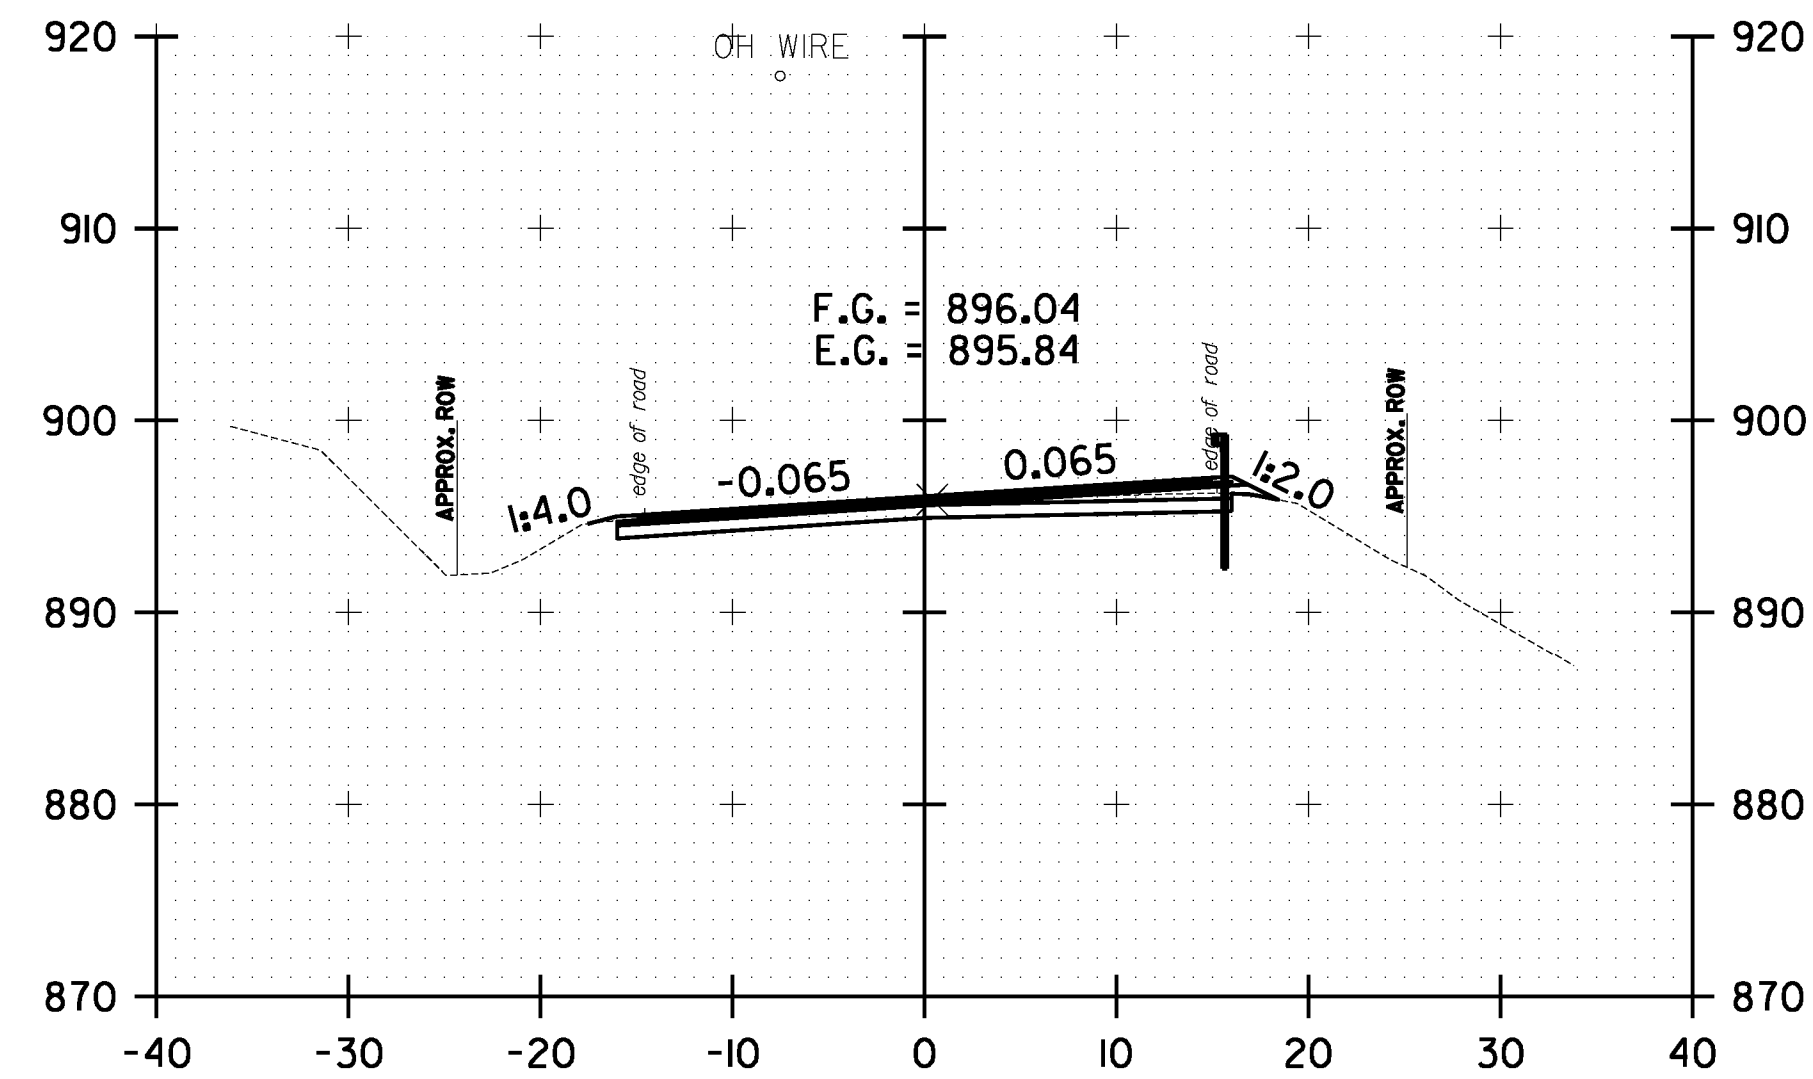


234+50.00

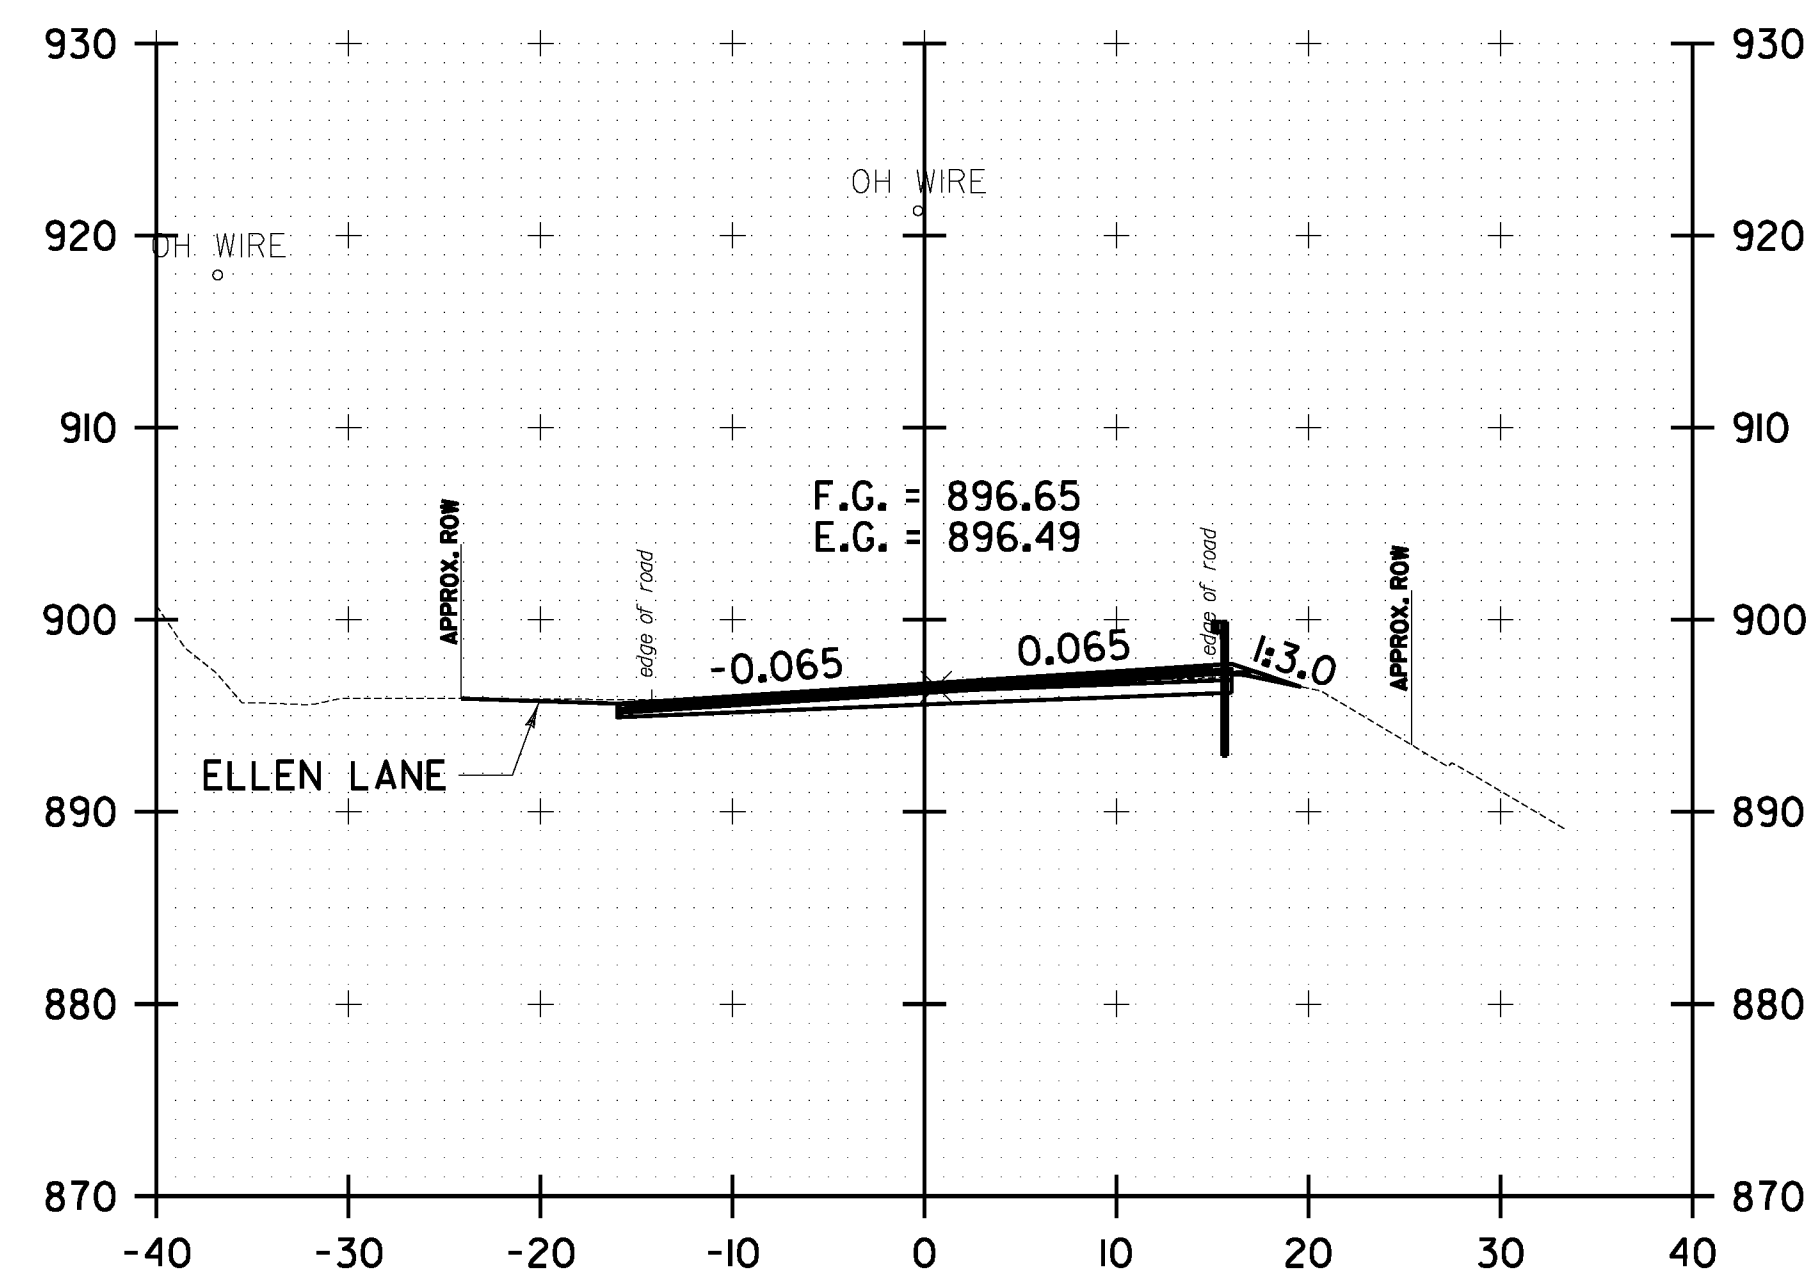


234+00.00

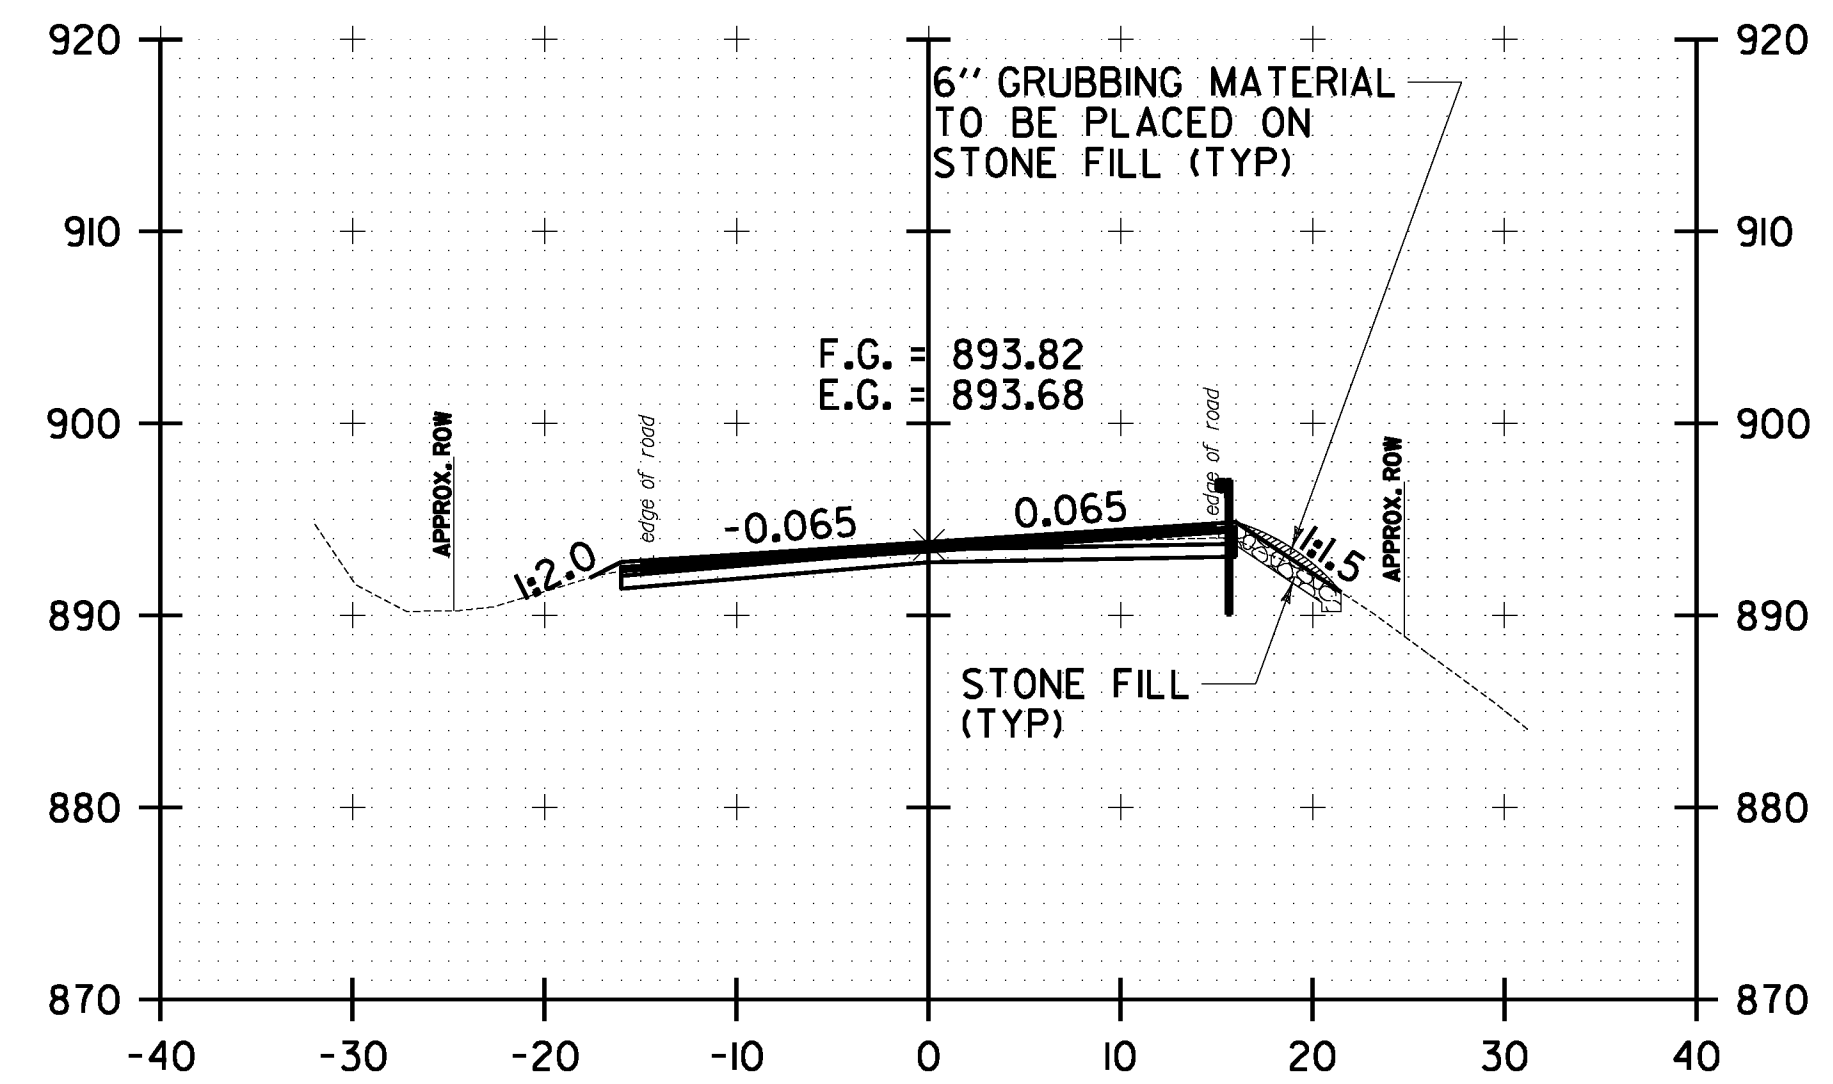

235+50.00

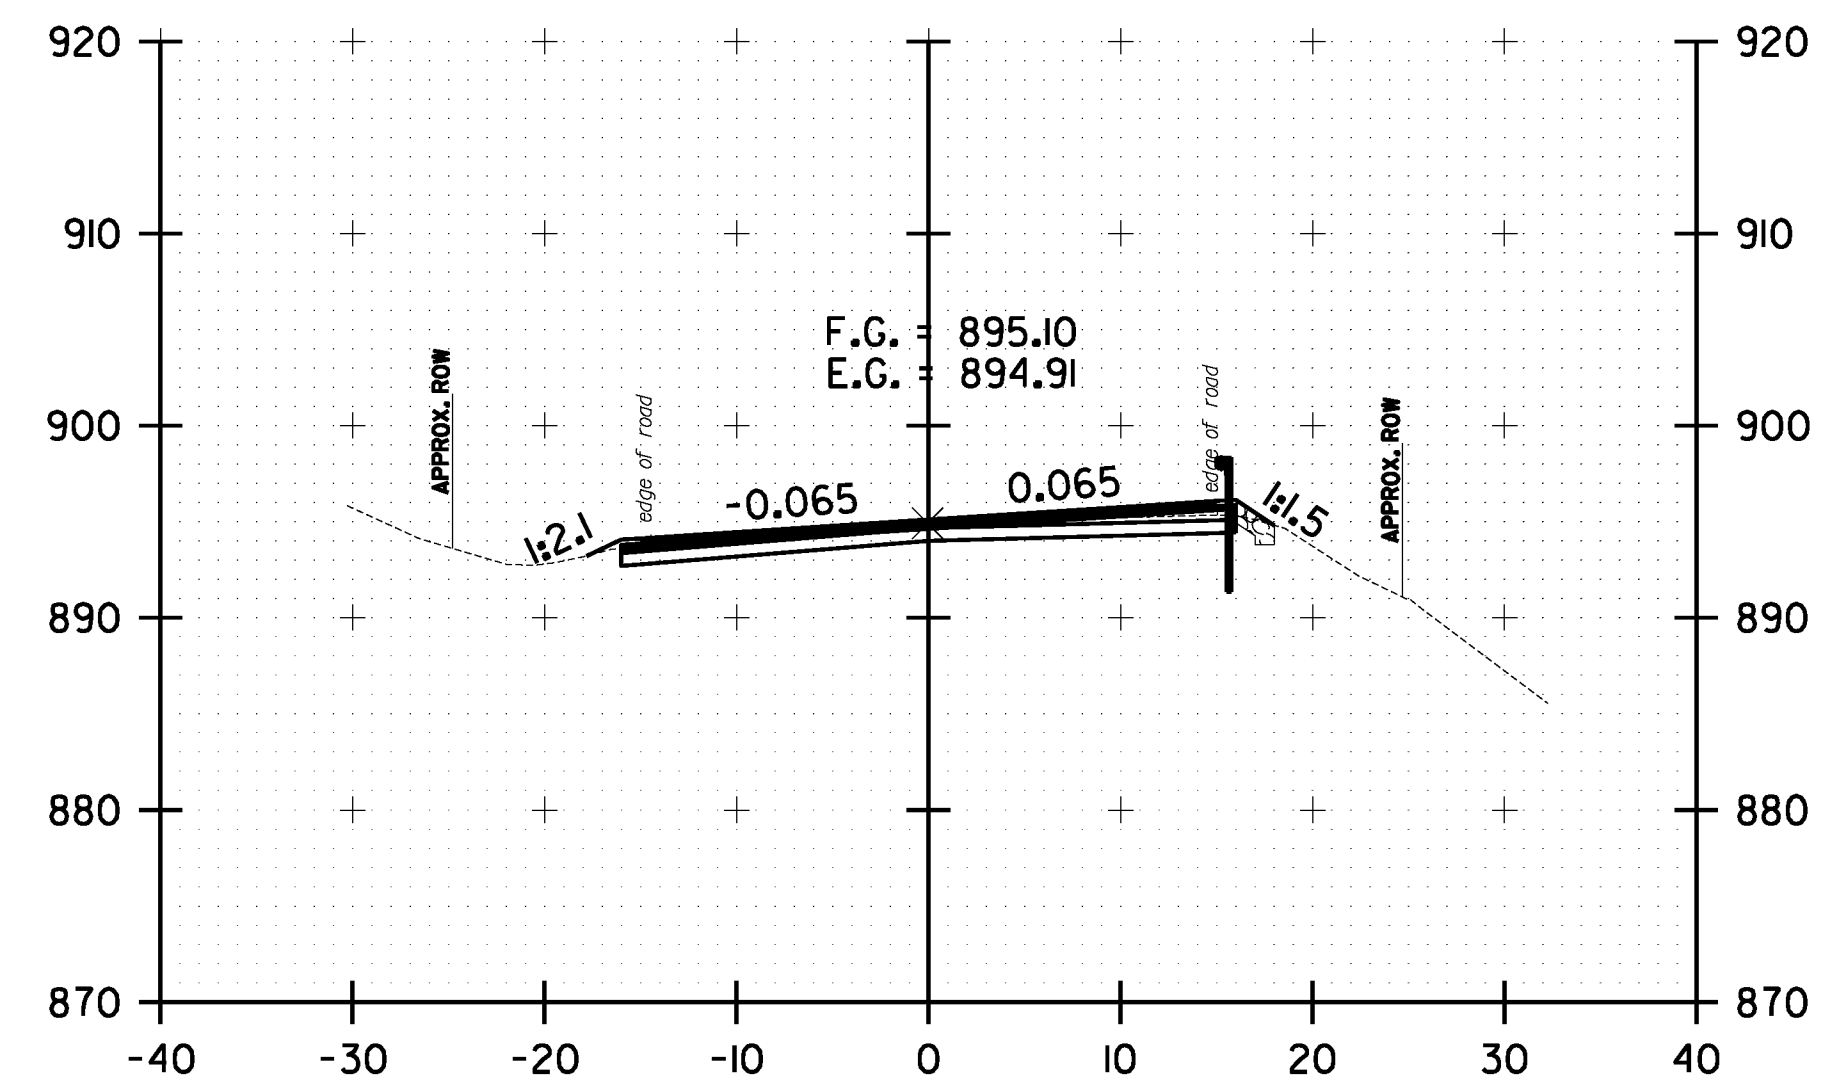

235+00.00

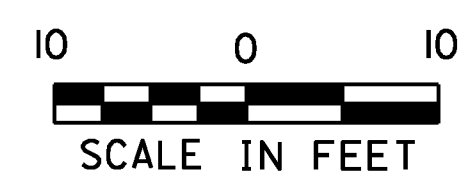

**WARREN
CROSS SECTION
SHEET #62**

PROJECT NAME: WARREN-WAITSFIELD

PROJECT NUMBER: STP 2506(II)

FILE NAME: p05b048.dgn

PROJECT LEADER: D.E.G.

DESIGNED BY: M.J.M.

IPARM FILE: p05b048xs62.1

PLOT DATE: 12/20/2012

DRAWN BY: W.G.P.

CHECKED BY: D.E.G.

SHEET 225 OF 310