




FILE NAME = U:\1762\CADD\N5TIN\STP 2506\p05b048.Convect Plans.dgn
DATE/TIME = 12/20/2012
USER = 4986

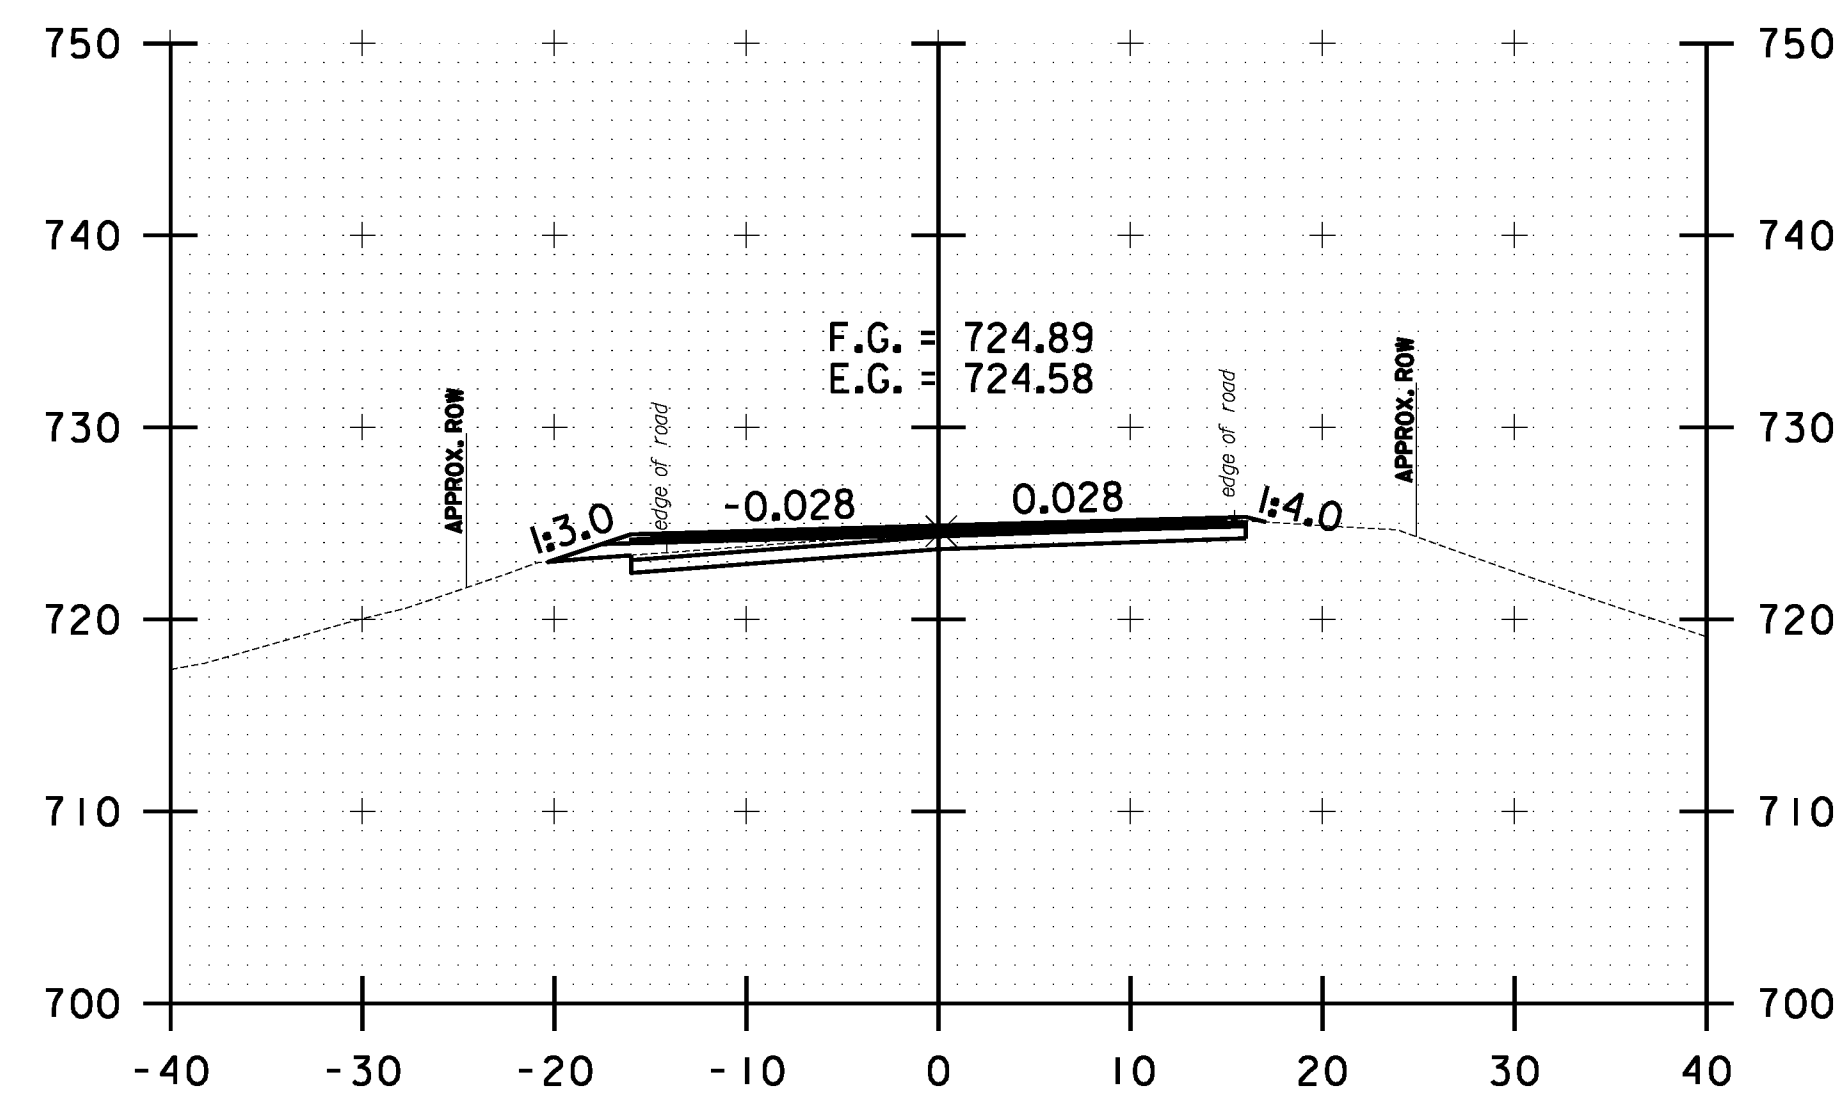


111+00.00

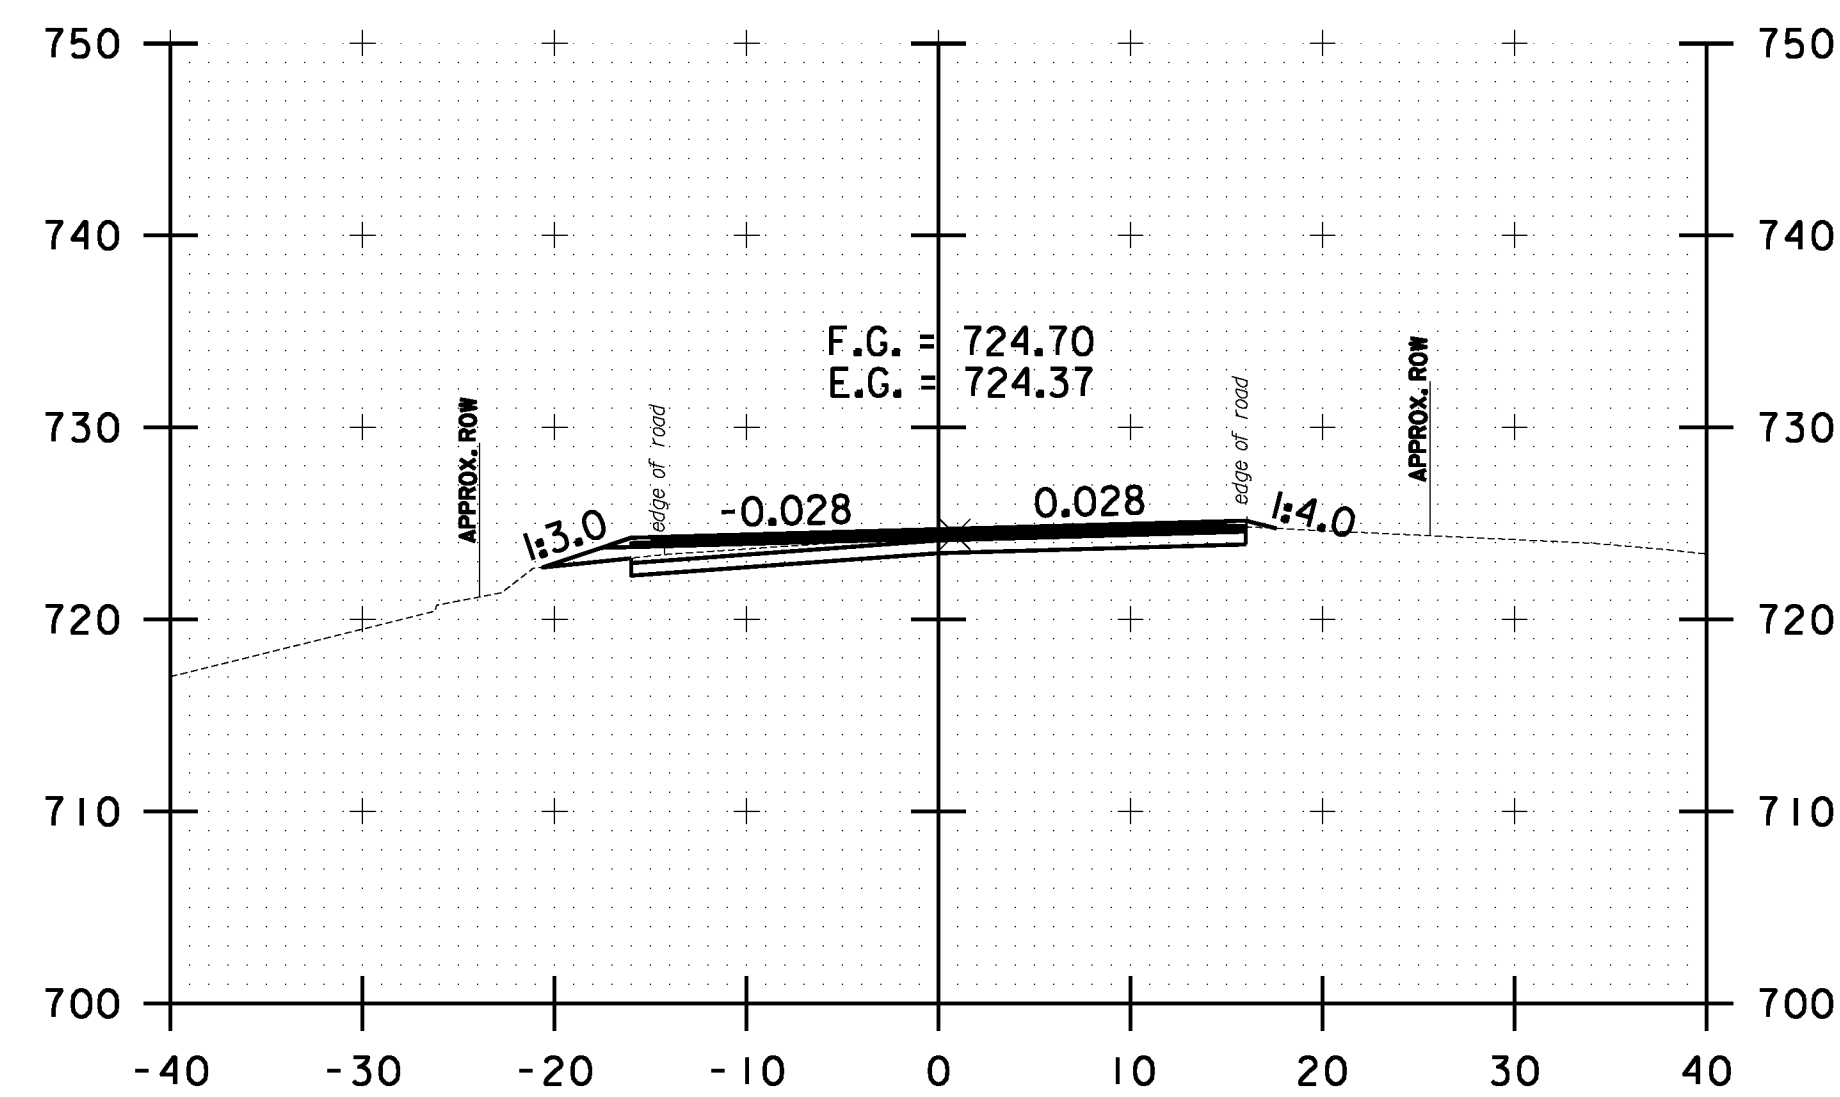


112+00.00

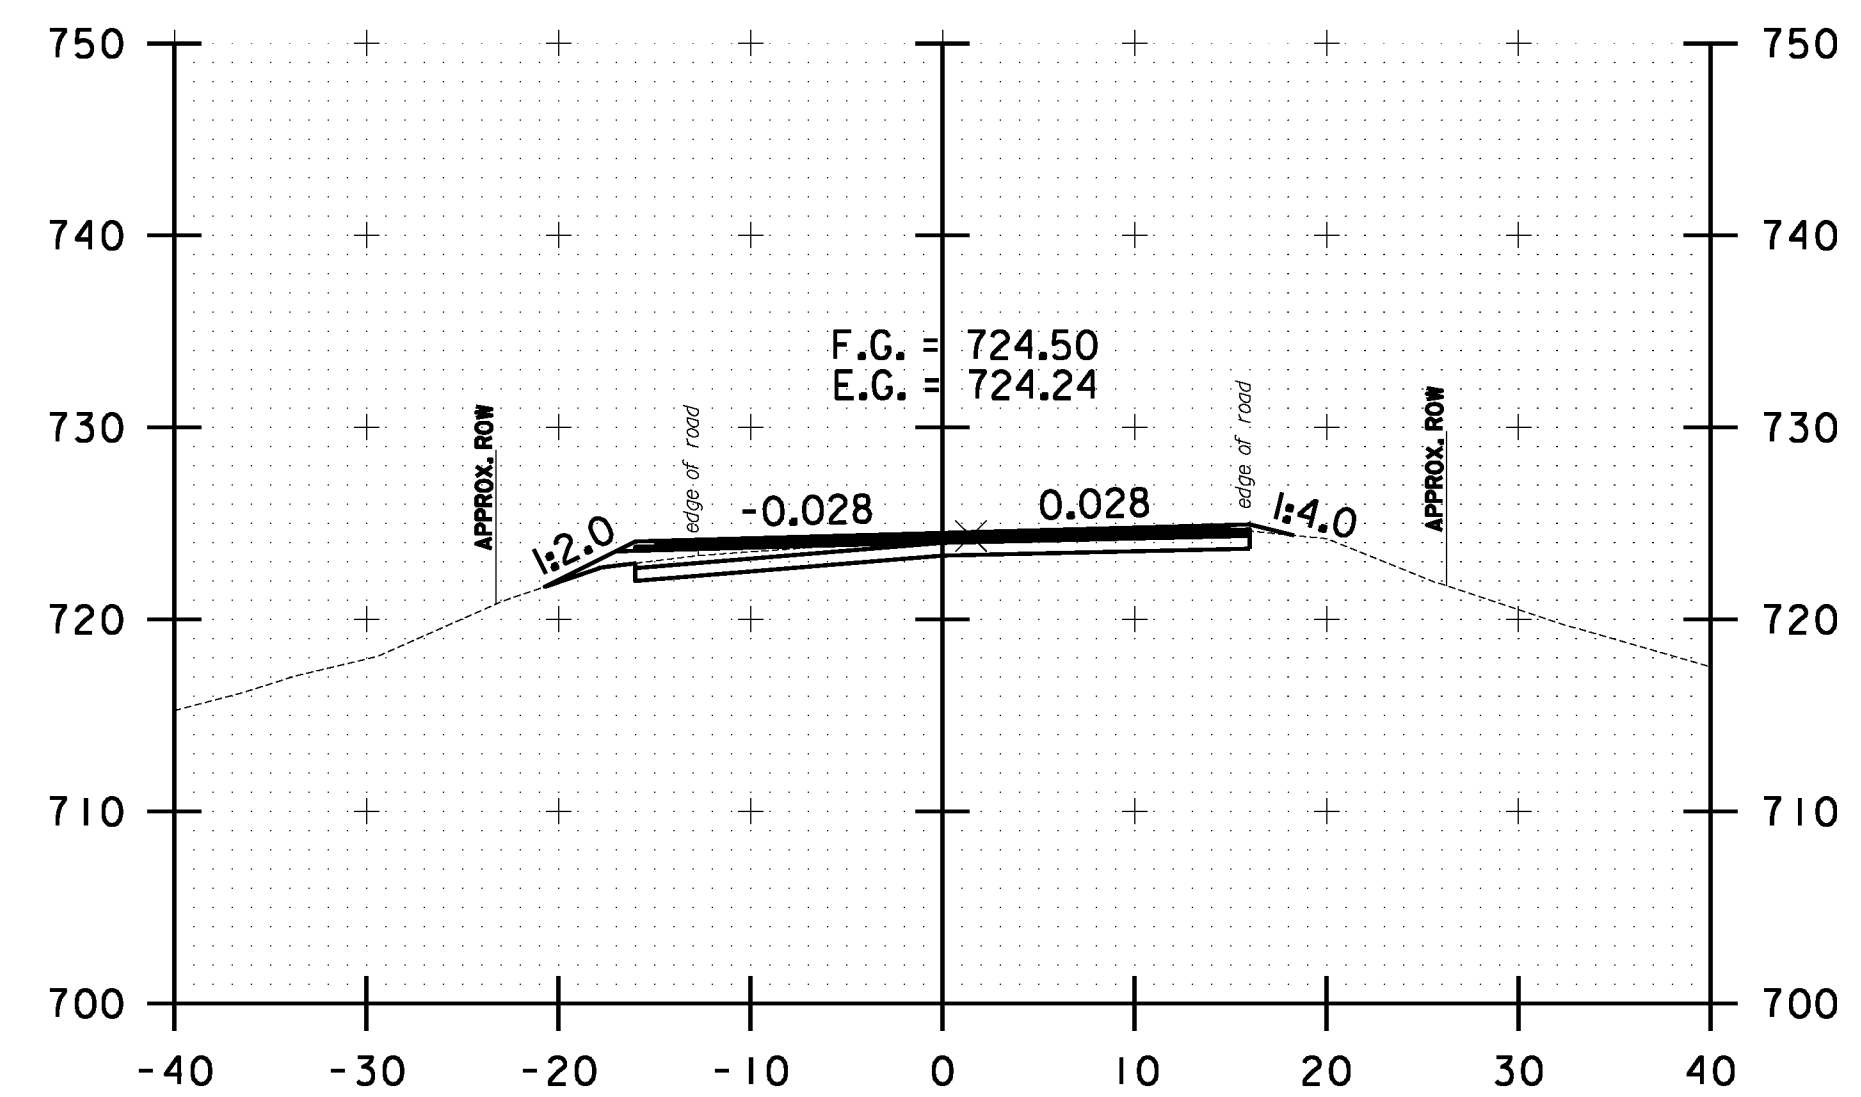


113+00.00

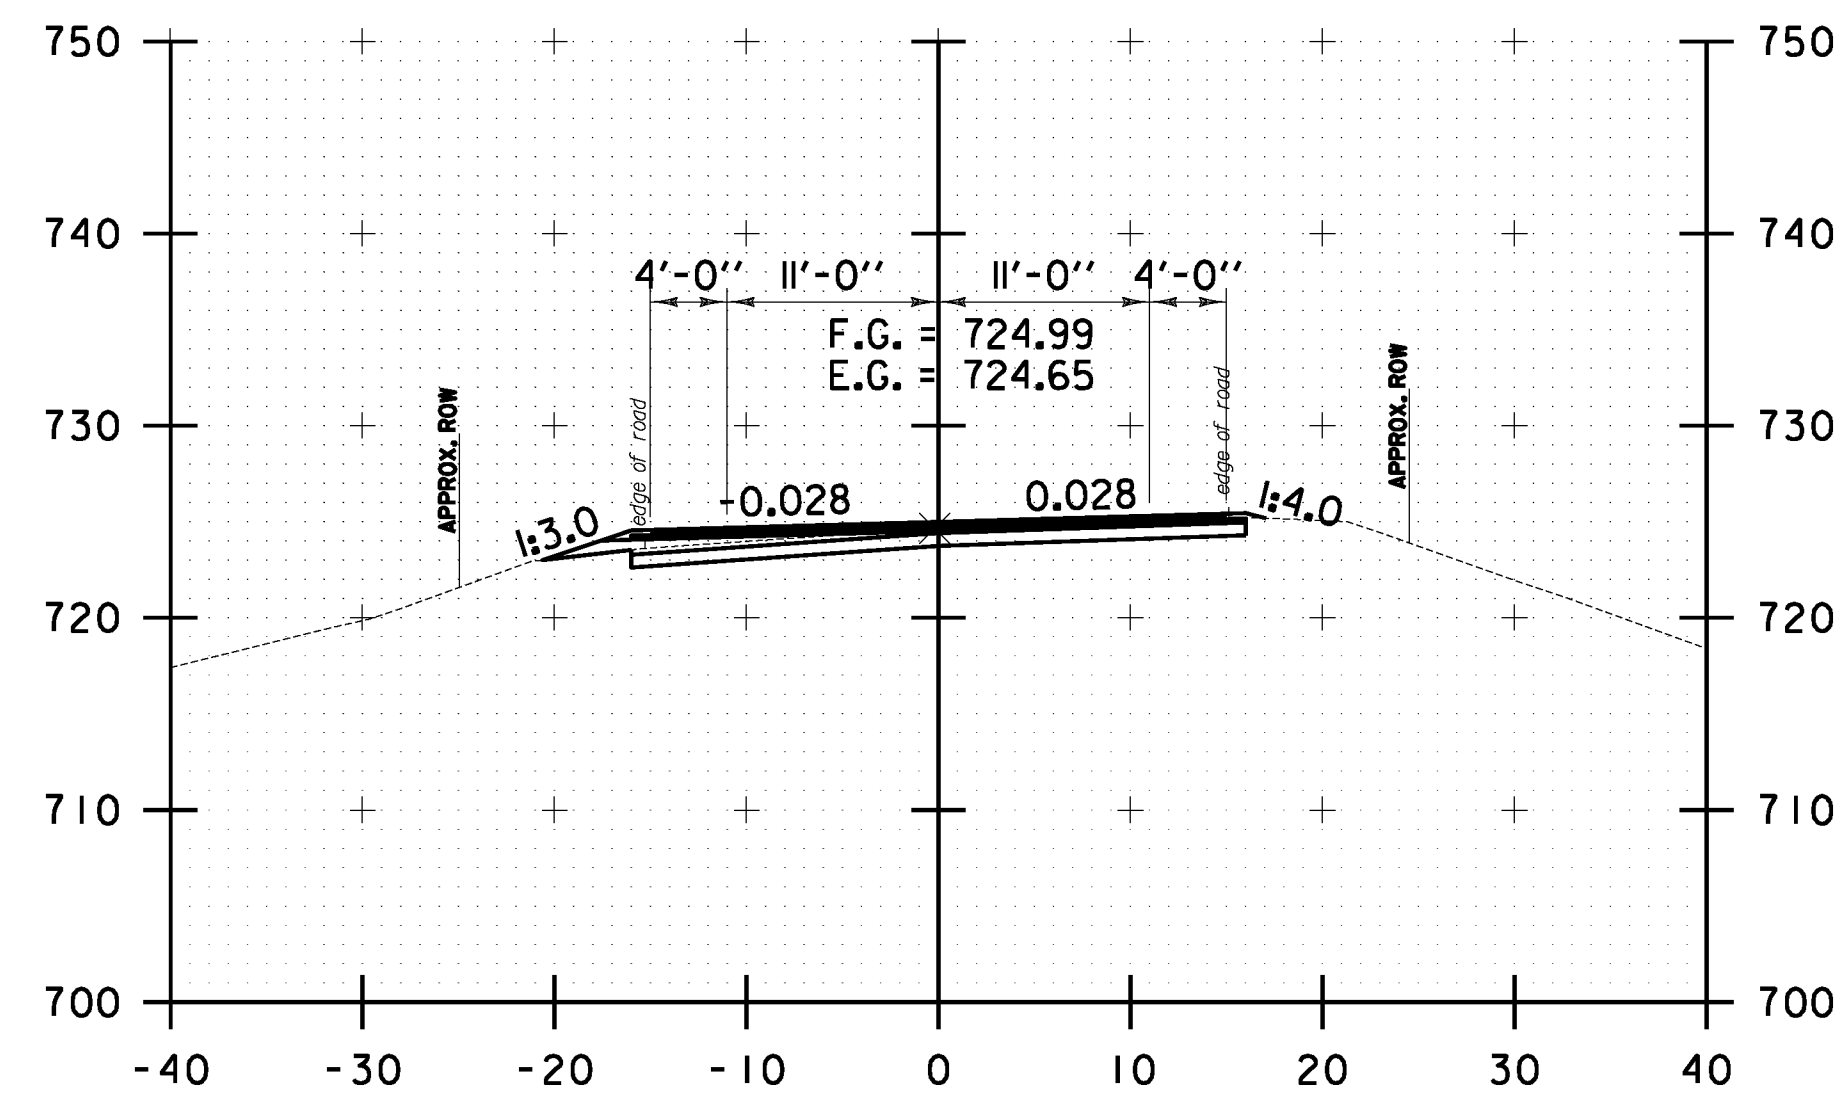


110+50.00

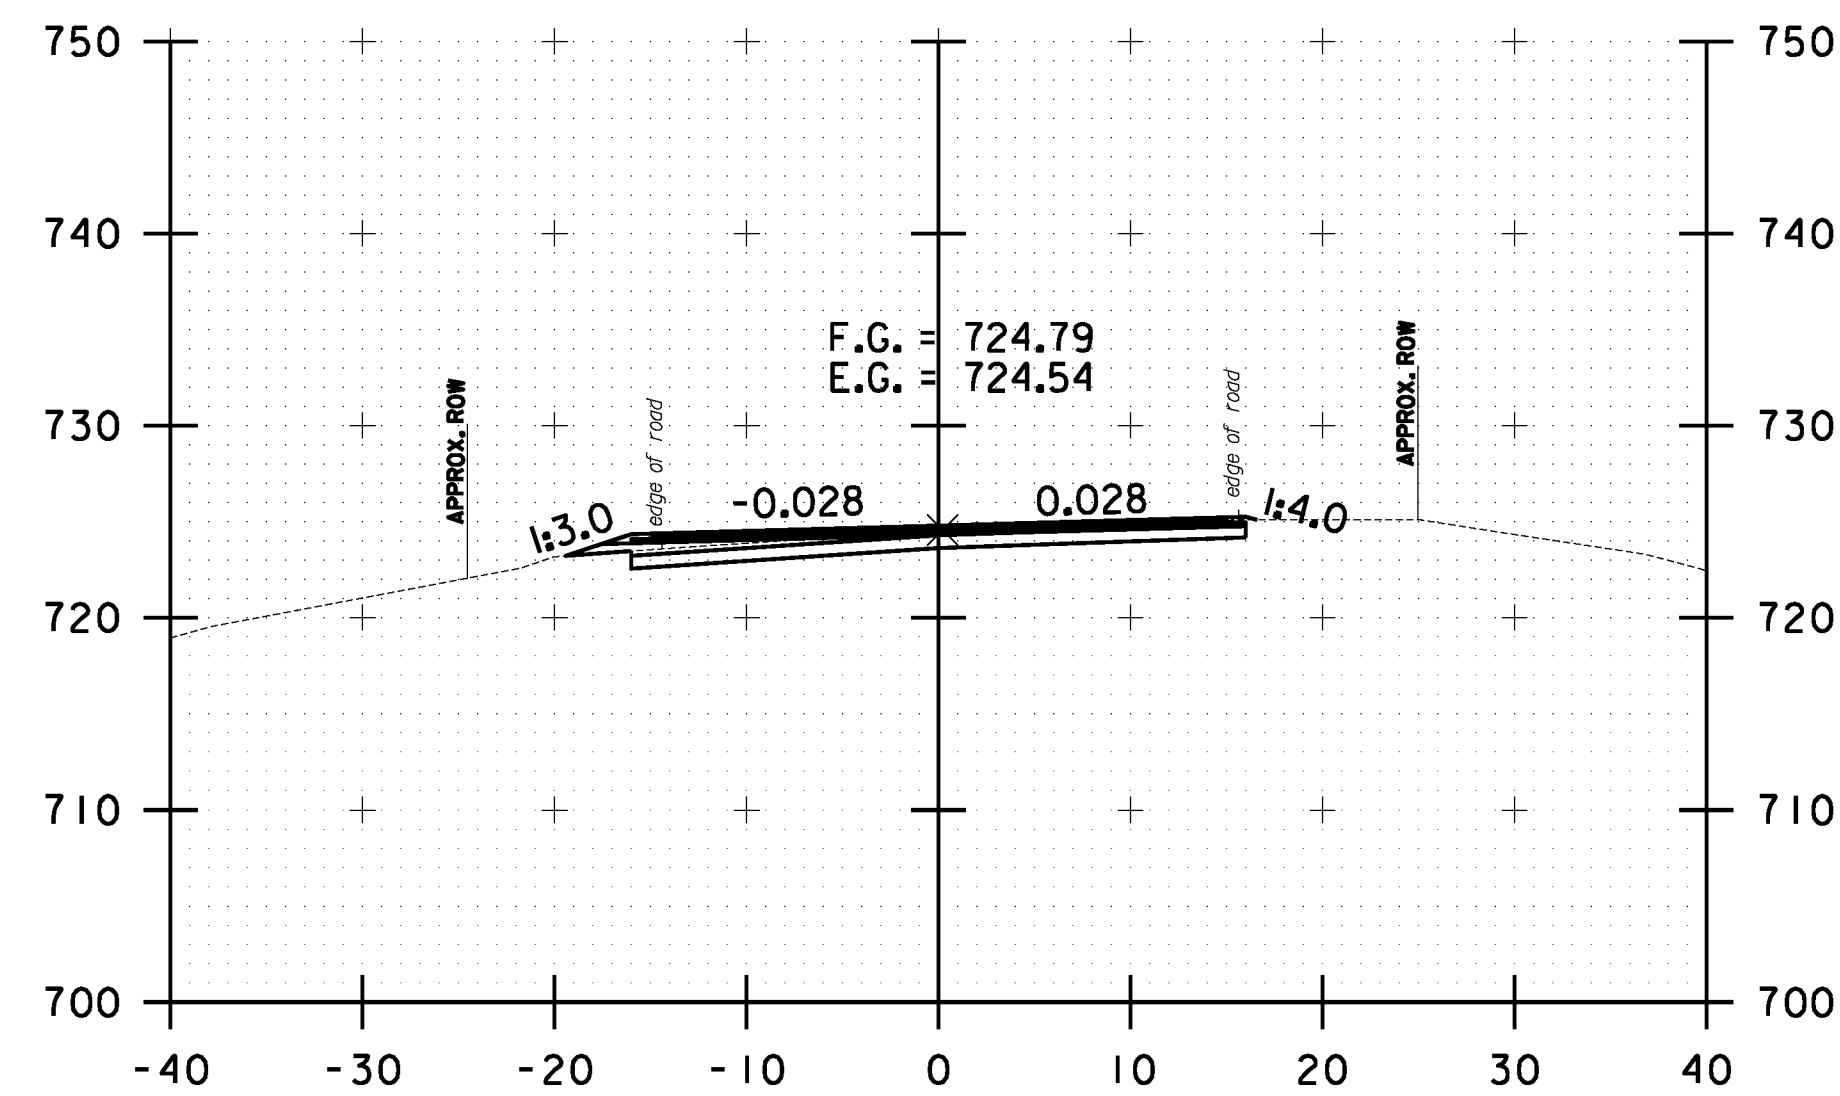

111+50.00

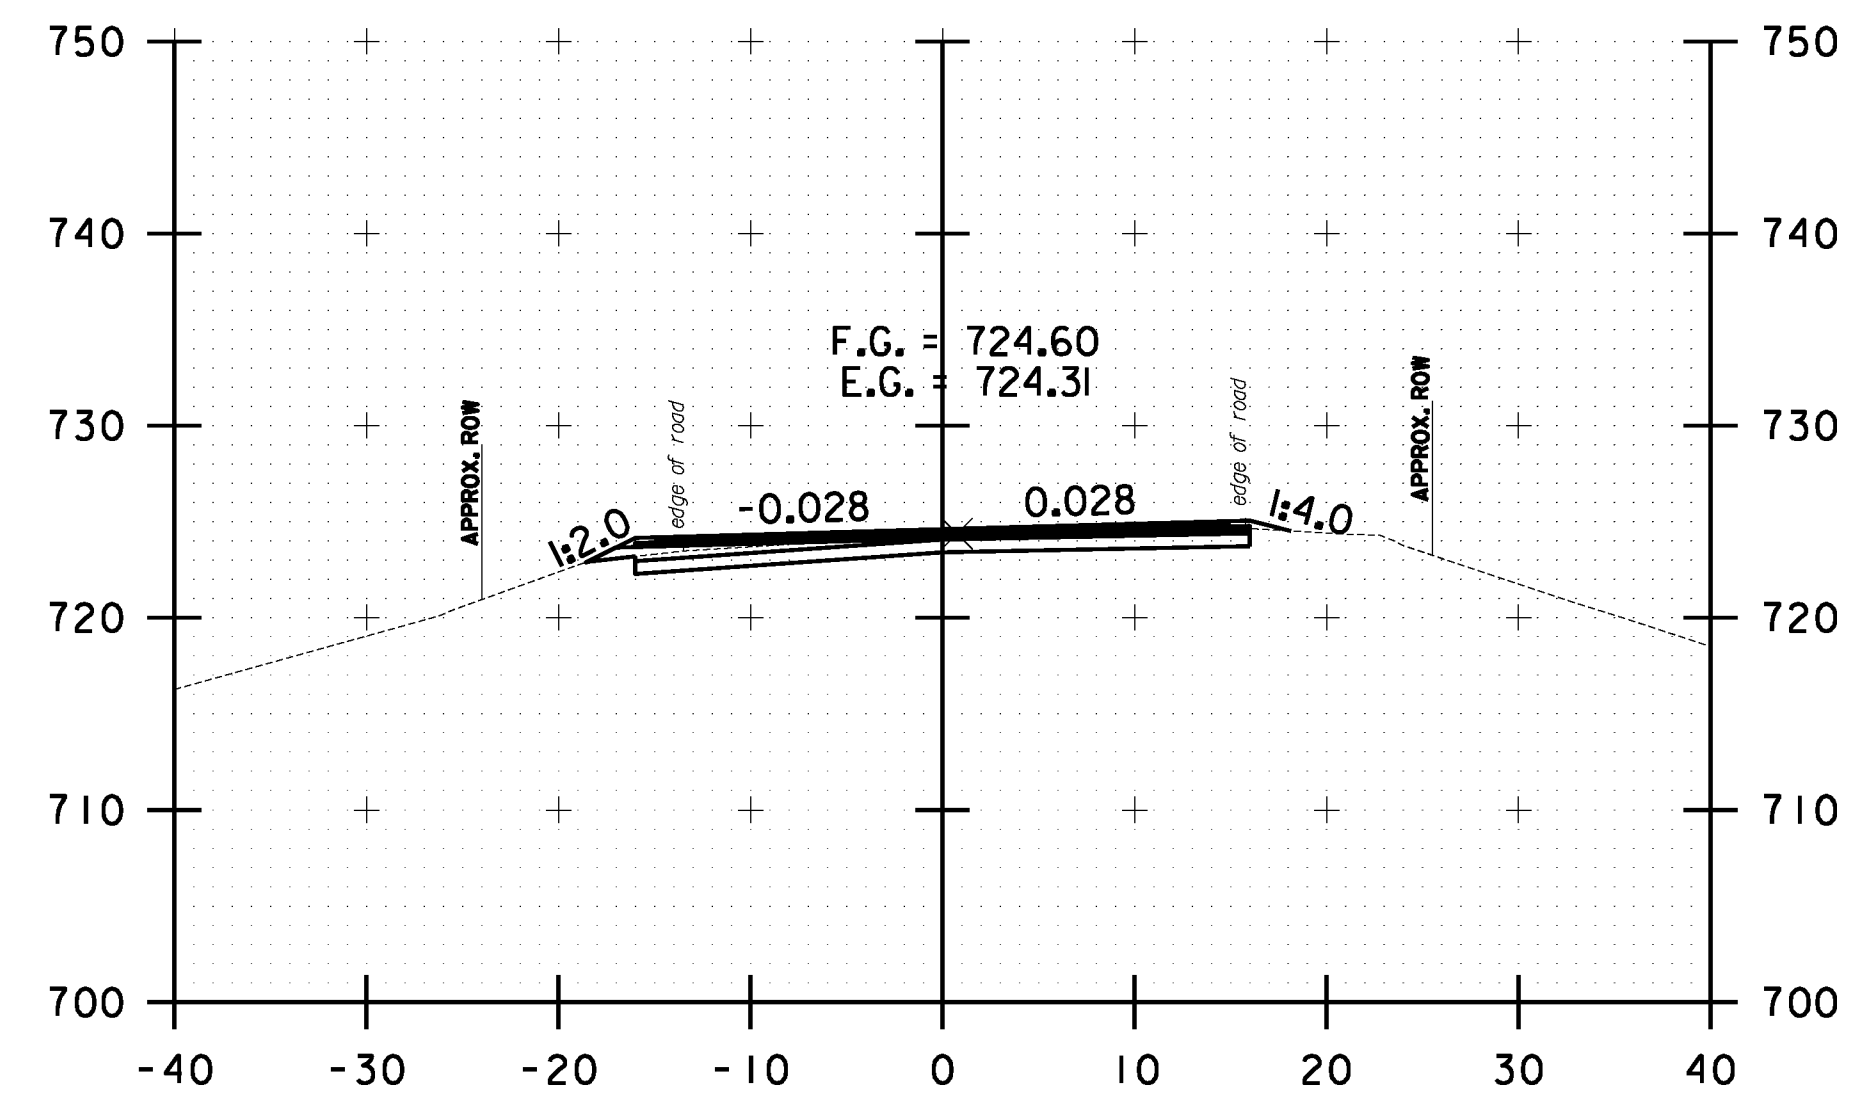

112+50.00

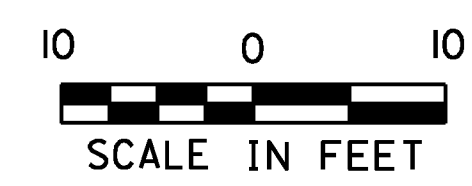

**WAITSFIELD
CROSS SECTION
SHEET #35**

PROJECT NAME: WARREN-WAITSFIELD

PROJECT NUMBER: STP 2506(II)

FILE NAME: p05b048.dgn

PROJECT LEADER: D.E.G.

DESIGNED BY: M.J.M.

IPARM FILE: p05b048xsl28.l

PLOT DATE: 12/20/2012

DRAWN BY: W.G.P.

CHECKED BY: D.E.G.

SHEET 29 OF 310