

INDEX OF SHEETS

1	TITLE SHEET
2-3	PROJECT TYPICAL SHEETS
4	ASPHALTIC PLUG JOINT DETAIL SHEET
5-6	QUANTITY SHEETS
7-8	ITEM DETAIL SUMMARY SHEETS
9	DITCH CLEANING DETAIL SHEET
10-29	PAVING PROJECT LAYOUT SHEETS
30-38	TRAFFIC SIGN SUMMARY SHEETS
39	BRIDGE DETAIL SHEET I
40	NON-YIELDING OBJECT APPROACH and SIGN DETAIL SHEET.
41	PAVEMENT MARKING DETAIL SHEET
42	CONSTRUCTION APPROACH SIGNING SHEET

VAOT STANDARDS

D-3	TREATED GUTTERS	06-01-94
D-8	REINFORCED CONCRETE DROP INLET WITH PRECAST COVER	01-03-00
D-15	REINFORCED CONCRETE DROP INLET WITH GRATE (BOTTOM SECTION)	
D-15	PRECAST REINFORCED CONCRETE CATCH BASIN W/CAST IRON GRATE	06-01-94
D-15	PRECAST REINFORCED CONCRETE MANHOLE W/CAST IRON COVER	
D-15	CAST IRON GRATE WITH FRAME, TYPE D	
D-15	CAST IRON GRATE WITH FRAME, TYPE E	
E-100	CONSTRUCTION APPROACH SIGNS	01-02-04
E-100A	SIDE ROAD CONSTRUCTION APPROACH SIGNS	01-02-04
E-101	CONSTRUCTION SIGN DETAILS	05-30-03
E-102	CONSTRUCTION SIGN DETAILS	06-30-03
E-102A	CONSTRUCTION SIGN DETAILS	05-01-04
E-103	MAINLINE TRAFFIC CONTROL DIVIDED HIGHWAY ONE LANE CLOSED	03-01-04
E-106	TRAFFIC CONTROL MISCELLANEOUS DETAILS	03-01-04
E-107	DELINEATION, BARRICADES AND DETOURS FOR CONSTRUCTION AREAS	06-30-03
E-107A	BREAKAWAY BARRICADE DETAILS	08-08-95
E-110	MAJOR MAINTENANCE OPERATION LANE CLOSURE	08-08-95
E-111	MINOR MAINTENANCE OPERATIONS	03-11-97
E-119	UTILITY WORK ZONE	03-01-04
E-120	STANDARD SIGN PLACEMENT EXPRESSWAY AND FREEWAY	08-08-95
E-121	STANDARD SIGN PLACEMENT CONVENTIONAL ROAD	08-08-95
E-140	REGULATORY SIGN DETAILS	08-30-96
E-141	REGULATORY SIGN DETAILS	09-20-95
E-143	REGULATORY SIGN DETAILS	06-15-04
E-144	REGULATORY SIGN DETAILS	03-29-99
E-145A	REGULATORY SIGN DETAILS, LANE USE CONTROL SIGNS	12-23-94
E-145B	REGULATORY SIGN DETAILS, LANE USE CONTROL SIGNS	12-23-94
E-150	WARNING SIGN DETAILS	05-01-04
E-152	WARNING SIGN DETAILS	05-01-04
E-153B	WARNING SIGN DETAILS	05-30-03
E-154	WARNING SIGN DETAILS	05-10-04
E-164	SQUARE STEEL SIGN POST	05-20-99
E-191	PAVEMENT MARKING DETAILS	02-01-99
E-193	PAVEMENT MARKING DETAILS	08-18-95
G-1	STEEL BEAM GUARDRAIL WITH STEEL POSTS	01-03-00
G-1	STEEL BEAM GUARDRAIL WITH WOOD POSTS	
G-10	STEEL BEAM GUARDRAIL APPROACH END TERMINAL	01-03-00
G-10	STEEL BEAM GUARDRAIL TRAILING END TERMINAL	
G-10	ANCHOR FOR STEEL BEAM GUARDRAIL	
G-10	STEEL BEAM MEDIAN BARRIER	
G-4	PLANK RAIL GUIDE POSTS	06-01-94
G-4	WOOD MARKER POSTS	
G-4	STEEL MARKER POSTS	
G-19	GENERIC PLANS FOR GUARDRAIL END TERMINALS	11-15-02

STATE OF VERMONT AGENCY OF TRANSPORTATION




PROPOSED IMPROVEMENTS TOWNS OF ST. GEORGE, SHELBURNE WILLISTON, and SOUTH BURLINGTON COUNTY OF CHITTENDEN VT ROUTE 116


BEGINNING AT STATION 0+00 (MM 0.000) OF VT ROUTE 116 IN THE TOWN OF ST. GEORGE AND EXTENDING NORTHERLY ALONG VT ROUTE 116 THROUGH THE TOWNS OF ST. GEORGE, SHELBURNE, WILLISTON, and INTO THE TOWN OF SOUTH BURLINGTON FOR A DISTANCE OF APPROXIMATELY 42,026 FEET (7.959 MILES) TO THE END OF THE PROJECT AT STATION 223+34 (M.M. 4.230) IN THE TOWN OF SOUTH BURLINGTON.

STATION TO STATION DATA		LENGTH	
		(FEET)	(MILES)
TOWN OF ST. GEORGE			
STA 0+00 TO STA 85+61		8,561	1.621
(MM 0.000 TO MM 1.621)			
TOWN OF SHELBURNE			
STA 0+00 TO STA 89+29		8,929	1.691
(MM 0.000 TO MM 1.691)			
TOWN OF WILLISTON			
STA 0+00 TO STA 22+02		2,202	0.417
(MM 0.000 TO MM 0.417)			
TOWN OF SOUTH BURLINGTON			
STA 0+00 TO STA 169+25		16,925	3.205
(MM 0.000 TO MM 3.205)			
STA 175+30 TO STA 223+34		4,804	0.909
(MM 3.320 TO MM 4.230)			
PROJECT TOTALS		41,421	7.844

WORK TO BE PERFORMED UNDER THIS PROJECT INCLUDES RESURFACING OF THE EXISTING HIGHWAY WITH COLD PLANING & OVERLAY SECTIONS (LEVELING AND WEARING COURSE), NEW PAVEMENT MARKINGS, GUARD RAIL INSTALLATION, DRAINAGE IMPROVEMENTS AND INCIDENTAL ITEMS.

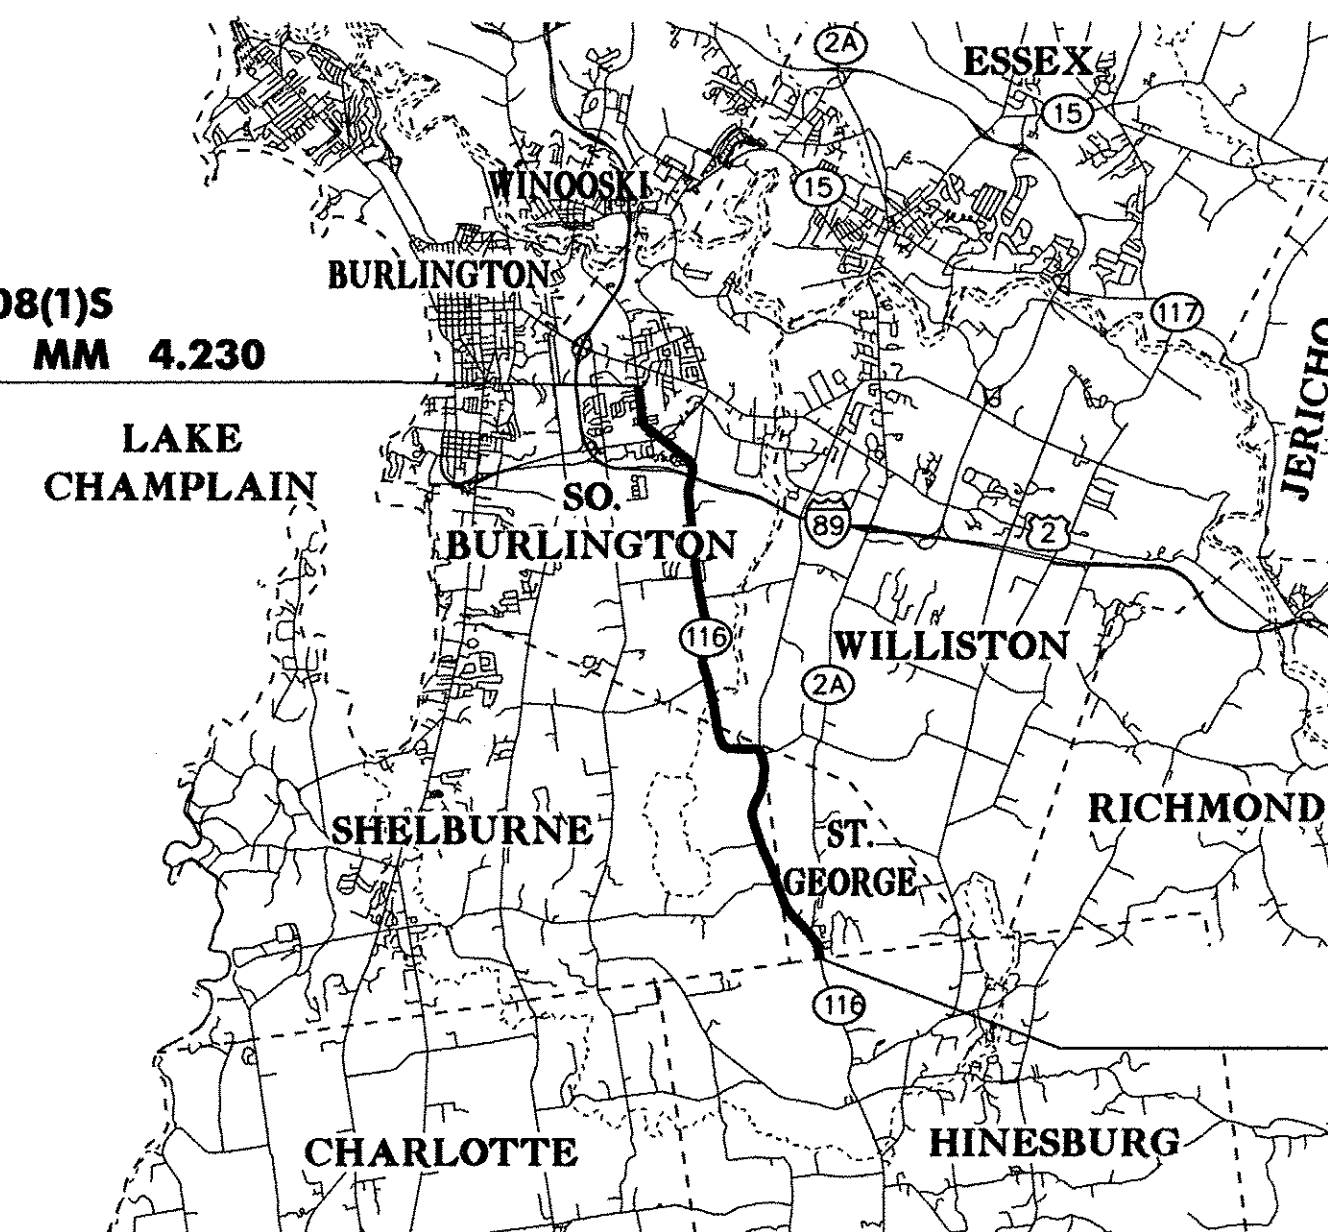

END ST-STP 2508(1)S
STA 223+34 = MM 4.230

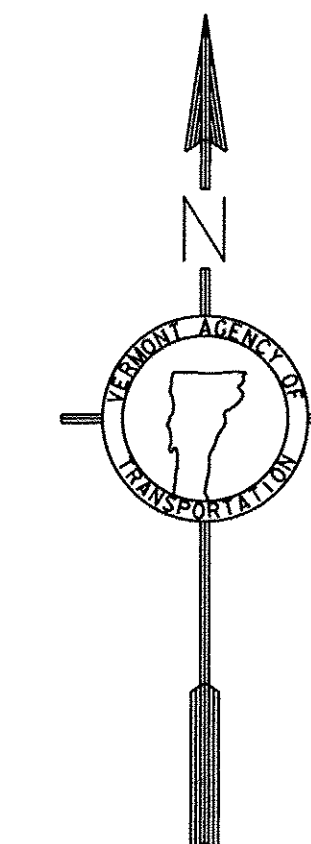


BEGIN ST-STP 2508(1)S
STA 0+00 = MM 0.000

PROJECT LOCATION ST-STP 2508(1)S

CONTRACTOR:	PIKE INDUSTRIES, INC. - BERLIN, VT
RESIDENT ENGINEER:	IAN JENIKE
CONSTRUCTION BEGAN:	AUGUST 26, 2008
CONSTRUCTION COMPLETE:	MAY 15, 2009
RECORD PLANS BY:	IAN JENIKE & AMOS KEMPTON
I HEREBY CERTIFY THAT ALL THE CONSTRUCTION REQUIRED BY THIS SET OF DRAWINGS HAS BEEN ACCOMPLISHED AS INDICATED HEREIN.	
BY	<i>[Signature]</i> FOR IAN JENIKE, RESIDENT ENGINEER
DATE	7-10-2012

NOTE: Any further information concerning final quantities, amounts or other details relative to this project may be found at Central Files in the electronic archives.

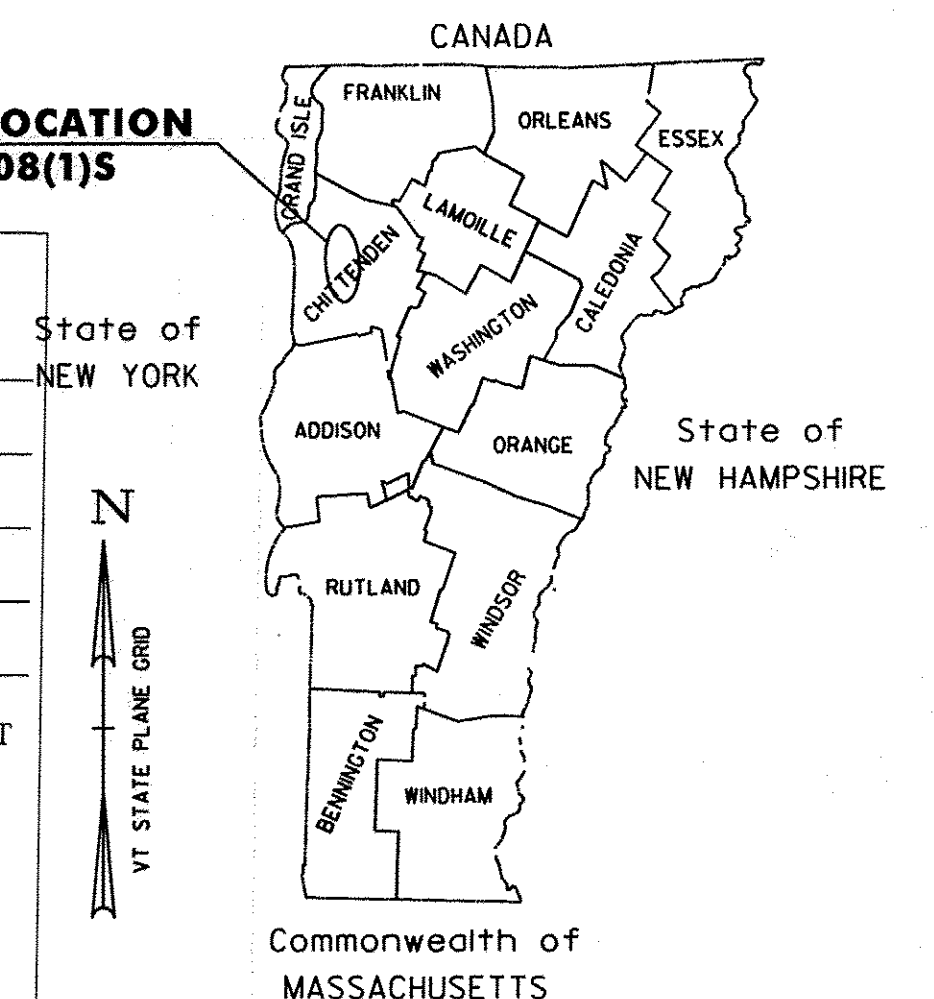

ST. GEORGE - SO. BURLINGTON VT ROUTE 116, MM 0.000 TO MM 4.230	
BITUMINOUS CONCRETE PAVEMENT SUPERPAVE MIXTURE DESIGN CRITERIA	
DESIGN LANE/DESIGN LIFE ESAL	1,051,000
DESIGN NUMBER OF GYRATIONS	65
PERFORMANCE GRADED ASPHALT BINDER	PG 58-28

TRAFFIC DATA

	ADT		DHV		FLEXIBLE ESAL'S	
	2007	2017	2007	2017	(2007-2017)	(2007-2017)
BEGINNING OF PROJECT TO CHEESE FACTORY RD (SO. BURL. MM 0.240)	6,300	6,700	700	750	577,000	1,358,000
CHEESE FACTORY RD. TO KENNEDY DR. (SO. BURL. MM 3.27)	8,100	8,500	890	930	842,000	1,940,000
KENNEDY DR. TO WRIGHT COURT (SO. BURL. MM 3.73)	9,700	10,300	1,050	1,110	819,000	1,901,000
WRIGHT COURT TO END OF PROJECT	10,800	11,400	1,160	1,230	908,000	2,102,000

THESE PLANS ARE SUBJECT TO SUCH ENGINEERING CHANGES AS MAY BE REQUIRED BY THE FEDERAL HIGHWAY ADMINISTRATION OR THE DIRECTOR OF PROGRAM DEVELOPMENT.

CONSTRUCTION IS TO BE CARRIED ON IN ACCORDANCE WITH THESE PLANS AND THE STANDARD SPECIFICATIONS FOR CONSTRUCTION DATED 2006, AS APPROVED BY THE FEDERAL HIGHWAY ADMINISTRATION ON JUNE 15, 2006 FOR USE ON THIS PROJECT, INCLUDING ALL SUBSEQUENT REVISIONS AND SUCH REVISED SPECIFICATIONS AND SPECIAL PROVISIONS AS ARE INCORPORATED IN THESE PLANS.

DIRECTOR OF PROGRAM DEVELOPMENT	
APPROVED <i>[Signature]</i> DATE 6-20-08	
PROJECT MANAGER : TED DOMEY	
PROJECT NAME : ST. GEORGE-SO. BURLINGTON	
PROJECT NUMBER : ST-STP 2508(1)S	
SHEET 1 OF 42 SHEETS	

CONVENTIONAL SIGNS

COUNTY LINE	---
TOWN LINE	---
LIMITS OF ACCESS	---o---
POINT OF ACCESS	X
FENCE LINE	---x---
STONE WALL	---o---
TRAVELED WAY	---o---
GUARD RAIL	---o---
RAILROAD	---o---
SURVEY LINE	---o---
CULVERT	---o---
POWER POLE	---o---
TELEPHONE POLE	---o---
TREES	---o---
CONTROL OF ACCESS	---o---
PROPERTY LINE	---o---
R.O.W. TAKING LINE	---o---
SLOPE RIGHTS	---o---
TOP OF CUT	---o---
TOE OF SLOPE	---o---

RIGHT-OF-WAY LIMITS, IF APPLICABLE, ARE PROVIDED SOLELY FOR THE CONVENIENCE OF THE STATE AND ITS CONTRACTOR DURING THE COURSE OF THIS PAVING PROJECT. ANY REFERENCES TO OFFSETS ON THESE PLANS ARE APPROXIMATE AND SHOULD NOT BE RELIED UPON FOR ANY OTHER PURPOSES.

UNLESS OTHERWISE NOTED, ALL DRAWINGS AND DETAILS ON THESE PLANS ARE DRAWN 'NOT TO SCALE'.

DATUM
VERTICAL N/A
HORIZONTAL N/A

BY:



CIVIL ENGINEERING ASSOCIATES, INC.
P.O. BOX 488 SHELBURNE, VT 05482
802-985-2323 FAX: 802-985-2271 web: www.cca-vt.com

NOTES

1. THE PAVEMENT WEARING COURSE SHALL BE TYPE IVS.

THE LEVELING COURSE SHALL BE TYPE IVS UNLESS OTHERWISE SHOWN IN THE PLANS OR DIRECTED BY THE RESIDENT ENGINEER. LEVELING HAS BEEN INCLUDED TO RESHAPE THE ROADWAY PRIOR TO PAVING THE TOP COURSE ALONG THE OVERLAY AND COLD PLANE TYPICAL SECTIONS. AN ESTIMATED THICKNESS OF 1/2in. OF ITEM 490.30 HAS BEEN INCLUDED TO COVER THIS PROVISION.

ALL ASPHALT CEMENT USED IN THE BITUMINOUS CONCRETE PAVEMENT SHALL BE PG 58-28.

2. EMULSIFIED ASPHALT, RS-1, SHALL BE APPLIED ON EXISTING PAVEMENT SURFACES, BETWEEN ALL COURSES OF PAVEMENT AND ON COLD PLANED SURFACES AT THE RATE OF 0.025 GAL/SY OR AS DIRECTED BY THE RESIDENT ENGINEER.

3. BITUMINOUS CONCRETE PAVEMENT TOLERANCE = +/- 1/4in (TOTAL THICKNESS EXCLUDING LEVELING).

4. EXISTING SHOULDER MATERIAL DEEMED UNSUITABLE BY THE RESIDENT ENGINEER WILL BE EXCAVATED TO A DEPTH OF 3 in +/- OR AS DIRECTED BY THE RESIDENT ENGINEER. EXCAVATED MATERIAL WILL BE SPREAD ON THE ADJACENT SLOPES OR REMOVED FROM THE PROJECT, AS DIRECTED BY THE RESIDENT ENGINEER. THIS WORK WILL BE PAID FOR USING THE APPROPRIATE RENTAL ITEMS SUCH AS ALL PURPOSE EXCAVATOR RENTAL, GRADER RENTAL, LOADER RENTAL, TRUCK RENTAL, AND POWER BROOM RENTAL. THE METHOD OF REMOVAL AND THE USE OF RENTAL ITEMS SHALL BE APPROVED BY THE RESIDENT ENGINEER PRIOR TO ANY WORK BEING DONE. MATERIAL REMOVED SHALL BE REPLACED WITH SUBBASE OF CRUSHED GRAVEL, FINE GRADED OR AGGREGATE SHOULDERS, RAP.

5. THE PROPOSED GUARDRAIL SHALL BE INSTALLED A MINIMUM OF 16 FEET FROM THE CENTER OF THE ROAD, OR A DISTANCE THAT MAXIMIZES THE DISTANCE FROM THE CENTER OF THE ROAD TO THE FACE OF GUARDRAIL. THREE FEET OF BACKING IS REQUIRED BEHIND THE FACE OF GUARD RAIL WITH 6 ft POSTS. IF THIS CANNOT BE OBTAINED THEN 8ft POSTS SHALL BE USED. ALL GUARDRAIL SHALL BE STEEL BEAM WITH STEEL POSTS AND WOOD BLOCKOUTS (OR APPROVED ALTERNATIVE MATERIAL). NEW GUARDRAIL SHALL BE INSTALLED IN COMPLIANCE WITH STANDARD G-1.

6. COLD PLANING TO BE COMPLETED ACCORDING TO THE TYPICAL OR AS NOTED OTHERWISE ON THE PLANS. A FULL DEPTH BUTT JOINT SHALL BE CONSTRUCTED AT THE PROJECT BEGIN/END AND AT ALL SIDE ROAD APPROACHES AS DENOTED ON THE PROJECT PLANS OR AS OTHERWISE DIRECTED BY THE RESIDENT ENGINEER.

7. ITEMS 604.40 & 604.42 ARE ESTIMATED QUANTITIES AND SHALL BE PERFORMED AT LOCATIONS INDICATED ON THE LAYOUT SHEETS AND AS DIRECTED BY THE RESIDENT ENGINEER. ALL D.I.'S SHALL BE RAISED OR REHABILITATED SUCH THAT THE NEW GRATE ELEVATION IS LEVEL WITH THE SURROUNDING TERRAIN.


8. ALL EDGES OF PAVEMENT SHALL BE BACKED UP FULL HEIGHT WITH COLD PLANE GRINDINGS AS DIRECTED BY THE RESIDENT ENGINEER AND WILL BE PAID FOR UNDER ITEM 402.J3, AGGREGATE SHOULDERS, RAP. ADDITIONAL MATERIAL REQUIRED AFTER THE COLD PLANE GRINDINGS ARE USED WILL BE PAID FOR UNDER ITEM 402.I2, AGGREGATE SHOULDERS.

9. ALL DRIVES SHALL RECEIVE A PAVED APRON, OR BE PAVED FROM EDGE OF ROADWAY TO SIDEWALK, AS DIRECTED BY THE RESIDENT ENGINEER. ANY AND ALL REQUIRED EXCAVATION IN DRIVE AREAS SHALL BE AS DIRECTED, AND WILL BE PAID FOR UNDER ITEM 210.I0 OR THE APPLICABLE RENTAL ITEM(S). IF REQUIRED, A NEW DRIVEWAY SUBBASE SHALL BE CONSTRUCTED AND WILL BE PAID FOR UNDER ITEM 301.28, SUBBASE OF CRUSHED GRAVEL, FINE GRADED. A NEW BITUMINOUS SURFACE SHALL BE CONSTRUCTED AS DIRECTED AND WILL BE PAID FOR UNDER ITEM 490.30. ESTIMATED QUANTITIES OF THE ABOVE ITEMS HAVE BEEN INCLUDED TO PAY FOR THIS WORK.

10. EXCAVATED DITCHING MATERIAL SHALL BE USED FOR CONSTRUCTING GUARD RAIL END SECTIONS, UNLESS OTHERWISE DIRECTED BY THE RESIDENT ENGINEER. PAYMENT FOR DITCHING MATERIAL WILL BE MADE UNDER ALL PURPOSE EXCAVATOR RENTAL, TYPE I. THE QUANTITY REFLECTS 2 HOURS OF EXCAVATOR RENTAL FOR EACH GUARD RAIL TERMINAL.


11. ITEM 616.47, BITUMINOUS CONCRETE GUTTERS AND TRAFFIC ISLANDS WILL BE PAID ONLY WHERE SPECIFIED IN THE PLANS. ALL OTHER BITUMINOUS CONCRETE PAVEMENT WORK, WHICH COULD INVOLVE SOME HAND-WORK (SUCH AS DRIVE AND SIDEROAD APPROACHES AND AROUND DRAINAGE/UTILITY STRUCTURES), SHALL BE PAID FOR AT THE CONTRACT UNIT PRICE FOR ITEM 490.30, SUPERPAVE BITUMINOUS CONCRETE PAVEMENT (PG 58-28).

12. COMPACTION, GRADING, AND CLEAN UP OF ITEM 301.28, SUBBASE OF CRUSHED GRAVEL, ITEM 402.I2, AGGREGATE SHOULDERS, AND ITEM 651.35, TOPSOIL, IS TO BE INCLUDED IN THE CONTRACT PRICE OF EACH ITEM.

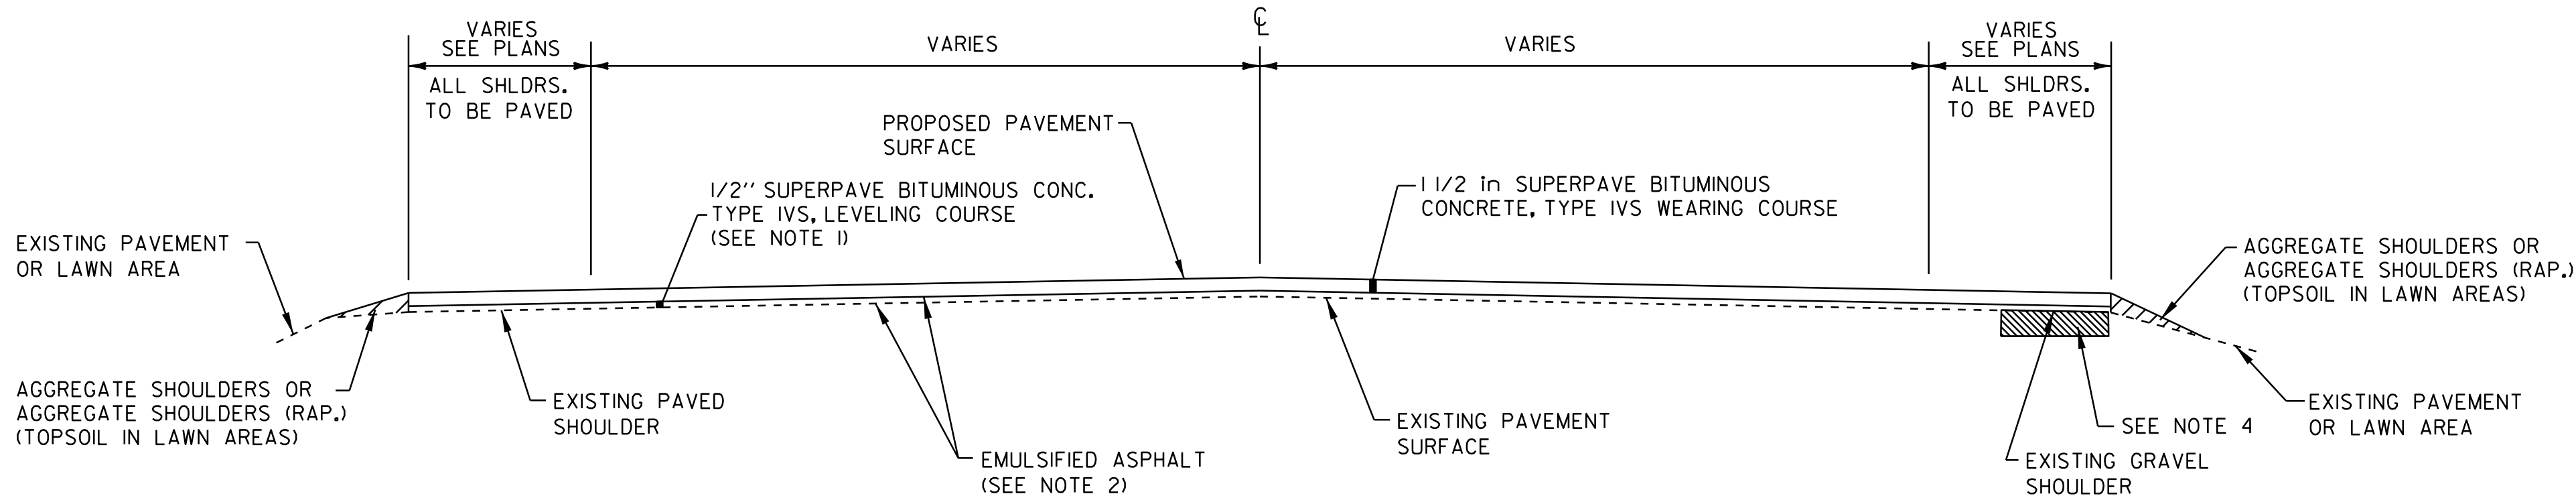

OVERLAY TYPICAL SECTION

ST. GEORGE
STA 0+000 TO 85+61
SHELBURNE
STA 0+00 TO 89+29
WILLISTON
STA 0+00 TO 22+02
SOUTH BURLINGTON
STA 0+00 TO 169+25
STA 175+30 TO 197+75

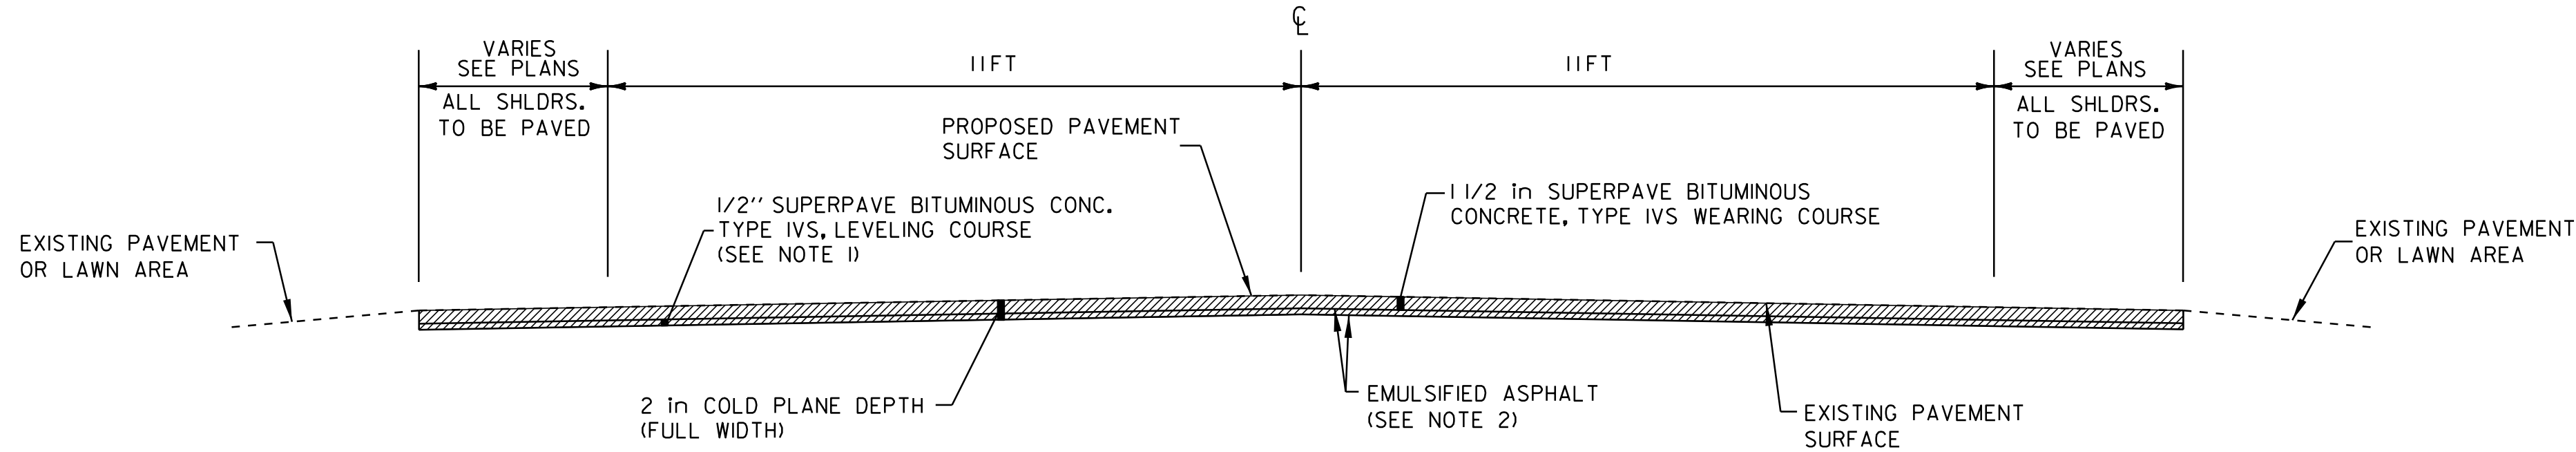

COLD PLANED TYPICAL SECTION


SOUTH BURLINGTON
STA 197+75 TO 223+34

PROJECT PAVING LIMITS

TOWN & ROUTE	BEGIN STATION	END STATION	LANE TYPICAL (IN FEET)	WEARING DEPTH	LEVELING Tons	NOTES
ST. GEORGE- VT ROUTE 116	0+00	85+61	4-11-11-4	1-1/2 in	793	1/2" LEVEL, PAVE W/1-1/2" TYPE IVS
SHELBURNE - VT ROUTE 116	0+00	89+29	4-11-11-4	1-1/2 in	827	1/2" LEVEL, PAVE W/1-1/2" TYPE IVS
WILLISTON - VT ROUTE 116	0+00	21+94	4-11-11-4	1-1/2 in	204	1/2" LEVEL, PAVE W/1-1/2" TYPE IVS
WILLISTON S. BURL.- VT ROUTE 116	21+94	0+08	4-11-11-4	1-1/4 in	--	BR. 30 COLD PLANE 1-1/4", PAVE W/1-1/4" TYPE IVS
SO. BURLINGTON - VT ROUTE 116	0+08	4+50	4-11-11-4	1-1/2 in	42	1/2" LEVEL, PAVE W/1-1/2" TYPE IVS
SO. BURLINGTON - VT ROUTE 116	4+50	25+75	9-12-12-9	1-1/2 in	262	1/2" LEVEL, PAVE W/1-1/2" TYPE IVS
SO. BURLINGTON - VT ROUTE 116	25+75	43+75	4-11-11-4	1-1/2 in	167	1/2" LEVEL, PAVE W/1-1/2" TYPE IVS
SO. BURLINGTON - VT ROUTE 116	43+75	56+00	8-12-12-8	1-1/2 in	151	1/2" LEVEL, PAVE W/1-1/2" TYPE IVS
SO. BURLINGTON - VT ROUTE 116	56+00	124+50	4-11-11-4	1-1/2 in	634	1/2" LEVEL, PAVE W/1-1/2" TYPE IVS
SO. BURLINGTON - VT ROUTE 116	124+50	138+74	5-11-11-5	1-1/2 in	140	1/2" LEVEL, PAVE W/1-1/2" TYPE IVS
SO. BURLINGTON - VT ROUTE 116	138+74	141+34	5-11-11-5	1-1/4 in	--	BR 31 COLD PLANE 1-1/4", PAVE W/1-1/4" TYPE IVS
SO. BURLINGTON - VT ROUTE 116	141+34	147+00	5-11-11-5	1-1/2 in	56	1/2" LEVEL, PAVE W/1-1/2" TYPE IVS
SO. BURLINGTON - VT ROUTE 116	147+00	151+00	8-12-12-8	1-1/2 in	49	1/2" LEVEL, PAVE W/1-1/2" TYPE IVS
SO. BURLINGTON - VT ROUTE 116	151+00	169+25	5-11-11-5	1-1/2 in	180	1/2" LEVEL, PAVE W/1-1/2" TYPE IVS
SO. BURLINGTON - VT ROUTE 116	169+25	175+30	NO WORK--KENNEDY DRIVE			
SO. BURLINGTON - VT ROUTE 116	175+30	197+75	4-11-11-4	1-1/2 in	208	1/2" LEVEL, PAVE W/1-1/2" TYPE IVS
SO. BURLINGTON - VT ROUTE 116	197+75	223+34	VARIES	1-1/2 in	237	COLD PLANE 2 in, LEVEL 1/2" TYPE IVS, WEARING COURSE 1-1/2 in TYPE IVS


PROJECT
TYPICAL
SHEET #1

DESIGNED BY	BCE/PJM	DATE	10-06
DRAWN BY	C.E.A., INC.	DATE	10-06
DESIGN FILE NO.	p05b052.dgn		
PRF FILE	p05b052+y01.i	DATE PLOTTED	03-MAY-2012
PROJ. NAME	ST. GEORGE-SO. BURLINGTON		
PROJ. NO.	ST-STP 2508(1)S		
SHEET	2	OF	42 SHEETS

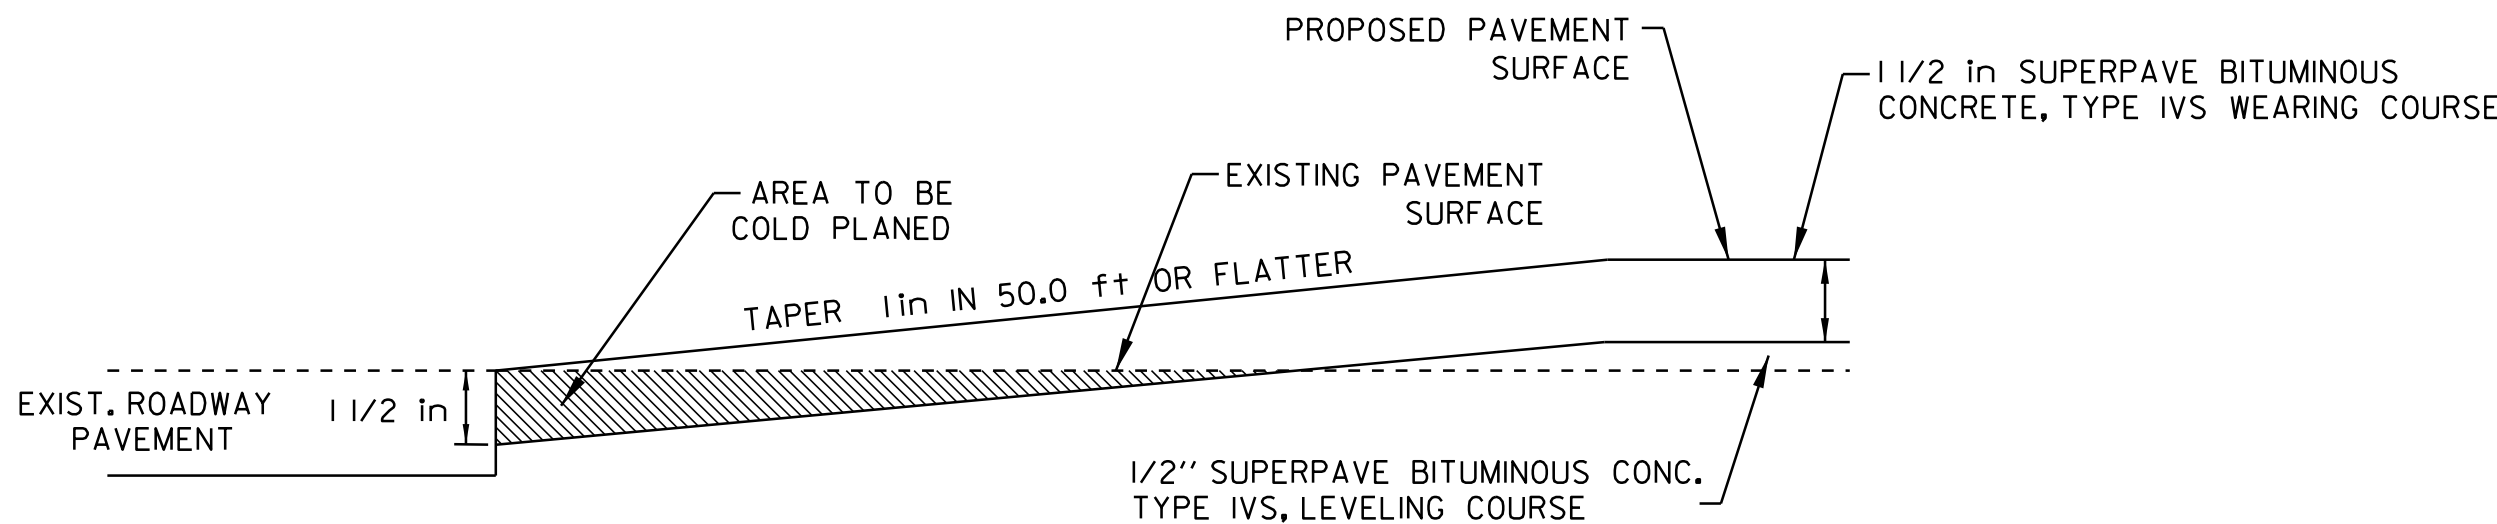


- APPROACH AREA DETAIL -

ST. GEORGE
STA 0+00 TO 100+00 (BEGIN PROJECT)

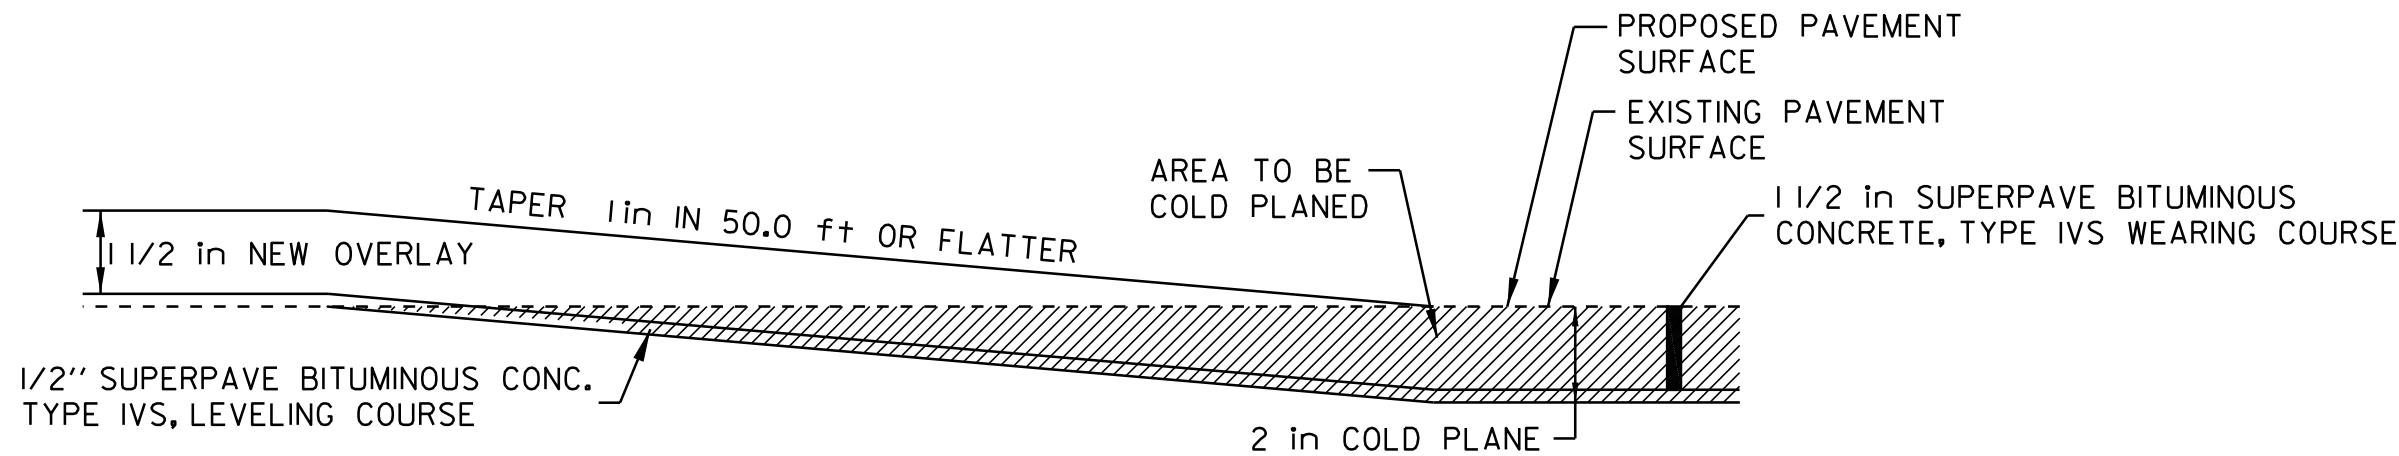

- TRANSITION AREA DETAIL -


SOUTH BURLINGTON
STA 196+75 TO 197+75 (END OVERLAY/BEGIN COLD PLANE)

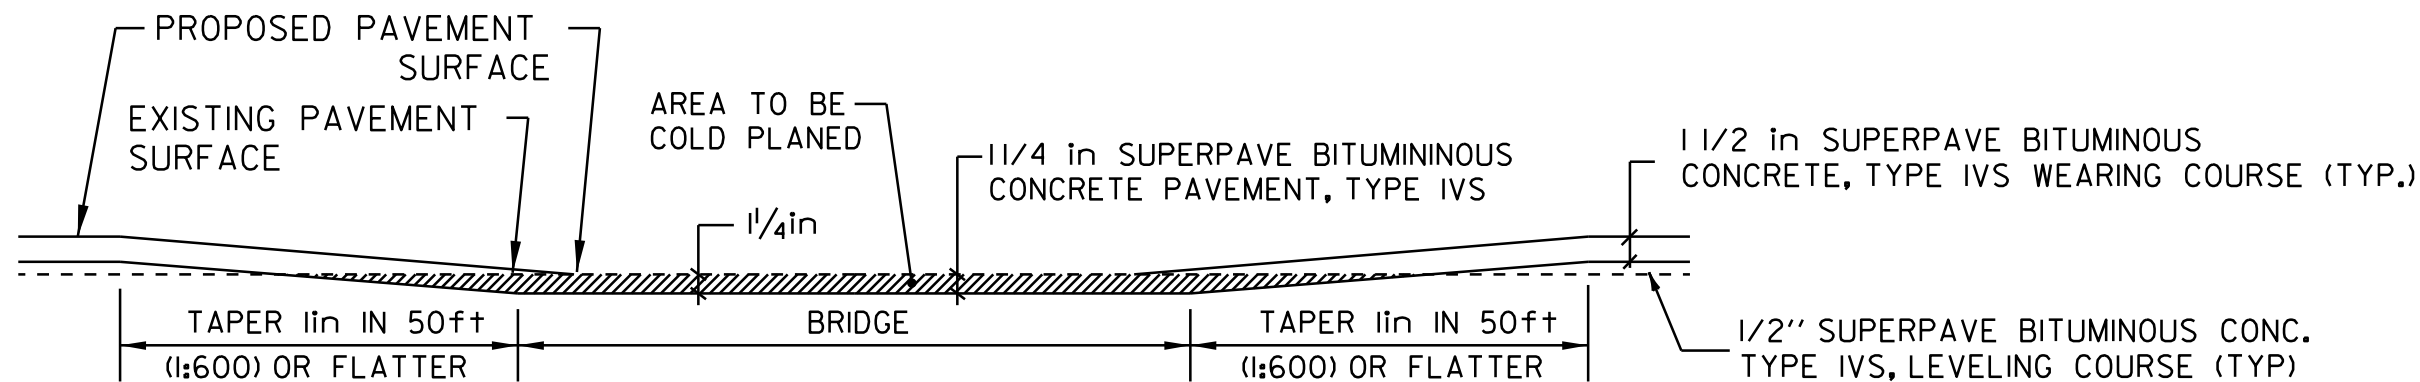

- COLD PLANING DETAIL BRIDGES -

WILLISTON
BRIDGE #30 - STA 22+02

SOUTH BURLINGTON
BRIDGE #31 - STA 139+83

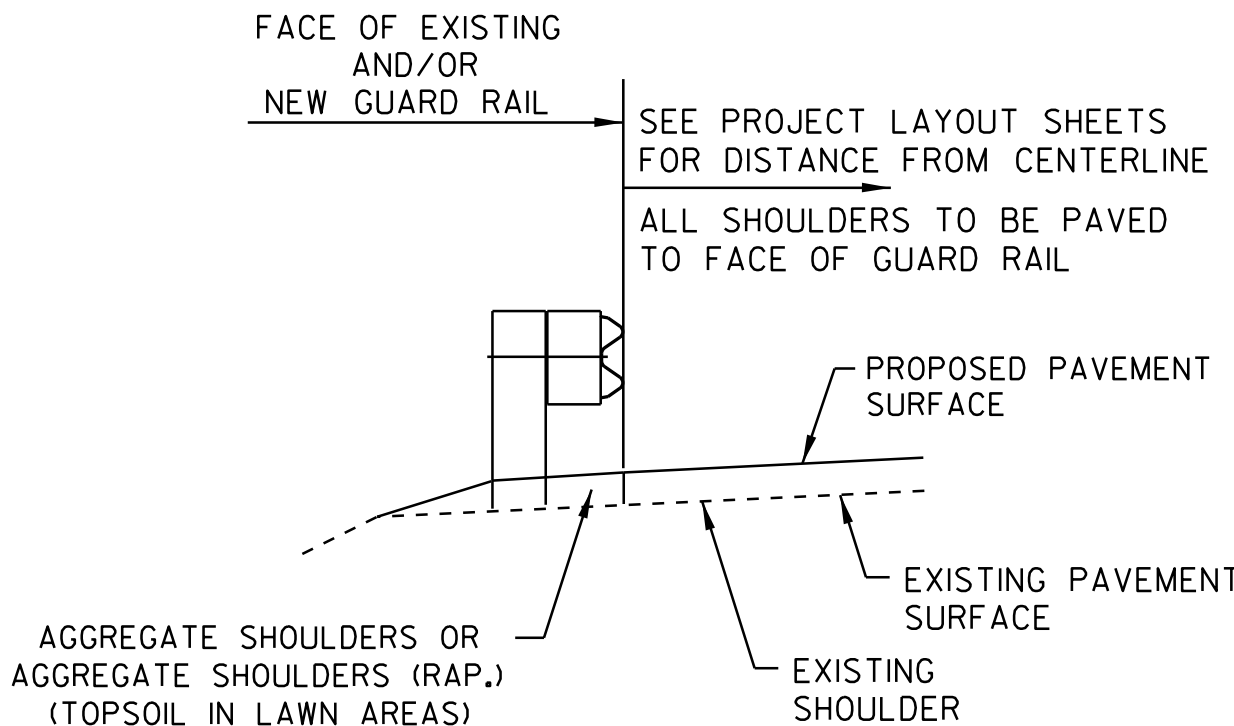

- TYPICAL SECTION AT GUARD RAIL -

CONSERVATION SEED MIX

RURAL AREA - SEED MIXTURE

% WT.	lbs./ACRE	NAME	PUR%	GERM%
37.5	22.5	CREEPING RED FESCUE	98	85
37.5	22.5	TALL FESCUE	95	90
5.0	3	RED TOP	95	90
15.0	9	BIRDSFOOT TREFOIL	98	85
5.0	3	ANNUAL RYEGRASS	95	85
100.0	60			

SEED MIXTURE:
SHALL NOT HAVE A WEED CONTENT EXCEEDING 0.40% BY WEIGHT
AND SHALL BE FREE OF ALL NOXIOUS SEED.

SEED:
TO BE APPLIED PER SEEDING FORMULAS OR AS DIRECTED BY THE
ENGINEER.

FERTILIZER:
FORMULA 10-20-10, TO BE USED WITH SEED , APPLIED AT THE
RATE OF 500 lbs/ACRE. (HYDRO SEEDERS MAY USE 19-19-19
FORMULA)

AGRICULTURAL LIMESTONE:
TO BE APPLIED AT THE RATE OF 2.0 TONS/ACRE, OR AS DIRECTED
BY THE ENGINEER.

HAY MULCH:
TO BE PLACED ON EARTH SLOPES AT THE RATE OF 2.0 TONS/ACRE,
OR AS DIRECTED BY THE ENGINEER.

TOPSOIL:
TO BE USED AS INDICATED ON THE PLANS, OR AS DIRECTED BY
THE ENGINEER.

PROJECT
TYPICAL
SHEET #2

DESIGNED BY BCE/PJM DATE 8-06

DRAWN BY C.E.A., INC. DATE 8-06


DESIGN FILE NO. p05b052.dgn

PRF FILE p05b052ty02.i DATE PLOTTED 03-MAY-2012 17

PROJ. NAME ST. GEORGE-SO. BURLINGTON

PROJ. NO. ST-STP 2508(1)S

SHEET 3 OF 42 SHEETS

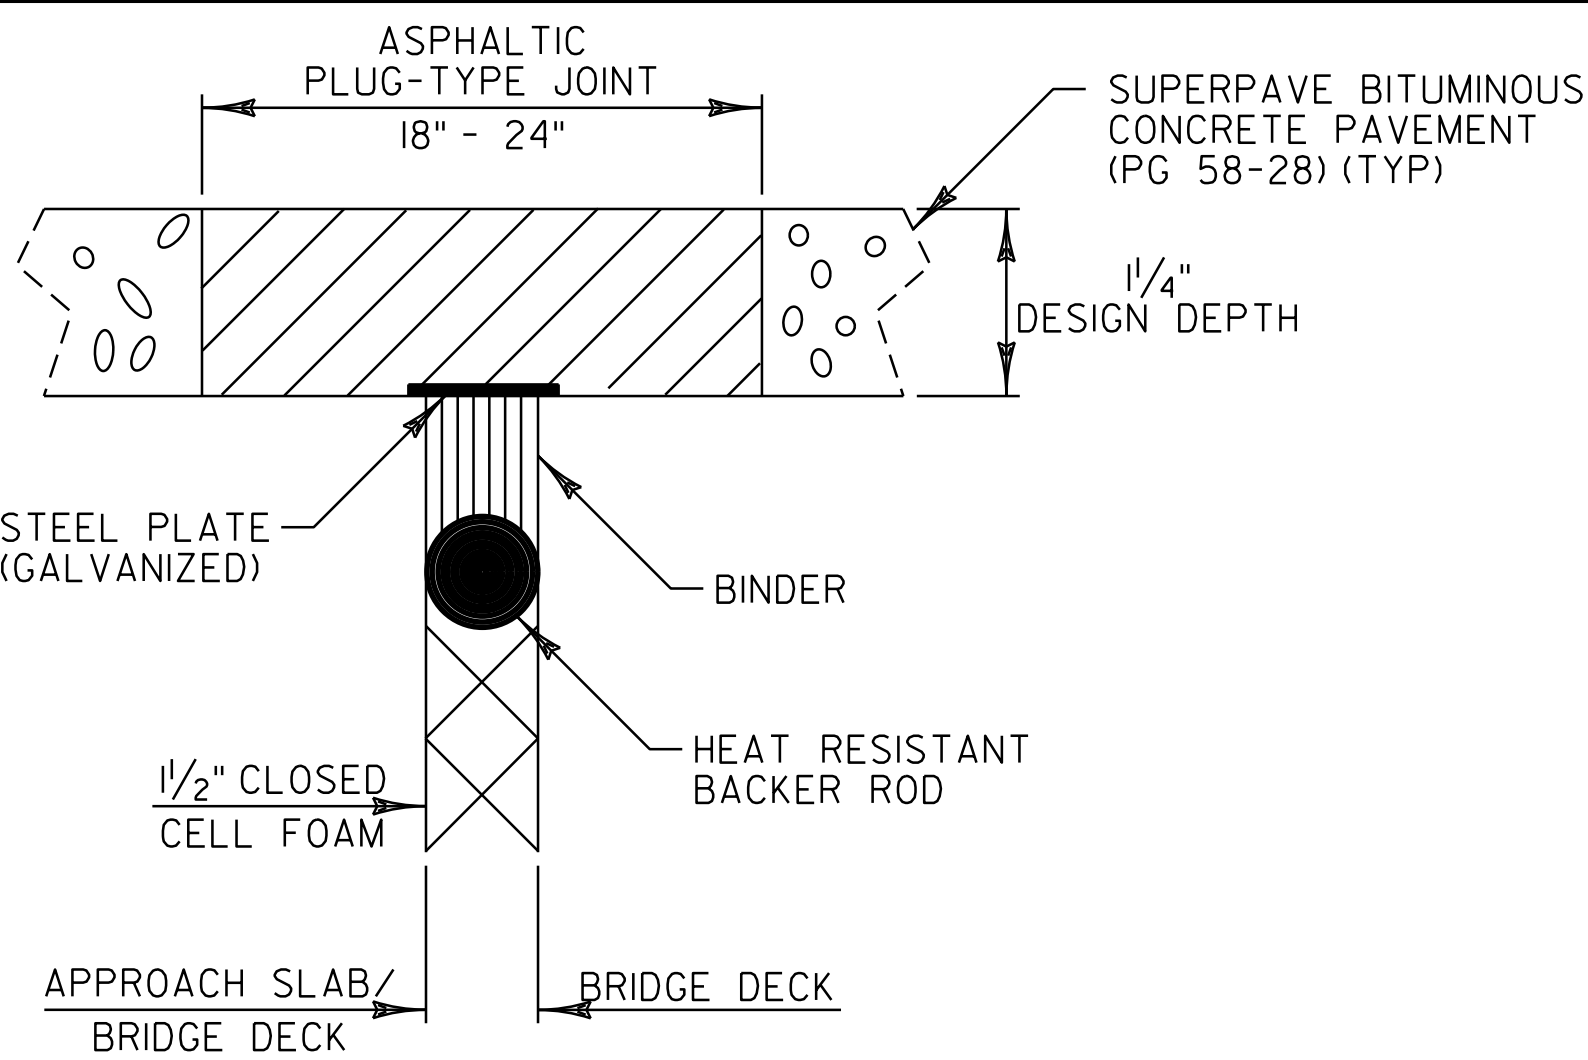

ASPHALTIC PLUG-TYPE JOINT DETAIL

LOCATION


SOUTH BURLINGTON
BRIDGE 31 STA 138+74 32 LF
BRIDGE 31 STA 139+38 32 LF
BRIDGE 31 STA 140+02 32 LF
BRIDGE 31 STA 140+66 32 LF
BRIDGE 31 STA 141+30 32 LF

NOTES:

1. THE JOINT SHALL BE LOCATED CENTRALLY OVER THE DECK EXPANSION GAP OR FIXED JOINT MARKED OUT TO THE MANUFACTURER'S RECOMMENDED WIDTH.
2. THE JOINT SHALL BE EXCAVATED AS SHOWN ON THE PLANS BY USE OF SAWS AND PNEUMATIC HAMMER OR A HAMMER AND CHISEL.
3. THE JOINT AREA SHALL BE BLAST CLEANED OF DEBRIS AND ASPHALT. THE JOINT AREA SHALL BE THOROUGHLY DRIED USING HOT COMPRESSED AIR PRIOR TO APPLYING BINDER MATERIAL.
4. SPALLED AND DEFECTIVE CONCRETE SHALL BE REPAIRED WITH AN APPROVED MATERIAL AS AGREED UPON BY THE RESIDENT ENGINEER.
5. PROPERLY SIZED HEAT RESISTANT BACKER ROD SHALL BE PLACED IN THE MOVEMENT GAP ALLOWING FOR 1 INCH +/- OF BINDER ABOVE THE ROD.
6. THE BINDER MATERIAL SHALL BE HEATED AND PLACED AS RECOMMENDED BY THE MANUFACTURER.
7. PLACE 1/4 INCH THICK BY 8 INCH WIDE SECTIONS OF STEEL PLATE OVER THE CENTER OF THE MOVEMENT GAP. SECURE PLATES FROM MOVING BY INSERTING LOCATING PINS THROUGH THE PRESTAMPED HOLES INTO BACKER ROD AND COVER WITH HOT BINDER.
 - A. THE STEEL PLATES MAY BE OMITTED WHERE THE APPROACH SLAB IS COVERED WITH A STONE BASE OR BITUMINOUS PAVEMENT AND VERTICAL MOVEMENT OF THE PLATES MIGHT OCCUR.
8. THE BINDER MATERIAL AND AGGREGATE SHALL BE HEATED AND MIXED AS RECOMMENDED BY THE MANUFACTURER.
9. THE INSTALLATION OF MATERIAL, COMPACTION, AND TOPCOATING SHALL BE AS RECOMMENDED BY THE MANUFACTURER.
10. IMMEDIATELY AFTER TOPCOATING, AN ANTI-SKID MATERIAL SHALL BE CAST OVER THE JOINT TO REDUCE THE RISK OF TRACKING.
11. JOINT SHALL BE PROTECTED FROM TRAFFIC UNTIL THE MATERIAL HAS COOLED TO 125°F ±.

WEATHER LIMITATIONS


- BINDER MATERIAL SHALL BE APPLIED ONLY WHEN THE FOLLOWING CONDITIONS PREVAIL:
- A. THE AMBIENT AIR TEMPERATURE IS AT LEAST 50°F AND RISING.
 - B. THE ROAD SURFACE IS SUFFICIENTLY DRY.
 - C. WEATHER CONDITIONS OR OTHER CONDITIONS ARE FAVORABLE AND ARE EXPECTED TO REMAIN SO FOR THE PERFORMANCE OF SATISFACTORY WORK.

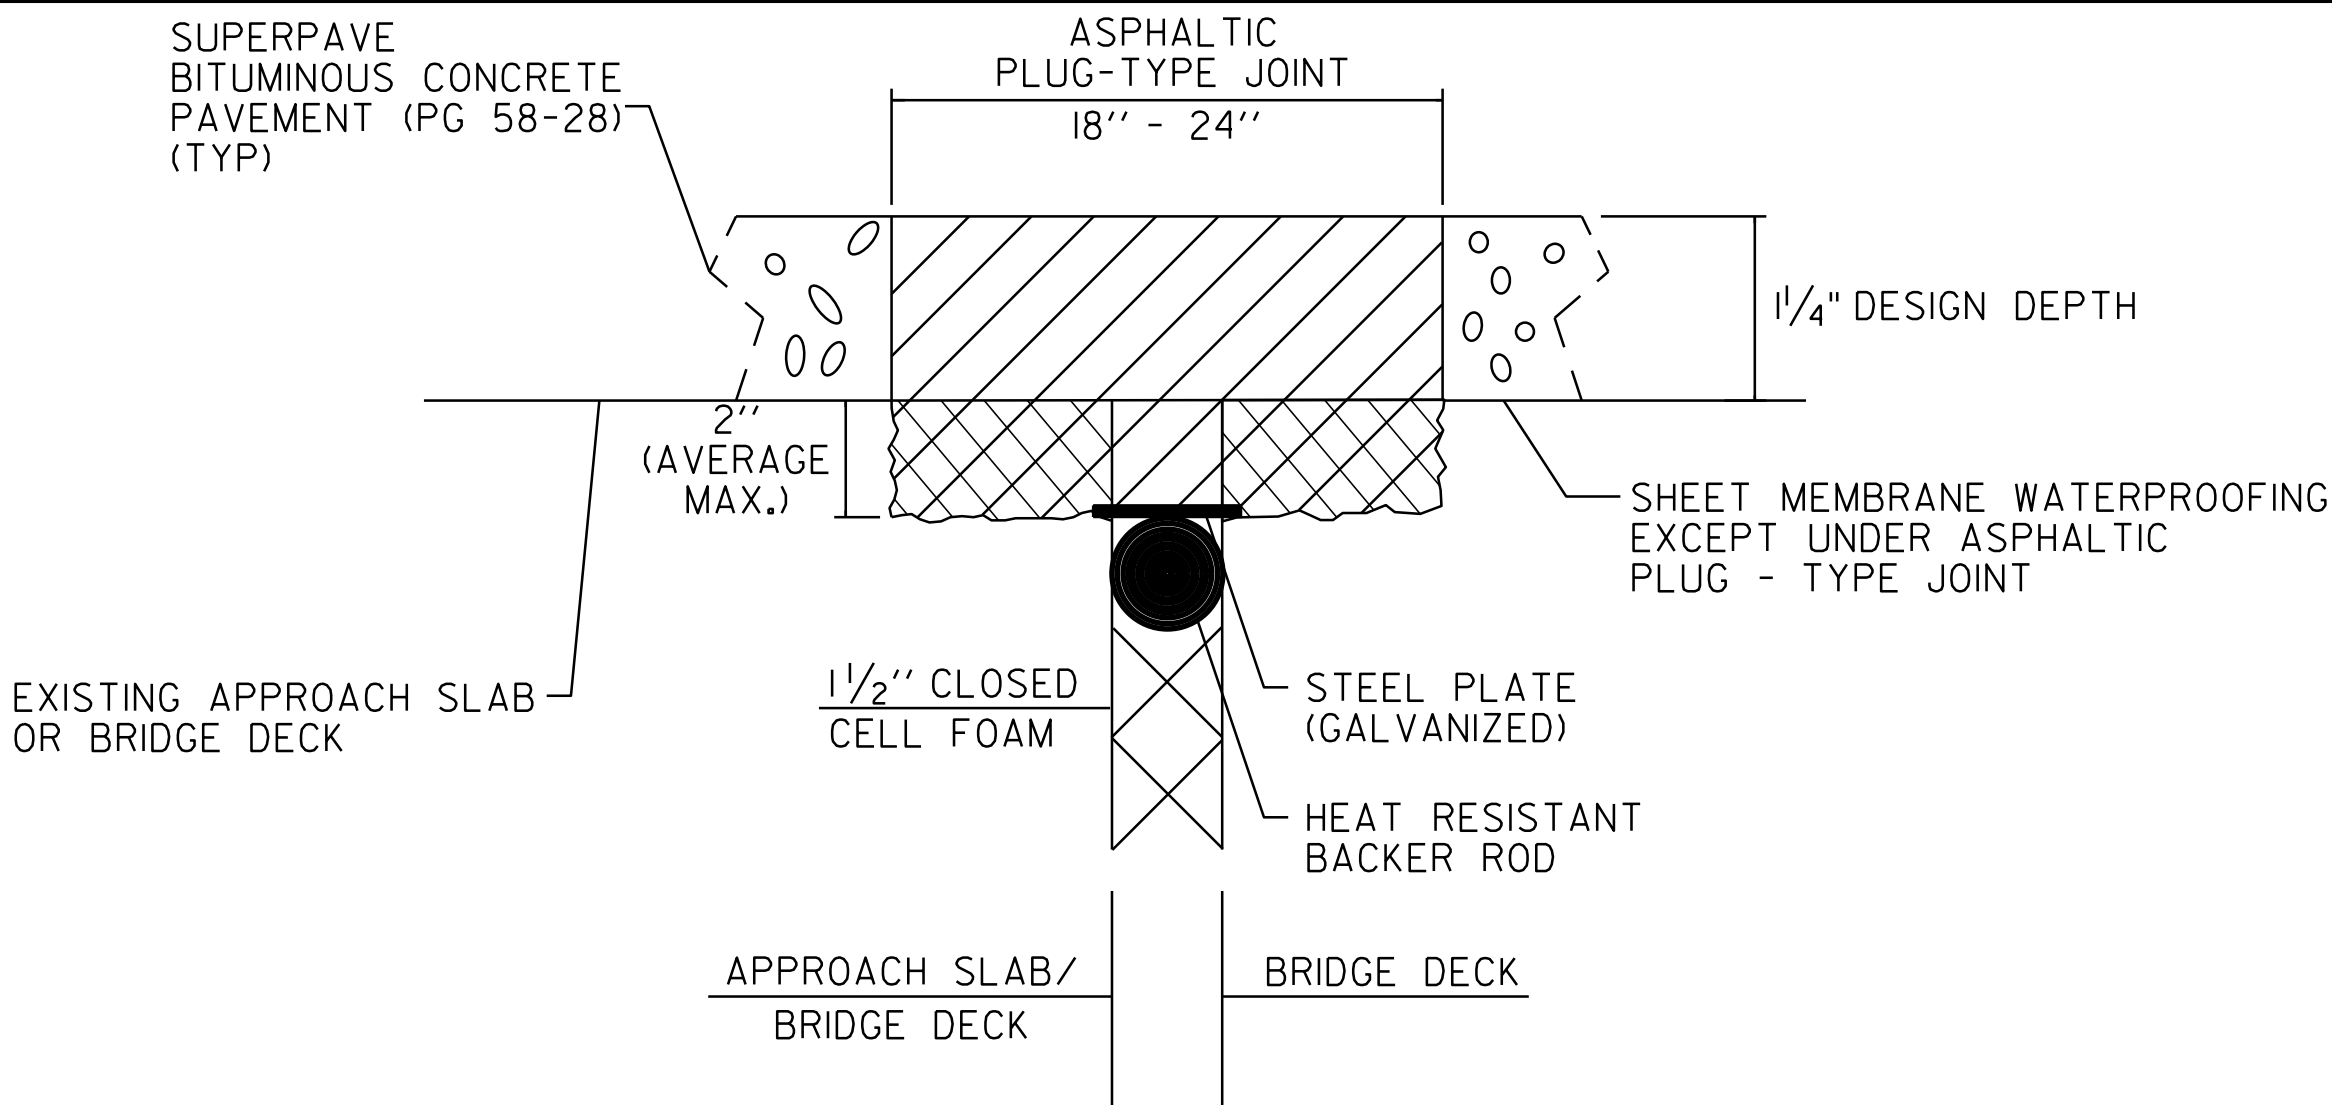

ASPHALTIC PLUG-TYPE JOINT DETAIL
REMOVAL OF UP TO
2" DETERIORATED CONCRETE

NOTES:

1. UPON ENCOUNTERING UP TO 2" AVERAGE OF DETERIORATED CONCRETE, THE CONTRACTOR SHALL REMOVE THE DETERIORATED MATERIAL AND REPLACE IT WITH THE ASPHALTIC PLUG JOINT MATERIAL AS DIRECTED BY THE RESIDENT ENGINEER.
2. REMOVAL OF THE DETERIORATED CONCRETE WILL NOT BE PAID SEPARATELY BUT WILL BE CONSIDERED INCIDENTAL TO THE UNIT BID PRICE FOR THE ITEM 516.10. THE ADDITIONAL PLUG JOINT MATERIAL BELOW THE DESIGN DEPTH REQUIRED TO REPLACE THE DETERIORATED CONCRETE WILL BE CONSIDERED INCIDENTAL TO THE UNIT BID PRICE FOR THE ITEM 516.10.
3. THE STEEL PLATE IN THE ASPHALTIC PLUG JOINT MAY BE OMITTED ONLY IF THE REPAIRED SURFACE IS SO IRREGULAR IT WILL CAUSE VERTICAL MOVEMENT AND IT IS DIRECTED BY THE RESIDENT ENGINEER.

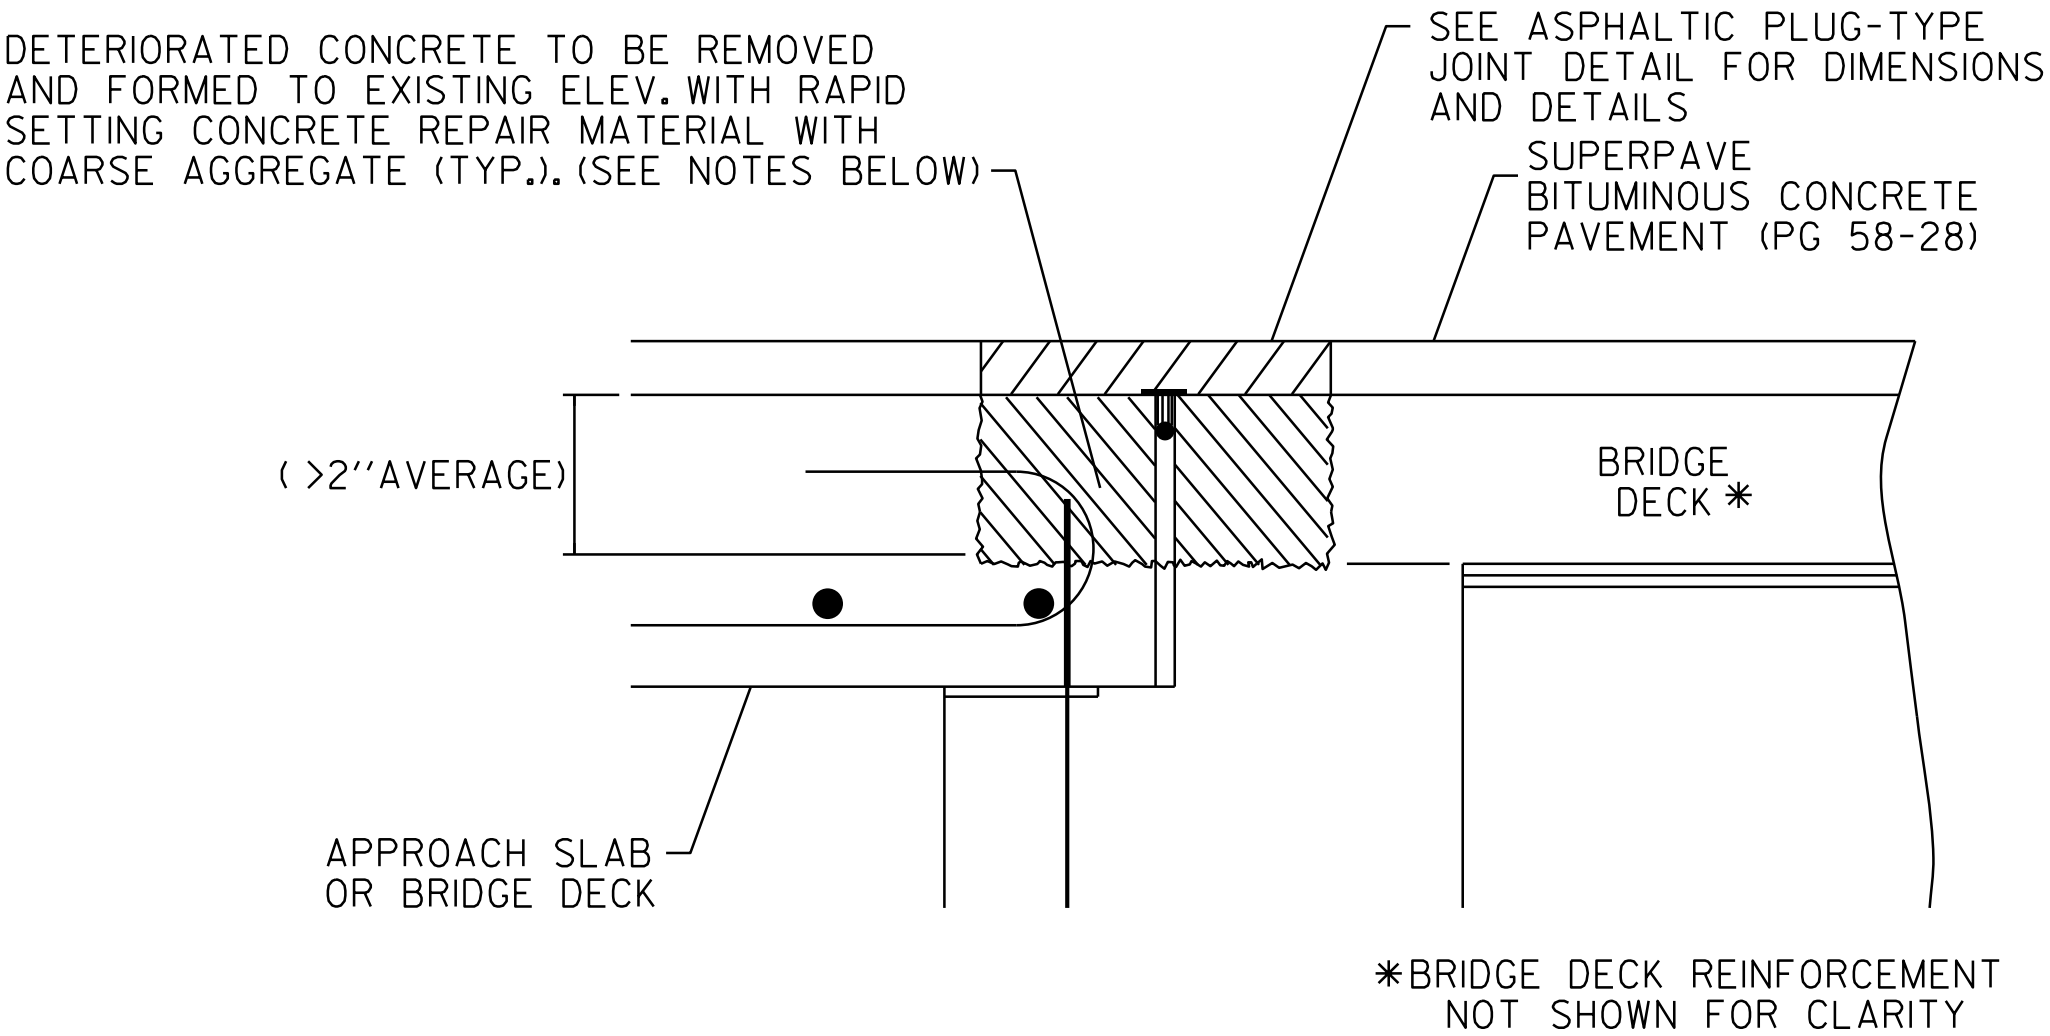

ASPHALTIC PLUG-TYPE JOINT DETAIL
REMOVAL OF >2"
DETERIORATED CONCRETE

NOTES:

1. UPON ENCOUNTERING GREATER THAN 2" AVERAGE OF DETERIORATED CONCRETE, THE CONTRACTOR SHALL REMOVE THE DETERIORATED MATERIAL AND REPLACE IT WITH RAPID SETTING CONCRETE REPAIR MATERIAL WITH COARSE AGGREGATE.
2. REMOVAL OF THE DETERIORATED CONCRETE WILL BE INCLUDED IN THE UNIT BID PRICE FOR ITEM 580.20 RAPID SETTING CONCRETE REPAIR MATERIAL WITH COARSE AGGREGATE.
3. THE STEEL PLATE IN THE ASPHALTIC PLUG JOINT MAY BE OMITTED ONLY IF THE REPAIRED SURFACE IS SO IRREGULAR IT WILL CAUSE VERTICAL MOVEMENT AND IT IS DIRECTED BY THE RESIDENT ENGINEER.

NOT TO SCALE

ASPHALTIC
PLUG JOINT
DETAIL SHEET

PROJECT NAME: St. George-So. Burlington
PROJECT NUMBER: ST-STP 2508(1)S

FILE NAME: p05b052.dgn
PROJECT LEADER: D.E.G.
DESIGNED BY: M.J.M.
IPARM FILE: p05b052pds1.i

PLOT DATE: 03-MAY-2012 1
DRAWN BY: C.A.K.
CHECKED BY: D.W.E.
SHEET 4 OF 42

QUANTITY SHEET 1

[illegible][illegible][illegible]

QUANTITY SHEET 2

APPROXIMATE SUMMARY OF QUANTITIES											
NON PART.	EMPLOYEE TRAINEESHIP	FULL CE	BRIDGE	ROADWAY	ALTERNATE A	ALTERNATE B	QUANTITIES GRAND TOTAL	UNIT	ITEMS		
				85 000			85 000	FT	4IN WHITE LINE	646.20	502
				85 000			85 000	FT	4IN YELLOW LINE	646.21	1186
				250			250	FT	8IN WHITE LINE	646.22	8
				1000			1000	FT	8IN YELLOW LINE	646.23	90
				450			450	FT	24 IN STOP BAR	646.26	6
				280			280	EA	LETTER OR SYMBOL	646.30	6
				410			410	FT	CROSSWALK MARKING	646.31	6
				85 000			85 000	FT	TEMPORARY 4IN WHITE LINE, PAINT	646.602	502
				85 000			85 000	FT	TEMPORARY 4IN YELLOW LINE, PAINT	646.612	1186
				225			225	FT	TEMPORARY 8IN WHITE LINE, PAINT	646.642	31
				225			225	FT	TEMPORARY 8IN YELLOW LINE, PAINT	646.652	31
				510			510	FT	TEMPORARY 24IN STOP BAR, PAINT	646.682	12
				200			200	EA	TEMPORARY LETTER OR SYMBOL, PAINT	646.692	--
				700			700	FT	TEMPORARY CROSSWALK MARKING, PAINT	646.702	14
				1 000			1 000	EA	LINE STRIPING TARGETS	646.76	EST
				4 800			4 800	SY	GEOTEXTILE UNDER STONE FILL	649.31	42
				100			100	LB	SEED	651.15	EST
				1 000			1 000	LB	FERTILIZER	651.18	EST
				4			4	TON	AGRICULTURAL LIMESTONE	651.20	EST
				1			1	TON	HAY MULCH	651.25	EST
				50			50	CY	TOPSOIL	651.35	EST
				2 850			2 850	SY	TEMPORARY EROSION MATTING	653.20	46
				545			545	SF	TRAFFIC SIGNS, TYPE A	675.20	4.5
				1 500			1 500	FT	SQUARE TUBE STEEL POST AND ANCHORS	675.341	30
				105			105	EA	REMOVING SIGNS	675.50	--
				28			28	EA	ERECTING SALVAGED SIGNS	675.60	--
				20			20	EA	DELINEATORS WITH STEEL POST	676.10	2
				1			1	EA	PRICE ADJUSTMENT, FUEL (N.A.B.I.)	690.50	EST
				37.5			37.5	LF	SPECIAL PROVISION (STEEL BEAM GUARDRAIL, GALVANIZED/NESTED)	900.640	--
									BEGIN ALTERNATE ITEMS		
									ALTERNATE A		
					17 500		17 500	TON	SUPERPAVE BITUMINOUS CONCRETE PAVE. (PG 58-28)	490.30	418
					1		1	LU	AIR VOIDS PAY ADJUSTMENT (N.A.B.I.)	490.31	--
					1		1	LU	MAT DENSITY PAY ADJUSTMENT (N.A.B.I.)	490.32	--
					1		1	LU	SURFACE TOLERANCE PAY ADJUSTMENT (N.A.B.I.)	490.33	--
					1		1	LU	LONG. JOINT COMPACTION PAY ADJUST. (N.A.B.I.)	490.34	--
									ALTERNATE B		
						17 500		TON	SUPERPAVE BITUMINOUS CONCRETE PAVE. (PG 58-28)	490.30	418
						1		LU	AIR VOIDS PAY ADJUSTMENT (N.A.B.I.)	490.31	--
									END ALTERNATE ITEMS		

[illegible][illegible][illegible]


TOTALS		* SHEET REVISED 7 JULY 2008 (PAGINATION)	
QUANTITY SHEET #2	PROJECT NAME	ST. GEORGE-SO. BURLINGTON	DATE PLOTTED 03-MAY-2012 17
	PROJECT NUMBER	ST-STP 2508(1)S	SHEET 6 OF 42 SHEETS

ITEM DETAIL SUMMARY SHEET 1

LOCATION			MISCELLANEOUS ITEMS											DRAINAGE ITEMS						GUARD RAIL ITEMS														REMARKS	
STA	STA	POS.	203.15	203.16	203.30	301.28	402.12	402.13	616.47	617.10	618.10	618.15	618.30	604.40	604.412	NEW PIPE				613.10	619.17	621.20	621.205	621.21	621.50	900.640	621.60	621.76	621.77	621.80	621.81	676.10			
			COM. EXCAV.	SOLID ROCK EXCAV.	EARTH BORROW	SUBBASE OF CRUSHED GRAVEL, FINE	AGG. SHOULD.	AGG. SHOULD. (RAP)	B. CONC. GUTTER & TRAF. ISLAND	RELOCATE MAILBOX SINGLE SUPPORT	PORT. CEMENT CONC. WALK (5in)	BITUM. CONC. WALK	DETECT. WARN. SURFACE	CHANGE ELEV.	REHAB. D.I. CLASS I	DIA.	CSP (0.064)	RCP	CPEP	STONE FILL, TYPE I	YIELD. MARKER POSTS	STEEL BEAM G.R.	STEEL BEAM G.R. 8ft POSTS	HEAVY DUTY S.B. G.R.	MANUF. TERMINAL SECTION, FLARED	SPEC. PROV. (S.B. GR. GALV. NESTED)	ANCHOR FOR S.B. RAIL	REPLACE G.R. POST ASSEMBLY	REPLACE G.R. BEAM UNIT	REMOVE & DISP. OF GUARD RAIL	REMOVE & DISP. OF GUIDE POSTS	DELIN. w/STEEL POSTS			
			CY	CY	CY	TON	TON	TON	TON	EA	SY	TON	SF	EA	EA	in	FT	FT	FT	CY	EA	FT	FT	FT	EA	FT	EA	EA	EA	FT	EA	EA			
ST. GEORGE																																			
0+00	53+57	LT&RT				180		260																										ESTIMATED QUANTITIES TO BE USED AS DIRECTED BY THE RESIDENT ENGINEER.	
9+15	9+90	RT			50			10														75					2			75		2		REPLACE EXISTING STEEL BEAM GUARD RAIL.	
9+35	10+10	LT			50			10														75					2			75		2		REPLACE EXISTING STEEL BEAM GUARD RAIL.	
36+30	47+05	LT			50			10							1							200	800		2					975		2		REPLACE EXISTING STEEL BEAM GUARD RAIL, REHAB D. I. AT STA 44+10.	
SHELburne																																			
0+00	62+21	LT&RT				200		345																										ESTIMATED QUANTITIES TO BE USED AS DIRECTED BY THE RESIDENT ENGINEER.	
0+00	1+75	RT																	40															STONE TO STABILIZE BANK.	
ST. GEORGE																																			
53+57	85+61	LT&RT						156																											ESTIMATED QUANTITIES TO BE USED AS DIRECTED BY THE RESIDENT ENGINEER.
68+70		RT													1																				REHAB D. I.
SHELburne																																			
62+21	89+29	LT&RT				90		92																											ESTIMATED QUANTITIES TO BE USED AS DIRECTED BY THE RESIDENT ENGINEER.
74+00	78+50	LT			50			10															375		2					450		2		REPLACE EXISTING STEEL BEAM GUARD RAIL, REDUCED POST SPACING AT POWER POLE AT STA 78+25.	
WILLISTON																																			
0+00	22+02	LT&RT				70		89																											ESTIMATED QUANTITIES TO BE USED AS DIRECTED BY THE RESIDENT ENGINEER.
WILL. 20+56	SO. BUR. 0+79	LT			50			10															112.5		2	37.5				175		2		REPLACE EXISTING STEEL BEAM GUARD RAIL.	
WILL. 20+96	SO. BUR. 0+84	RT			50			10																						187.5		2		REPLACE EXISTING STEEL BEAM GUARD RAIL.	
SO. BURLINGTON																																			
0+00	223+34	LT&RT					822																												ESTIMATED QUANTITIES TO BE USED AS DIRECTED BY THE RESIDENT ENGINEER.
133+45		RT		1		10				10		20																							CONSTRUCT SIDEWALK RAMPS, TYPE I, WITH DETECTABLE WARNING SURFACES.
134+01	138+38	LT			25		5															437.5				1			437.5		1		REPLACE EXISTING STEEL BEAM GUARD RAIL, ATTACH TO EXISTING BRIDGE APPROACH RAIL @ STA 138+38.		
136+22	138+34	RT			25		5															212.5				1			212.5		1		REPLACE EXISTING STEEL BEAM GUARD RAIL, ATTACH TO EXISTING BRIDGE APPROACH RAIL @ STA 138+34.		
141+64	142+52	RT			25		5															77 87.5				1		75 87.5		1		REPLACE EXISTING STEEL BEAM GUARD RAIL, ATTACH TO EXISTING BRIDGE APPROACH RAIL @ STA 142+52.			
141+68	142+56	LT			25		5															87.5				1		87.5		1		REPLACE EXISTING STEEL BEAM GUARD RAIL, ATTACH TO EXISTING BRIDGE APPROACH RAIL @ STA 142+56.			
159+90		LT		1		10				10		20																						CONSTRUCT SIDEWALK RAMPS, TYPE I, WITH DETECTABLE WARNING SURFACES.	
177+40		LT												1																				CHANGE ELEVATION OF D. I.	
180+95		LT													1																			REHAB D. I.	
183+55		LT													1																			REHAB D. I.	
183+35	184+85	RT			50		10															150				2				2		2		REPLACE EXISTING GUIDE POSTS WITH STEEL BEAM GUARD RAIL.	
187+02		LT	4			10				1	20																							CONSTRUCT SIDEWALK RAMPS, TYPE I, WITH DETECTABLE WARNING SURFACES.	
189+80		LT	4			10				1	20																							CONSTRUCT SIDEWALK RAMPS, TYPE I, WITH DETECTABLE WARNING SURFACES.	
195+00		LT	4			10				1	20																							CONSTRUCT SIDEWALK RAMPS, TYPE I, WITH DETECTABLE WARNING SURFACES.	
196+95		RT												1																				CHANGE ELEVATION OF D. I.	
SHEET SUB-TOTALS			12	2	450	590	852	1013		20	3	100		2	4					40		1325	1375		8	75	10			2762.5	2	18			
																																			ITEM DETAIL SUMMARY SHEET #1 DESIGNED BY <u>BCE/PJM</u> DATE <u>12-06</u> DRAWN BY <u>C.E.A., INC.</u> DATE <u>12-06</u> DESIGN FILE NO. <u>p05b052.dgn</u> PRF FILE <u>p05b0521d01.i</u> DATE PLOTTED <u>03-MAY-2012 17:</u> PROJ. NAME: ST. GEORGE-SO. BURLINGTON PROJ. NO.: ST-STP 2508(1)S SHEET 7 OF 42 SHEETS

ITEM DETAIL SUMMARY SHEET 2

[illegible]

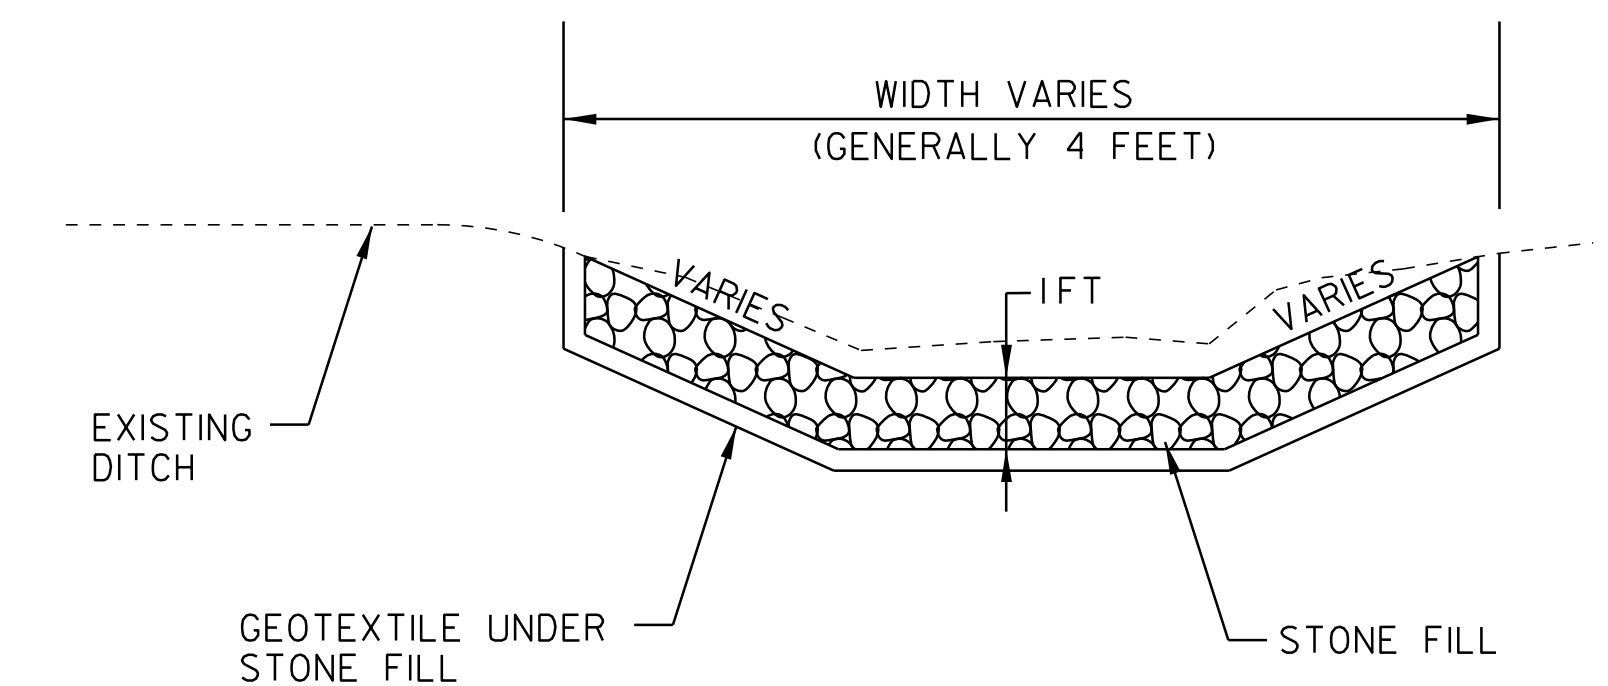[illegible]


DITCH DETAIL
NOT TO SCALE

NOTES:

PIPE INLET AND OUTLET AREAS, AND DITCH CLEANING THROUGH PROJECT, SHALL BE PERFORMED AT LOCATIONS AS INDICATED ON THIS SHEET AND AS DIRECTED BY THE RESIDENT ENGINEER. PAYMENT WILL BE UNDER THE APPLICABLE EQUIPMENT RENTAL ITEM(S).

ESTIMATED QUANTITIES OF TEMPORARY EROSION MATTING, STONE FILL TYPE I, HAVE BEEN INCLUDED. DITCHES WITH A SLOPE LESS THAN 1 PERCENT SHALL BE SEEDED. EROSION MATTING SHALL BE USED IN ALL DITCHES WITH A GRADE BETWEEN 1 AND 2 1/2 PERCENT, AND STONE FILL TYPE I SHALL BE USED IN ALL DITCHES WITH A GRADE BETWEEN 2 1/2 AND 10 PERCENT.


DITCH CLEANING DETAIL SHEET	PROJECT :	PROJECT NO. :
	ST. GEORGE-SO. BURLINGTON	ST-STP 2508(IIS)
	DESIGN FILE NAME: p05b052.dgn	
	IPARM FILE NAME: p05b052d+01.i	PLOT DATE: 03-MAY-2012 17:00
	SURVEYED BY: BCE/PJM	SURVEY DATE: 9-06
	SQUAD LEADER: BCE	DRAWN BY: C.E.A., INC.
		SHEET: 9 OF 42

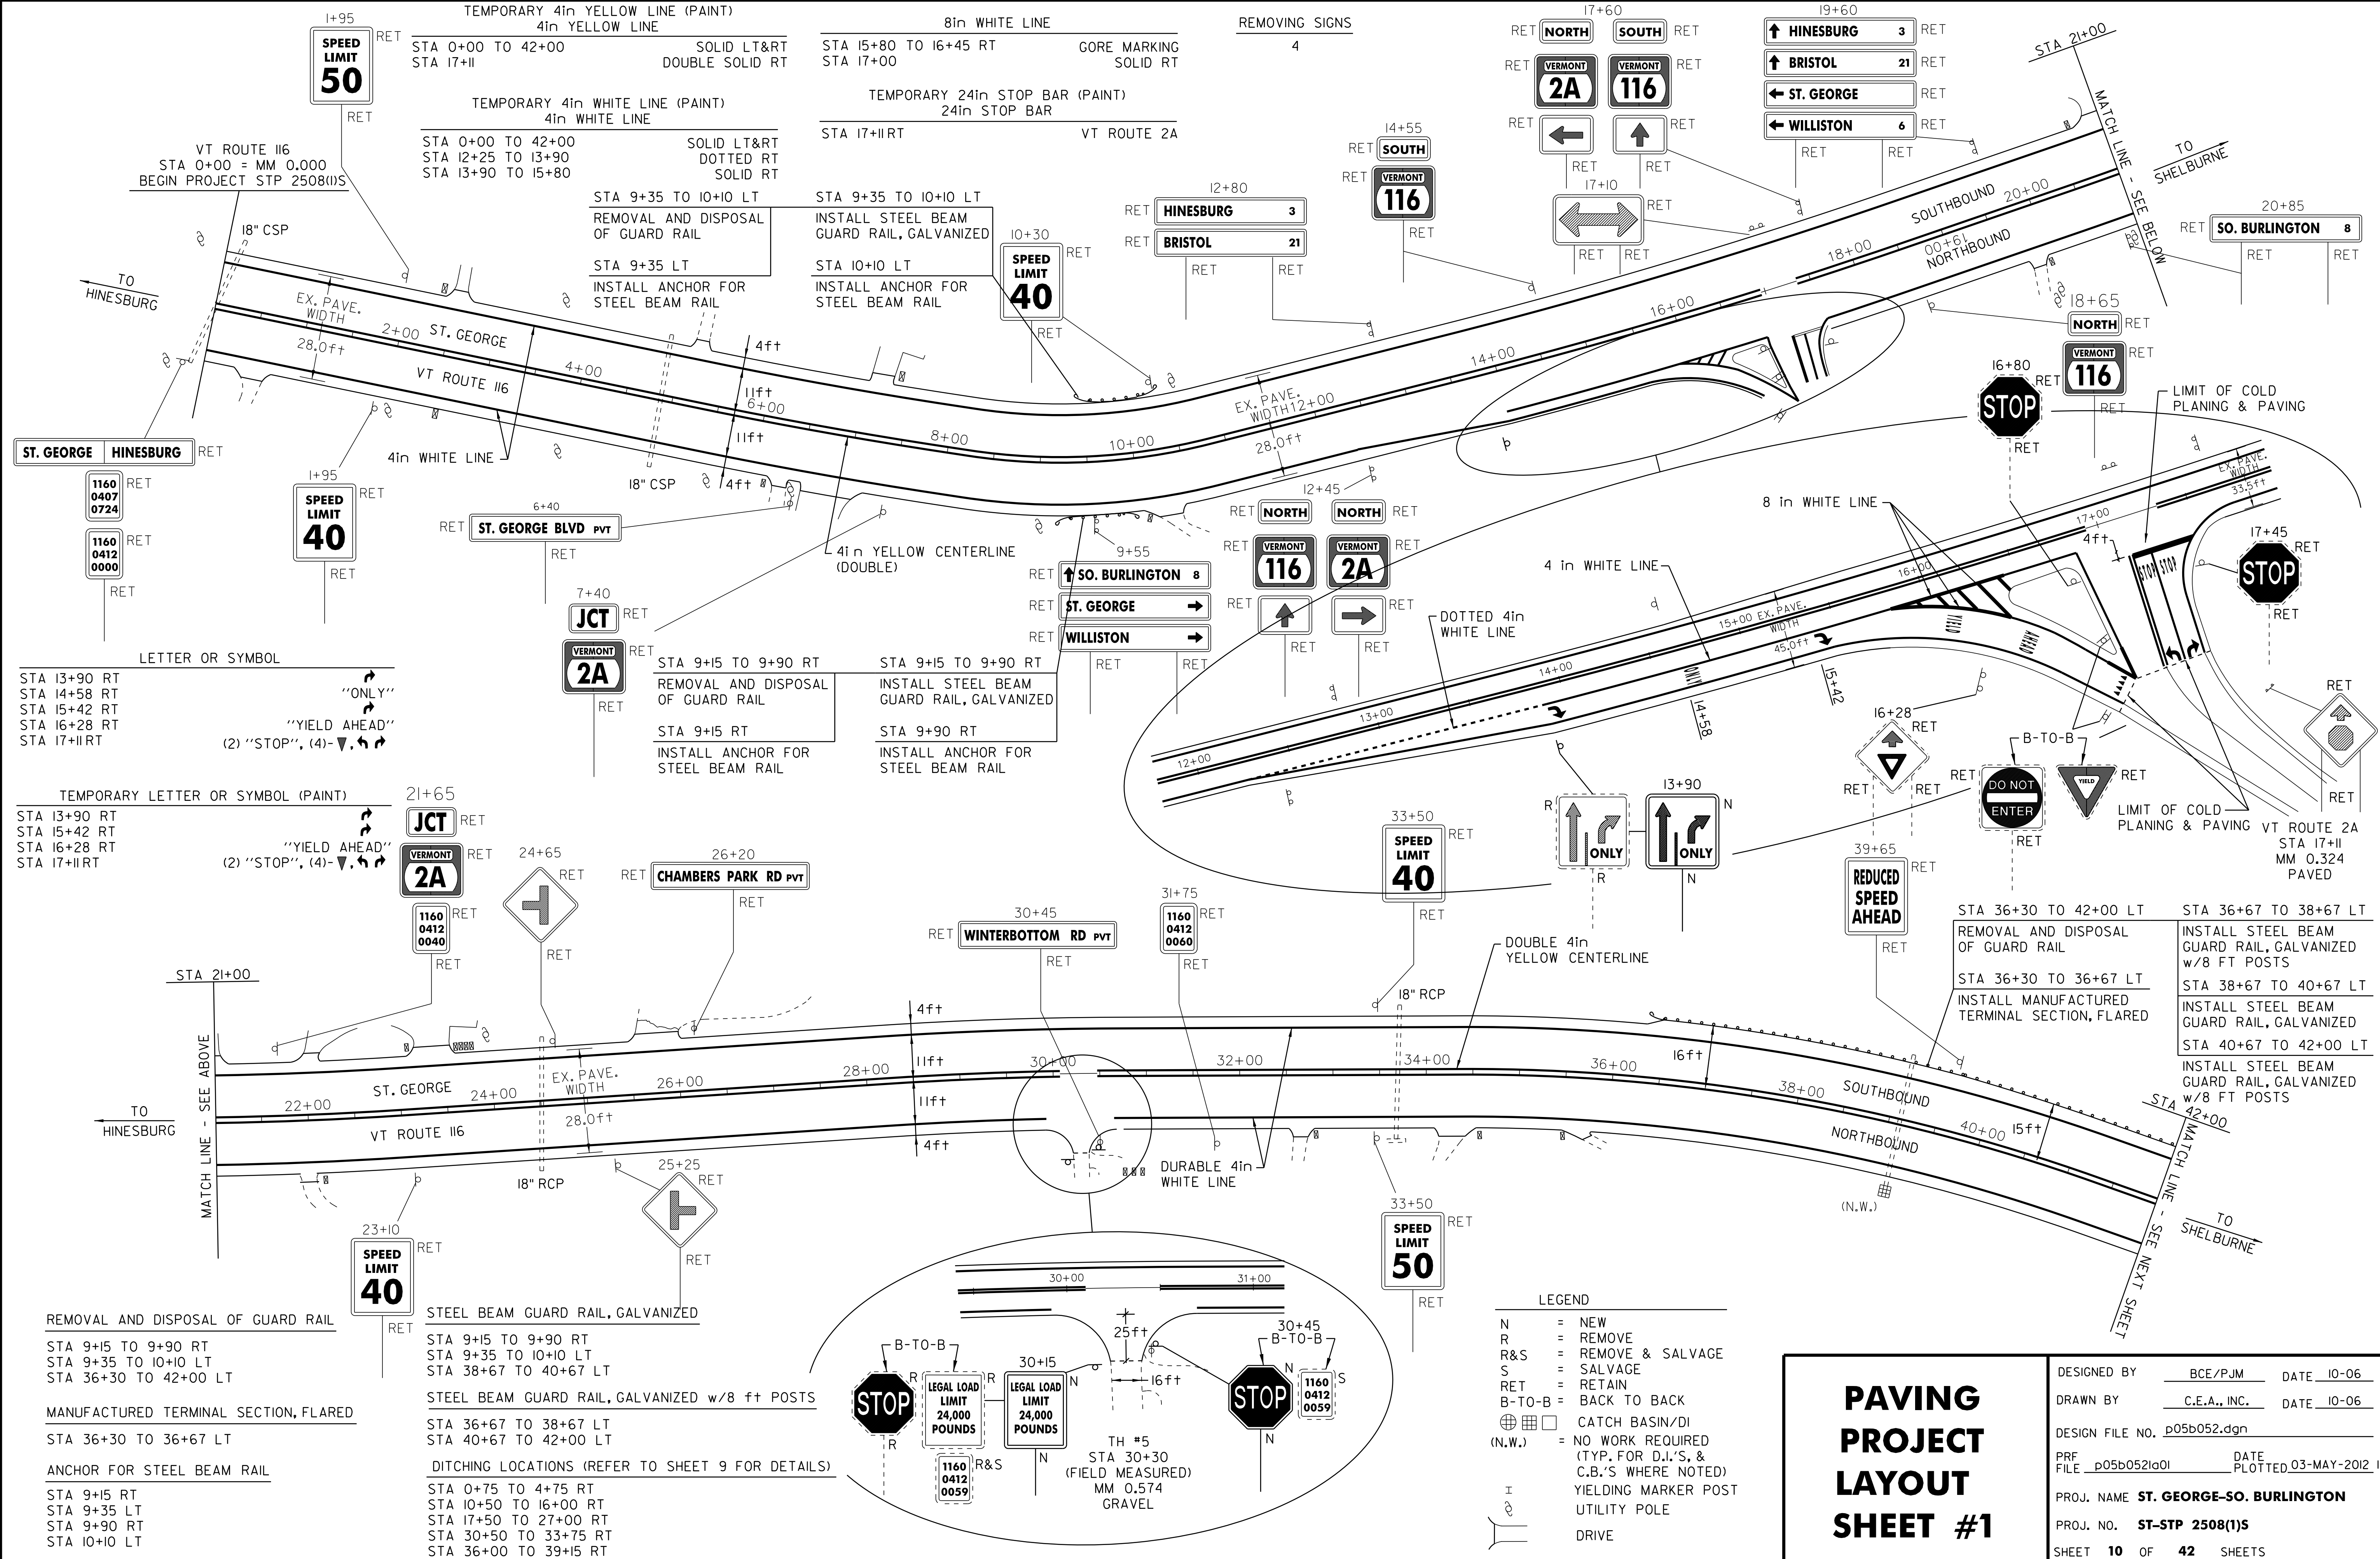

REMOVING SIGNS

SHELBURNE
STA 1+72 LT "STOP"
TEMPORARY 24in STOP BAR (PAINT)
24in STOP BAR


SHELBURNE
STA 1+72 LT POND RD

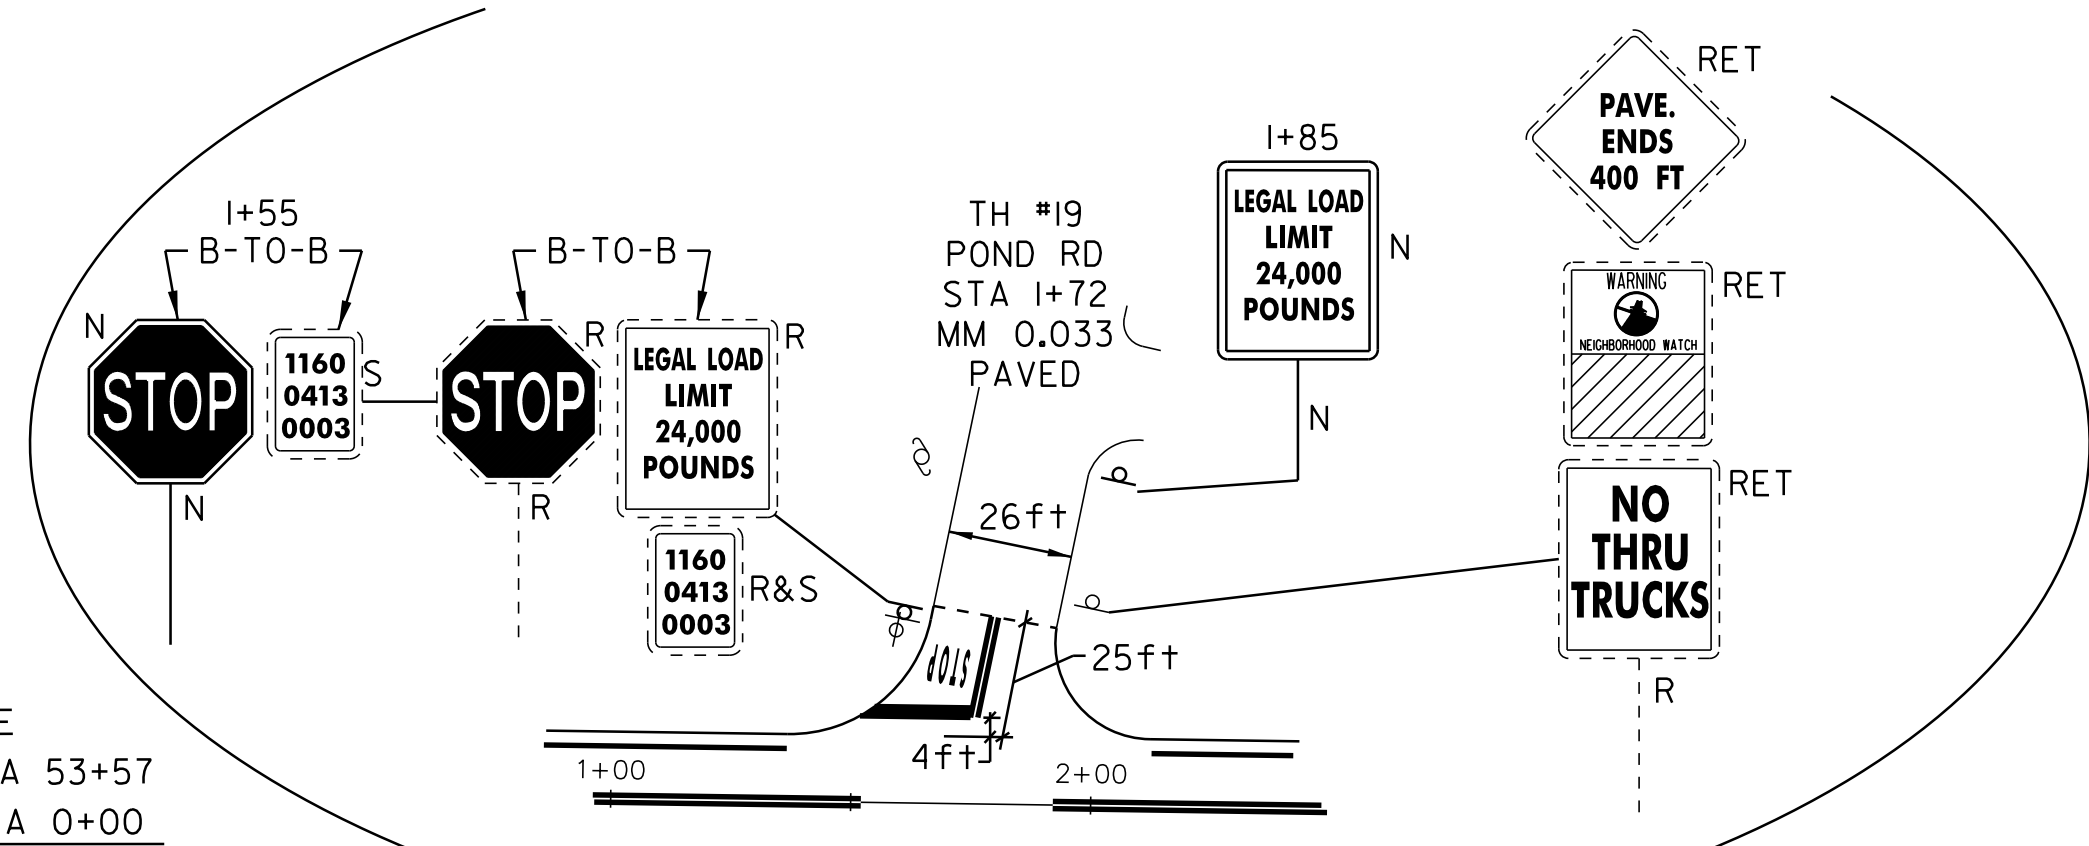

TOWN OF SHELBURNE
STA 1+75 TO 3+00 RT
STA 4+50 TO 7+00 LT
STA 13+50 TO 16+00 RT
STA 26+25 TO 28+00 LT

PAVING PROJECT LAYOUT SHEET #2

DESIGNED BY BCE/PJM DATE 10-06
DRAWN BY C.E.A., INC. DATE 10-06
DESIGN FILE NO. p05b052.dgn
PRF FILE p05b052la02 DATE PLOTTED 03-MAY-2011
PROJ. NAME **ST. GEORGE-SO. BURLINGTON**
PROJ. NO. **ST-STP 2508(1)S**
SHEET **11** OF **42** SHEETS

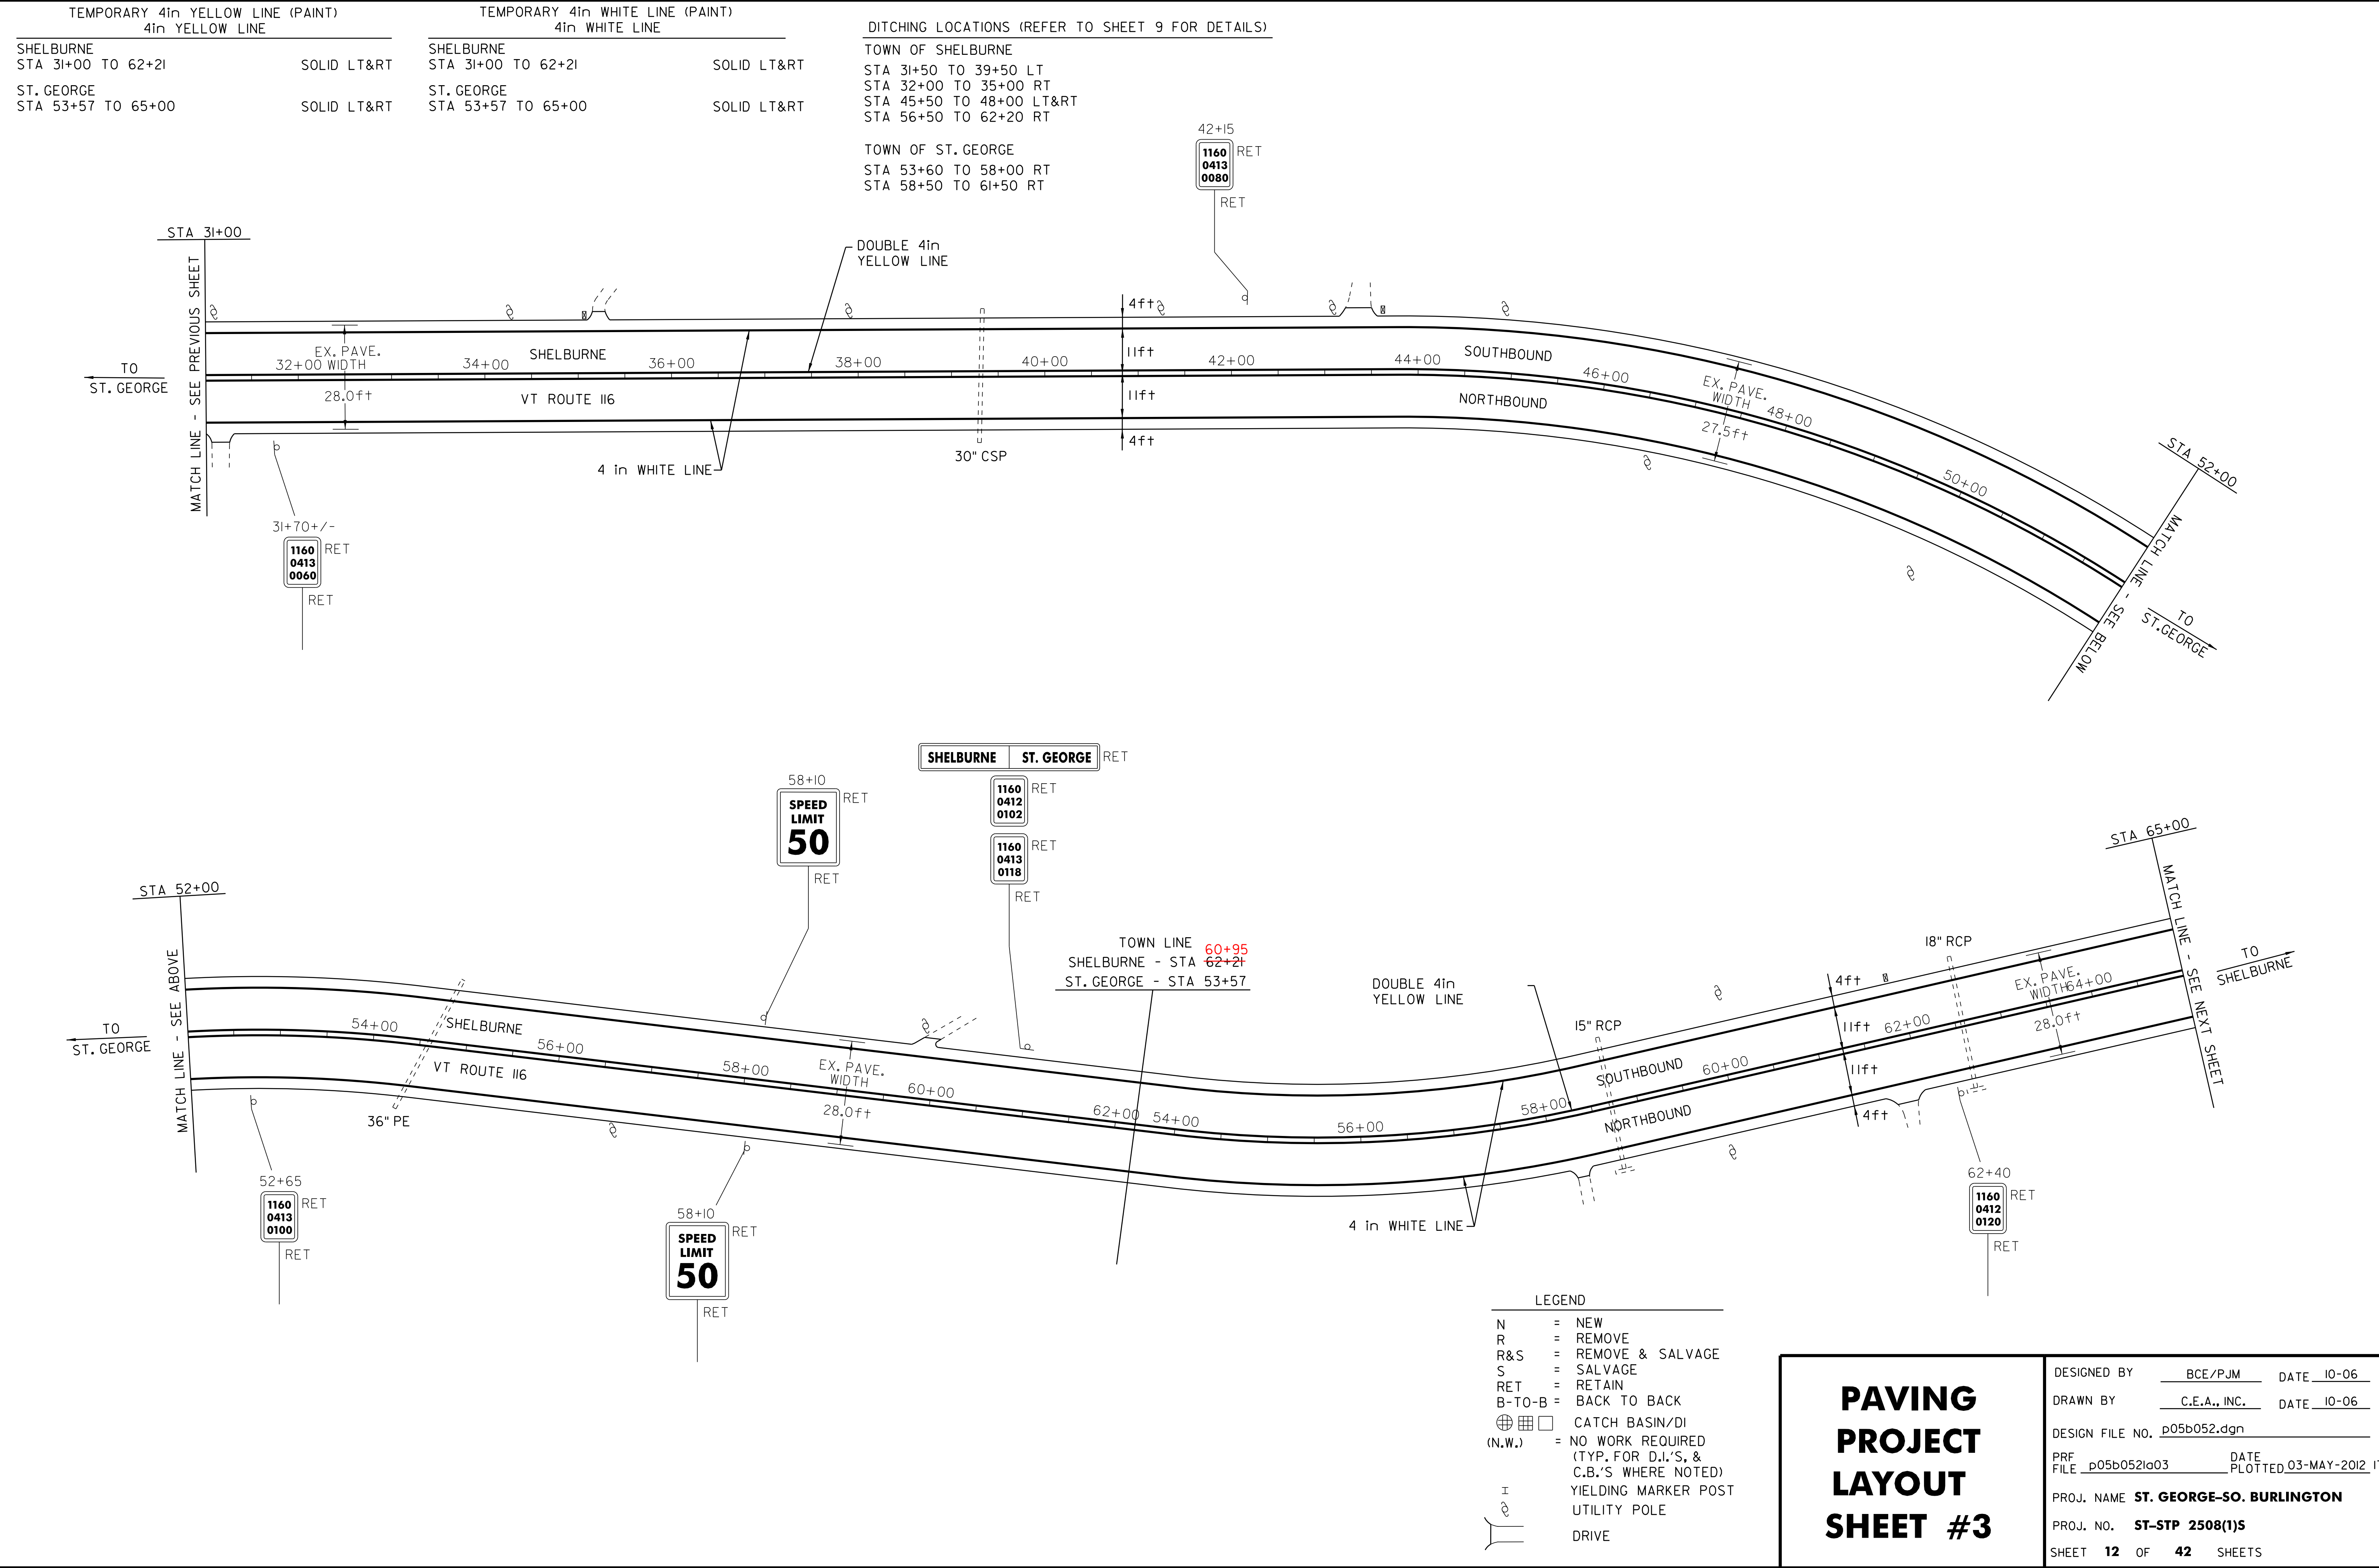

REHABILITATION OF D.I.'S, C.B.'S, OR M.H.'S

STA 68+70 RT

DITCHING LOCATIONS (REFER TO SHEET 9 FOR DETAILS)


TOWN OF ST. GEORGE

STA 66+70 TO 68+70 RT

STA 72+50 TO 77+75 RT

STA 78+00 TO 79+00 RT

TOWN LINE
ST. GEORGE - STA 85+61
SHELBURNE - STA 62+21

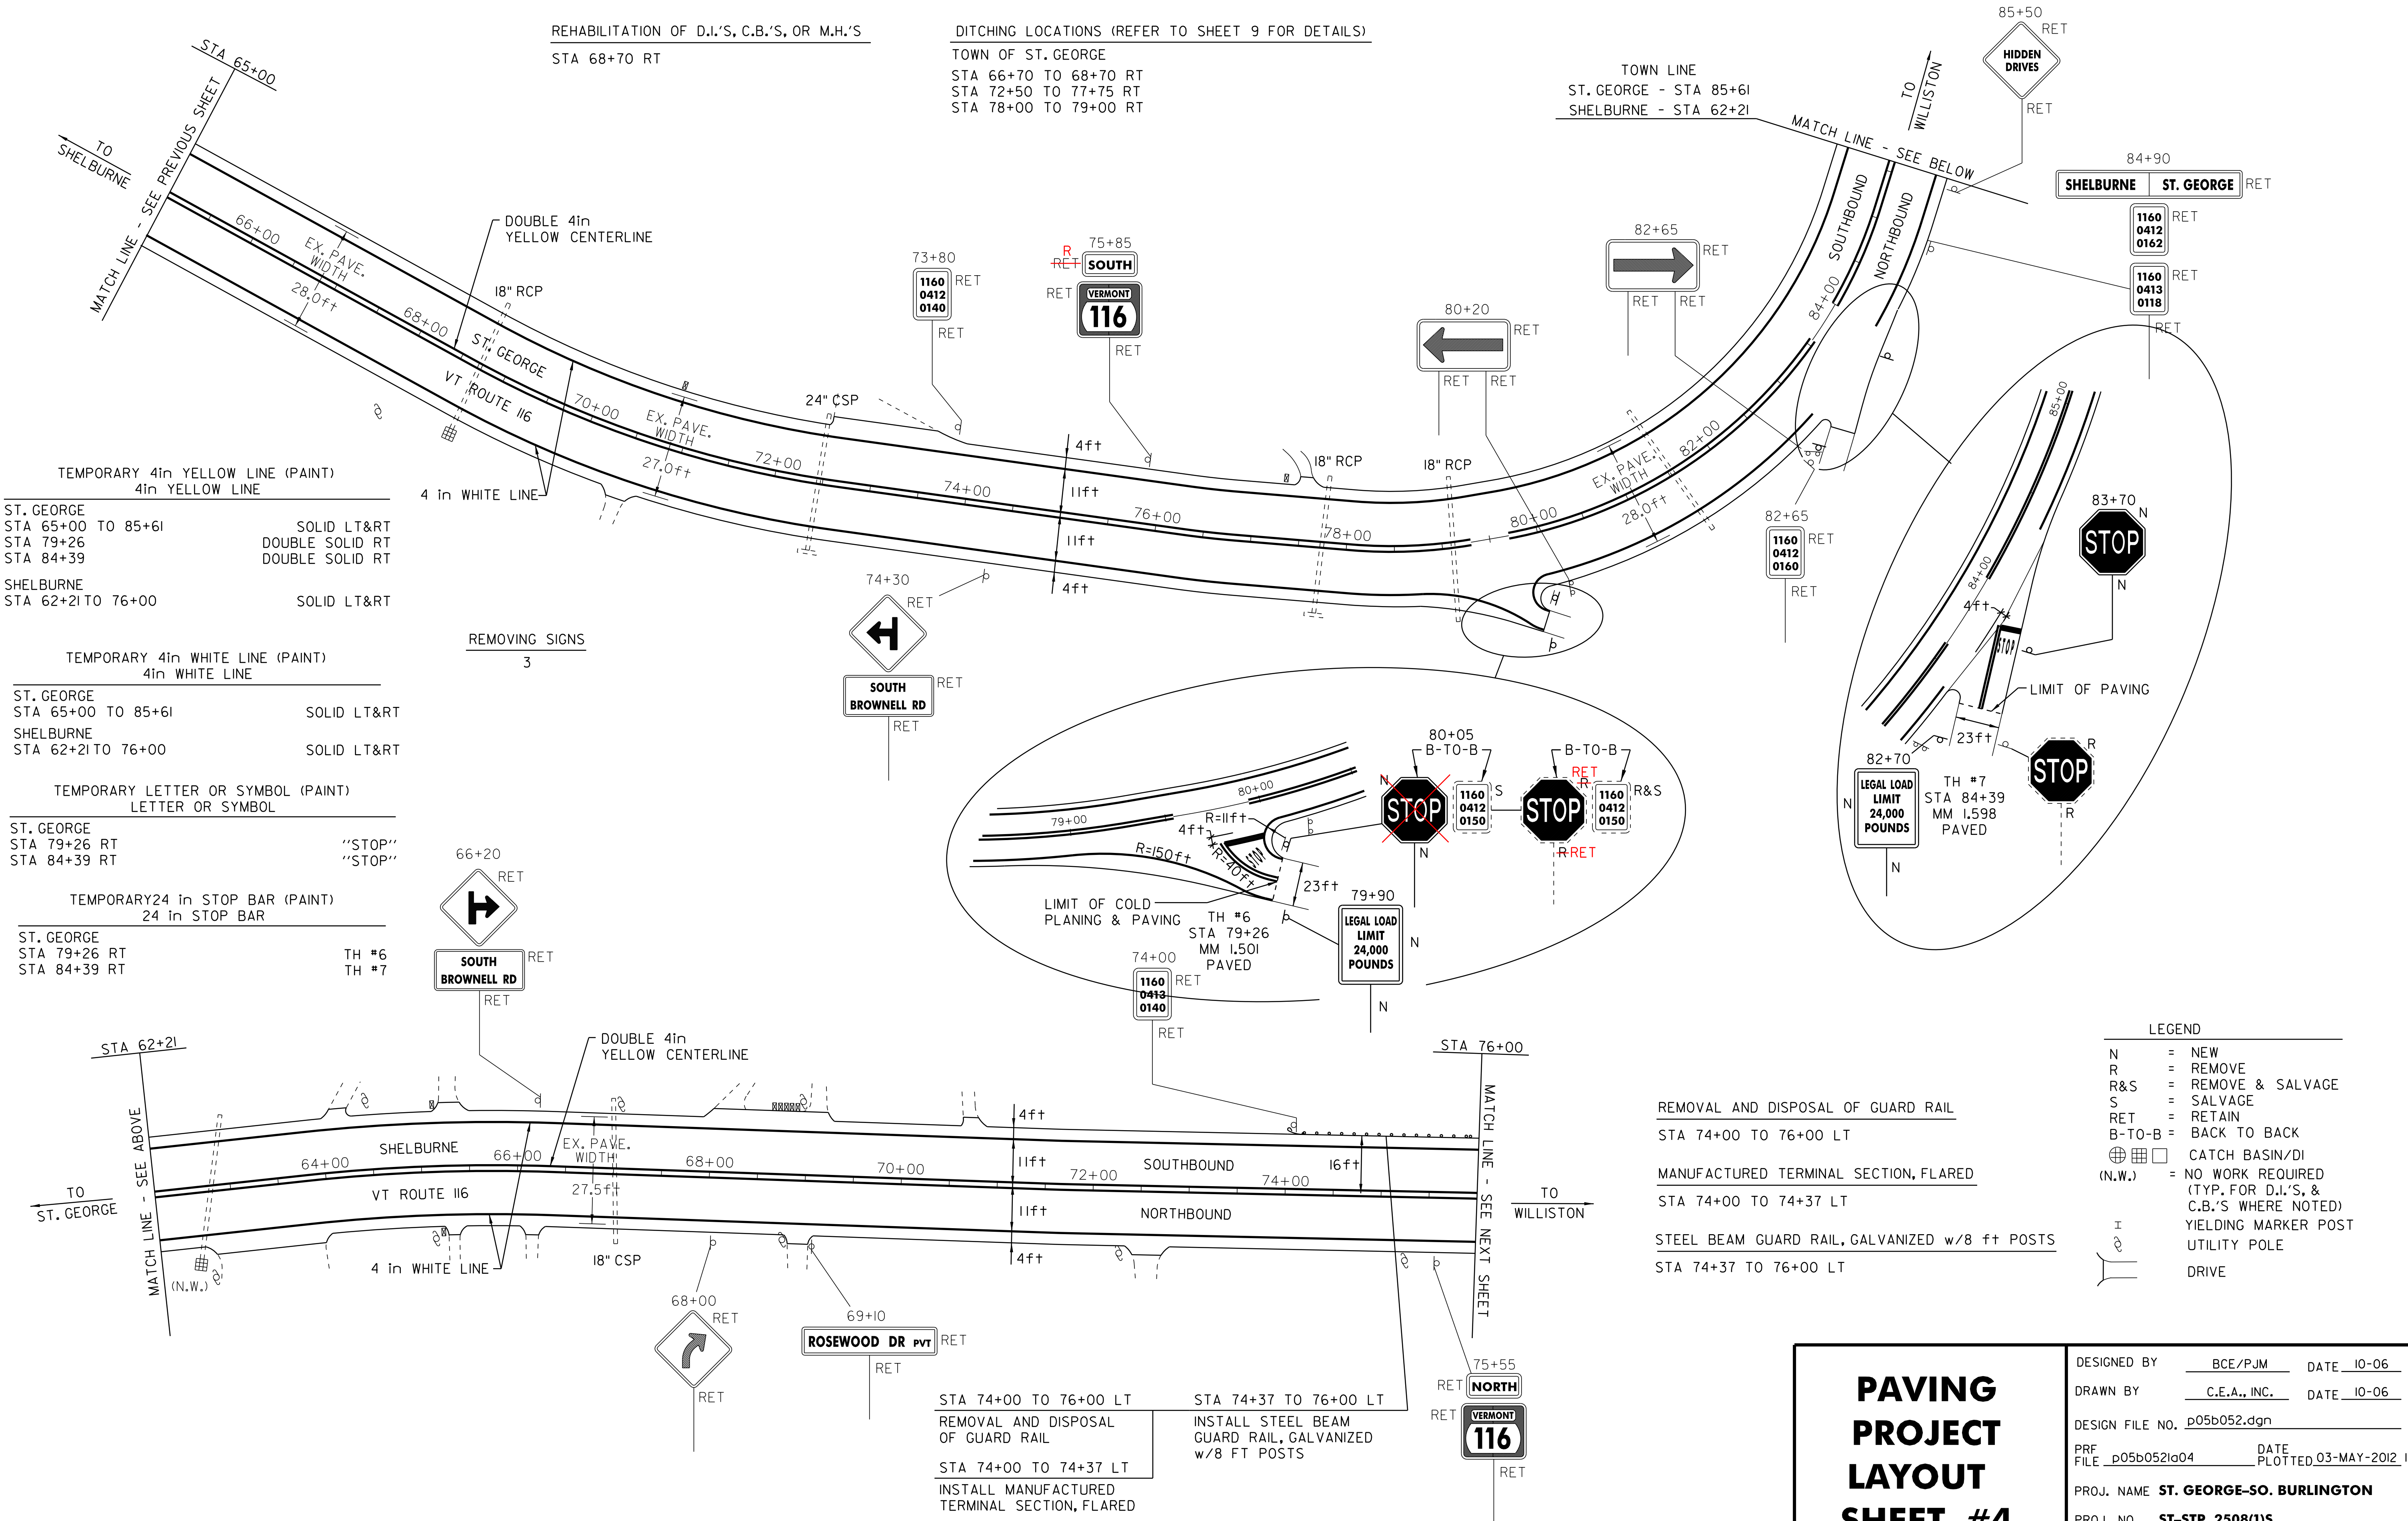

TEMPORARY 4in YELLOW LINE (PAINT)
4in YELLOW LINE

ST. GEORGE
STA 65+00 TO 85+61
STA 79+26
STA 84+39

SOLID LT&RT
DOUBLE SOLID RT
DOUBLE SOLID RT

SHELBURNE
STA 62+21 TO 76+00

SOLID LT&RT

TEMPORARY 4in WHITE LINE (PAINT)
4in WHITE LINE

ST. GEORGE
STA 65+00 TO 85+61

SOLID LT&RT

SHELBURNE
STA 62+21 TO 76+00

SOLID LT&RT

TEMPORARY LETTER OR SYMBOL (PAINT)
LETTER OR SYMBOL

ST. GEORGE
STA 79+26 RT
STA 84+39 RT

"STOP"
"STOP"

TEMPORARY 24 in STOP BAR (PAINT)
24 in STOP BAR

ST. GEORGE
STA 79+26 RT
STA 84+39 RT

TH #6
TH #7

REMOVING SIGNS
3

66+20
RET
SOUTH BROWNELL RD
RET

74+30
RET
SOUTH BROWNELL RD
RET

74+00
RET
1160
0413
0140
RET

80+05
B-T-O-B
STOP
1160
0412
0150
S
B-T-O-B
STOP
1160
0412
0150
R&S
LEGAL LOAD
LIMIT
24,000
POUNDS
N

82+70
N
LEGAL LOAD
LIMIT
24,000
POUNDS
N
TH #7
STA 84+39
MM 1,598
PAVED
STOP
R
STOP
N

LEGEND
N = NEW
R = REMOVE
R&S = REMOVE & SALVAGE
S = SALVAGE
RET = RETAIN
B-T-O-B = BACK TO BACK
CATCH BASIN/DI
(N.W.) = NO WORK REQUIRED
(TYP. FOR D.I.'S, &
C.B.'S WHERE NOTED)
YIELDING MARKER POST
UTILITY POLE
DRIVE

REMOVAL AND DISPOSAL OF GUARD RAIL

STA 74+00 TO 76+00 LT

MANUFACTURED TERMINAL SECTION, FLARED

STA 74+00 TO 74+37 LT


STEEL BEAM GUARD RAIL, GALVANIZED w/8 ft POSTS

STA 74+37 TO 76+00 LT

PAVING
PROJECT
LAYOUT
SHEET #4

DESIGNED BY BCE/PJM DATE 10-06
DRAWN BY C.E.A., INC. DATE 10-06
DESIGN FILE NO. p05b052.dgn
PRF FILE p05b052a04 DATE PLOTTED 03-MAY-2012 17
PROJ. NAME ST. GEORGE-SO. BURLINGTON
PROJ. NO. ST-STP 2508(1)S
SHEET 13 OF 42 SHEETS

DESIGNED BY BCE/PJM DATE 10-06
DRAWN BY C.E.A., INC. DATE 10-06
DESIGN FILE NO. p05b052.dgn
PRF FILE p05b052la06 DATE PLOTTED 03-MAY-2012
PROJ. NAME **ST. GEORGE-SO. BURLINGTON**
PROJ. NO. **ST-STP 2508(1)S**
SHEET **15** OF **42** SHEETS

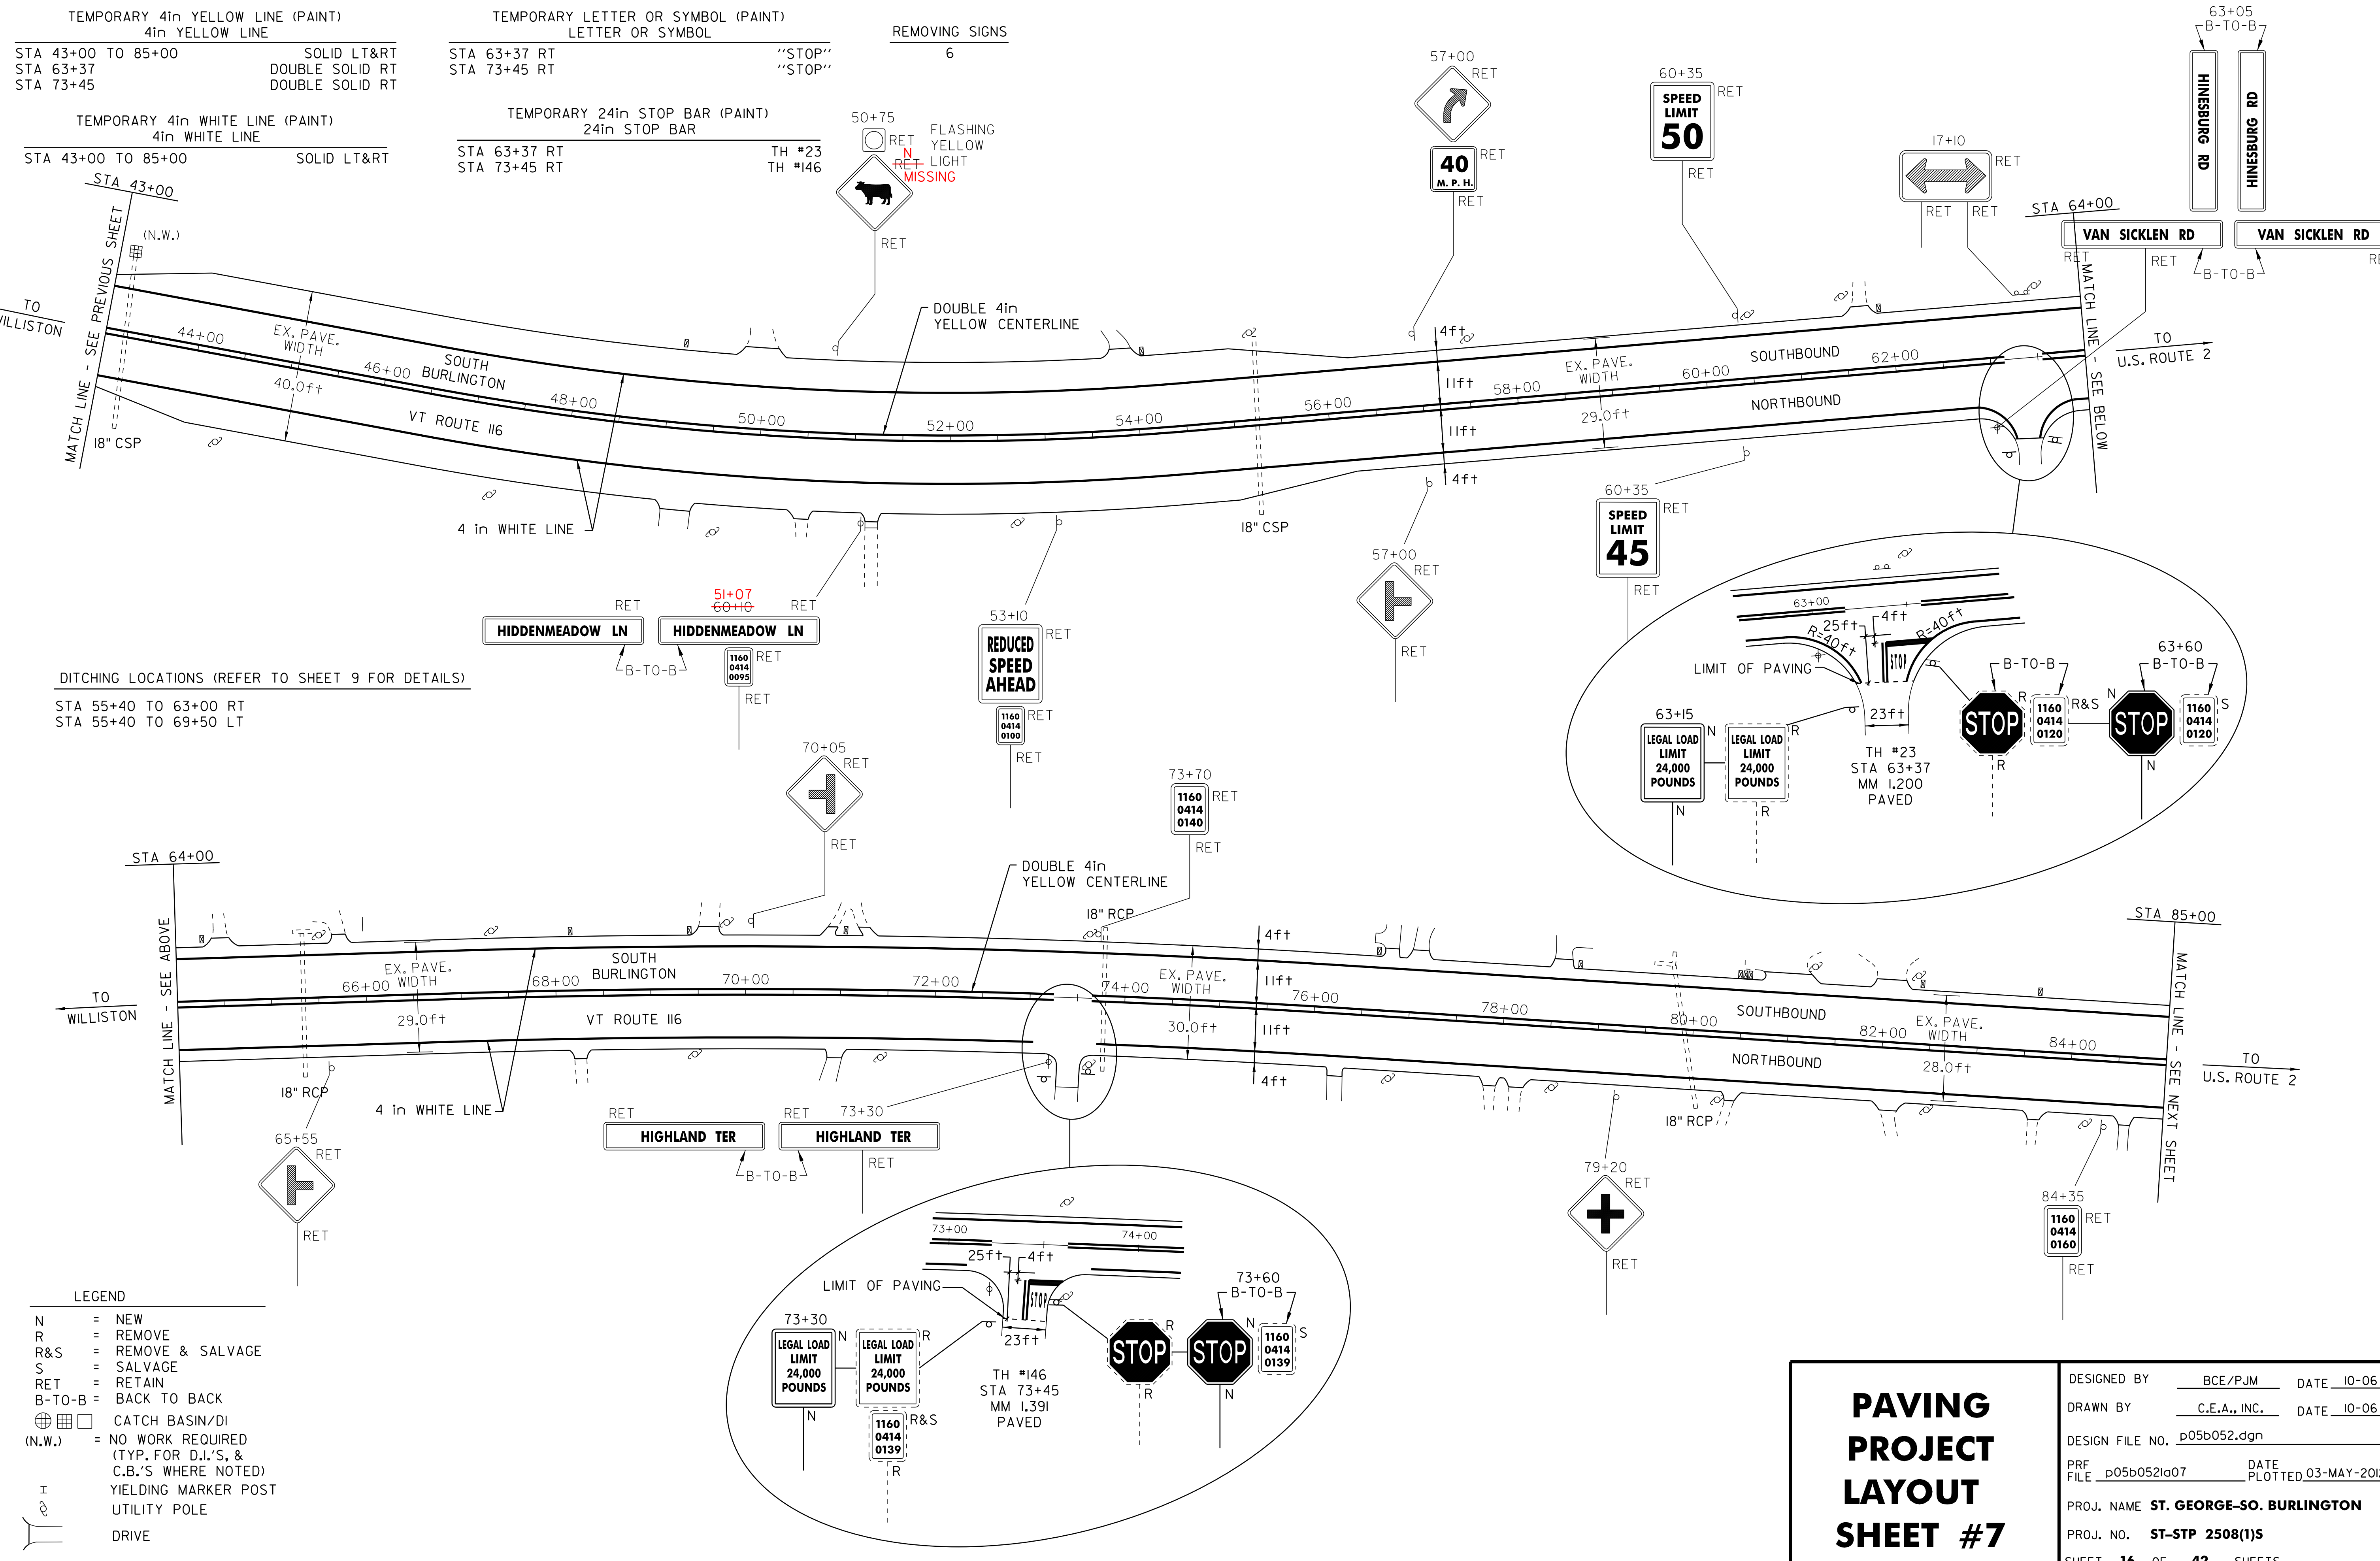

TEMPORARY 4in YELLOW LINE (PAINT)	TEMPORARY LETTER OR SYMBOL (PAINT)	REMOVING SIGNS
4in YELLOW LINE	LETTER OR SYMBOL	6
STA 43+00 TO 85+00		
STA 63+37	“STOP”	
STA 73+45	“STOP”	

TEMPORARY 4in WHITE LINE (PAINT)	TEMPORARY 24in STOP BAR (PAINT)
4in WHITE LINE	24in STOP BAR
STA 43+00 TO 85+00	TH #23
	TH #146

DITCHING LOCATIONS (REFER TO SHEET 9 FOR DETAILS)

STA 55+40 TO 63+00 RT

STA 55+40 TO 69+50 LT

LEGEND	
N	= NEW
R	= REMOVE
R&S	= REMOVE & SALVAGE
S	= SALVAGE
RET	= RETAIN
B-TO-B	= BACK TO BACK
⊕ ⊞ □	CATCH BASIN/DI
(N.W.)	= NO WORK REQUIRED (TYP. FOR D.I.'S, & C.B.'S WHERE NOTED)
⊕	YIELDING MARKER POST
⊕	UTILITY POLE
⊕	DRIVE

PAVING
PROJECT
LAYOUT
SHEET #7

DESIGNED BY

BCE/PJM

DATE

10-06

DRAWN BY

C.E.A., INC.

DATE

10-06

DESIGN FILE NO.

p05b052.dgn

PRF FILE

p05b052a07

DATE PLOTTED

03-MAY-2012 17

PROJ. NAME

ST. GEORGE-SO. BURLINGTON

PROJ. NO.

ST-STP 2508(1)S


SHEET

16

OF

42

SHEETS

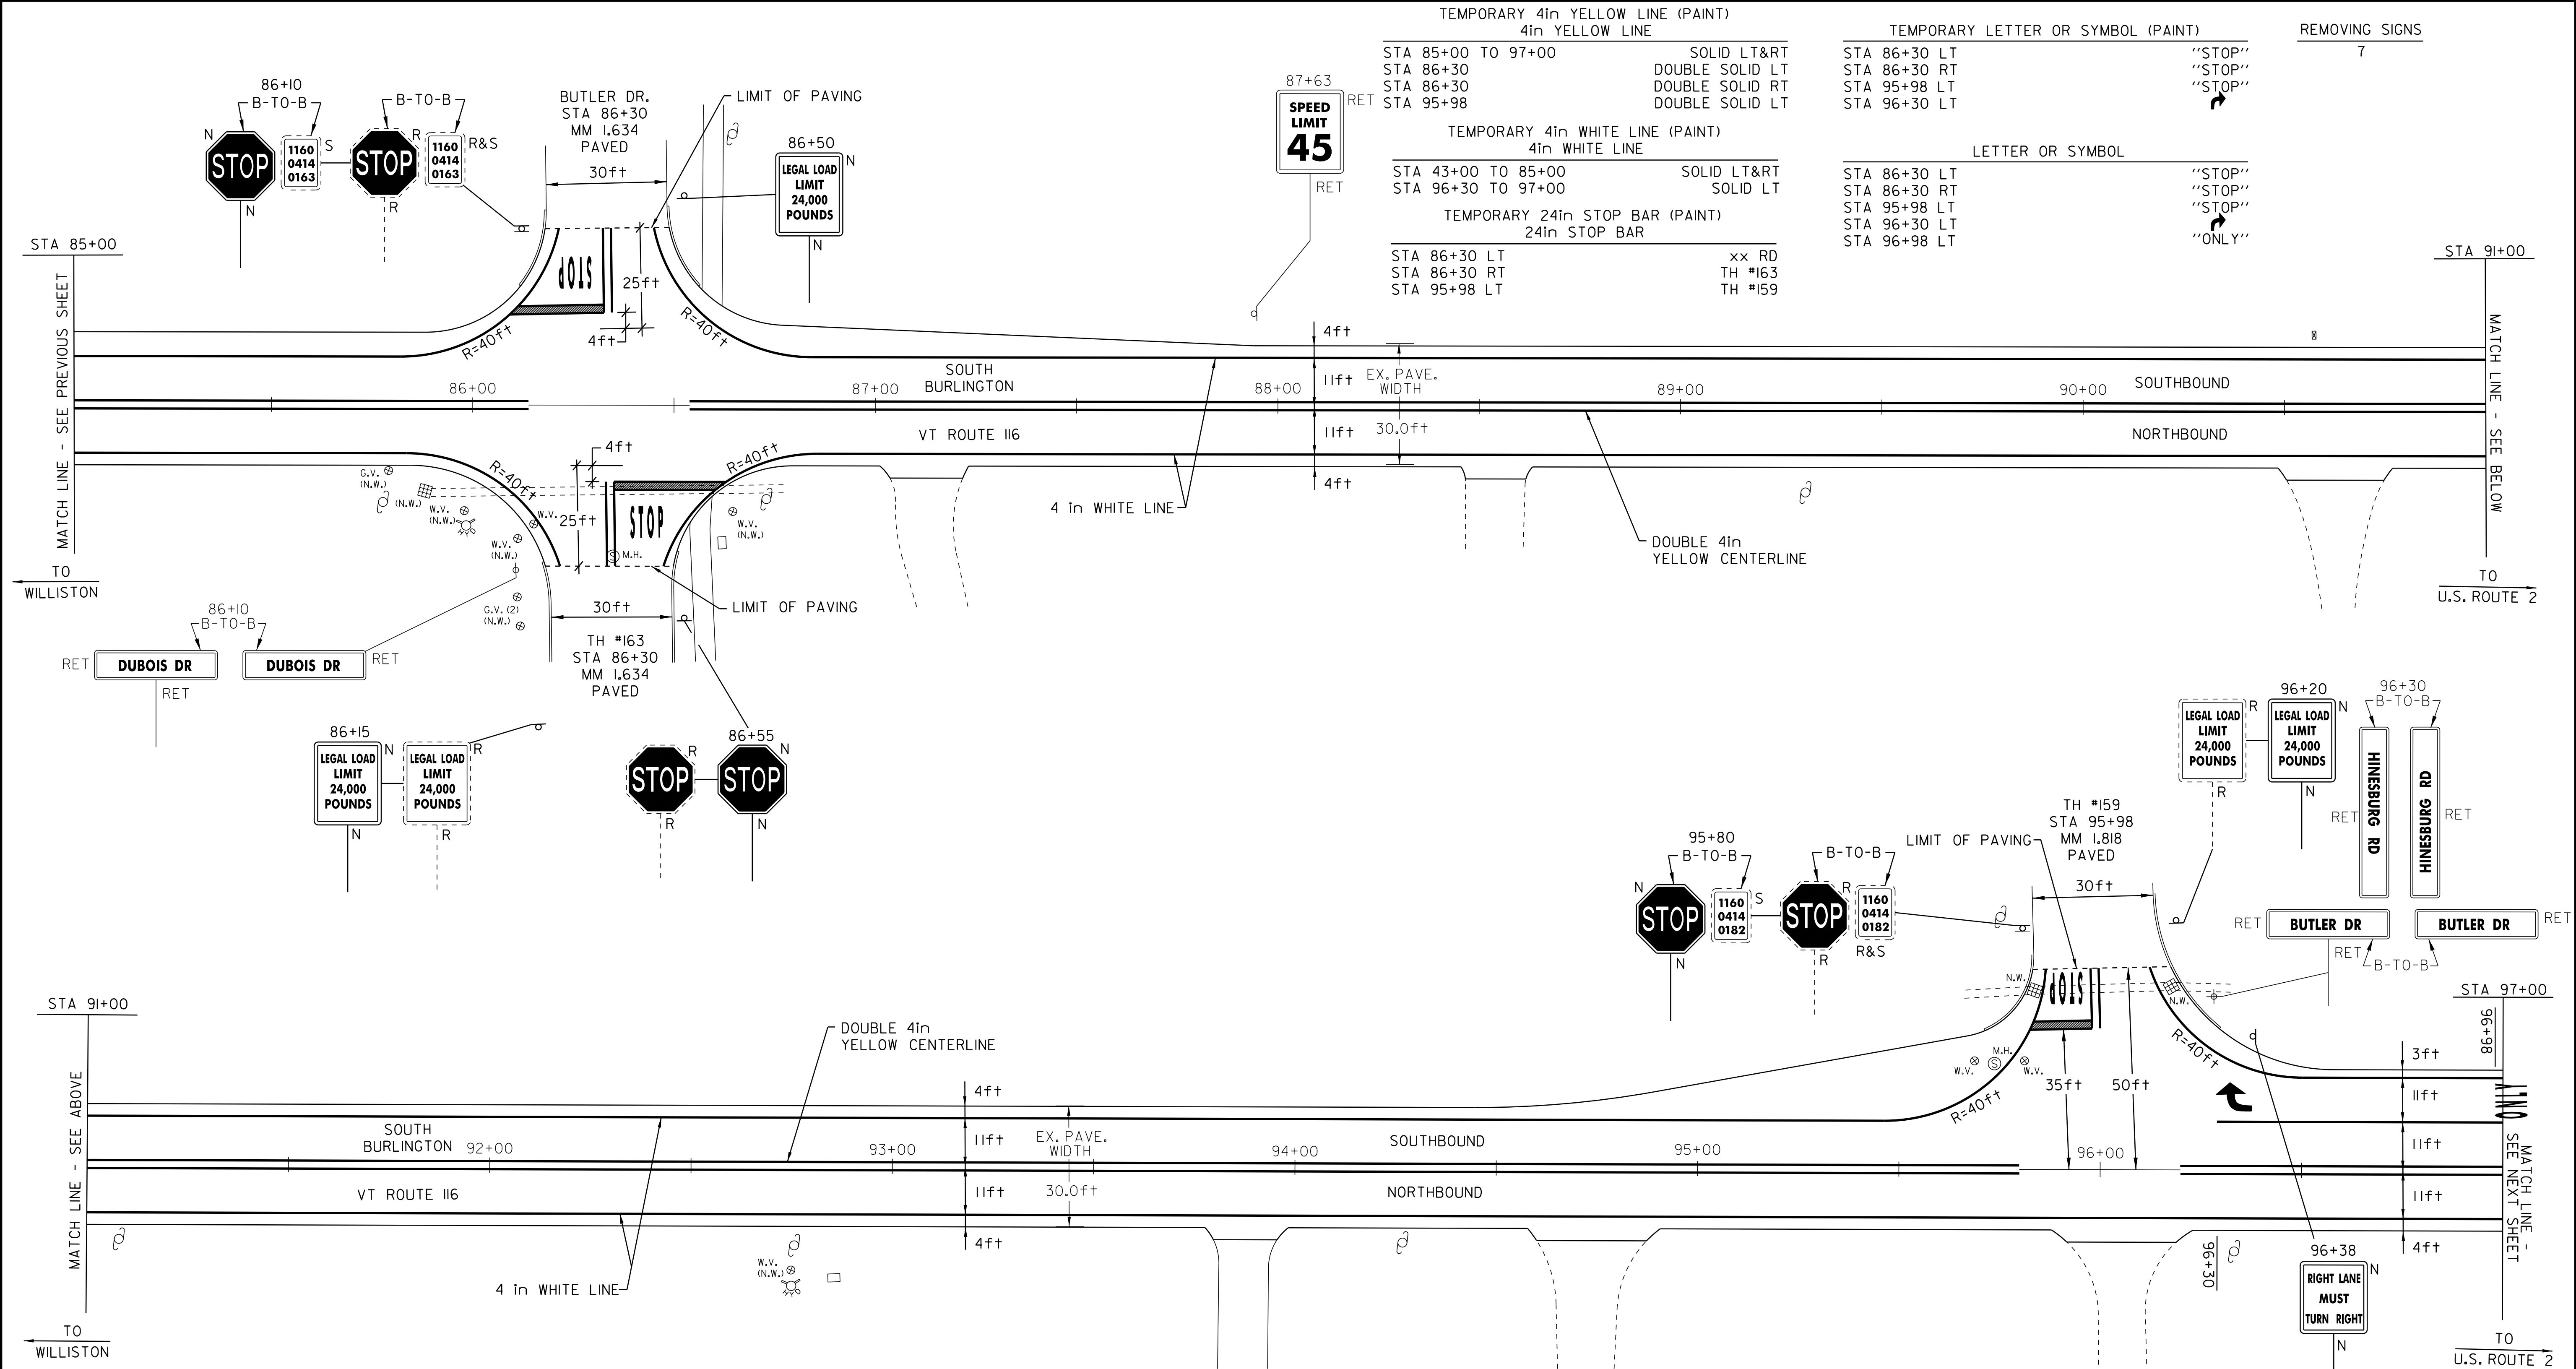

TEMPORARY 4in YELLOW LINE (PAINT)	
STA 85+00 TO 97+00	SOLID LT&RT
STA 86+30	DOUBLE SOLID LT
STA 86+30	DOUBLE SOLID RT
STA 95+98	DOUBLE SOLID LT
TEMPORARY 4in WHITE LINE (PAINT)	
STA 43+00 TO 85+00	SOLID LT&RT
STA 96+30 TO 97+00	SOLID LT
TEMPORARY 24in STOP BAR (PAINT)	
STA 86+30 LT	xx RD
STA 86+30 RT	TH #163
STA 95+98 LT	TH #159

TEMPORARY LETTER OR SYMBOL (PAINT)	
STA 86+30 LT	"STOP"
STA 86+30 RT	"STOP"
STA 95+98 LT	"STOP"
STA 96+30 LT	"STOP"
STA 96+98 LT	"ONLY"
LETTER OR SYMBOL	
STA 86+30 LT	"STOP"
STA 86+30 RT	"STOP"
STA 95+98 LT	"STOP"
STA 96+30 LT	"STOP"
STA 96+98 LT	"ONLY"

REMOVING SIGNS
7

LEGEND	
N	= NEW
R	= REMOVE
R&S	= REMOVE & SALVAGE
S	= SALVAGE
RET	= RETAIN
B-T-O-B	= BACK TO BACK
⊕	= CATCH BASIN/DI
(N.W.)	= NO WORK REQUIRED (TYP. FOR D.I.'S, & C.B.'S WHERE NOTED)
⊕	= YIELDING MARKER POST
⊕	= UTILITY POLE
⊕	= DRIVE

DITCHING LOCATIONS (REFER TO SHEET 9 FOR DETAILS)

STA 86+75 TO 90+50 RT

CHANGE ELEVATION OF SEWER MANHOLE (WORK TO BE DONE BY OTHERS)

STA 86+30 RT

STA 95+75 LT

ADJUST ELEVATION OF VALVE BOX (WORK TO BE DONE BY OTHERS)

STA 86+15 RT

STA 95+70 LT

STA 95+80 LT

PAVING
PROJECT
LAYOUT
SHEET #8

DESIGNED BY

BCE/PJM

DATE

10-06

DRAWN BY

C.E.A., INC.

DATE

10-06

DESIGN FILE NO.

p05b052.dgn

PRF FILE

p05b052la08

DATE PLOTTED

03-MAY-2012 17

PROJ. NAME

ST. GEORGE-SO. BURLINGTON

PROJ. NO.

ST-STP 2508(1)S

SHEET

17

OF



42

SHEETS

TEMPORARY 4in YELLOW LINE (PAINT)	
4in YELLOW LINE	
STA 97+00 TO 108+00	SOLID LT&RT
TEMPORARY 4in WHITE LINE (PAINT)	
4in WHITE LINE	
STA 97+00 TO 108+00	SOLID LT&RT
STA 97+00 TO 97+75	SOLID LT
STA 97+75 TO 99+15	DOTTED LT

TEMPORARY LETTER OR SYMBOL (PAINT)	
STA 97+67 LT	
LETTER OR SYMBOL	
STA 97+67 LT	

REMOVING SIGNS
2

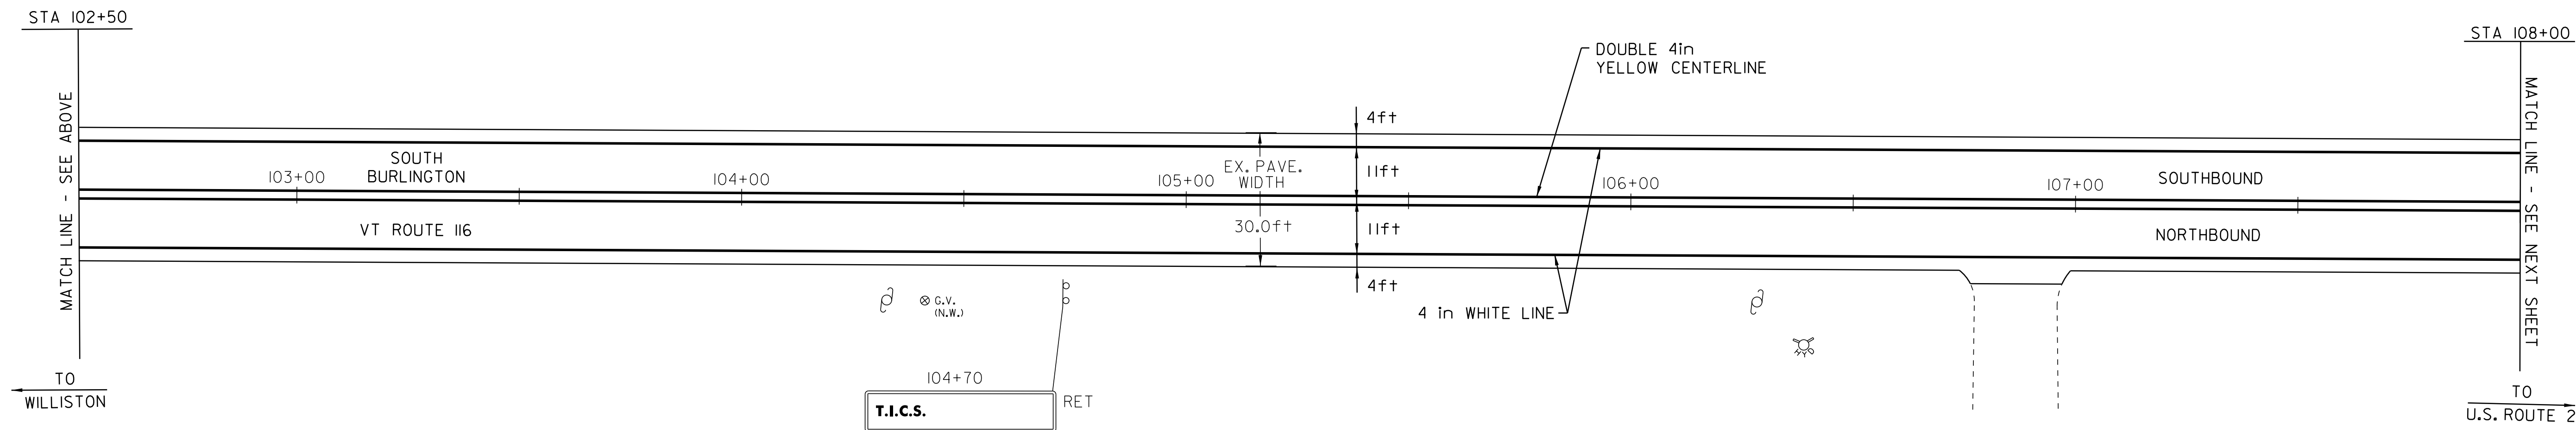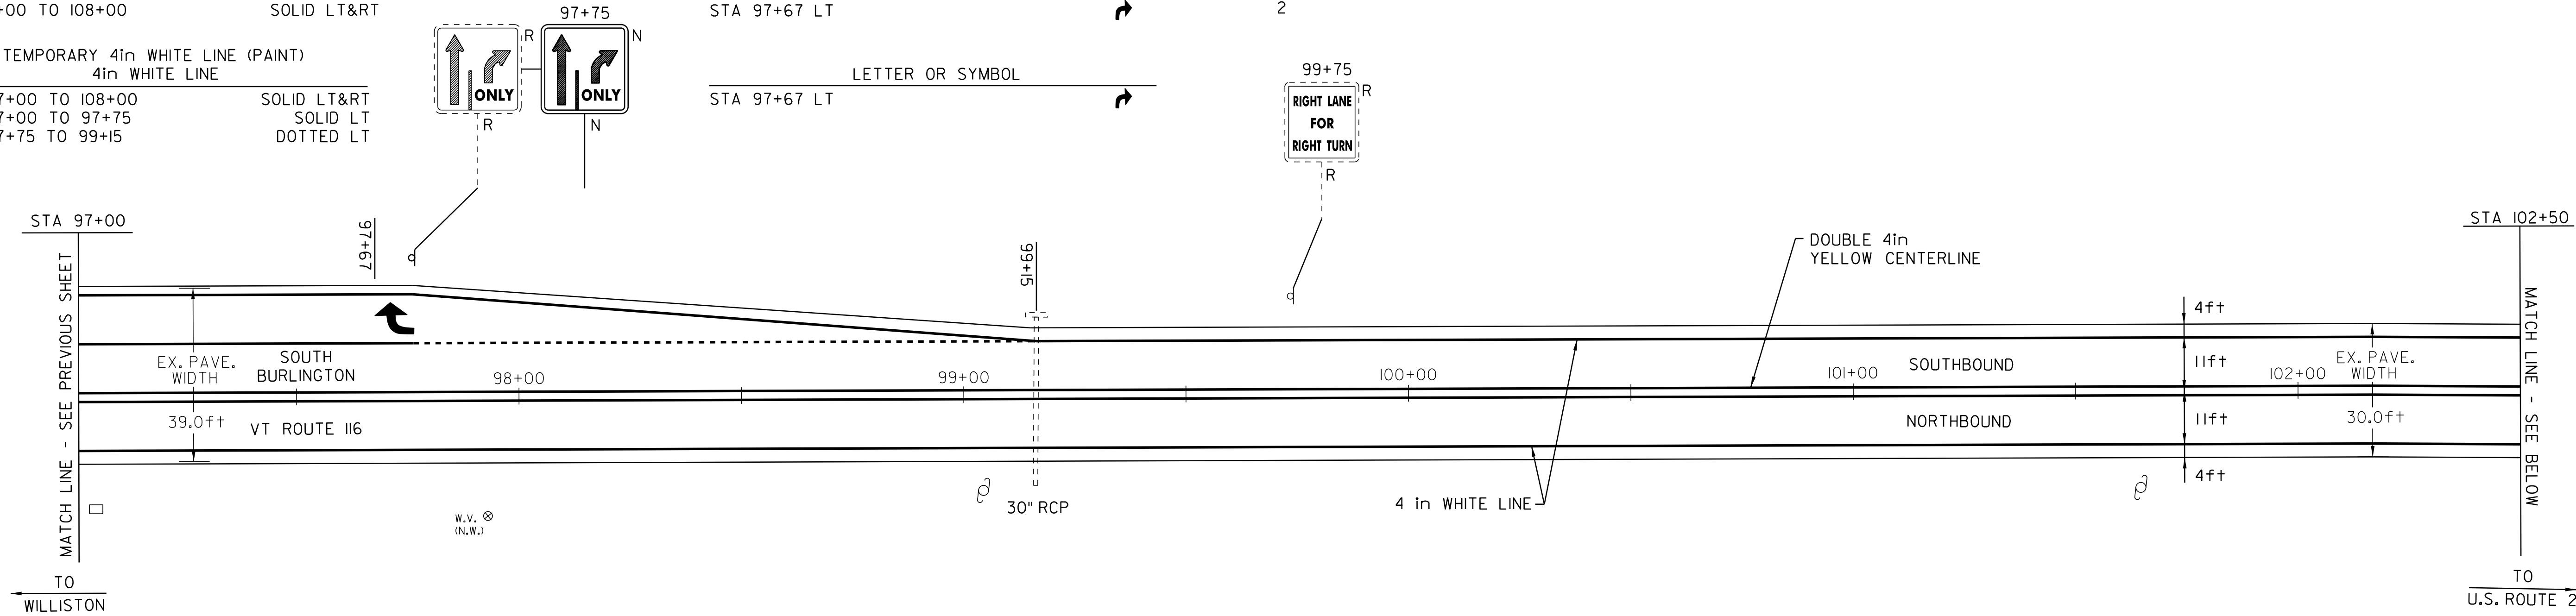

104+70

T.I.C.S.

RET

T.I.C.S.

RET



T.I.C.S.

RET

1160
0414
0200

RET

RET

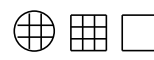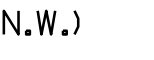LEGEND	
N	= NEW
R	= REMOVE
R&S	= REMOVE & SALVAGE
S	= SALVAGE
RET	= RETAIN
B-TO-B	= BACK TO BACK
	CATCH BASIN/DI
	= NO WORK REQUIRED (TYP. FOR D.I.'S, & C.B.'S WHERE NOTED)
	YIELDING MARKER POST
	UTILITY POLE
	DRIVE

PAVING
PROJECT
LAYOUT
SHEET #9

DESIGNED BY

BCE/PJM

DATE

10-06

DRAWN BY

C.E.A., INC.

DATE

10-06

DESIGN FILE NO.

p05b052.dgn

PRF FILE

p05b0521a09

DATE PLOTTED

03-MAY-2012 17

PROJ. NAME

ST. GEORGE-SO. BURLINGTON

PROJ. NO.

ST-STP 2508(1)S


SHEET

18

OF

42

SHEETS

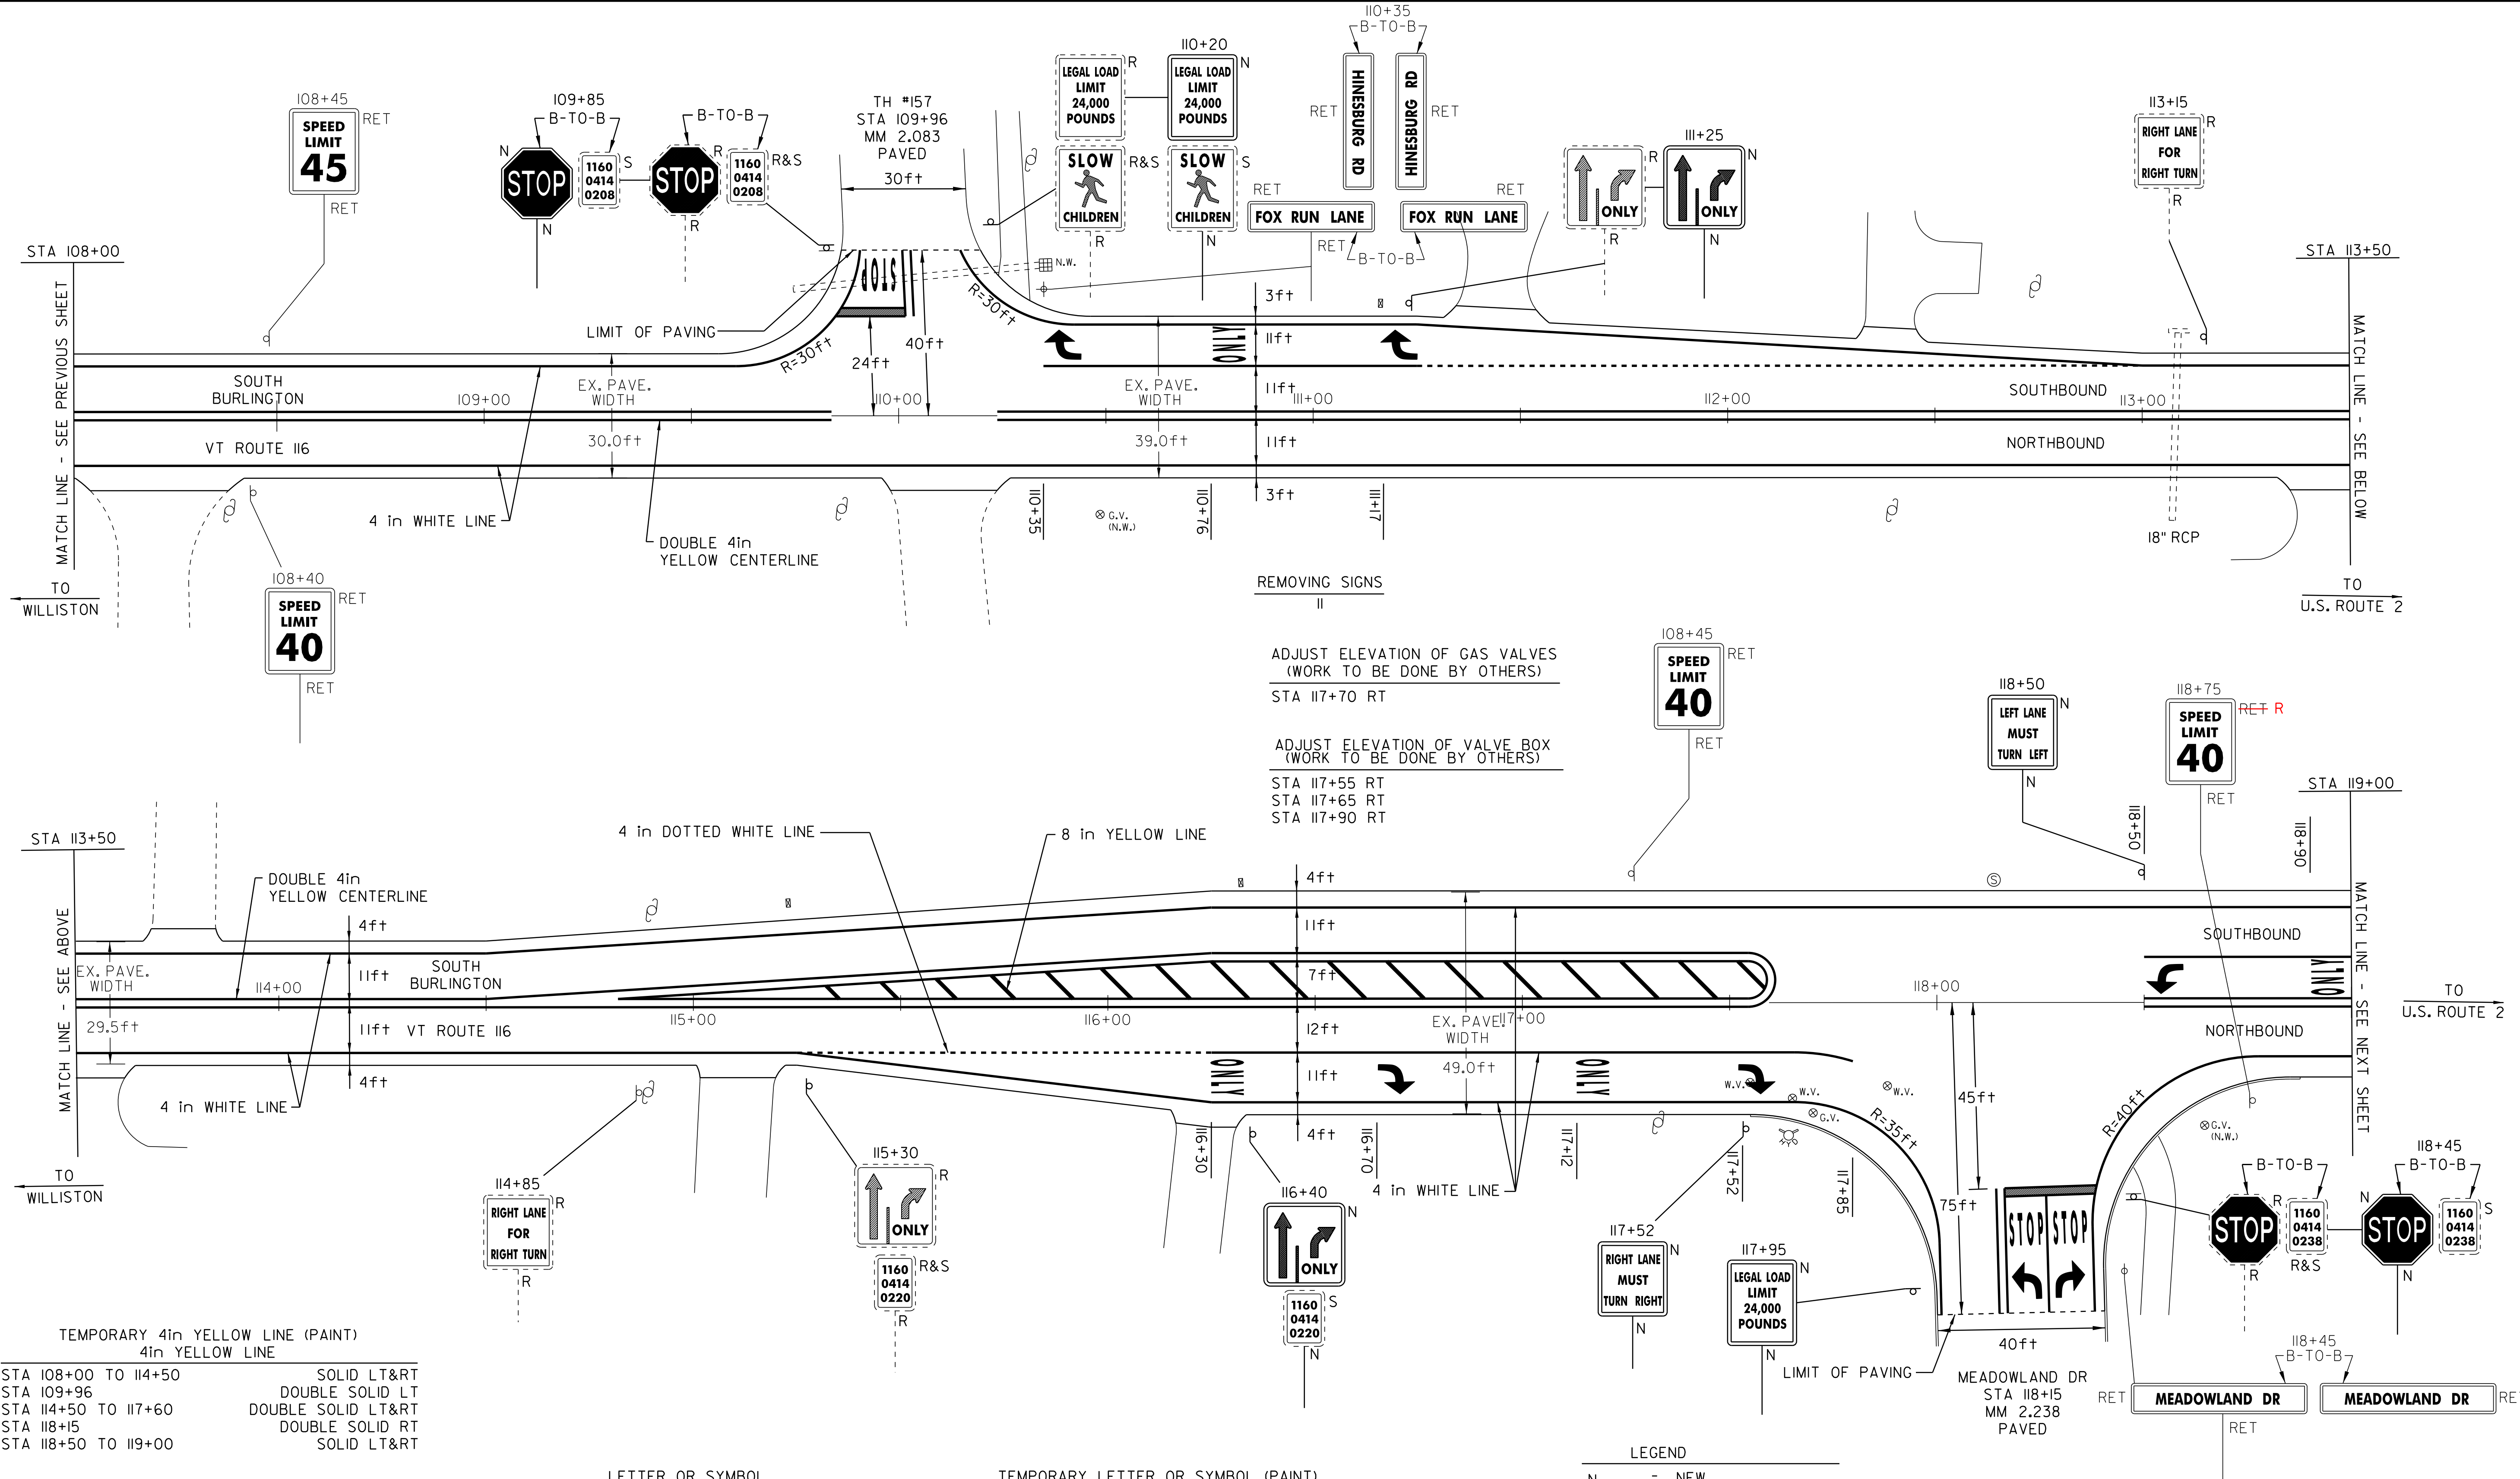

TEMPORARY 4in YELLOW LINE (PAINT)	
4in YELLOW LINE	
STA 108+00 TO 114+50	SOLID LT&RT
STA 109+96	DOUBLE SOLID LT
STA 114+50 TO 117+60	DOUBLE SOLID LT&RT
STA 118+15	DOUBLE SOLID RT
STA 118+50 TO 119+00	SOLID LT&RT

TEMPORARY 4in WHITE LINE (PAINT)	
4in WHITE LINE	
STA 108+00 TO 119+00	SOLID LT&RT
STA 110+35 TO 113+25	SOLID LT
STA 113+25 TO 113+00	DOTTED LT
STA 115+30 TO 116+30	DOTTED RT
STA 116+30 TO 117+85	SOLID RT

TEMPORARY 24in STOP BAR (PAINT)	
24in STOP BAR	
STA 109+96 RT	TH #157
STA 118+50 LT	MEADOWLAND DR

LETTER OR SYMBOL	
STA 109+96 LT	"STOP"
STA 110+35 LT	"ONLY"
STA 110+76 LT	"ONLY"
STA 113+17 LT	"ONLY"
STA 116+30 RT	"ONLY"
STA 116+70 RT	"ONLY"
STA 117+12 RT	"ONLY"
STA 117+52 RT	"ONLY"
STA 118+15 RT	"ONLY"
STA 118+50 LT	"ONLY"
STA 118+90 LT	"ONLY"

TEMPORARY LETTER OR SYMBOL (PAINT)	
STA 109+96 LT	"STOP"
STA 110+35 LT	"ONLY"
STA 113+17 LT	"ONLY"
STA 116+70 RT	"ONLY"
STA 117+52 RT	"ONLY"
STA 118+15 RT	"ONLY"
STA 118+50 LT	"ONLY"
8in YELLOW LINE	
PAINTED ISLAND	

LEGEND	
N	= NEW
R	= REMOVE
R&S	= REMOVE & SALVAGE
S	= SALVAGE
RET	= RETAIN
B-T-O-B	= BACK TO BACK
⊕ ⊞ ⊠	CATCH BASIN/DI
(N.W.)	= NO WORK REQUIRED (TYP. FOR D.I.'S, & C.B.'S WHERE NOTED)
⊕	YIELDING MARKER POST
⊕	UTILITY POLE
⊕	DRIVE

PAVING
PROJECT
LAYOUT
SHEET #10

DESIGNED BY

BCE/PJM

DATE

10-06

DRAWN BY

C.E.A., INC.

DATE

10-06

DESIGN FILE NO.

p05b052.dgn

PRF

p05b052la10

DATE

10-06

PLOTTED

03-MAY-2012

PROJ. NAME

ST. GEORGE-SO. BURLINGTON

PROJ. NO.

ST-STP 2508(1)S

SHEET

19

OF

42

SHEETS

TEMPORARY 4in YELLOW LINE (PAINT)		
STA 119+00 TO 121+25		SOLID LT&RT
STA 121+25 TO 124+50		DOUBLE SOLID LT&RT
STA 124+50 TO 130+00		SOLID LT&RT
STA 129+00 TO 130+00		DOUBLE SOLID LT

TEMPORARY 4in WHITE LINE (PAINT)		
STA 119+00 TO 130+00		SOLID LT&RT
STA 119+00 TO 120+50		SOLID LT
STA 120+50 TO 122+20		DOTTED LT
STA 129+00 TO 130+00		DOTTED RT



LETTER OR SYMBOL
STA 120+02 LT
STA 120+42 LT
“ONLY”

TEMPORARY LETTER OR SYMBOL (PAINT)
STA 120+02 LT

8in YELLOW LINE
STA 121+25 TO 124+50
STA 129+00 TO 130+00
PAINTED ISLAND
PAINTED ISLAND

REMOVING SIGNS
2

T.I.C.S.	RET
T.I.C.S.	RET
T.I.C.S.	RET
RET	RET

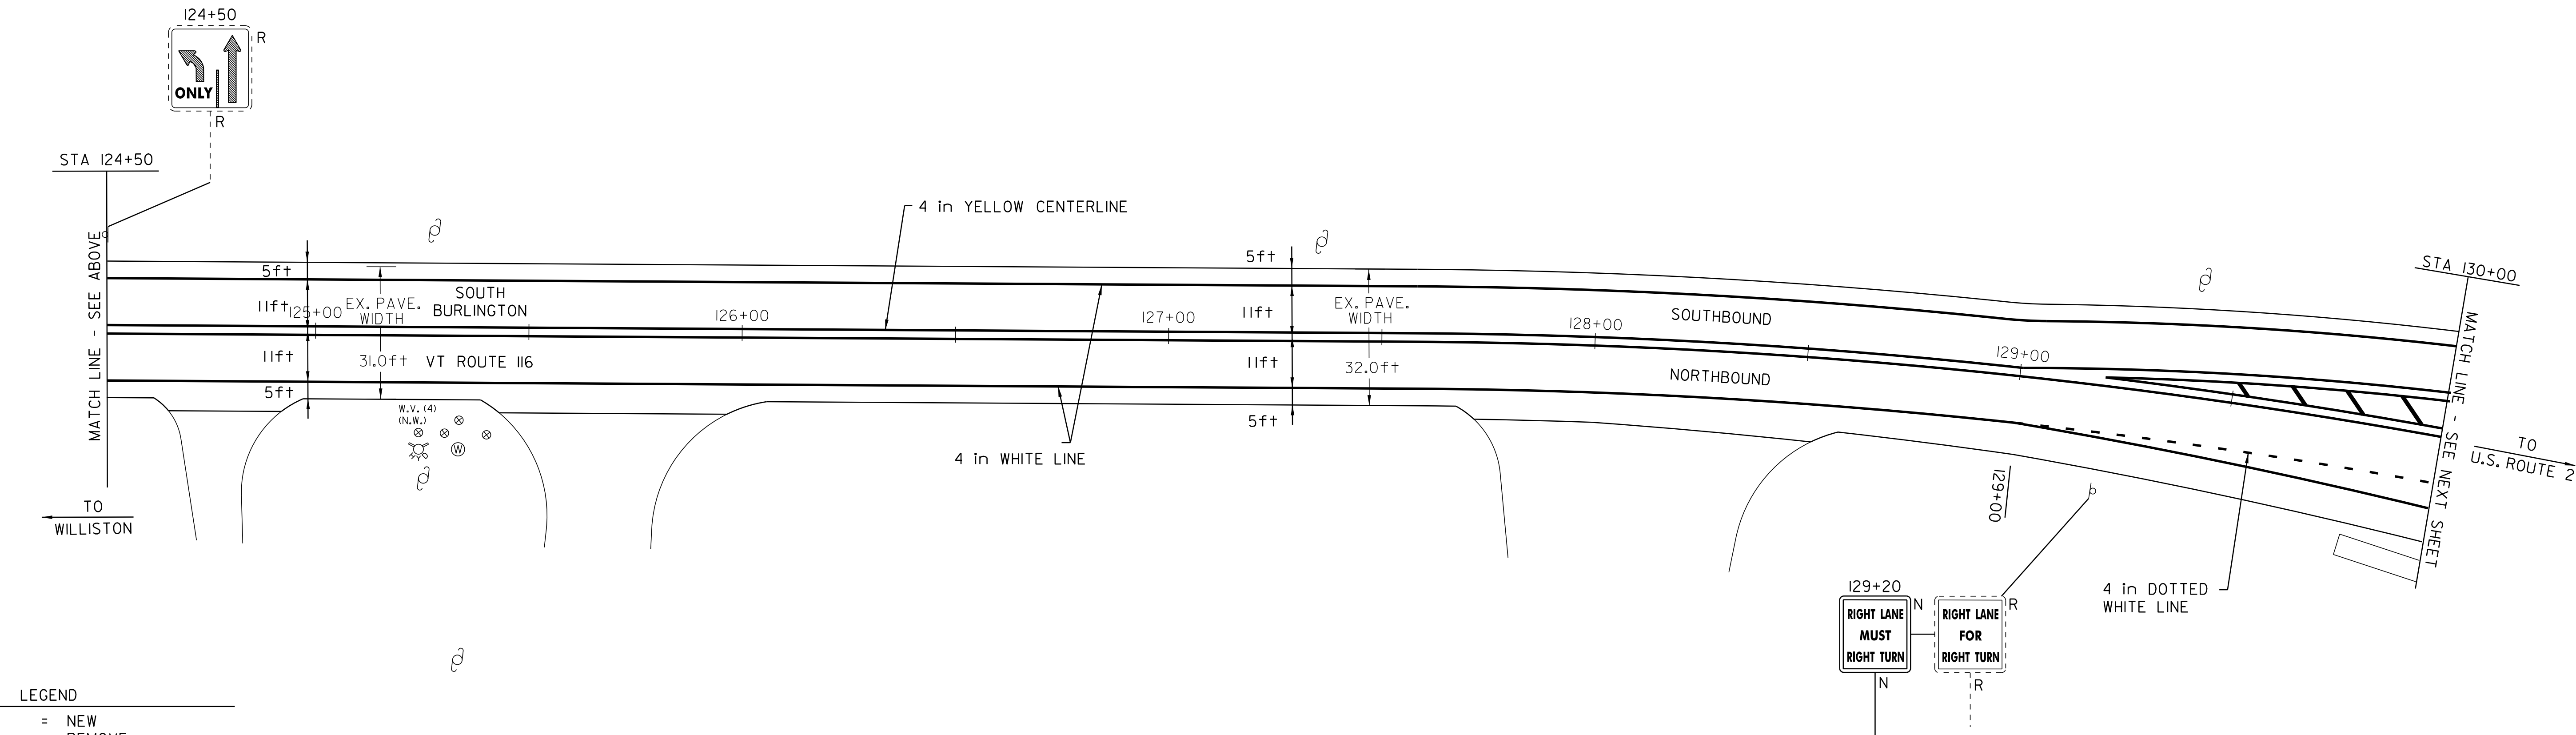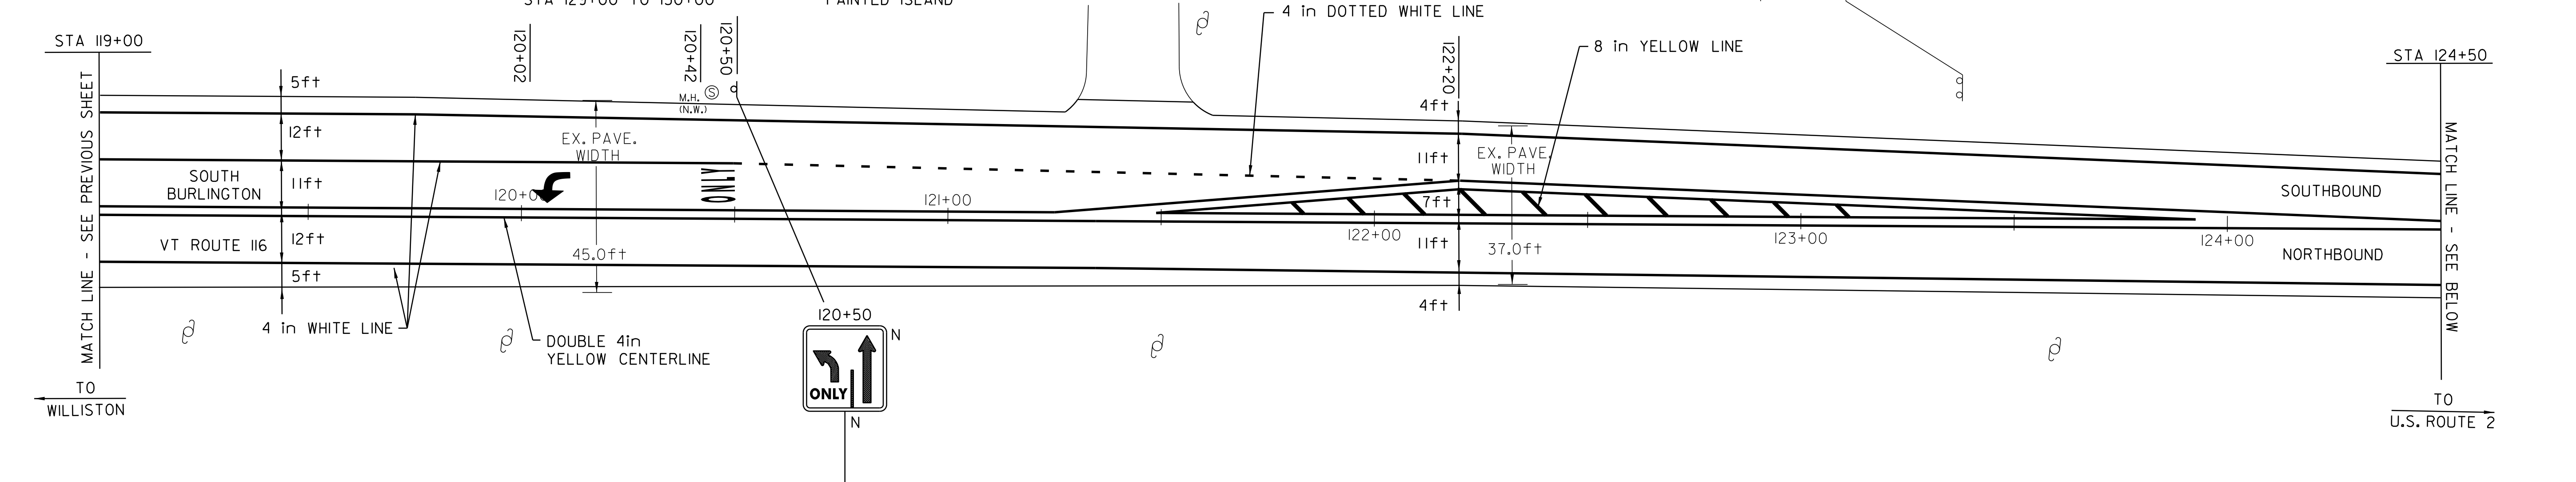

LEGEND	
N	= NEW
R	= REMOVE
R&S	= REMOVE & SALVAGE
S	= SALVAGE
RET	= RETAIN
B-TO-B	= BACK TO BACK
⊕ ⊞ □	CATCH BASIN/DI
(N.W.)	= NO WORK REQUIRED (TYP. FOR D.I.'S, & C.B.'S WHERE NOTED)
⊕	YIELDING MARKER POST
⊕	UTILITY POLE
⊕	DRIVE

PAVING
PROJECT
LAYOUT
SHEET #11

DESIGNED BY

BCE/PJM

DATE

10-06

DRAWN BY

C.E.A., INC.

DATE

10-06

DESIGN FILE NO.

p05b052.dgn

PRF
FILE

p05b052a01

DATE
PLOTTED

03-MAY-2012 17

PROJ. NAME

ST. GEORGE-SO. BURLINGTON

PROJ. NO.

ST-STP 2508(1)S

SHEET


20

OF

42

SHEETS

TEMPORARY 4in YELLOW LINE (PAINT)		TEMPORARY 4in WHITE LINE (PAINT)		LETTER OR SYMBOL		TEMPORARY LETTER OR SYMBOL (PAINT)		TEMPORARY 24in STOP BAR (PAINT)	
4in YELLOW LINE		4in WHITE LINE						24in STOP BAR	
STA 130+00 TO 141+00	SOLID LT&RT	STA 130+00 TO 141+00	SOLID LT&RT	STA 131+00 RT	"ONLY"	STA 131+40 RT		STA 133+45 RT	(VERIZON)
STA 130+00 TO 133+25	DOUBLE SOLID LT	STA 130+00 TO 131+00	DOTTED RT	STA 131+40 RT	"ONLY"	STA 132+92 RT			
STA 133+45	DOUBLE SOLID RT	STA 131+00 TO 133+35	SOLID RT	STA 132+52 RT	"STOP"	STA 133+45 RT			
STA 134+70 TO 138+00	DOUBLE SOLID LT	STA 133+70 TO 134+70	SOLID LT	STA 132+92 RT	"ONLY"	STA 133+70 LT			
(WITH CENTERLINE BREAKS FOR TOWN HIGHWAYS)		STA 134+70 TO 136+35	DOTTED LT	STA 133+45 RT		STA 134+62 LT			
		(WITH EDGE LINE BREAKS FOR TOWN HIGHWAYS)		STA 133+70 LT					
				STA 134+16 LT					
				STA 134+62 LT					
REMOVING SIGNS	ERECTING SALVAGED SIGNS								
5	1								

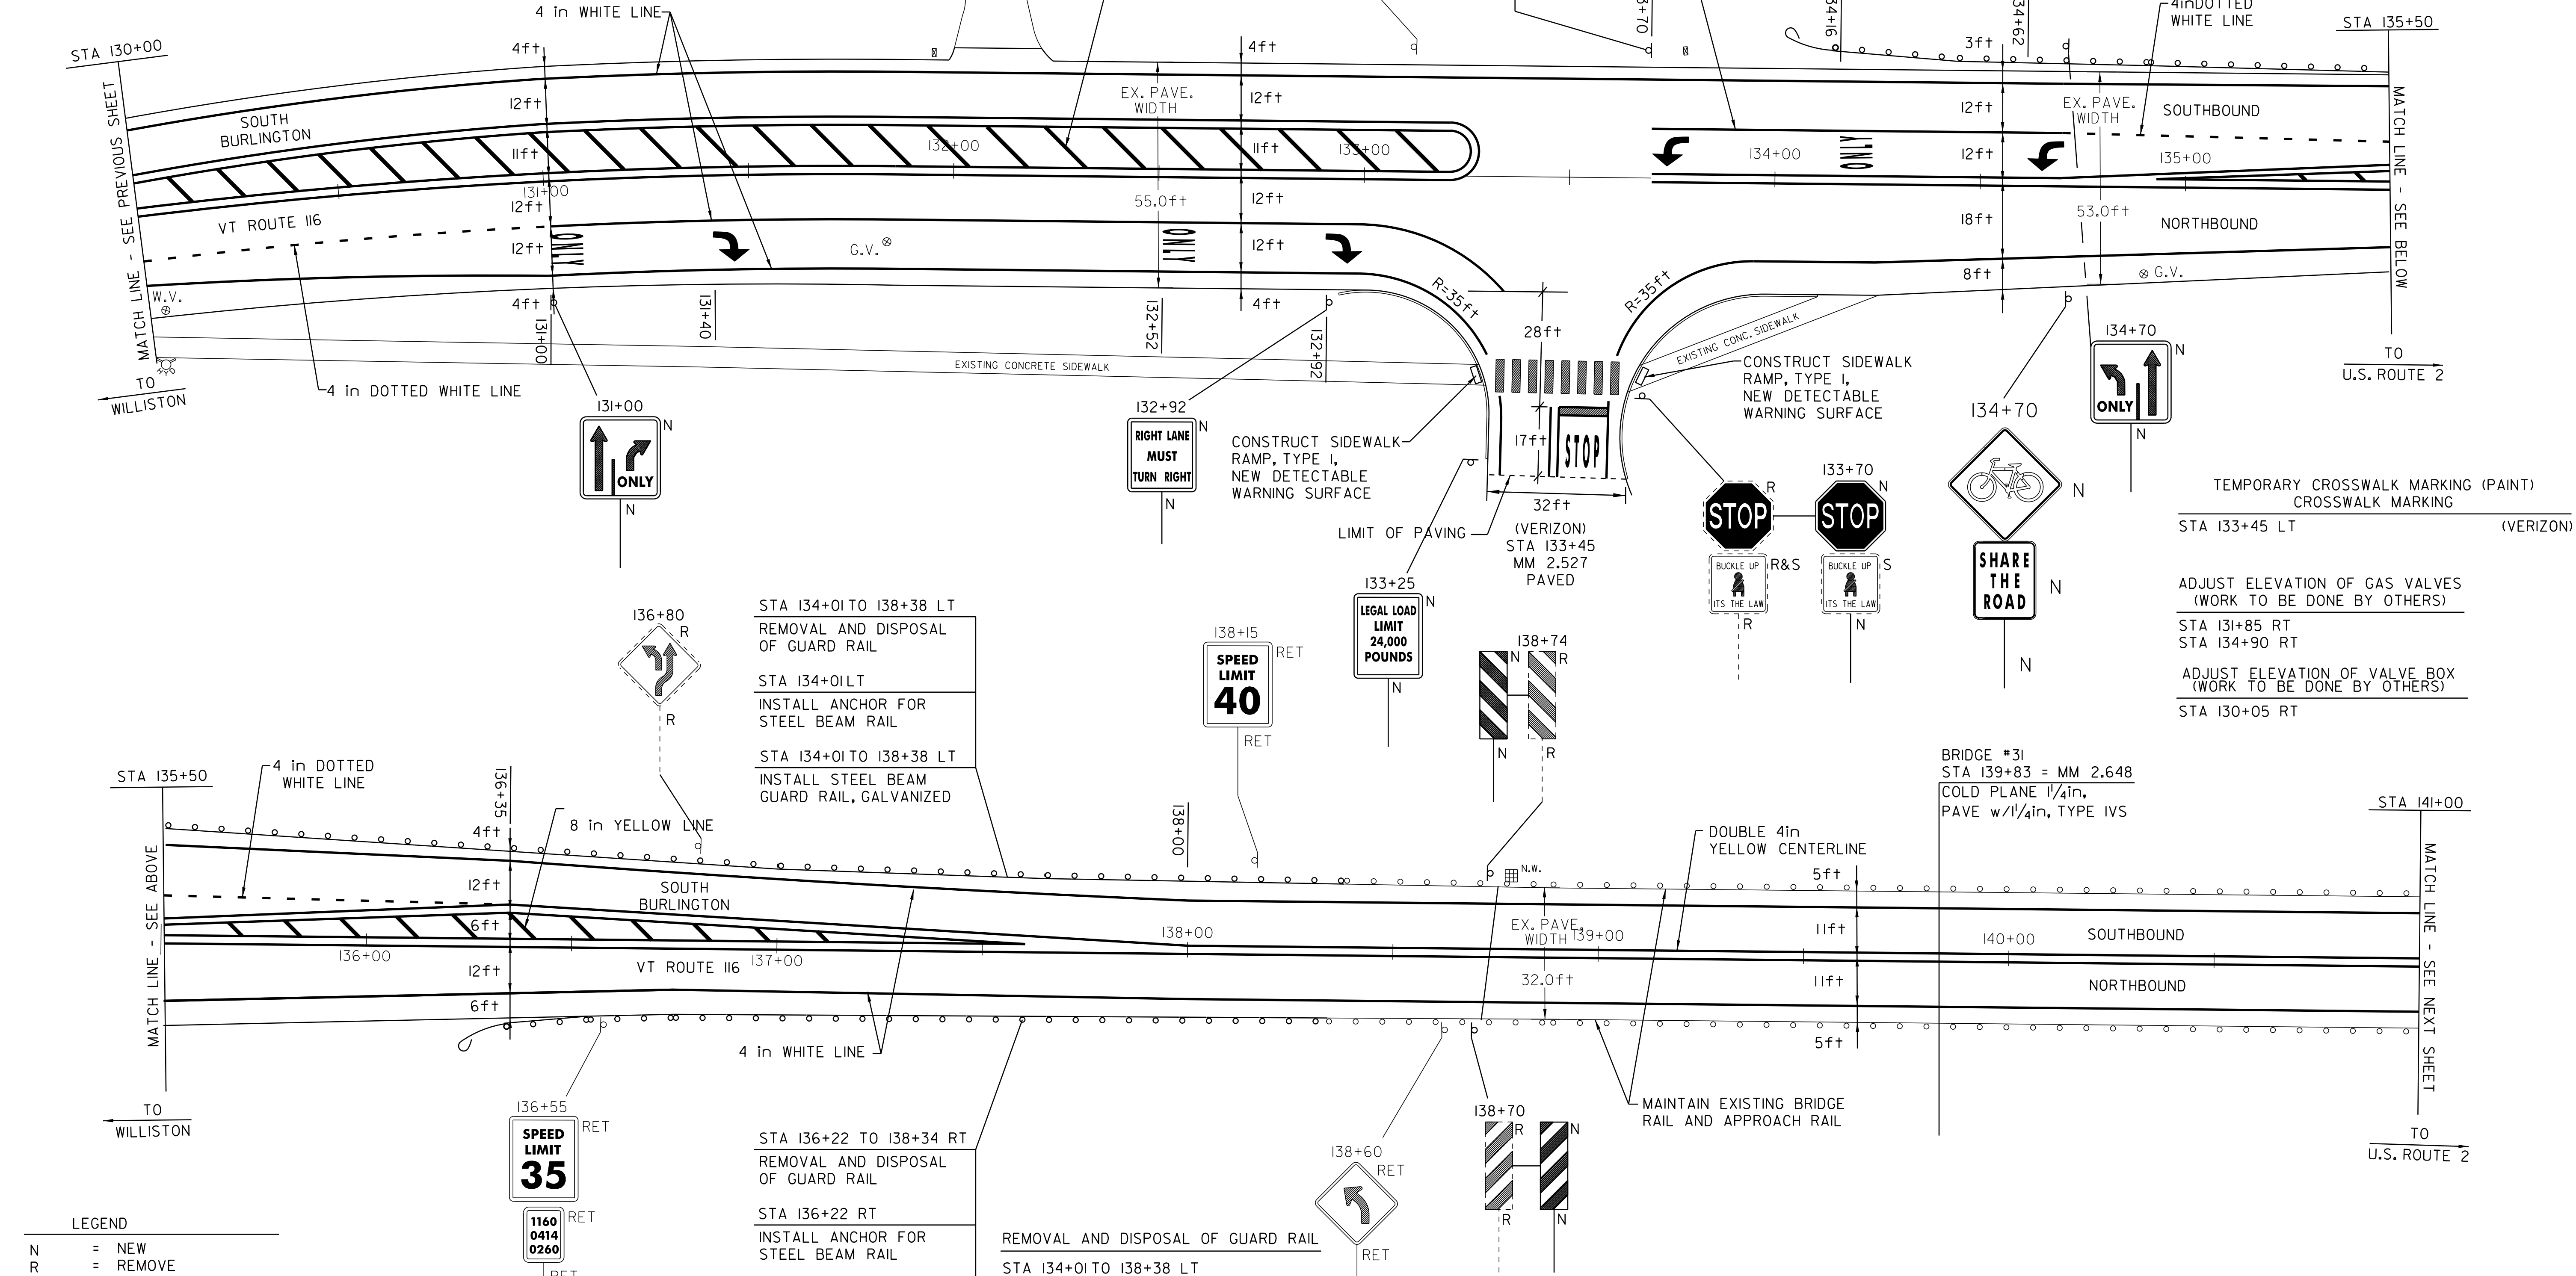

LEGEND

N = NEW
R = REMOVE
R&S = REMOVE & SALVAGE
S = SALVAGE
RET = RETAIN
B-TO-B = BACK TO BACK

⊕ □ □ CATCH BASIN/DI
(N.W.) = NO WORK REQUIRED
(TYP. FOR D.I.'S. &
C.B.'S WHERE NOTED)

YIELDING MARKER POST
UTILITY POLE
DRIVE

STA 134+01 TO 138+38 LT
REMOVAL AND DISPOSAL
OF GUARD RAIL

STA 134+01 LT
INSTALL ANCHOR FOR
STEEL BEAM RAIL

STA 134+01 TO 138+38 LT
INSTALL STEEL BEAM
GUARD RAIL, GALVANIZED

STA 136+22 TO 138+34 RT
REMOVAL AND DISPOSAL
OF GUARD RAIL

STA 136+22 RT
INSTALL ANCHOR FOR
STEEL BEAM RAIL

STA 136+22 TO 138+34 RT
INSTALL STEEL BEAM
GUARD RAIL, GALVANIZED

REMOVAL AND DISPOSAL OF GUARD RAIL

STA 134+01 TO 138+38 LT
STA 136+22 TO 138+34 RT

ANCHOR FOR STEEL BEAM RAIL

STA 134+01 LT
STA 136+22 RT

STEEL BEAM GUARD RAIL, GALVANIZED

STA 134+01 TO 138+38 LT
STA 136+22 TO 138+34 RT

PAVING PROJECT LAYOUT SHEET #12

DESIGNED BY BCE/PJM DATE 10-06

DRAWN BY C.E.A., INC. DATE 10-06


DESIGN FILE NO. p05b052.dgn

PRF FILE p05b052d12 DATE 10-06
PLOTTED 03-MAY-2012 17

PROJ. NAME **ST. GEORGE-SO. BURLINGTON**

PROJ. NO. **ST-STP 2508(1)S**

SHEET **21** OF **42** SHEETS

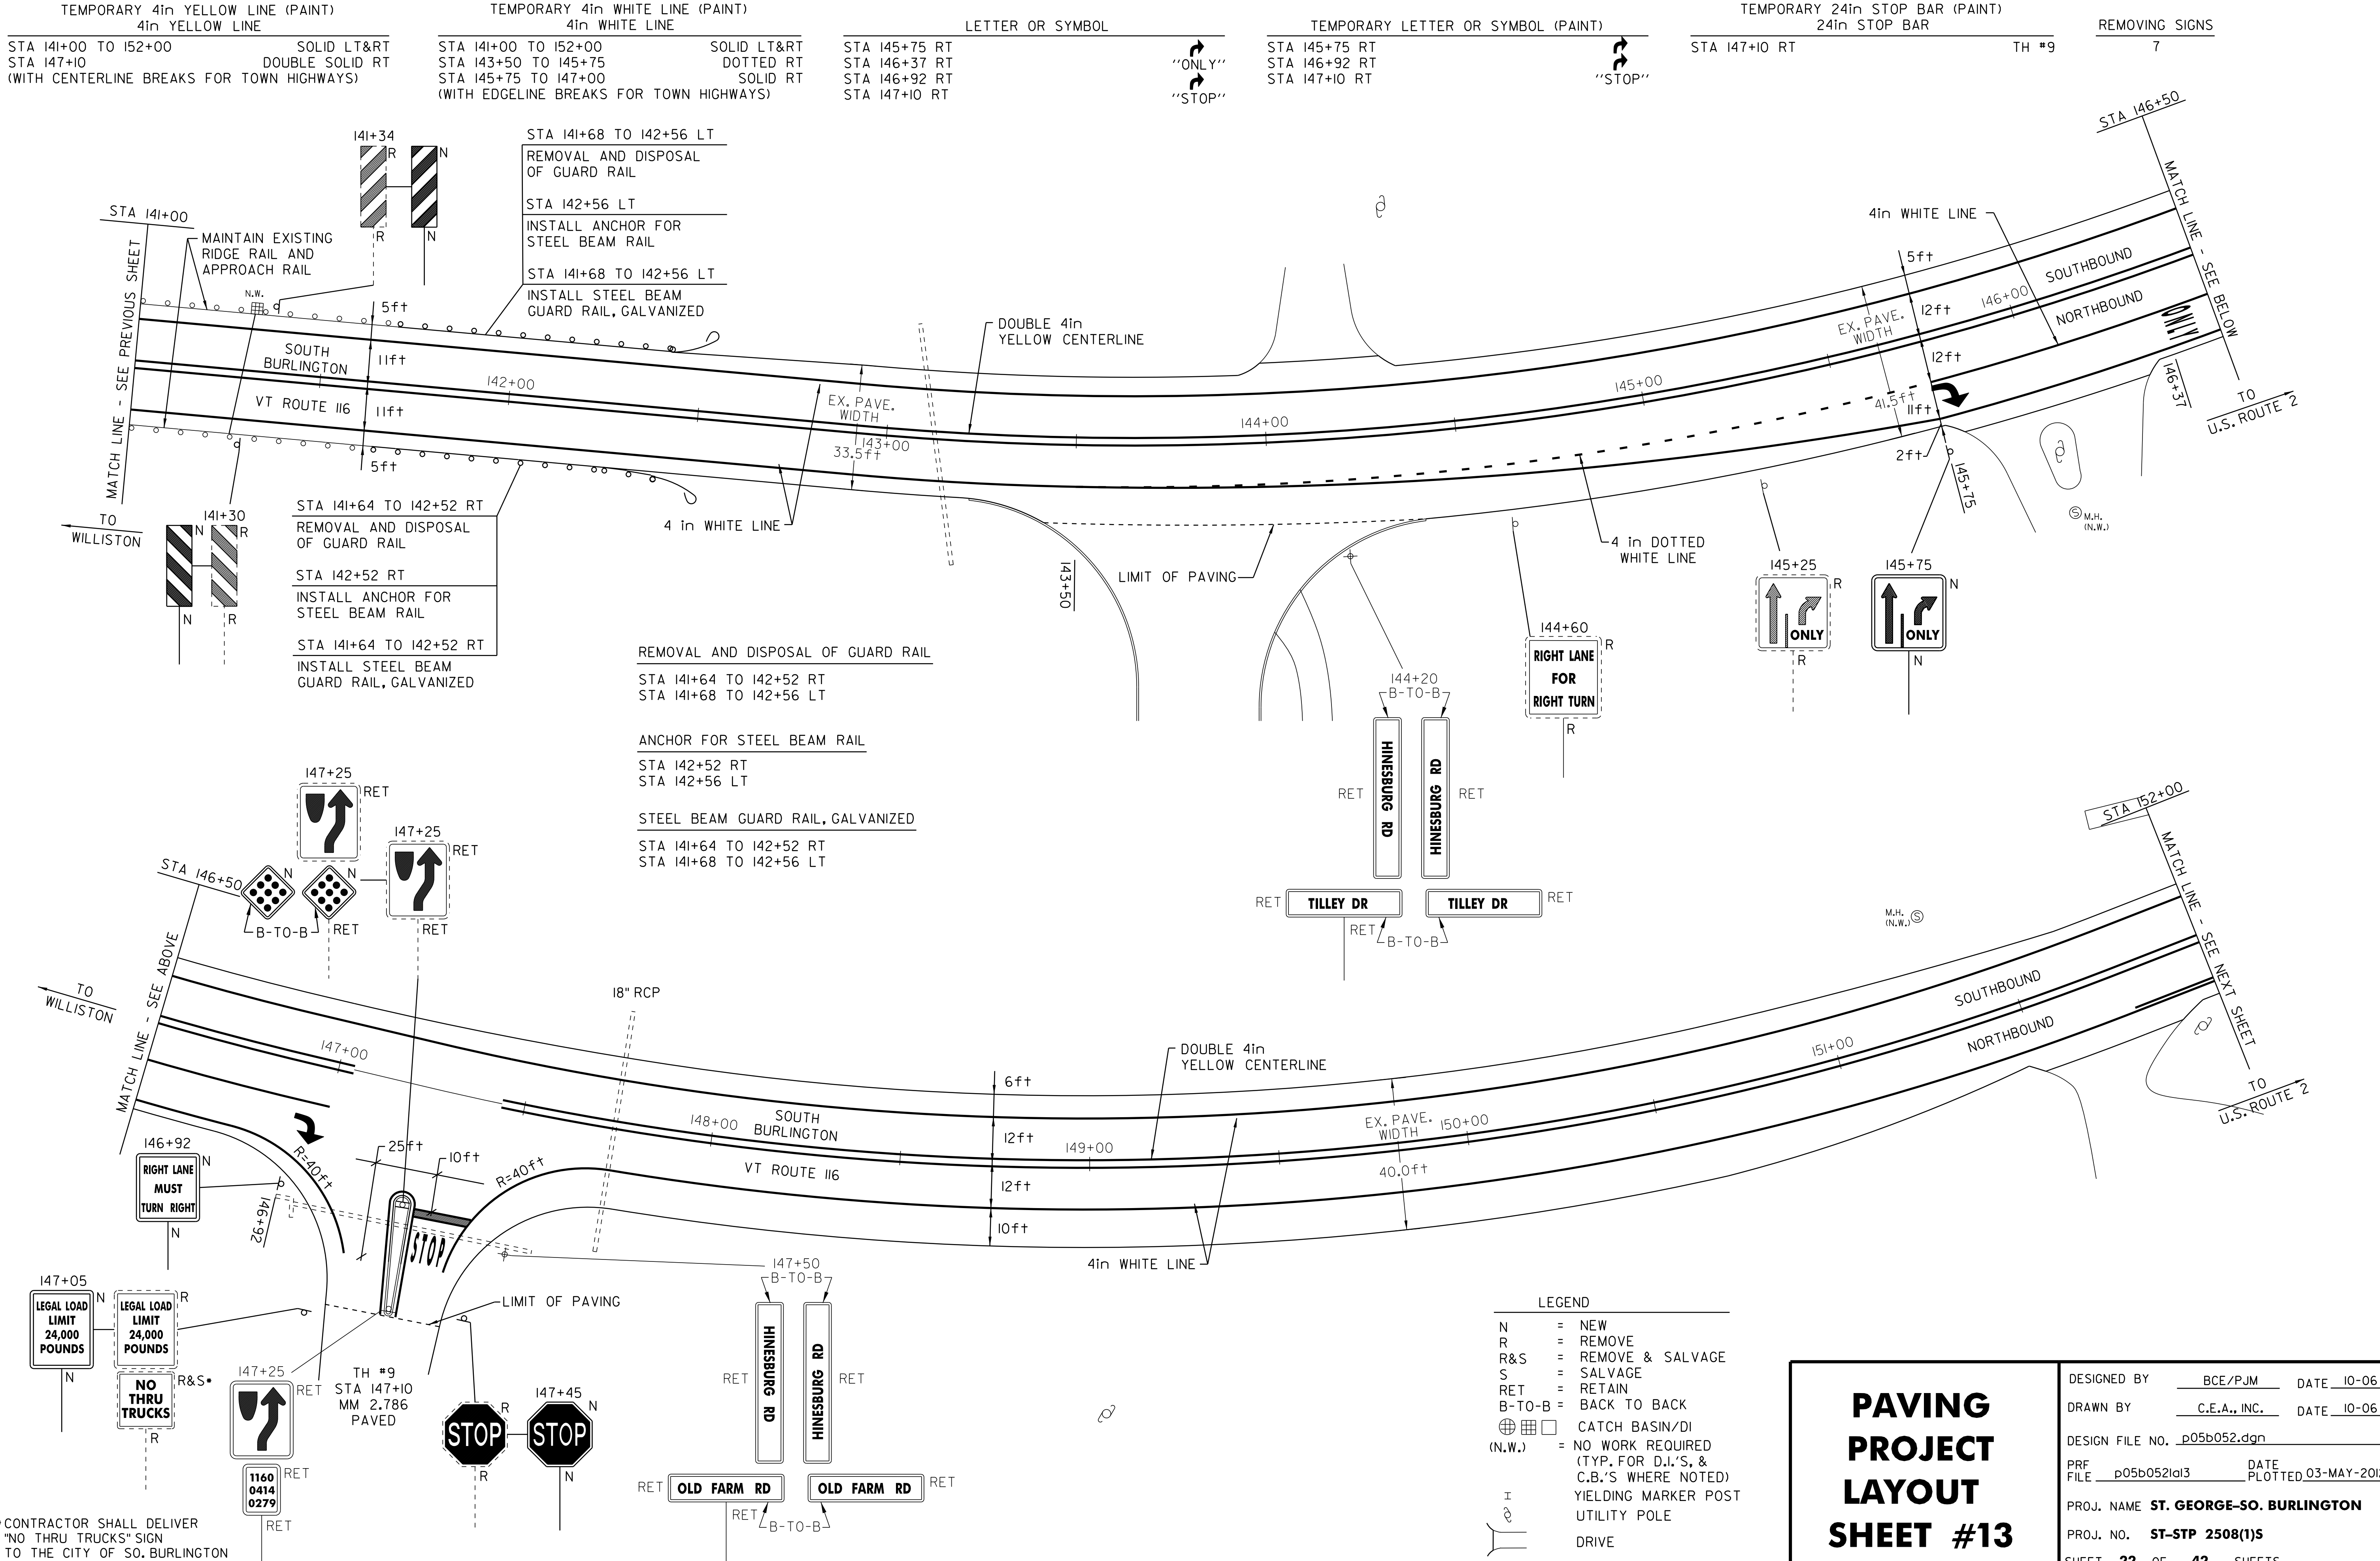

*CONTRACTOR SHALL DELIVER "NO THRU TRUCKS" SIGN TO THE CITY OF SO. BURLINGTON

- LEGEND
- N = NEW
 - R = REMOVE
 - R&S = REMOVE & SALVAGE
 - S = SALVAGE
 - RET = RETAIN
 - B-T-O-B = BACK TO BACK
 - ⊕ ⊞ ⊠ = CATCH BASIN/DI (N.W.)
 - = NO WORK REQUIRED (TYP. FOR D.I.'S, & C.B.'S WHERE NOTED)
 - ⊕ = YIELDING MARKER POST
 - ⊕ = UTILITY POLE
 - ⊕ = DRIVE

PAVING
PROJECT
LAYOUT
SHEET #13

DESIGNED BY

BCE/PJM

DATE

10-06

DRAWN BY

C.E.A., INC.

DATE

10-06

DESIGN FILE NO.

p05b052.dgn

PRF FILE

p05b052la13

DATE PLOTTED

03-MAY-2012 17

PROJ. NAME

ST. GEORGE-SO. BURLINGTON

PROJ. NO.

ST-STP 2508(1)S

SHEET

22

OF

42

SHEETS


TEMPORARY 4in WHITE LINE (PAINT)		
4in WHITE LINE		
STA 152+00 TO 163+00	SOLID	LT&RT
STA 155+90 TO 157+80	DOTTED	RT
STA 157+80 TO 159+60	SOLID	RT
STA 160+20 TO 161+20	SOLID	LT
STA 160+20 TO 162+15	SOLID	LT
STA 161+20 TO 162+15	DOTTED	LT
STA 162+15 TO 163+00	DOTTED	LT
(WITH EDGELINE BREAKS FOR TOWN HIGHWAYS)		

	LETTER	OR	SYMBOL
STA 157+80	RT		
STA 158+20	RT		
STA 159+12	RT		
STA 159+52	RT		
STA 159+80	RT		
STA 159+90	LT		
STA 160+20	RT		
STA 160+32	LT		
STA 160+60	RT		
STA 160+72	LT		
STA 161+12	LT		
STA 161+67	RT		
STA 162+07	RT		

TEMPORARY LETTER OR SYMBOL (PAINT)		
STA 158+20	RT	
STA 159+52	RT	
STA 159+80	RT	"STOP"
STA 159+90	LT	"STOP"
STA 160+20	RT	    
STA 160+32	LT	
STA 161+12	LT	
STA 161+67	RT	
STA 161+70	RT	

TEMPORARY 24in STOP BAR (PAINT)		
24in STOP BAR		
STA 159+80 RT		ELDRIDGE RD
STA 159+90 LT		TH #145
8in YELLOW LINE		
STA 154+00 TO 157+80		PAINTED ISLAND
STA 162+15 TO 163+00		PAINTED ISLAND
TEMPORARY CROSSWALK MARKING (PAINT)		
CROSSWALK MARKING		
STA 159+80 RT		ELDRIDGE RD
STA 159+90 LT		TH #145

REMOVING SIGNS

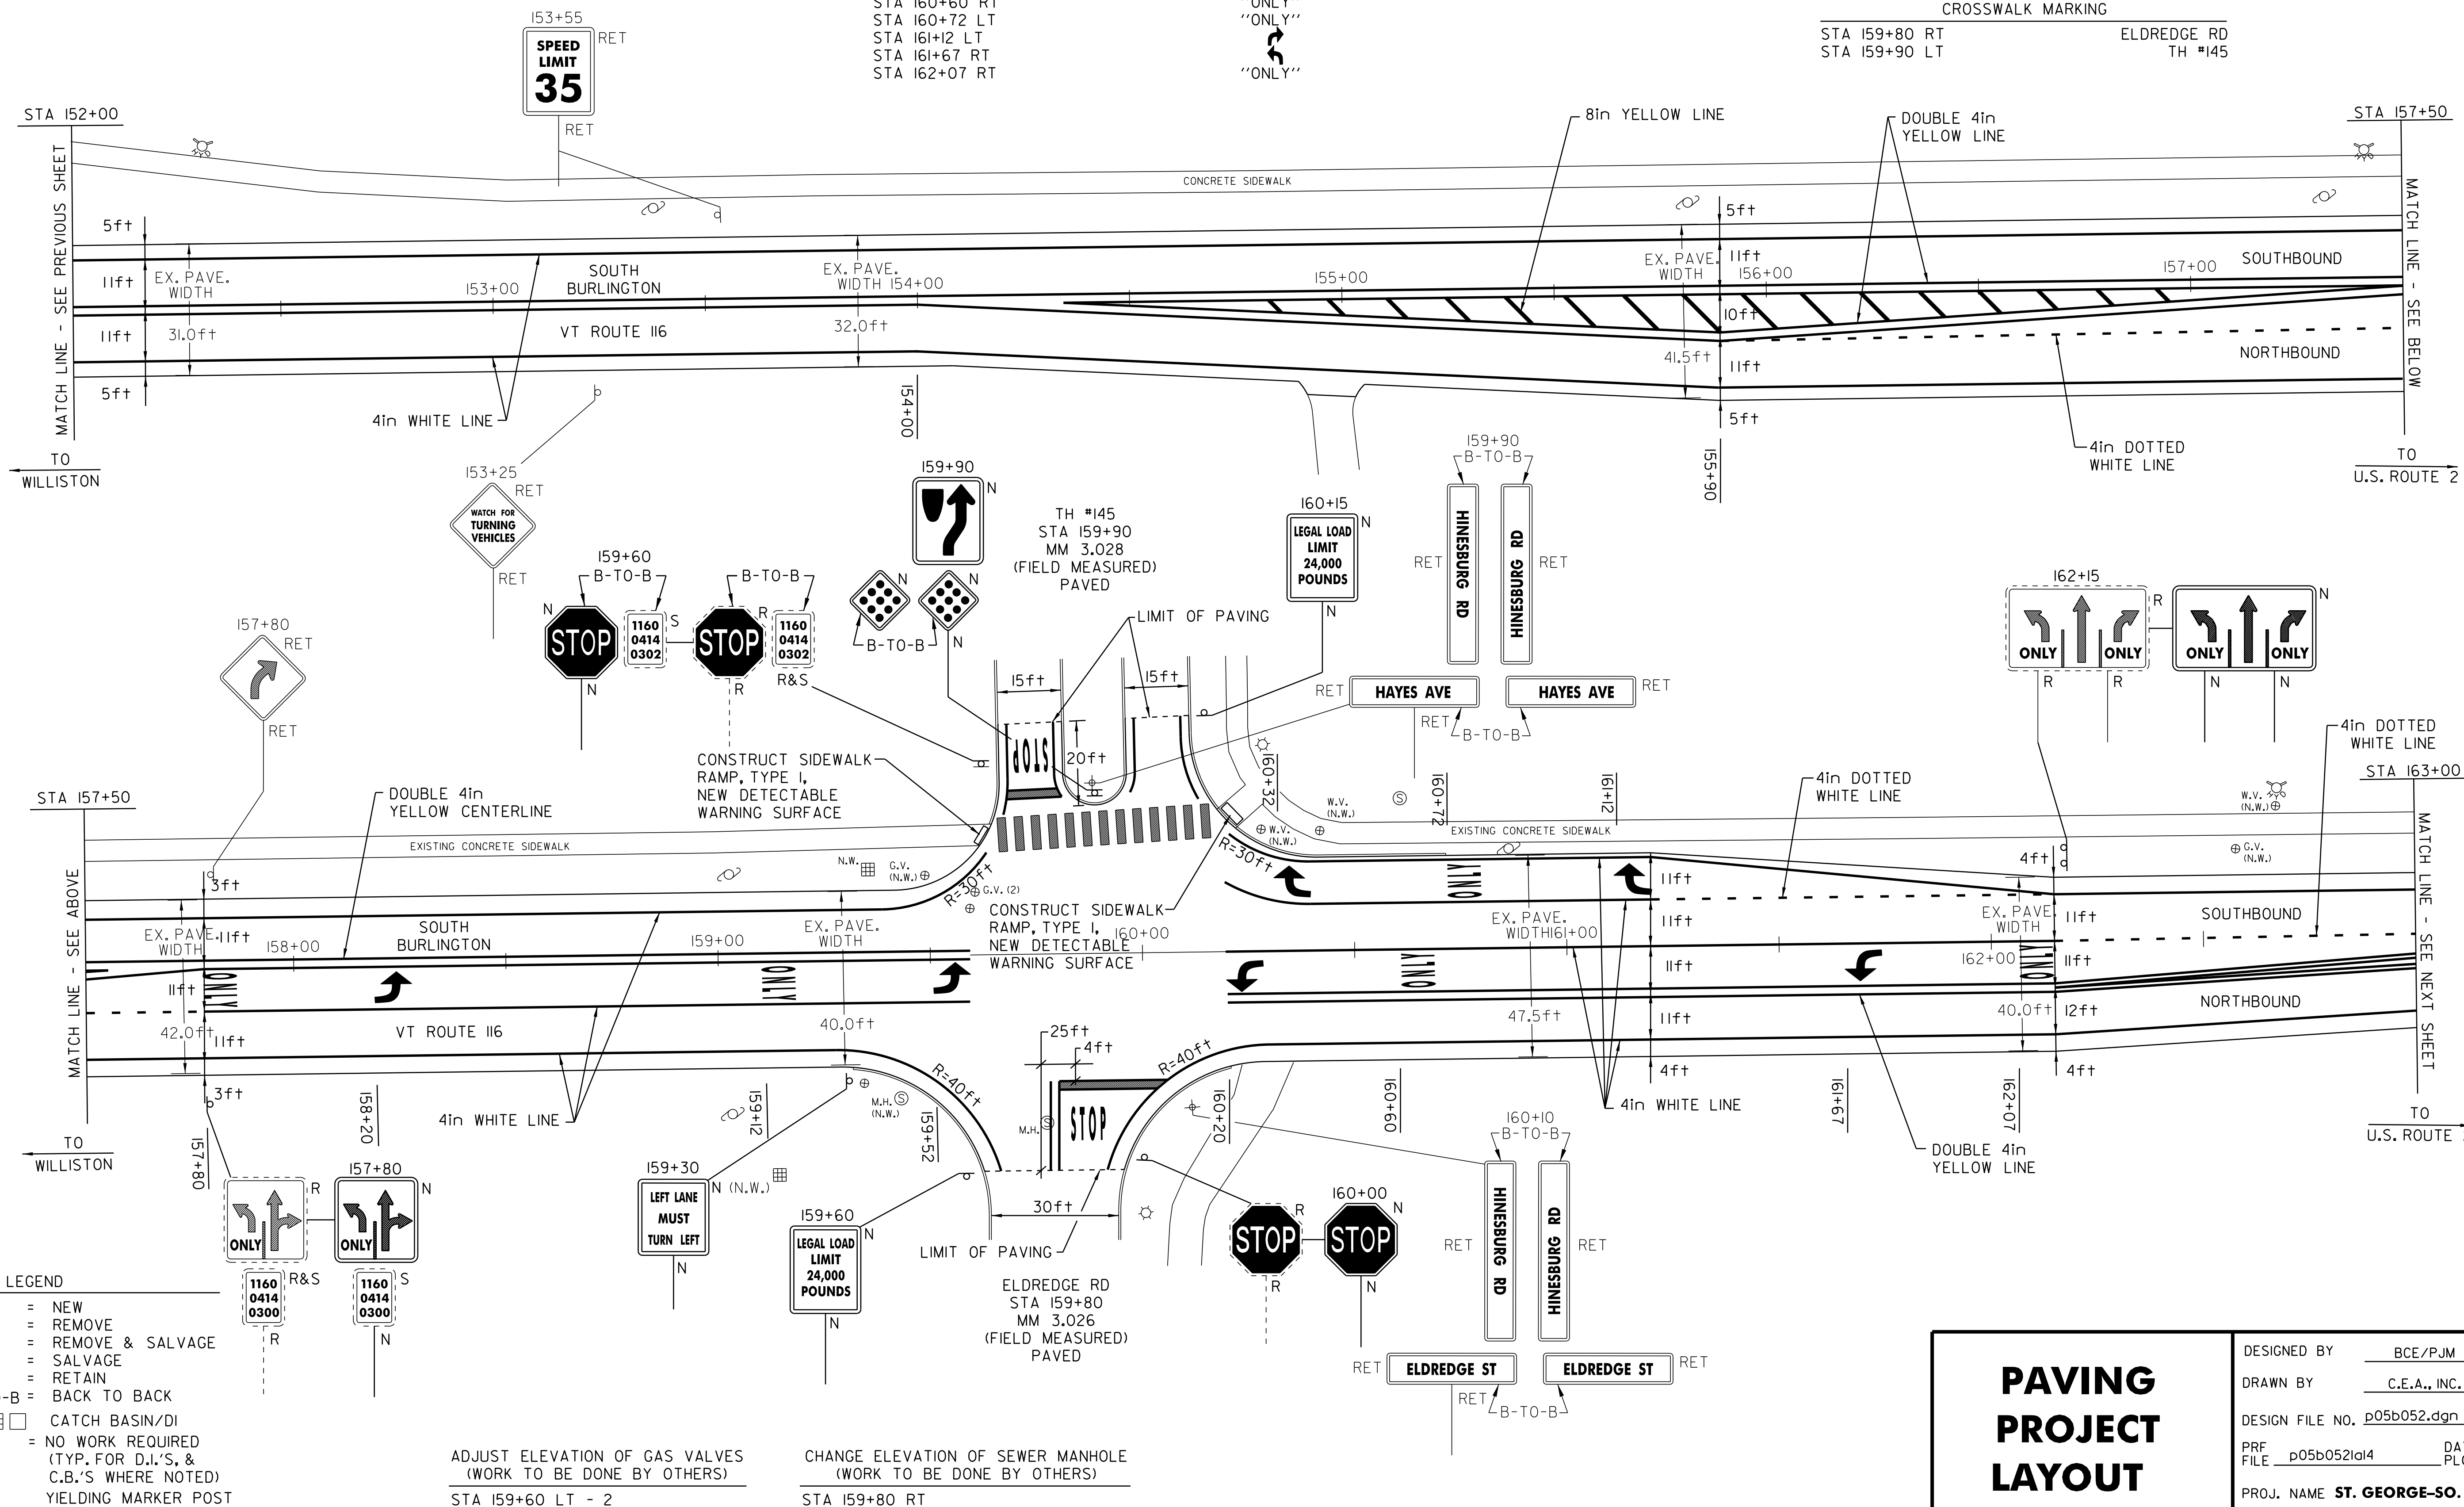

LEGEND	
N	= NEW
R	= REMOVE
R&S	= REMOVE & SALVAGE
S	= SALVAGE
RET	= RETAIN
B-TO-B	= BACK TO BACK
  	CATCH BASIN/DI
(N.W.)	= NO WORK REQUIRED (TYP. FOR D.J.'S, & C.B.'S WHERE NOTED
	YIELDING MARKER POS
	UTILITY POLE
	DRIVE

ADJUST ELEVATION OF GAS VALVES
(WORK TO BE DONE BY OTHERS)


STA 159+60 LT - 2

CHANGE ELEVATION OF SEWER MANHOLE
(WORK TO BE DONE BY OTHERS)

STA 159+80 RT

PAVING PROJECT LAYOUT SHEET #14

DESIGNED BY BCE/PJM DATE 10-06
DRAWN BY C.E.A., INC. DATE 10-06
DESIGN FILE NO. p05b052.dgn
PRF FILE p05b052a14 DATE 03-MAY-2012
PLOT
PROJ. NAME **ST. GEORGE-SO. BURLINGTON**
PROJ. NO. **ST-STP 2508(1)S**
SHEET **23** OF **42** SHEETS

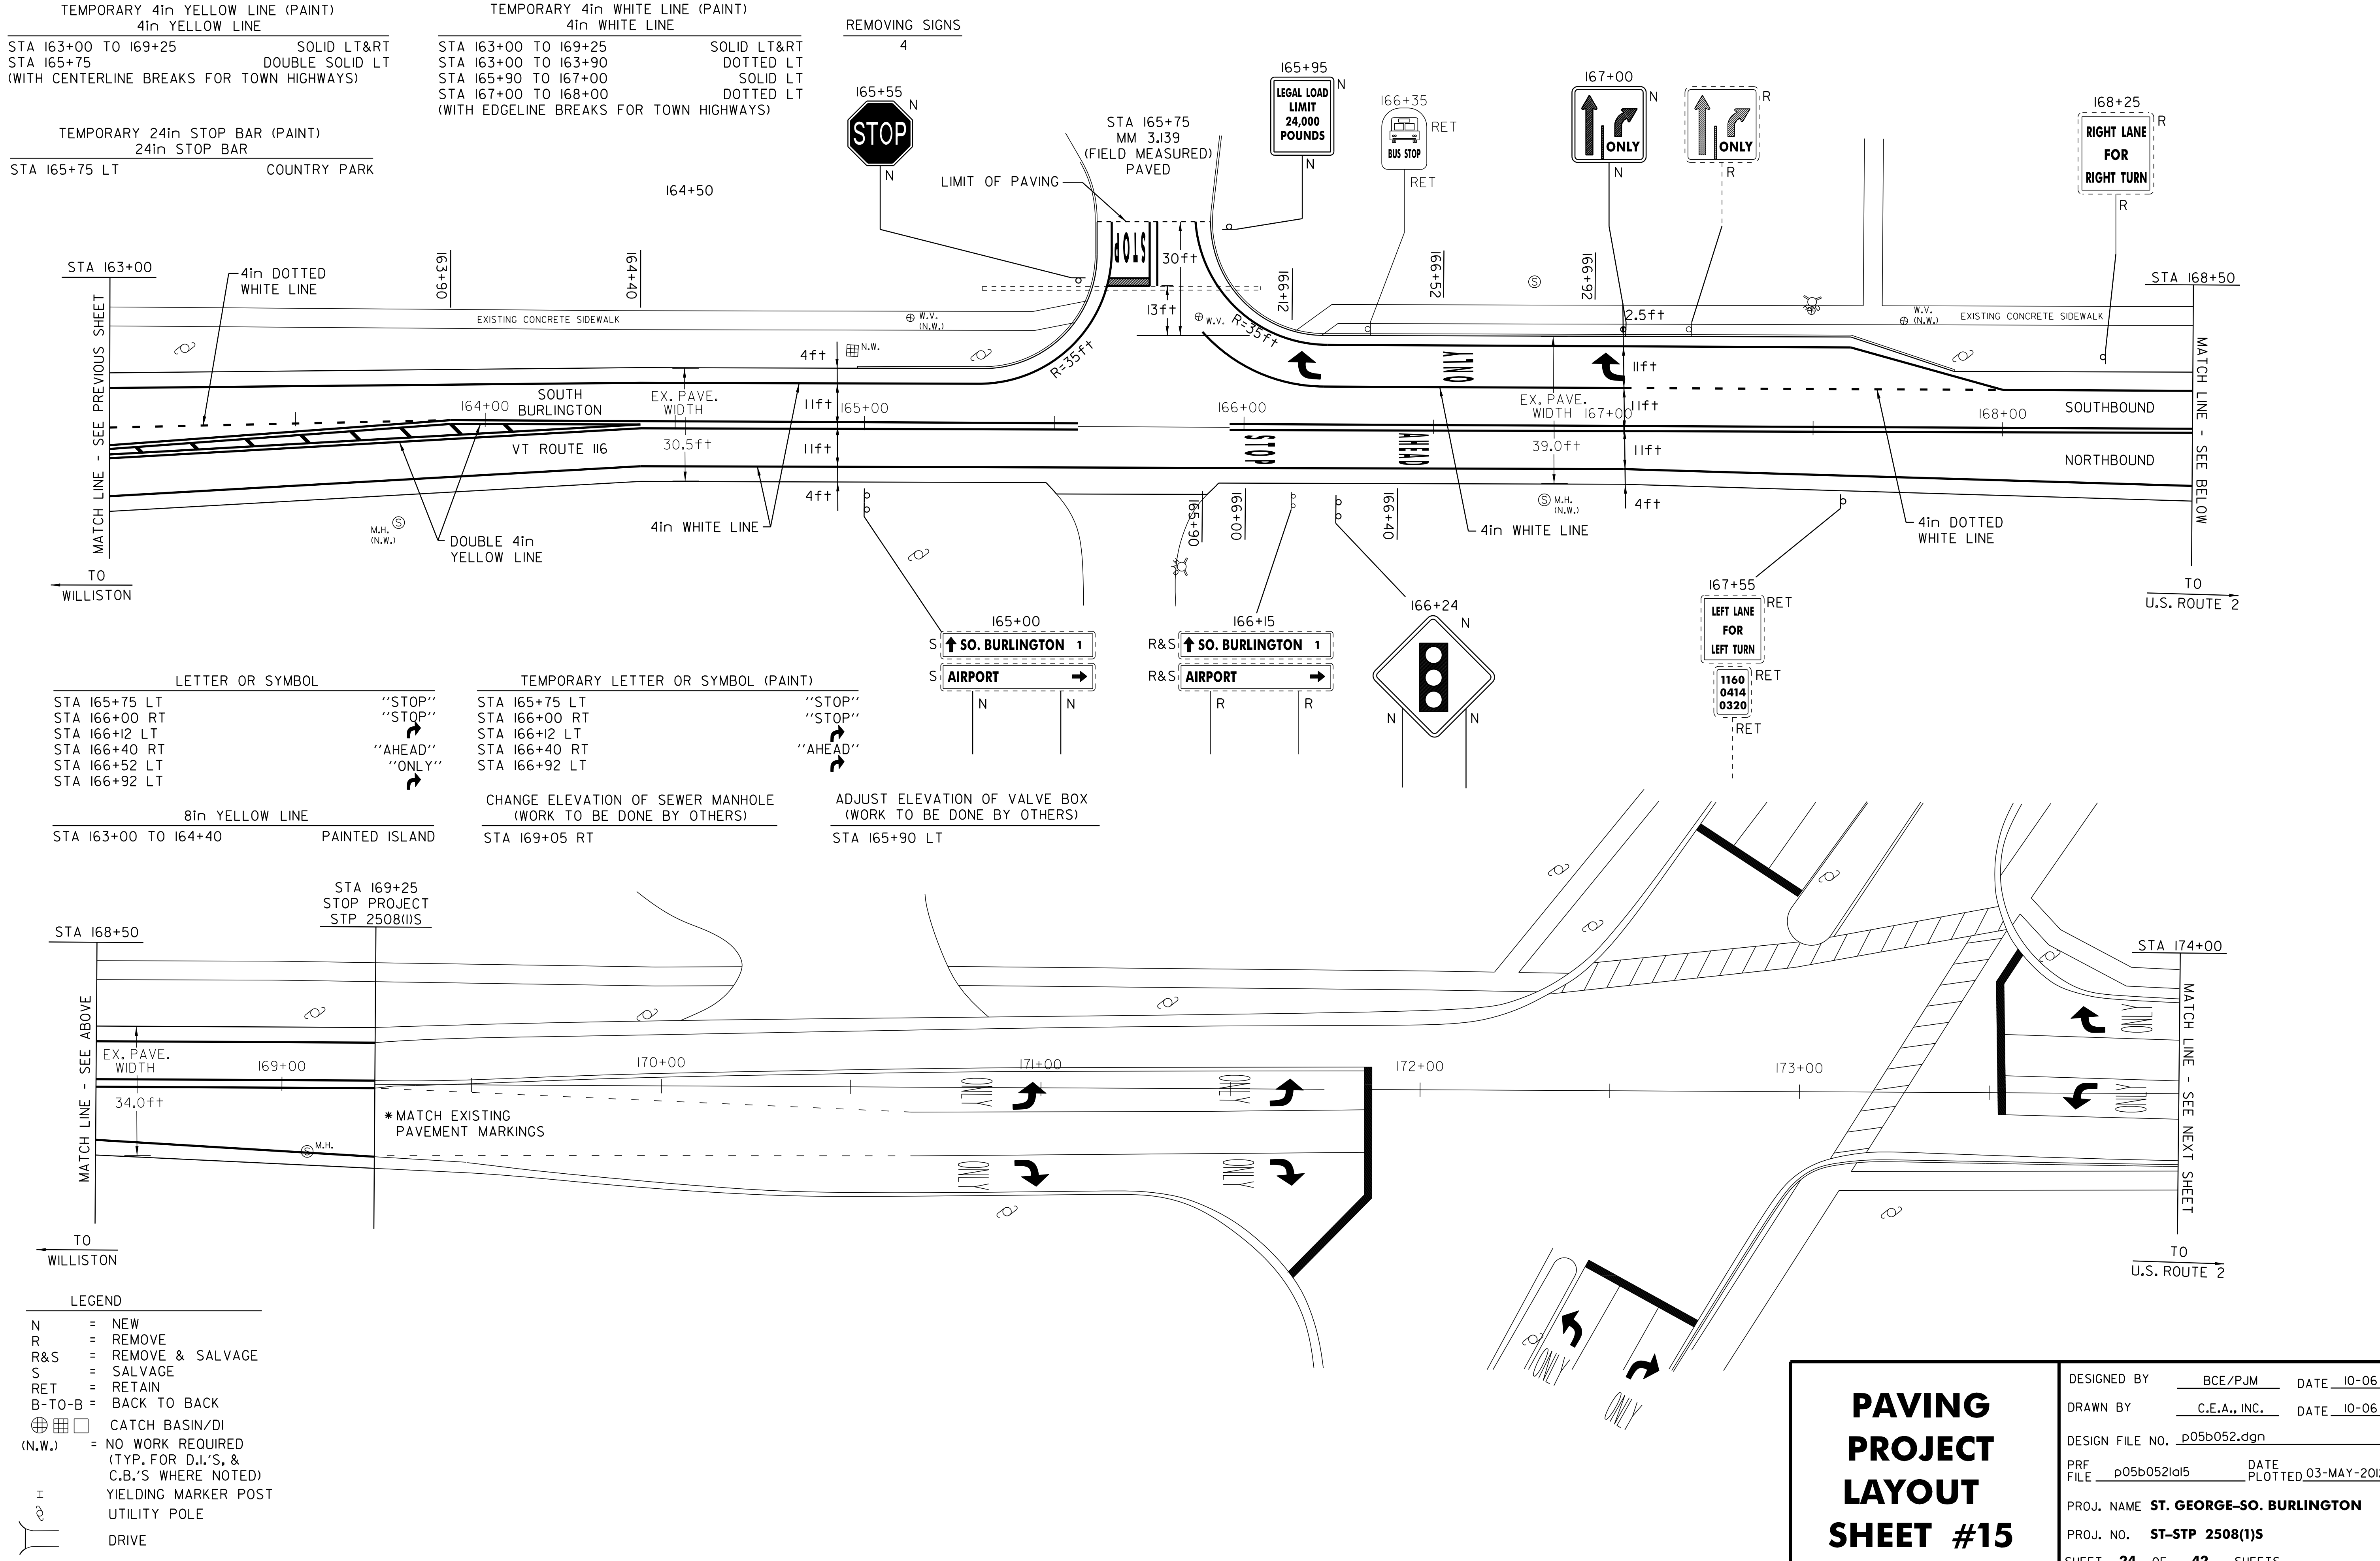

TEMPORARY 4in YELLOW LINE (PAINT)	
4in YELLOW LINE	
STA 163+00 TO 169+25	SOLID LT&RT
STA 165+75	DOUBLE SOLID LT
(WITH CENTERLINE BREAKS FOR TOWN HIGHWAYS)	

TEMPORARY 24in STOP BAR (PAINT)	
24in STOP BAR	
STA 165+75 LT	COUNTRY PARK

TEMPORARY 4in WHITE LINE (PAINT)	
4in WHITE LINE	
STA 163+00 TO 169+25	SOLID LT&RT
STA 163+00 TO 163+90	DOTTED LT
STA 165+90 TO 167+00	SOLID LT
STA 167+00 TO 168+00	DOTTED LT
(WITH EDGE LINE BREAKS FOR TOWN HIGHWAYS)	

REMOVING SIGNS	
4	
165+55 N	STOP


LETTER OR SYMBOL	
STA 165+75 LT	"STOP"
STA 166+00 RT	"STOP"
STA 166+12 LT	"AHEAD"
STA 166+40 RT	"ONLY"
STA 166+52 LT	"ONLY"
STA 166+92 LT	"ONLY"

8in YELLOW LINE	
PAINTED ISLAND	
STA 163+00 TO 164+40	PAINTED ISLAND

TEMPORARY LETTER OR SYMBOL (PAINT)	
STA 165+75 LT	"STOP"
STA 166+00 RT	"STOP"
STA 166+12 LT	"AHEAD"
STA 166+40 RT	"AHEAD"
STA 166+92 LT	"AHEAD"

CHANGE ELEVATION OF SEWER MANHOLE	
(WORK TO BE DONE BY OTHERS)	
STA 169+05 RT	CHANGE ELEVATION OF SEWER MANHOLE

ADJUST ELEVATION OF VALVE BOX	
(WORK TO BE DONE BY OTHERS)	
STA 165+90 LT	ADJUST ELEVATION OF VALVE BOX

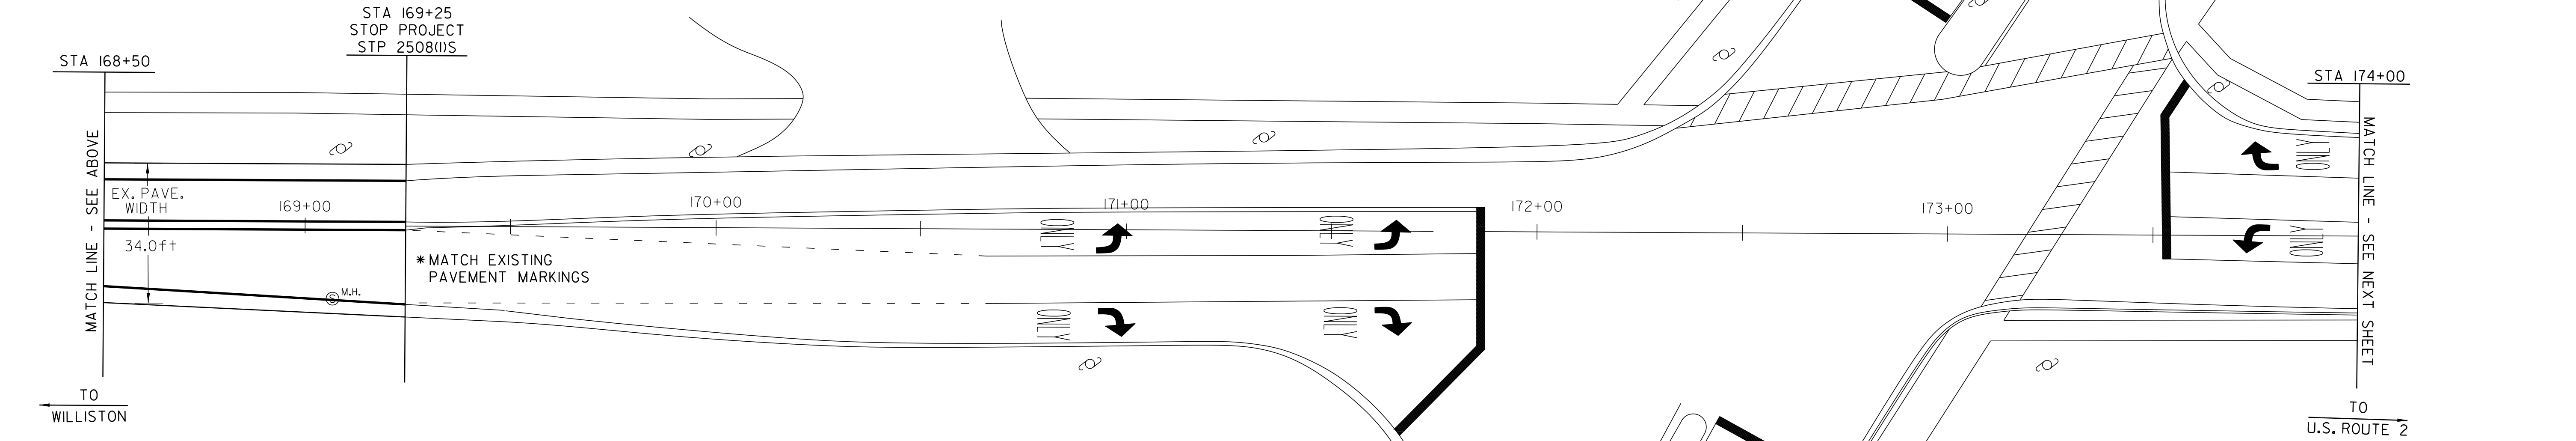

LEGEND	
N	= NEW
R	= REMOVE
R&S	= REMOVE & SALVAGE
S	= SALVAGE
RET	= RETAIN
B-TO-B	= BACK TO BACK
⊕	= CATCH BASIN/DI
(N.W.)	= NO WORK REQUIRED (TYP. FOR D.I.'S, & C.B.'S WHERE NOTED)
Y	= YIELDING MARKER POST
U	= UTILITY POLE
D	= DRIVE

PAVING
PROJECT
LAYOUT
SHEET #15

DESIGNED BY

BCE/PJM

DATE

10-06

DRAWN BY

C.E.A., INC.

DATE

10-06

DESIGN FILE NO.

p05b052.dgn

PRF FILE

p05b052la15

DATE PLOTTED

03-MAY-2012 17

PROJ. NAME

ST. GEORGE-SO. BURLINGTON

PROJ. NO.

ST-STP 2508(1)S

SHEET



24

OF

42

SHEETS

TEMPORARY 4in YELLOW LINE (PAINT) 4in YELLOW LINE		TEMPORARY 4in WHITE LINE (PAINT) 4in WHITE LINE		LETTER OR SYMBOL	TEMPORARY LETTER OR SYMBOL (PAINT)	ADJUST ELEVATION OF GAS VALVES (WORK TO BE DONE BY OTHERS)	CHANGE ELEVATION OF SEWER MANHOLE (WORK TO BE DONE BY OTHERS)
STA 175+30 TO 185+00 (WITH CENTERLINE BREAKS FOR TOWN HIGHWAYS)		STA 175+30 TO 185+00 SOLID LT&RT STA 175+30 TO 176+00 (2) SOLID LT STA 176+00 TO 177+45 DOTTED LT (WITH EDGE LINE BREAKS FOR TOWN HIGHWAYS)		STA 175+52 LT STA 175+92 LT STA 179+76 LT STA 180+16 LT	“ONLY” “AHEAD” “SIGNAL”	STA 175+52 LT STA 179+76 LT STA 180+16 LT	STA 176+60 RT STA 184+70 LT

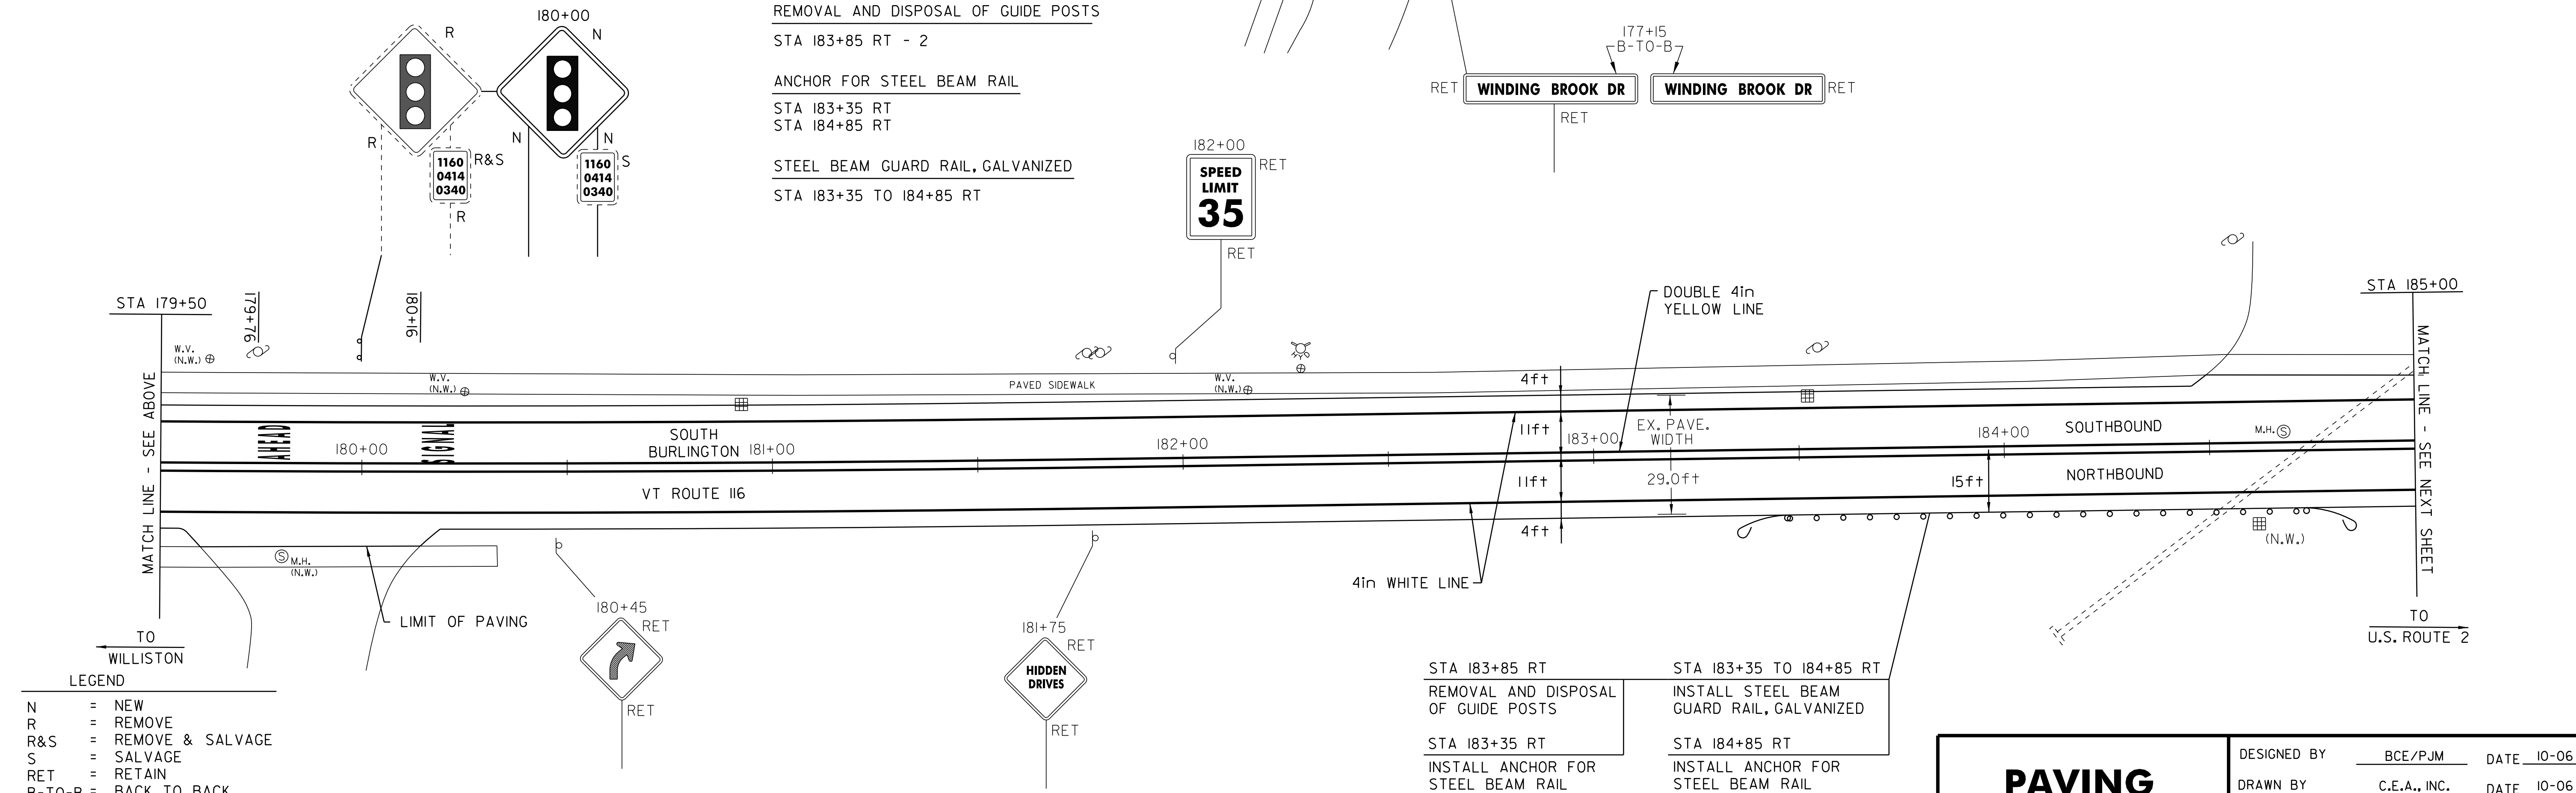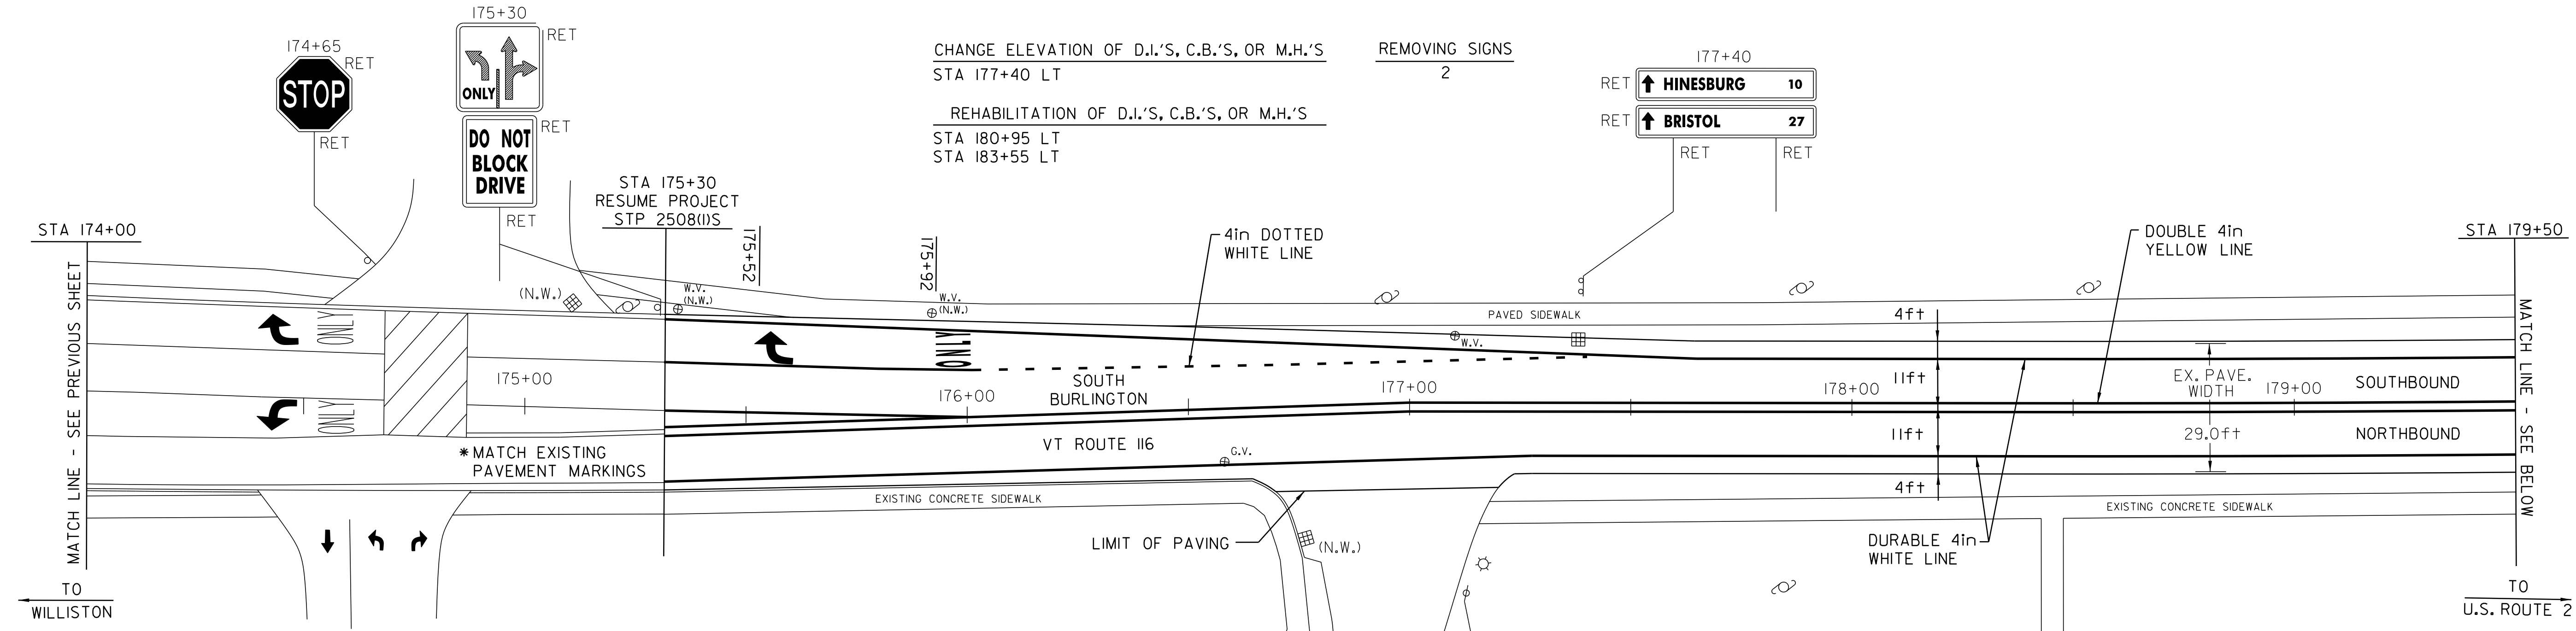

LEGEND	
N	= NEW
R	= REMOVE
R&S	= REMOVE & SALVAGE
S	= SALVAGE
RET	= RETAIN
B-TO-B	= BACK TO BACK
⊕ ⊞ □	CATCH BASIN/DI
(N.W.)	= NO WORK REQUIRED (TYP. FOR D.I.'S, & C.B.'S WHERE NOTED)
⊙	YIELDING MARKER POST
⊙	UTILITY POLE
—	DRIVE

STA 183+85 RT REMOVAL AND DISPOSAL OF GUIDE POSTS	STA 183+35 TO 184+85 RT INSTALL STEEL BEAM GUARD RAIL, GALVANIZED
STA 183+35 RT INSTALL ANCHOR FOR STEEL BEAM RAIL	STA 184+85 RT INSTALL ANCHOR FOR STEEL BEAM RAIL

PAVING
PROJECT
LAYOUT
SHEET #16

DESIGNED BY

BCE/PJM

DATE

10-06

DRAWN BY

C.E.A., INC.

DATE

10-06

DESIGN FILE NO.

p05b052.dgn

PRF FILE

p05b052d16

DATE PLOTTED

03-MAY-2012 17

PROJ. NAME

ST. GEORGE-SO. BURLINGTON

PROJ. NO.

ST-STP 2508(1)S

SHEET

25

OF

42


SHEETS

TEMPORARY 4in YELLOW LINE (PAINT)
4in YELLOW LINE

STA 185+00 TO 196+00 SOLID LT&RT
STA 187+02 DOUBLE SOLID LT
STA 189+80 DOUBLE SOLID LT
STA 191+81 DOUBLE SOLID RT
(WITH CENTERLINE BREAKS FOR TOWN HIGHWAYS)

TEMPORARY 4in WHITE LINE (PAINT)
4in WHITE LINE

STA 185+00 TO 196+00 SOLID LT&RT
(WITH EDGE LINE BREAKS FOR TOWN HIGHWAYS)

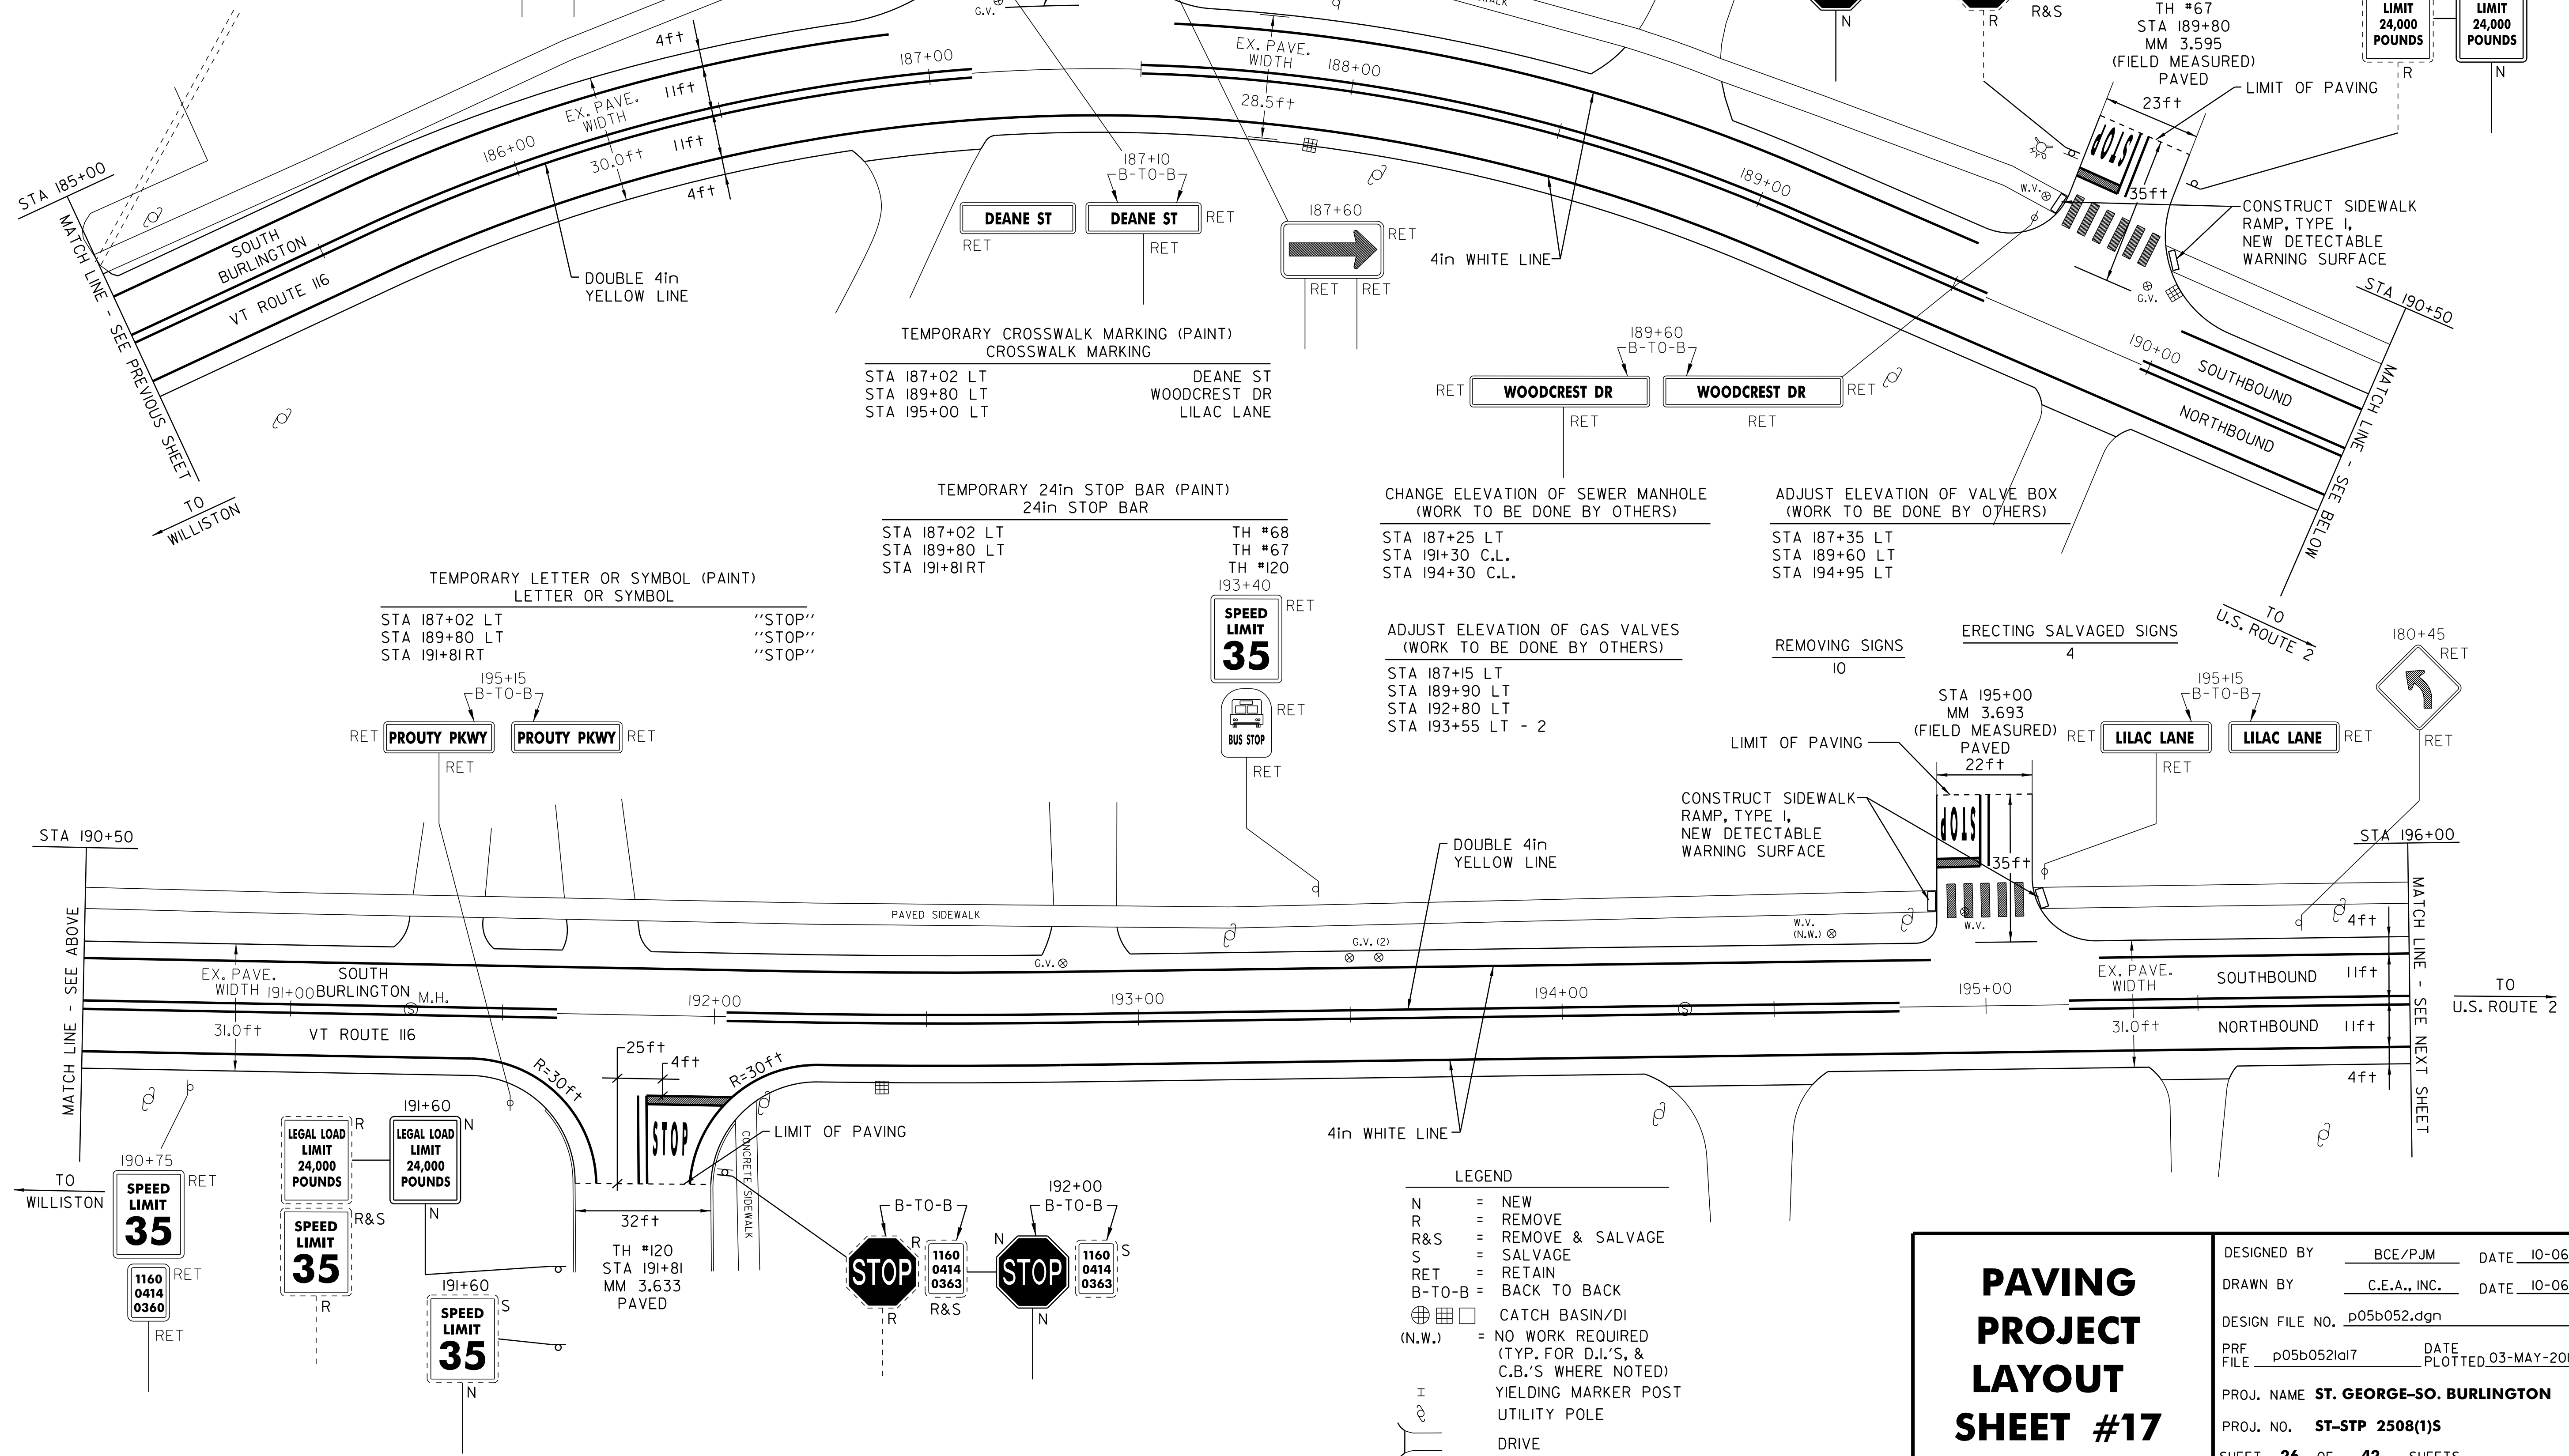

PAVING
PROJECT
LAYOUT
SHEET #17

DESIGNED BY

BCE/PJM

DATE

10-06

DRAWN BY

C.E.A., INC.

DATE

10-06

DESIGN FILE NO.

p05b052.dgn

PRF FILE

p05b052a17

DATE PLOTTED

03-MAY-2012 17

PROJ. NAME

ST. GEORGE-SO. BURLINGTON

PROJ. NO.

ST-STP 2508(1)S

SHEET

26

OF

42


SHEETS

TEMPORARY 4in YELLOW LINE (PAINT)
4in WHITE LINE

STA 196+00 TO 207+00 SOLID LT&RT
STA 197+15 DOUBLE SOLID RT
STA 202+48 DOUBLE SOLID LT
STA 206+10 DOUBLE SOLID LT
(WITH CENTERLINE BREAKS FOR TOWN HIGHWAYS)

TEMPORARY 4in WHITE LINE (PAINT)
4in WHITE LINE

STA 196+00 TO 207+00 SOLID LT&RT
(WITH EDGELINE BREAKS FOR TOWN HIGHWAYS)

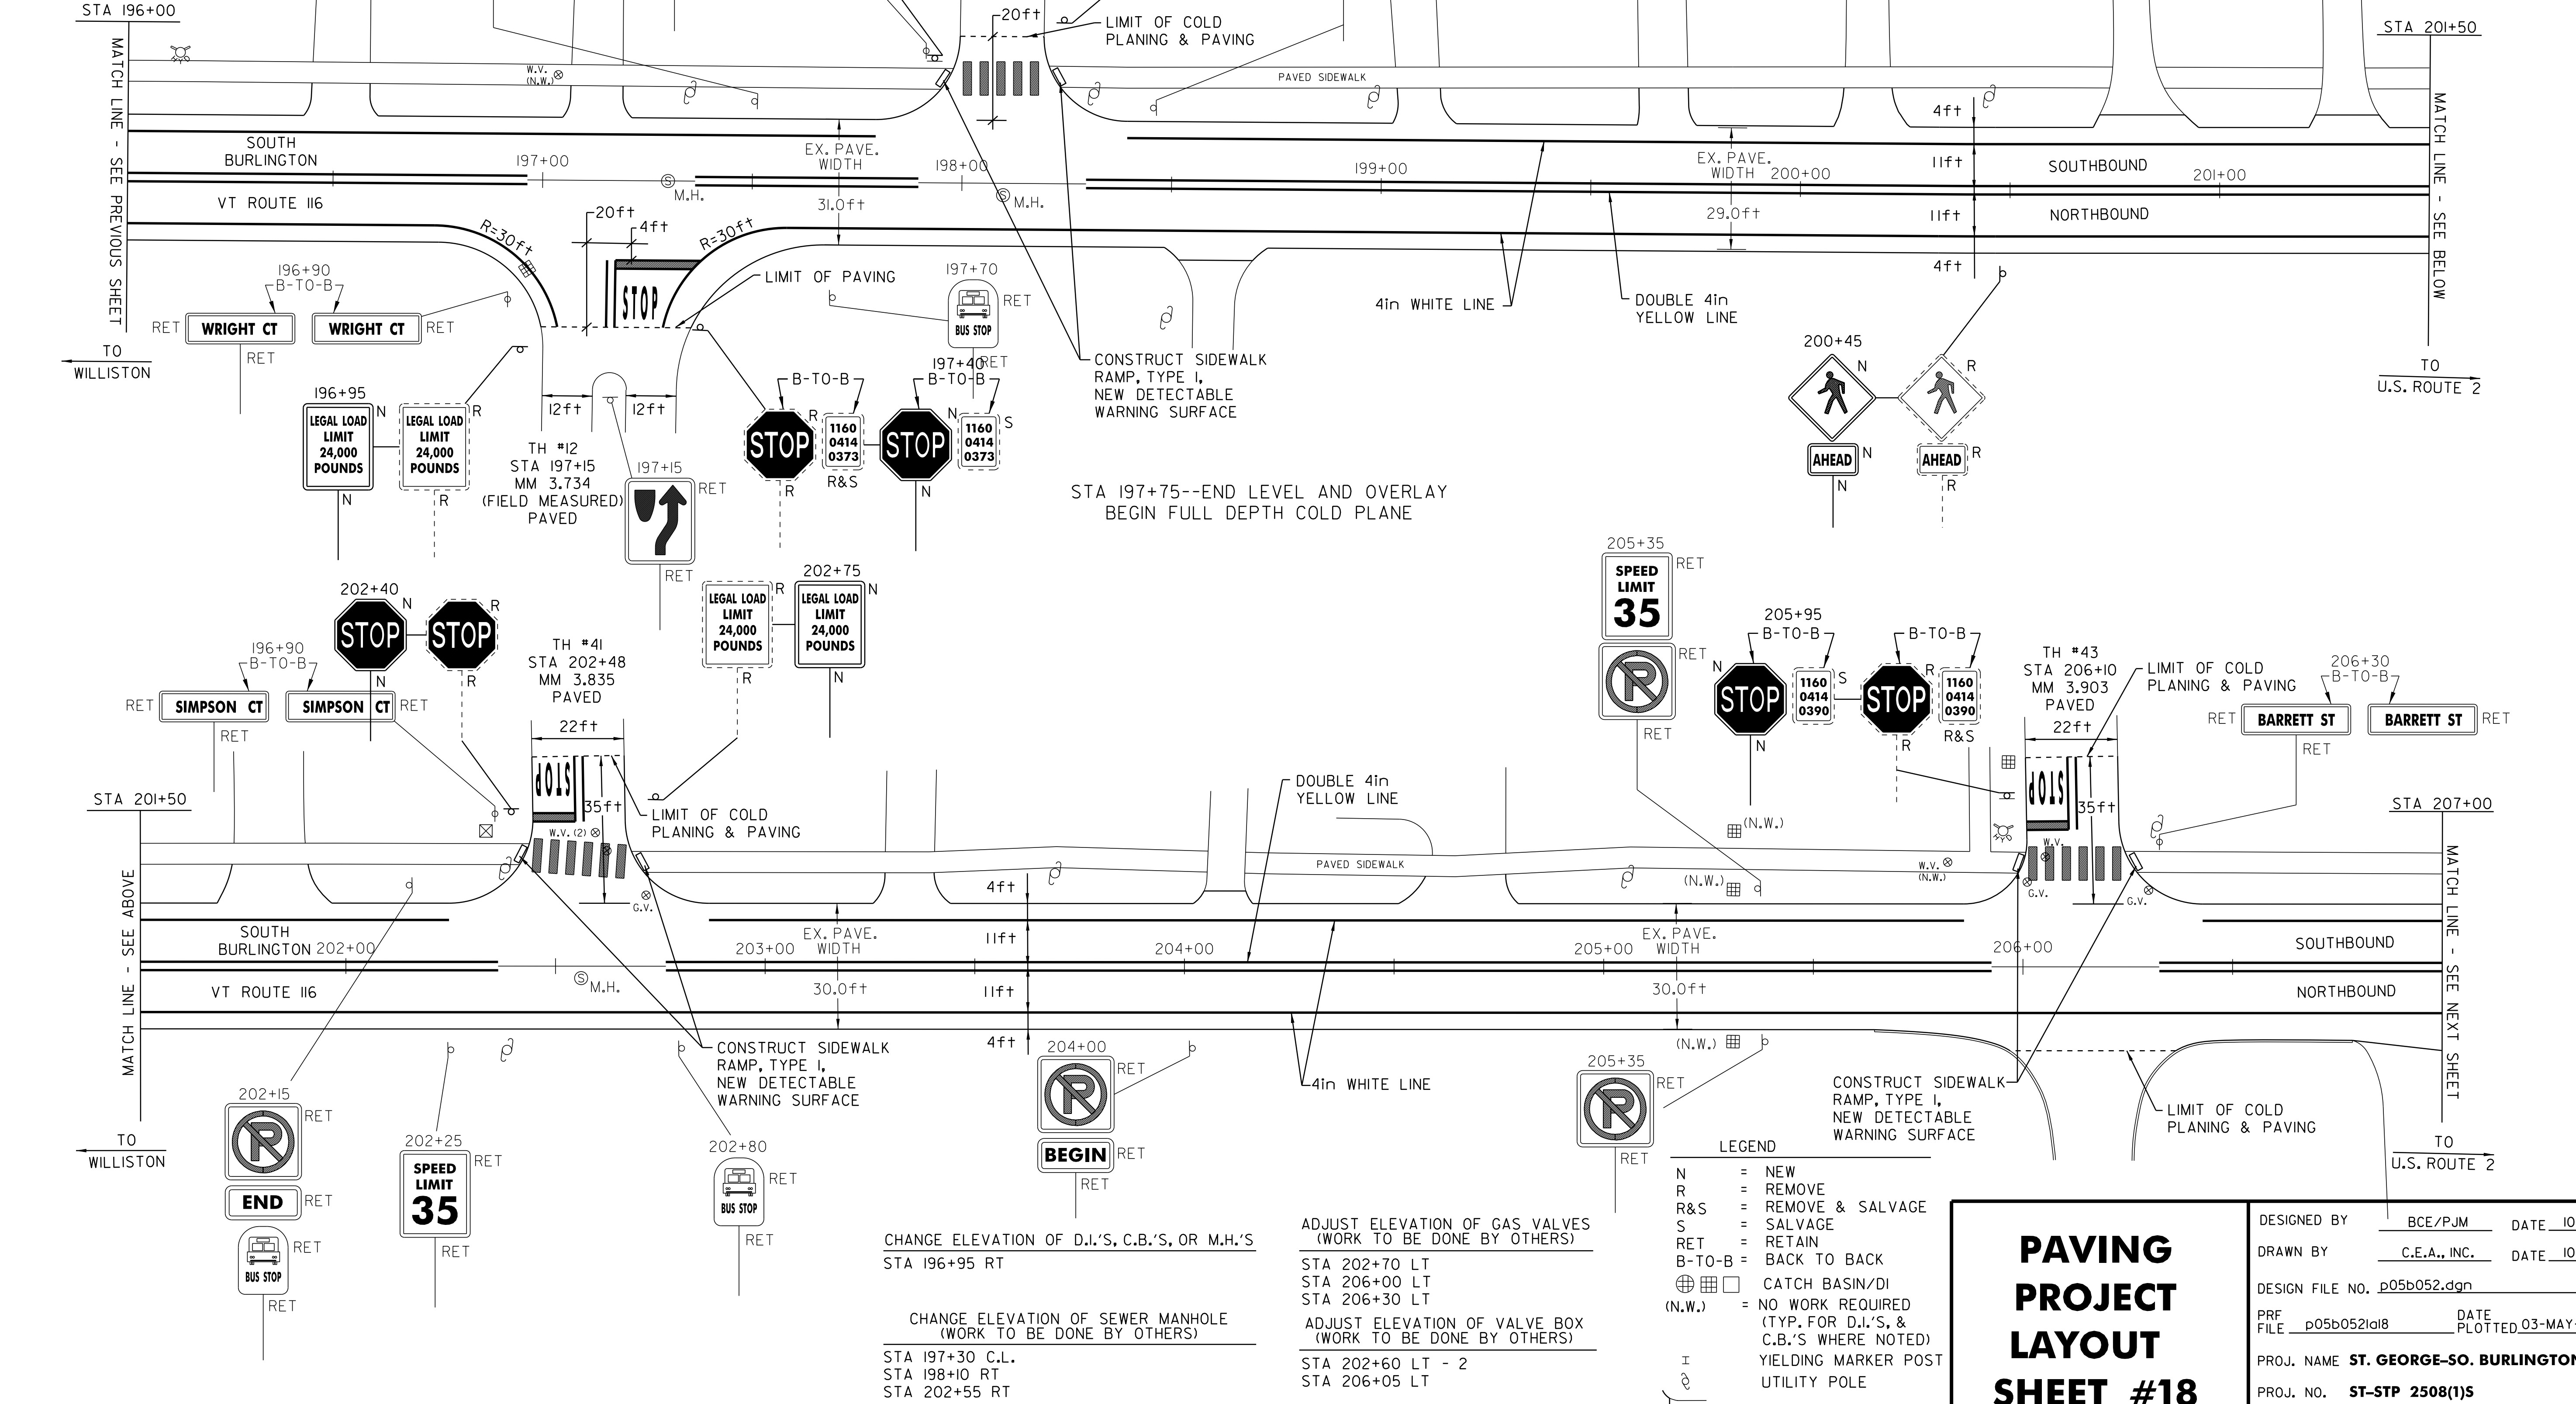

TEMPORARY LETTER OR SYMBOL (PAINT)
LETTER OR SYMBOL

STA 197+15 RT "STOP"
STA 202+48 LT "STOP"
STA 206+10 LT "STOP"

TEMPORARY CROSSWALK MARKING (PAINT)
CROSSWALK MARKING

STA 198+10 LT SUNSET AVE
STA 202+48 LT SIMPSON CT
STA 206+10 LT BARRETT ST

REMOVING SIGNS
10

ERECTING SALVAGED SIGNS
3

TEMPORARY 24in STOP BAR (PAINT)
24in STOP BAR

STA 197+15 RT TH #12
STA 202+48 LT TH #41
STA 206+10 LT TH #43

- LEGEND
- N = NEW
 - R = REMOVE
 - R&S = REMOVE & SALVAGE
 - S = SALVAGE
 - RET = RETAIN
 - B-T-O-B = BACK TO BACK
 - ⊕ ⊞ ⊠ = CATCH BASIN/DI
 - (N.W.) = NO WORK REQUIRED (TYP. FOR D.I.'S, & C.B.'S WHERE NOTED)
 - ⊥ = YIELDING MARKER POST
 - ⊥ = UTILITY POLE
 - ⊥ = DRIVE

PAVING PROJECT LAYOUT SHEET #18

DESIGNED BY
BCE/PJM

DRAWN BY
C.E.A., INC.

DESIGN FILE NO.
p05b052.dgn

PRF FILE
p05b052a18

PROJ. NAME
ST. GEORGE-SO. BURLINGTON

SHEET
27

DATE
10-06

DATE
10-06

DATE
03-MAY-2012

PROJ. NO.
ST-STP 2508(1)S

OF
42


SHEETS

CHANGE ELEVATION OF D.I.'S, C.B.'S, OR M.H.'S
STA 196+95 RT

CHANGE ELEVATION OF SEWER MANHOLE
(WORK TO BE DONE BY OTHERS)
STA 197+30 C.L.
STA 198+10 RT
STA 202+55 RT

ADJUST ELEVATION OF GAS VALVES
(WORK TO BE DONE BY OTHERS)
STA 202+70 LT
STA 206+00 LT
STA 206+30 LT

ADJUST ELEVATION OF VALVE BOX
(WORK TO BE DONE BY OTHERS)
STA 202+60 LT - 2
STA 206+05 LT

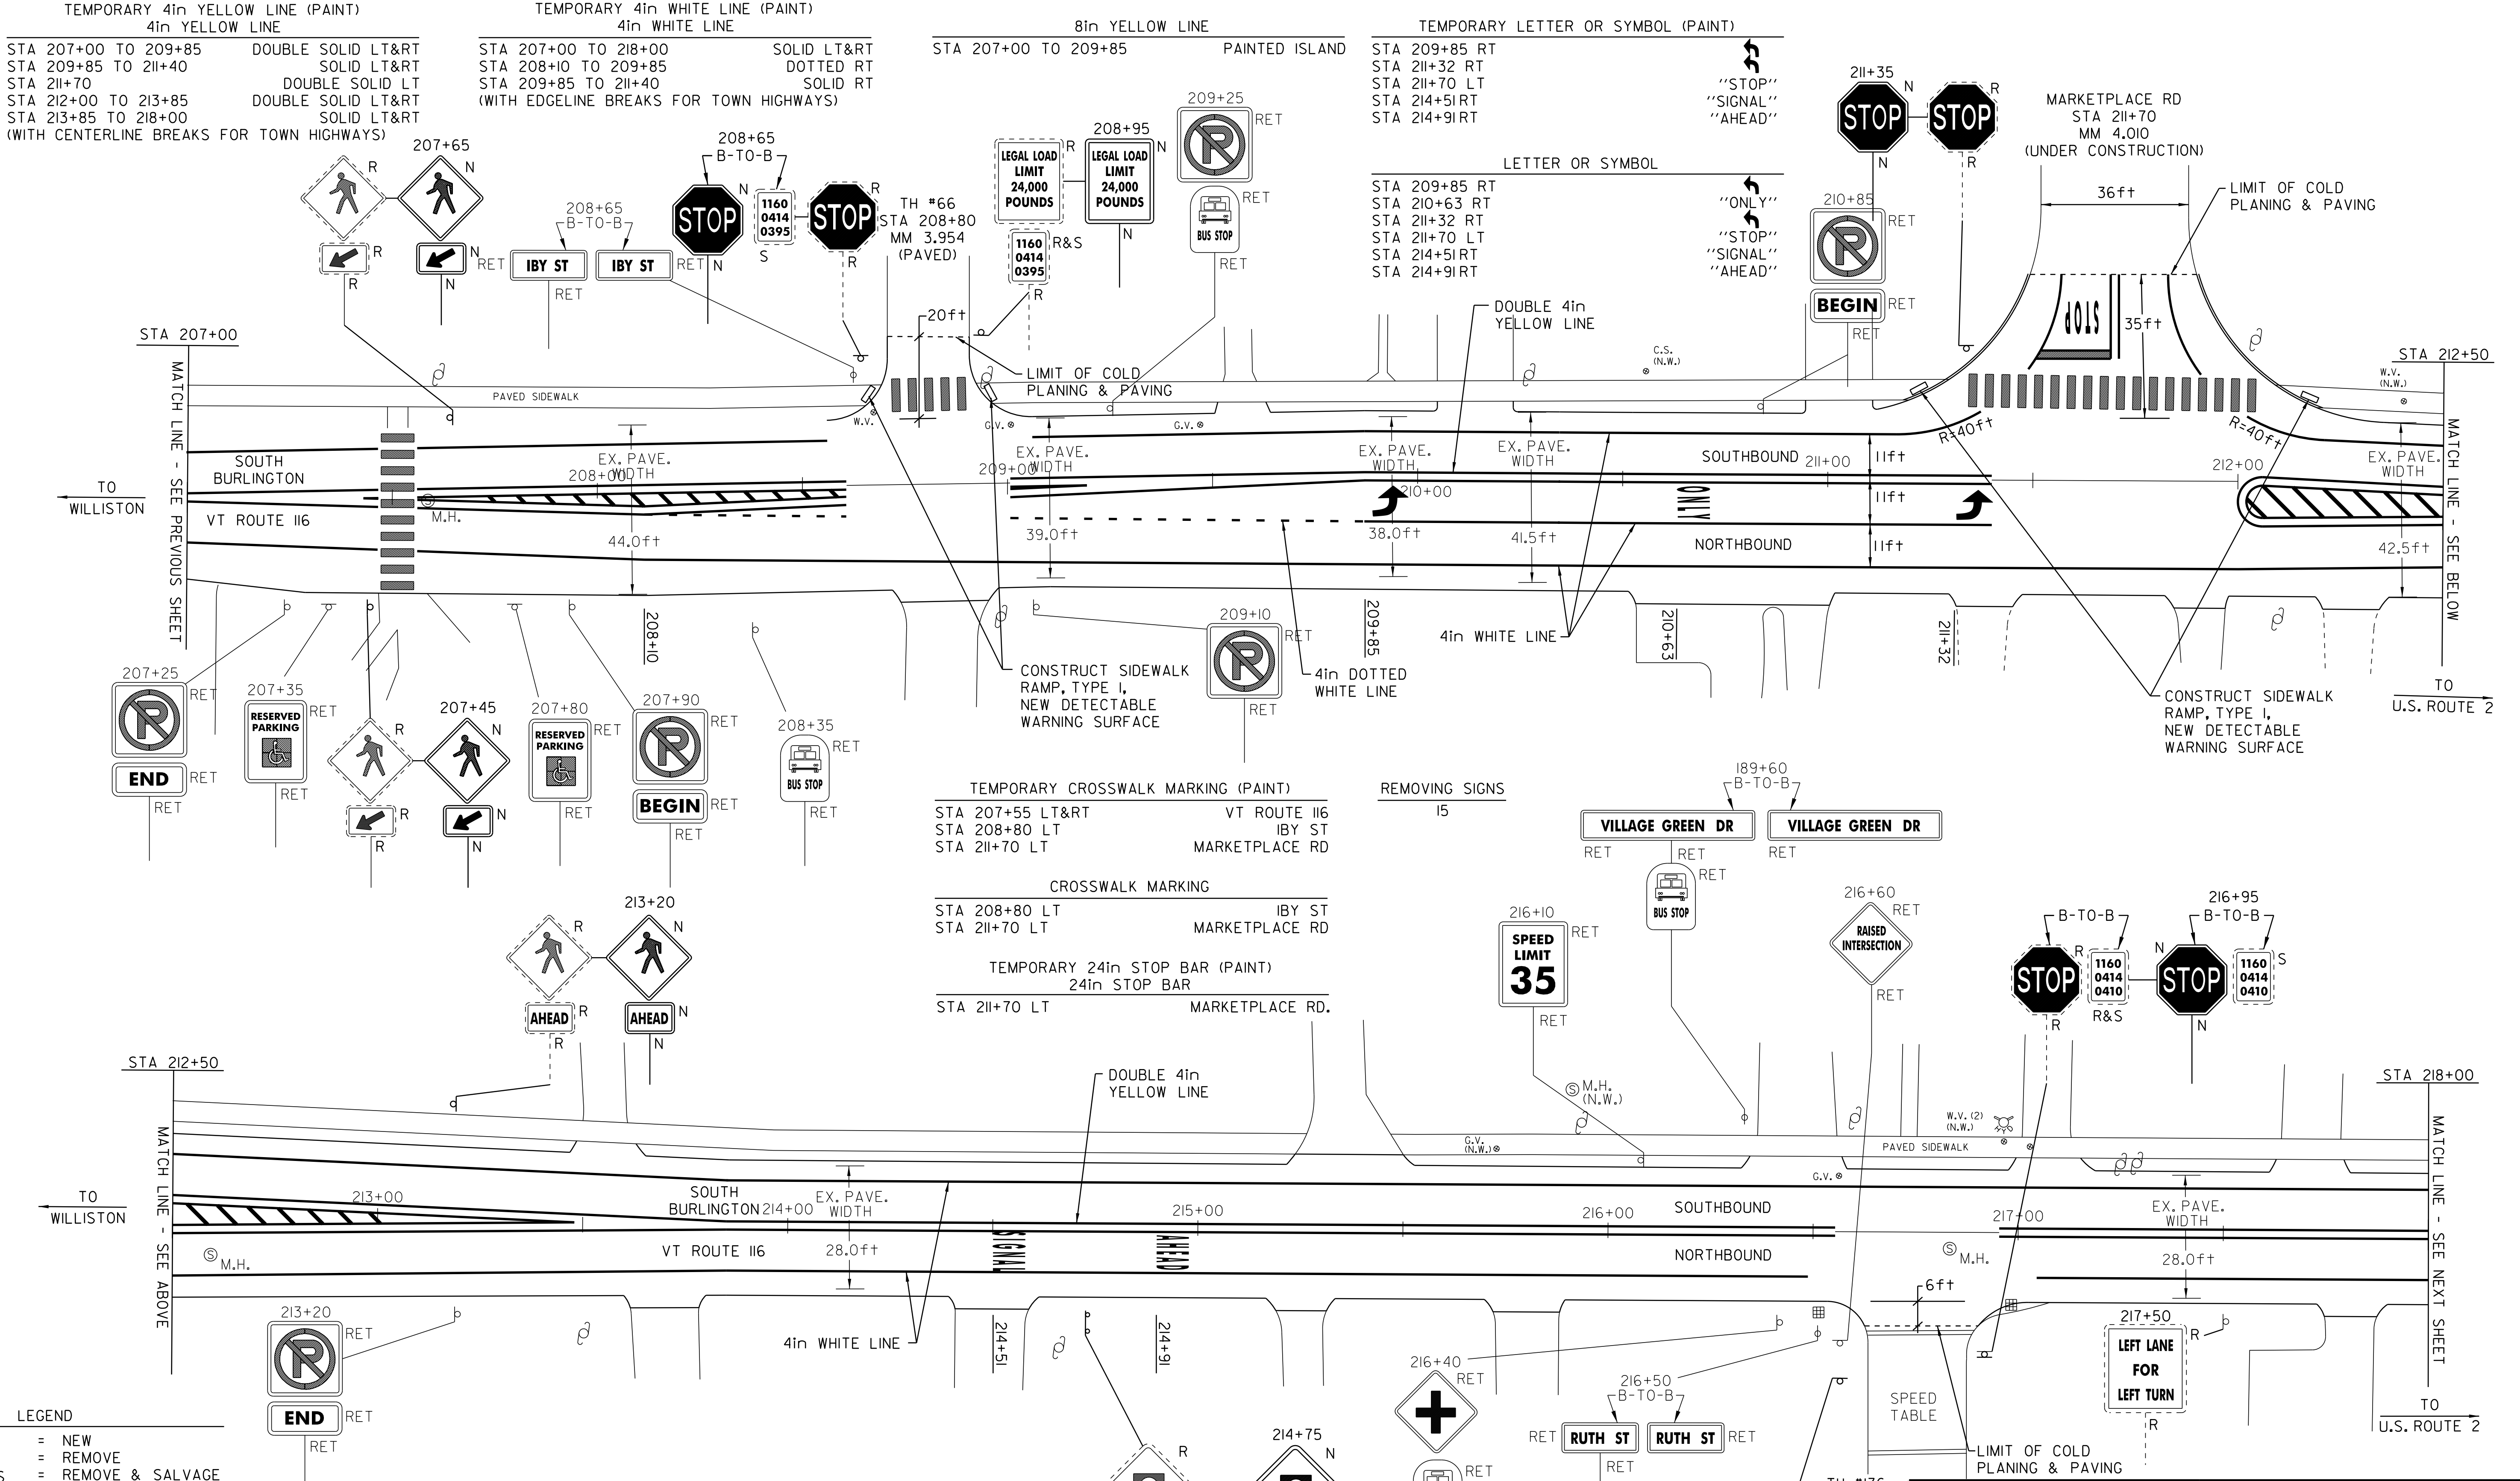

- LEGEND
- N = NEW
 - R = REMOVE
 - R&S = REMOVE & SALVAGE
 - S = SALVAGE
 - RET = RETAIN
 - B-T-O-B = BACK TO BACK
 - ⊕ □ = CATCH BASIN/DI
 - (N.W.) = NO WORK REQUIRED (TYP. FOR D.I.'S, & C.B.'S WHERE NOTED)
 - YIELDING MARKER POST
 - UTILITY POLE
 - DRIVE

ADJUST ELEVATION OF GAS VALVES
(WORK TO BE DONE BY OTHERS)

STA 209+00 LT
STA 209+50 LT
STA 216+55 LT

ADJUST ELEVATION OF VALVE BOX
(WORK TO BE DONE BY OTHERS)

STA 208+65 LT

REHABILITATION OF D.I.'S, C.B.'S, OR M.H.'S

STA 216+50 RT
STA 217+00 RT

CHANGE ELEVATION OF SEWER MANHOLE
(WORK TO BE DONE BY OTHERS)

STA 207+60 C.L.
STA 212+60 RT
STA 216+85 RT

PAVING PROJECT LAYOUT SHEET #19

DESIGNED BY

BCE/PJM

DATE

10-06

DRAWN BY

C.E.A., INC.

DATE

10-06

DESIGN FILE NO.

p05b052.dgn

PRF FILE

p05b052la9

DATE PLOTTED

03-MAY-2012 17

PROJ. NAME

ST. GEORGE-SO. BURLINGTON

PROJ. NO.

ST-STP 2508(1)S

SHEET


28

OF

42

SHEETS




TEMPORARY 4in YELLOW LINE (PAINT) 4in YELLOW LINE	TEMPORARY 4in WHITE LINE (PAINT) 4in WHITE LINE	TEMPORARY LETTER OR SYMBOL (PAINT)	LETTER OR SYMBOL	REMOVING SIGNS
STA 218+00 TO 223+34 SOLID LT&RT STA 221+45 DOUBLE SOLID LT (WITH CENTERLINE BREAKS FOR TOWN HIGHWAYS)	STA 218+00 TO 223+34 SOLID LT&RT STA 218+65 TO 219+90 DOTTED RT STA 219+90 TO 223+34 SOLID RT STA 221+70 TO 222+67 SOLID LT STA 222+67 TO 223+34 DOTTED LT (WITH EDGE LINE BREAKS FOR TOWN HIGHWAYS)	STA 220+30 RT STA 221+45 LT STA 222+05 RT STA 222+67 LT	STA 219+90 RT STA 220+30 RT STA 221+45 LT STA 221+65 RT STA 222+00 LT STA 222+05 RT STA 222+67 LT	5
REHABILITATION OF D.I.'S, C.B.'S, OR M.H.'S STA 222+25 LT&RT				
CHANGE ELEVATION OF SEWER MANHOLE (WORK TO BE DONE BY OTHERS)	TEMPORARY CROSSWALK MARKING (PAINT) CROSSWALK MARKING	TEMPORARY 24in STOP BAR (PAINT) 24in STOP BAR		
STA 222+80 RT	STA 221+45 LT SHOPPING CENTER	STA 221+45 LT SHOPPING CENTER		
ADJUST ELEVATION OF VALVE BOX (WORK TO BE DONE BY OTHERS)	ADJUST ELEVATION OF GAS VALVES (WORK TO BE DONE BY OTHERS)			
STA 222+05 LT	STA 219+90 LT			

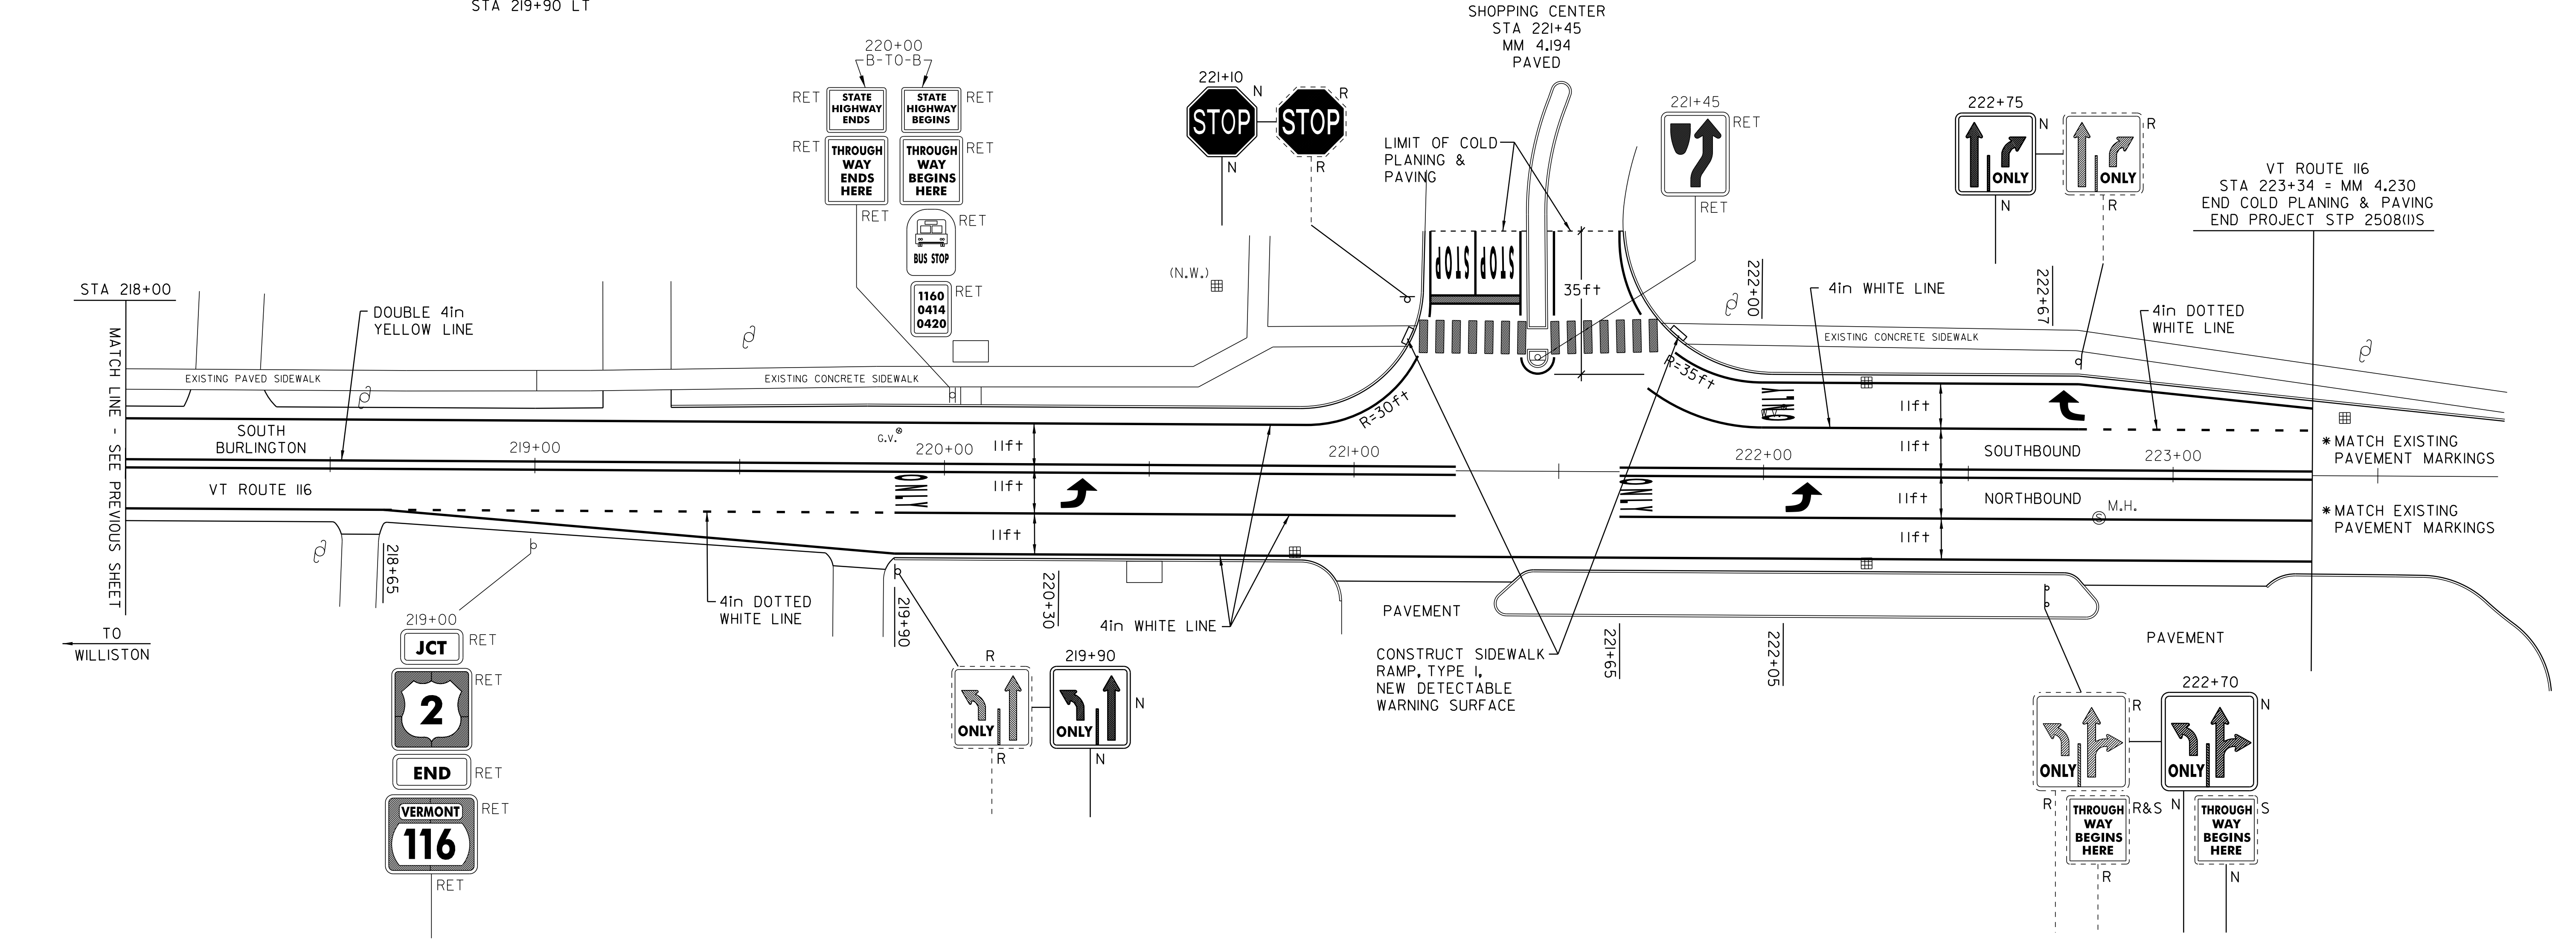

LEGEND	
N	= NEW
R	= REMOVE
R&S	= REMOVE & SALVAGE
S	= SALVAGE
RET	= RETAIN
B-TO-B	= BACK TO BACK
⊕ ⊞ □	CATCH BASIN/DI
(N.W.)	= NO WORK REQUIRED (TYP. FOR D.I.'S, & C.B.'S WHERE NOTED)
I	YIELDING MARKER POST
⊙	UTILITY POLE
—	DRIVE

PAVING PROJECT LAYOUT SHEET #20	DESIGNED BY	BCE/PJM	DATE	10-06
	DRAWN BY	C.E.A., INC.	DATE	10-06
	DESIGN FILE NO.	p05b052.dgn		
	PRF FILE	p05b052la20	DATE PLOTTED	03-MAY-2012 17
	PROJ. NAME	ST. GEORGE-SO. BURLINGTON		
	PROJ. NO.	ST-STP 2508(1)S		
	SHEET	29	OF	42 SHEETS

TRAFFIC SIGN SUMMARY SHEET 1

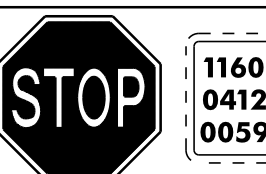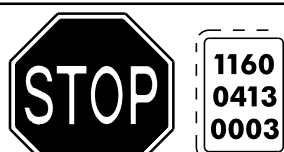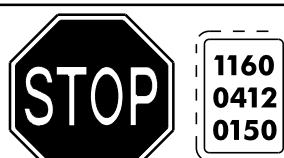KILOMETER MARKER, STATION, OR SIGN NUMBER	SIGN LEGEND	SIGN DIMENSIONS			NEW & SALVAGED SIGNS				EXIST POST		NO. OF POSTS	FLANGED CHANNEL			SQUARE STEEL (in)			TUBULAR ALUMINUM Ø (in)			TUBULAR STEEL Ø (in)				W-SHAPE STEEL				S I G N F R A M E S T R U C T U R E	REMARKS	SIGN DETAIL		
					"A"	"B"	SALV SIGN	SALV TIS	S A L V A G E R E T A I N	lb/ft			1.75	2.0	2.5	ANCHOR	S P L I T	3.0	4.0	4.0 MOD.	FOUND- ATION	3.0	3.5	4.0	5.0	FTG. SIZE		WEIGHT			POST SIZE	DETAIL ON SHEET NUMBER	STD. SHEET NUMBER
		1.12	2.0	3.0						1.88		2.16	3.35	1.3	1.7			1.7	7.6	9.0		10.8	14.6	24"	30"								
		EA	WIDTH (in)	HEIGHT (in)																													
OPTION ITEMS																																	
ST. GEORGE 13+90 RT		1	30	30	6.25						1					X													VR-921		E-145A		
30+15 RT		1	24	30	5.0						1					X													REFER TO STANDARD E-121 FOR PLACEMENT. VR-017		E-141		
30+45 RT		1	30	30	6.25			1			1					X													R1-1		E-143		
SHELBURNE 1+55 LT		1	30	30	6.25			1			1					X													BACK TO BACK R1-1		E-143		
1+85 LT		1	24	30	5.0						1					X													REFER TO STANDARD E-121 FOR PLACEMENT. VR-017		E-141		
74+00 LT								1																					1R				
ST. GEORGE 79+90 RT		1	24	30	5.0						1					X													REFER TO STANDARD E-121 FOR PLACEMENT. VR-017		E-141		
80+05 RT		1	30	30	6.25			1			1					X													BACK TO BACK R1-1		E-143		
82+70 RT		1	24	30	5.0						1					X													REFER TO STANDARD E-121 FOR PLACEMENT. VR-017		E-141		
83+70 RT		1	30	30	6.25						1					X													R1-1		E-143		
21+94 LT		1	12	36	3.0						1					X													OM-3R		E-120		
21+94 RT		1	12	36	3.0						1					X													OM-3L		E-120		
SO. BURLINGTON 0+08 LT		1	12	36	3.0						1					X													OM-3L		E-120		
0+08 RT		1	12	36	3.0						1					X													OM-3R		E-120		
FINAL POST LENGTHS ARE TO BE DETERMINED IN THE FIELD. POST SIZES ARE COMPUTED BASED ON INFORMATION FURNISHED ON THE STANDARD SHEET AND THE ROADWAY. TRAFFIC & SAFETY AND PAVEMENT MANAGEMENT SECTION'S SIGN POST DESIGN GUIDELINE.			SF			SF	EA.	SF				FT	FT	FT	FT	FT	FT		EA.	LB	LB	LB	EA.	LB	LB	LB	LB	EA.	EA.	LB			
			SHEET TOTALS			63.25						3								195													

TRAFFIC
SIGN
SUMMARY
SHEET #1

PROJECT: ST. GEORGE-SO. BURLINGTON



PROJECT NO.: ST-STP 2508(1)S
DATE: 8-06

DESIGN FILE NAME: p05b052.dgn
IPARM FILE NAME: p05b052+ts01.i
SURVEYED BY:
SQUAD LEADER:

PLOT DATE: 03-MAY-2012 17:55
DRAWN BY: C.E.A., INC.
SHEET: 30 OF 42

TRAFFIC SIGN SUMMARY SHEET 2

KILOMETER MARKER, STATION, OR SIGN NUMBER	SIGN LEGEND	SIGN DIMENSIONS			NEW & SALVAGED SIGNS				EXIST POST		NO. OF POSTS	FLANGED CHANNEL			SQUARE STEEL (in)			TUBULAR ALUMINUM Ø (in)			TUBULAR STEEL Ø (in)				W-SHAPE STEEL				REMARKS	SIGN DETAIL																																																																																																																																																																																																																																																																																																																																																																																																																																																																																																																																																																																																																																														
					“A”	“B”	SALV SIGN	SALV TIS	REIN	SALVAGE		lb/ft	1.75	2.0	2.5	ANCHOR	SPICES	3.0	4.0	4.0 MOD.	FOUND- ATION	3.0	3.5	4.0	5.0	FTG. SIZE		WEIGHT		POST SIZE	DETAIL ON SHEET NUMBER	STD. SHEET NUMBER																																																																																																																																																																																																																																																																																																																																																																																																																																																																																																																																																																																																																																												
		24”	30”																																																																																																																																																																																																																																																																																																																																																																																																																																																																																																																																																																																																																																																																									
				lb/ft																						lb/ft																																																																																																																																																																																																																																																																																																																																																																																																																																																																																																																																																																																																																																																		
				1.12																						2.0	3.0						1.88	2.16	3.35	1.3	1.7	1.7	7.6	9.0	10.8	14.6																																																																																																																																																																																																																																																																																																																																																																																																																																																																																																																																																																																																																																		
OPTION ITEMS																																																																																																																																																																																																																																																																																																																																																																																																																																																																																																																																																																																																																																																																												
12+50 LT		1	30	30	6.25			1						X															BACK TO BACK R1-1		E-143																																																																																																																																																																																																																																																																																																																																																																																																																																																																																																																																																																																																																																													
13+00 LT		1	24	30	5.0					1				X															REFER TO STANDARD E-121 FOR PLACEMENT. VR017		E-141																																																																																																																																																																																																																																																																																																																																																																																																																																																																																																																																																																																																																																													
63+15 RT		1	24	30	5.0					1				X															REFER TO STANDARD E-121 FOR PLACEMENT. VR017		E-141																																																																																																																																																																																																																																																																																																																																																																																																																																																																																																																																																																																																																																													
63+60 RT		1	30	30	6.25			1			1			X															BACK TO BACK R1-1		E-143																																																																																																																																																																																																																																																																																																																																																																																																																																																																																																																																																																																																																																													
73+30 RT		1	24	30	5.0					1				X															REFER TO STANDARD E-121 FOR PLACEMENT. VR017		E-141																																																																																																																																																																																																																																																																																																																																																																																																																																																																																																																																																																																																																																													
73+60 RT		1	30	30	6.25			1			1			X															BACK TO BACK R1-1		E-143																																																																																																																																																																																																																																																																																																																																																																																																																																																																																																																																																																																																																																													
86+10 LT		1	30	30	6.25			1			1			X															BACK TO BACK R1-1		E-143																																																																																																																																																																																																																																																																																																																																																																																																																																																																																																																																																																																																																																													
86+15 RT		1	24	30	5.0					1				X															REFER TO STANDARD E-121 FOR PLACEMENT. VR017		E-141																																																																																																																																																																																																																																																																																																																																																																																																																																																																																																																																																																																																																																													
86+50 LT		1	24	30	5.0					1				X															REFER TO STANDARD E-121 FOR PLACEMENT. VR017		E-141																																																																																																																																																																																																																																																																																																																																																																																																																																																																																																																																																																																																																																													
86+55 RT		1	30	30	6.25					1				X															R1-1		E-143																																																																																																																																																																																																																																																																																																																																																																																																																																																																																																																																																																																																																																													
95+80 LT		1	30	30	6.25			1			1			X															BACK TO BACK R1-1		E-143																																																																																																																																																																																																																																																																																																																																																																																																																																																																																																																																																																																																																																													
96+20 LT		1	24	30	5.0					1				X															REFER TO STANDARD E-121 FOR PLACEMENT. VR017		E-141																																																																																																																																																																																																																																																																																																																																																																																																																																																																																																																																																																																																																																													
FINAL POST LENGTHS ARE TO BE DETERMINED IN THE FIELD. POST SIZES ARE COMPUTED BASED ON INFORMATION FURNISHED ON THE STANDARD SHEET AND THE ROADWAY, TRAFFIC & SAFETY AND PAVEMENT MANAGEMENT SECTION'S SIGN POST DESIGN GUIDELINE.			SF			SF	EA.	SF				FT	FT	FT	FT	FT	FT		EA.	LB	LB	LB	EA.	LB	LB	LB	LB	EA.	EA.	LB																																																																																																																																																																																																																																																																																																																																																																																																																																																																																																																																																																																																																																														

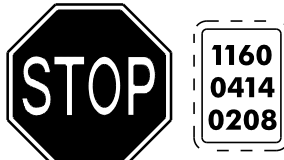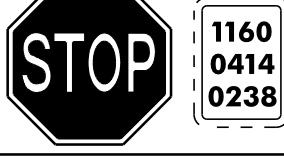KILOMETER MARKER, STATION, OR SIGN NUMBER	SIGN LEGEND	SIGN DIMENSIONS			NEW & SALVAGED SIGNS				EXIST POST RETAI N	NO. OF POST S	NEW SIGN POSTS																REMARKS	SIGN DETAIL						
											FLANGED CHANNEL			SQUARE STEEL (in)			TUBULAR ALUMINUM Ø (in)			TUBULAR STEEL Ø (in)				W-SHAPE STEEL						DETAIL ON SHEET NUMBER	STD. SHEET NUMBER			
		E A	WIDTH (in)	HEIGHT (in)	“A”	“B”	SALV SIGN	SALV TIS			lb/ft	1.75	2.0	2.5	ANCHOR RO S	S C R E W S	3.0	4.0	4.0 MOD.	FOUND- ATION	3.0	3.5	4.0	5.0	FTG. SIZE			WEIGHT	POST SIZE			SC R E W S	R O U T E O R D E R	
																									1.12	2.0								3.0
OPTION ITEMS																																		
96+38 LT		1	30	30	6.25					1					X																	R3-76		E-140
97+75 LT		1	30	30	6.25					1					X																	VR-921		E-145A
109+85 LT		1	30	30	6.25				1						X																	BACK TO BACK R1-1		E-143
110+20 LT		1	24	30	5.0					1					X																REFER TO STANDARD E-121 FOR PLACEMENT. VR-017		E-141	
								1																										
111+25 LT		1	30	30	6.25					1					X																	VR-921		E-145A
116+40 RT		1	30	30	6.25					1					X																	VR-921		E-145A
								1																										
117+52 RT		1	30	30	6.25					1					X																	R3-7R		E-140
117+95 RT		1	24	30	5.0					1					X																REFER TO STANDARD E-121 FOR PLACEMENT. VR-017		E-141	
118+45 RT		1	30	30	6.25				1						X																	BACK TO BACK R1-1		E-143
118+50 LT		1	30	30	6.25					1					X																	R3-7L		E-140
120+50 LT		1	30	30	6.25					1					X																MIRROR IMAGE OF VR-921		E-145A	
FINAL POST LENGTHS ARE TO BE DETERMINED IN THE FIELD. POST SIZES ARE COMPUTED BASED ON INFORMATION FURNISHED ON THE STANDARD SHEET AND THE ROADWAY, TRAFFIC & SAFETY AND PAVEMENT MANAGEMENT SECTION'S SIGN POST DESIGN GUIDELINE.					SF	SF	EA.	SF			FT	FT	FT	FT	FT	FT		EA.	LB	LB	LB	EA.	LB	LB	LB	LB	EA.	EA.	LB	TRAFFIC SIGN SUMMARY SHEET #3		PROJECT: ST. GEORGE-SO. BURLINGTON		PROJECT NO.: ST-STP 2508(1)S
														165														DESIGN FILE NAME: p05b052.dgn IPARM FILE NAME: p05b052ts03.i SURVEYED BY: SQUAD LEADER:				PLOT DATE: 03-MAY-2012 17:55 SURVEY DATE: DRAWN BY: C.E.A., INC. SHEET: 32 OF 42		
			SHEET TOTALS		66.25		4							165																				






KILOMETER MARKER, STATION, OR SIGN NUMBER	SIGN LEGEND	SIGN DIMENSIONS			NEW & SALVAGED SIGNS				EXIST POST REMAIN SALVAGE		NO. OF POSTS	FLANGED CHANNEL			SQUARE STEEL (in)			NEW SIGN POSTS			TUBULAR STEEL Ø (in)				TUBULAR ALUMINUM Ø (in)				W-SHAPE STEEL Ø (in)				REMARKS				SIGN DETAIL																																																																																																																																																																																																																																																																																																																																																																																																																		
																		TUBULAR ALUMINUM Ø (in)																					TUBULAR STEEL Ø (in)				W-SHAPE STEEL Ø (in)																																																																																																																																																																																																																																																																																																																																																																																																												
		E A	WIDTH (in)	HEIGHT (in)	“A”	“B”	SALV SIGN	SALV TIS	lb/ft	lb/ft		
TRAFFIC SIGN SUMMARY SHEET 5

[illegible]

KILOMETER MARKER, STATION, OR SIGN NUMBER	SIGN LEGEND	SIGN DIMENSIONS			NEW & SALVAGED SIGNS				EXIST POST RETAI N	S ALV AGE	NO. OF POST S	NEW SIGN POSTS															REMARKS	SIGN DETAIL										
												FLANGED CHANNEL			SQUARE STEEL (in)			TUBULAR ALUMINUM Ø (in)			TUBULAR STEEL Ø (in)				W-SHAPE STEEL				DETAIL ON SHEET NUMBER	STD. SHEET NUMBER								
		E A	WIDTH (in)	HEIGHT (in)	“A”	“B”	SALV SIGN	SALV TIS				lb/ft			1.75	2.0	2.5	ANCHOR RO S	FLANGE S	3.0	4.0	4.0 MOD.	FOUND- ATION	3.0	3.5	4.0		5.0			FTG. SIZE		WEIGHT	POST SIZE	SIGN POST RELOC ATED OR NEW			
												1.12	2.0	3.0																	1.88	2.16				3.35	1.3	1.7
OPTION ITEMS																																						
162+15 LT		1	48	30	10.0						2					X															VR-932		E-145B					
165+00 RT							2				2					X															RELOCATE EXISTING INFORMATION SIGNS.							
165+55 LT		1	30	30	6.25						1					X															R1-1		E-143					
165+95 LT		1	24	30	5.0						1					*															REFER TO STANDARD E-121 FOR PLACEMENT. VR-017		E-141					
166+24 RT		1	36	36	9.0						2					*																W3-3		E-152				
167+00 LT		1	30	30	6.25						1					X																VR-921		E-145A				
180+00 LT		1	36	36	9.0						2					*																POSTS OKAY (SQUARE TUBE) W3-3		E-152				
187+15 LT		1	30	30	6.25		1				1					*																POSTS OKAY (SQUARE TUBE) BACK TO BACK R1-1		E-143				
187+50 LT		1	24	30	5.0						1					*																	REFER TO STANDARD E-121 FOR PLACEMENT. VR-017		E-141			
189+65 LT		1	30	30	6.25		1				1					X																BACK TO BACK R1-1 USED EXISTING STUB		E-143				
189+95 LT		1	24	30	5.0						1					*																REFER TO STANDARD E-121 FOR PLACEMENT. VR-017		E-141				
FINAL POST LENGTHS ARE TO BE DETERMINED IN THE FIELD. POST SIZES ARE COMPUTED BASED ON INFORMATION FURNISHED ON THE STANDARD SHEET AND THE ROADWAY, TRAFFIC & SAFETY AND PAVEMENT MANAGEMENT SECTION'S SIGN POST DESIGN GUIDELINE.					SF	SF	EA.	SF				FT	FT	FT	FT	FT	FT			EA.	LB	LB	LB	EA.	LB	LB	LB	EA.	EA.	LB			TRAFFIC SIGN SUMMARY SHEET #6		PROJECT: ST. GEORGE-SO. BURLINGTON		PROJECT NO.: ST-STP 2508(1)S	
													226													DESIGN FILE NAME: p05b052.dgn IPARM FILE NAME: p05b052ts06.i		PLOT DATE: 03-MAY-2012 17:55										
			SHEET TOTALS		68.0		5							226																						SURVEYED BY:		DRAWN BY: C.E.A., INC.
																																	SQUAD LEADER:		SHEET: 35 OF 42			

TRAFFIC SIGN SUMMARY SHEET 7

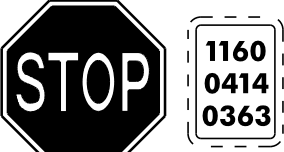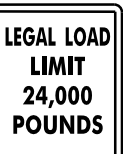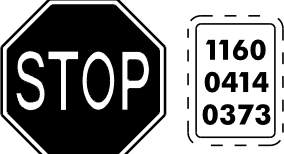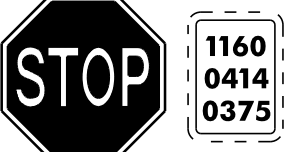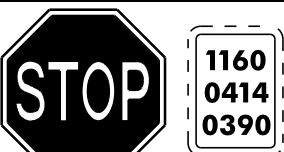KILOMETER MARKER, STATION, OR SIGN NUMBER	SIGN LEGEND	SIGN DIMENSIONS			NEW & SALVAGED SIGNS				EXIST POST RE TAIN	NO. OF POSTS	NEW SIGN POSTS												REMARKS	SIGN DETAIL										
					FLANGED CHANNEL	SQUARE STEEL (in)					TUBULAR ALUMINUM Ø (in)			TUBULAR STEEL Ø (in)				W-SHAPE STEEL				DETAIL ON SHEET NUMBER		STD. SHEET NUMBER										
		lb/ft	1.75	2.0		2.5	ANCHOR RODS	FLANGE PLATE			3.0	4.0	4.0 MOD.	FOUND- ATION	3.0	3.5	4.0	5.0	FTG. SIZE		WEIGHT				POST SIZE									
			1.12	2.0		3.0					1.88	2.16	3.35		1.3	1.7	1.7	7.6	9.0	10.8						14.6	24"	30"						
OPTION ITEMS																																		
191+60 RT		1	24	30	5.0						1				X															REFER TO STANDARD E-121 FOR PLACEMENT. VR-017		E-141		
191+60 RT		1	24	30	5.0		+				1				X															R2-1				
192+00 RT		1	30	30	6.25		+				1				*															BACK TO BACK R1-1 LEGAL AS IS		E-143		
196+95 RT		1	24	30	5.0						1				*															REFER TO STANDARD E-121 FOR PLACEMENT. VR-017 POSTS OKAY (SQUARE TUBE)		E-141		
197+40 RT		1	30	30	6.25			1			1				*															BACK TO BACK R1-1 USED EXISTING POST, NEW STUB		E-143		
197+95 LT		1	30	30	6.25			1			1				*															BACK TO BACK R1-1 LEGAL AS IS		E-143		
198+25 LT		1	24	30	5.0		1				1				X															REFER TO STANDARD E-121 FOR PLACEMENT. VR-017 NEW POST ONLY		E-141		
200+45 RT		1	30	30	6.25						1				*															LEGAL AS IS		E-152		
		1	24	12	2.0																									LEGAL AS IS W16-7P	40			
202+40 LT		1	30	30	6.25						1				*															LEGAL AS IS R1-1		E-143		
202+75 LT		1	24	30	5.0						1				*															REFER TO STANDARD E-121 FOR PLACEMENT. VR-017 POSTS OKAY		E-141		
205+95 LT		1	30	30	6.25		+				1				*															LEGAL AS IS BACK TO BACK R1-1		E-143		
FINAL POST LENGTHS ARE TO BE DETERMINED IN THE FIELD. POST SIZES ARE COMPUTED BASED ON INFORMATION FURNISHED ON THE STANDARD SHEET AND THE ROADWAY, TRAFFIC & SAFETY AND PAVEMENT MANAGEMENT SECTION'S SIGN POST DESIGN GUIDELINE.					SF	SF	EA.	SF			FT	FT	FT	FT	FT	FT	EA.	LB	LB	LB	EA.	LB	LB	LB	EA.	EA.	LB			TRAFFIC SIGN SUMMARY SHEET #7	PROJECT: ST. GEORGE-SO. BURLINGTON		PROJECT NO.: ST-STP 2508(1)S DATE: 8-06	
																												DESIGN FILE NAME: p05b052.dgn IPARM FILE NAME: p05b052+ts07.i SURVEYED BY: SQUAD LEADER:			PLOT DATE: 03-MAY-2012 17:55 SURVEY DATE: DRAWN BY: C.E.A., INC. SHEET: 36 OF 42			
			SHEET TOTALS		59.5			5						165																				


KILOMETER MARKER, STATION, OR SIGN NUMBER	SIGN LEGEND	SIGN DIMENSIONS			NEW & SALVAGED SIGNS						EXIST POST REMAIN	NO. OF POSTS	NEW SIGN POSTS												REMARKS								SIGN DETAIL																																																																																																																																																																																																																																																																																																																																																																																																																																																																																																																																																																																																																																																																																																																																																																																																																																																																																																																																																																																																																																																																																																																																																																																																				
									FLANGED CHANNEL				SQUARE STEEL (in)			TUBULAR ALUMINUM Ø (in)			TUBULAR STEEL Ø (in)				W-SHAPE STEEL										SIGN DETAIL																																																																																																																																																																																																																																																																																																																																																																																																																																																																																																																																																																																																																																																																																																																																																																																																																																																																																																																																																																																																																																																																																																																																																																																																				
		E A	WIDTH (in)	HEIGHT (in)	"A"	"B"	SALV SIGN	SALV TIS	1.75	2.0			2.5	ANCHOR ROD	SUMMIT PLATE	3.0	4.0	4.0 MOD.	FOUND- ATION	3.0	3.5	4.0	5.0	FTG. SIZE									WEIGHT	POST SIZE	SIGN POST ELEVATION	POST ELEVATION	DETAIL ON SHEET NUMBER	STD. SHEET NUMBER																																																																																																																																																																																																																																																																																																																																																																																																																																																																																																																																																																																																																																																																																																																																																																																																																																																																																																																																																																																																																																																																																																																																																																																															
																								lb/ft															lb/ft	lb/ft	lb/ft	24"	30"																																																																																																																																																																																																																																																																																																																																																																																																																																																																																																																																																																																																																																																																																																																																																																																																																																																																																																																																																																																																																																																																																																																																																																																										

TRAFFIC SIGN SUMMARY SHEET 9


[illegible]

NOTES


1. SEE STANDARD G-1& G-ID FOR STEEL BEAM GUARD RAIL DETAILS.
2. THIS WORK SHALL BE PAID UNDER ITEM 900.640, SPECIAL PROVISION (STEEL BEAM GUARDRAIL, GALVANIZED/NESTED).

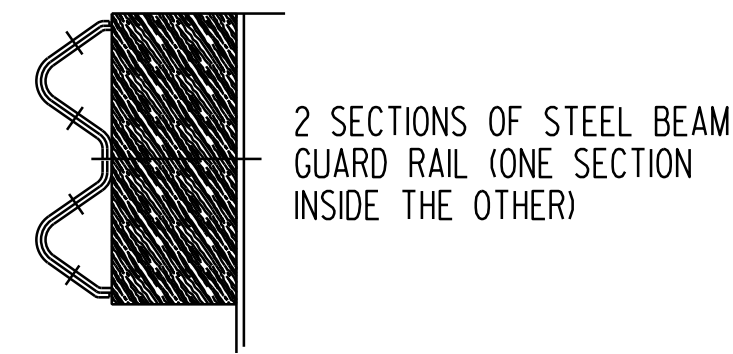


DETAIL A

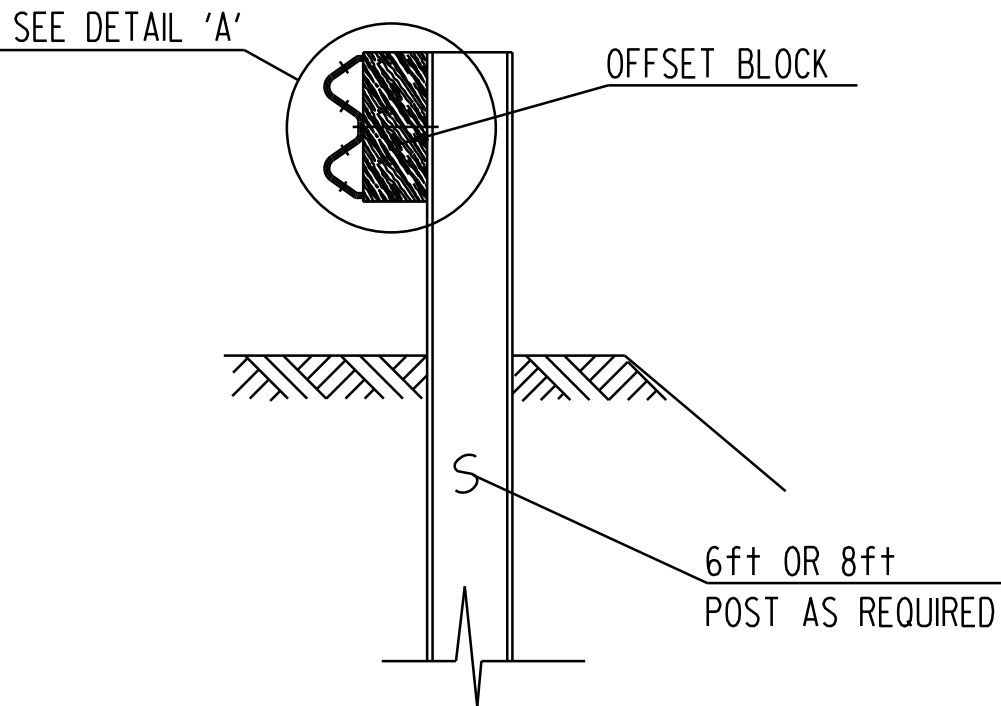


SECTION A-A

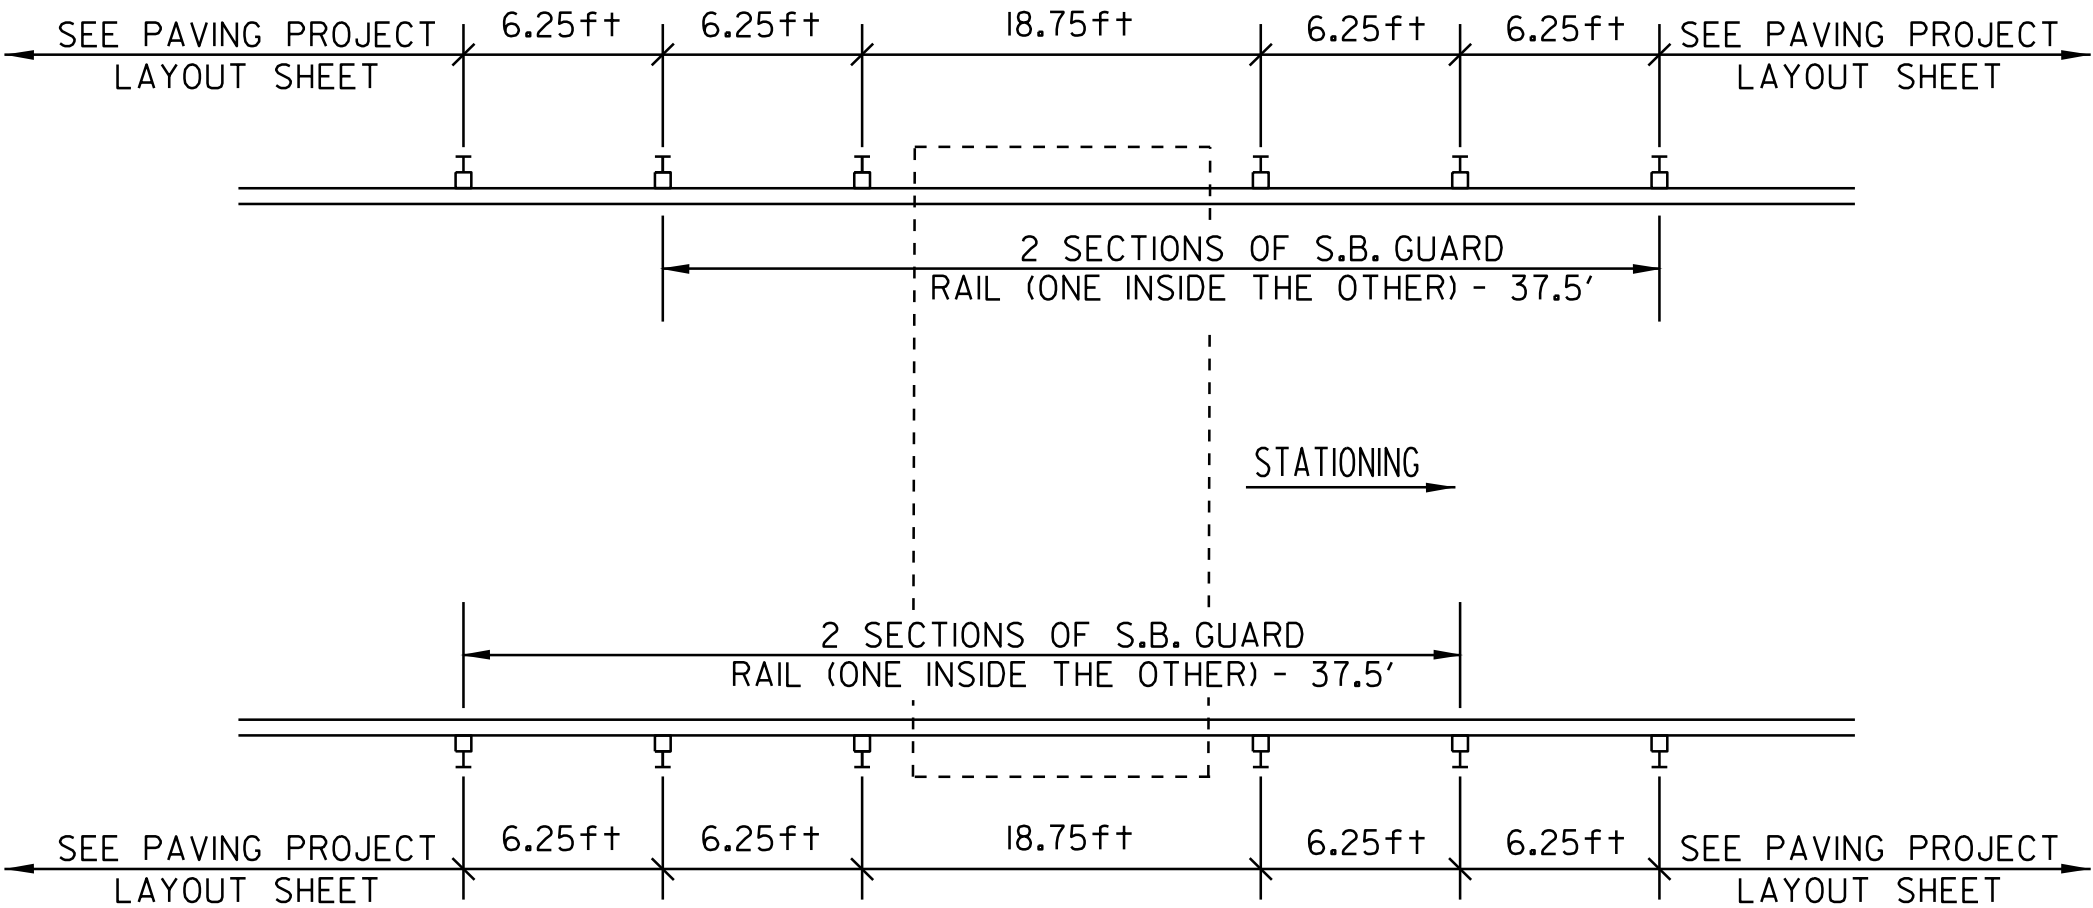

WILLISTON – BRIDGE #30
STA 22+02 = MM 0.417

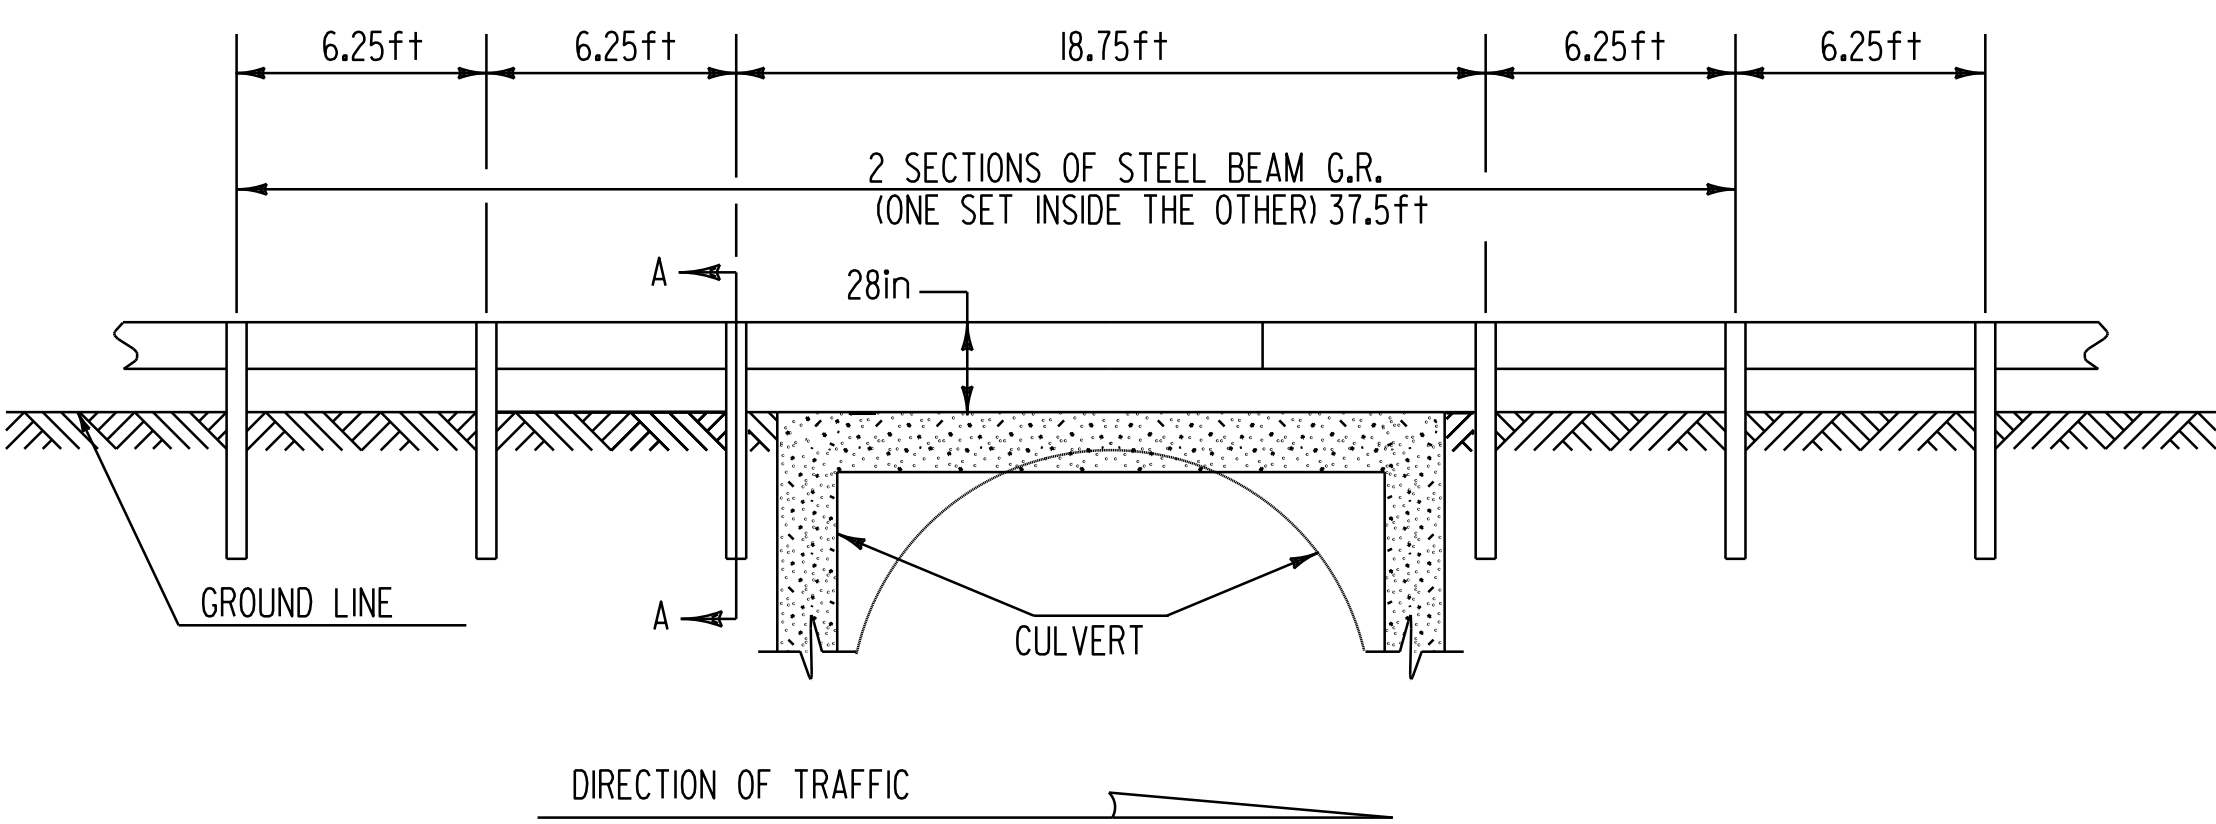


DETAIL OF STEEL BEAM GUARD RAIL AT LARGE CULVERTS

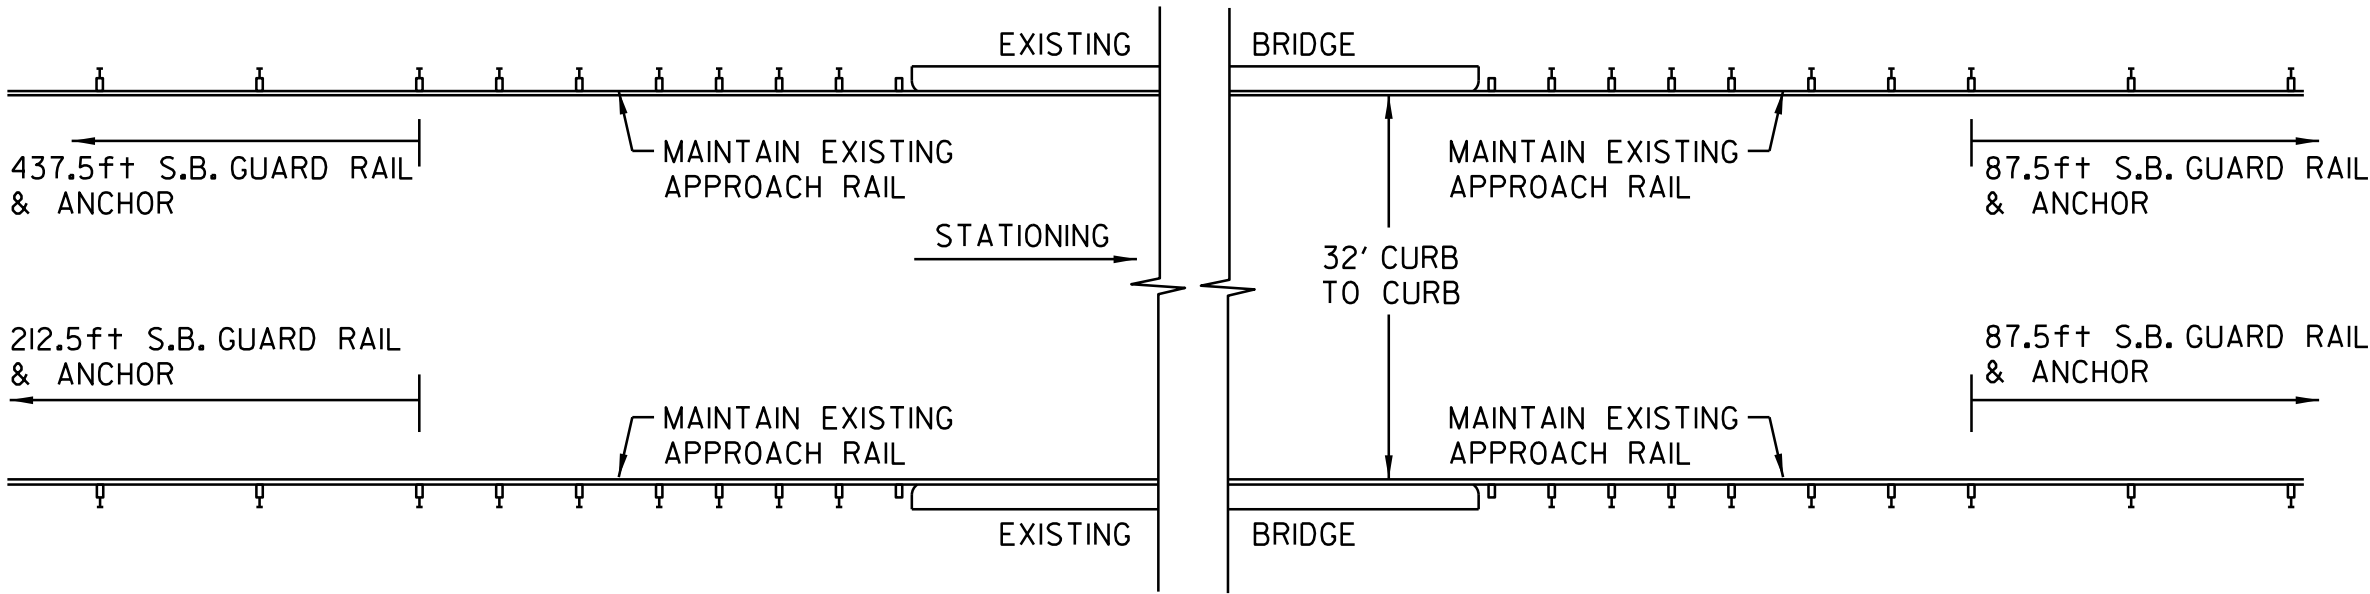


SOUTH BURLINGTON – BRIDGE #31
STA 139+83 = MM 2.648

BRIDGE
DETAIL
SHEET
#1

DESIGNED BY	BCE/PJM	DATE	6-07
DRAWN BY	C.E.A., INC.	DATE	6-07
DESIGN FILE NO.	p05b052.dgn		
PRF FILE	p05b052d+03.i	DATE PLOTTED	03-MAY-2012 17:3
PROJ. NAME	ST. GEORGE-SO. BURLINGTON		
PROJ. NO.	ST-STP 2508(1)S		
SHEET	39	OF	42 SHEETS

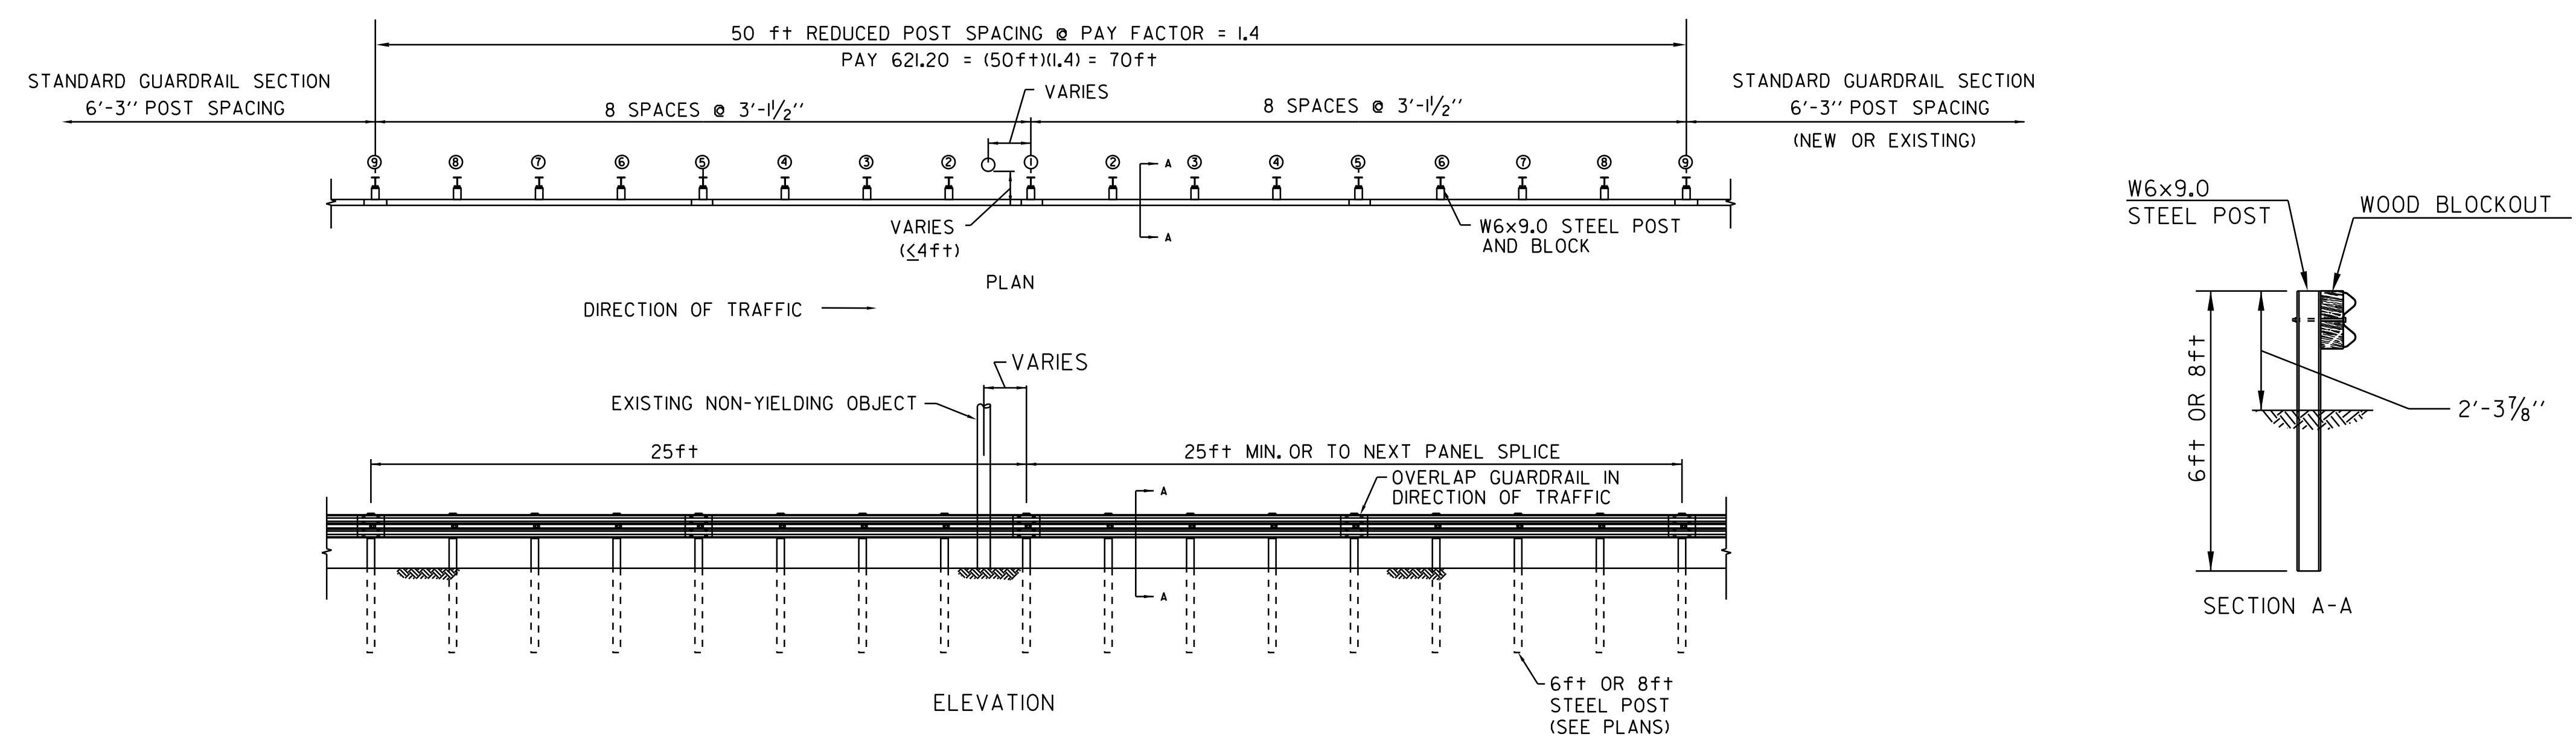


NON-YIELDING OBJECT APPROACH DETAIL
SHELBURNE
STA 78+25 LT

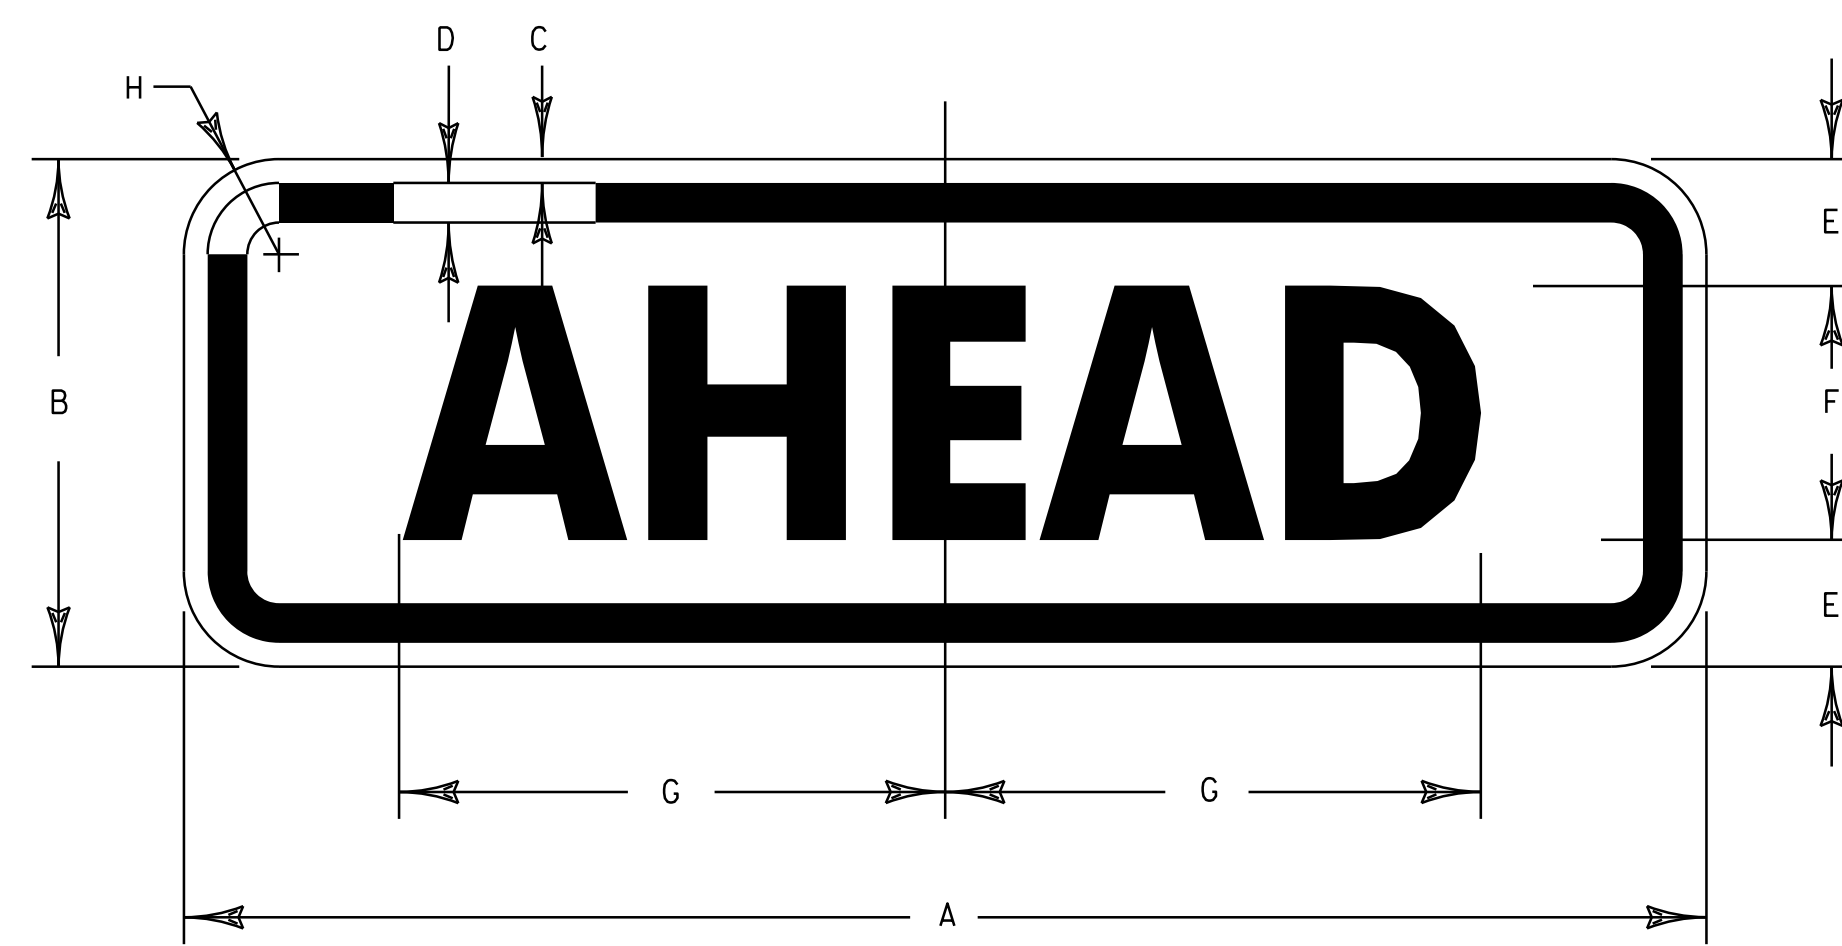

W16-7P
SO. BURLINGTON
STA 200+45 RT
STA 213+20 RT



SIGN	DIMENSIONS (in)							
	A	B	C	D	E	F	G	H
	24	12	3/8	5/8	3	6D	8	1 1/2

**NON-YIELDING OBJECT
APPROACH and
SIGN DETAIL SHEET**

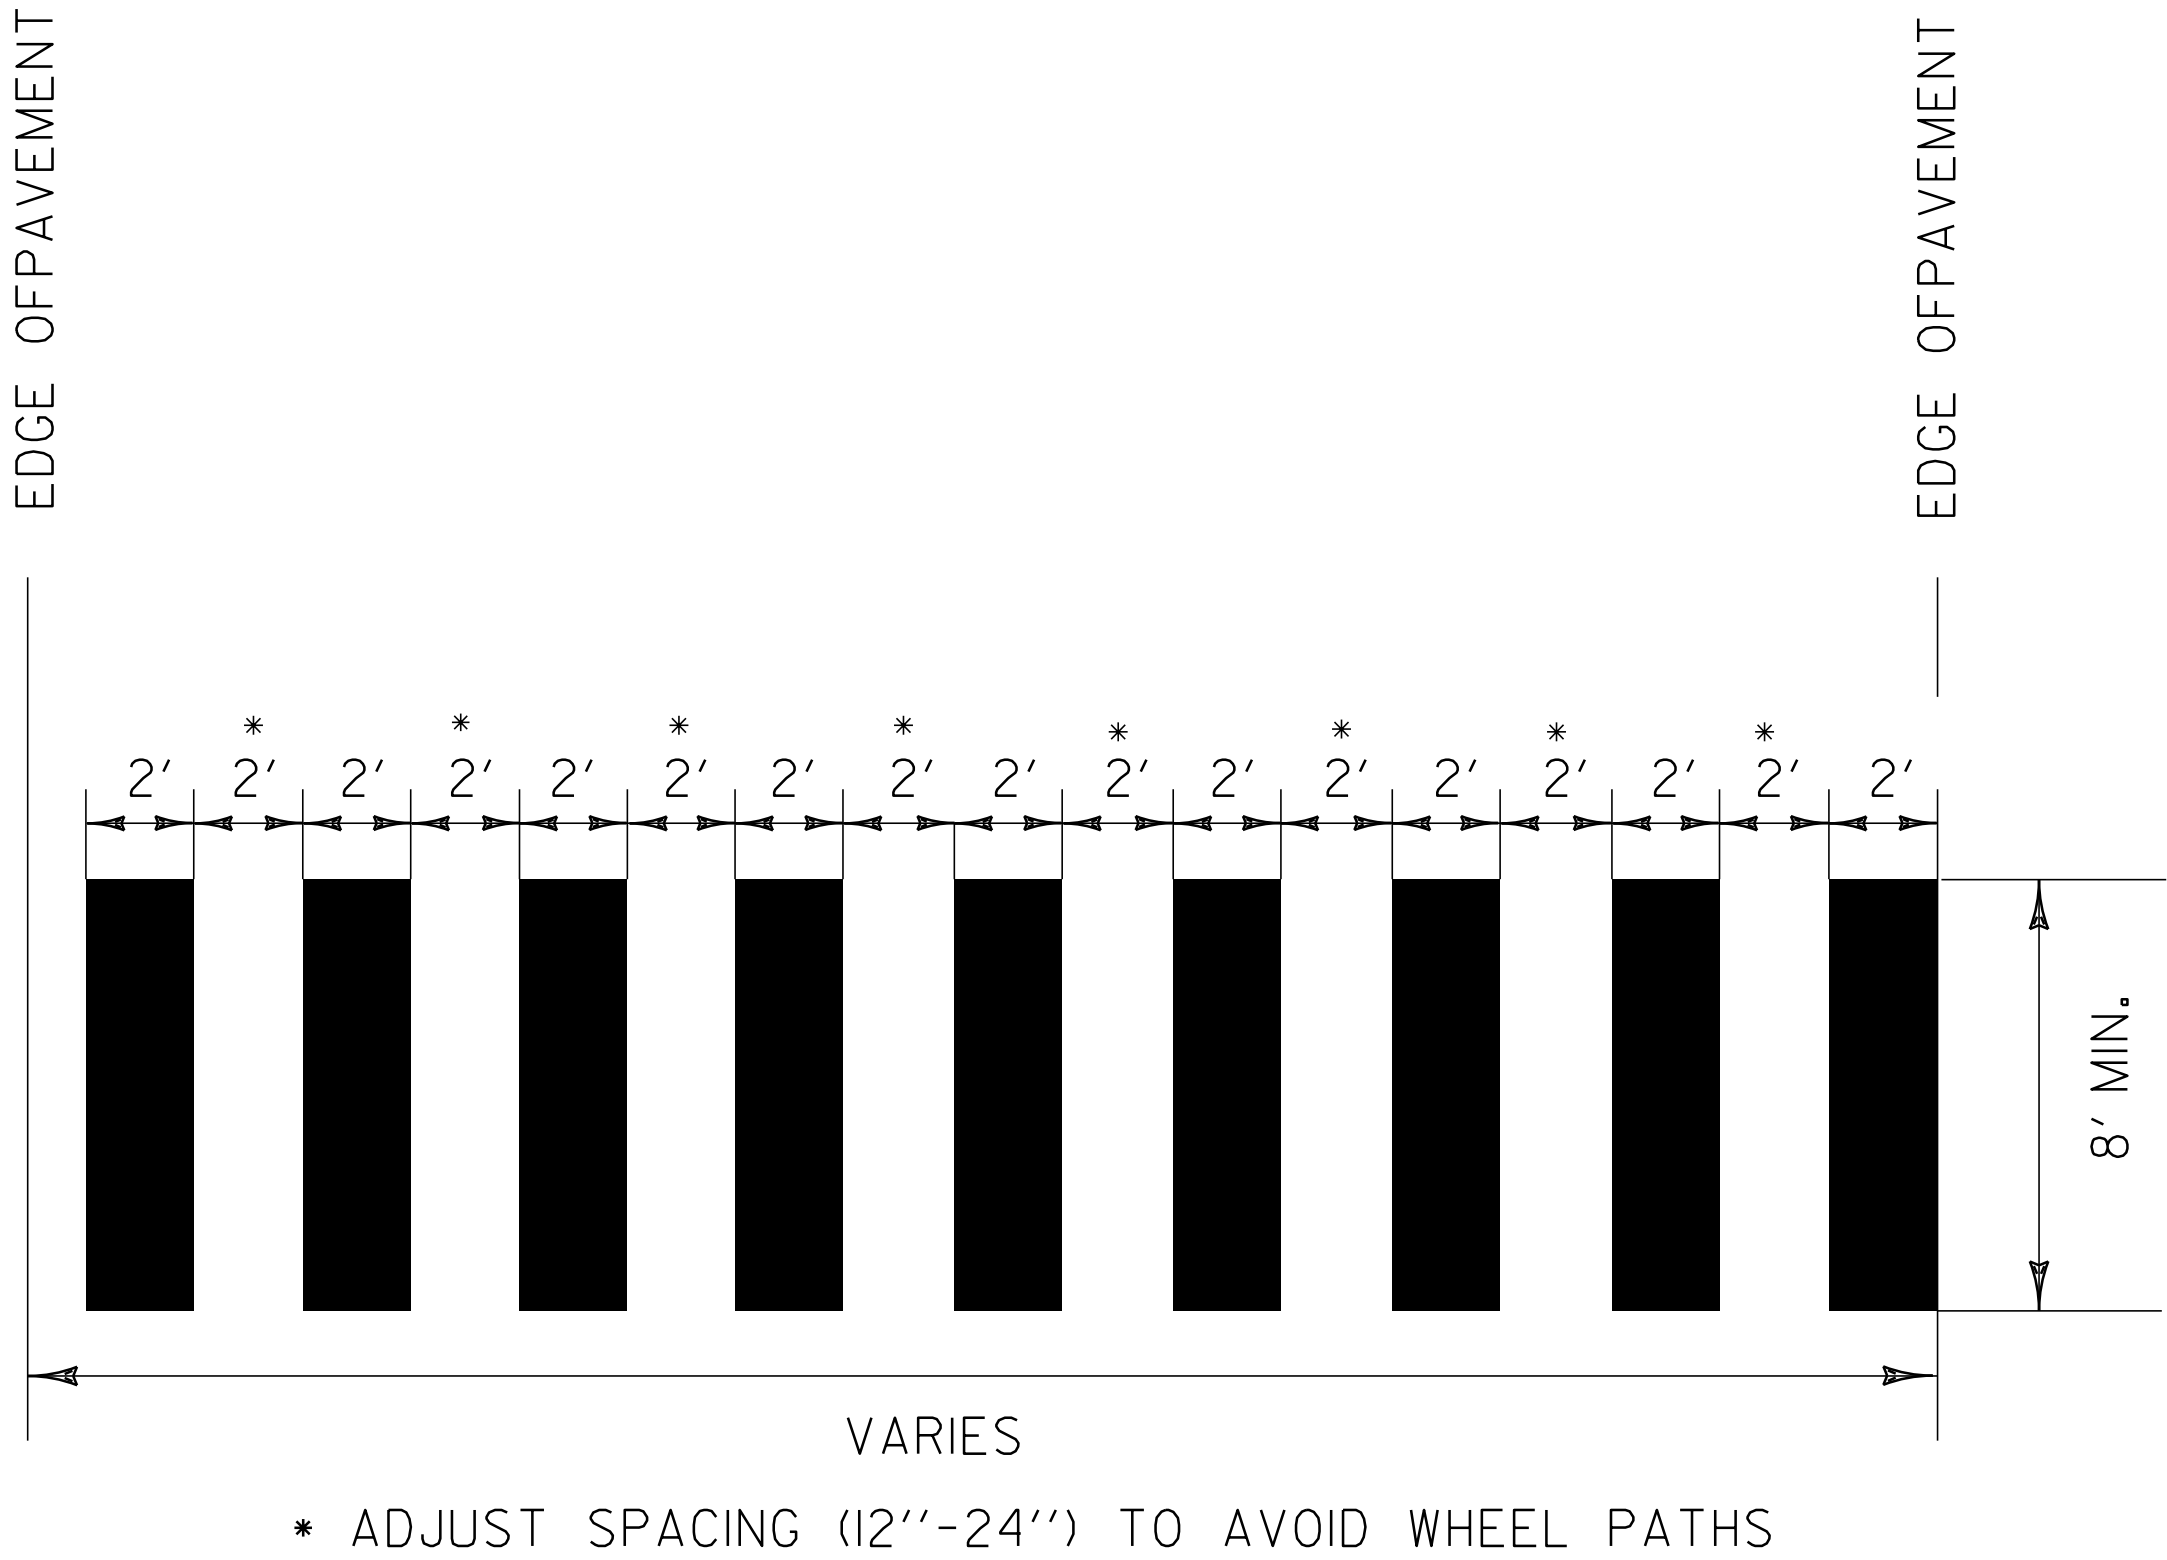

* ADJUST SPACING (12''-24'') TO AVOID WHEEL PATHS

BLOCK PATTERN CROSSWALK DETAIL

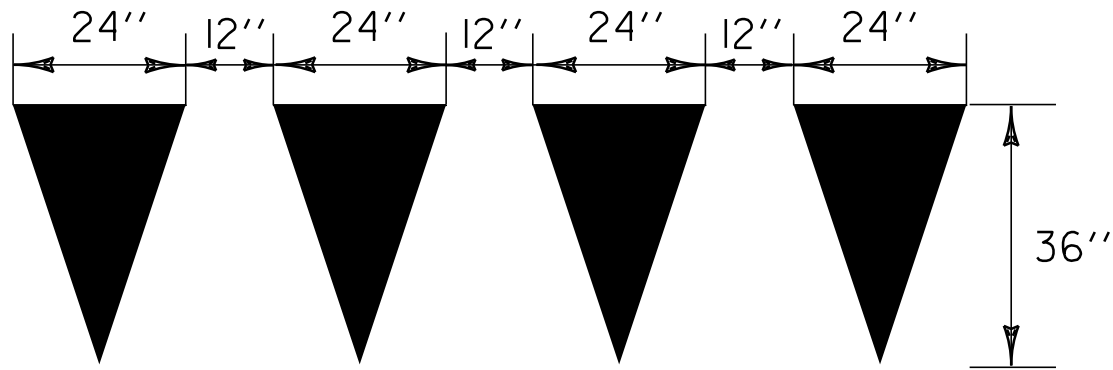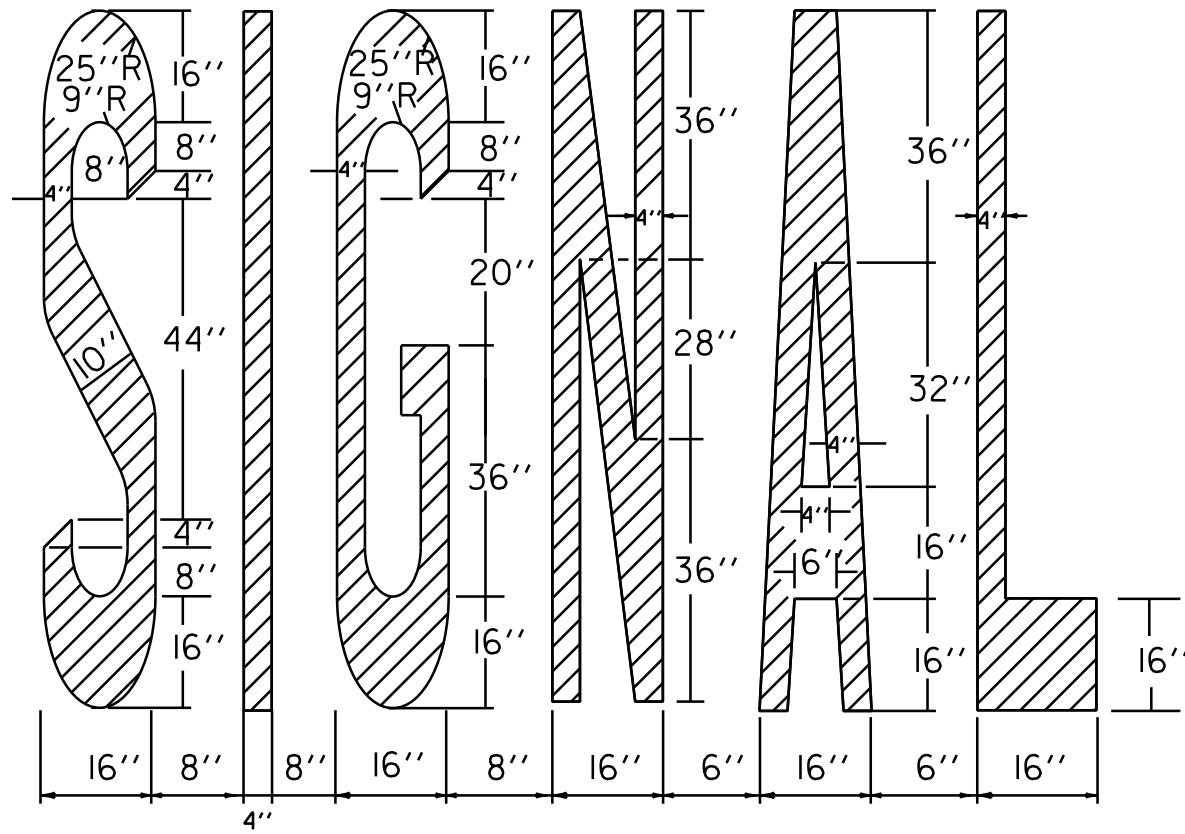


YIELD LINE DETAILS

TO BE INSTALLED ONLY AT THE
DIRECTION OF THE RESIDENT ENGINEER
TO BE PAID AS ONE LETTER OR SYMBOL
PER TRIANGLE

**PAVEMENT MARKING
DETAIL SHEET**

DESIGNED BY	BCE/PJM	DATE	6-07
DRAWN BY	C.E.A., INC.	DATE	6-07
DESIGN FILE NO.	p05b052.dgn		
PRF FILE	p05b052pmd.i	DATE PLOTTED	03-MAY-2012 17:3
PROJ. NAME	ST. GEORGE-SO. BURLINGTON		
PROJ. NO.	ST-STP 2508(1)S		
SHEET	41	OF	42 SHEETS

DATUM	
VERTICAL	N/A
HORIZONTAL	N/A

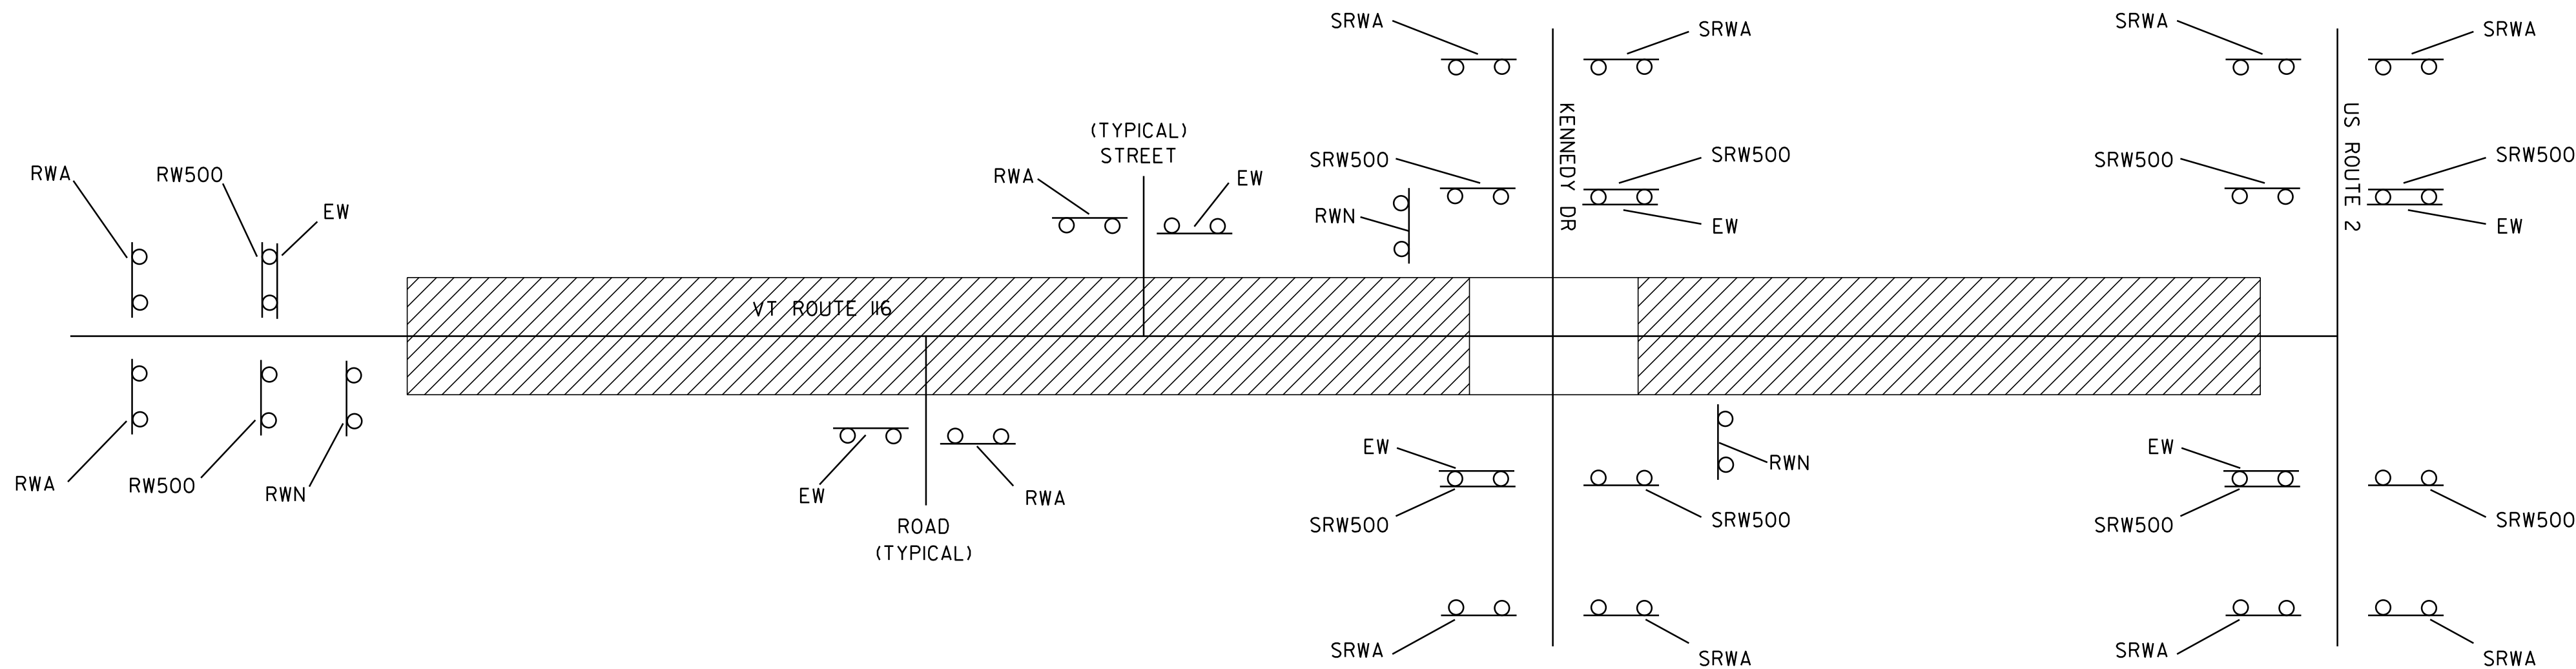

LEGEND
RWA = ROAD WORK AHEAD
RW500 = ROAD WORK 500 FEET
EW = END WORK
RWN = ROAD WORK NEXT 11MILES
SRWA = SIDE ROAD WORK AHEAD
SRW500 = SIDE ROAD WORK 500 FEET

CONSTRUCTION APPROACH SIGNING



SEE STD. E-100 FOR SIGN PLACEMENT

RESIDENT ENGINEER, AT HIS OR HER DISCRETION, SHALL ELIMINATE CONSTRUCTION APPROACH SIGNING AT DEAD END LOCATIONS.

LIST OF CONSTRUCTION SIGNS

TOWN HIGHWAY	RWA	RW500	SRWA	SRW500	EW	RWN
ST. GEORGE						
BEGIN PROJECT	2	2				
VT ROUTE 2A						
TH #5						
SHELBURNE						
TH#19						
ST. GEORGE						
TH #6						
TH #7						
SOUTH BURLINGTON						
TH#10						
TH#23						
TH#146						
BUTLER DR.						
TH#163						
TH#159						
TH#157						
MEADOWLAND DR (VERIZON)						
TH#9						
ELDREDGE RD						
TH #145						
KENNEDY DR			4	4	2	2
TH #68						
TH #67						
TH #120						
LILAC LANE						
TH #12						
TH #10						
TH #41						
TH #43						
TH #66						
MARKETPLACE RD						
END PROJECT			4	4	2	
TOTALS	30	2	8	8	33	3

- NOTES:
- THE CONTRACTOR SHALL SUBMIT A TRAFFIC CONTROL PLAN FOR APPROVAL PRIOR TO THE START OF CONSTRUCTION. THE COST OF PREPARING THIS PLAN (AND MAKING CHANGES IF NECESSARY) SHALL NOT BE PAID SEPARATELY BUT SHALL BE INCIDENTAL TO ITEM 641.10, "TRAFFIC CONTROL".
 - THE CONTRACTOR SHALL INCLUDE A CONSTRUCTION SIGN APPROACH PACKAGE FOR EXPECTED LANE CLOSURES AND WORK ZONE SPEED REDUCTIONS IN COMPLIANCE WITH VTRANS STANDARD E-103. PAYMENT FOR PROVIDING THIS PACKAGE SHALL BE INCIDENTAL TO ITEM 641.10, "TRAFFIC CONTROL".
 - PORTABLE CHANGEABLE MESSAGE SIGNS (PCMS) WILL BE PROVIDED FOR USE ALONG THIS PROJECT. THE PLACEMENT OF THESE UNITS AS WELL AS THE MESSAGE WILL BE APPROVED BY THE RESIDENT ENGINEER. THESE SIGNS WILL BE PAID FOR UNDER ITEM 641.15, "PORTABLE CHANGEABLE MESSAGE SIGN".
- PCMS SHOULD NOT REPLACE ANY OF THE SIGNING DETAILED IN THE MUTCD AND SHOULD NOT BE USED IF STANDARD TRAFFIC CONTROL DEVICES ADEQUATELY PROVIDE THE INFORMATION THE MOTORISTS NEED TO TRAVEL SAFELY.
- THE PCMS SHALL CONSIST OF EITHER ONE OR TWO PHASES. TYPICALLY, A PHASE SHALL CONSIST OF UP TO THREE LINES OF EIGHT CHARACTERS PER LINE. THE PCMS SHOULD BE USED TO SUPPLEMENT AND NOT AS A SUBSTITUTE FOR CONVENTIONAL SIGNS AND PAVEMENT MARKINGS.
- THE PCMS SHOULD COMMUNICATE WHAT INFORMATION MOTORISTS NEED TO KNOW. UNNECESSARY INFORMATION SHOULD BE AVOIDED. MESSAGES SHOULD BE UPDATED PERIODICALLY TO DESCRIBE THE WORK ACTIVITY OCCURRING SO THAT THE PCMS CONTINUES TO COMMAND THE ATTENTION OF MOTORISTS.
- THE MUTCD 2003 SHALL BE THE STANDARD FOR ALL TRAFFIC CONTROL DEVICES. EXISTING SIGNS, SIGNALS AND MARKINGS SHALL BE VALID UNTIL SUCH TIME AS THEY ARE REPLACED OR RECONSTRUCTED. WHEN NEW TRAFFIC CONTROL DEVICES ARE ERECTED OR PLACED OR EXISTING TRAFFIC CONTROL DEVICES ARE REPLACED OR REPAIRED, THE EQUIPMENT, DESIGN, METHOD OF INSTALLATION, PLACEMENT OR REPAIR SHALL CONFORM WITH SUCH STANDARDS.
 - NO CONSTRUCTION SIGNS SHALL BE INSTALLED AS TO INTERFERE OR OBSTRUCT THE VIEW OF EXISTING TRAFFIC CONTROL DEVICES, STOPPING SIGHT DISTANCE, AND CORNER SIGHT DISTANCE FROM DRIVES AND TOWN HIGHWAYS. TRAFFIC CONTROL DEVICES SHALL BE PLACED ACCORDING TO THE 2003 MUTCD AND/OR VTRANS STANDARDS.
 - ON VTRANS STANDARDS E-103, SIGN W4-2 MAY BE REPLACED WITH W9-2:
 - PAYMENT FOR CONSTRUCTION SIGNING WILL BE INCLUDED IN THE UNIT PRICE BID FOR CONTRACT ITEM 641.10, TRAFFIC CONTROL.

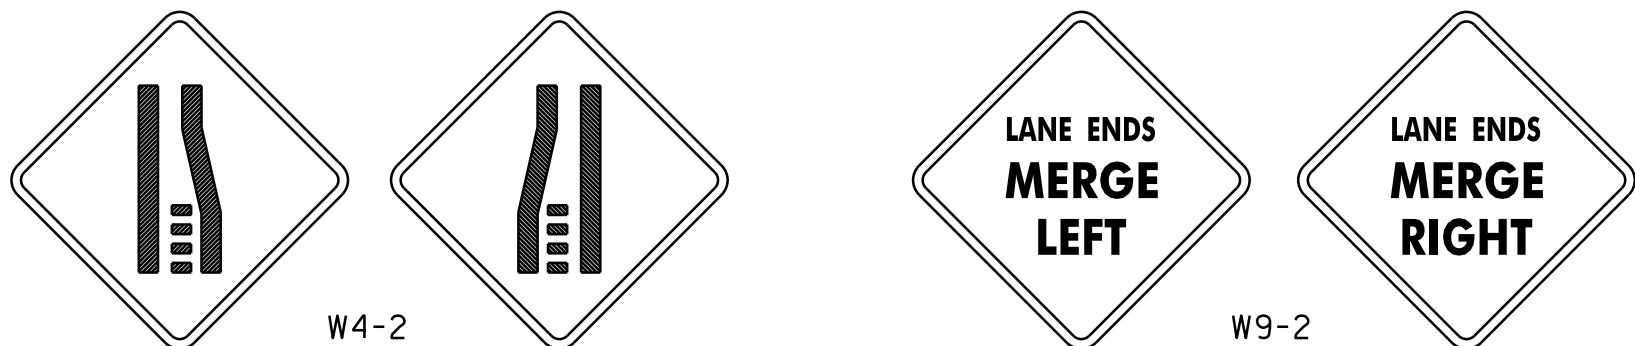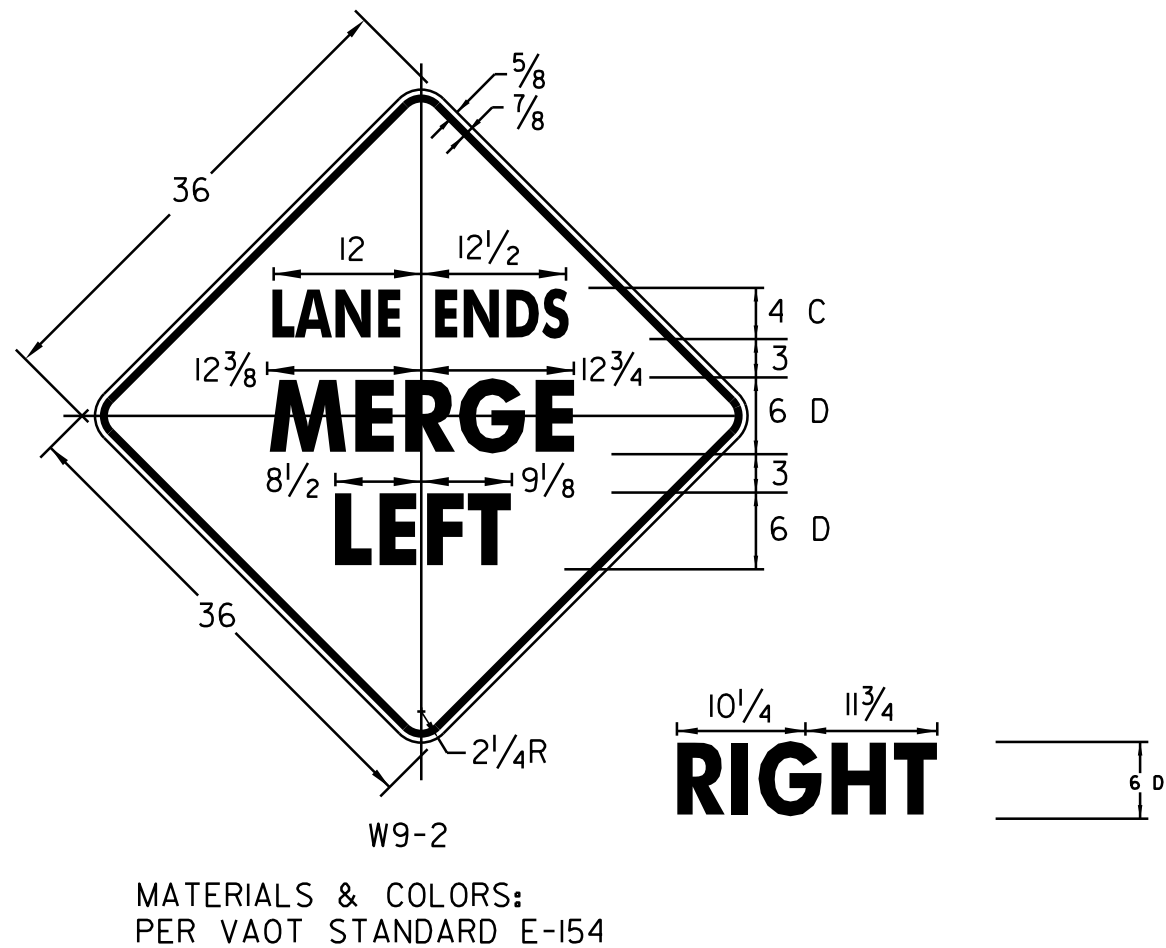

CONSTRUCTION APPROACH SIGNING

DESIGNED BY BCE/PJM DATE 6-07
DRAWN BY C.E.A., INC. DATE 6-07
DESIGN FILE NO. p05b052.dgn
PRF FILE p05b052cas.i DATE 03-MAY-2012 17:00
PROJ. NAME **ST. GEORGE-SO. BURLINGTON**
PROJ. NO. **ST-STP 2508(1)S**
SHEET **42** OF **42** SHEETS