


TEMPORARY 4in YELLOW LINE (PAINT) DURABLE 4in YELLOW LINE (THERMOPLASTIC)		TEMPORARY 4in WHITE LINE (PAINT) DURABLE 4in WHITE LINE (THERMOPLASTIC)		CHANGE ELEVATION OF D.I.'S, C.B.'S, OR M.H.'S	DITCHING LOCATIONS (REFER TO SHEET 8 FOR DETAILS)
TOWN OF MILTON STA 390+00 TO 413+42		TOWN OF MILTON STA 390+00 TO 413+42		STA 391+97 LT STA 396+00 LT	TOWN OF MILTON STA 404+50 TO 413+25 LT
TOWN OF GEORGIA STA 0+00 TO 2+50		TOWN OF GEORGIA STA 0+00 TO 2+50			TOWN OF GEORGIA STA 0+00 TO 2+50 LT
SOLID LT&RT		SOLID LT&RT			
SOLID LT&RT		SOLID LT&RT			

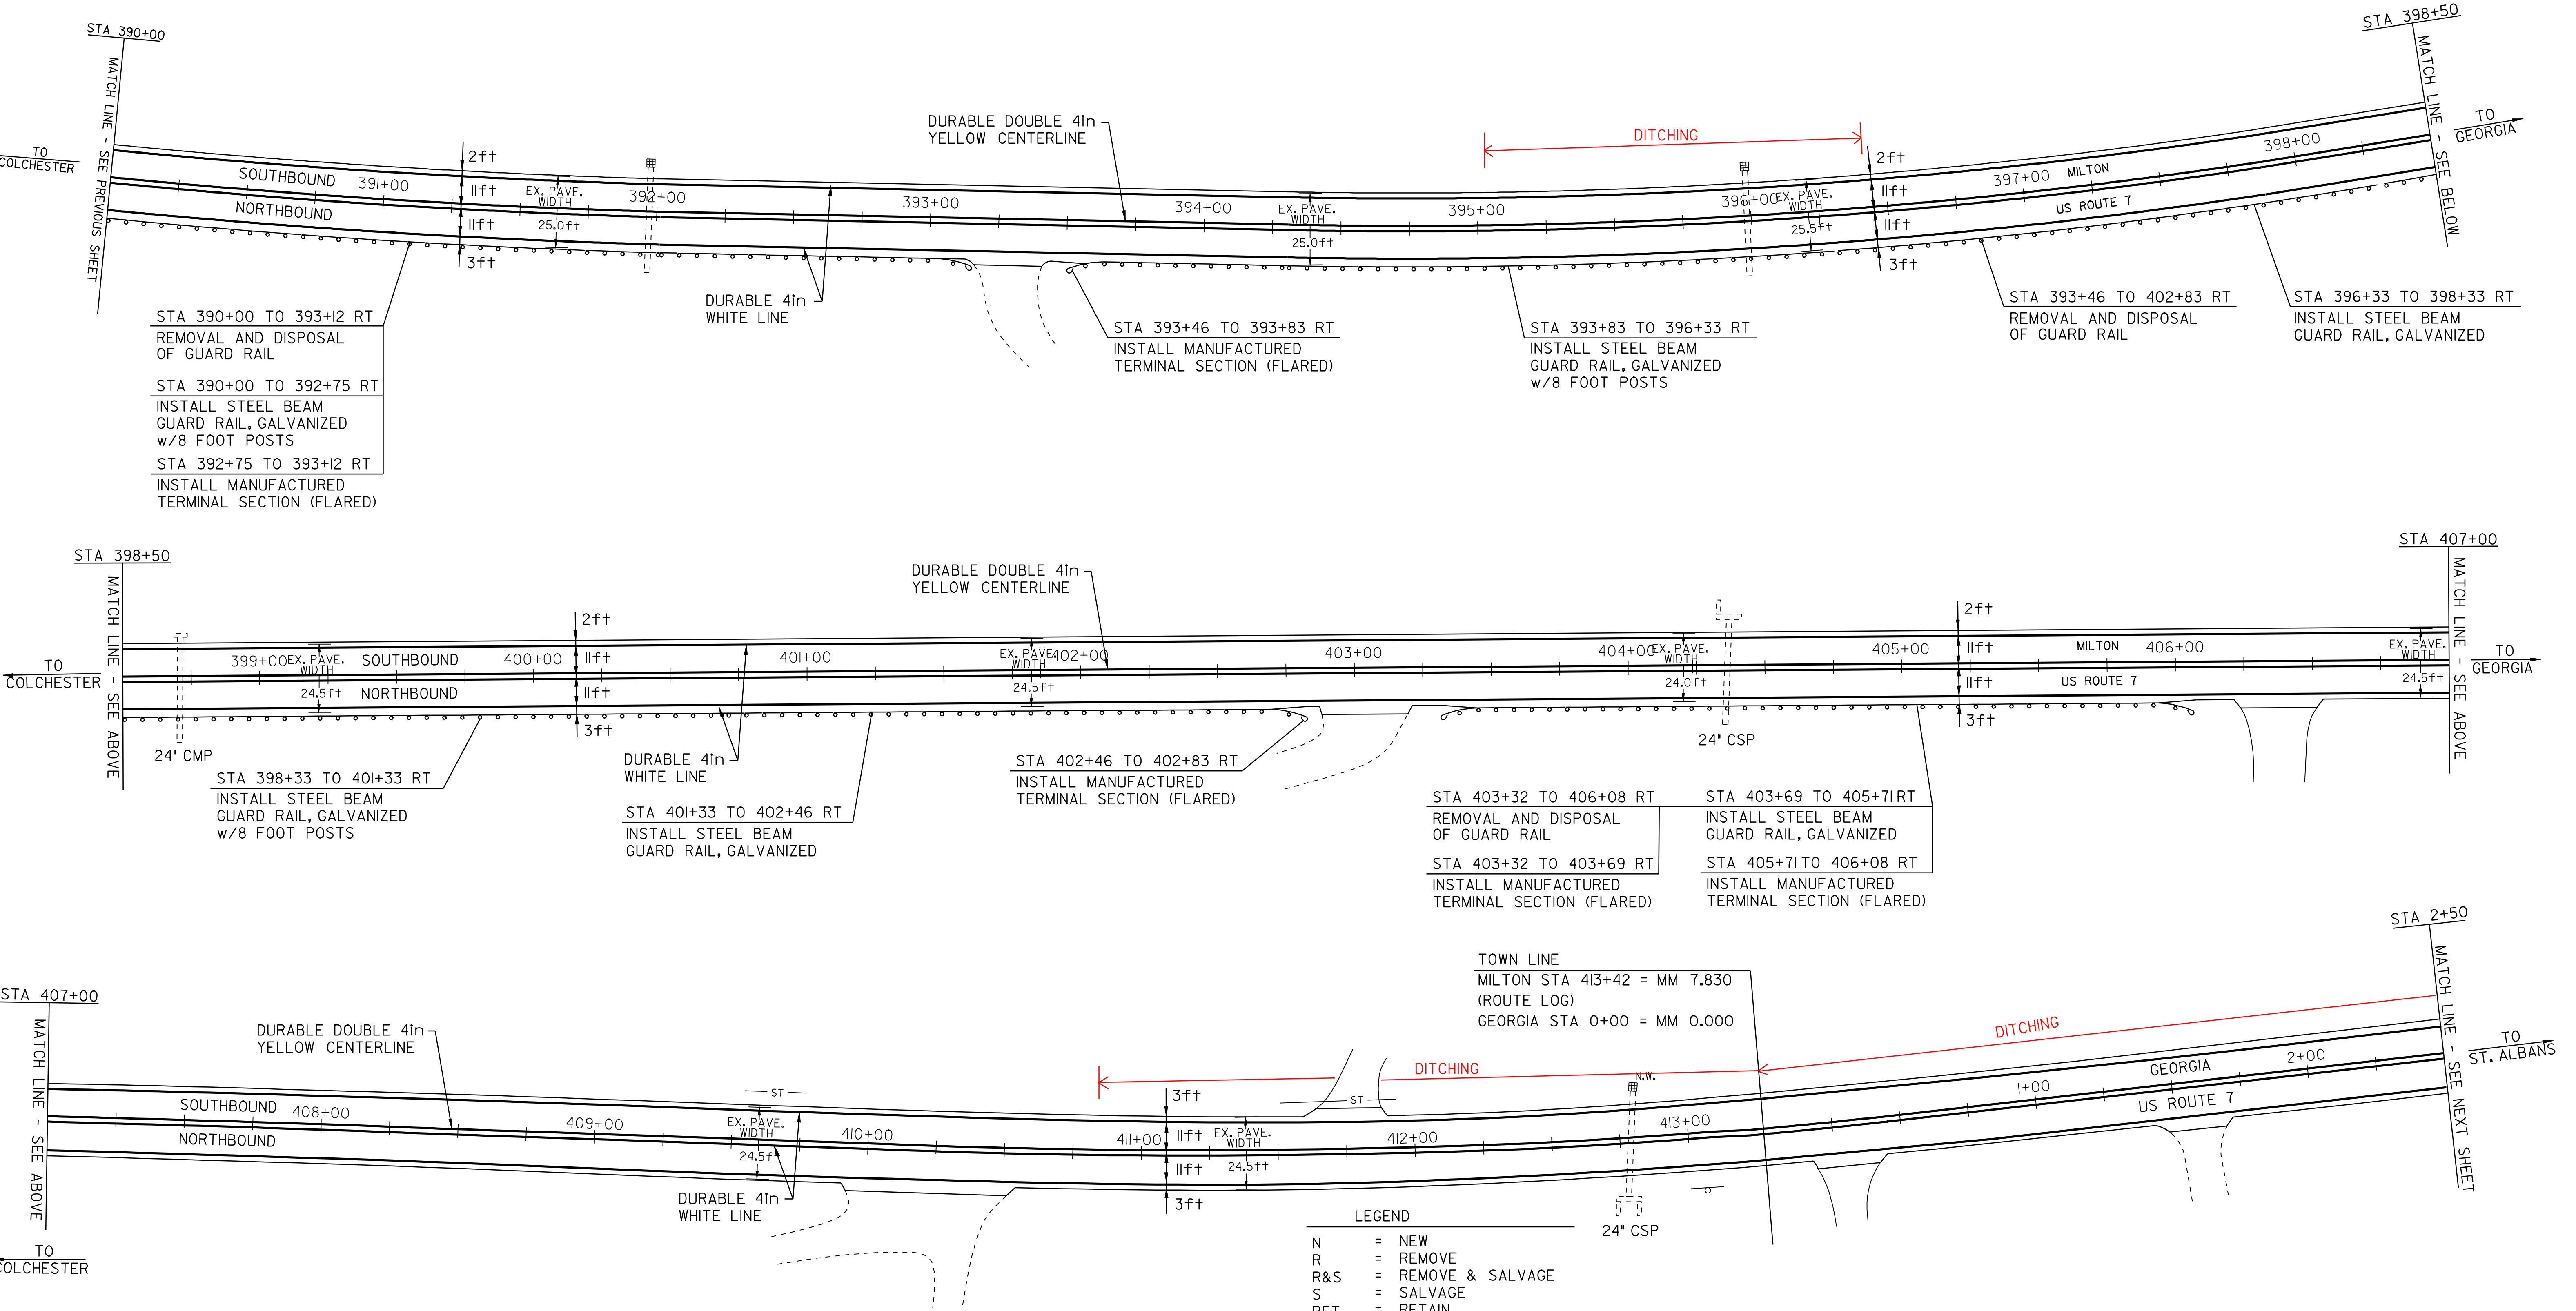

MANUFACTURED TERMINAL SECTION, FLARED

STA 392+75 TO 393+12 RT
STA 393+46 TO 393+83 RT
STA 402+46 TO 402+83 RT
STA 403+32 TO 403+69 RT
STA 405+71 TO 406+08 RT

REMOVAL AND DISPOSAL OF GUARD RAIL

STA 390+00 TO 393+12 RT
STA 393+46 TO 402+83 RT
STA 403+32 TO 406+08 RT

STEEL BEAM GUARD RAIL, GALVANIZED w/8 FOOT POSTS

STA 390+00 TO 392+75 RT
STA 393+83 TO 396+33 RT
STA 398+33 TO 401+33 RT

STEEL BEAM GUARD RAIL, GALVANIZED

STA 396+33 TO 398+33 RT
STA 401+33 TO 402+46 RT
STA 403+69 TO 405+71 RT

LEGEND

N = NEW
R = REMOVE
R&S = REMOVE & SALVAGE
S = SALVAGE
RET = RETAIN
B-TO-B = BACK TO BACK
CATCH BASIN/DI
EXISTING HYDRANT
EXISTING VALVE (WATER,GAS)
EXISTING MANHOLE (SEWER,ELECTRIC,TEL.)
= NO WORK REQUIRED (TYP. FOR VALVES,M.H.'S, & C.B.'S WHERE NOTED)
UTILITY POLE
DRIVE

PAVING PROJECT LAYOUT SHEET #23

DESIGNED BY BCE/PJM DATE 8-06

DRAWN BY C.E.A., INC. DATE 8-06

DESIGN FILE NO. 05cl58.dgn

PRF FILE 05cl58p23.i DATE PLOTTED 19-MAY-2009 12

PROJ. NAME MILTON - GEORGIA

PROJ. NO. STP 2510(1)S

SHEET 31 OF 44 SHEETS