


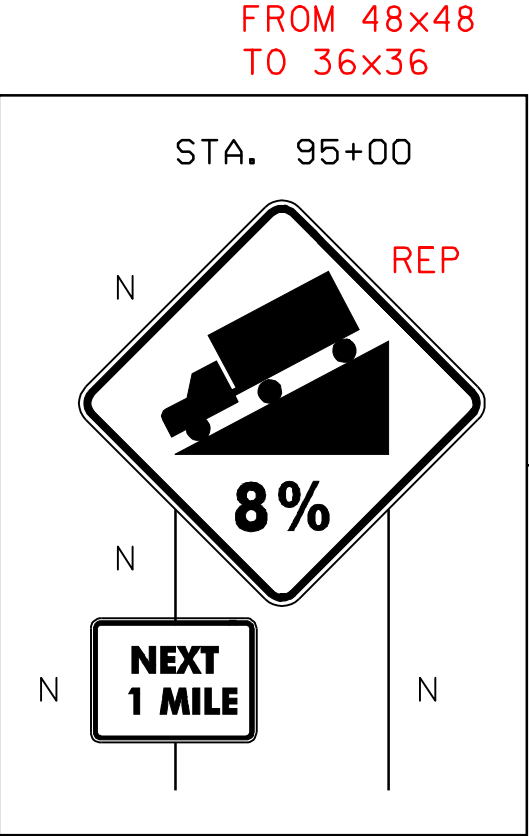

0 25 50
SCALE IN FEET

FILE NAME: STPG SIGN (13).DGN	PLOT DATE: 12-DEC-2008 13:2
PROJECT LEADER: N. AVERY	DRAWN BY: N. AVERY
DESIGNED BY: N. AVERY & M. MILLER	CHECKED BY: A. GAMBLE
SIGN(13) L19	SHEET 21 OF 38