





+0.080
+0.060
+0.040
+0.020
LEVEL
-0.020
-0.040
-0.060
-0.080

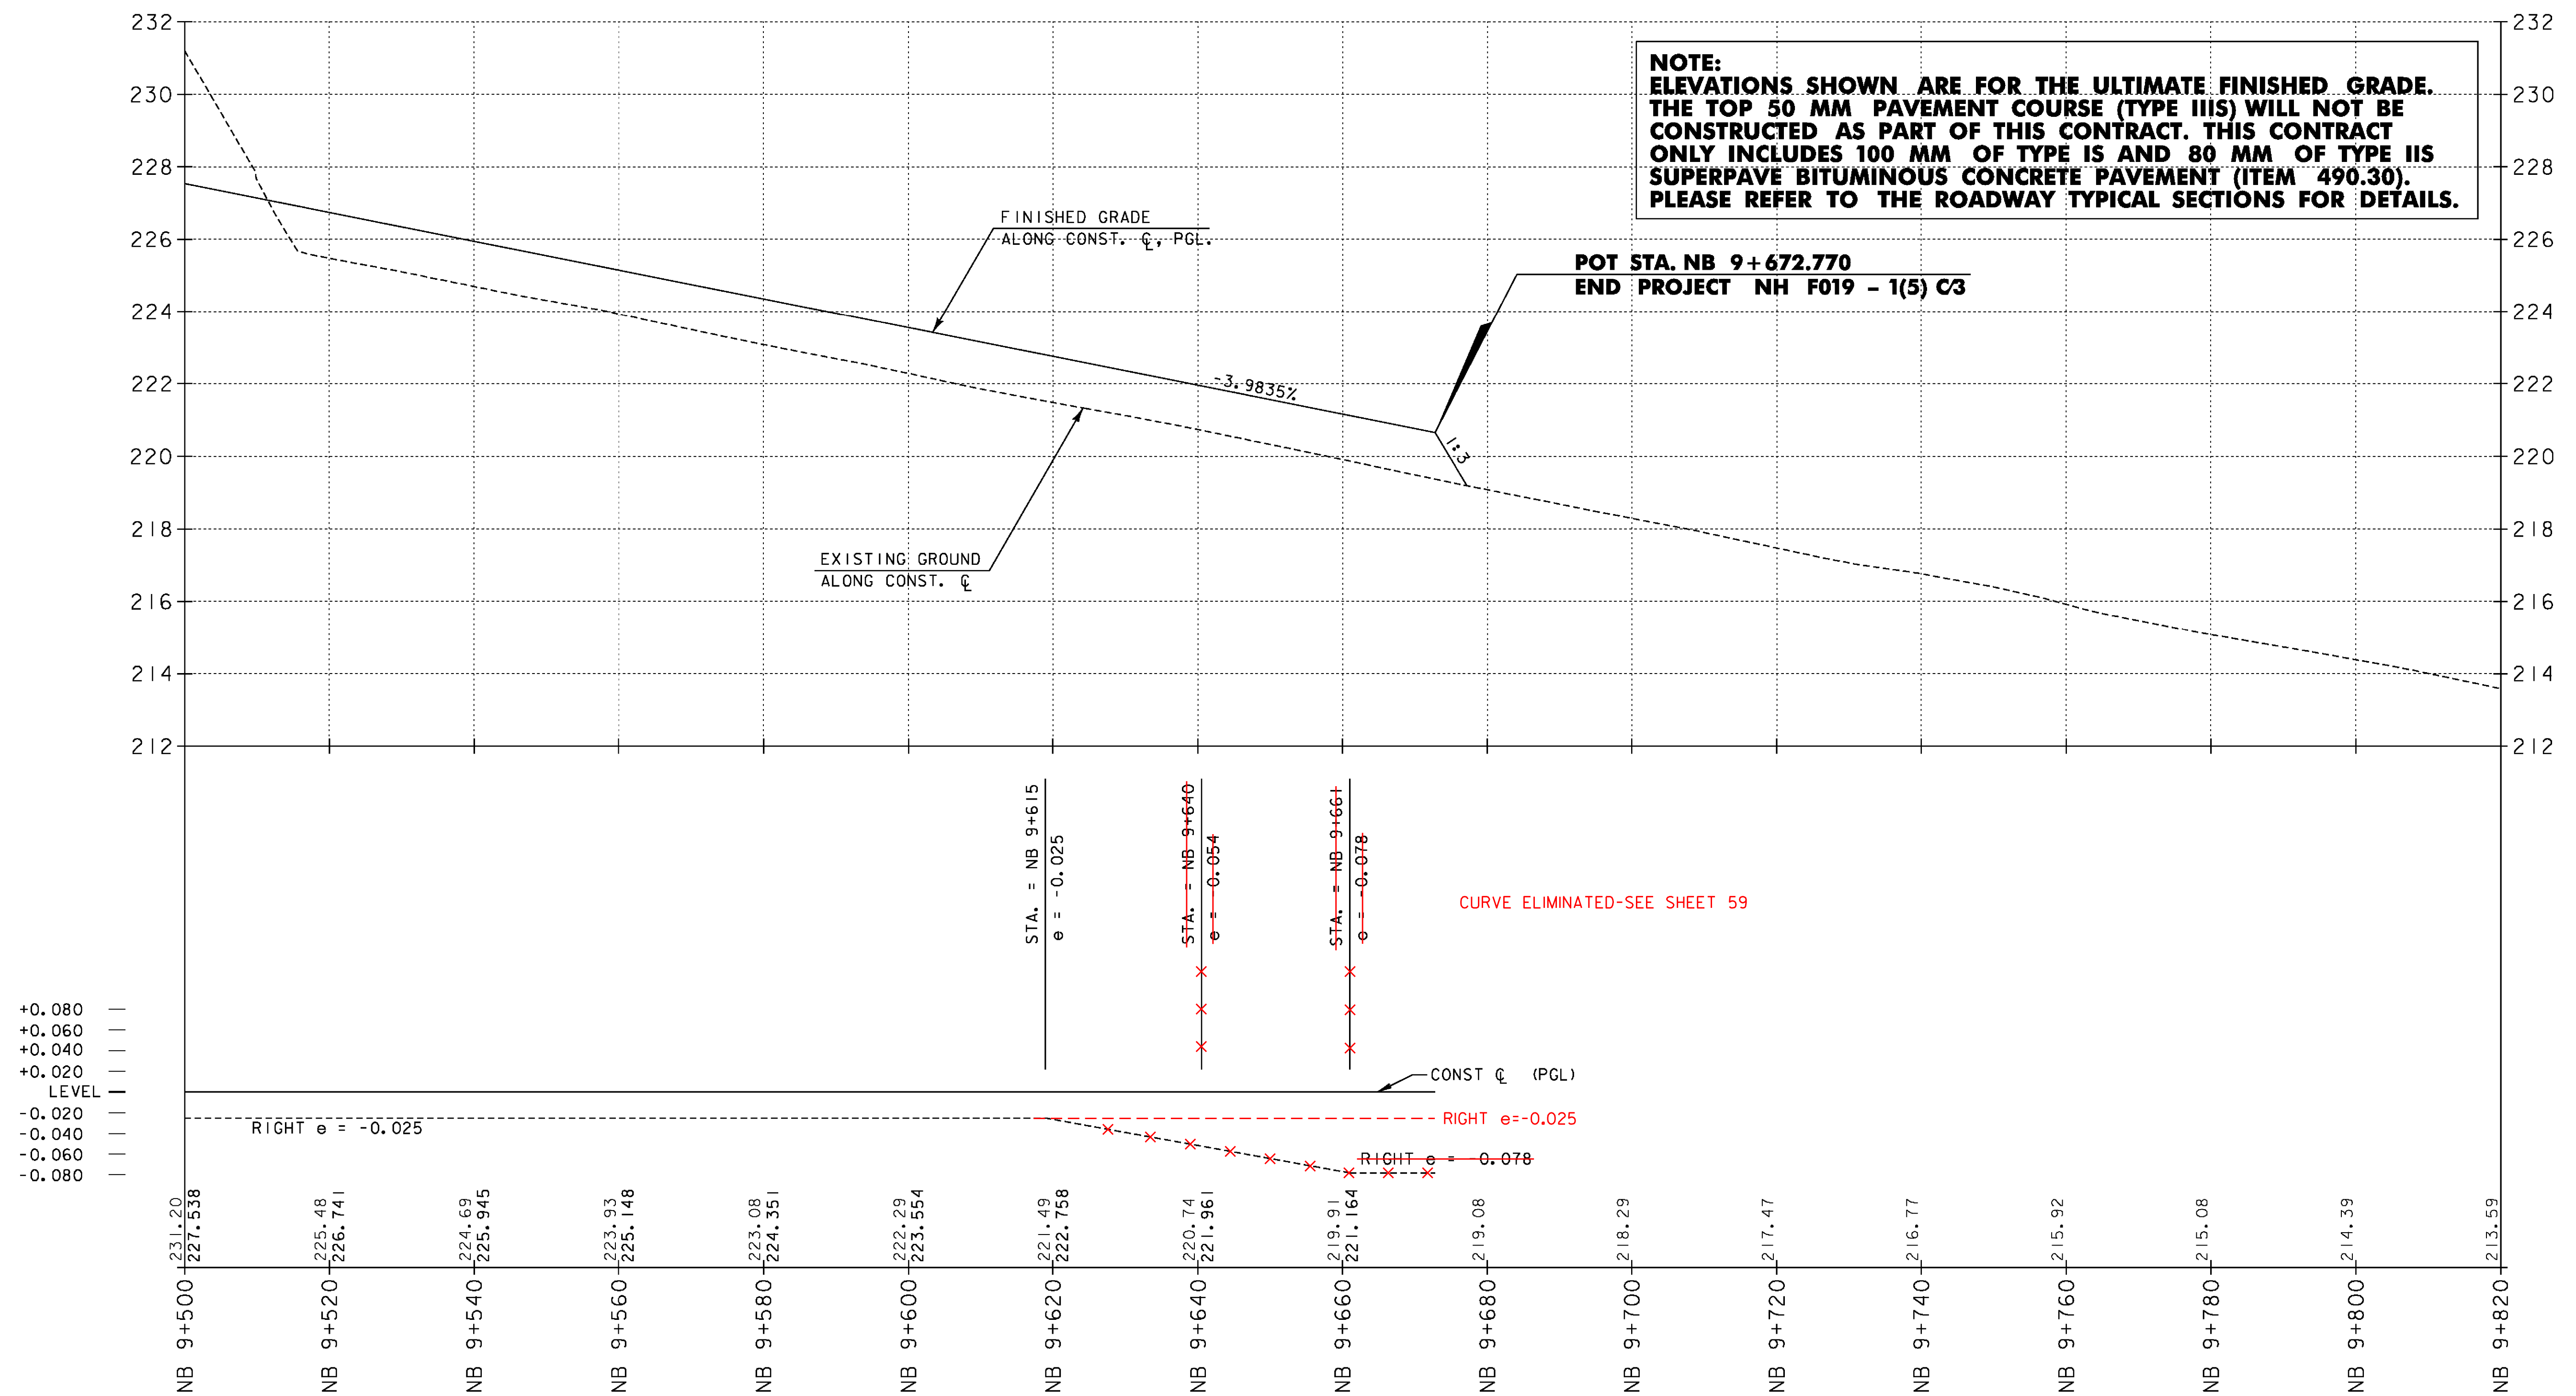

VERMONT AGENCY OF TRANSPORTATION

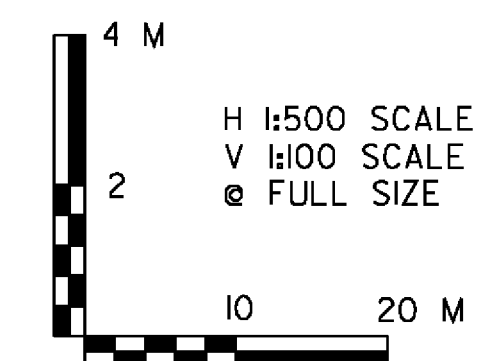

PROJECT NAME:	BENNINGTON
PROJECT NUMBER:	AC NH 019-1(53)
FILE NAME:	...\\plot_files\\zd307c3pro.nb.ptf
DESIGN SUPERVISOR:	GREG EDWARDS
DESIGNED BY:	MARC FOISY
NORTHBOUND - PR-4	
PLOT DATE:	5/16/2011
DRAWN BY:	STANTEC
CHECKED BY:	GARY SANTY
SHEET	69 OF 577