



V:\953\acrt\va\953\0002\transportation\drawing\center-cut_3\plot_files\zd307c3pro_xo.prf

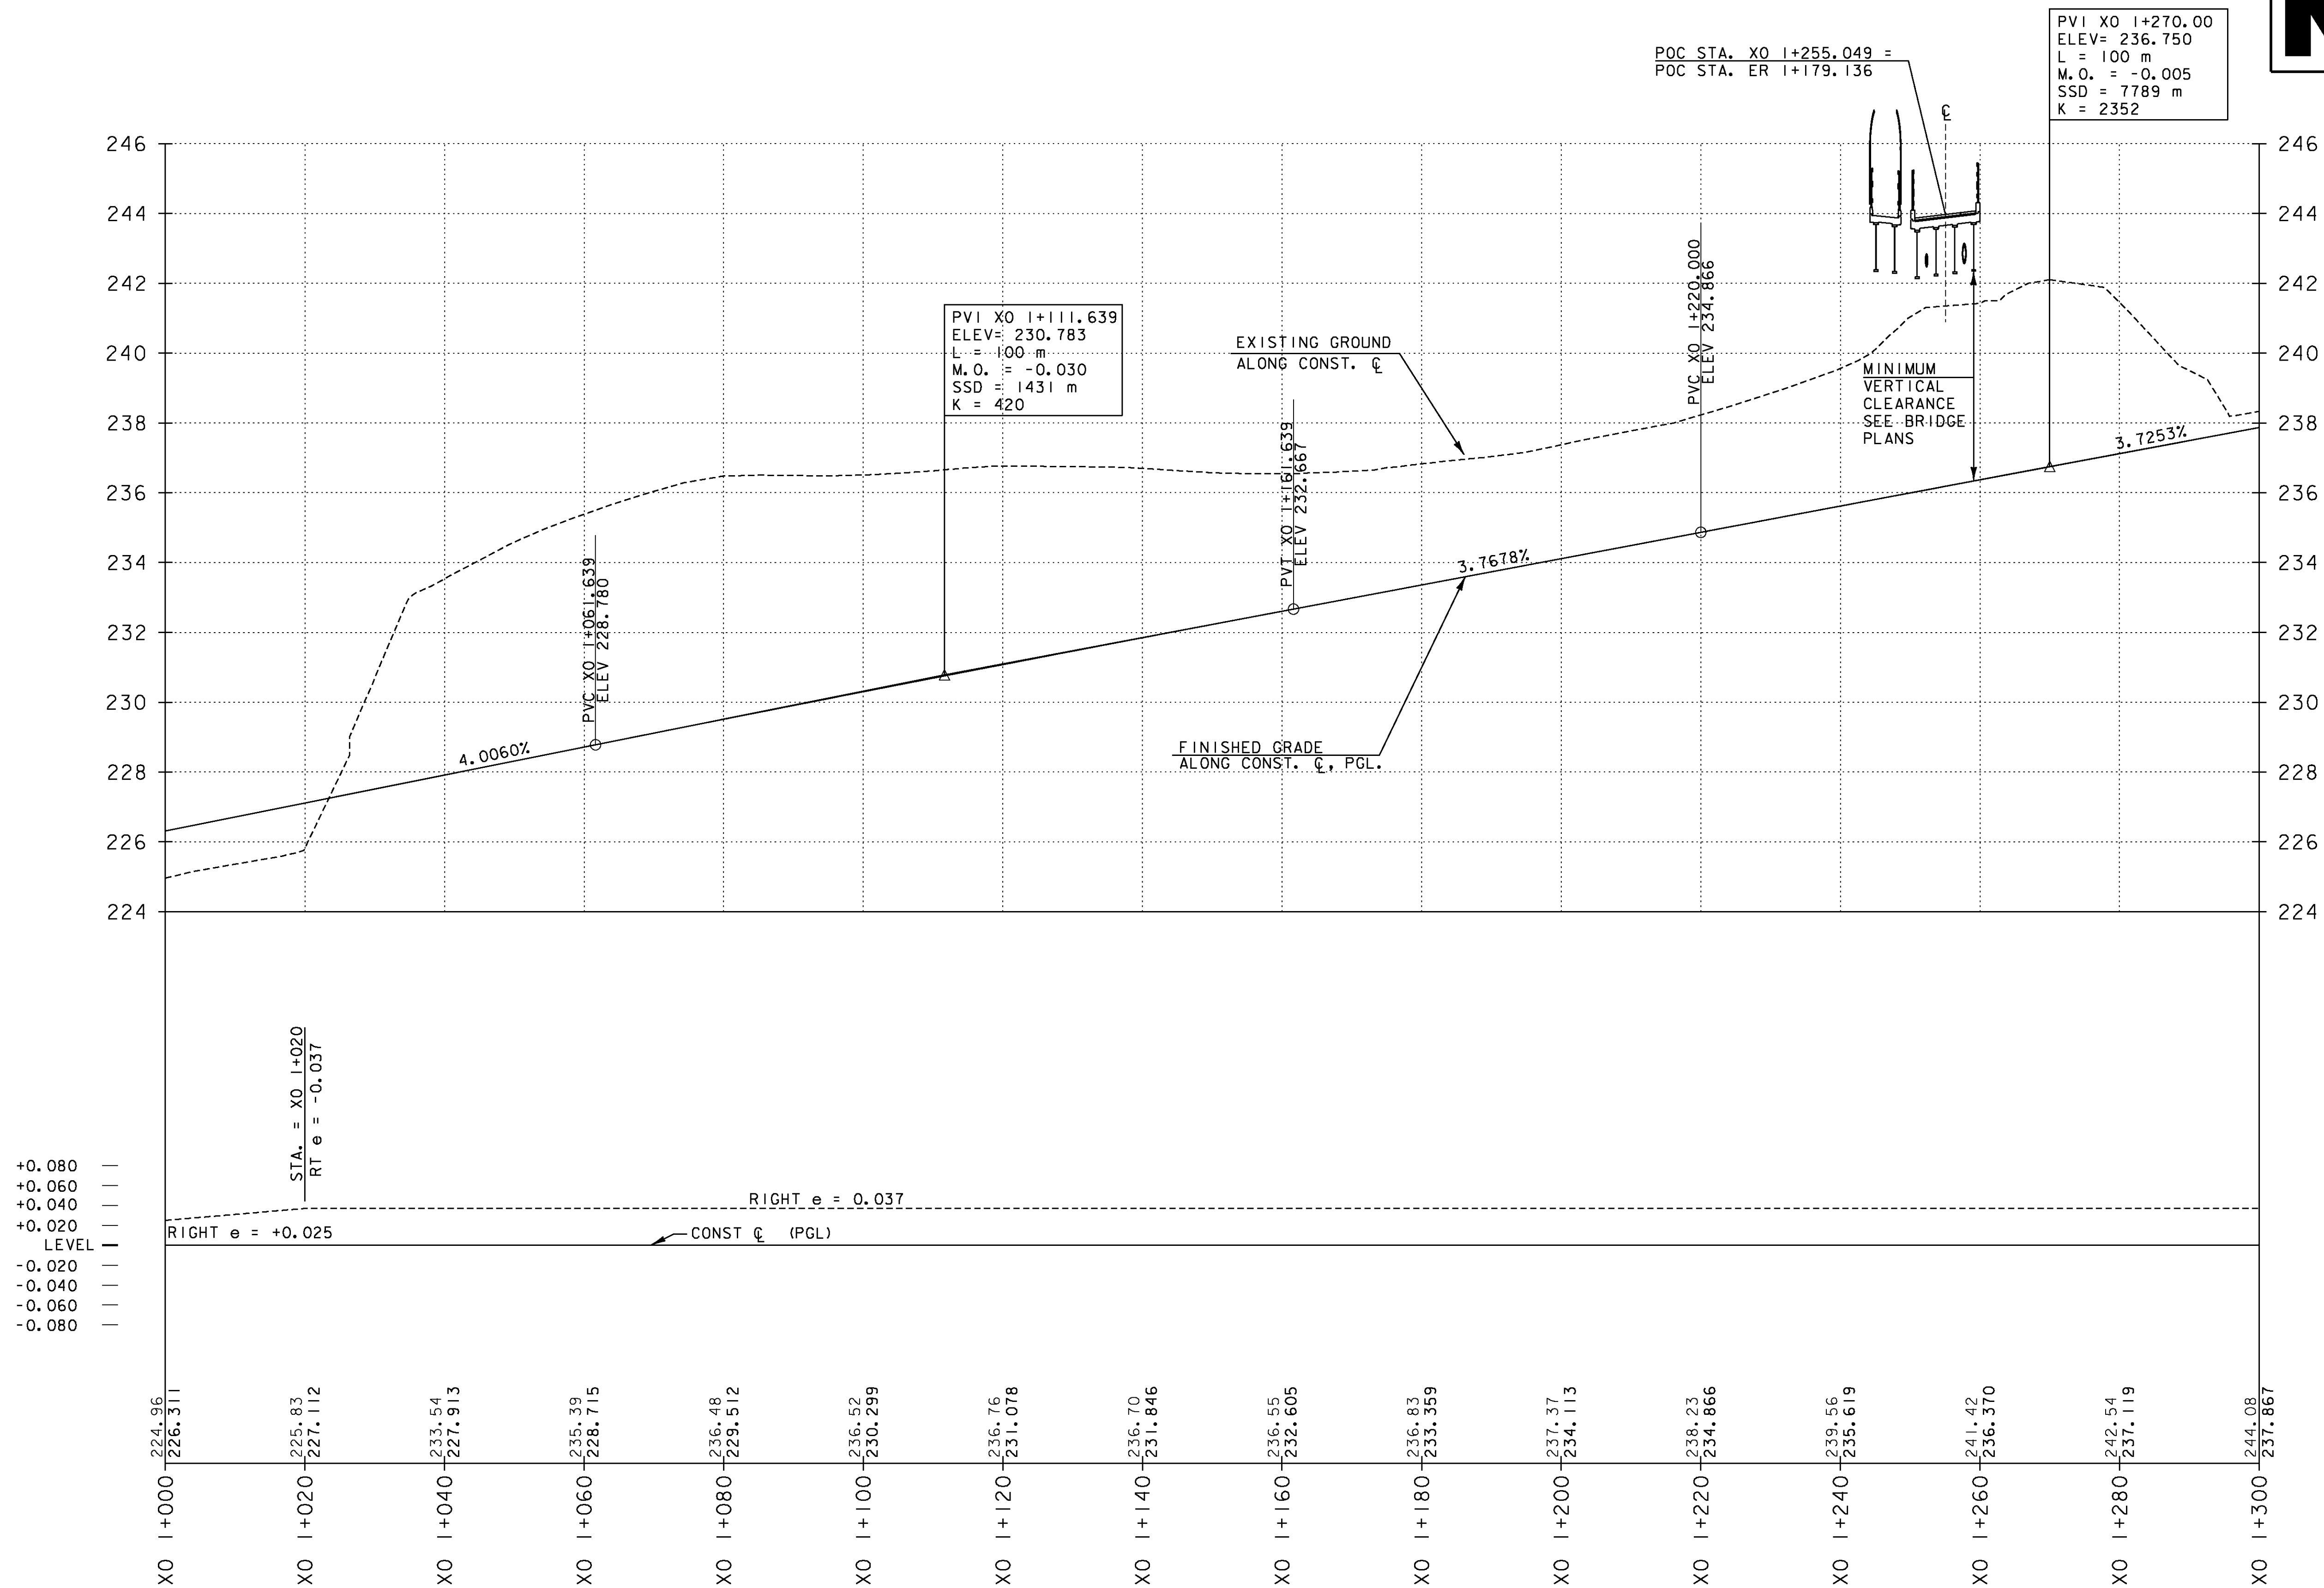

NOTE:
ELEVATIONS SHOWN ARE FOR THE ULTIMATE FINISHED GRADE. THE TOP 50 MM PAVEMENT COURSE (TYPE IIIS) WILL NOT BE CONSTRUCTED AS PART OF THIS CONTRACT. THIS CONTRACT ONLY INCLUDES 100 MM OF TYPE IS AND 80 MM OF TYPE IIS SUPERPAVE BITUMINOUS CONCRETE PAVEMENT (ITEM 490.30). PLEASE REFER TO THE ROADWAY TYPICAL SECTIONS FOR DETAILS.

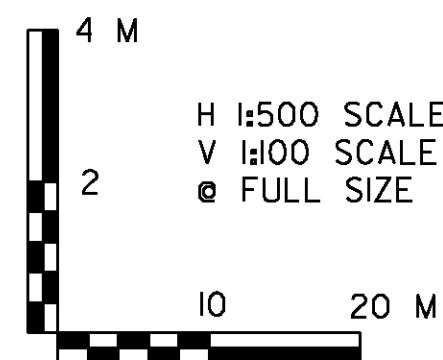

VERMONT AGENCY OF TRANSPORTATION	
	PROJECT NAME: BENNINGTON PROJECT NUMBER: AC NH 019-(153)
FILE NAME: ...\\plot_files\zd307c3pro_xo.prf DESIGN SUPERVISOR: GREG EDWARDS DESIGNED BY: MARC FOISY CROSS OVER PR-6	PLOT DATE: 5/26/2011 DRAWN BY: STANTEC CHECKED BY: GARY SANTY SHEET 71 OF 577