





NOTE:
FOR PROJECT TERMINI SEE SHEET TS-08

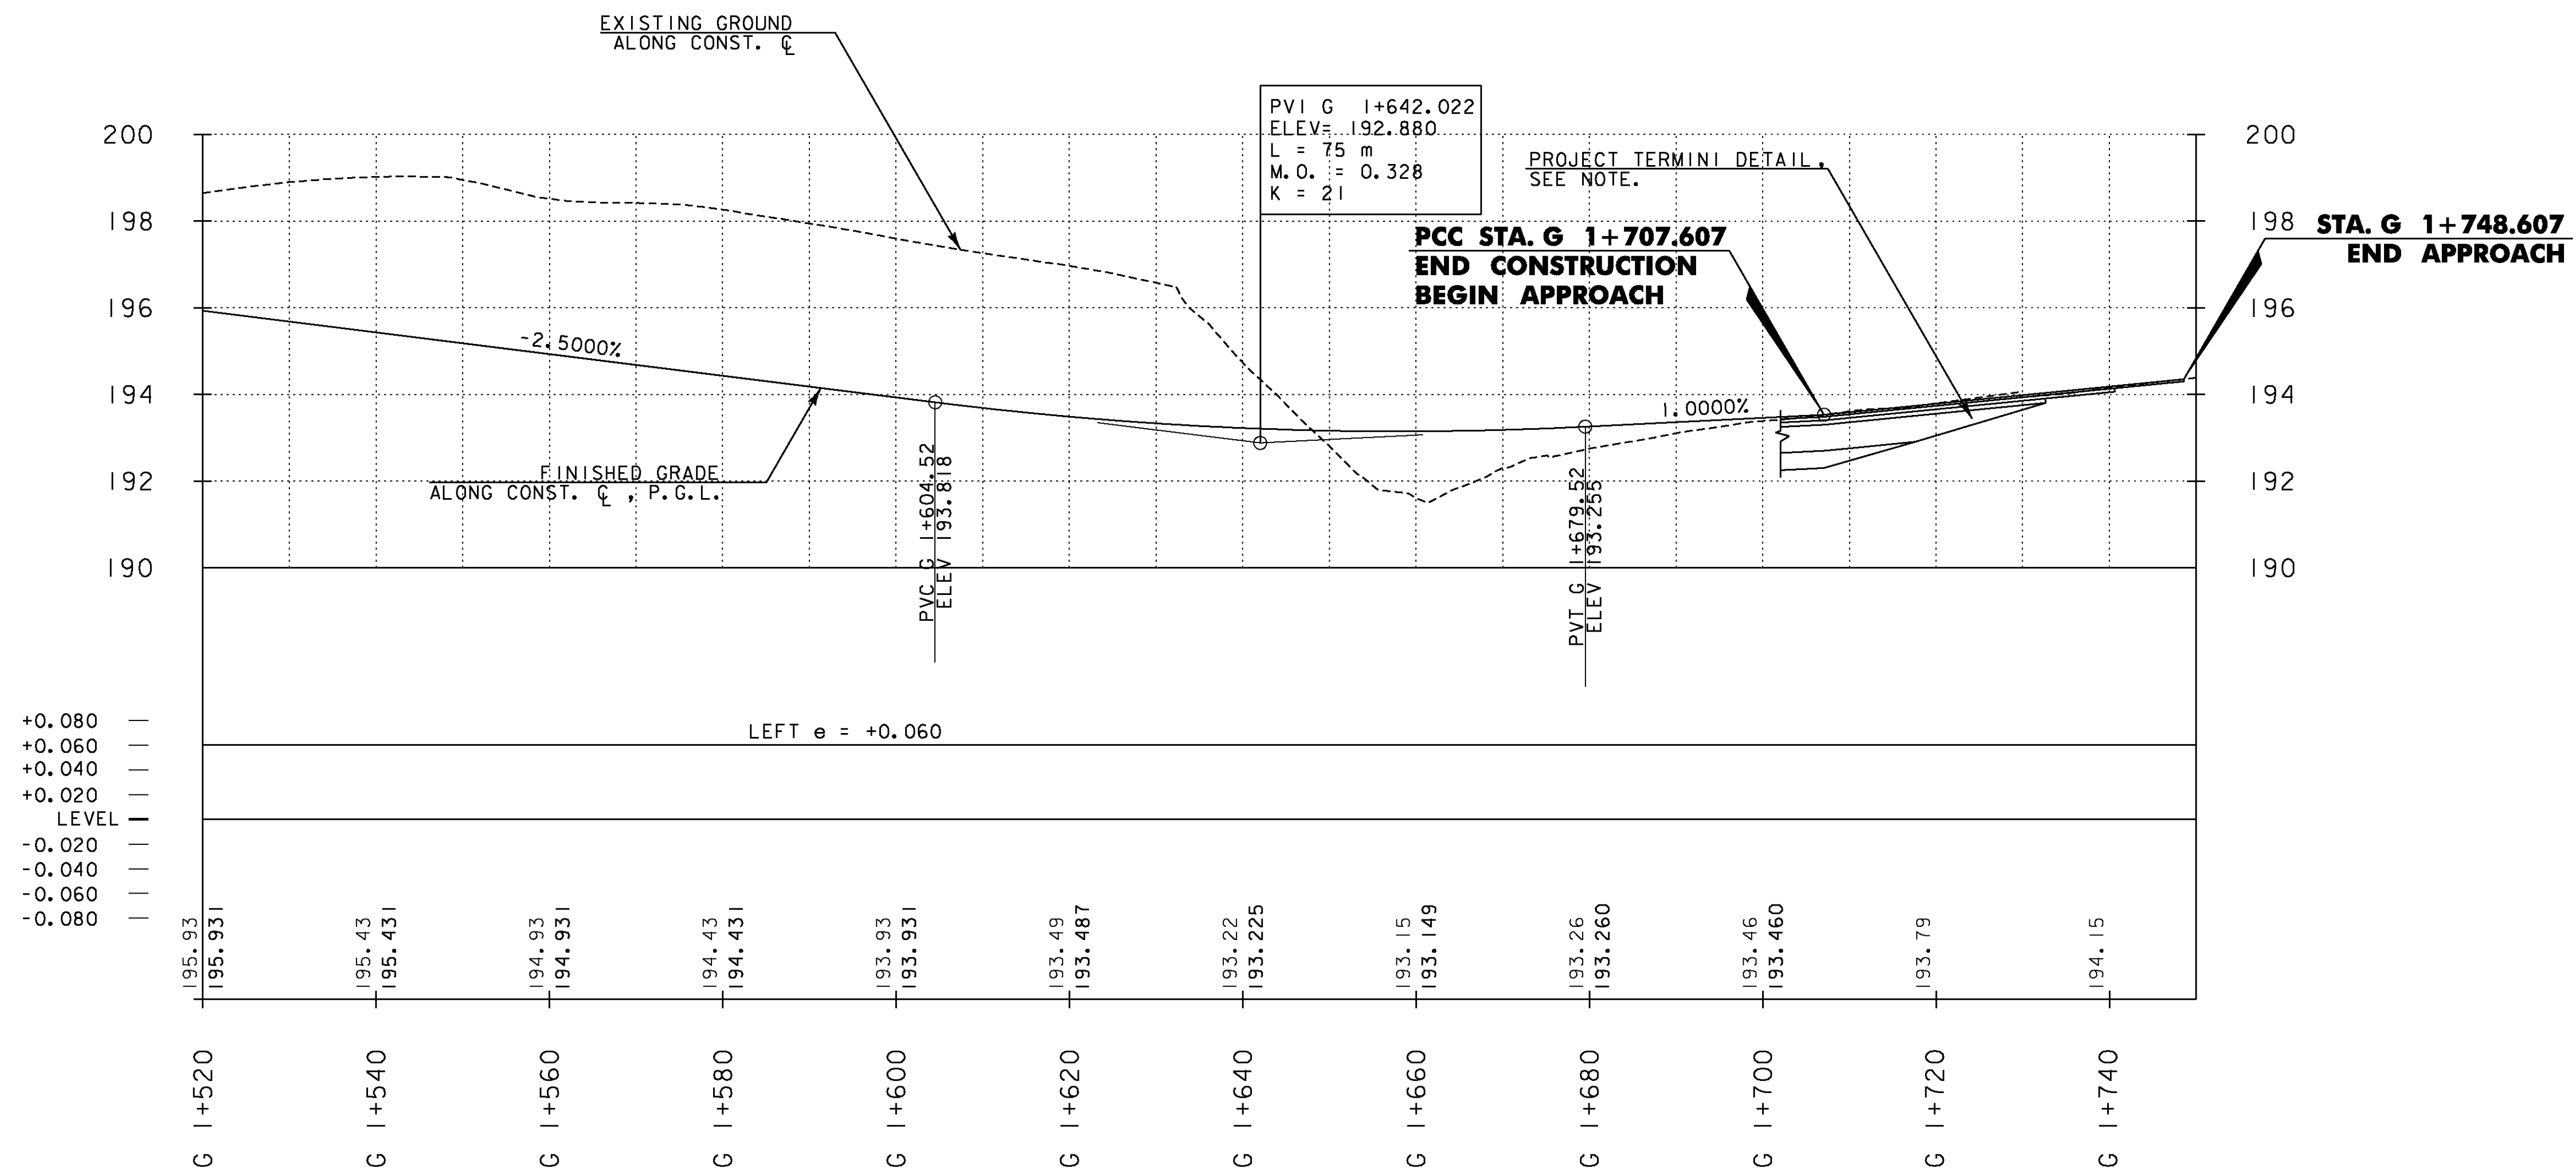

VERMONT AGENCY OF TRANSPORTATION

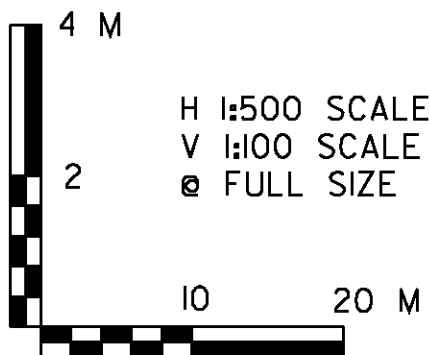

PROJECT NAME: BENNINGTON
PROJECT NUMBER: AC NH 019-1(53)
FILE NAME: ...\\zd307c3pro_ramp.gptf
DESIGN SUPERVISOR: GREG EDWARDS
DESIGNED BY: MARC FOISY
RAMP G PR-11

PLOT DATE: 5/16/2011
DRAWN BY: STANTEC
CHECKED BY: GARY SANTY
SHEET 76 OF 577