




RELOCATE MAILBOX, SINGLE SUPPORT
STA. ER 1+276.7, RT.



5 0 5 M

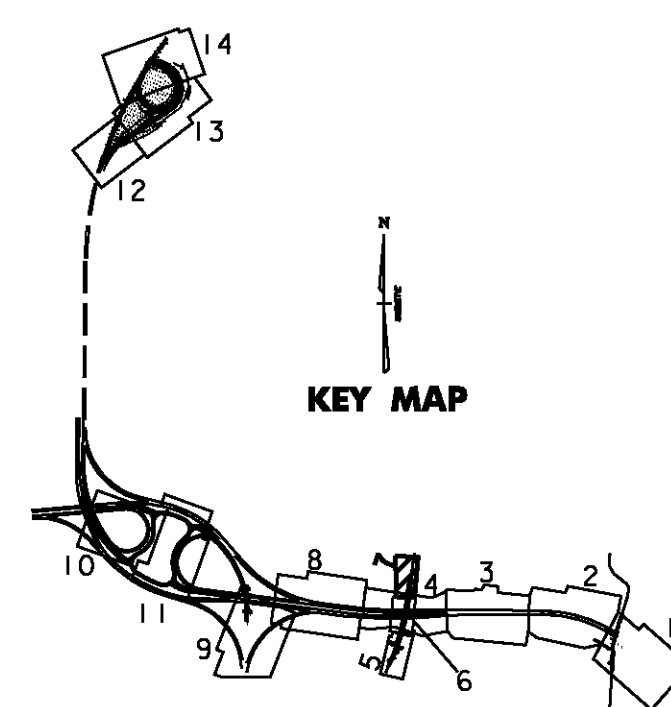

1:250 SCALE
@ FULL SIZE



PLOT DATE: 5/16/2011
DRAWN BY: STANTEC
CHECKED BY: GARY SANTY
SHEET 84 OF 577