

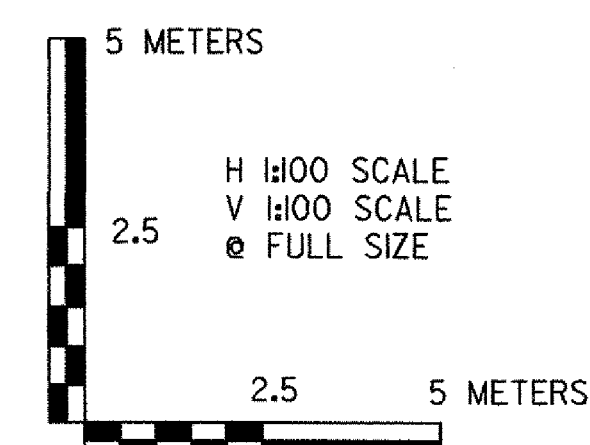


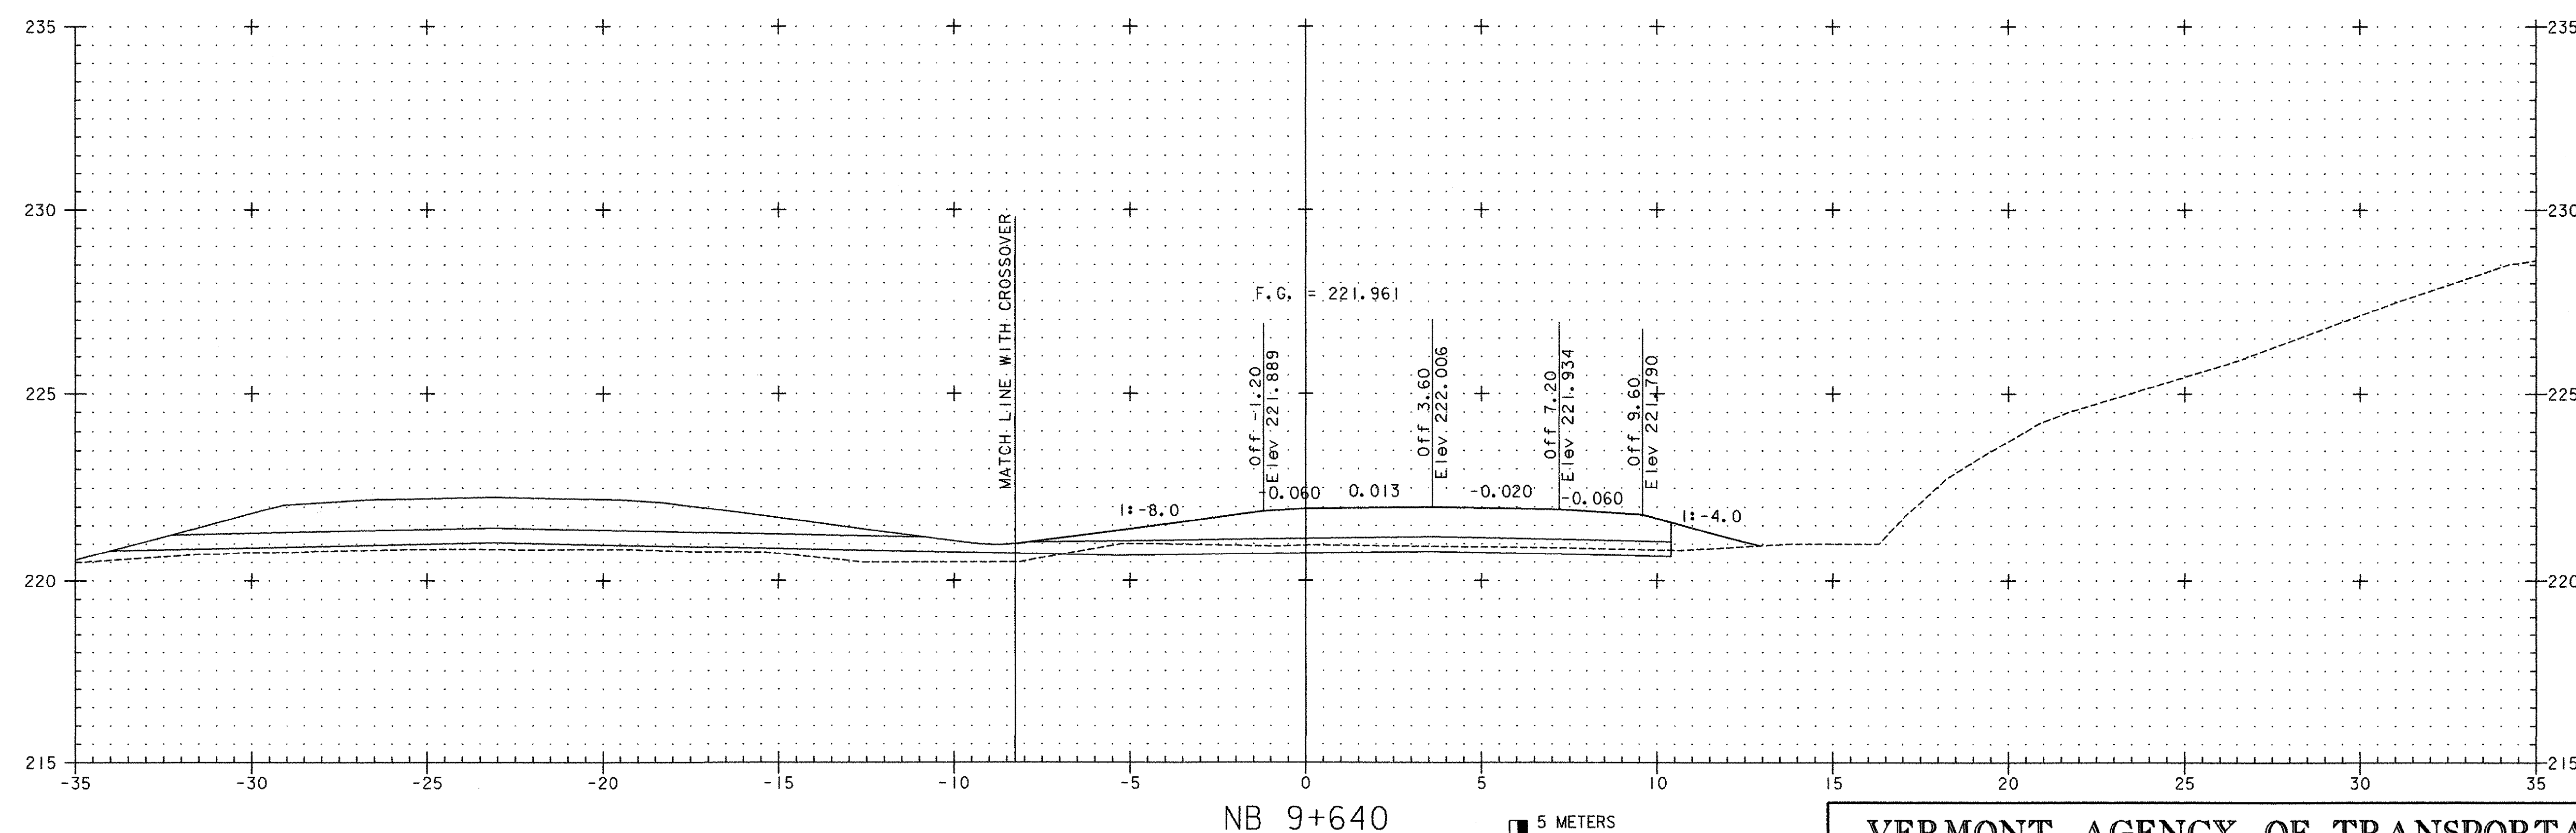

VERMONT AGENCY OF TRANSPORTATION

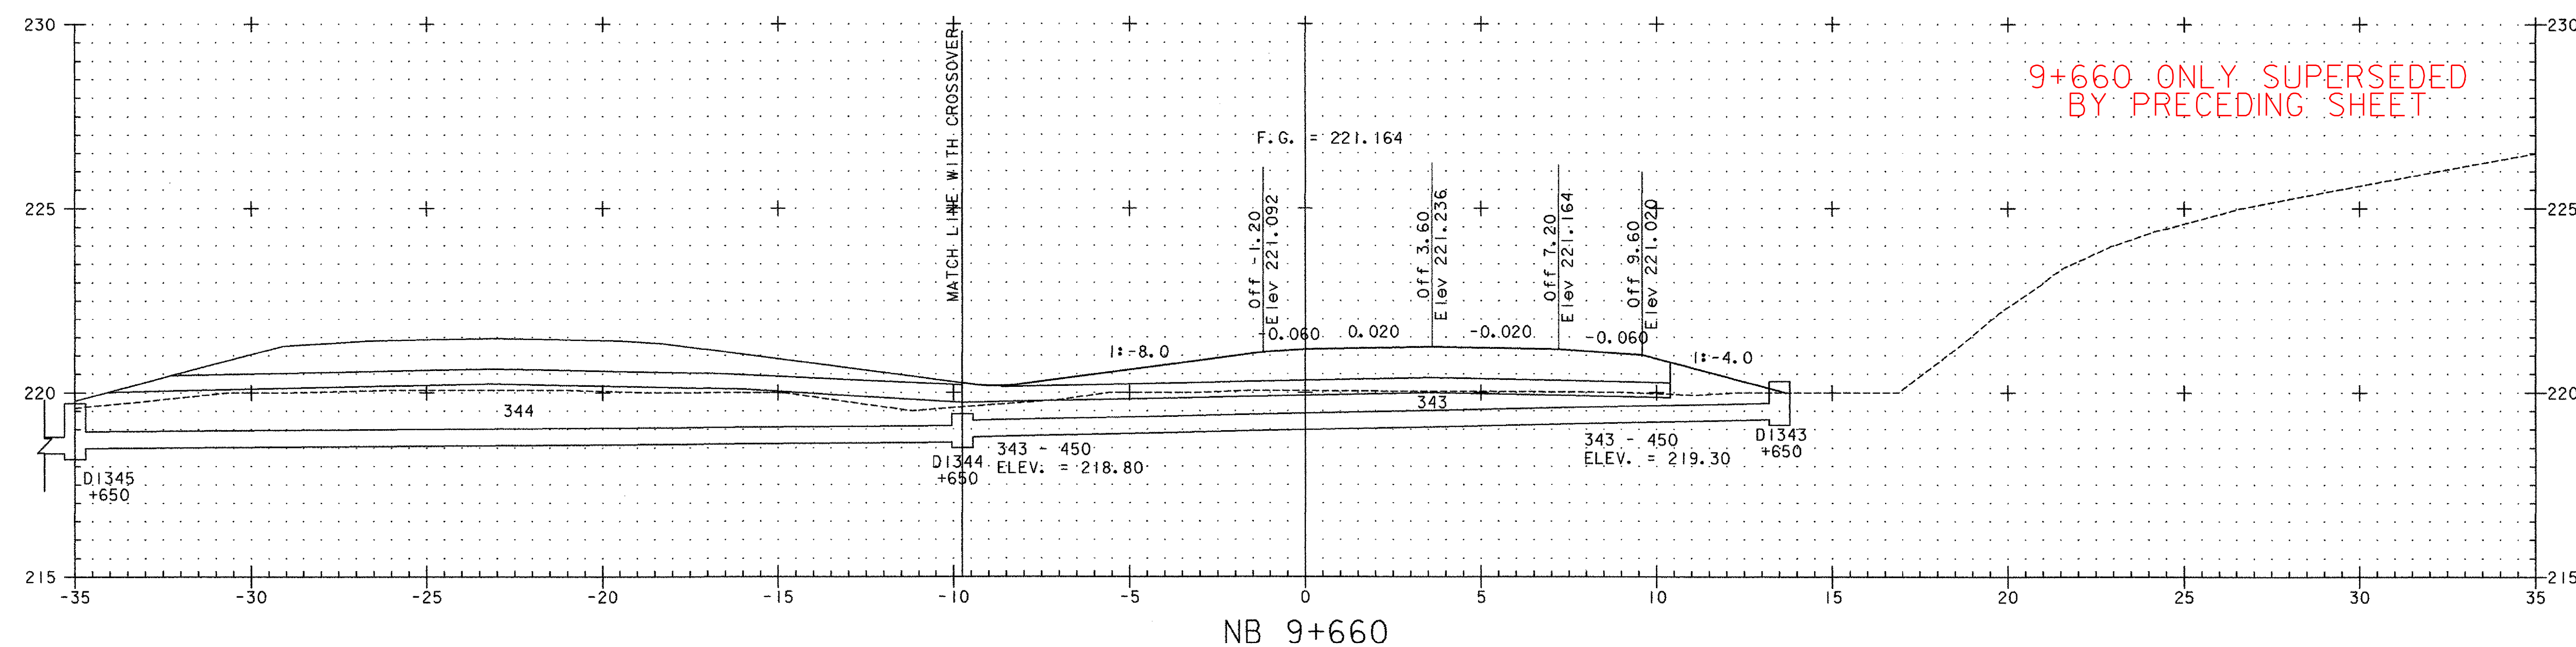

PROJECT NAME: BENNINGTON
PROJECT NUMBER: AC NH 019-1(53)

FILE NAME: ...plot_files\zd307c3xs_nb.pptf
DESIGN SUPERVISOR: GREG EDWARDS
DESIGNED BY: MARC FOISY
PLOT DATE: 5/19/2007
DRAWN BY: STANTEC
CHECKED BY: GARY SANTY
SHEET 329 OF 577

NB MAINLINE CROSS SECTIONS