
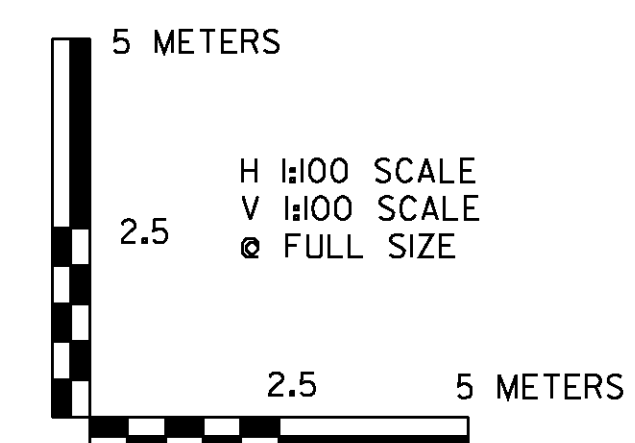
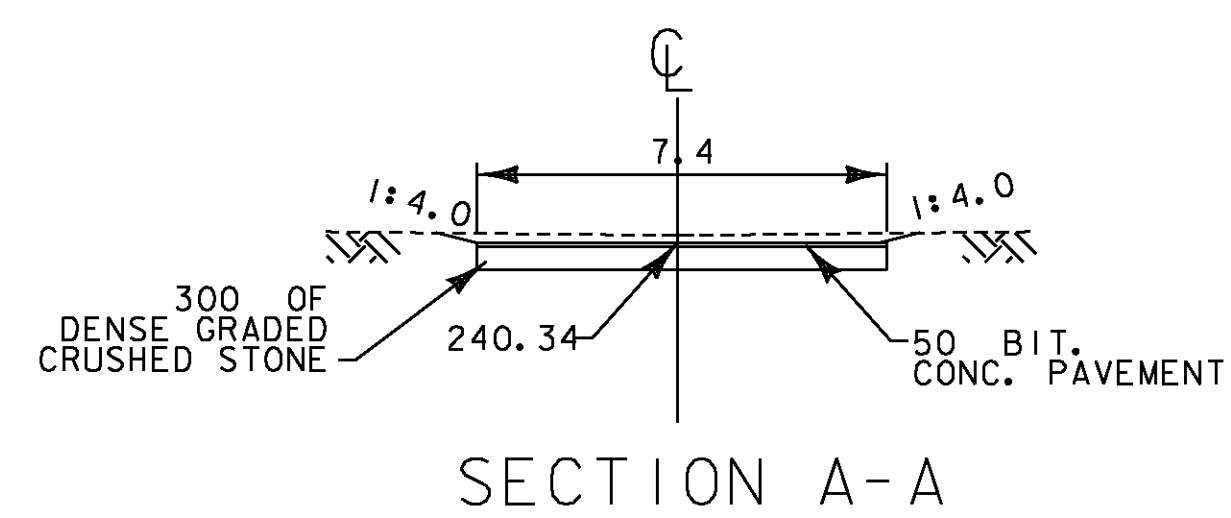
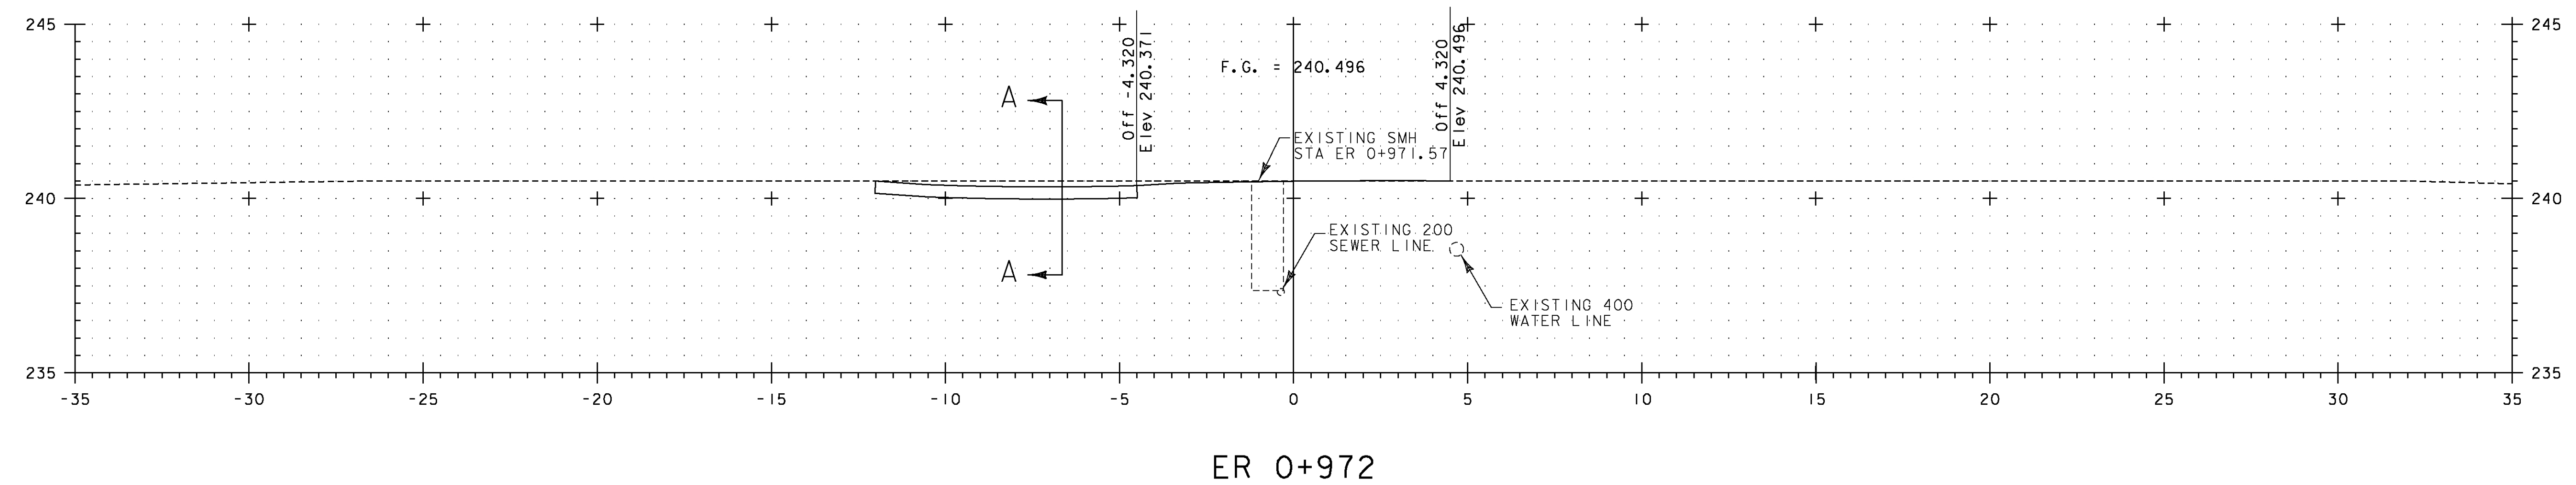


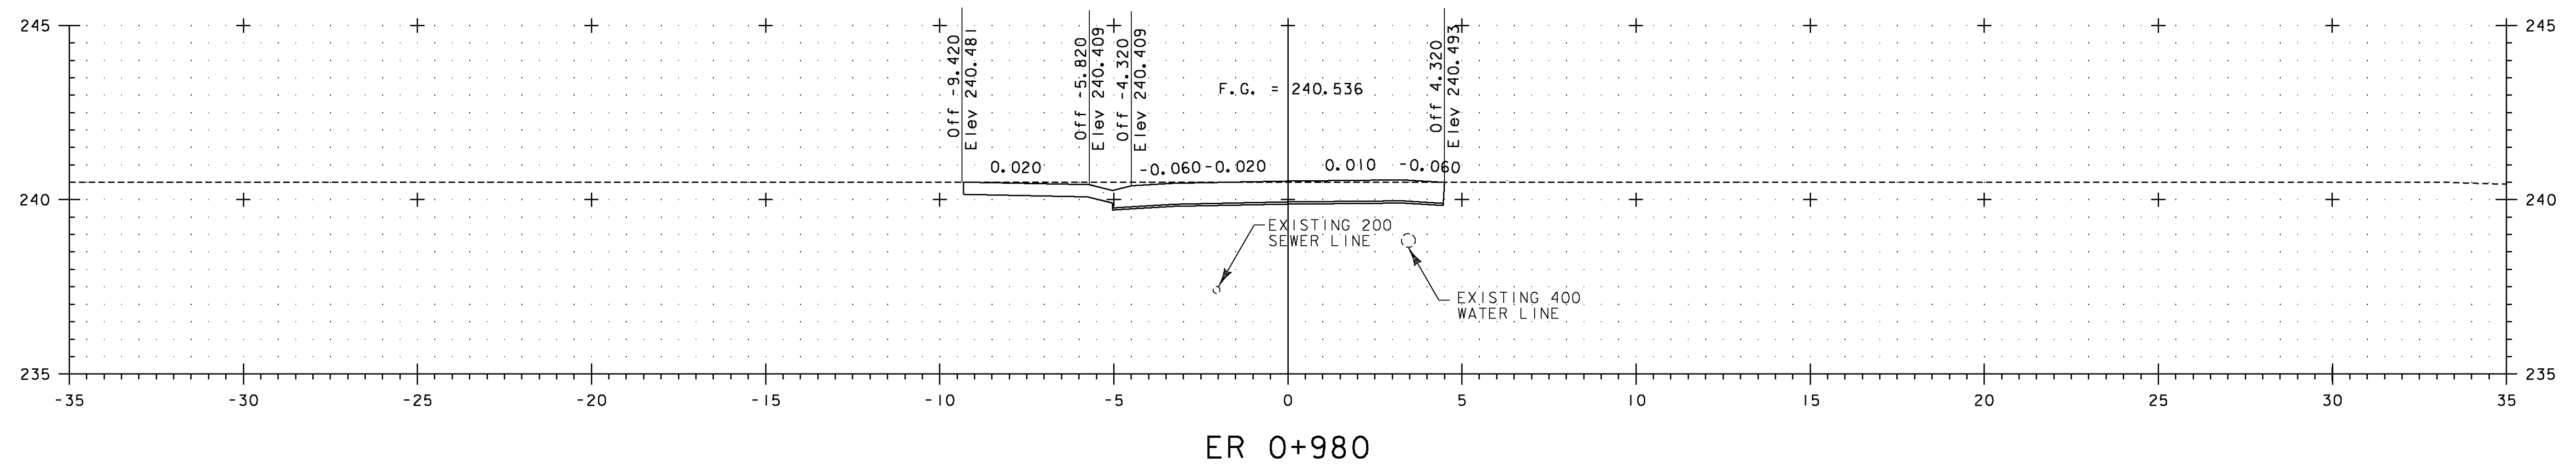

VERMONT AGENCY OF TRANSPORTATION			
	PROJECT NAME: BENNINGTON		
	PROJECT NUMBER: AC NH 019-1(53)		
	FILE NAME: ...\\plot_files\\zd307c3xs_east.prf	PLOT DATE: 5/16/2011	
	DESIGN SUPERVISOR: GREG EDWARDS	DRAWN BY: STANTEC	
	DESIGNED BY: MARC FOISY	CHECKED BY: GARY SANTY	
	EAST ROAD CROSS SECTIONS		SHEET 348 OF 577