
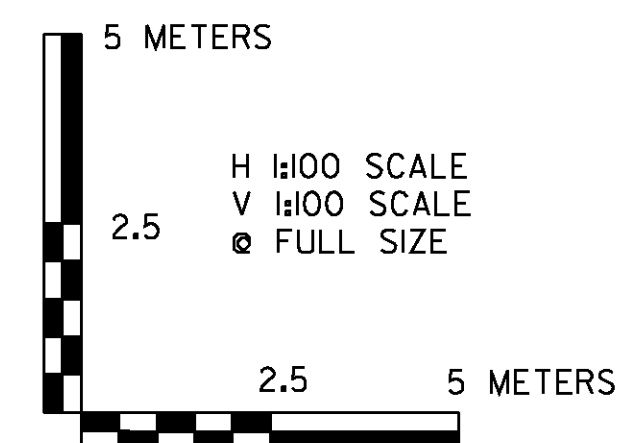
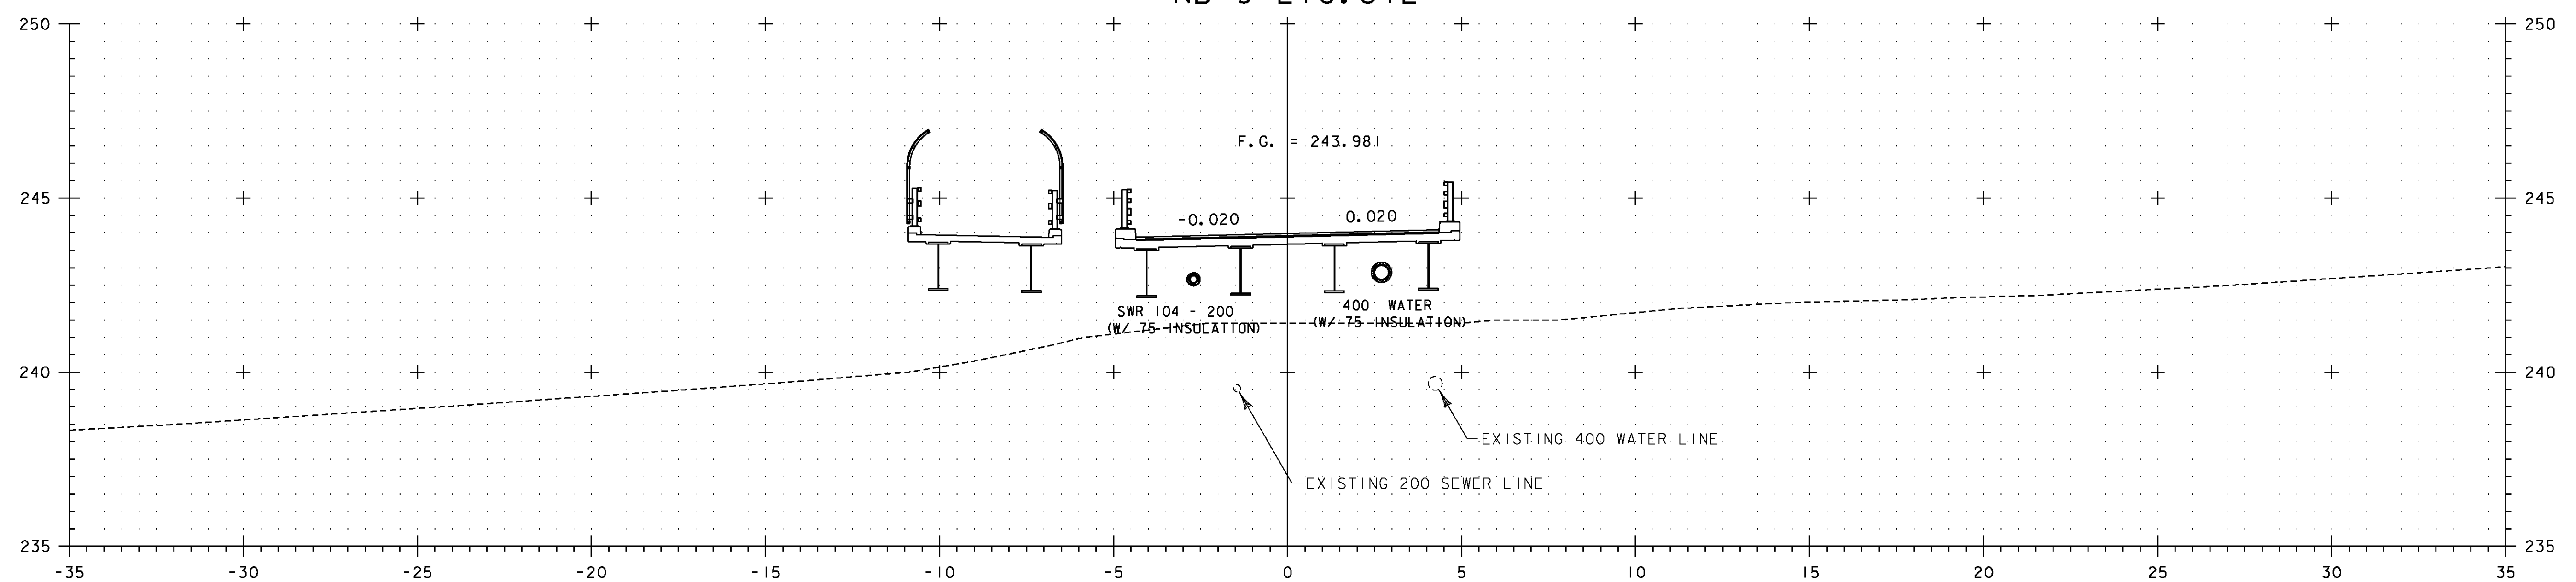


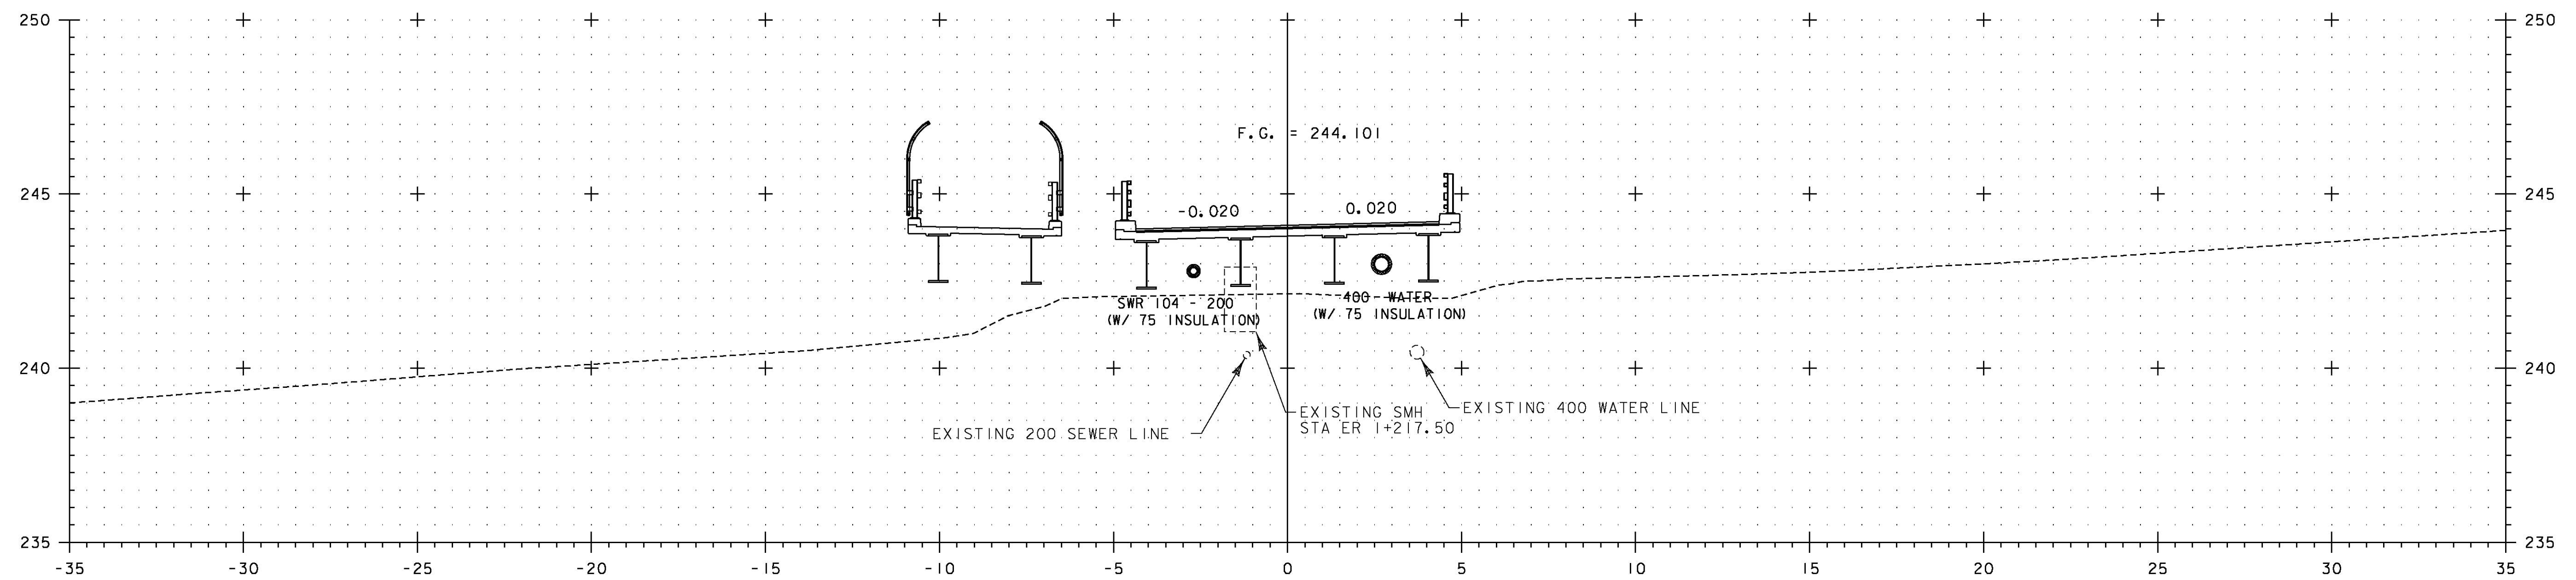

VERMONT AGENCY OF TRANSPORTATION			
	PROJECT NAME: BENNINGTON		
	PROJECT NUMBER: AC NH 019-1(53)		
	FILE NAME: ...\\plot_files\\zd307c3xs-east.pft	PLOT DATE: 5/16/2011	
	DESIGN SUPERVISOR: GREG EDWARDS	DRAWN BY: STANTEC	
DESIGNED BY: MARC FOISY		CHECKED BY: GARY SANTY	
EAST ROAD CROSS SECTIONS		SHEET 356 OF 577	