



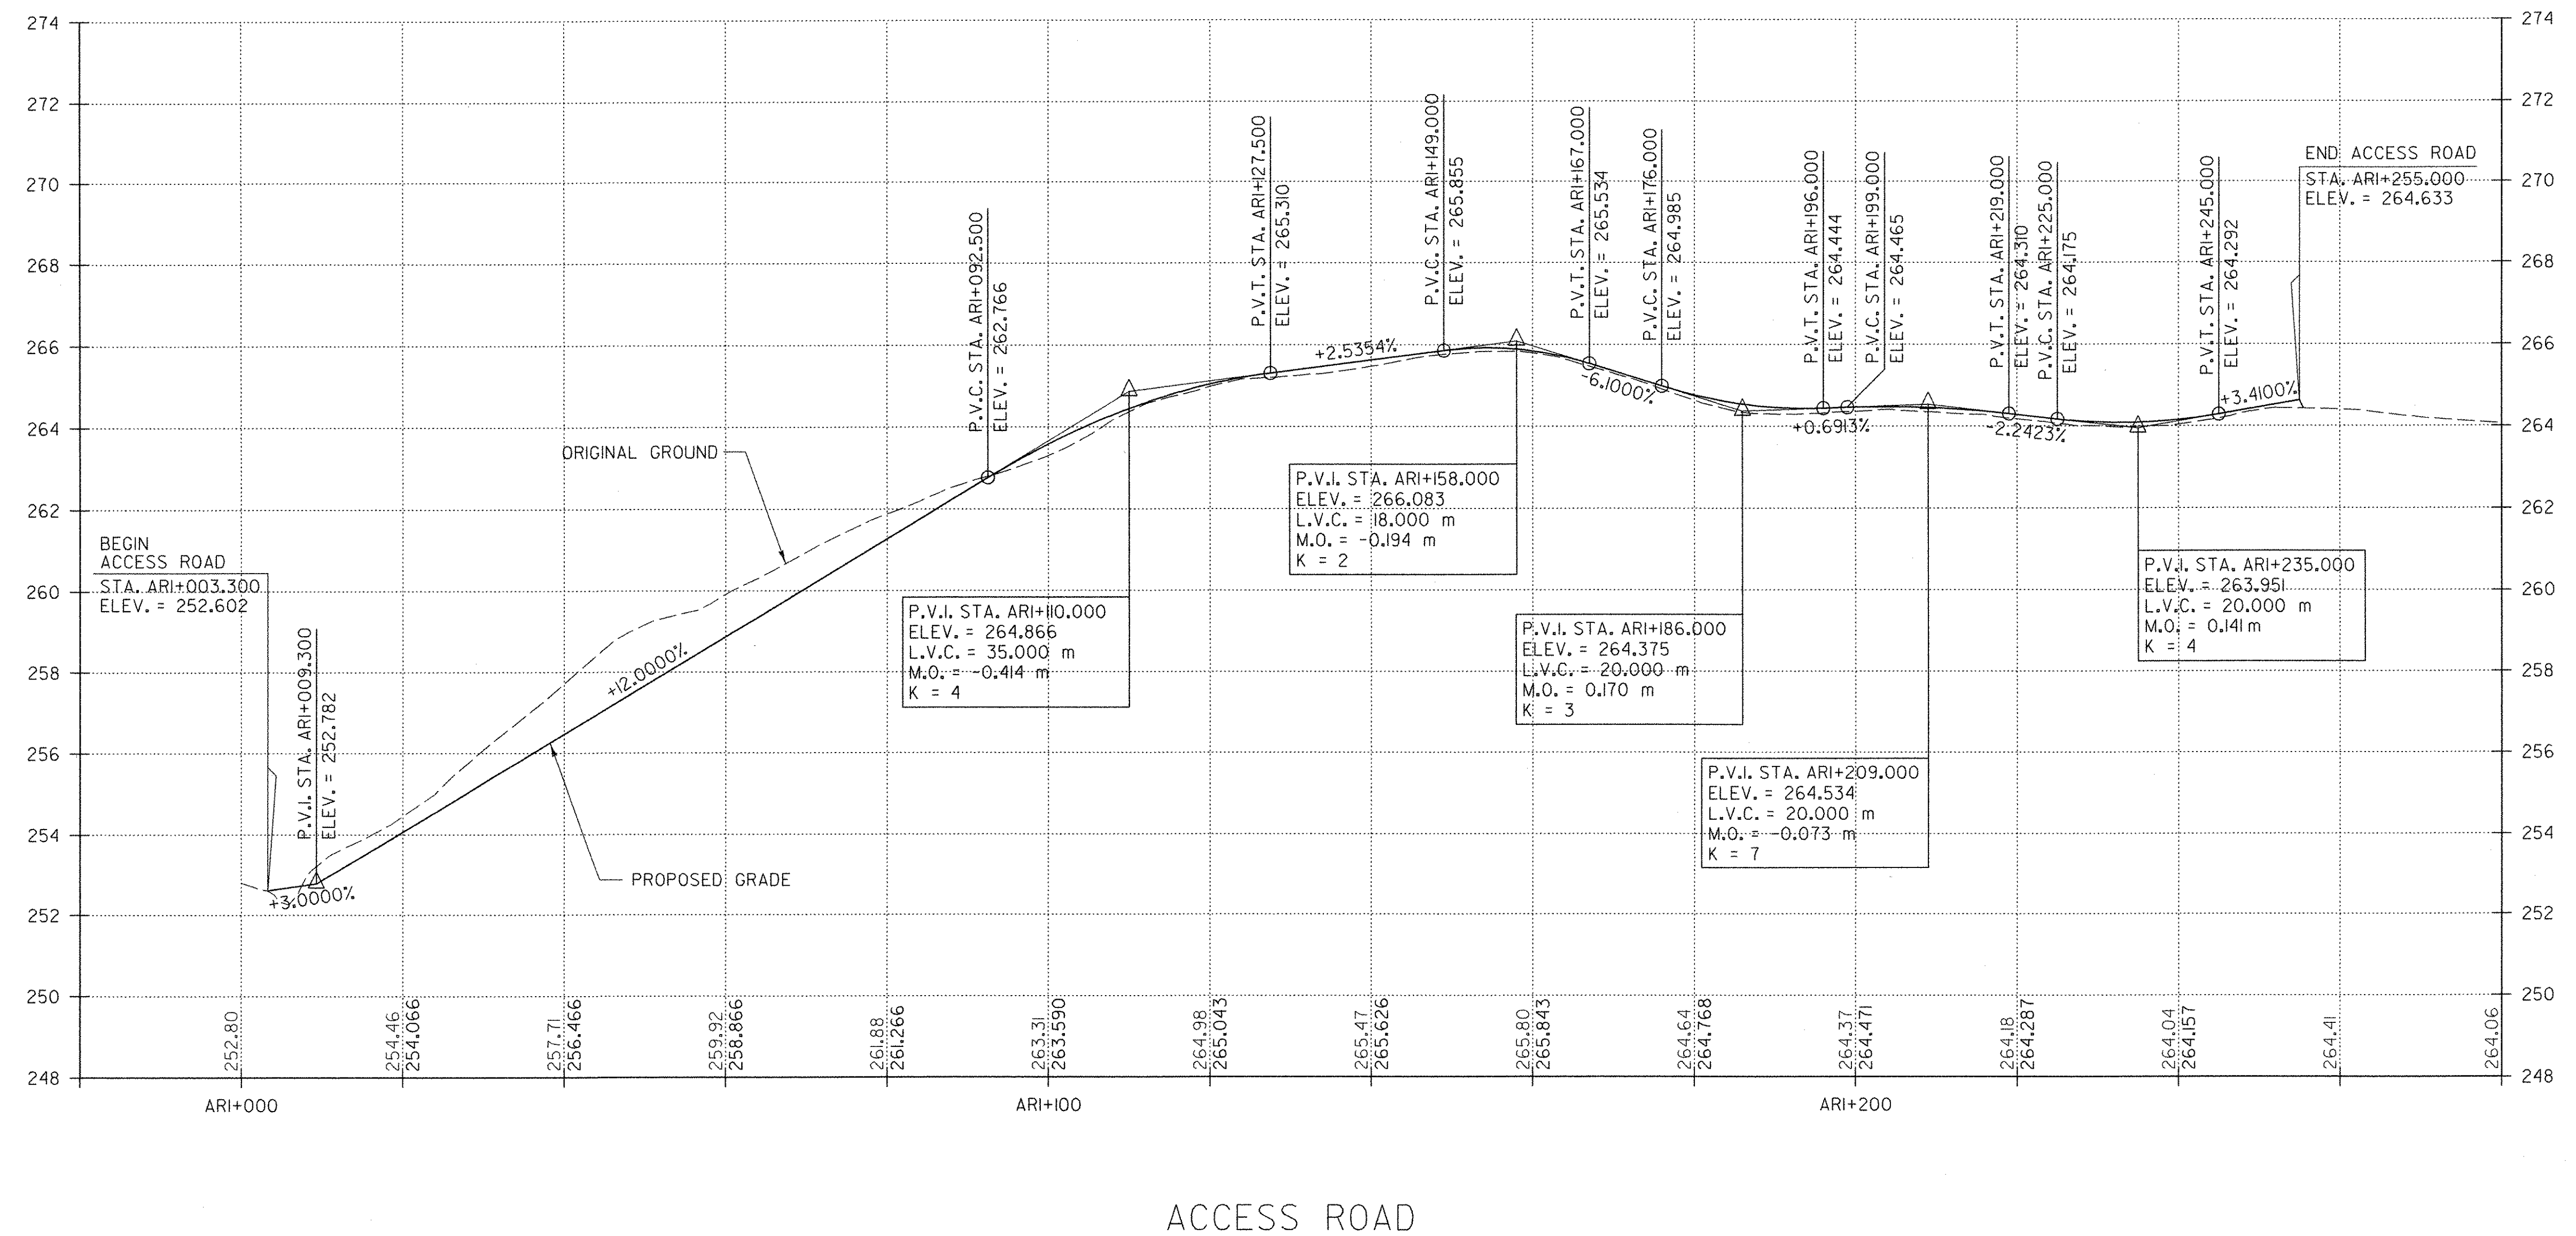

FILE NAME =U:\9819\mstn\03\clough\Stage One Sites\zd048pro-netc.dgn
DATE/TIME =5/18/2007
USER =3076

DATUM	
VERTICAL	NAVD 88
HORIZONTAL	NAD 83 (1992)

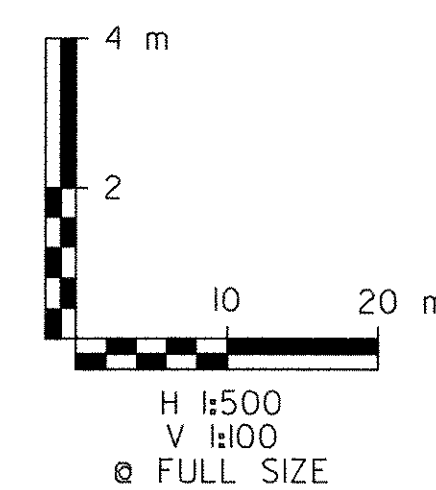

VERMONT AGENCY OF TRANSPORTATION	
	PROJECT NAME: BENNINGTON
	PROJECT NUMBER: AC NH 019-(K53)
	FILE NAME: ZD048PRO.DGN
	PLOT DATE: 5/18/2007
PROFILE PR-1	PROJECT LEADER: D.E.G.
	DESIGNED BY: J.S.P.
	CHECKED BY: D.E.G.
SHEET 438 OF 577	