


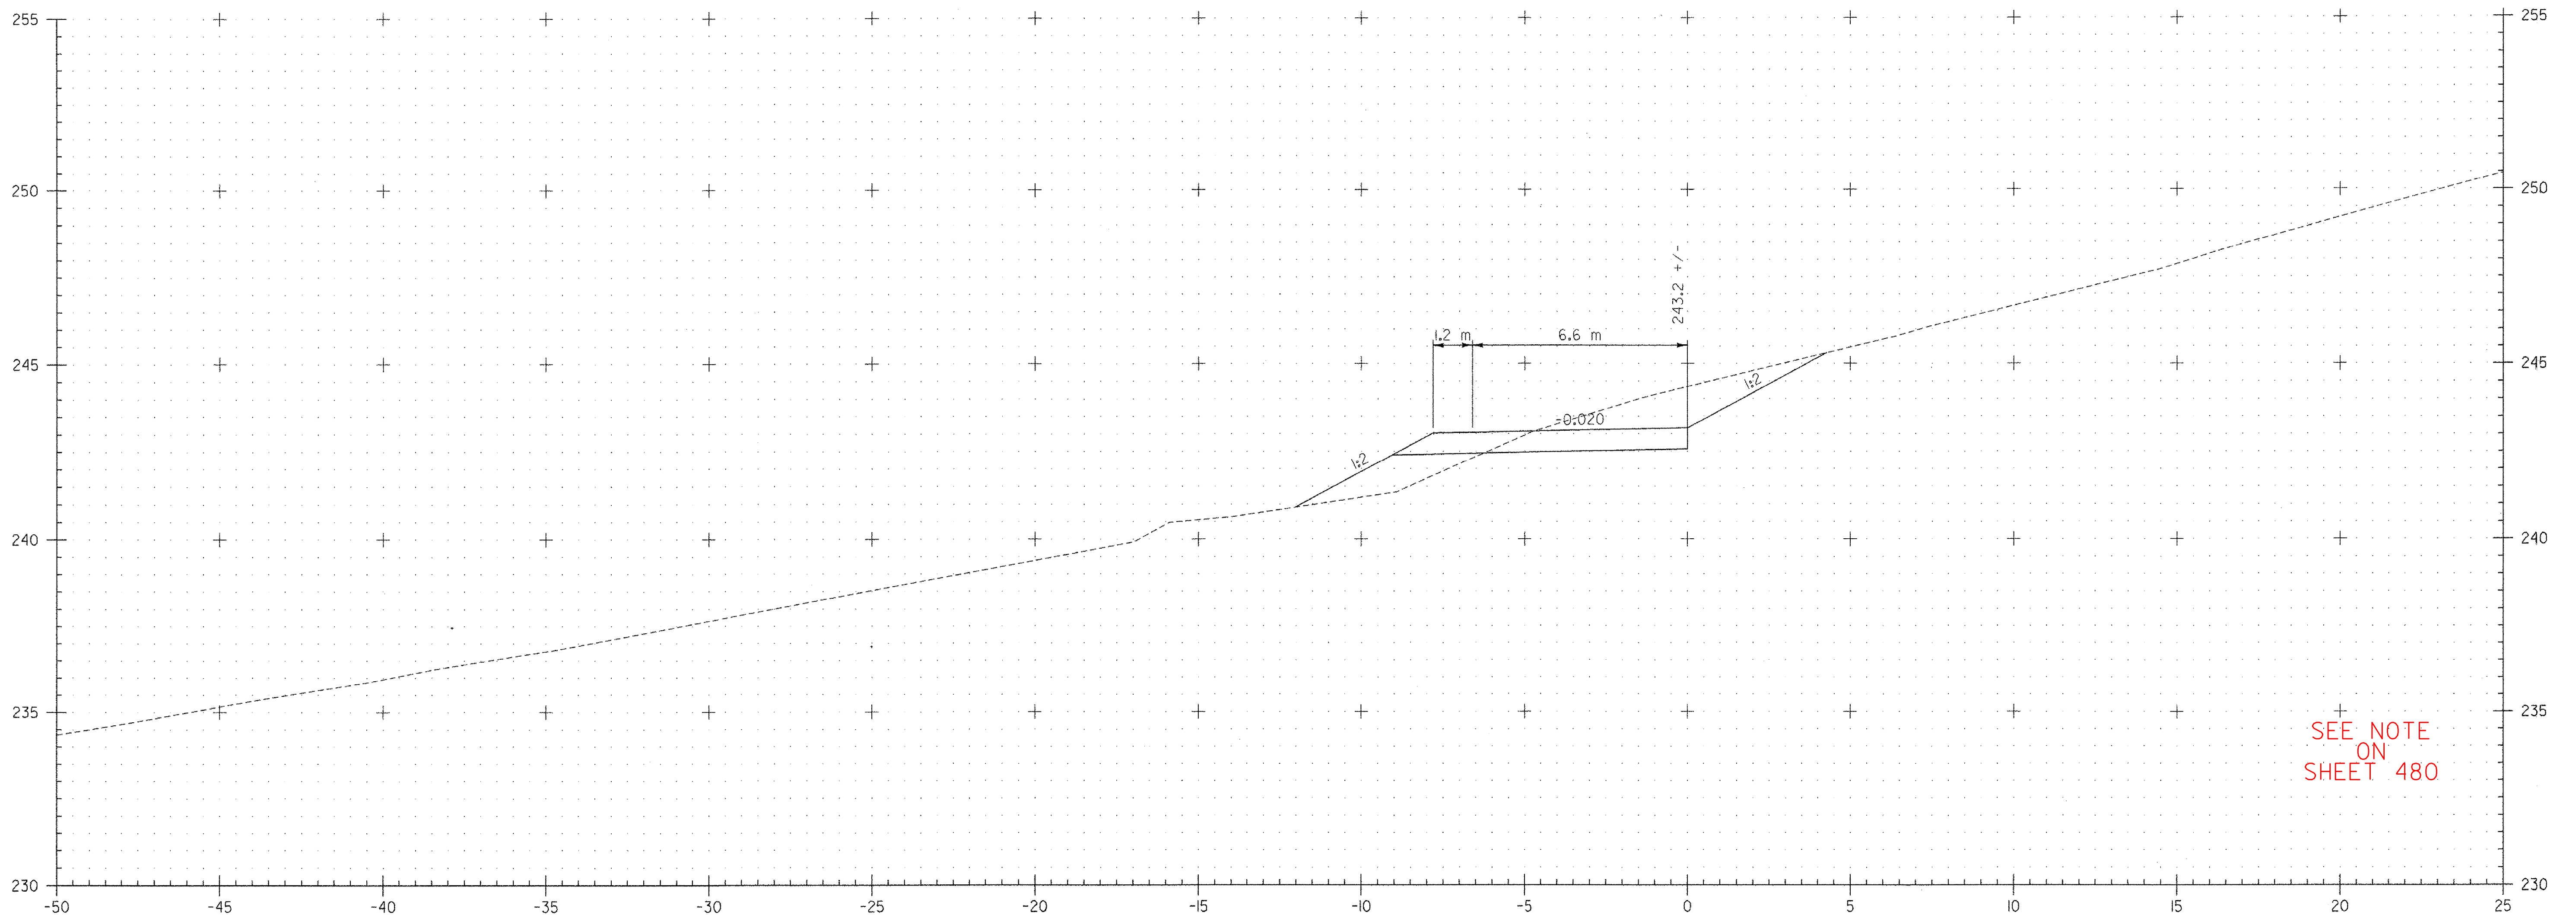

HR2+200
HAUL ROAD A

CUT (HAUL ROAD): 9
FILL (HAUL ROAD): 3

FILE NAME = \$FILE\$
DATE/TIME = \$DATE\$
USER = \$NTUSER\$

DATUM
VERTICAL NAVD 88
HORIZONTAL NAD 83 (1992)

2 0 2 m
1:100
© FULL SIZE

VERMONT AGENCY OF TRANSPORTATION

CHA
CLOUGH HARBOUR & ASSOCIATES LLP
111 Winnet Circle, PO Box 5289, Albany, NY 12205
www.cloughharbour.com

PROJECT NAME: BENNINGTON
PROJECT NUMBER: AC NH 019-1(53)

FILE NAME: ZD048XSC.DGN
PROJECT LEADER: D.E.G.
DESIGNED BY: J.S.P.
CROSS SECTIONS XSC-29

PLOT DATE: \$DATE\$
DRAWN BY: J.S.P.
CHECKED BY: D.E.G.
SHEET 508 OF 577