
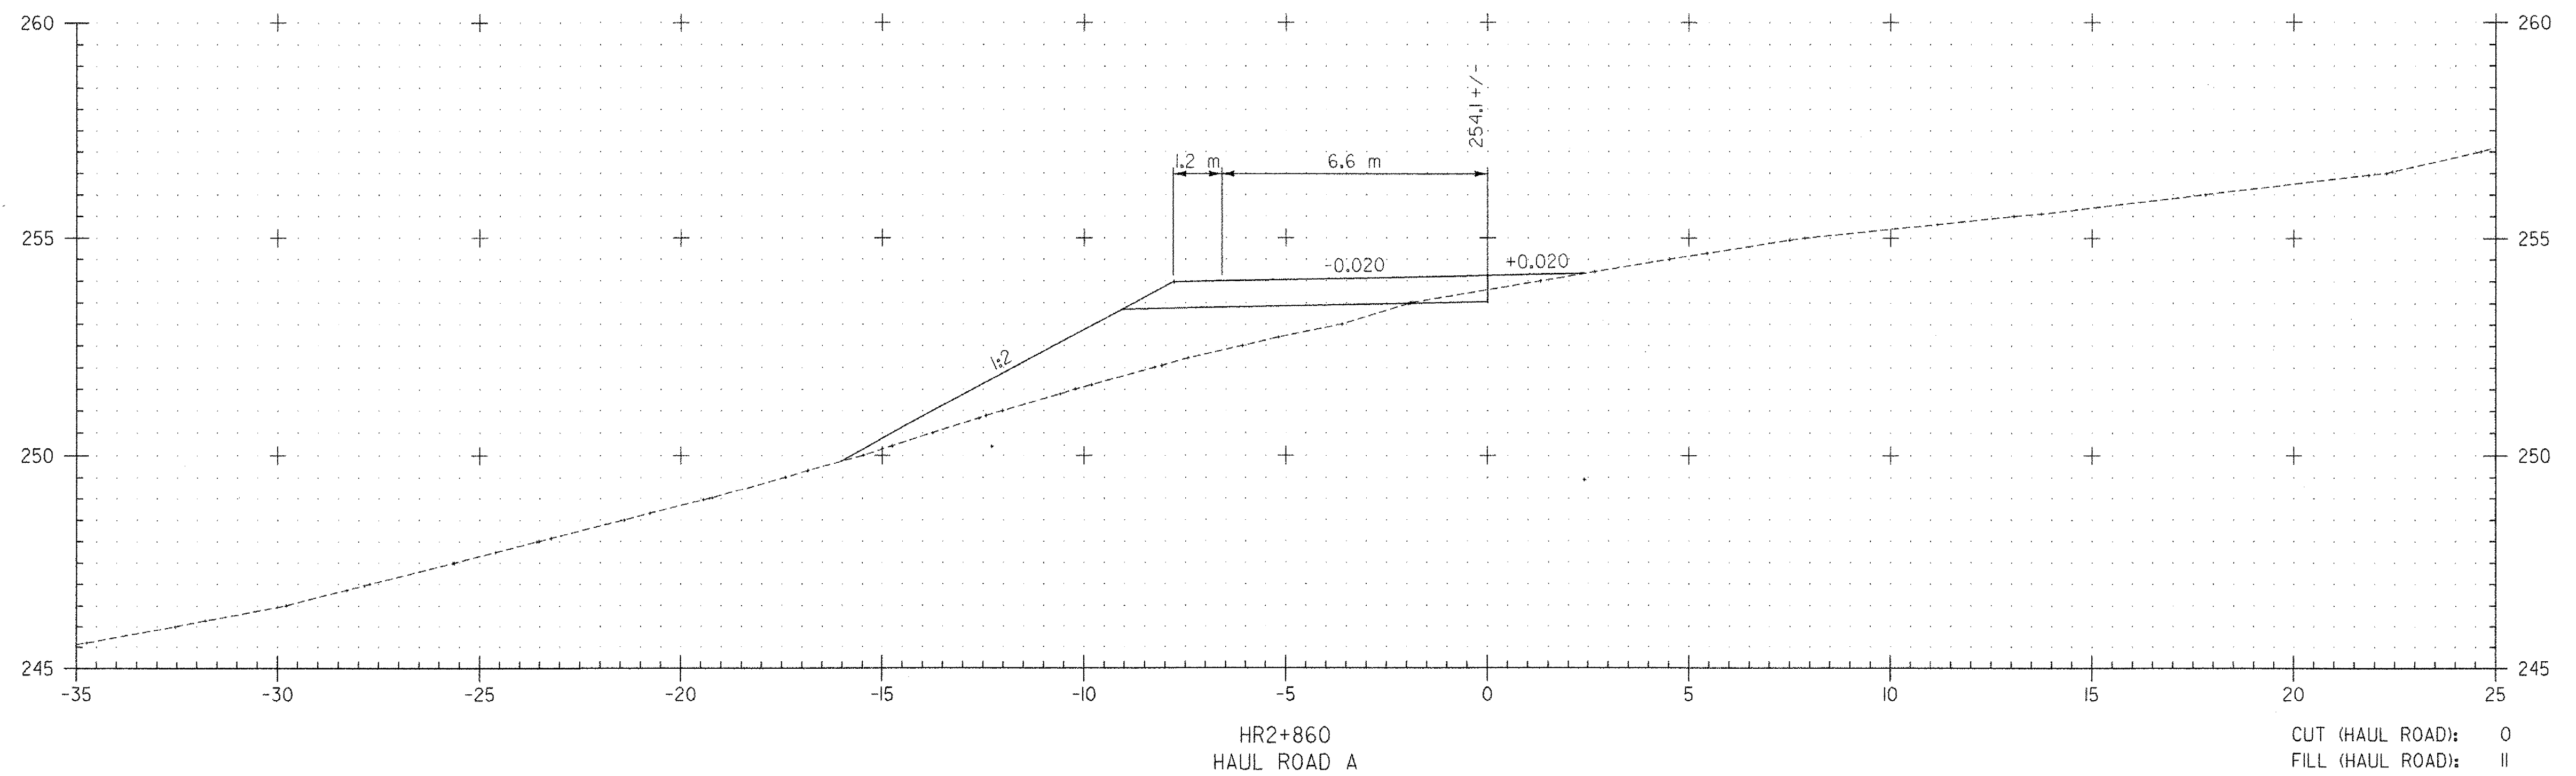


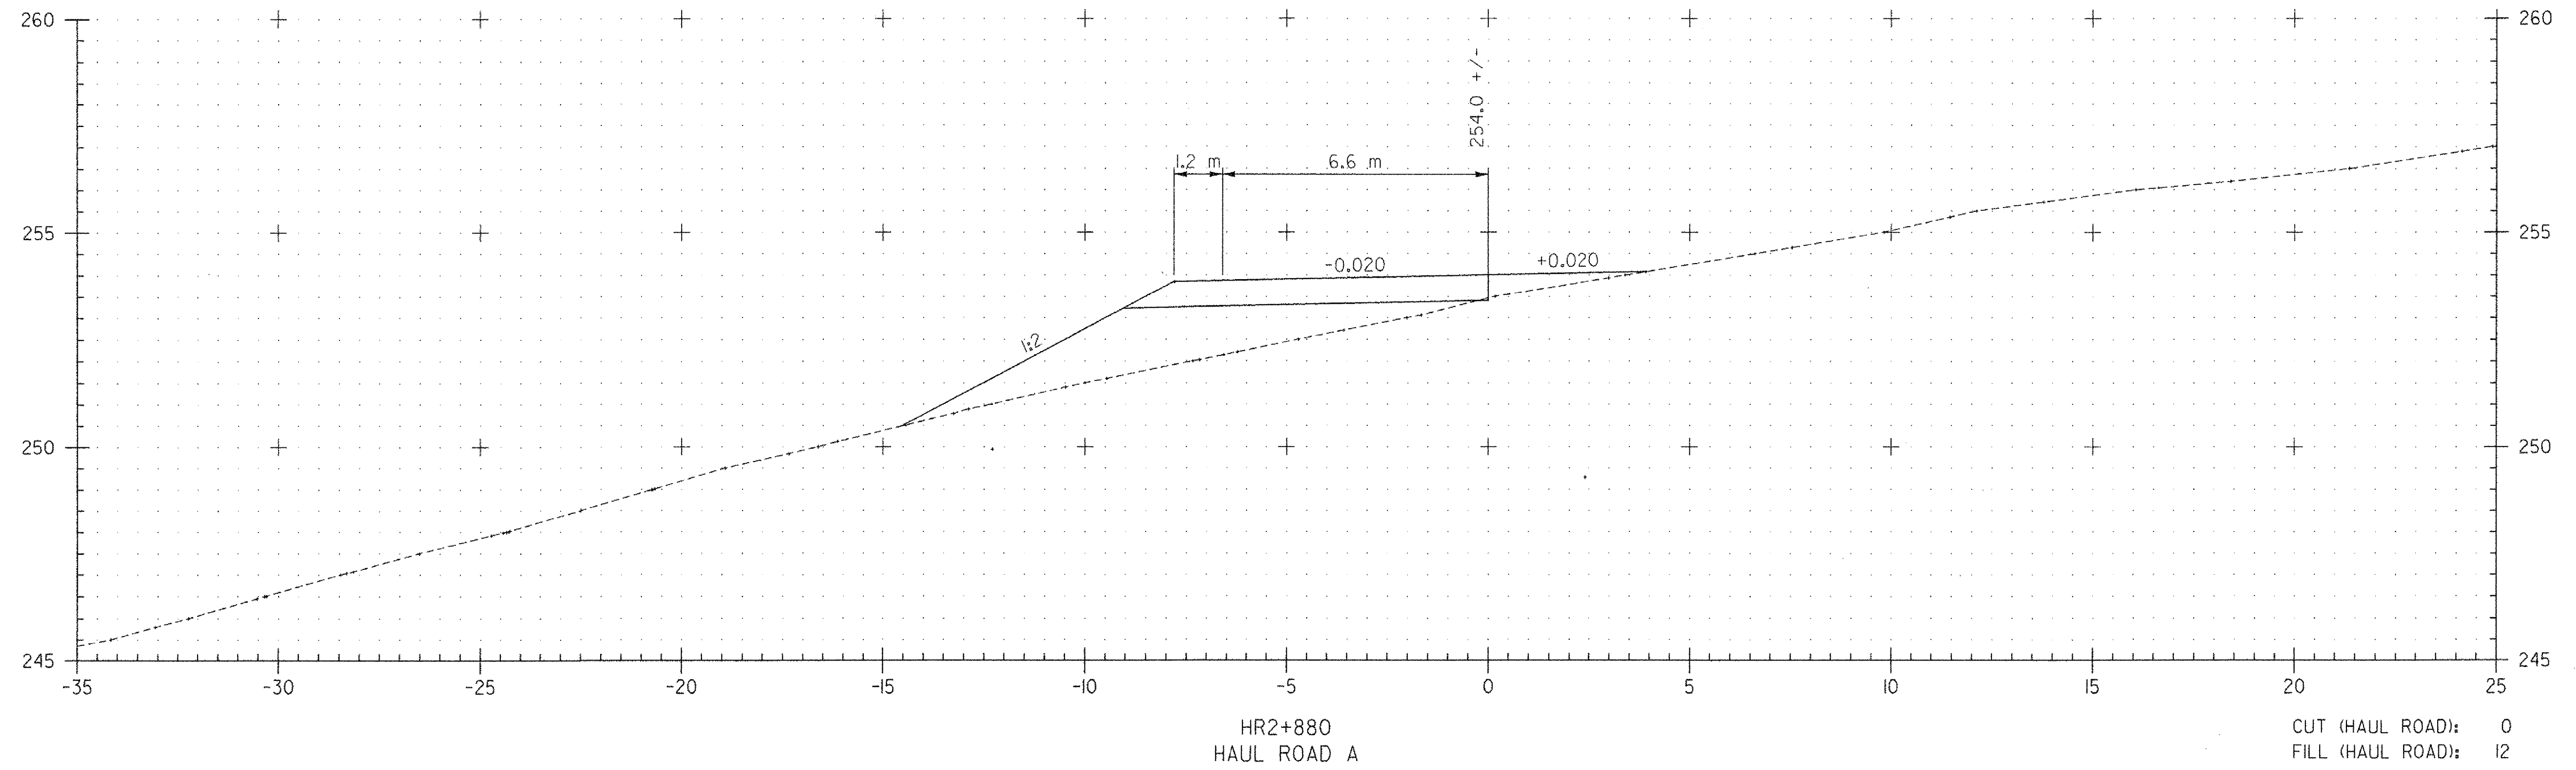

SEE NOTE
ON
SHEET 480

FILE NAME = U:\9819\mstn\03\clough\Stage One Sites\zd048xsc.f.dgn
DATE/TIME = 5/18/2007
USER = 1459

DATUM
VERTICAL NAVD 88
HORIZONTAL NAD 83 (1992)

2 0 2 m
1:100
@ FULL SIZE

VERMONT AGENCY OF TRANSPORTATION

CHA
CLOUGH HARBOUR & ASSOCIATES LLP
111 Winans Circle, PO Box 5250, Albany, NY 12205
www.cloughharbour.com

PROJECT NAME: BENNINGTON
PROJECT NUMBER: AC NH 019-1(53)

FILE NAME: ZD048XSC.DGN
PROJECT LEADER: D.E.G.
DESIGNED BY: J.S.P.
CROSS SECTIONS XSC-55

PLOT DATE: 5/18/2007
DRAWN BY: J.S.P.
CHECKED BY: D.E.G.
SHEET 534 OF 577