


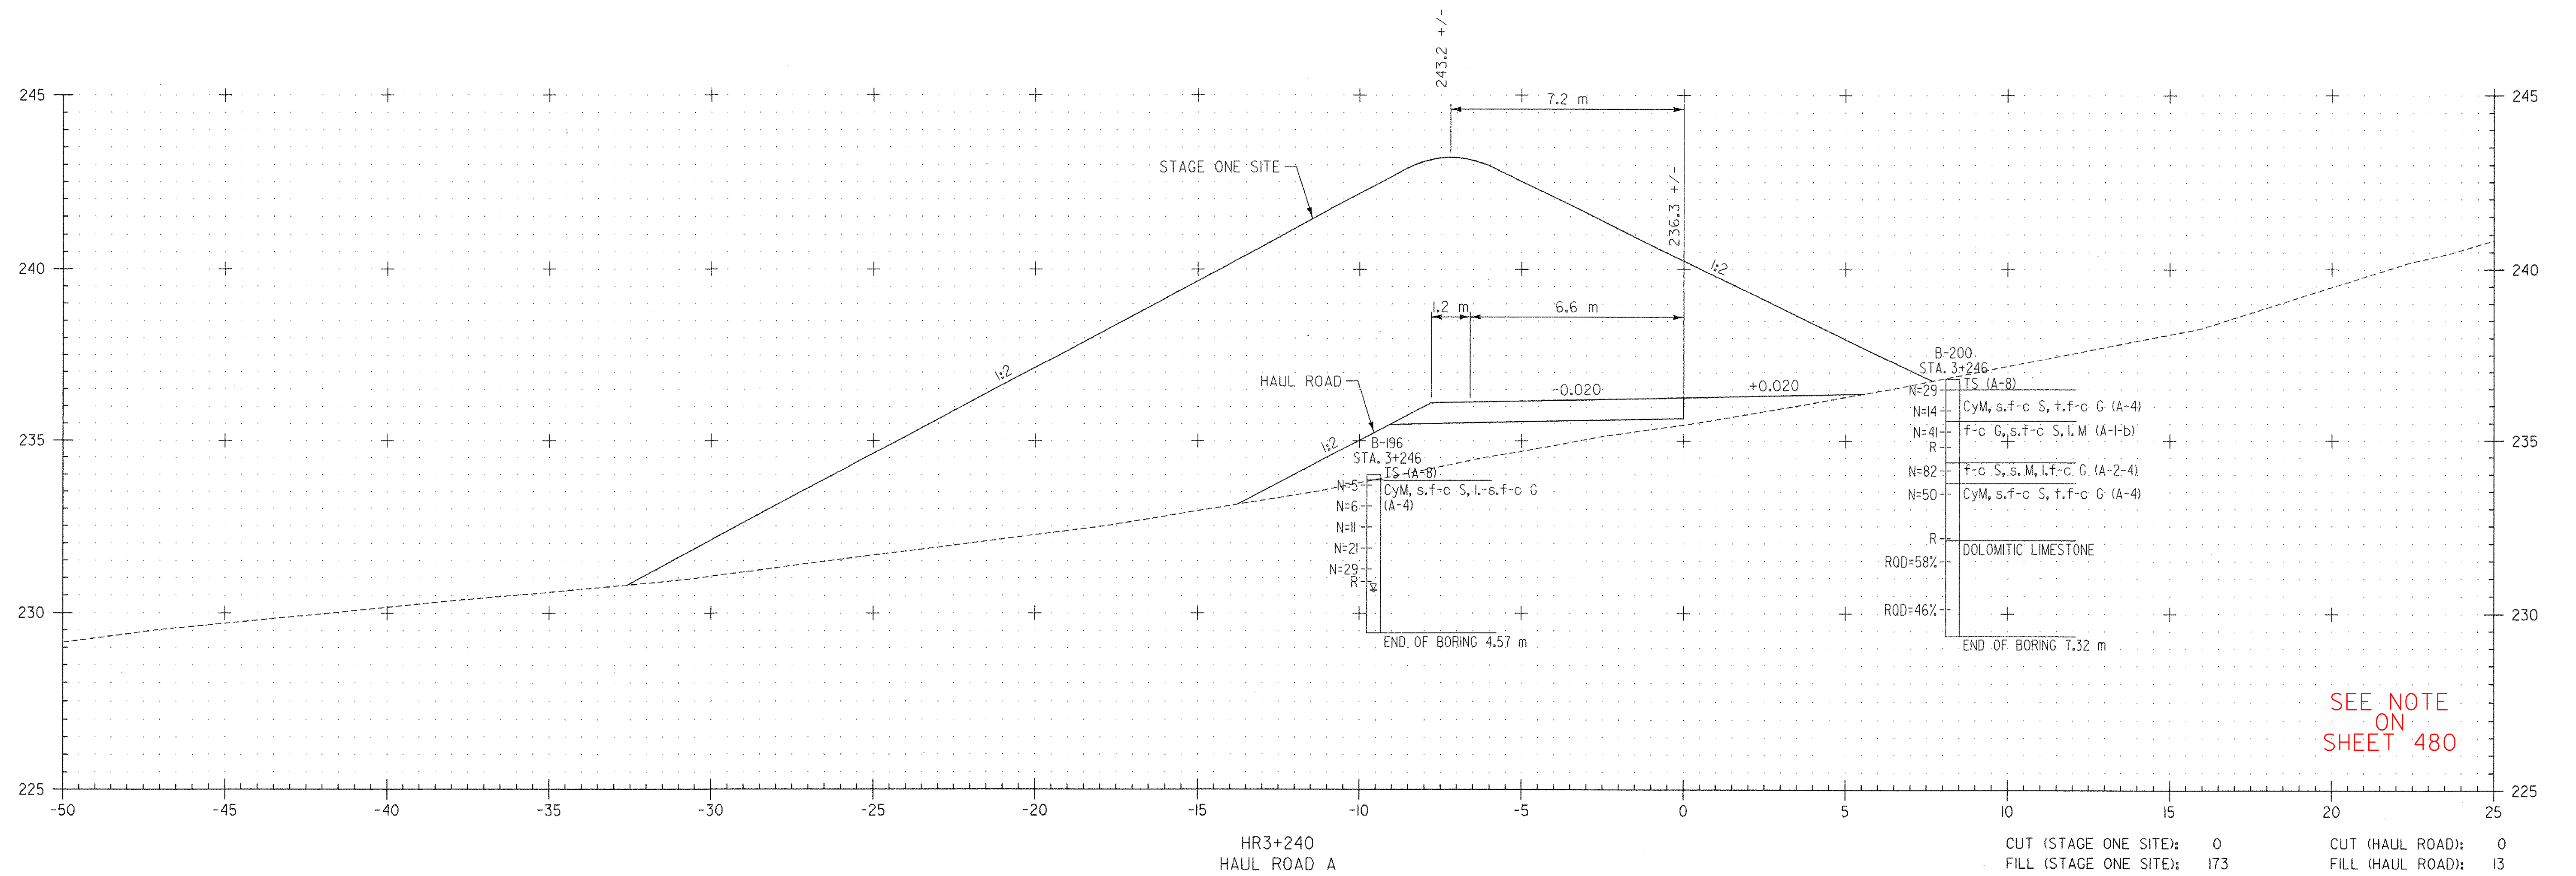

FILE NAME = U:\9819\mstn\03\clough\Stage One Sites\zd048xsc-f.dgn  
DATE/TIME = 5/18/2007  
USER = 1459

DATUM  
VERTICAL NAVD 88  
HORIZONTAL NAD 83 (1992)

2 0 2 m  
1:100  
@ FULL SIZE

# VERMONT AGENCY OF TRANSPORTATION



PROJECT NAME: BENNINGTON  
PROJECT NUMBER: AC NH 019-1(53)

FILE NAME: ZD048XSC.DGN  
PROJECT LEADER: D.E.G.  
DESIGNED BY: J.S.P.  
**CROSS SECTIONS XSC-69**

PLOT DATE: 5/18/2007  
DRAWN BY: J.S.P.  
CHECKED BY: D.E.G.  
SHEET 548 OF 577