


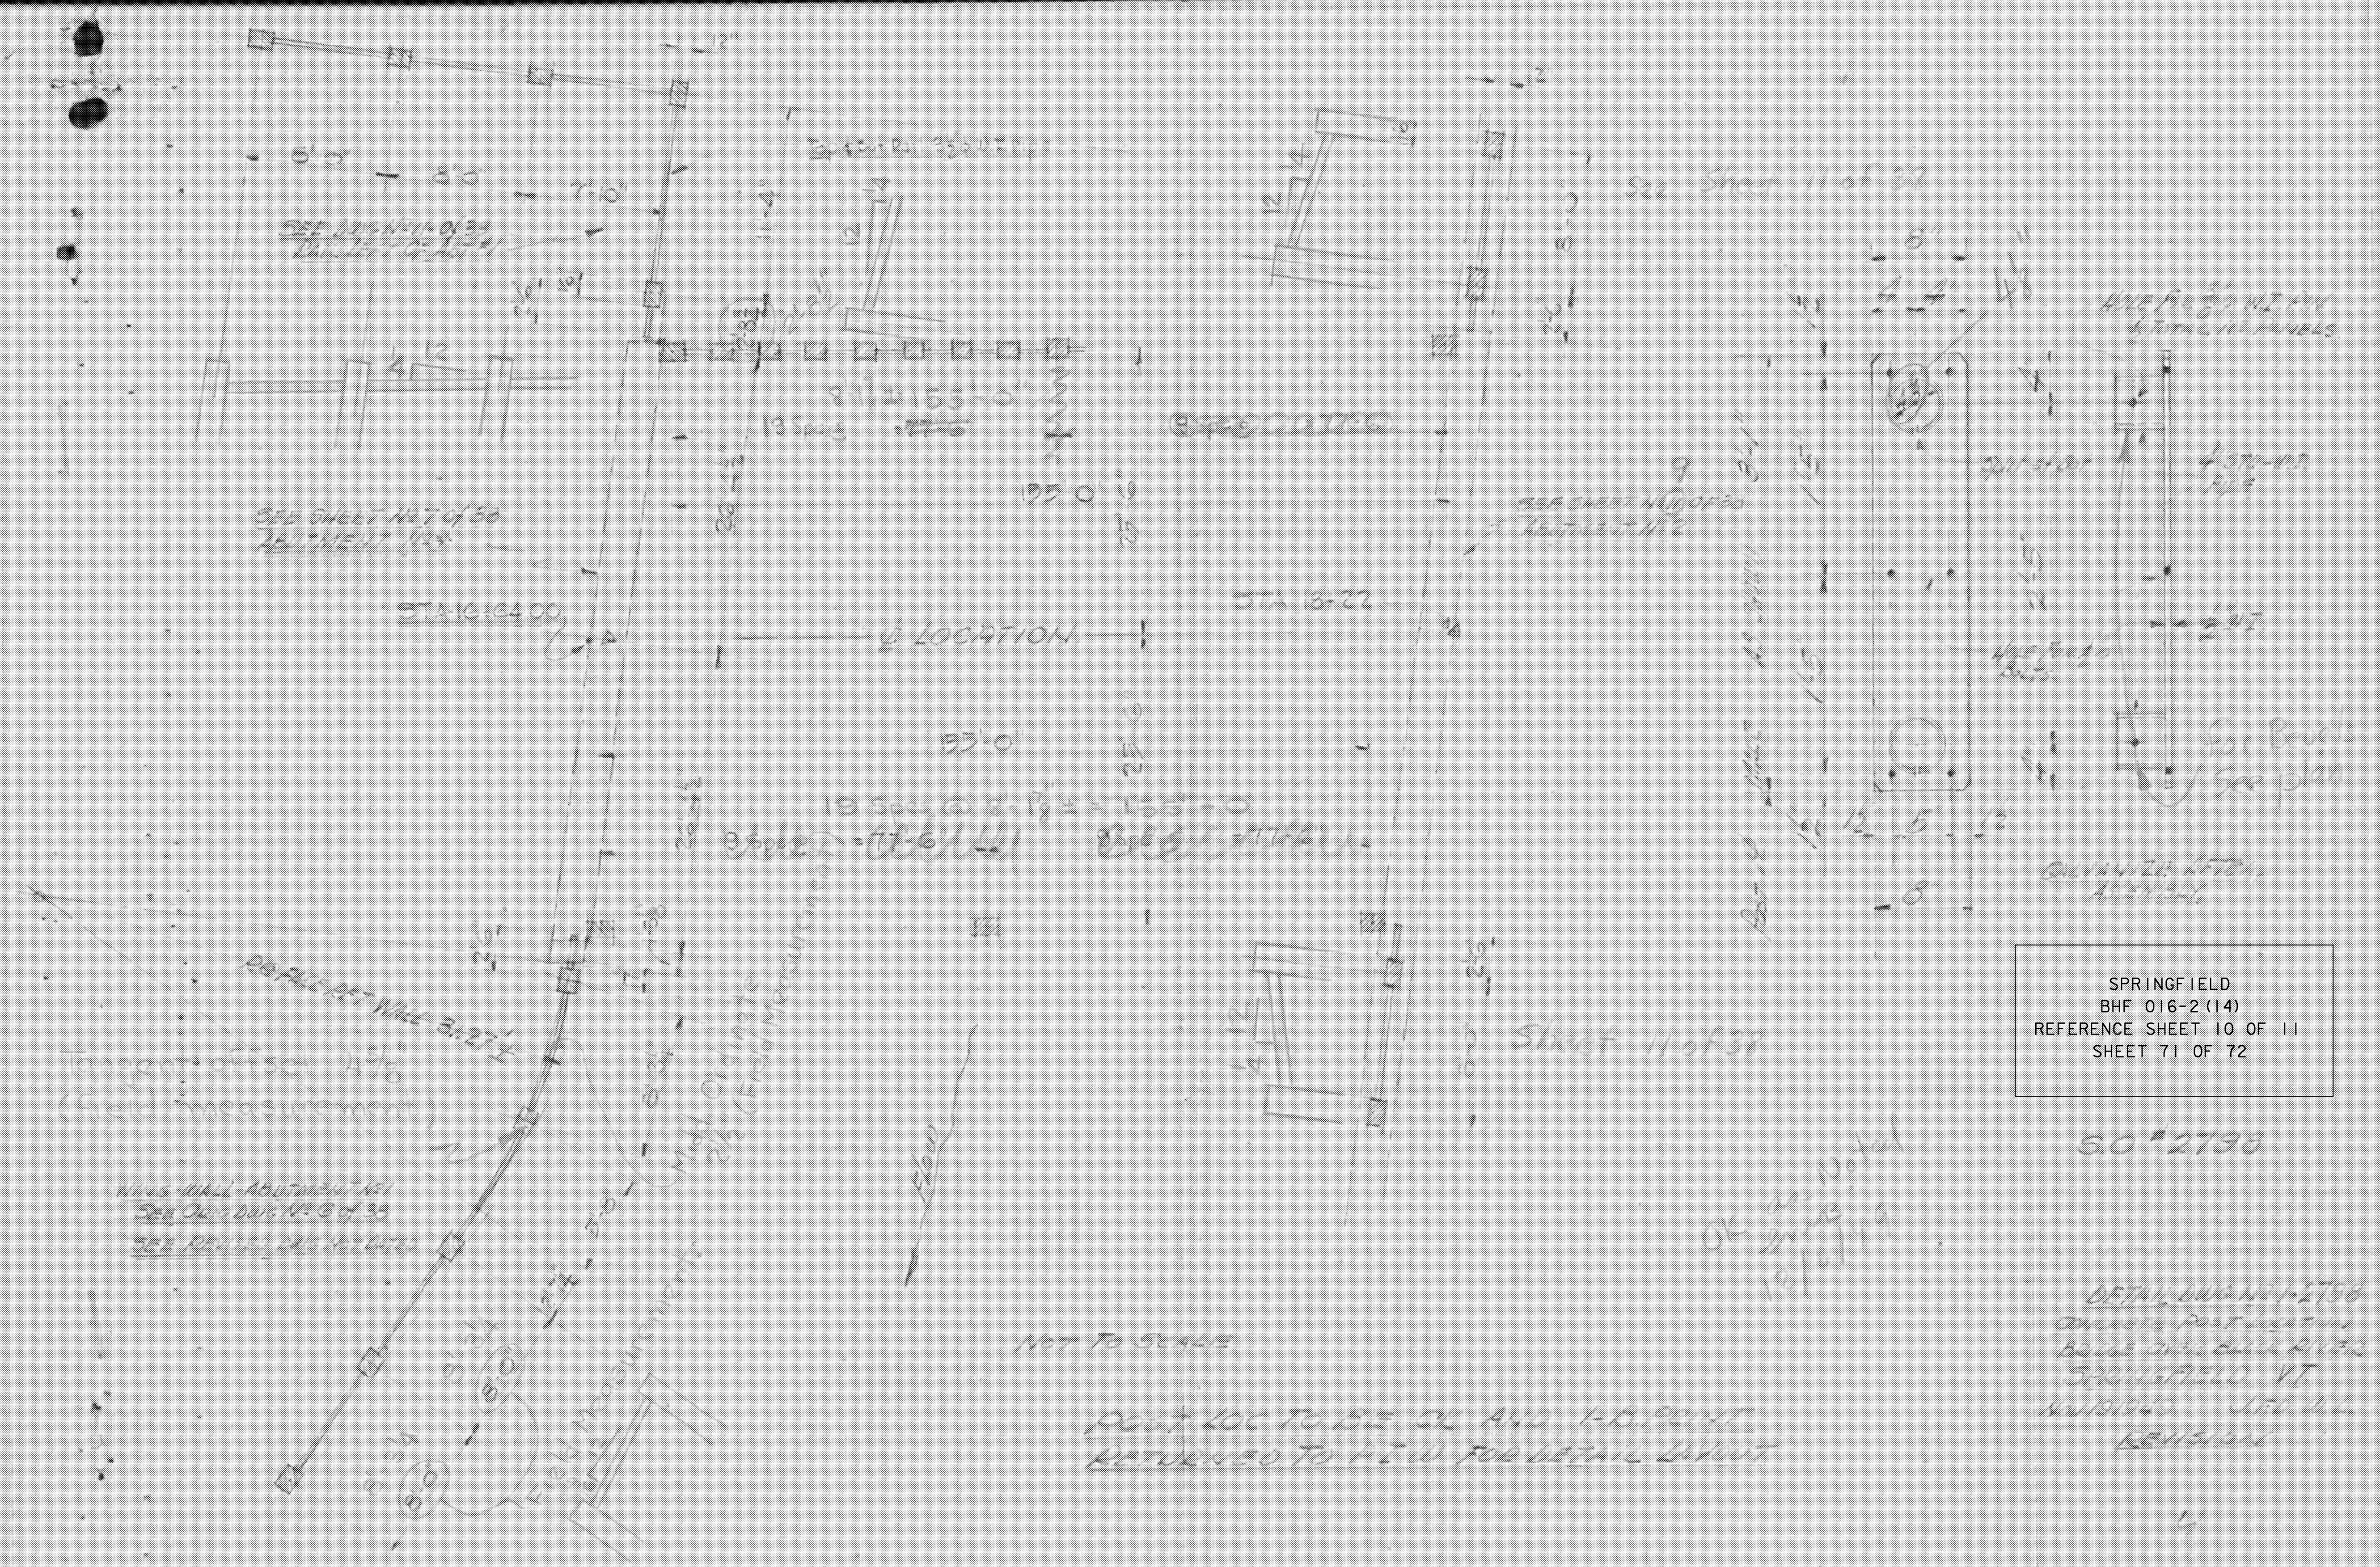

SPRINGFIELD
BHF 016-2 (14)
REFERENCE SHEET 10 OF 11
SHEET 71 OF 72

S.O #2798

DETAIL DWG NO 1-2798
CONCRETE POST LOCATION
BRIDGE OVER BLACK RIVER
SPRINGFIELD VT
NOV 19 1949 J.F.D. W.L.
REVISION 1

NOT TO SCALE

Pos. LOC TO BE OK AND I-B.P. PRINT
RETURNED TO P.I.W. FOR DETAIL LAYOUT

OK as Noted
12/6/49