



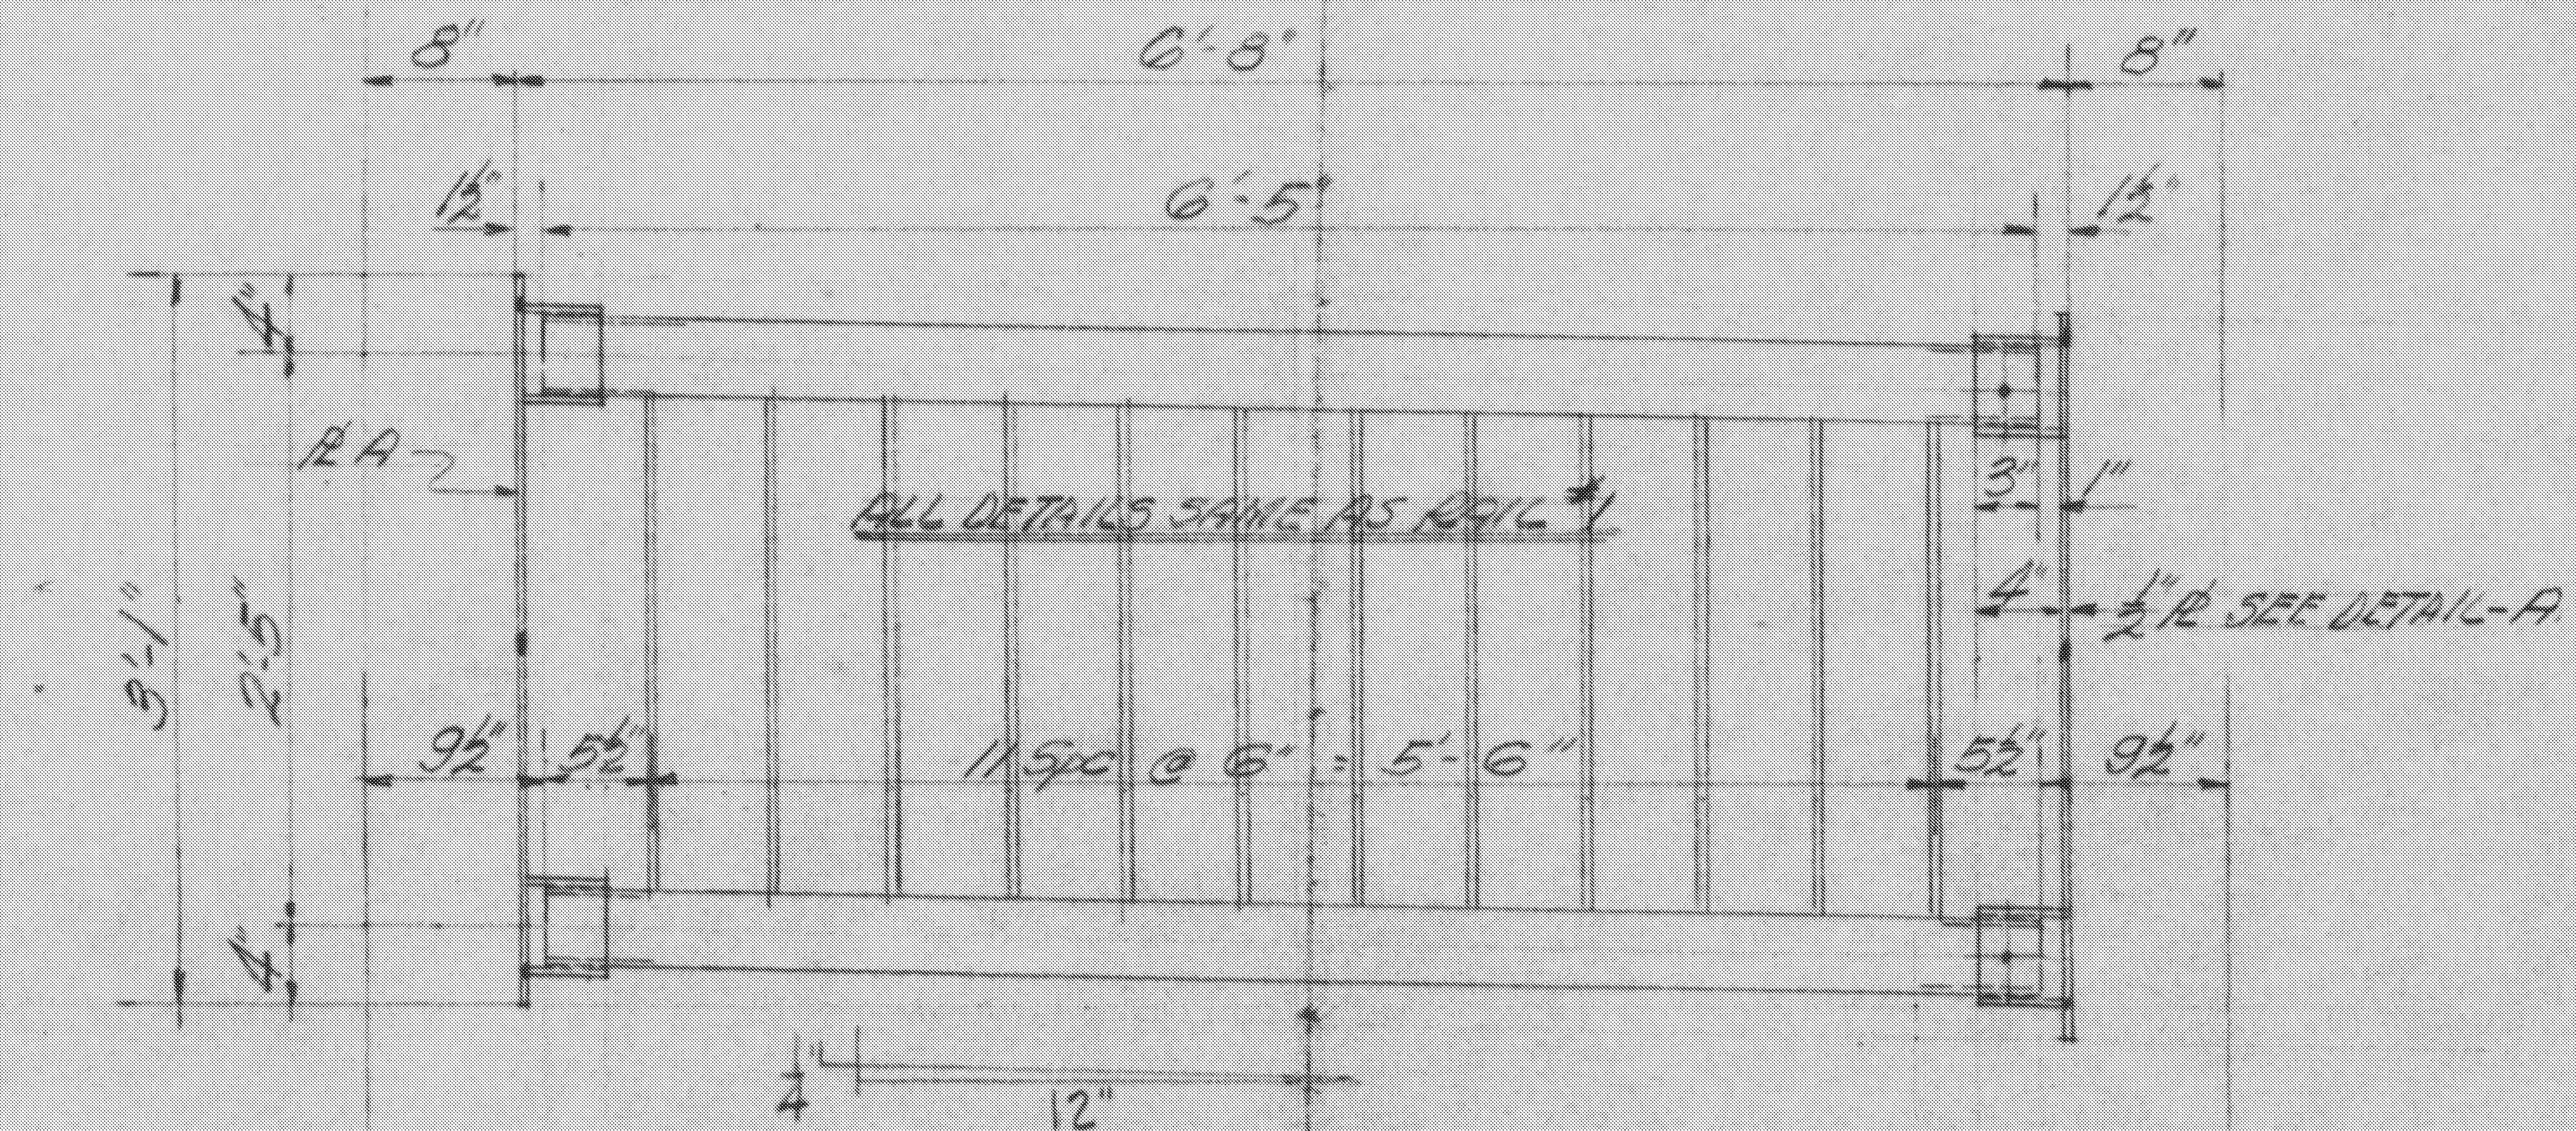

MK-T MAKE-2 AS SHOWN BOT & TOP RAIL 3 1/2" STD W.I. PIPE 8'-0"

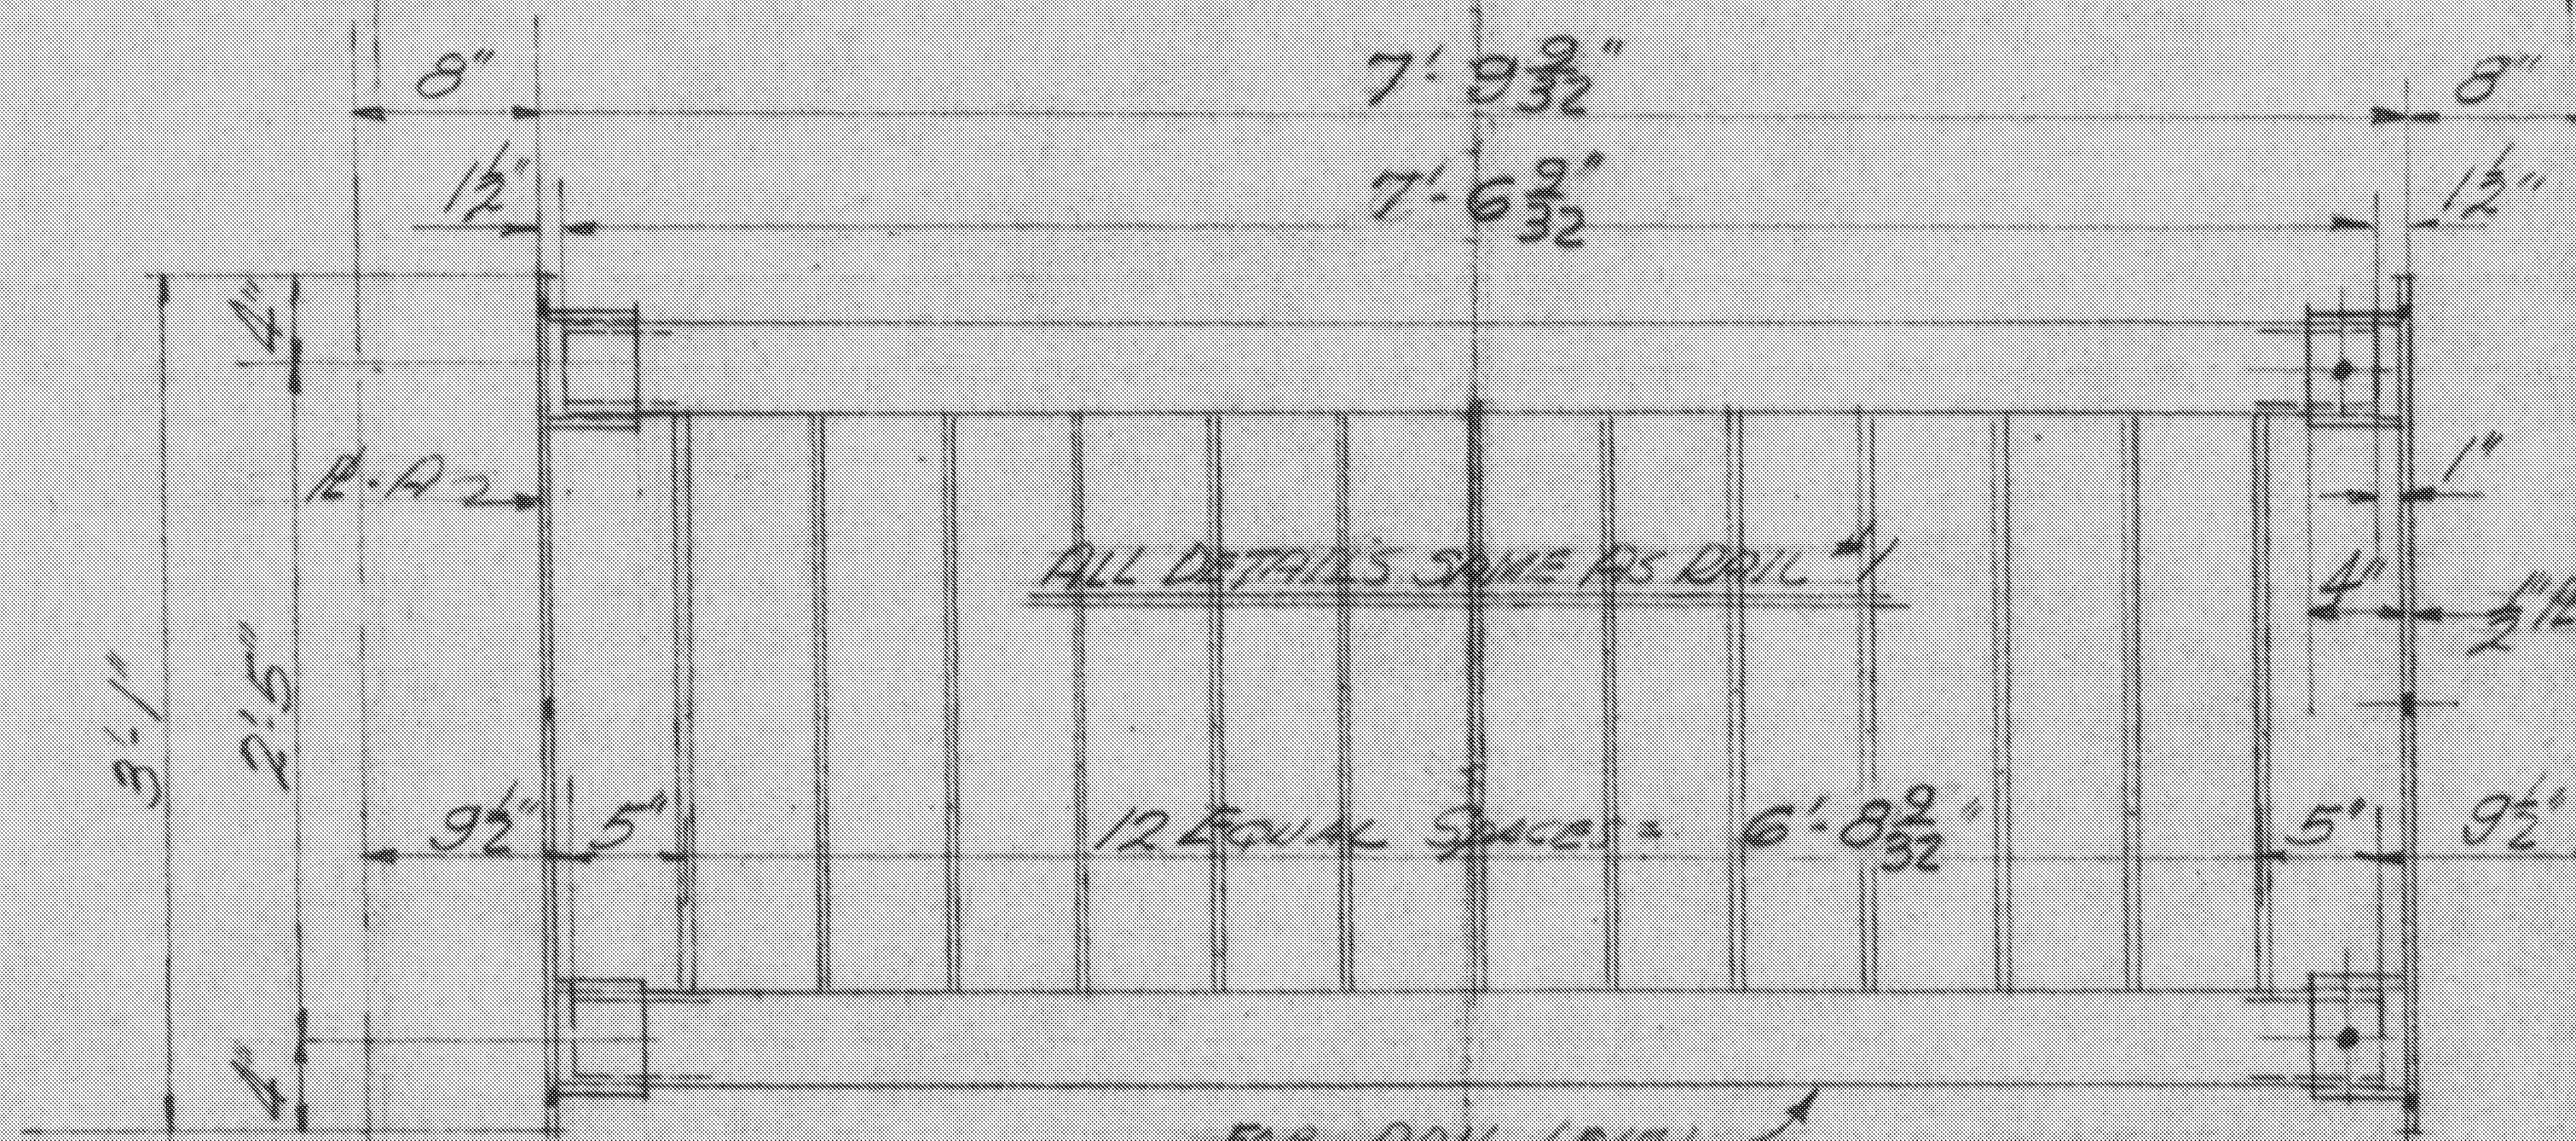

MK-B MAKE-34 AS SHOWN BOT & TOP RAIL 3 1/2" STD W.I. PIPE 9'-1 9/32"

SPRINGFIELD
BHF 016-2 (14)
REFERENCE SHEET 11 OF 11
SHEET 72 OF 72

APPROVED
1/30/50 - R.H.B.
(REV #1)

PITTSFIELD IRON WORKS
& COAL SUPPLY
158 SOUTH ST. PITTSFIELD, MASS.

DETAIL Dwg. No. 2798
PIPE RAIL DETAIL
BRIDGE OVER BLACK RIVER
SPRINGFIELD VT.
DEC 31, 1949 J.F.D. W.L.

REVISION
NO. 1. QD LENGTH & NO. REQ.
PTB. 1/30/50 J.F.D.