

REMOVAL AND DISPOSAL OF GUARDRAIL
 STA. NB 10+770.0, 6.6m LT. - STA. NB 10+876.9, 7.6m LT.
 STA. SB 10+910.0, 1.8m LT. - STA. SB 11+061.8, 6.6m LT.
 STA. SB 10+910.0, 16.9m RT. - STA. SB 10+919.4, 19.4m RT.
 STA. G 2+050.0, 3.0m RT. - STA. G 2+153.6, 8.5m RT.
 STA. I 1+248.6, 4.4m LT. - STA. I 1+324.0, 2.4m LT.
 STA. I 1+370.9, 1.5m RT. - STA. I 1+433.3, 1.2m RT.
 STA. I 1+418.6, 7.3m LT. - STA. I 1+433.3, 1.2m LT.

STEEL BEAM GUARDRAIL, GALVANIZED 2+079
 STA. NB 10+770.0, 6.6m LT. - STA. NB 10+860.0, 6.6m LT.
 STA. SB 10+910.0, 1.8m LT. - STA. SB 11+131.2, 1.8m LT.
 STA. G 2+050.0, 1.8m RT. - STA. G 2+061.8, 1.8m RT.
 STA. G 2+050.0, 7.0m LT. - STA. G 2+082.7, 6.6m LT.
 STA. I 1+395.2, 1.2m LT. - STA. I 1+433.3, 1.2m LT.
 STA. I 1+395.2, 1.2m RT. - STA. I 1+433.3, 1.2m RT.
 STA. S 1+049.7, 6.6m LT. - STA. S 1+164.6, 5.5m LT.

MANUFACTURED TERMINAL SECTION, FLARED
 STA. SB 11+131.2, 1.8m LT. - SB 11+142.6, 1.8m LT.
 STA. S 1+038.3, 6.6m LT. - 1+049.7, 6.6m LT.
 STA. I 1+383.8, 1.2m LT. - STA. I 1+395.2, 1.2m LT.
 STA. I 1+383.8, 1.2m RT. - STA. I 1+395.2, 1.2m RT.




ANCHOR FOR STEEL BEAM RAIL
 STA. NB 10+860.0, 6.6m LT.
 STA. G 2+061.8, 1.8m RT.
 STA. G 2+082.7, 6.6m LT.

PROJECT DEMARCATION FENCE
 STA. NB 10+770.0, RT. - STA. NB 11+040.8, RT.
 STA. SB 10+910.0, LT. - STA. SB 11+088.0, LT.
 STA. SB 11+174.2, RT. - STA. SB 11+220.0, RT.
 STA. I 1+337.3, RT. - STA. I 1+433.3, RT.
 STA. I 1+394.6, LT. - STA. I 1+433.3, LT.

BARRIER FENCE
 STA. NB 10+770.0, LT. - STA. G 2+050.0, RT.

BITUMINOUS CONCRETE CURB, TYPE A
 STA. NB 10+770.0, 6.6m LT. - STA. NB 10+860.0, 6.6m LT.
 STA. SB 10+910.0, 1.8m LT. - STA. SB 11+131.2, 1.8m LT.
 STA. G 2+050.0, 1.8m RT. - STA. G 2+061.8, 1.8m RT.
 STA. G 2+050.0, 7.0m LT. - STA. G 2+082.7, 6.6m LT.
 STA. S 1+049.7, 6.6m LT. - STA. S 1+164.6, 5.5m LT.

TERMINAL CONNECTOR FOR STEEL BEAM GUARDRAIL
 STA. S 1+164.6, 5.5m LT.

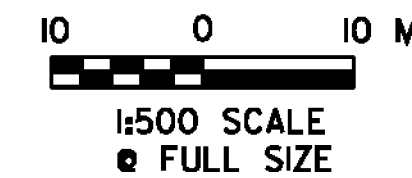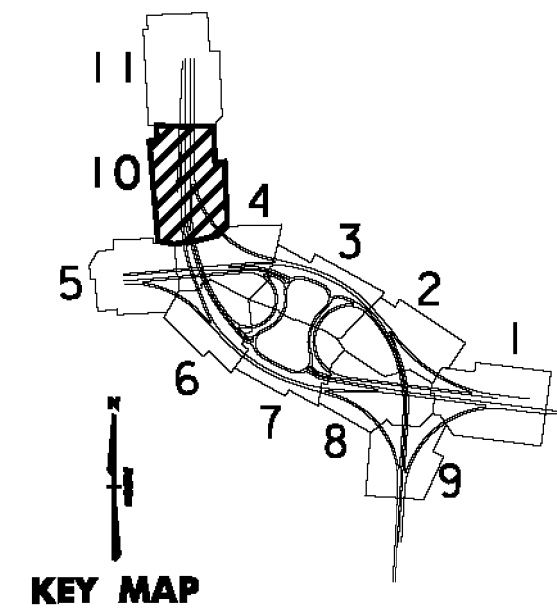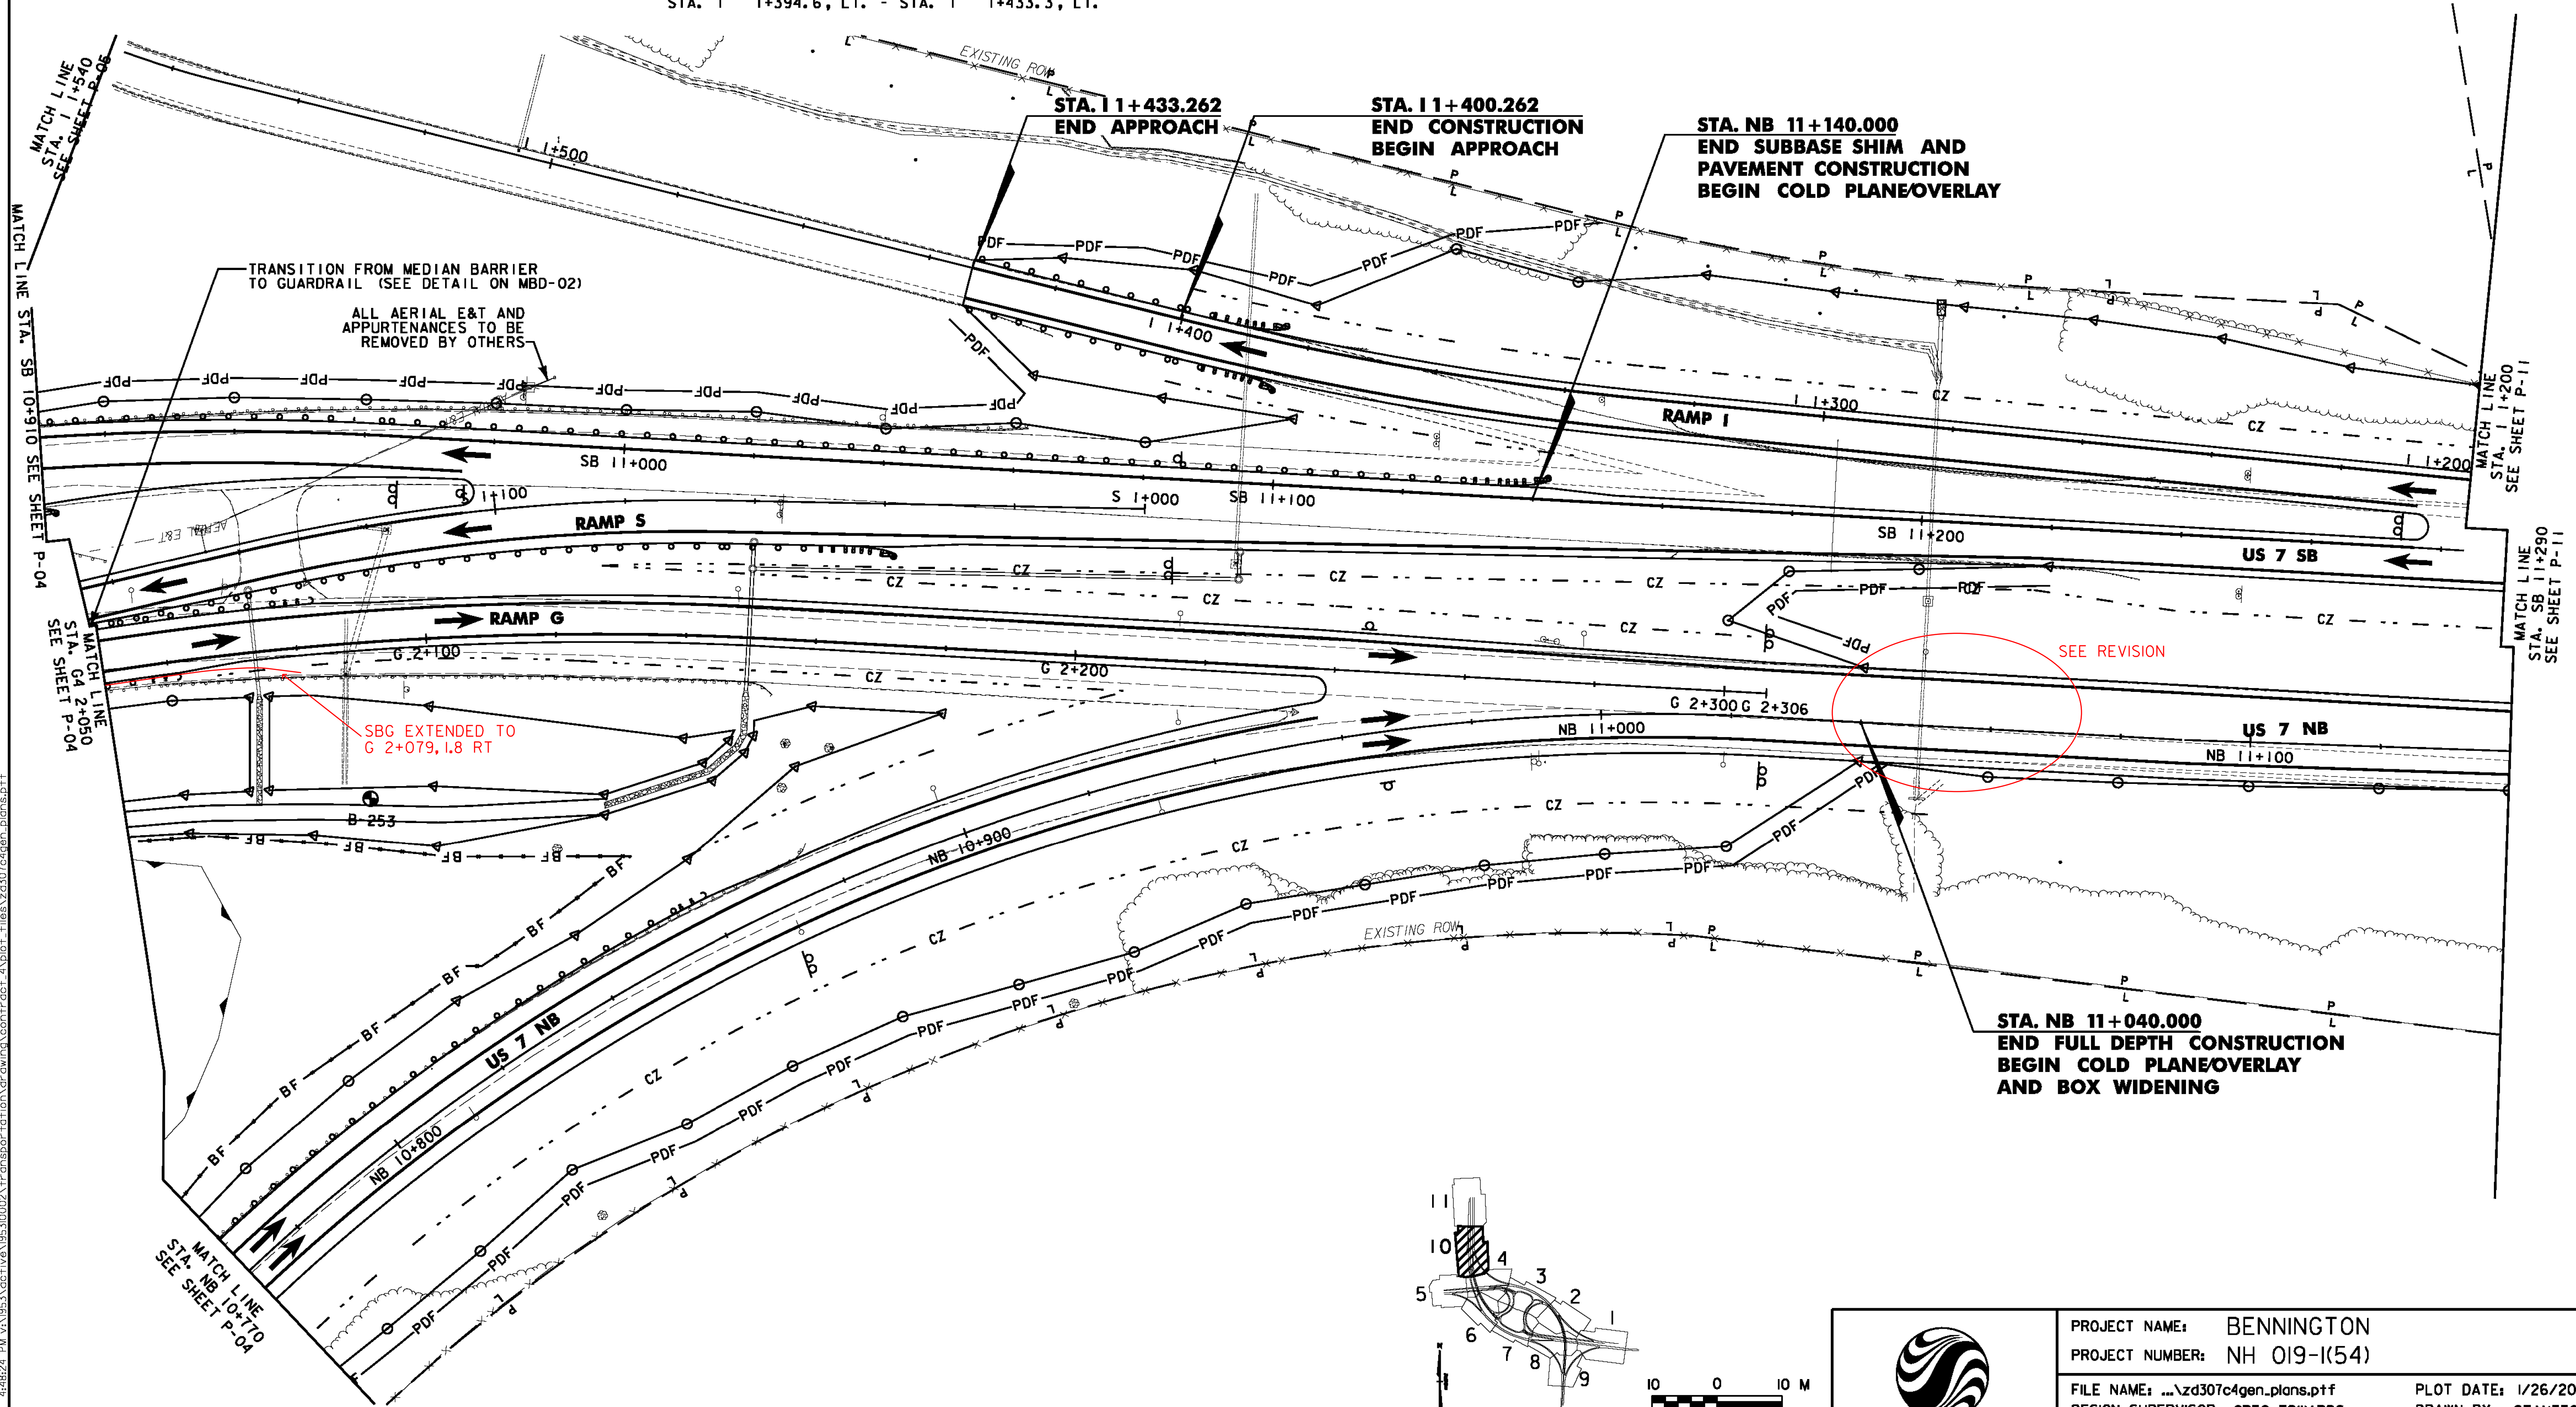

PROJECT NAME: BENNINGTON
 PROJECT NUMBER: NH 019-(K54)

FILE NAME: ...z307c4gen_plans.ptf
 DESIGN SUPERVISOR: GREG EDWARDS
 DESIGNED BY: MARC FOISY
 GENERAL PLAN P-10

PLOT DATE: 1/26/2010
 DRAWN BY: STANTEC
 CHECKED BY: GARY SANTY
 SHEET 125 OF 468