


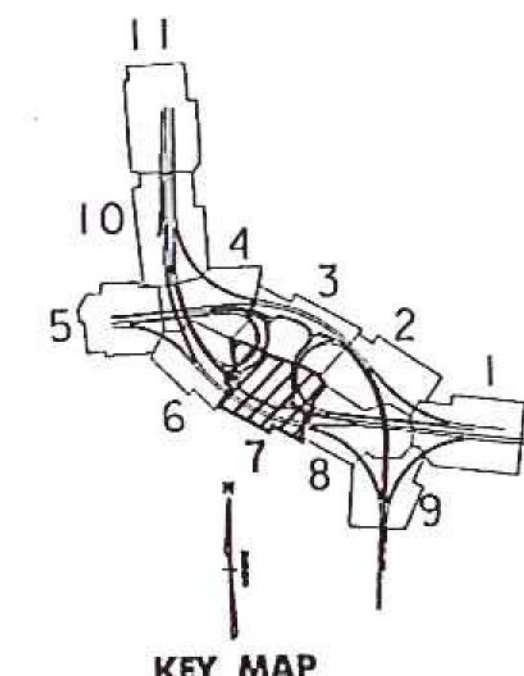

PROJECT NAME:	BENNINGTON	
PROJECT NUMBER:	NH 019-1(54)	
FILE NAME: ...zd307c4drn_plans.pff	PLOT DATE: 1/26/2010	
DESIGN SUPERVISOR: GREG EDWARDS	DRAWN BY: STANTEC	
DESIGNED BY: MARC FOISY	CHECKED BY: GARY SANTY	
DRAINAGE PLANS DP-07	SHEET 133 OF 468	

REVISED: 10-05-10