




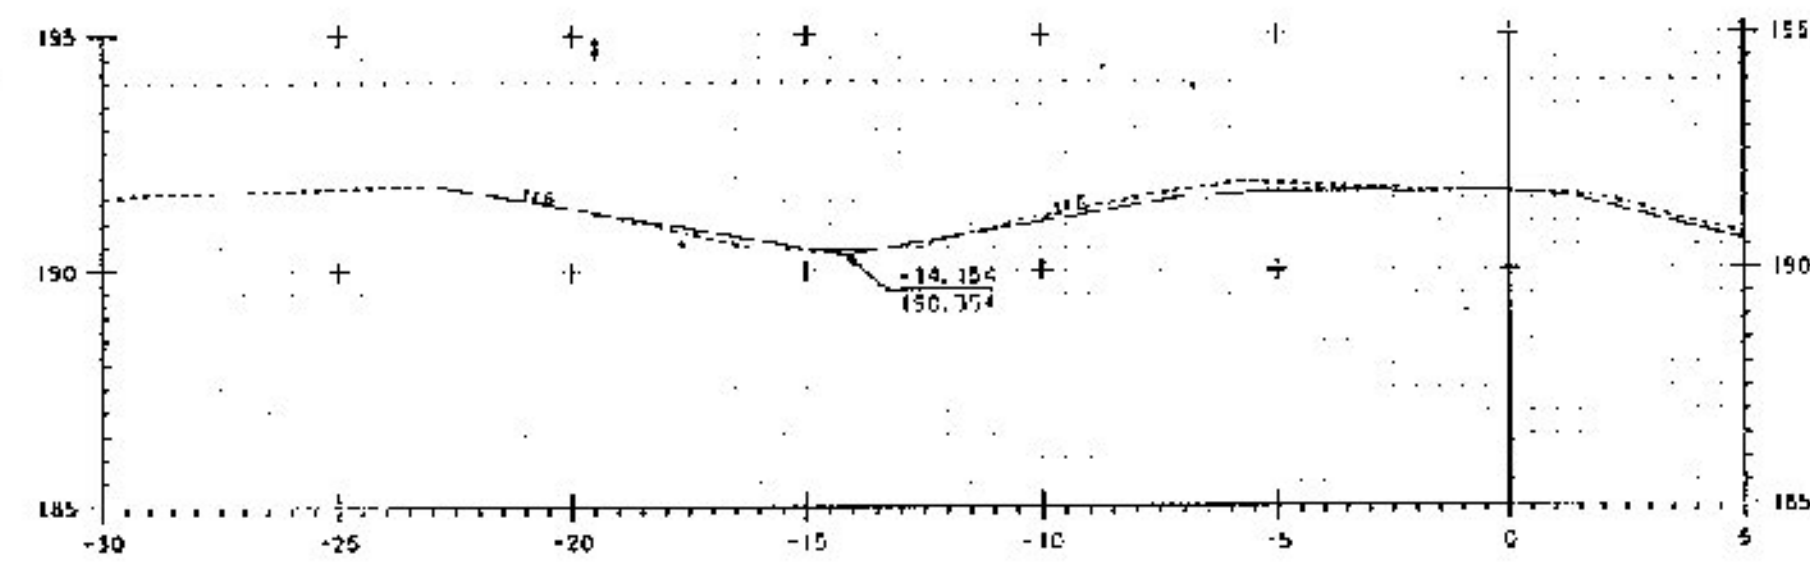


WB 10+920

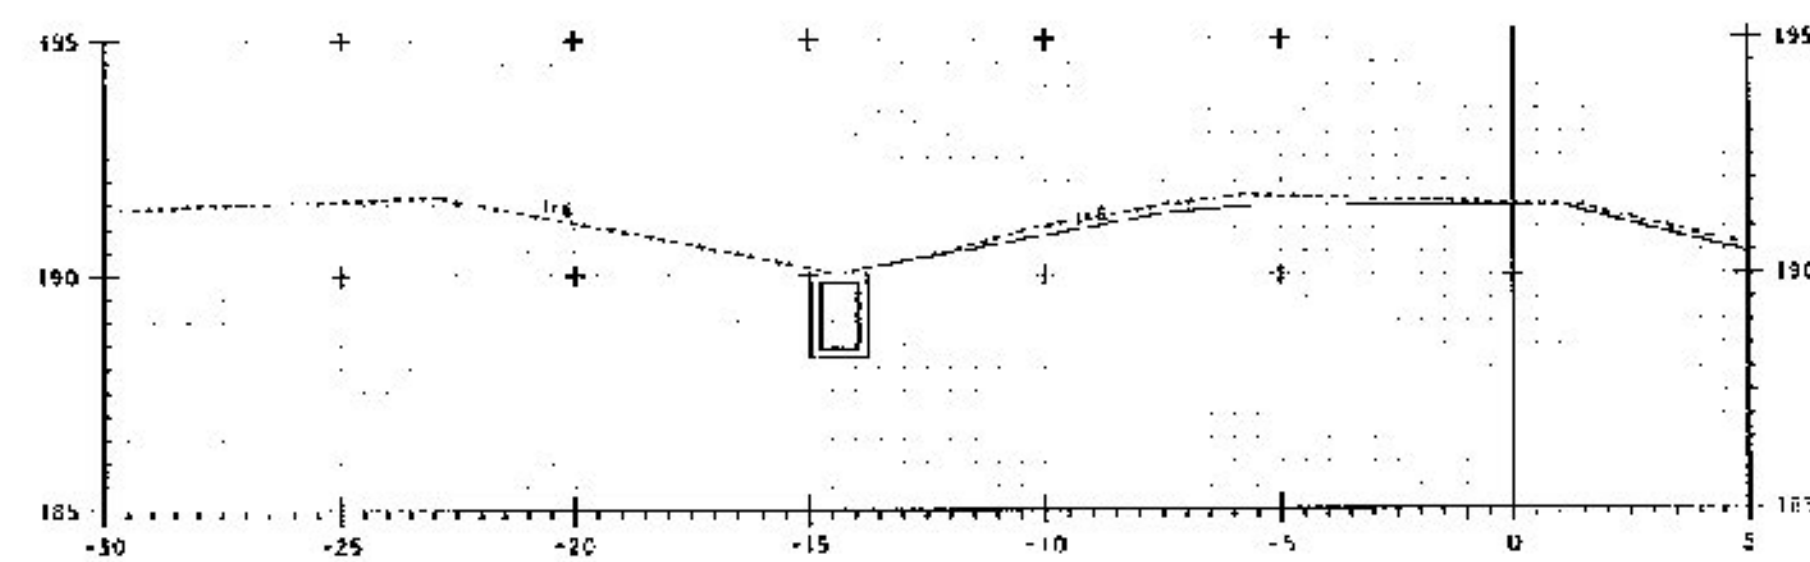


WB 10+910.56B

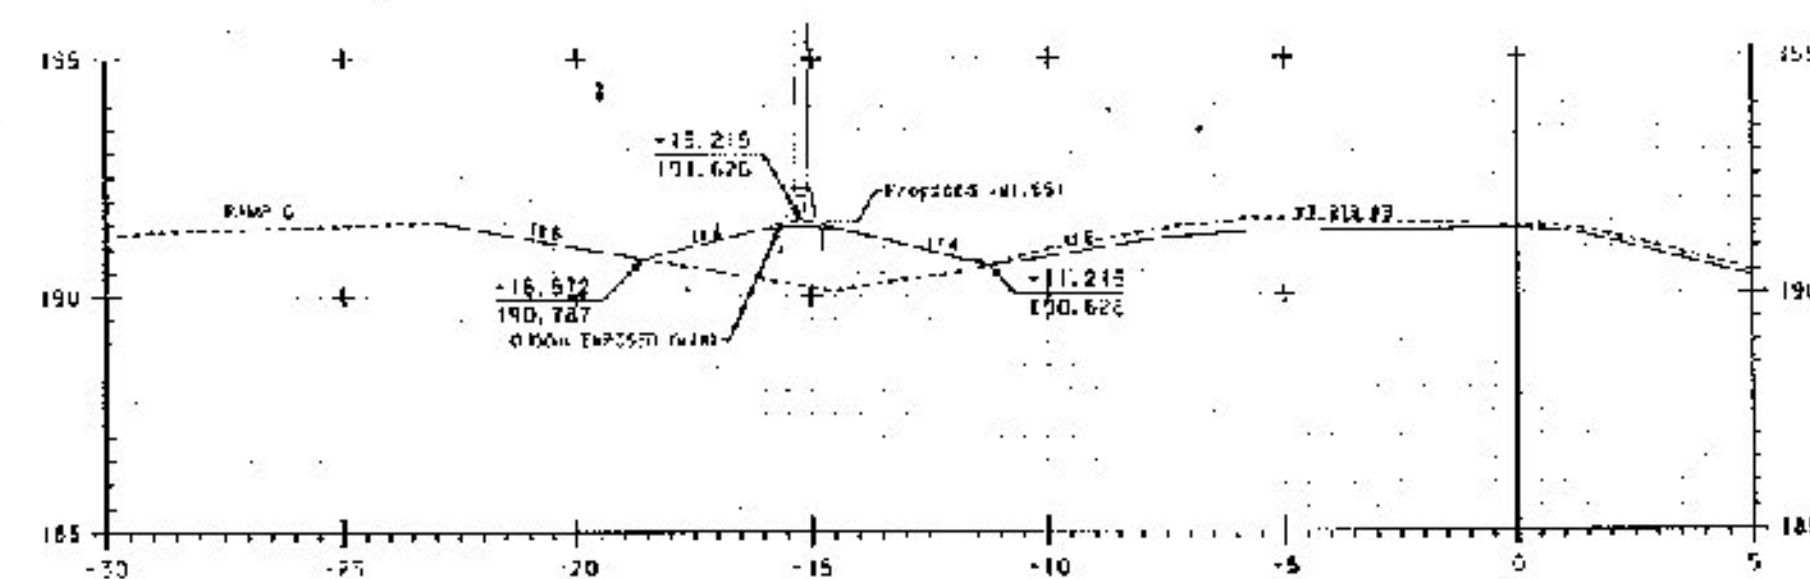


SL-112 (WB 10+904.9)

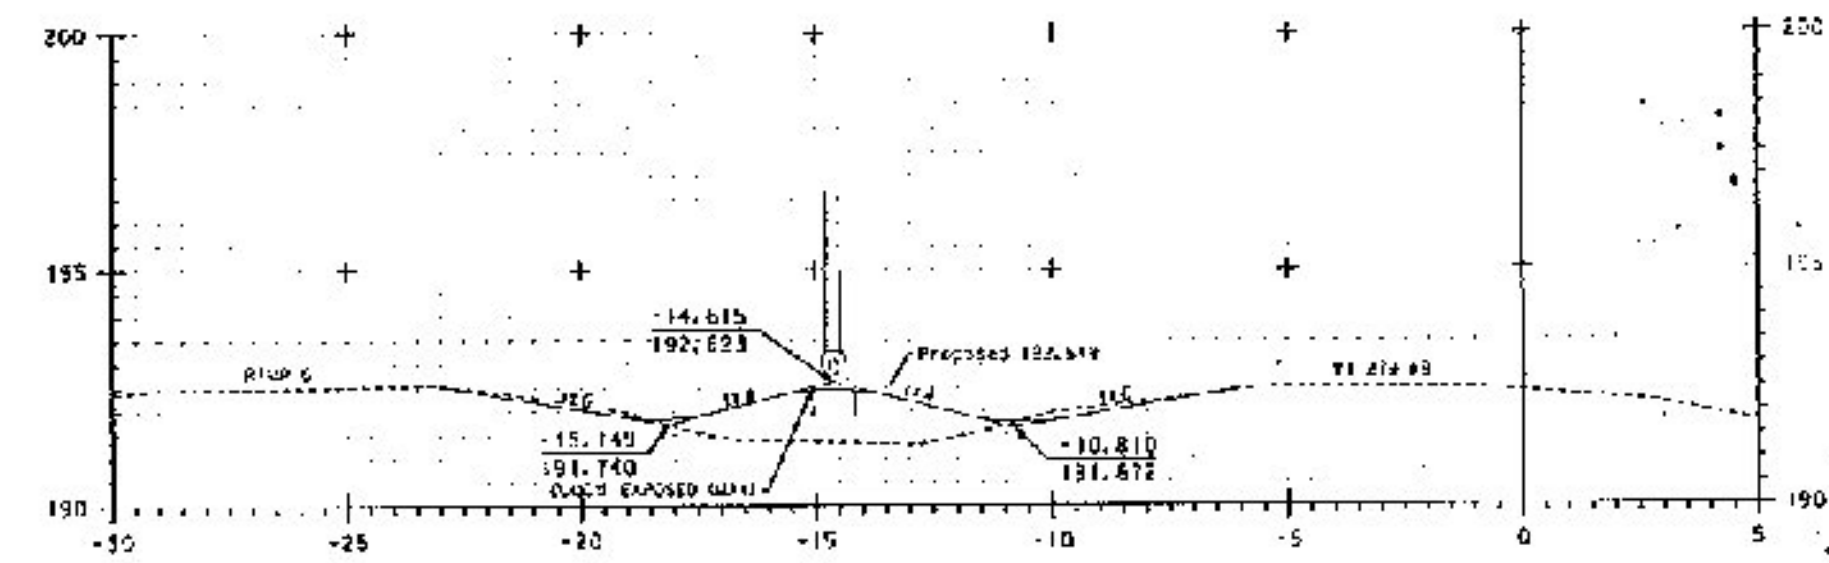

SL-113 (WB 10+965.4)

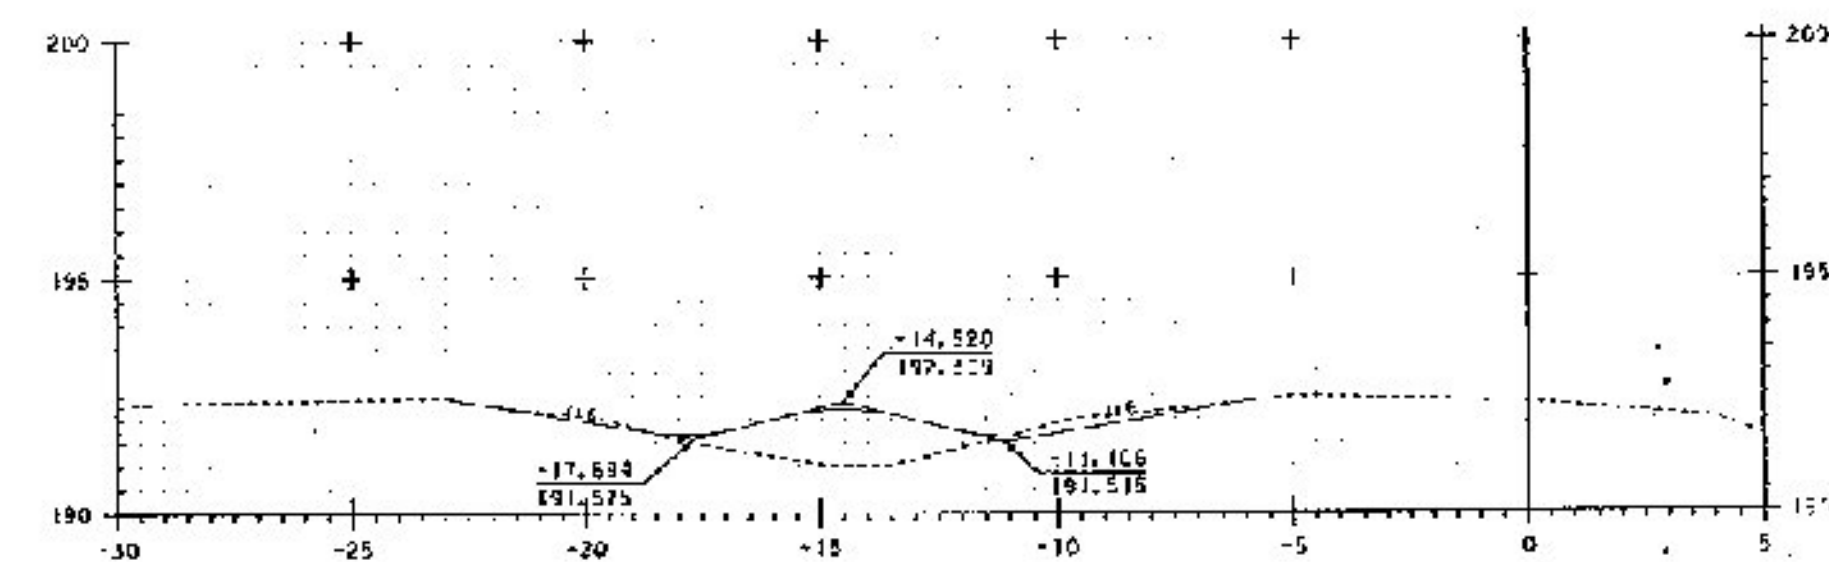

WB 10+960

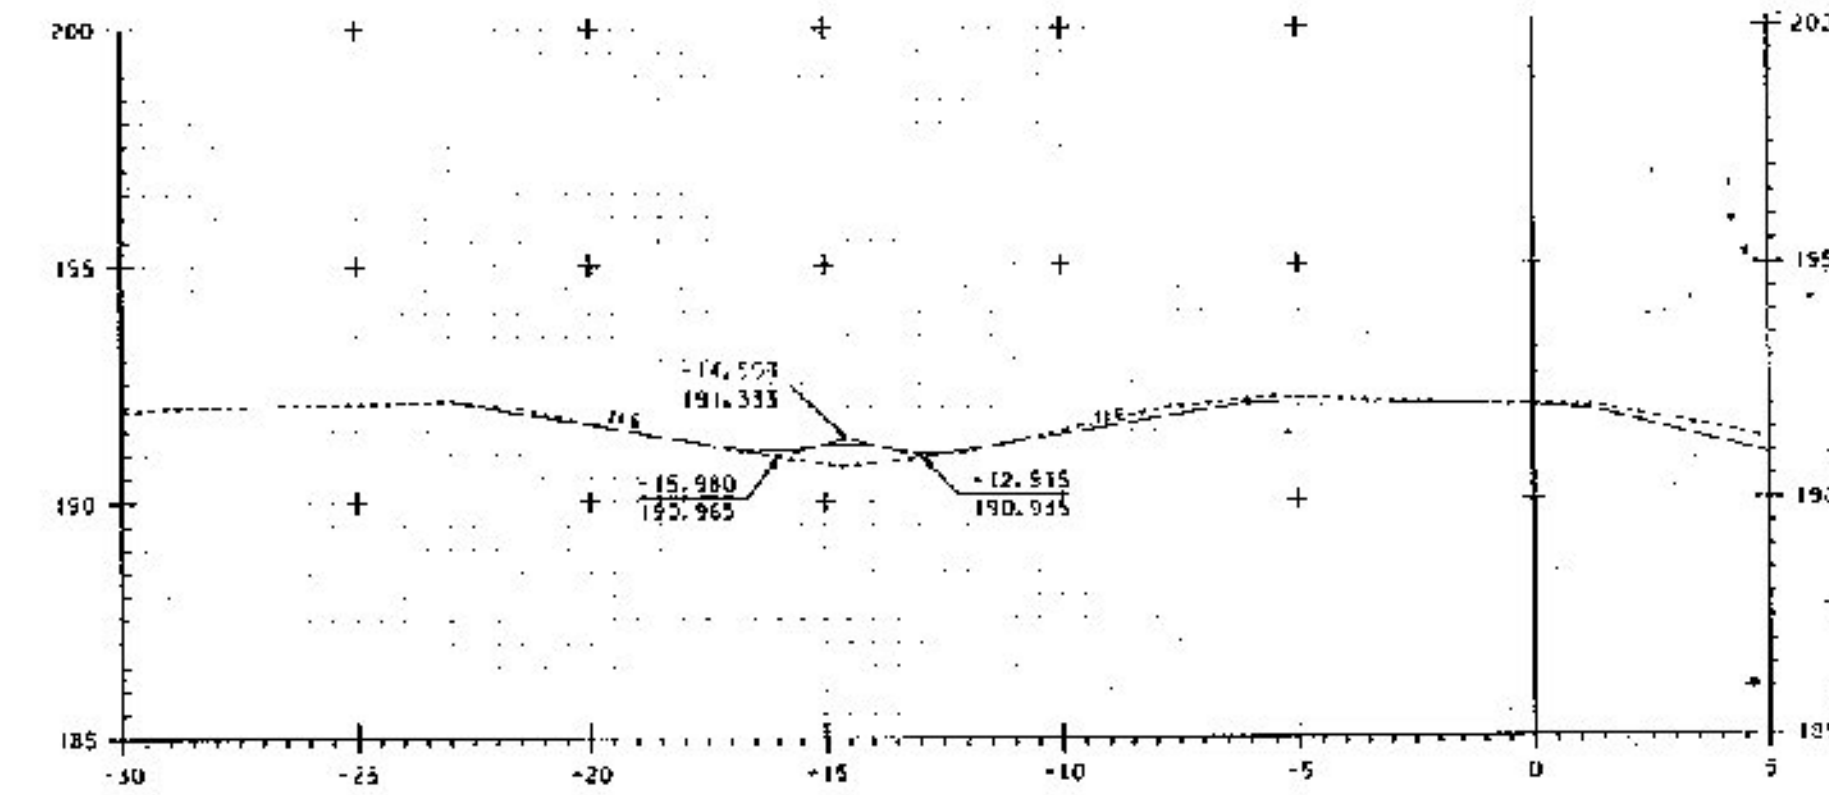

WB 10+940

LIGHT POLE
RECORD PLANS