
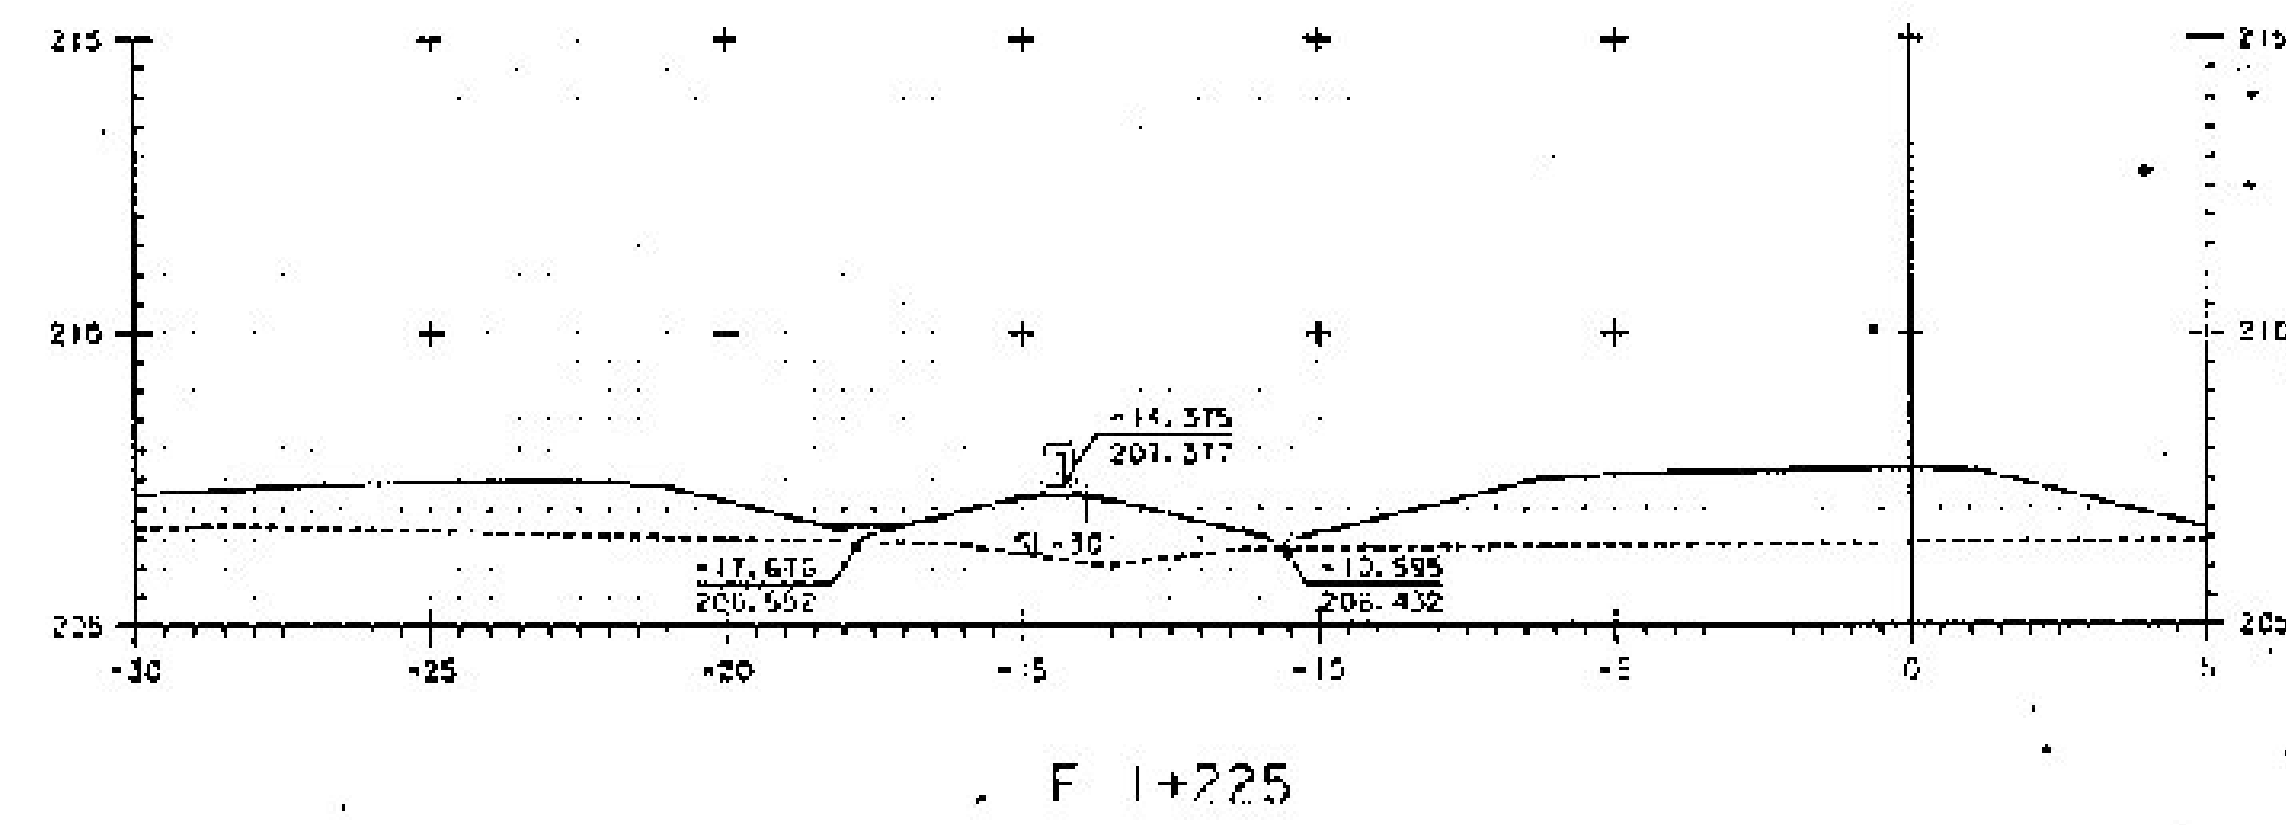
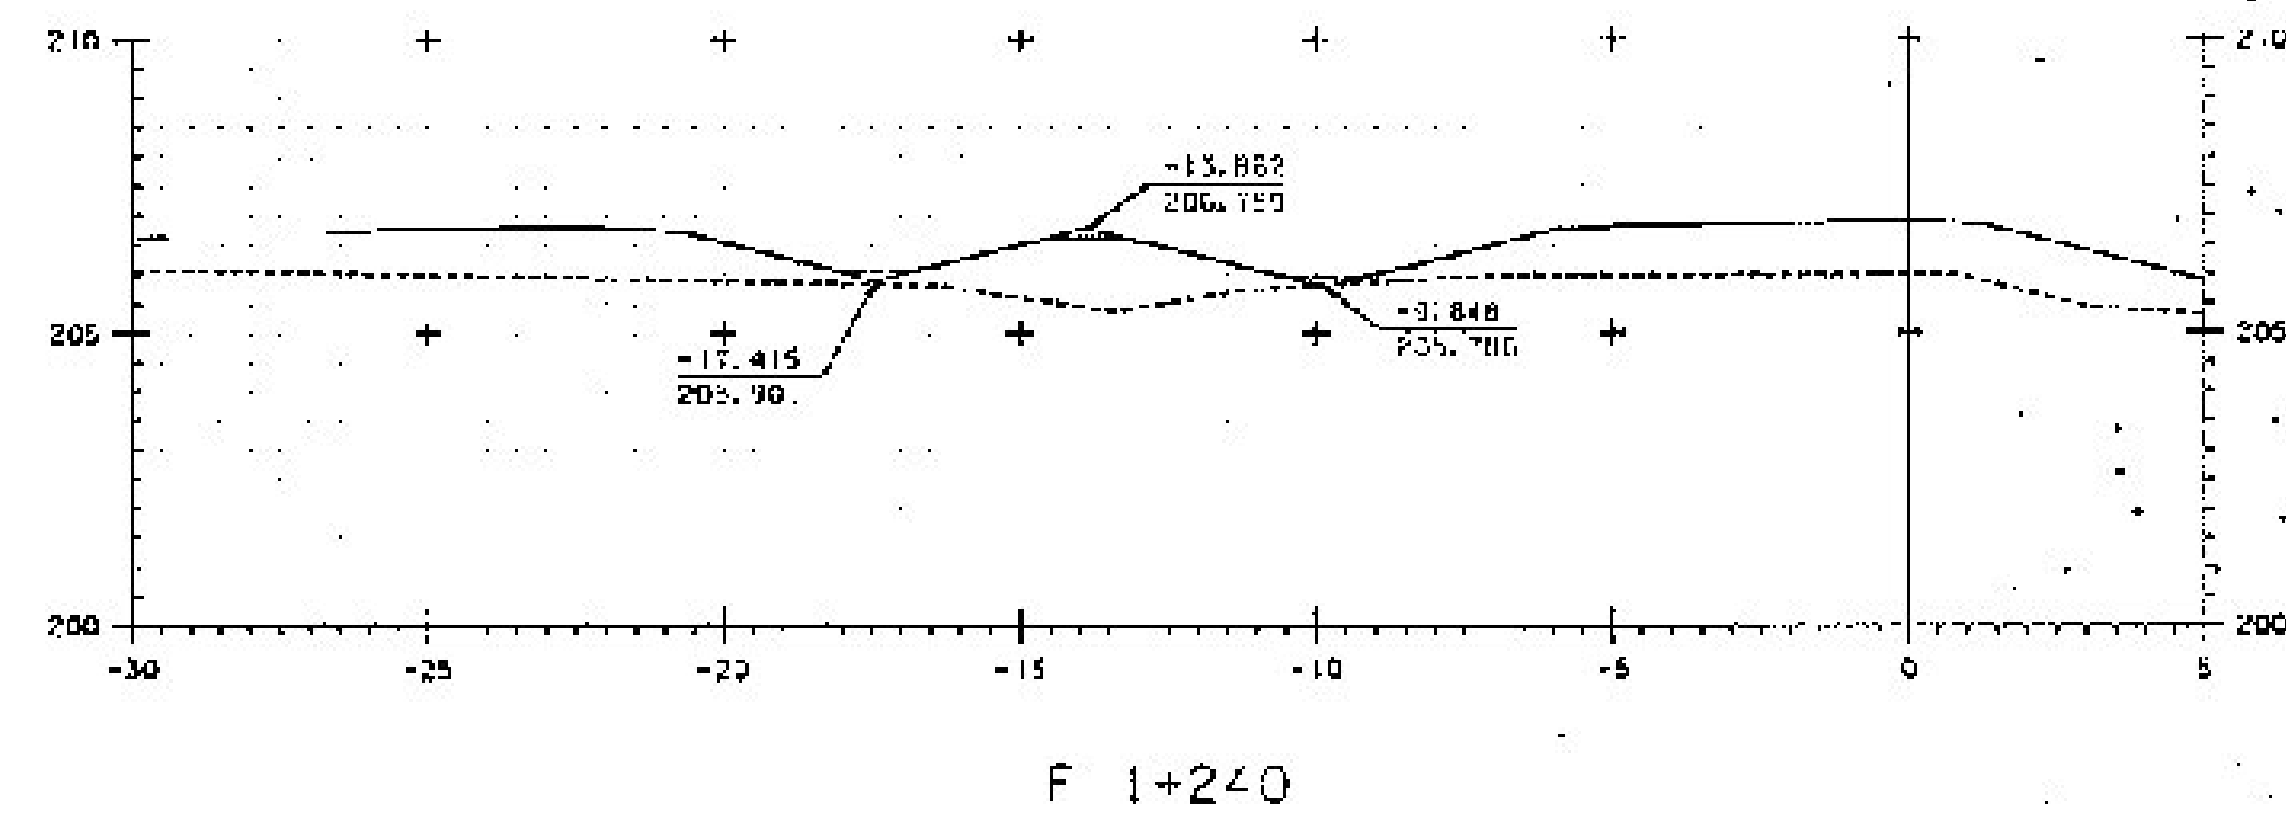
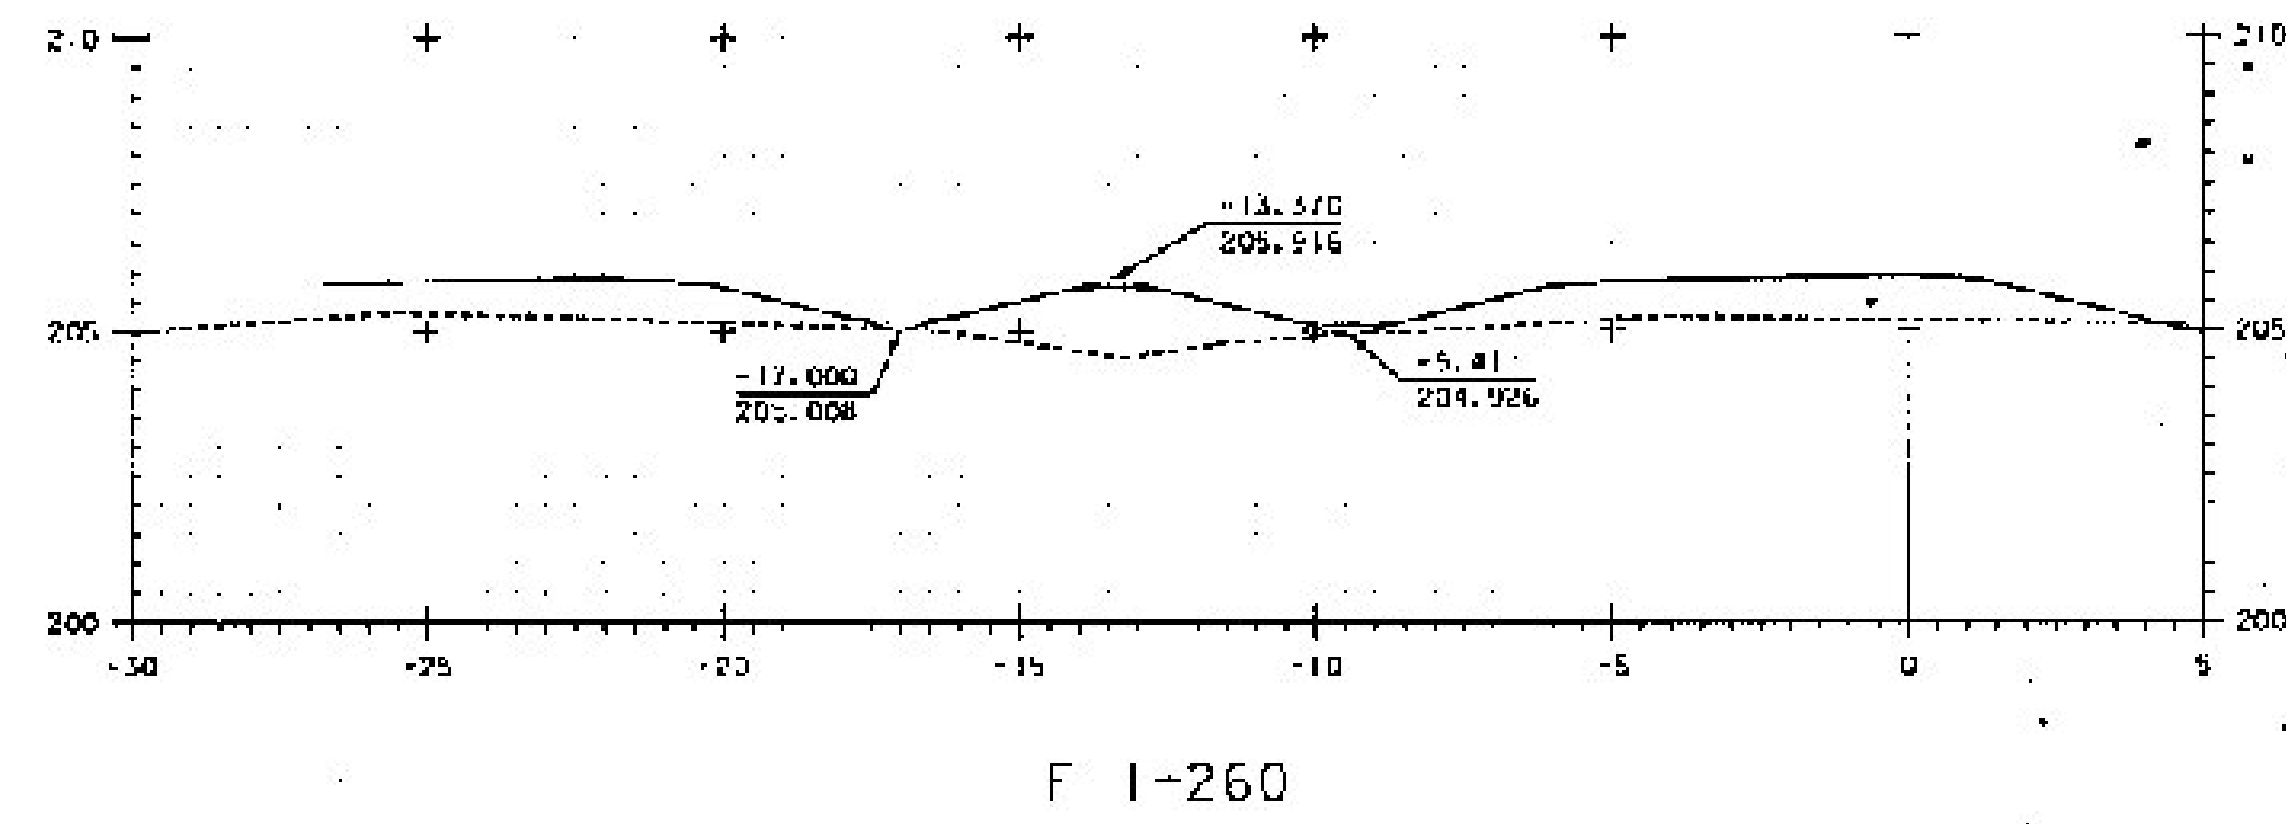
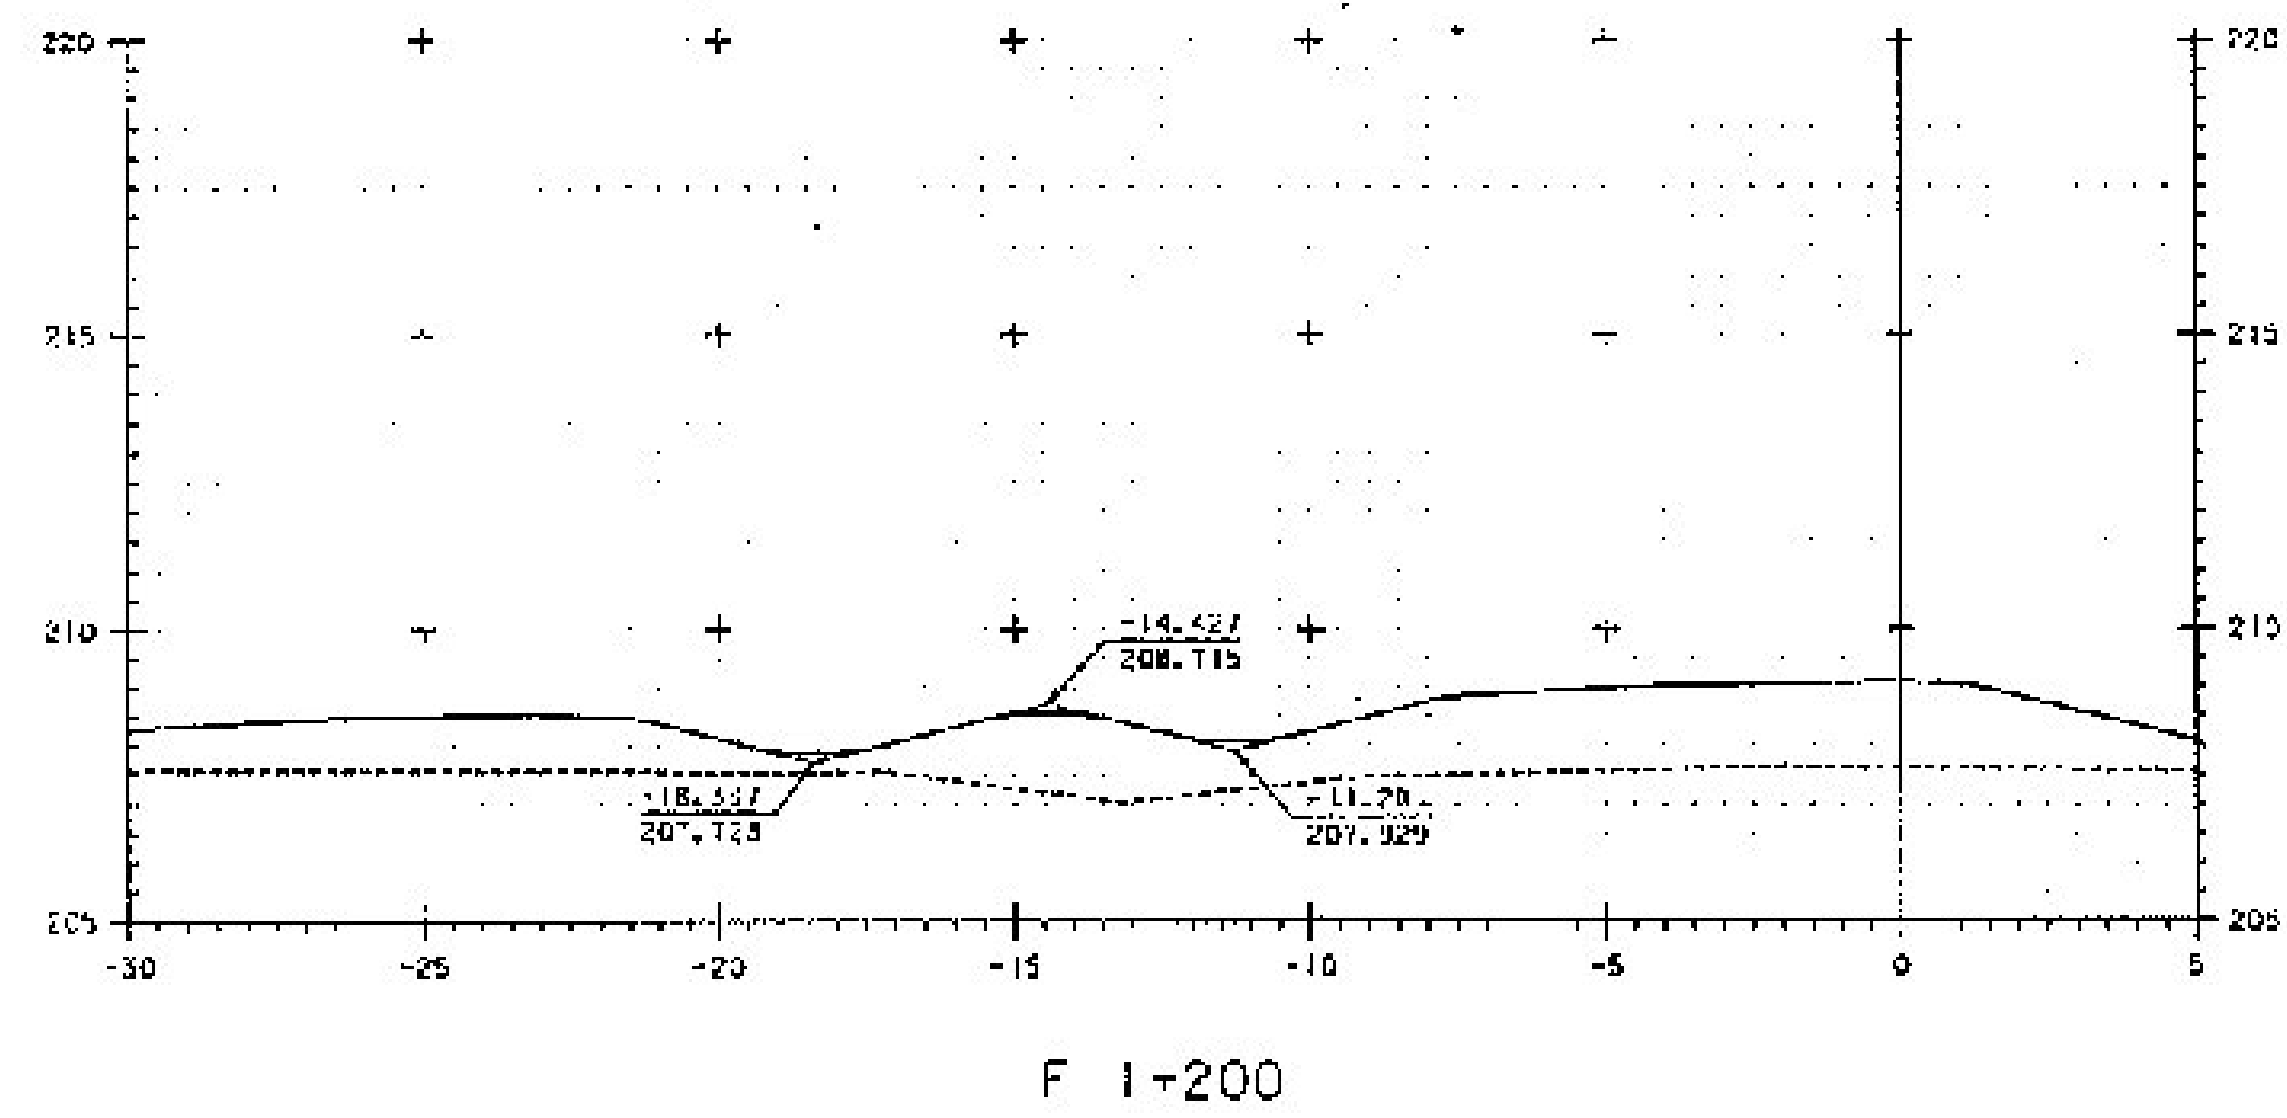


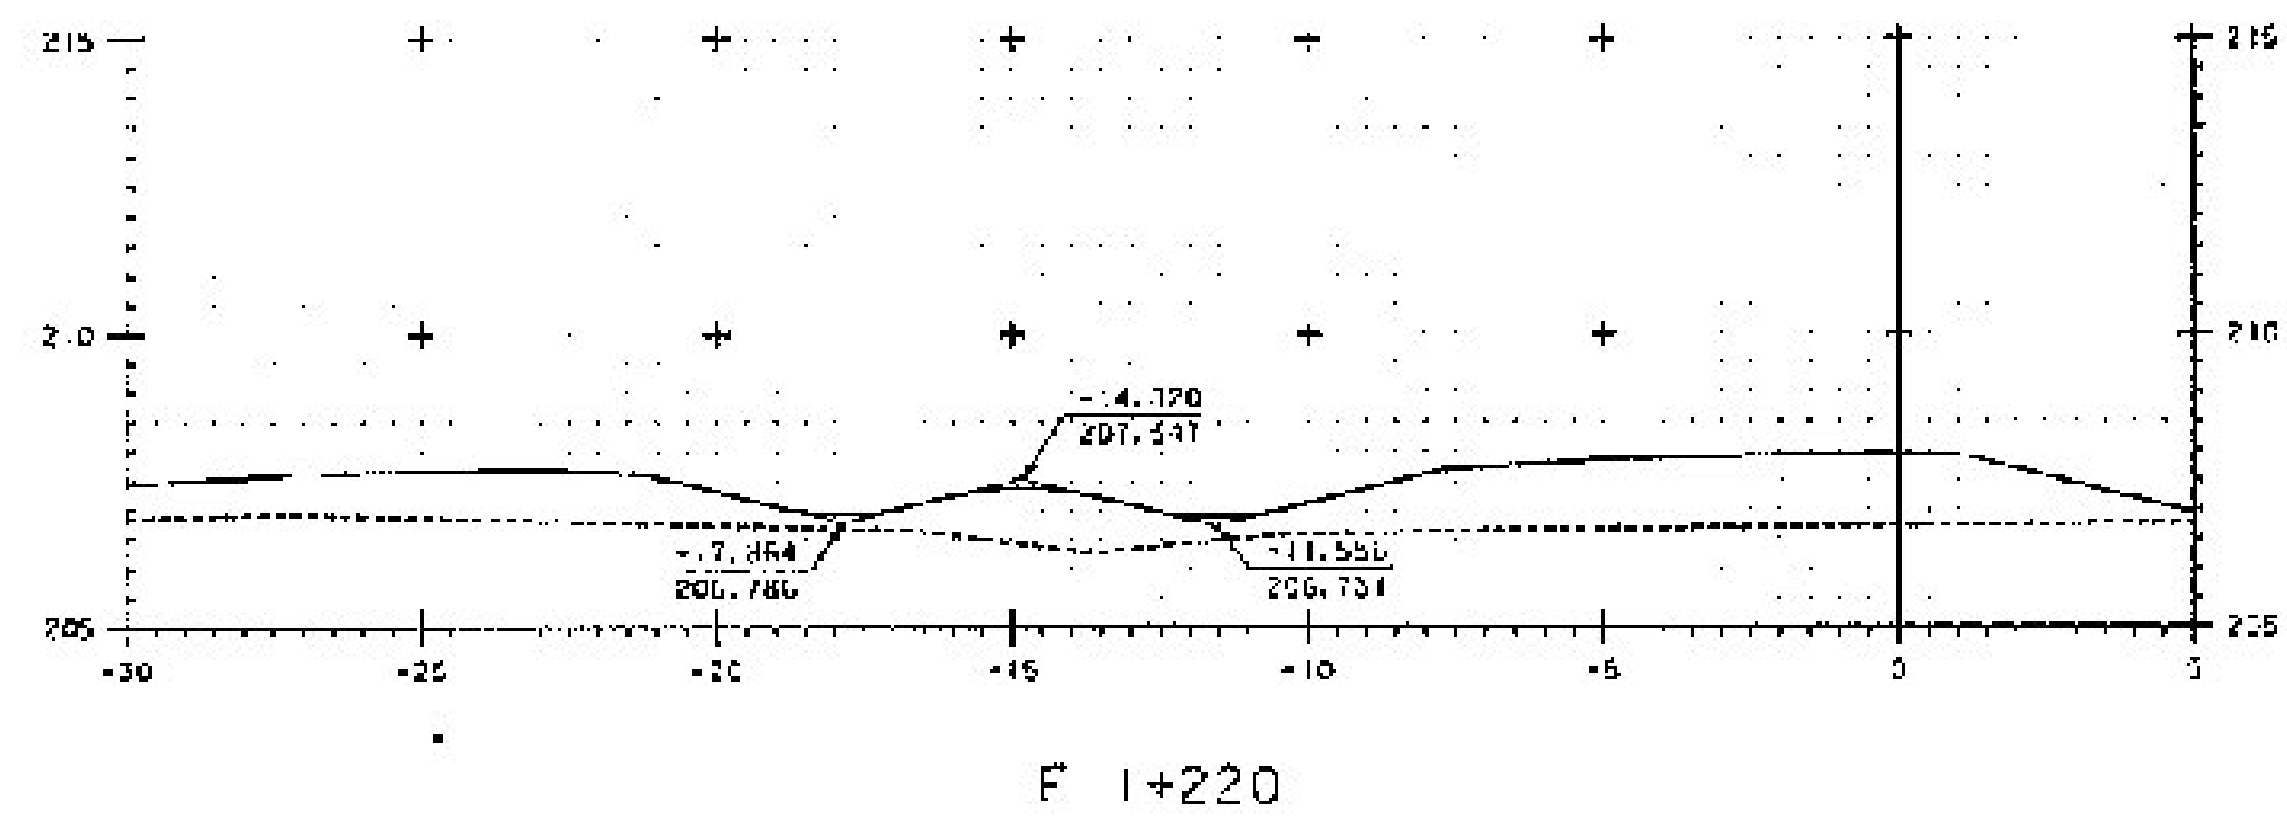

LIGHT POLE
RECORD PENS