
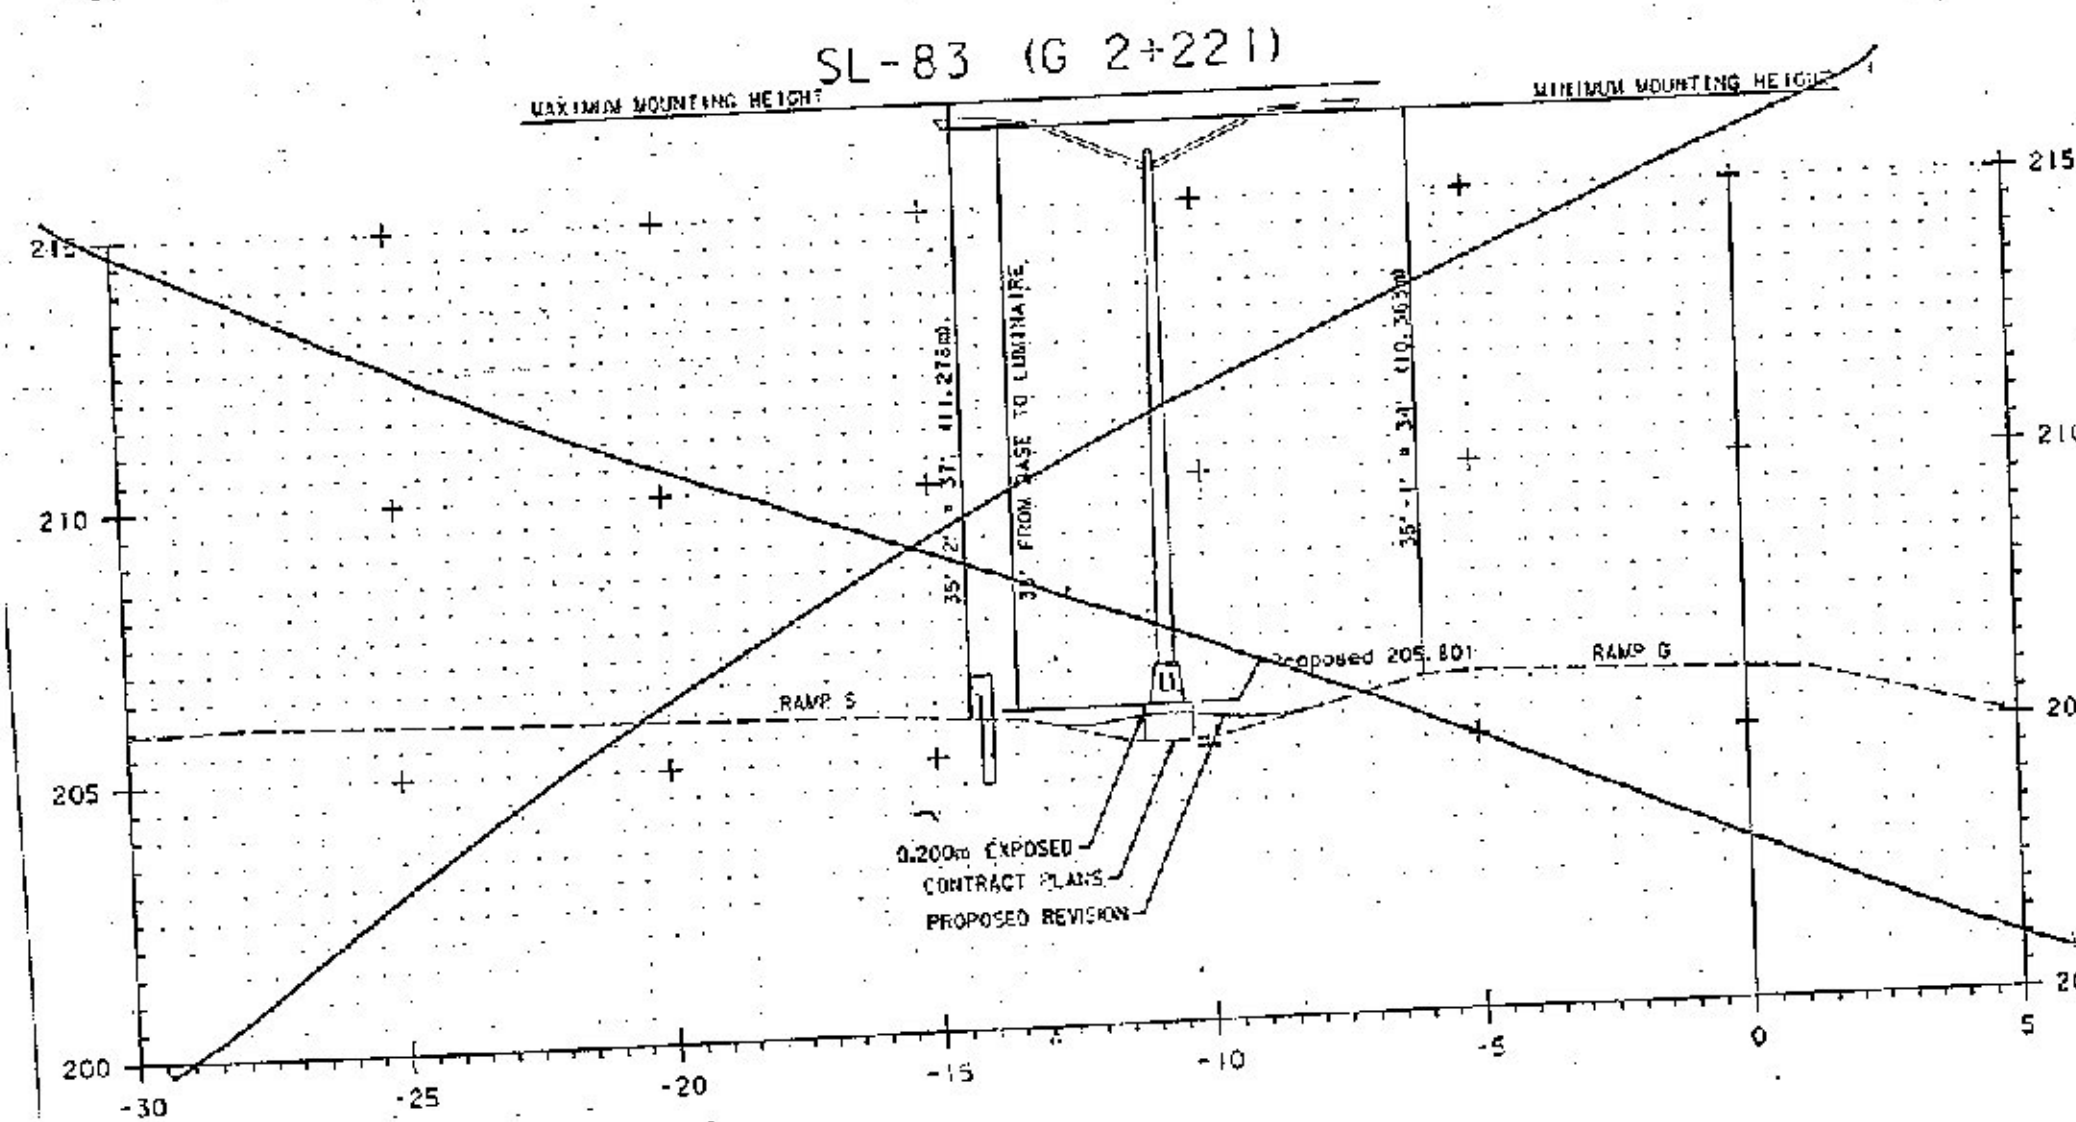



BENNINGTON (54)

#1

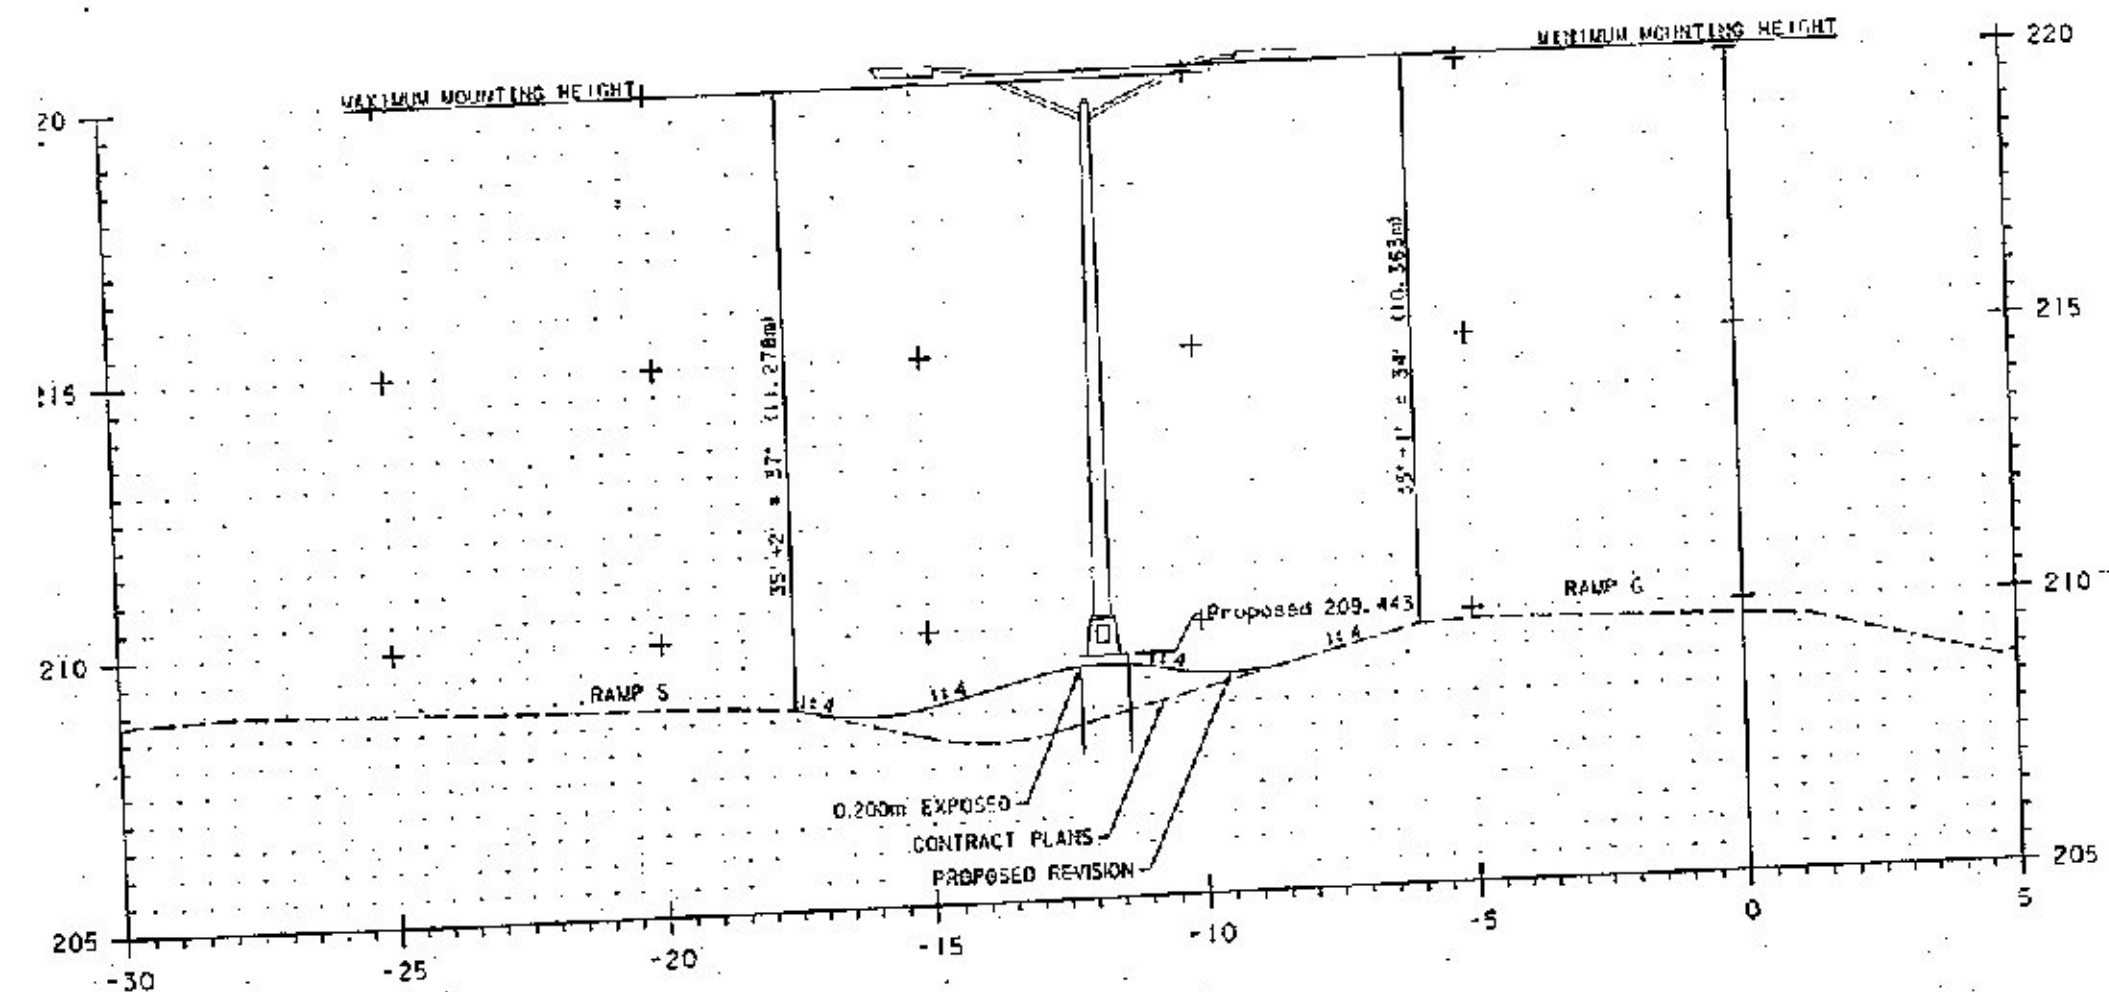

SEE
SL-82 CROSS SECTION

See Note on
Sheet 370

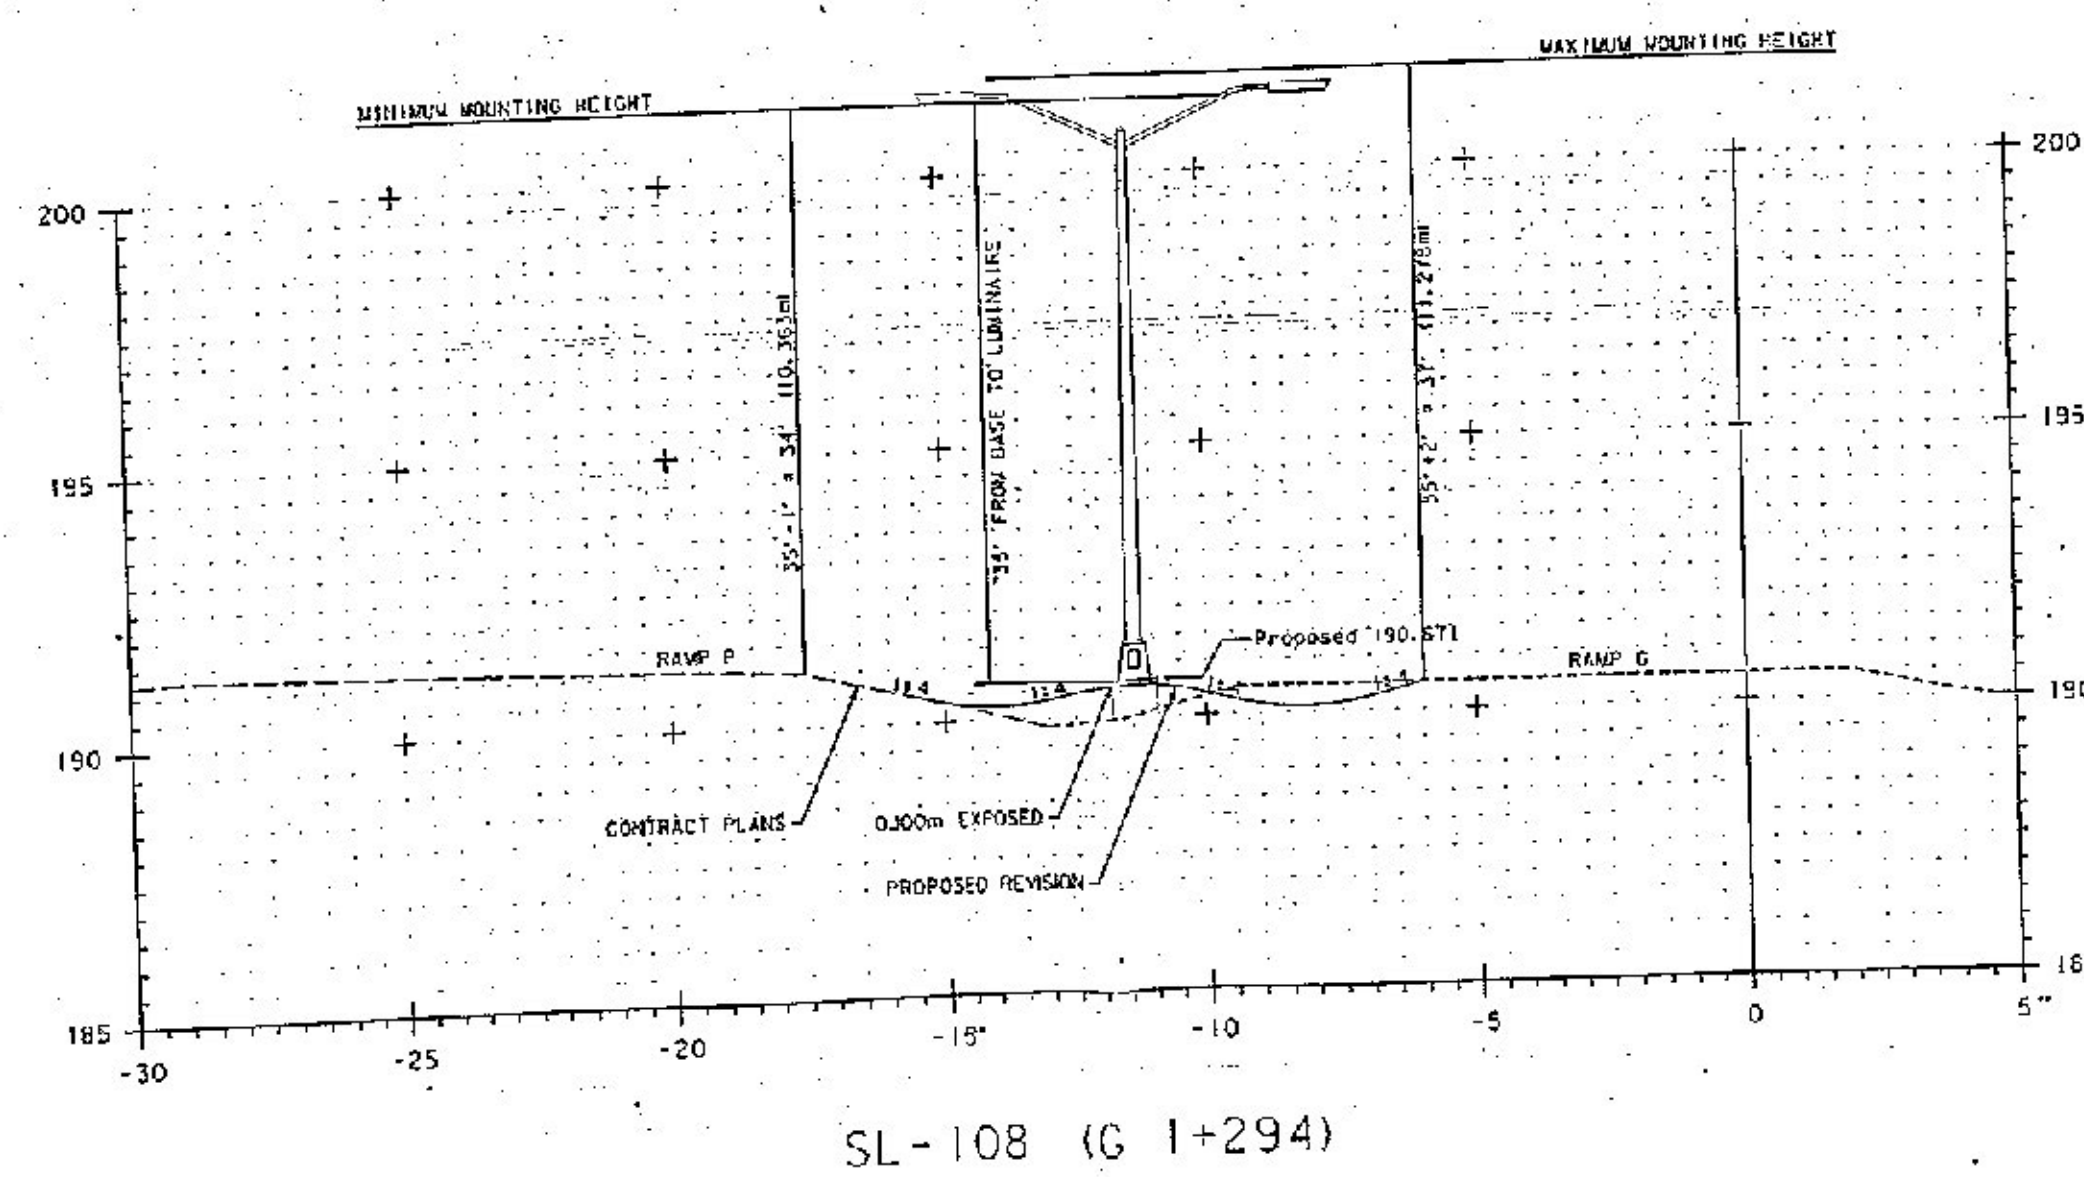

RECORD PLANS - LIGHT POLES
SL-82, SL-83, AND SL-108
CROSS SECTIONS
6/15/11