




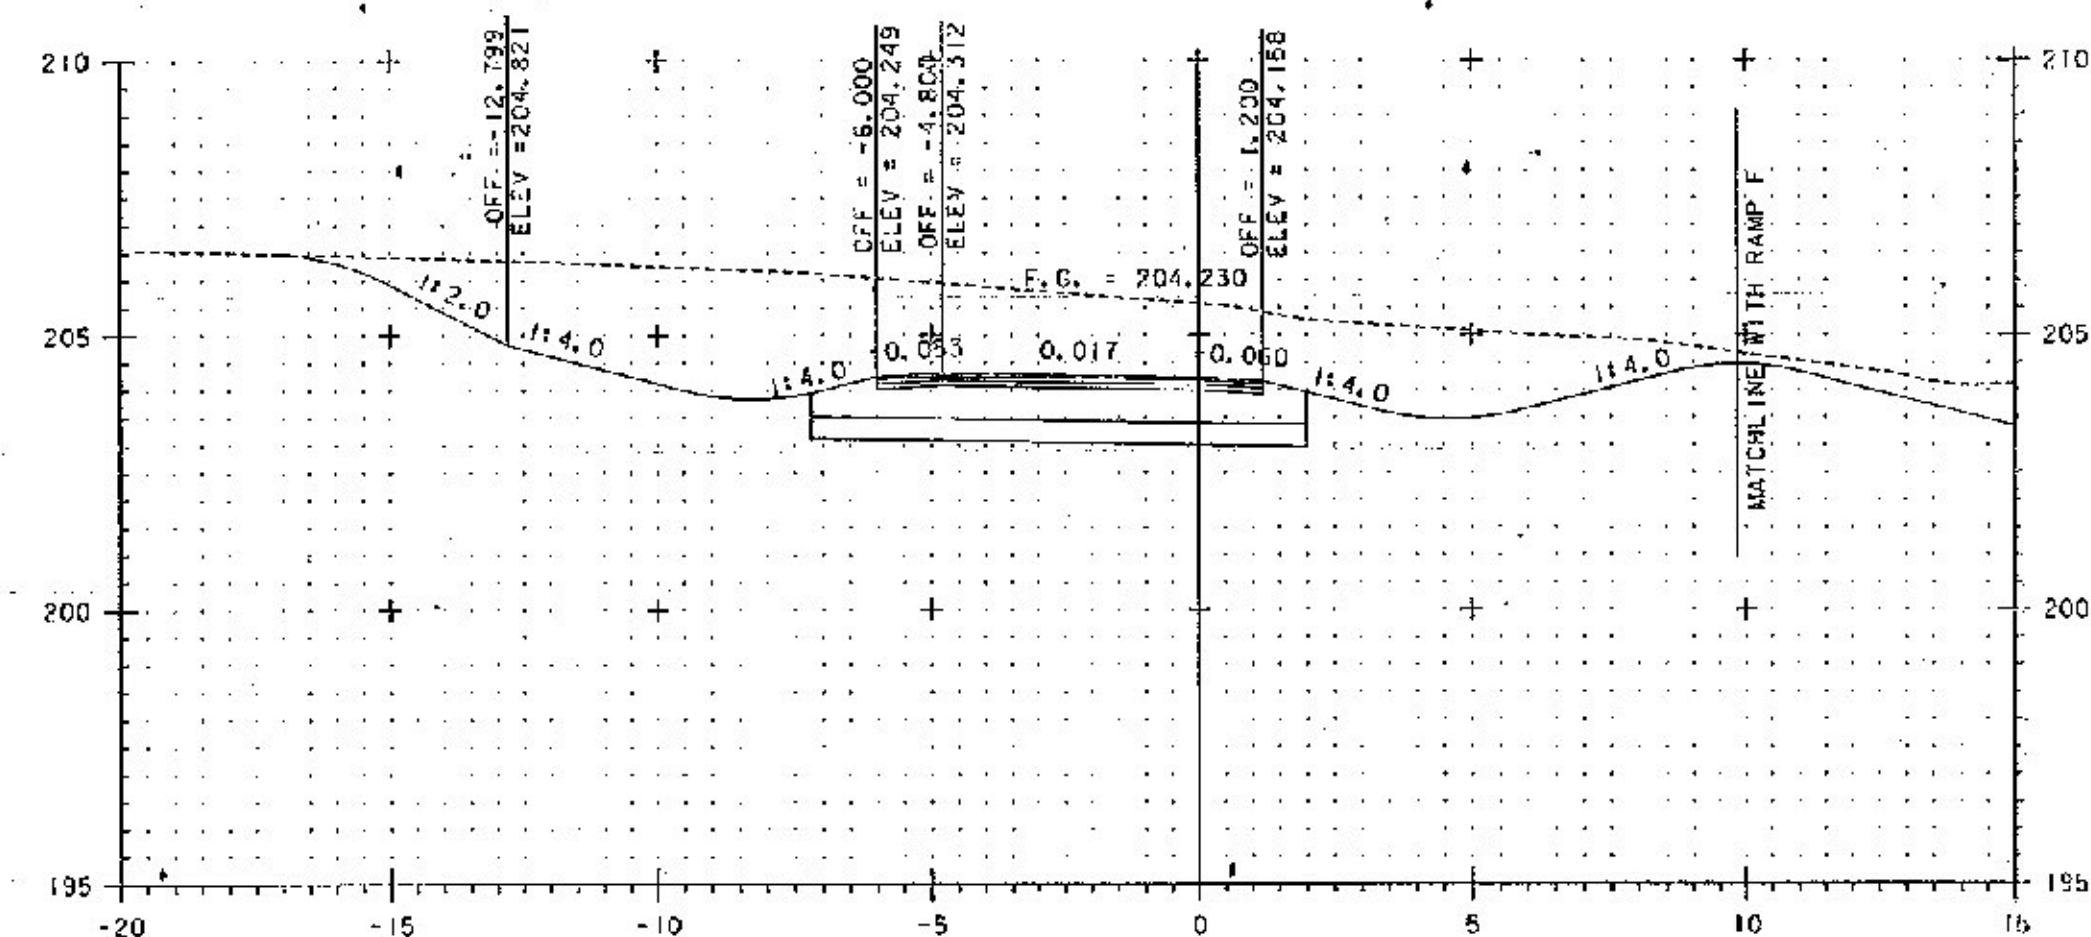


N 1+020

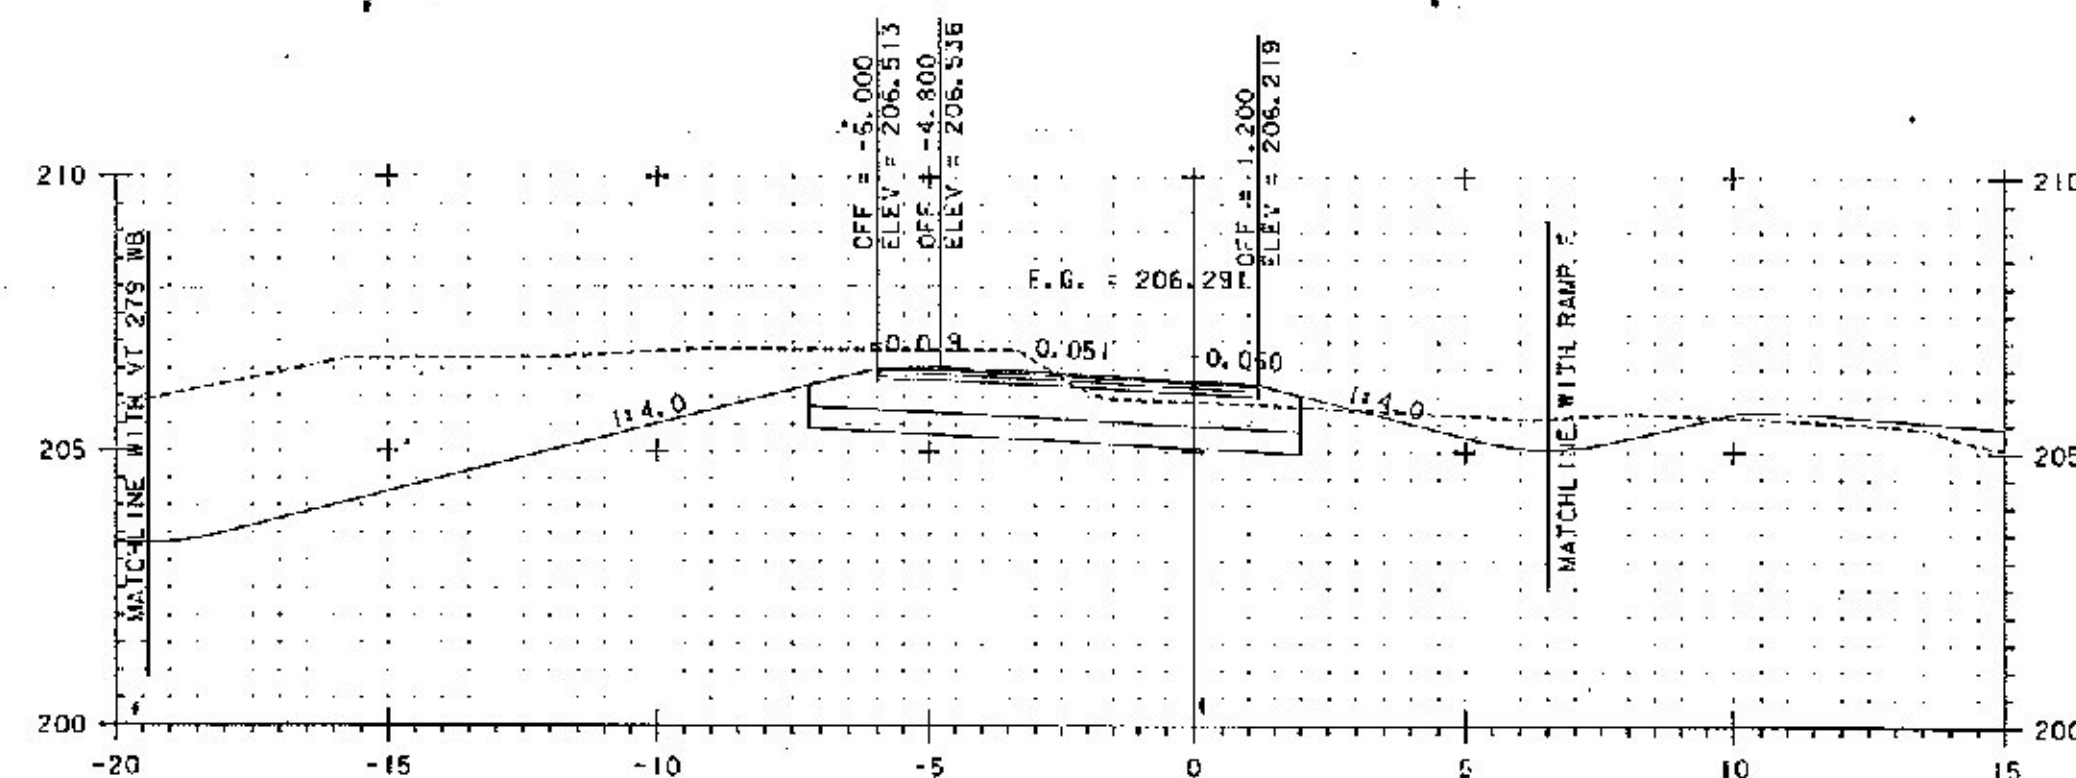

N 1+060

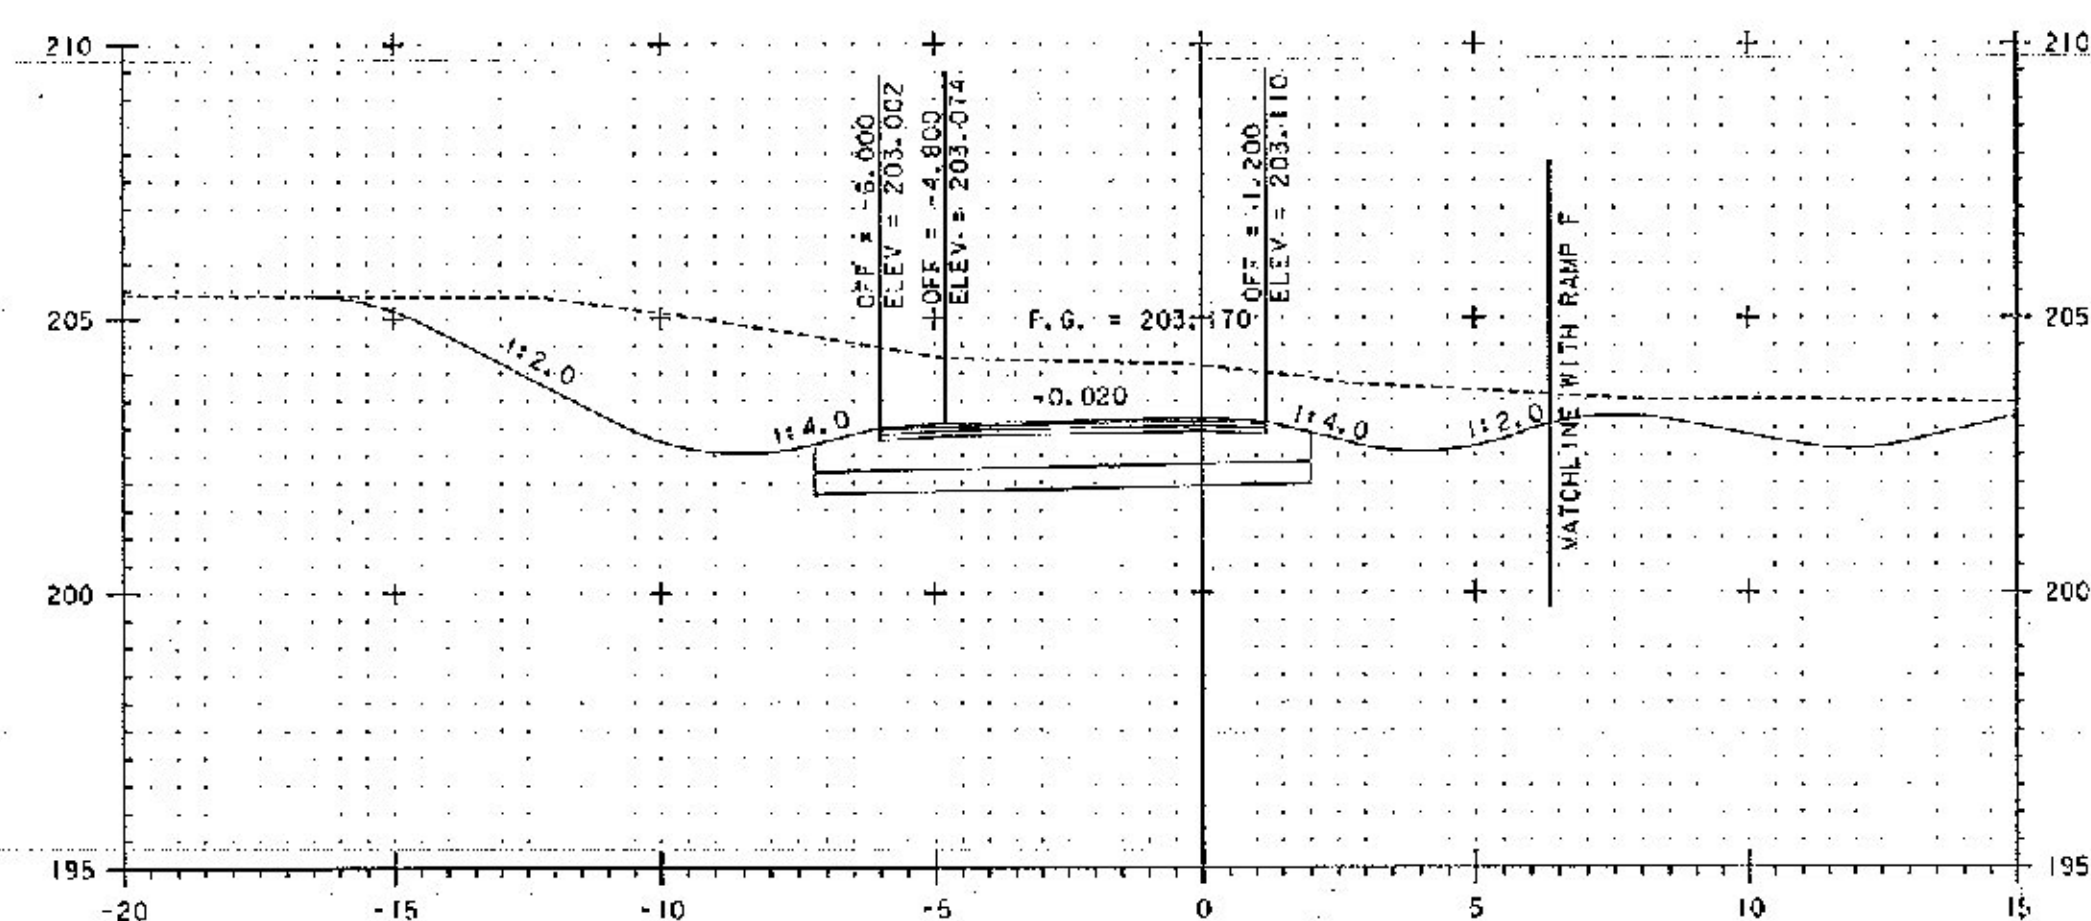


N 1+000

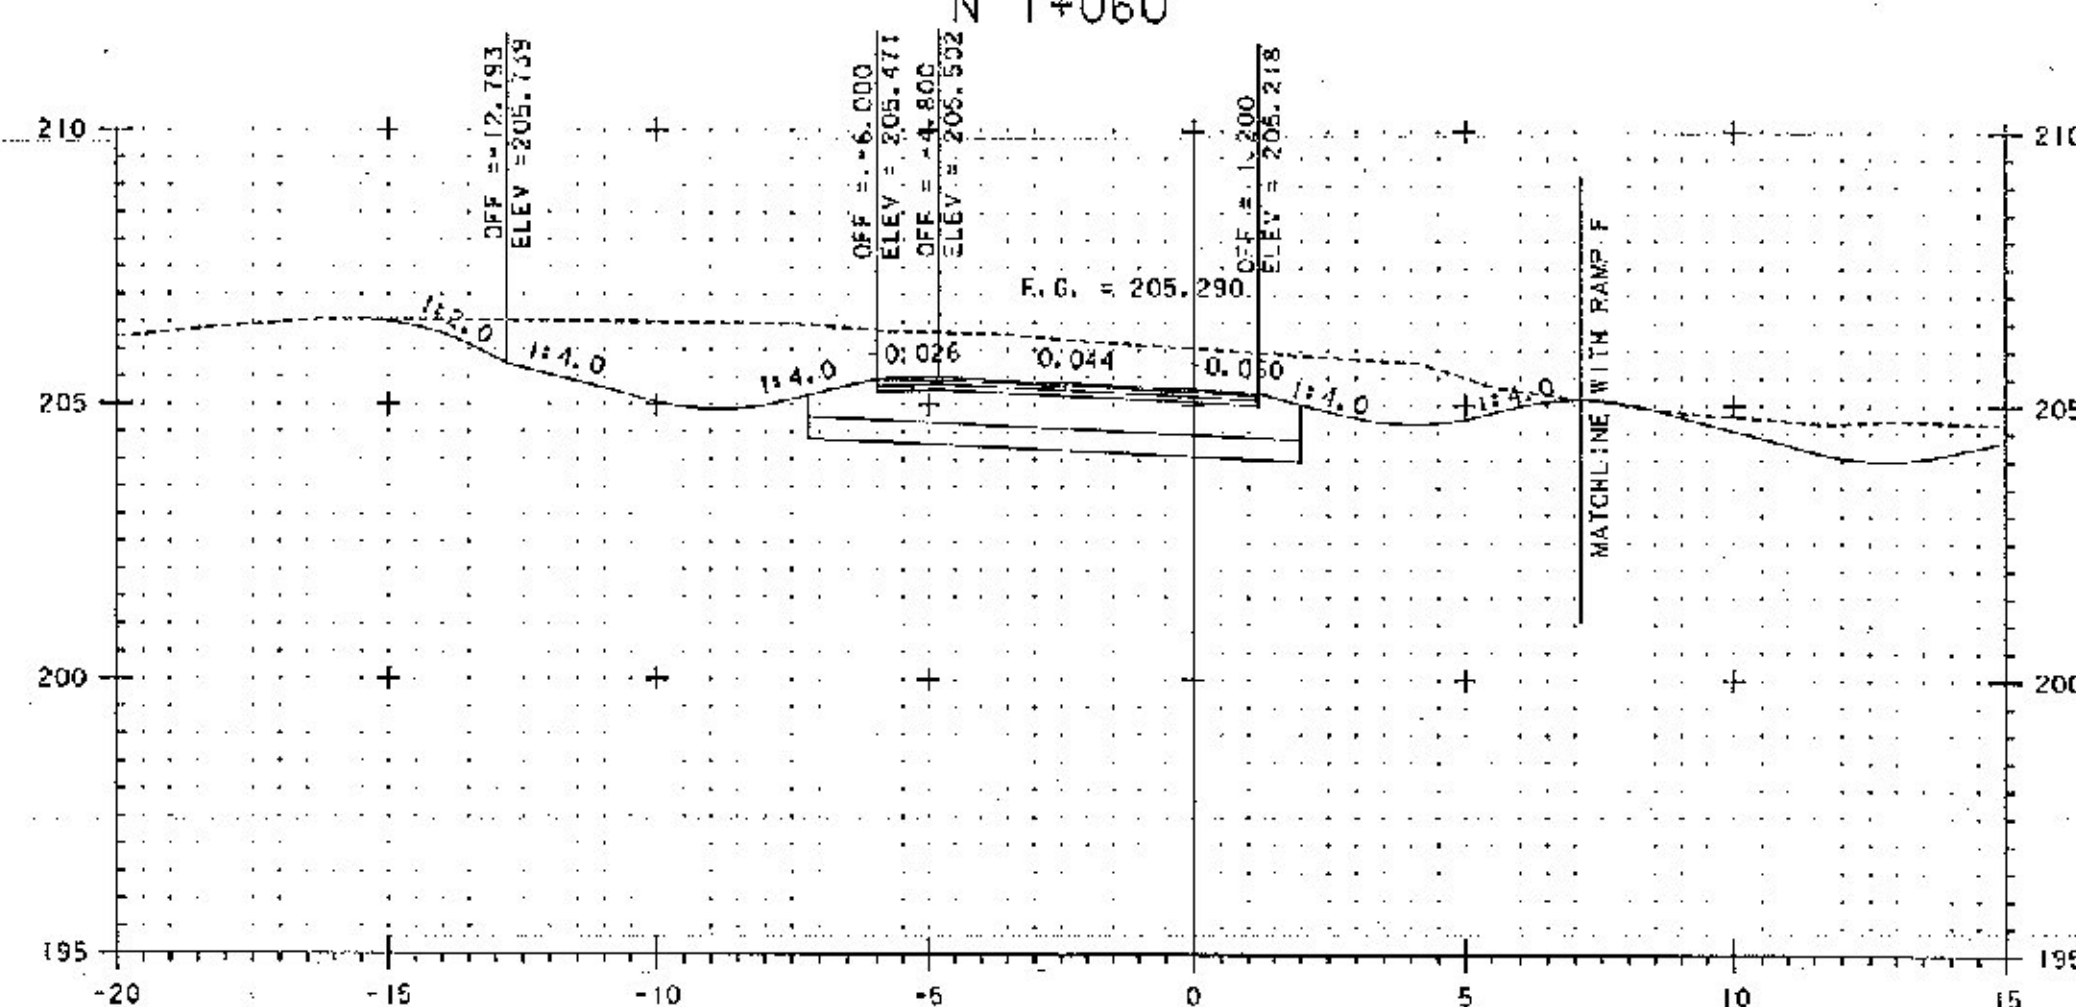

N 14040

**Note: Final Cross Sections for Ramp N
are contained in the Final Comp Books
for Item 203.15 – Common Excavation**

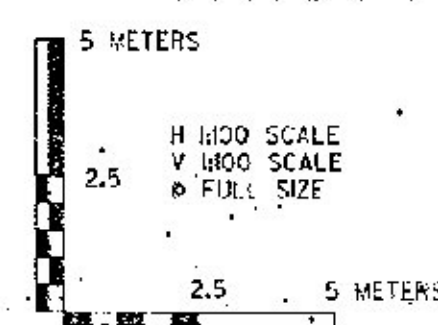

PROJECT NAME: BENNINGTON
PROJECT NUMBER: NH 019-1(54)
FILE NAME: ...z3307c4xs.pompn.ptf
DESIGN SUPERVISOR: GREG EDWARDS
DESIGNED BY: MARC FOISY
RAMP N CROSS SECTION NXS-01

PLOT DATE: 5/27/2010
DRAWN BY: STANTEC
CHECKED BY: GARY SANTY
SHEET 325 OF