


VT ROUTE 67A

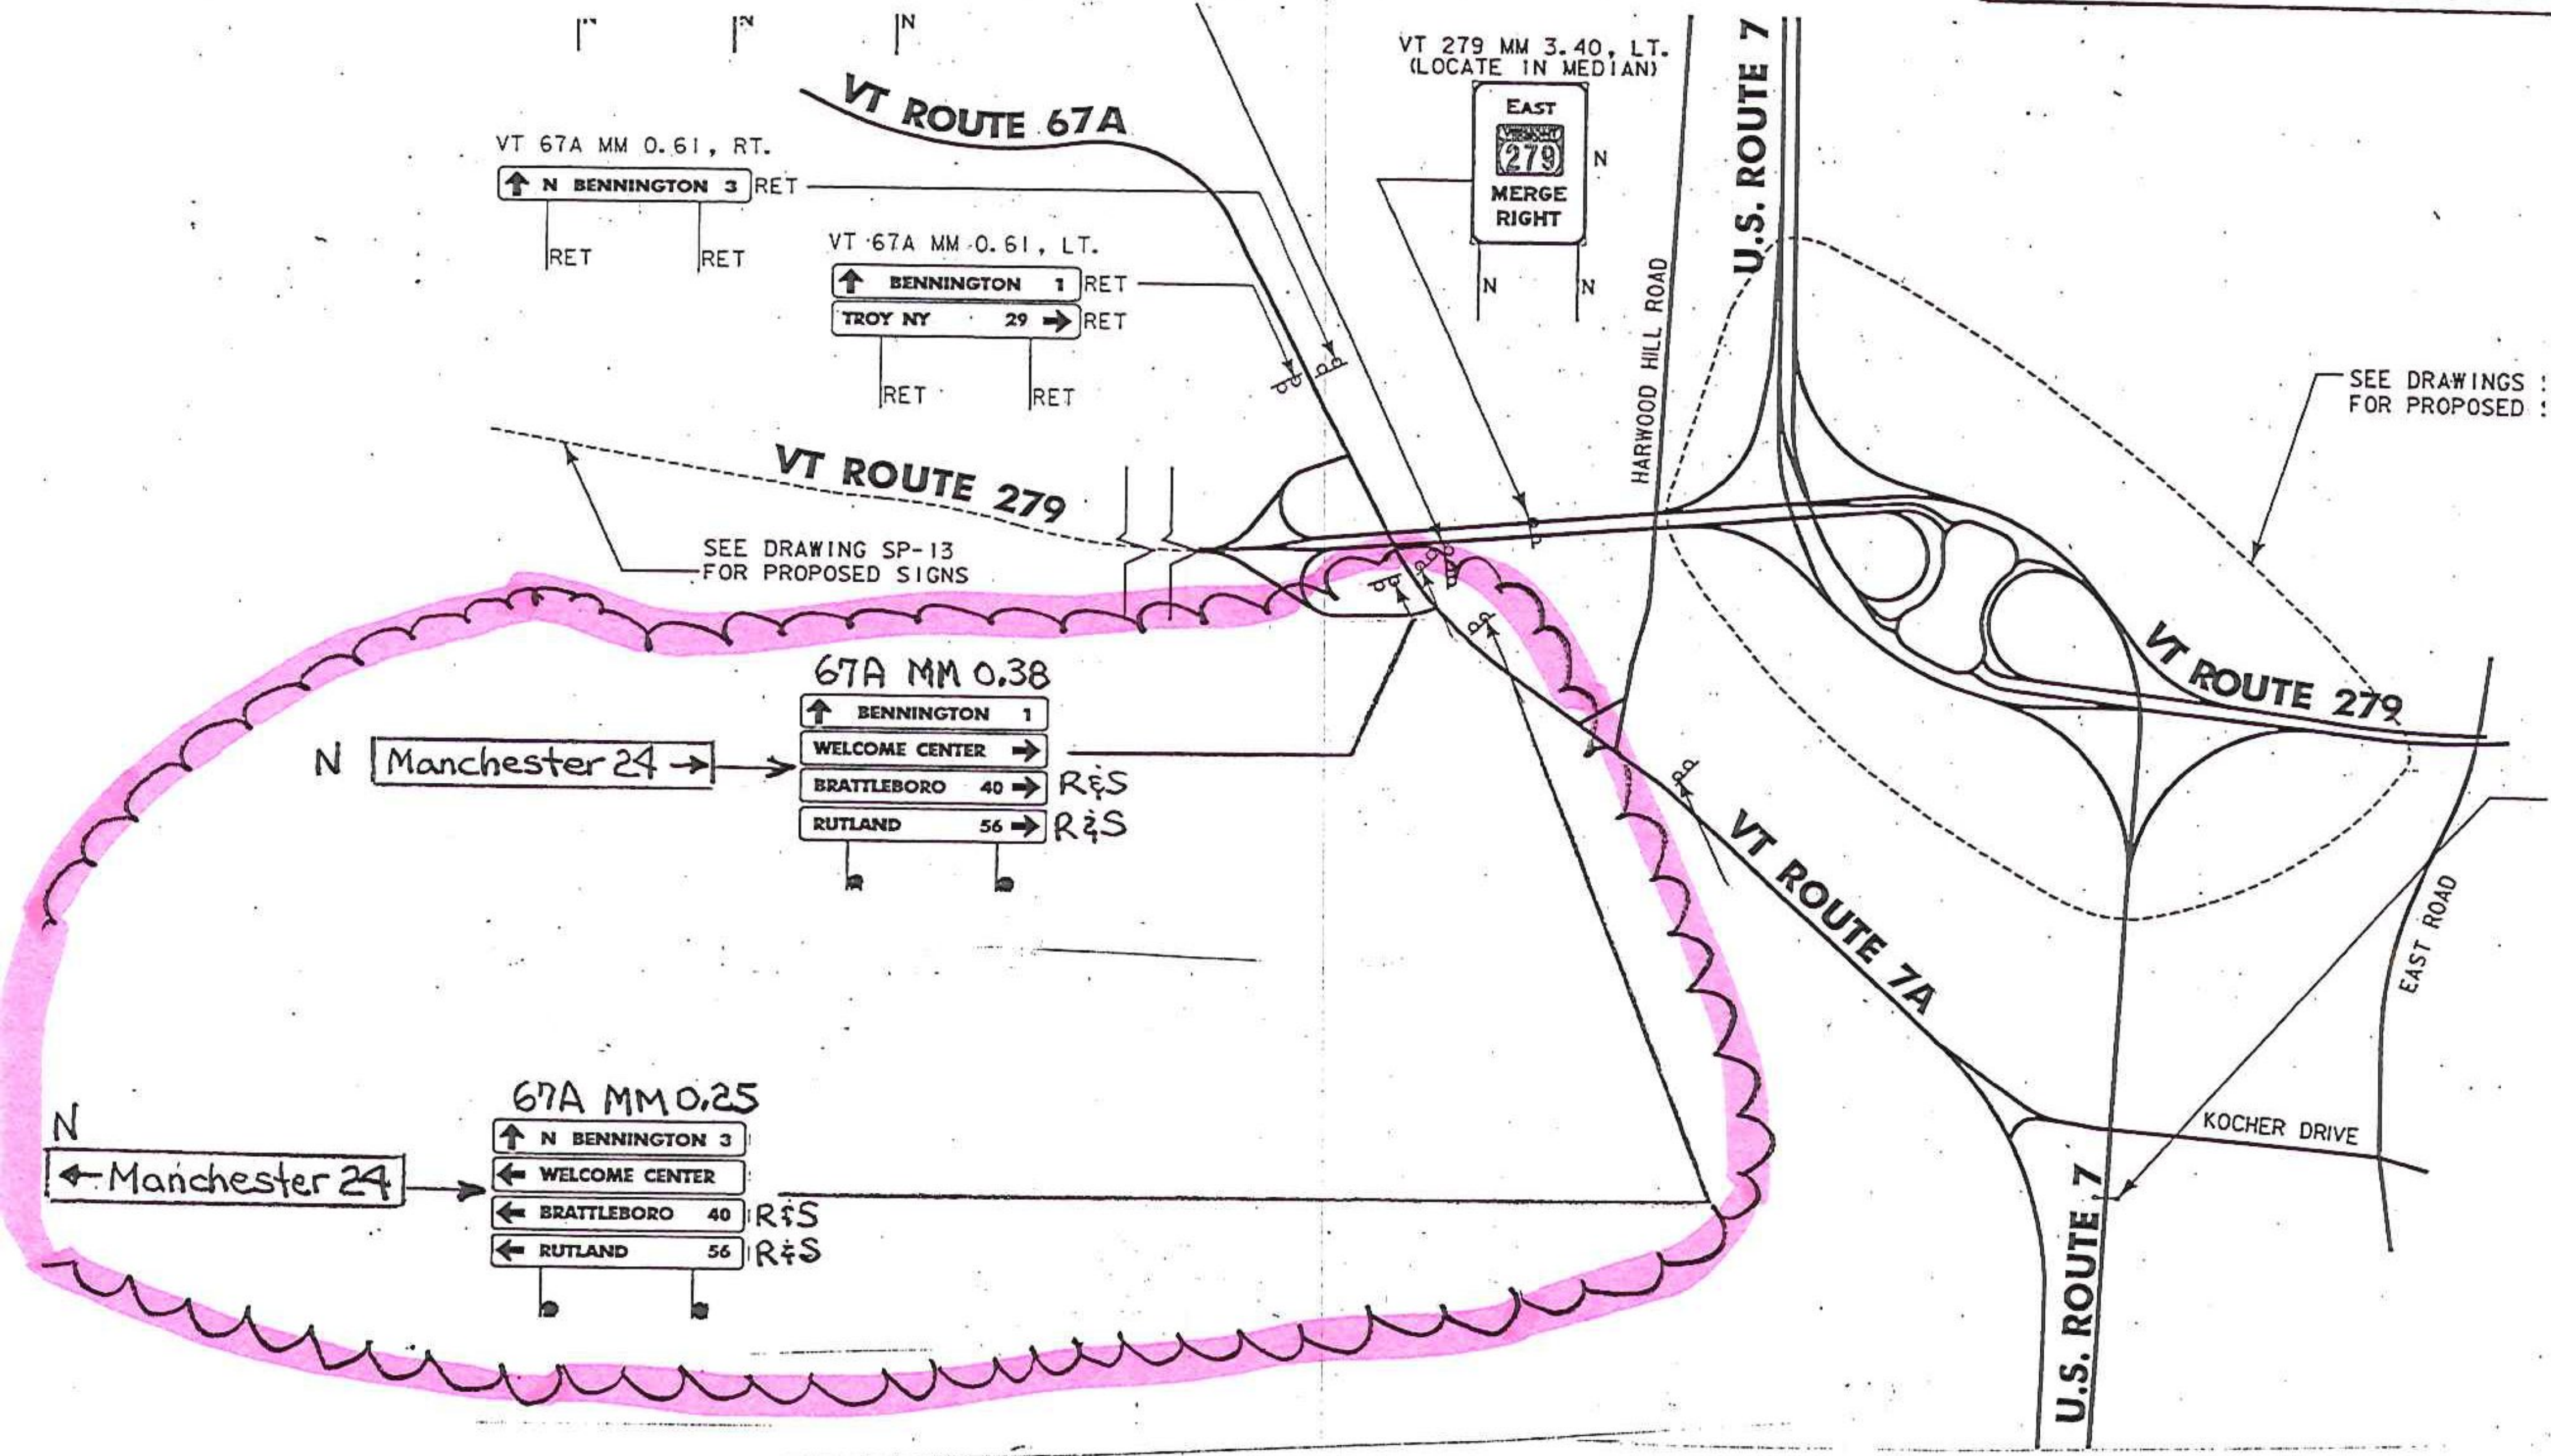

RECORD PLANS