
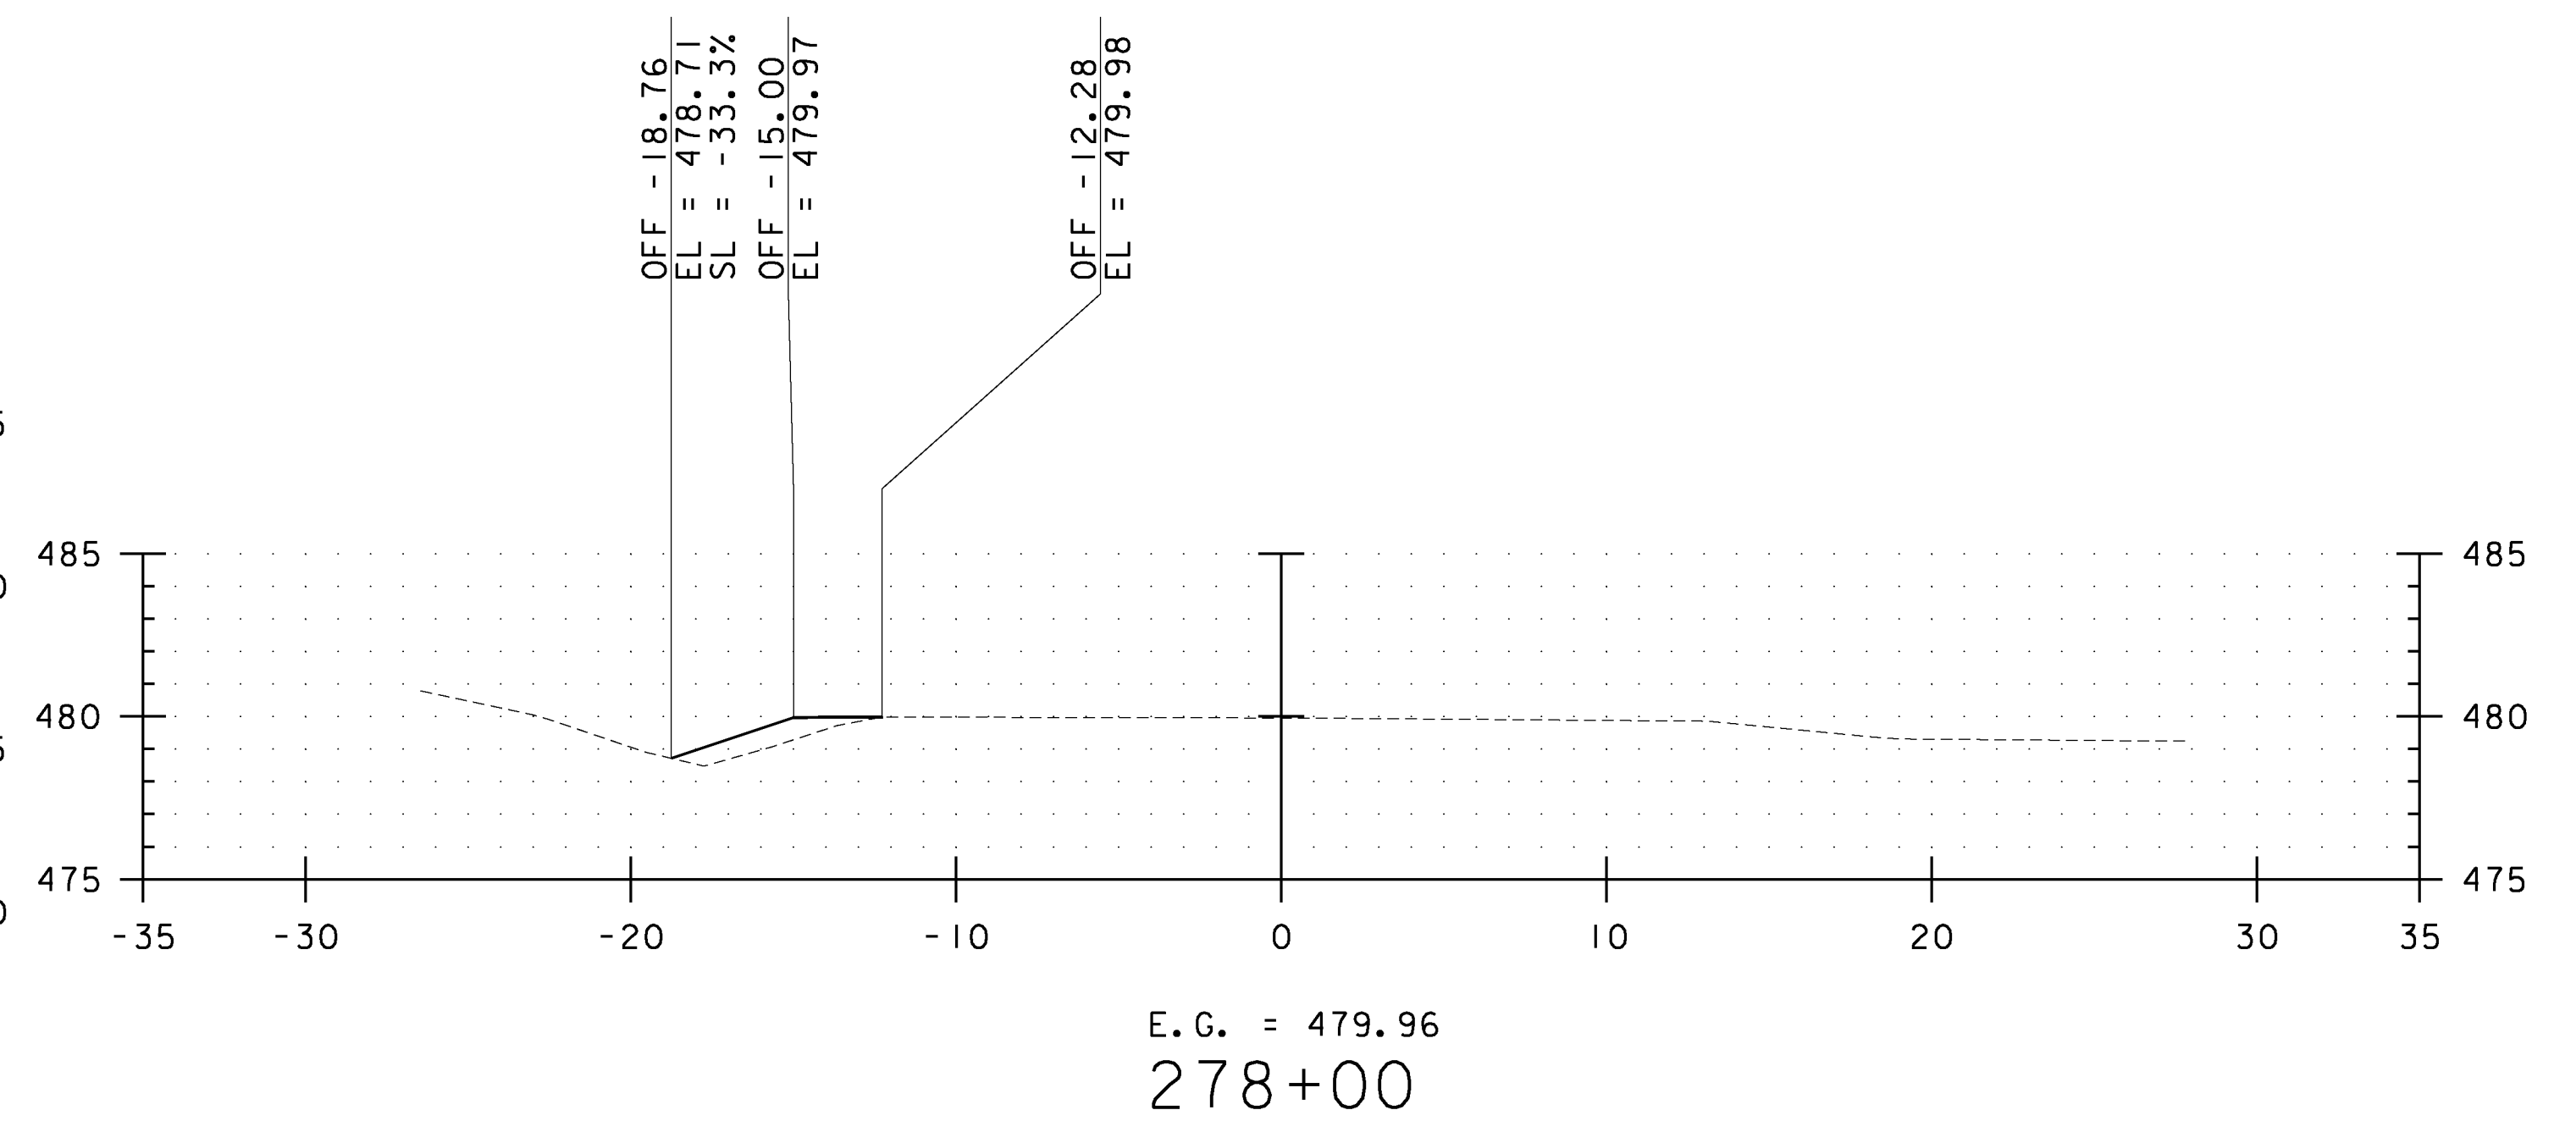


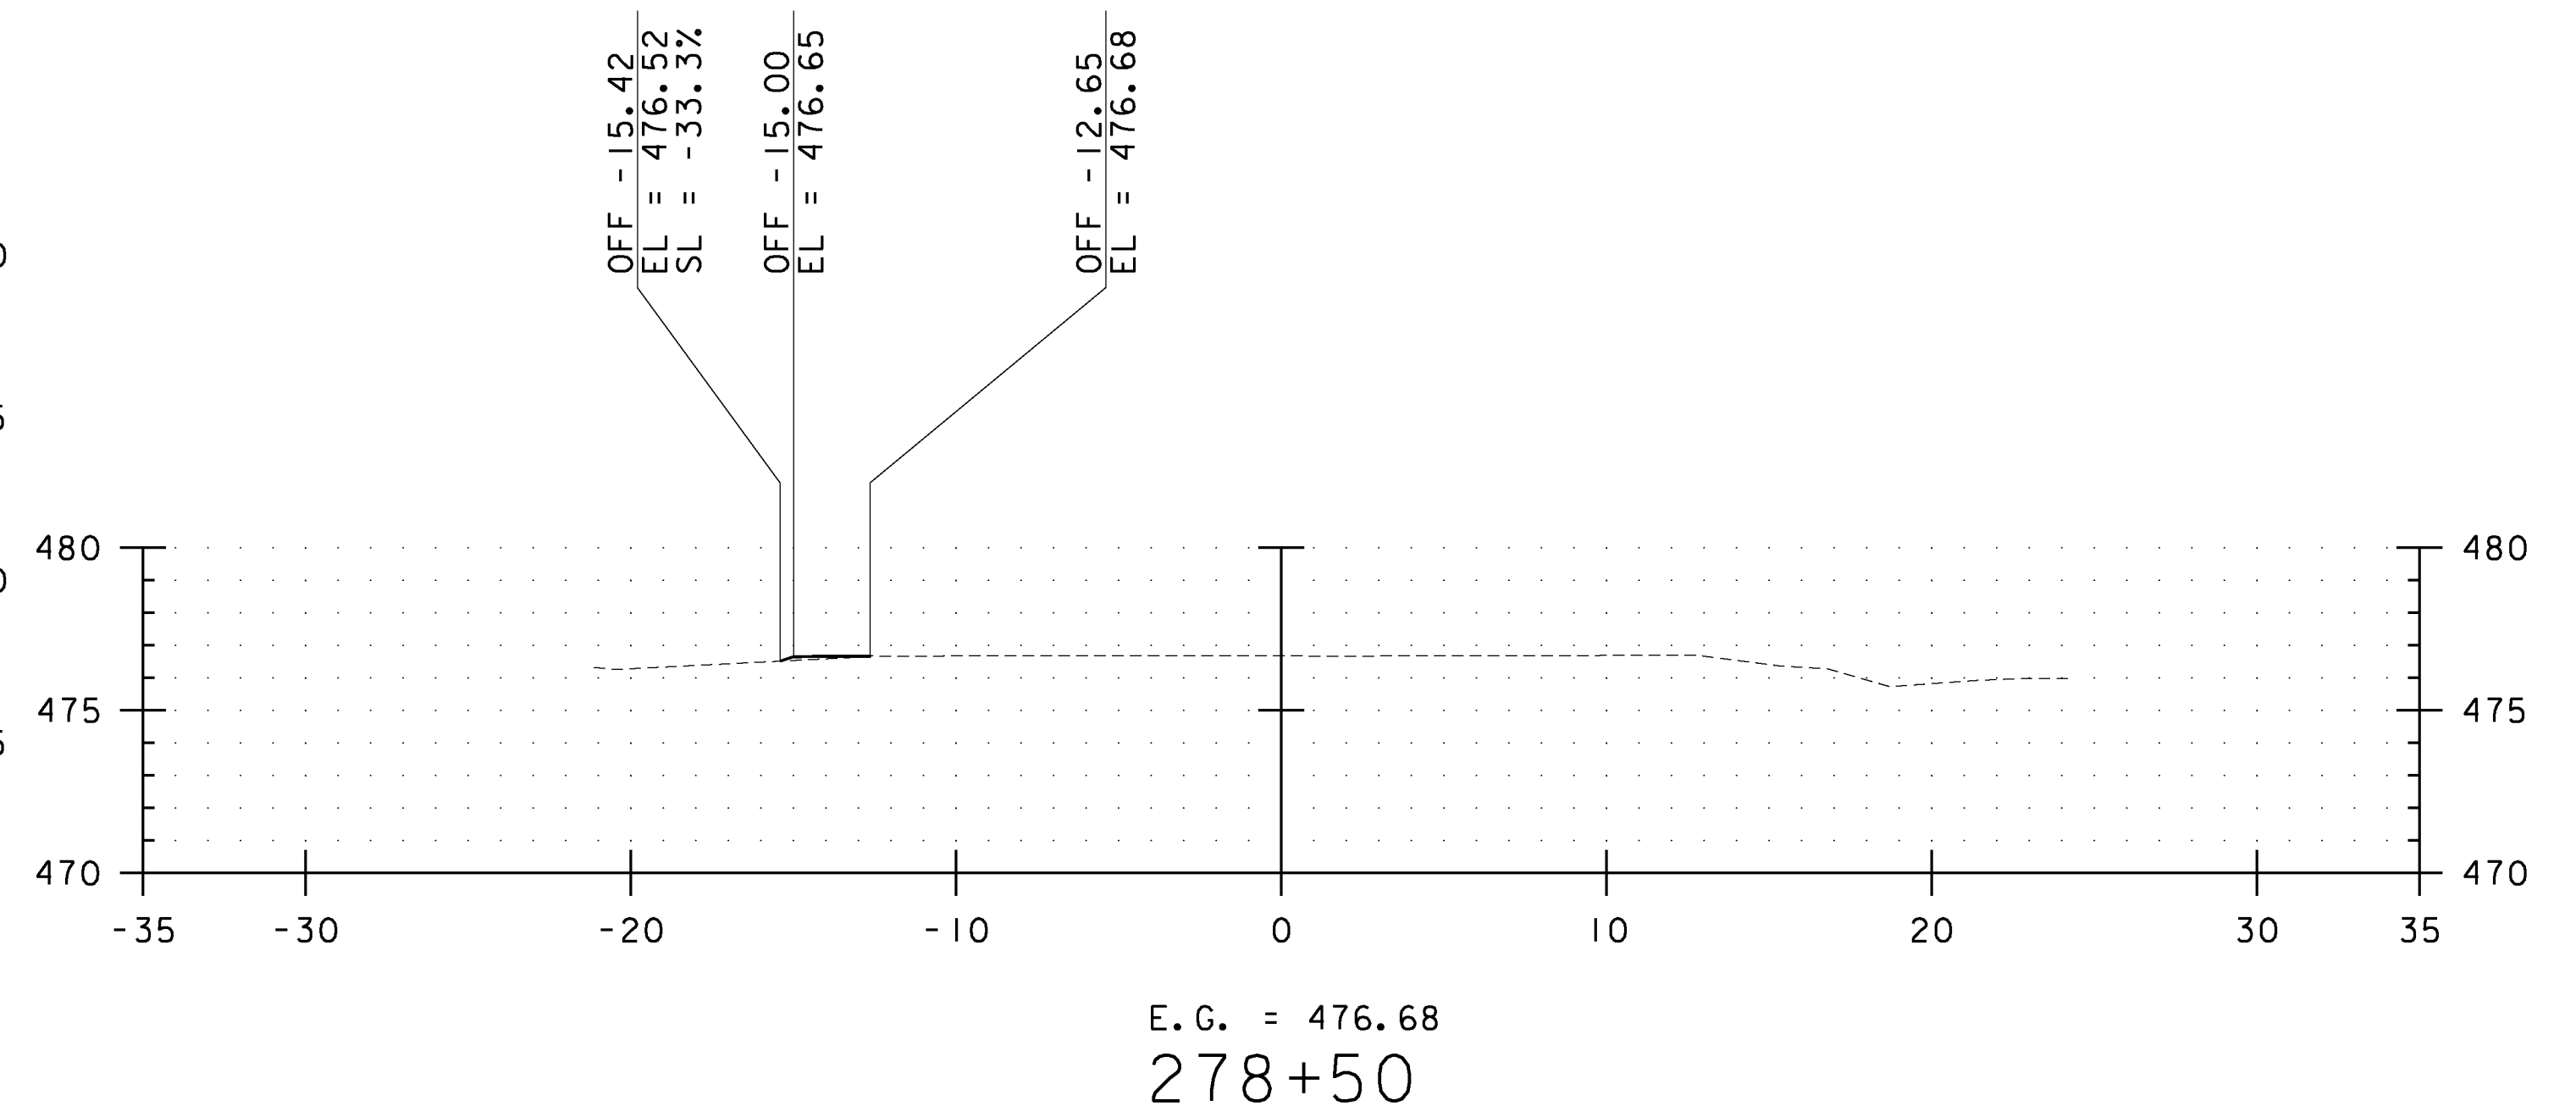

PLOT DATE: 06/09/2010
DRAWN BY: CM
CHECKED BY: MS
SHEET 108 OF 133