

REHAB.
DIS. C&S OR MHS. CLASS I, II OR III
SEE SHEET 105

CHANGING ELEVATION OF SEWER MANHOLES
SEE SHEET 105

VERTICAL GRANITE CURB
STA. 14+22, RT

REMOVAL OF EXISTING CURB
STA. 14+22, RT

PORTLAND CEMENT CONCRETE SIDEWALK, 5 INCH
STA. 13+63, LT
STA. 14+22, RT
STA. 14+28, RT

DETECTABLE WARNING SURFACE
STA. 13+63, LT
STA. 14+22, RT
STA. 14+28, RT

ADJUST ELEVATION OF VALVE BOX
SEE SHEET 105

DURABLE 4 INCH WHITE LINE, TYPE I TAPE
(ALL LINES WILL INCLUDE EDGE LINE BREAKS
AND RADII FOR SIDE ROADS)
STA. 11+50 TO 15+50, DASHED LT & RT (3)
STA. 11+50 TO 13+89, SOLID LT
STA. 11+88 TO 14+56, SOLID RT
STA. 14+50 TO 15+50, DOTTED LT

DURABLE 4 INCH YELLOW LINE, TYPE I TAPE
(ALL LINES WILL INCLUDE & BREAKS FOR SIDE ROADS)
STA. 11+50 TO 15+50, SOLID LT & RT

DURABLE 6 INCH WHITE LINE, TYPE I TAPE
(ALL LINES WILL INCLUDE EDGE LINE BREAKS
AND RADII FOR SIDE ROADS)
STA. 13+78, SOLID LT (RAMP D BIKE CROSSING)
STA. 13+78 TO 15+50, SOLID LT
STA. 14+38, SOLID RT (RAMP B BIKE CROSSING)
STA. 14+38 TO 15+50, SOLID RT

DURABLE 6 INCH YELLOW LINE, TYPE I TAPE
(ALL LINES WILL INCLUDE EDGE LINE BREAKS
AND RADII FOR SIDE ROADS)
STA. 13+71 TO 13+93, SOLID LT (RAMP D EDGELINE)
STA. 14+30 TO 14+56, SOLID RT (RAMP B EDGELINE)

DURABLE 8 INCH WHITE LINE, TYPE I TAPE
STA. 11+50 TO 11+88, RT (GORE & DIAGONALS)
SEE SHEET 107
STA. 13+89 TO 14+50, LT (GORE & DIAGONALS)
SEE SHEET 107
STA. 14+56 TO 14+97, RT (GORE)

DURABLE LETTER OR SYMBOL, TYPE I TAPE
STA. 14+41, RT (RAMP B BIKE LANE SYMBOL)
STA. 14+53, RT (RAMP B BIKE LANE ARROW)

DURABLE CROSSWALK MARKING, TYPE I TAPE
STA. 15+18, LT (SB ON RAMP D)
STA. 15+88, RT (SB OFF RAMP B)

TEMPORARY 4 INCH WHITE LINE, PAINT
(ALL LINES WILL INCLUDE EDGE LINE BREAKS
AND RADII FOR SIDE ROADS)
STA. 11+50 TO 15+50, DASHED LT & RT (3)
STA. 11+50 TO 13+89, SOLID LT
STA. 11+88 TO 14+56, SOLID RT
STA. 14+50 TO 15+50, DOTTED LT

TEMPORARY 4 INCH YELLOW LINE, PAINT
(ALL LINES WILL INCLUDE & BREAKS FOR SIDE ROADS)
STA. 11+50 TO 15+50, SOLID LT & RT

TEMPORARY 6 INCH WHITE LINE, PAINT
(ALL LINES WILL INCLUDE EDGE LINE BREAKS
AND RADII FOR SIDE ROADS)
STA. 13+78, SOLID LT (RAMP D BIKE CROSSING)
STA. 13+78 TO 15+50, SOLID LT
STA. 14+38, SOLID RT (RAMP B BIKE CROSSING)
STA. 14+38 TO 15+50, SOLID RT

TEMPORARY 6 INCH YELLOW LINE, PAINT
(ALL LINES WILL INCLUDE EDGE LINE BREAKS
AND RADII FOR SIDE ROADS)
STA. 13+71 TO 13+93, SOLID LT (RAMP D EDGELINE)
STA. 14+30 TO 14+56, SOLID RT (RAMP B EDGELINE)


TEMPORARY 8 INCH WHITE LINE, PAINT
STA. 11+50 TO 11+88, RT (GORE & DIAGONALS)
SEE SHEET 107
STA. 13+89 TO 14+50, LT (GORE & DIAGONALS)
SEE SHEET 107
STA. 14+56 TO 14+97, RT (GORE)

TEMPORARY LETTER OR SYMBOL, PAINT
STA. 14+41, RT (RAMP B BIKE LANE SYMBOL)
STA. 14+53, RT (RAMP B BIKE LANE ARROW)

TEMPORARY CROSSWALK MARKING, PAINT
STA. 15+18, LT (SB ON RAMP D)
STA. 15+88, RT (SB OFF RAMP B)

REMOVING SIGNS
AS SHOWN - 8

SPECIAL PROVISION
(PAINTED BIKE LANE)
STA. 13+67 TO 15+50, LT
STA. 14+26 TO 15+50, RT

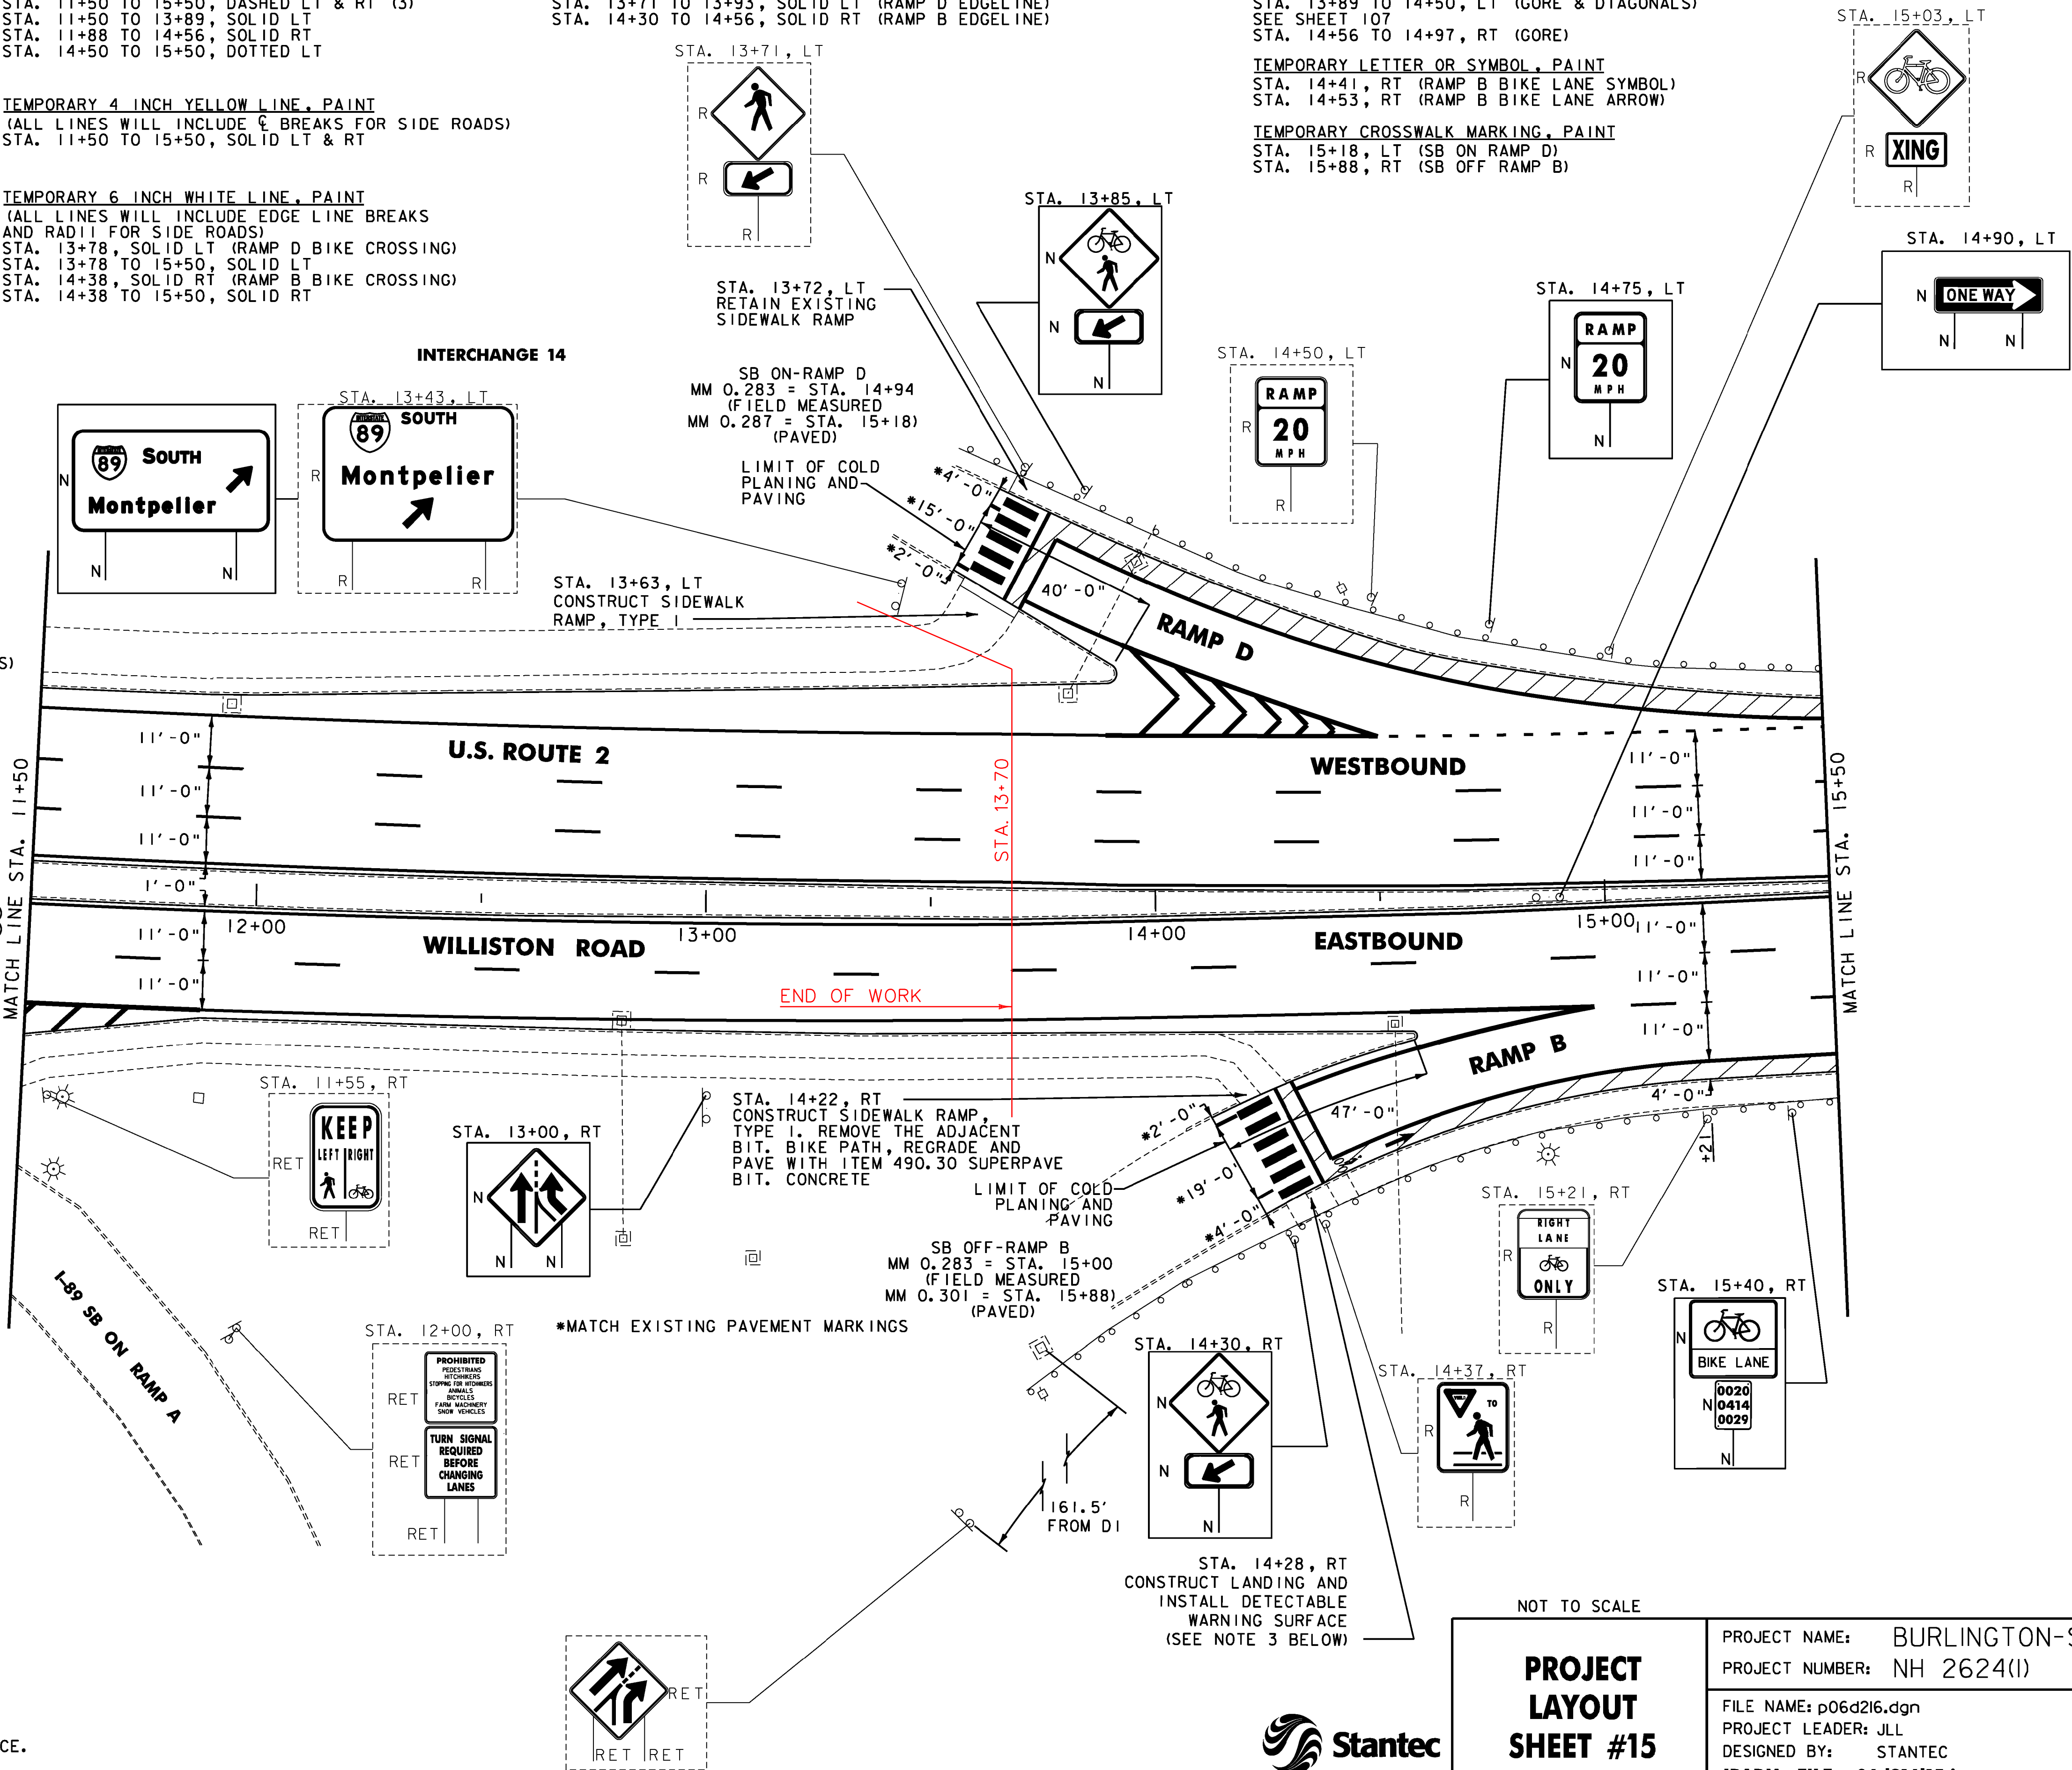

- NOTES:
- FOR LEGENDS, SEE SHEET 13.
 - ALL EXISTING SIGNS NOT SHOWN SHALL BE RETAINED.
 - THE SIDEWALK "LANDINGS" NOTED CONSIST OF THE REMOVAL AND REPLACEMENT OF A SINGLE SLAB OF CONCRETE SIDEWALK IN ORDER TO INSTALL A NEW DETECTABLE WARNING SURFACE.



NOT TO SCALE

**PROJECT
LAYOUT
SHEET #15**

PROJECT NAME: BURLINGTON-SOUTH BURLINGTON
PROJECT NUMBER: NH 2624(1)

FILE NAME: p06d216.dgn
PROJECT LEADER: JLL
DESIGNED BY: STANTEC
IPARM FILE: p06d216115.i

PLOT DATE: 2/7/2012
DRAWN BY: STANTEC
CHECKED BY: STANTEC
SHEET 28 OF 108