


ITEM 646.404 - DURABLE 4 INCH WHITE LINE, POLYUREA
(ALL LINES WILL INCLUDE EDGE LINE BREAKS AND
RADI FOR SIDE ROADS)
STA. 60+00 TO 61+83, SOLID RT
STA. 60+00 TO 60+22, DOTTED LT
STA. 60+00 TO 60+22, SOLID LT
STA. 60+22 TO 61+22, DOTTED LT
STA. 60+47 TO 61+57, DOTTED RT
STA. 61+22 TO 64+50, SOLID LT
STA. 61+57 TO 61+83, SOLID RT
STA. 62+04, LT (PINETREE TER.)
STA. 62+33 TO 63+33, DOTTED RT
STA. 62+33 TO 62+73, SOLID LT
STA. 63+33 TO 64+50, SOLID RT
STA. 62+34, LT (PINETREE TER.)

ITEM 646.414 - DURABLE 4 INCH YELLOW LINE, POLYUREA
(ALL LINES WILL INCLUDE & BREAKS FOR SIDE ROADS)
STA. 60+00 TO 61+57, DOUBLE SOLID LT & RT
STA. 61+57 TO 61+83, DOUBLE SOLID LT
STA. 62+08, DOUBLE SOLID RT (DAVIS PARKWAY)
STA. 62+19, DOUBLE SOLID LT (PINETREE TER.)
STA. 62+33 TO 63+33, DOUBLE SOLID RT
STA. 63+33 TO 64+50, SOLID LT & RT
STA. 63+33 TO 64+50, DASHED LT & RT

ITEM 646.454 - DURABLE 8 INCH YELLOW LINE, POLYUREA
STA. 60+00 TO 61+30, DIAGONALS
ITEM 646.484 - DURABLE 24 INCH STOP BAR, POLYUREA
STA. 62+08, RT (DAVIS PARKWAY)
STA. 62+19, LT (PINETREE TER.)

ITEM 646.494 - DURABLE LETTER OR SYMBOL, POLYUREA
STA. 61+12, C, "ONLY"
STA. 61+80, RT, ARROW (2)
STA. 61+80, C, ARROW
STA. 62+08, RT (DAVIS PARKWAY), "STOP"
STA. 62+19, LT (PINETREE TER.), "STOP"
STA. 62+40, C, ARROW
STA. 62+40, LT, ARROW (2)
STA. 62+70, C, "ONLY"
STA. 63+35, RT, HELMETED BICYCLIST
STA. 63+44, C, ARROW
STA. 63+47, RT, ARROW
STA. 63+62, C, ARROW
ITEM 646.504 - DURABLE CROSSWALK MARKING, POLYUREA
STA. 62+08, RT (DAVIS PARKWAY)
STA. 62+19, LT (PINETREE TER.)

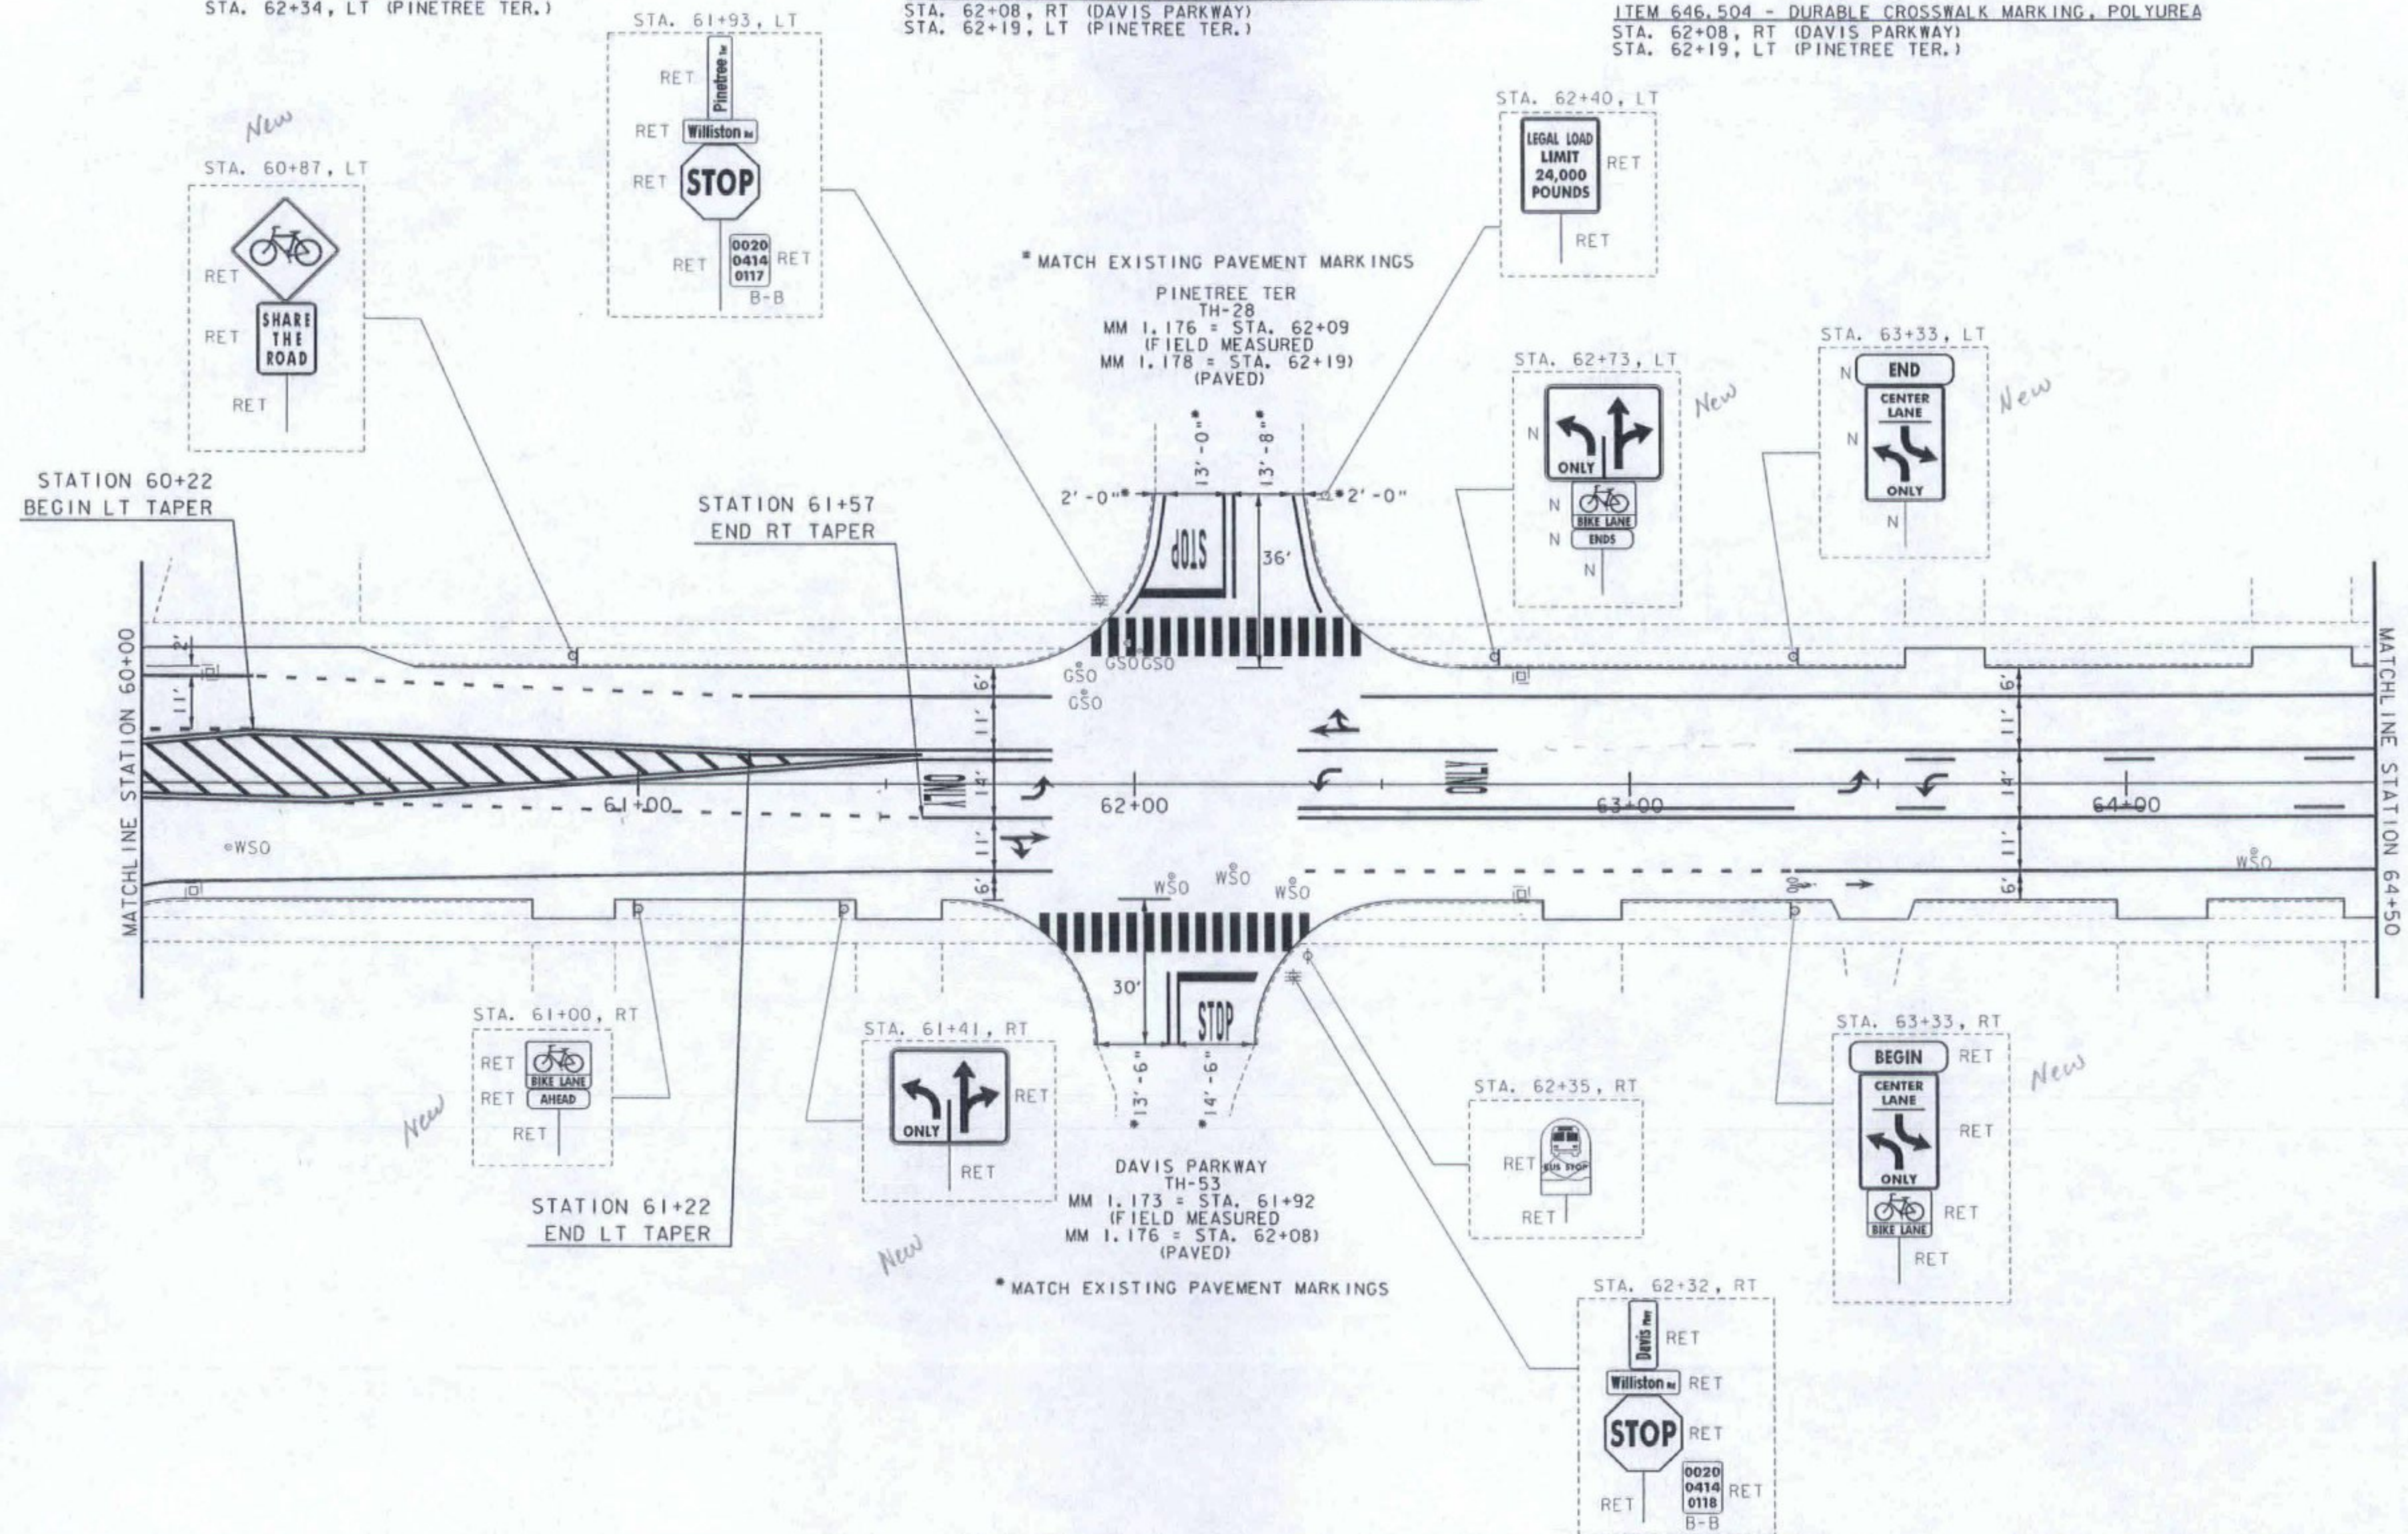

NOT TO SCALE



RSG INC.

RESOURCE SYSTEMS GROUP, INC.
55 Railroad Row, White River Junction, Vermont 05001
TEL 802.295.4999 • FAX 802.295.1006 • www.rsgr.com

**CHANGE ORDER
SIGN - STRIPE
SHEET #3**

PROJECT NAME: BURLINGTON-SOUTH BURLINGTON	PLOT DATE: 09/19/12
PROJECT NUMBER: NH 2624(I)	DRAWN BY: CDM
FILE NAME: p06d216.dgn	CHECKED BY: RMC
DESIGNED BY: CDM	SHEET 4 OF 18
IPARM FILE: p06d216135.i	