
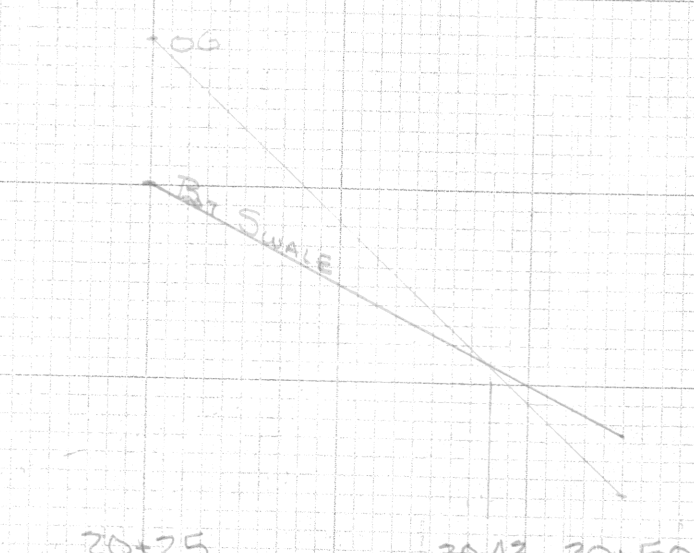
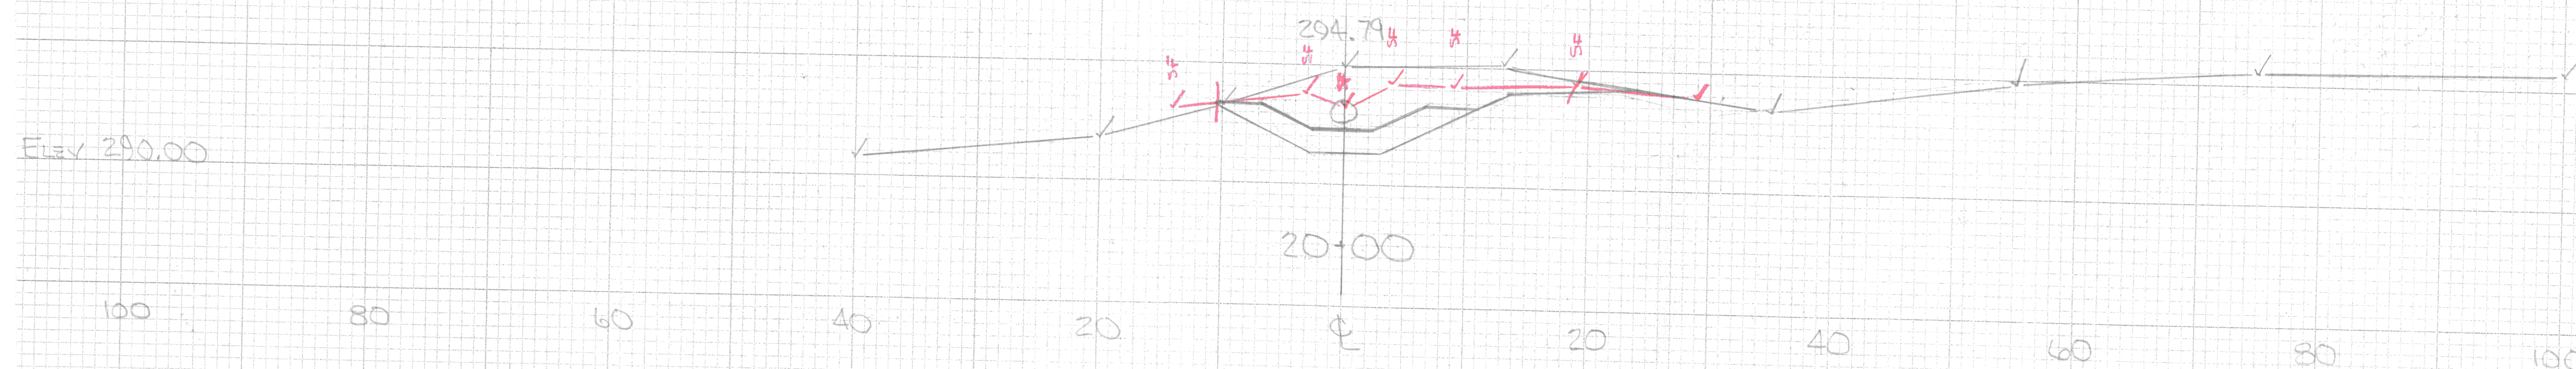
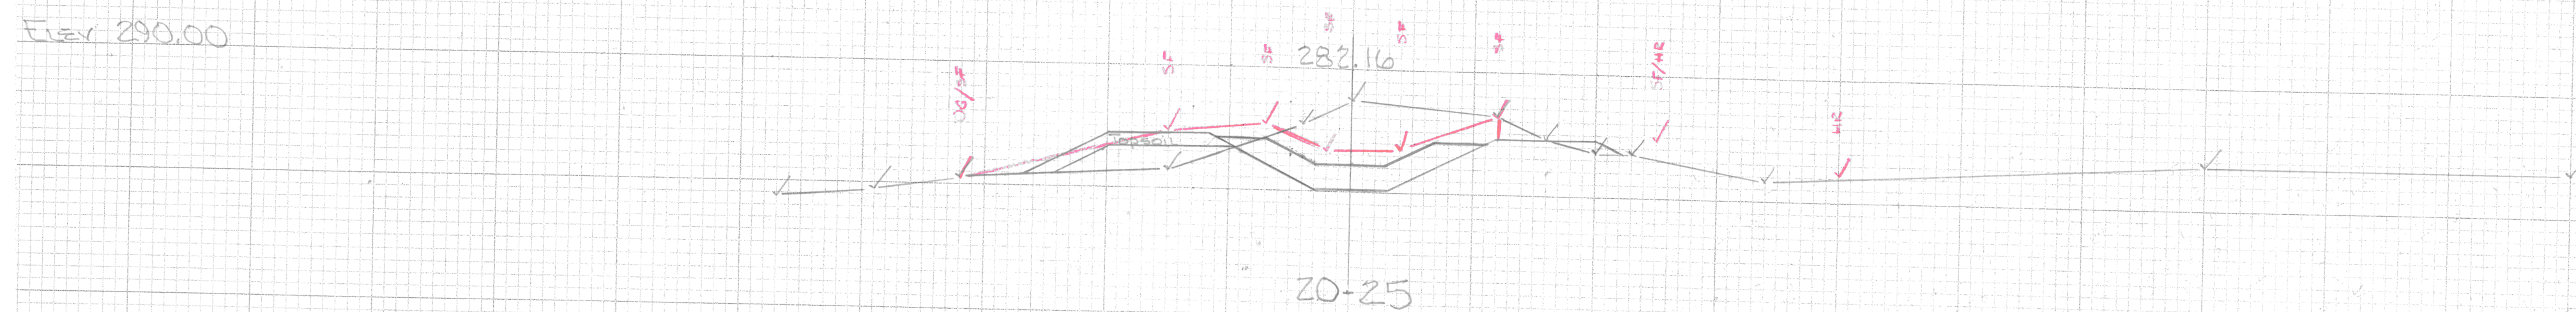
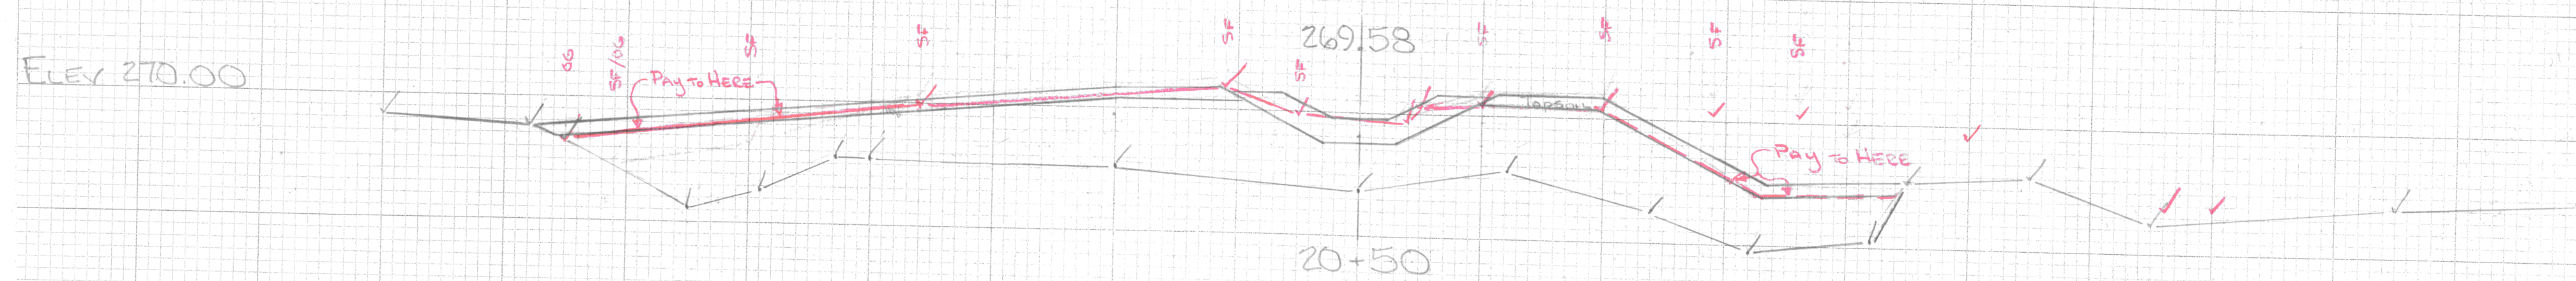


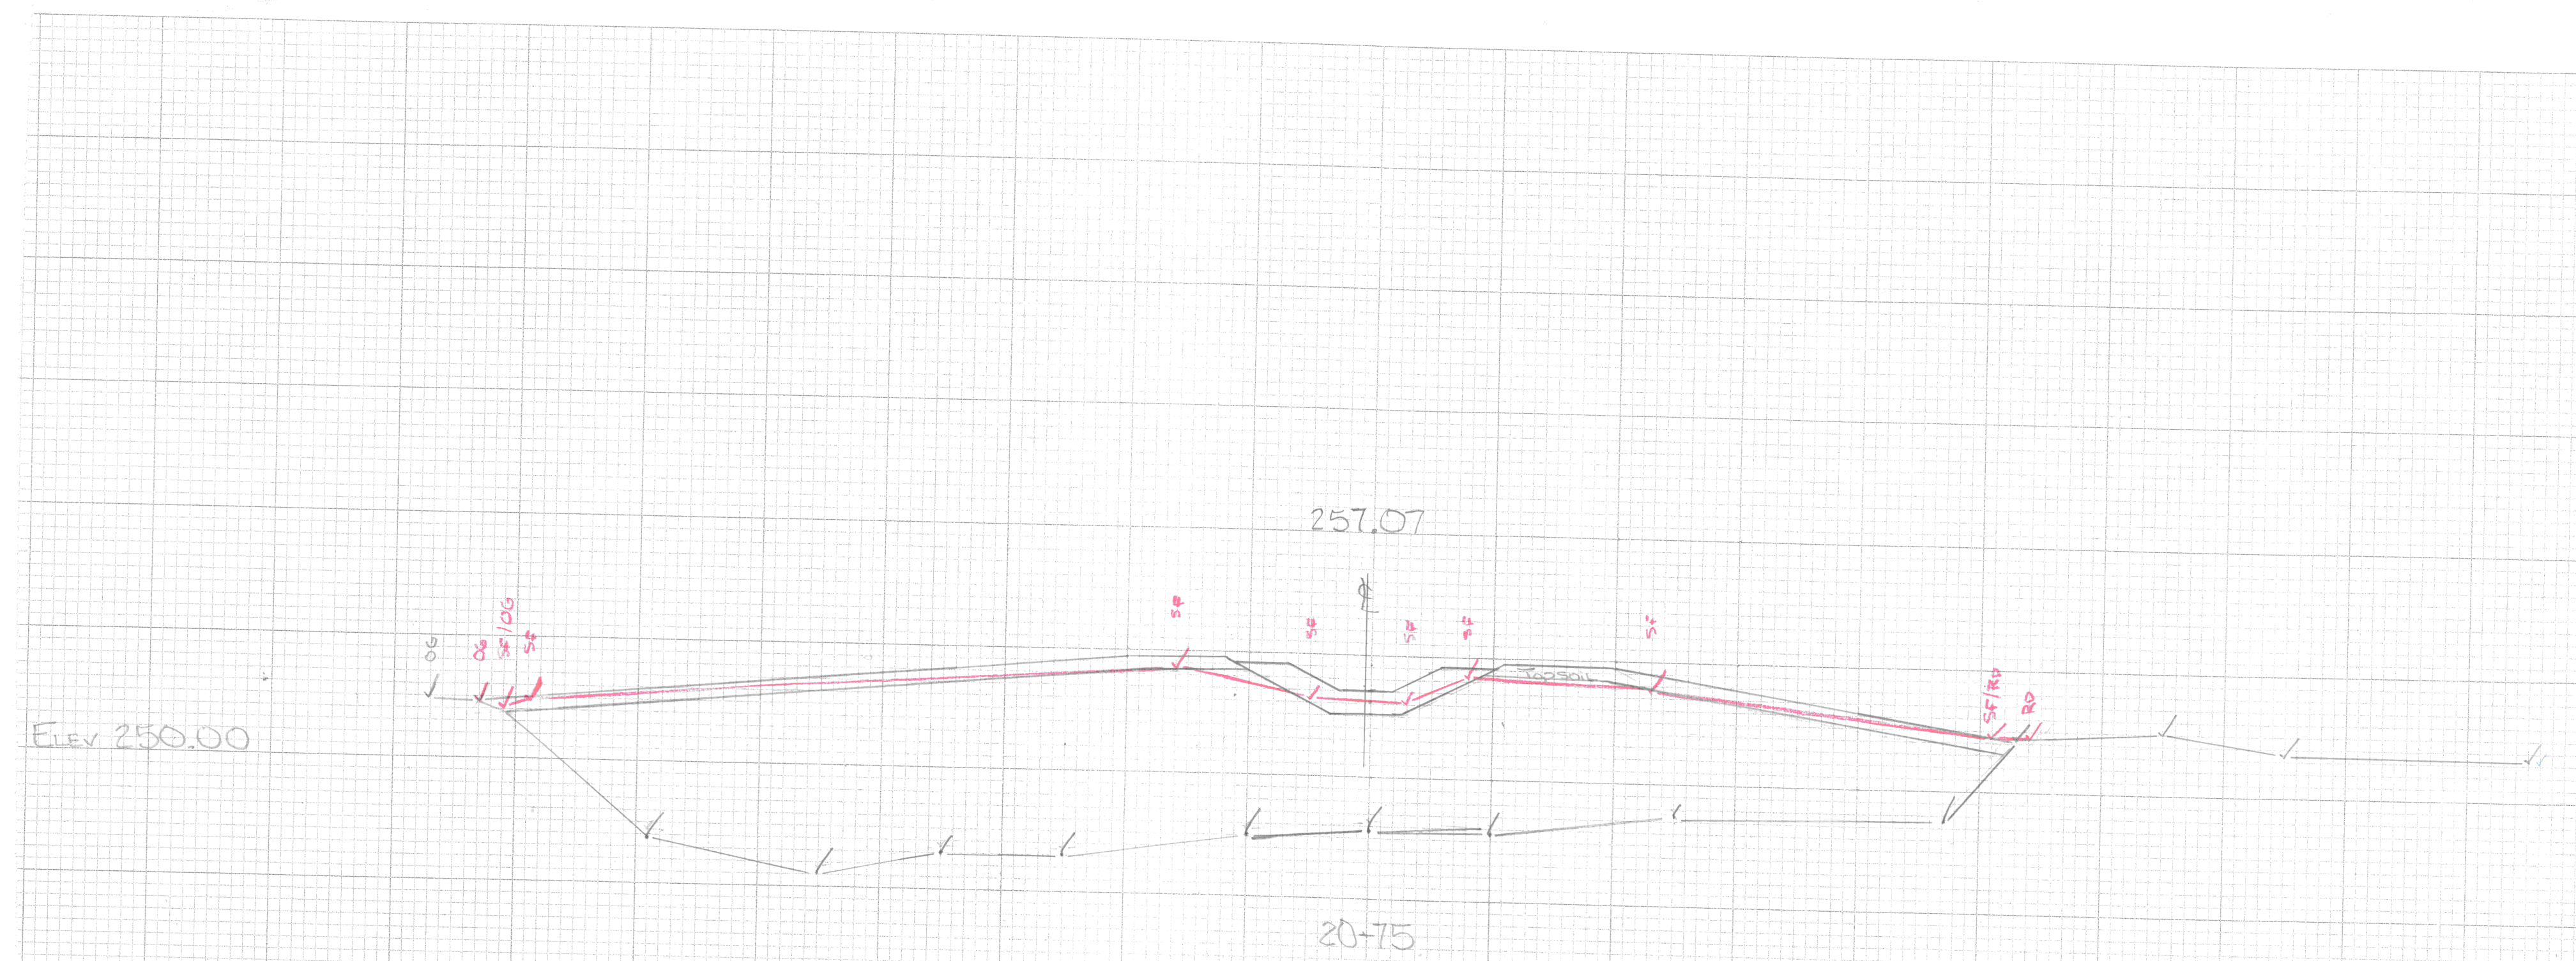

19-95 - ZERO COMMON EXCAVATION
 20+00 ZERO STONE FILL TYPE III
 BUTT

ESSEX
 STP 030-(20)
 CHANNEL CROSS SECTIONS
 SHEET # 1