

INDEX OF SHEETS

- 1. TITLE SHEET
- 2. QUANTITY SHEET
- 3-7. INTERCONNECT LAYOUT SHEETS 1-5

STANDARDS

E-101	CONSTRUCTION SIGN DETAILS	05/30/2003
E-102	CONSTRUCTION SIGN DETAILS	06/30/2003
E-110	MAJOR MAINTENANCE OPERATION LANE CLOSURE	08/08/1995
E-111	MINOR MAINTENANCE OPERATIONS	03/11/1997
E-171A	TRAFFIC CONTROL SIGNALS GENERAL NOTES & DETAILS	08/09/1995
E-171B	TRAFFIC CONTROL SIGNALS MISC. DETAILS	08/09/1995

STATE OF
AGENCY OF T




PROPOSED I
CITY OF SO
COUNTY OF
US ROUTE 7 - PH

BEGINNING AT THE BURLINGTON/SOUTH
0.87 MILES TO THE INTERSECTION OF H

LENGTH OF ROADWAY:
LENGTH OF PROJECT:

THIS PROJECT SHALL CONSIST OF ALL
OF WIRELESS INTERCONNECT EQUIPMENT

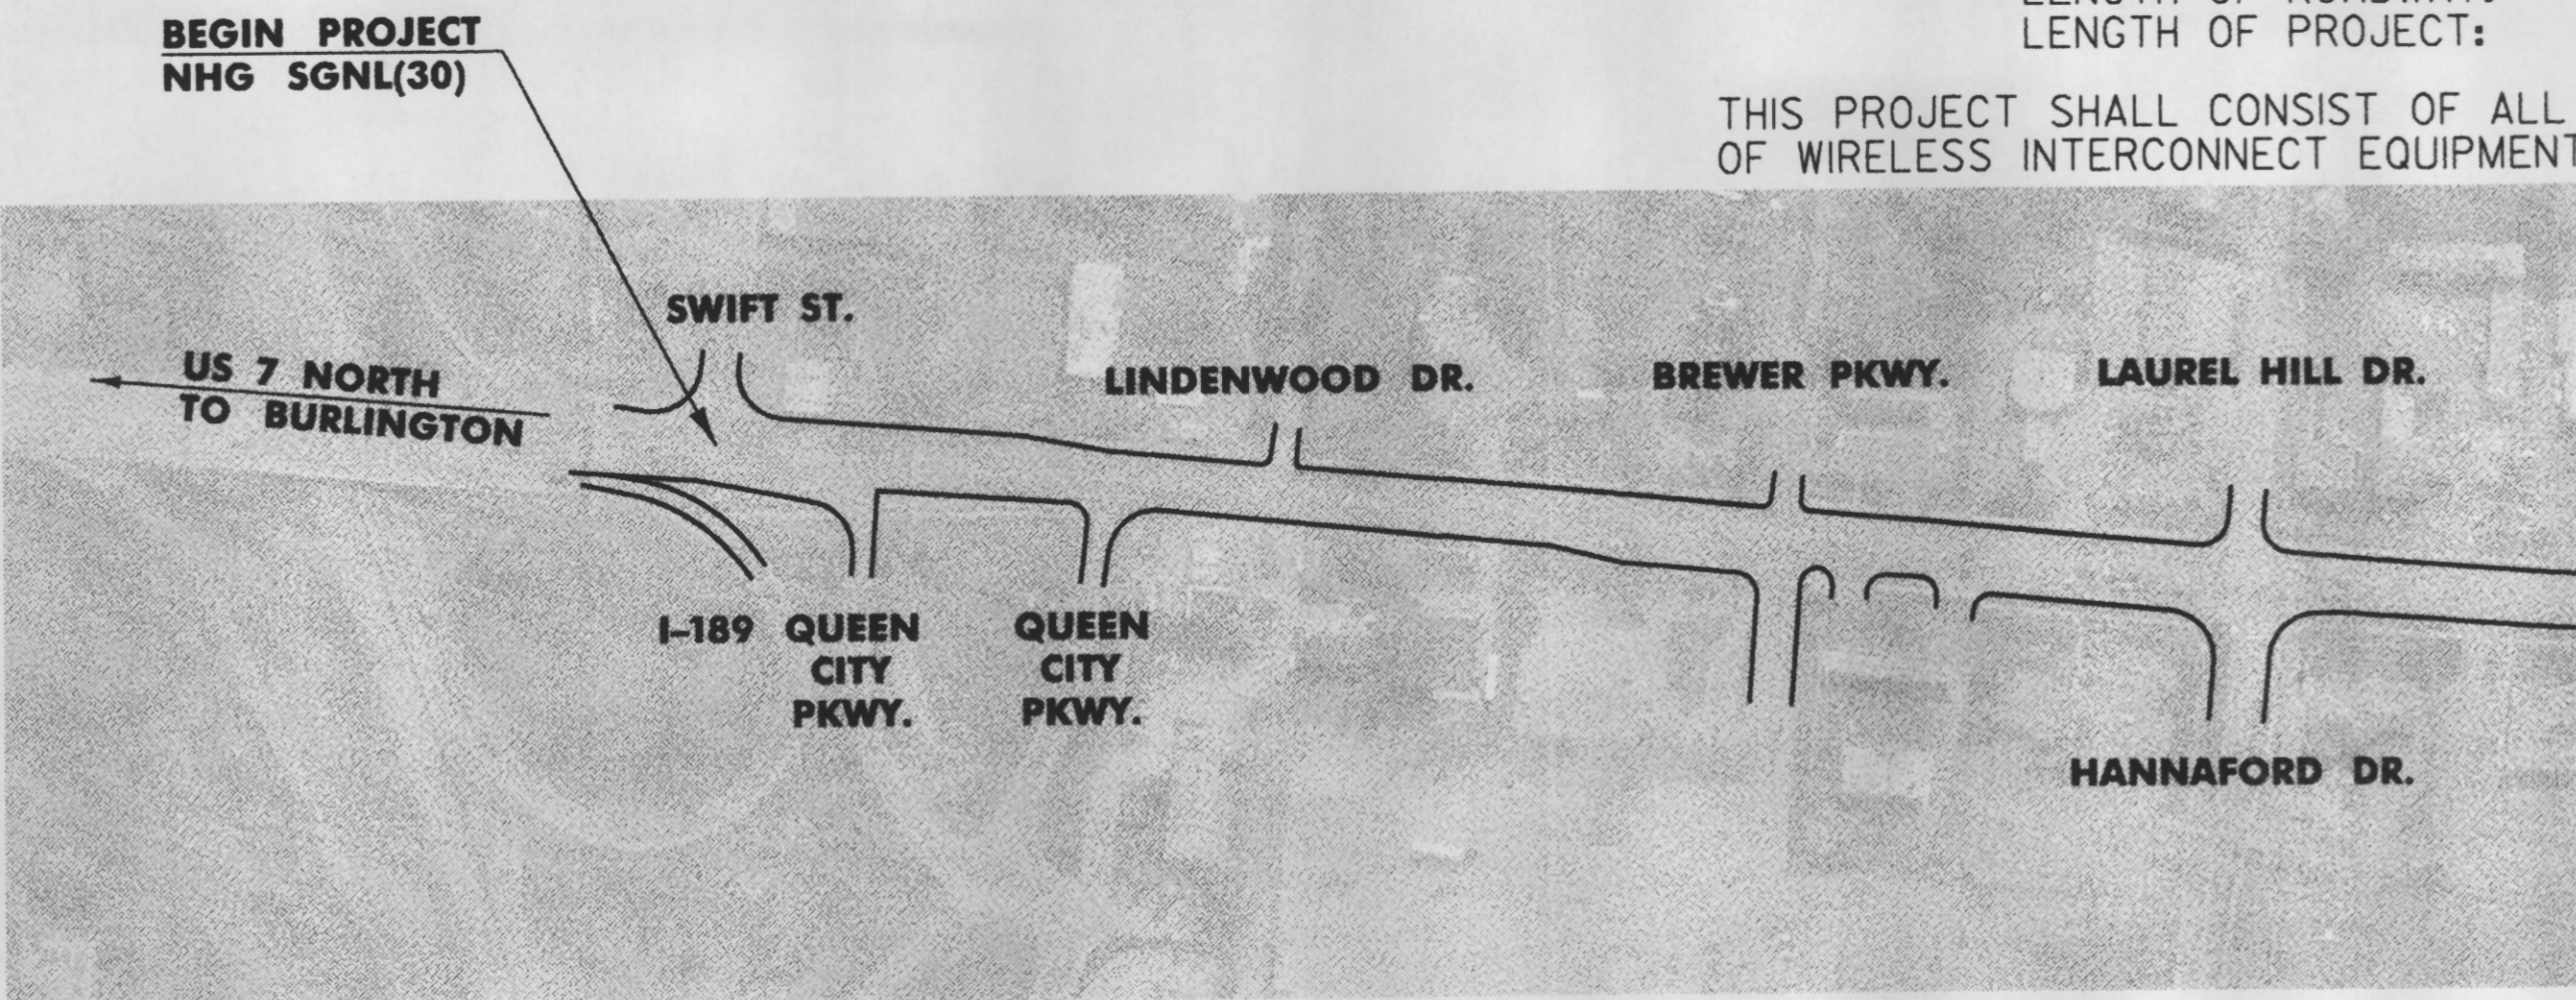

CONVENTIONAL SYMBOLS

COUNTY LINE	
TOWN LINE	
LIMITS OF ACCESS	
POINT OF ACCESS	
FENCE LINE	
STONE WALL	
TRAVELED WAY	
GUARD RAIL	
RAILROAD	
SURVEY LINE	
CULVERT	
POWER POLE	
TELEPHONE POLE	
TREES	
CONTROL OF ACCESS	
PROPERTY LINE	
R.O.W. TAKING LINE	
SLOPE RIGHTS	
TOP OF CUT	
TOE OF SLOPE	

SURVEYED BY : N/A
SURVEYED DATE : N/A

DATUM
VERTICAL N/A
HORIZONTAL N/A

RECORD

CONTRACTOR: DON WESTON EXC
RESIDENT ENGINEER: DALE
CONSTRUCTION BEGAN: JULY
CONSTRUCTION COMPLETE: OCTO
RECORD PLANS BY: DALE
I HEREBY CERTIFY THAT ALL THE C
OF DRAWINGS HAS BEEN ACCO
BY *Dale R. Yorton*
DATE *28 June 20*

NOTE: Any further information concerni
relative to this project may be found at Cen