



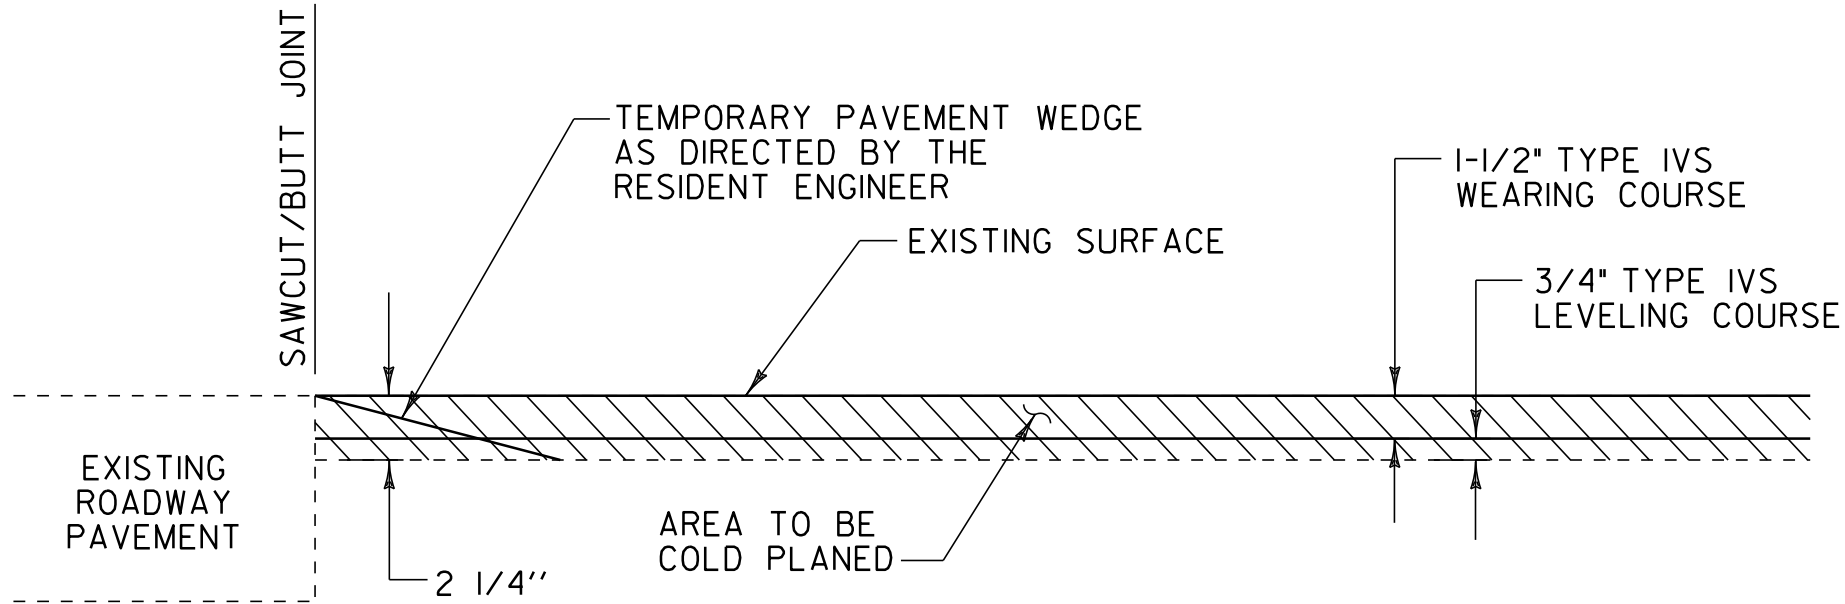


APPROACH AREA DETAIL

GUILDHALL
BEGIN PROJECT: MM 0.000
ROUTE 102 APPROACH: MM 0.000
TH*2 APPROACH: MM 0.000
TH*2 APPROACH: MM 0.000

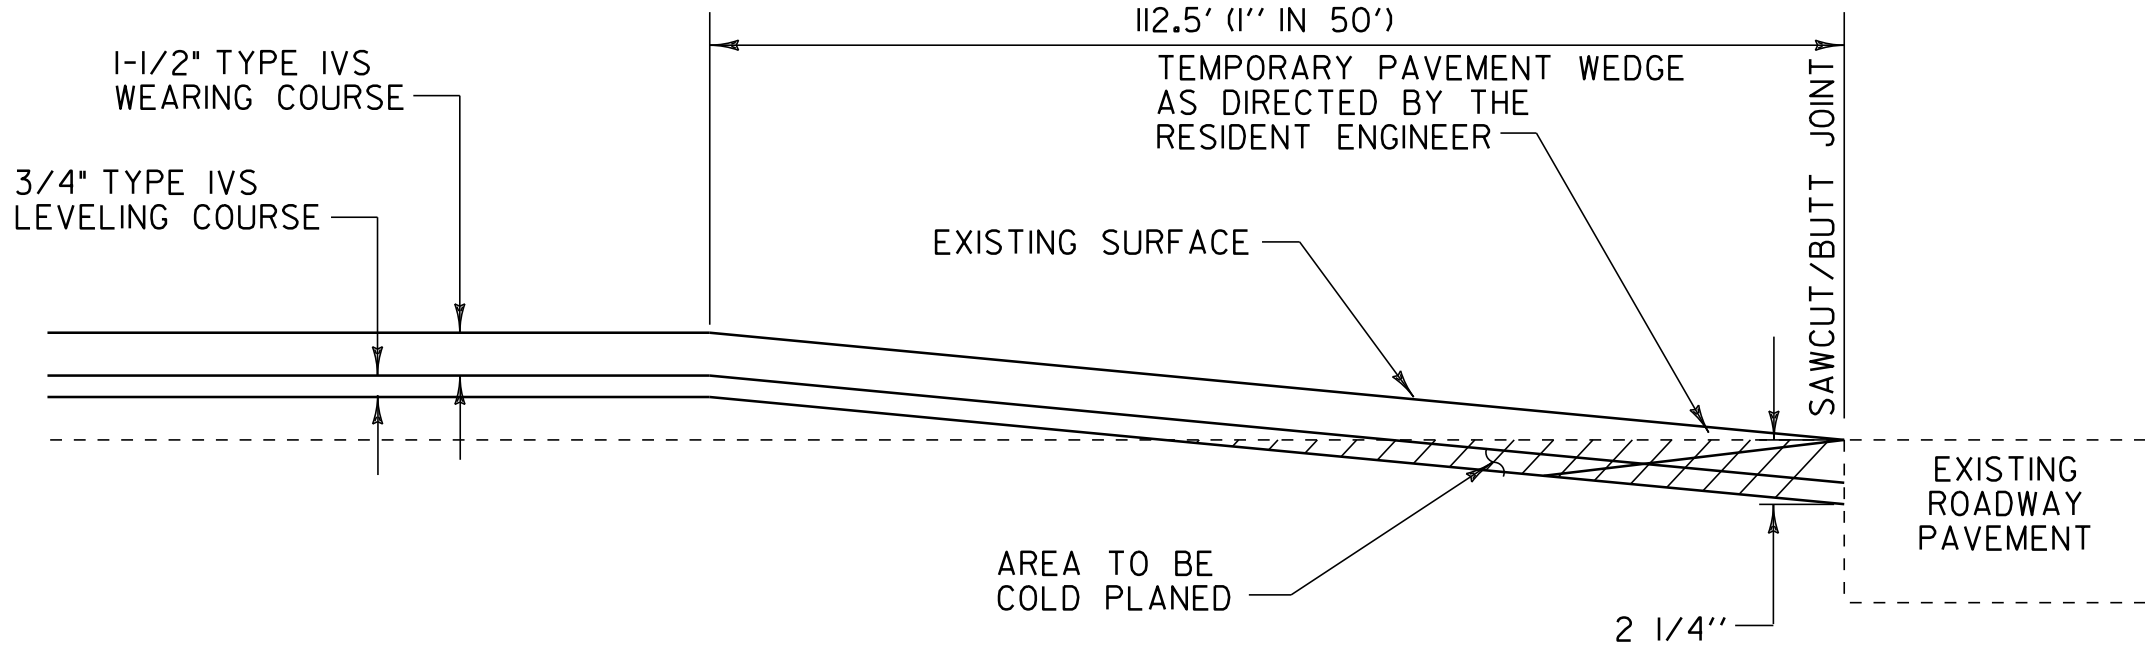


APPROACH AREA DETAIL

MAIDSTONE
END PROJECT: MM 2.835

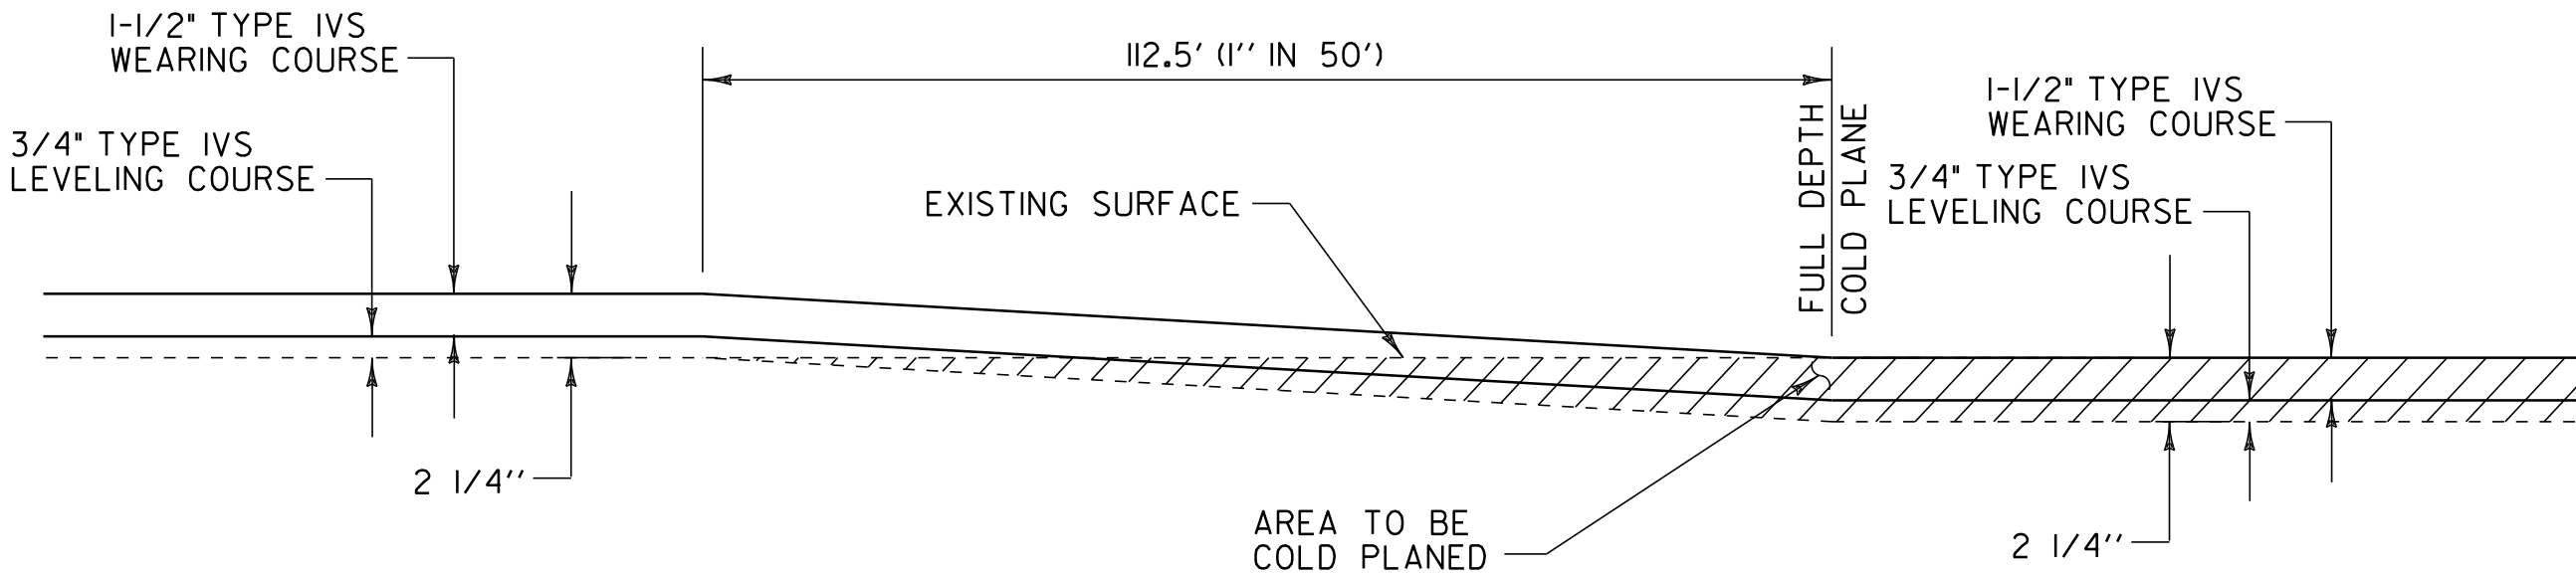


APPROACH AREA DETAIL

GUILDHALL
MM 0.070
MM 5.389
MM 6.550

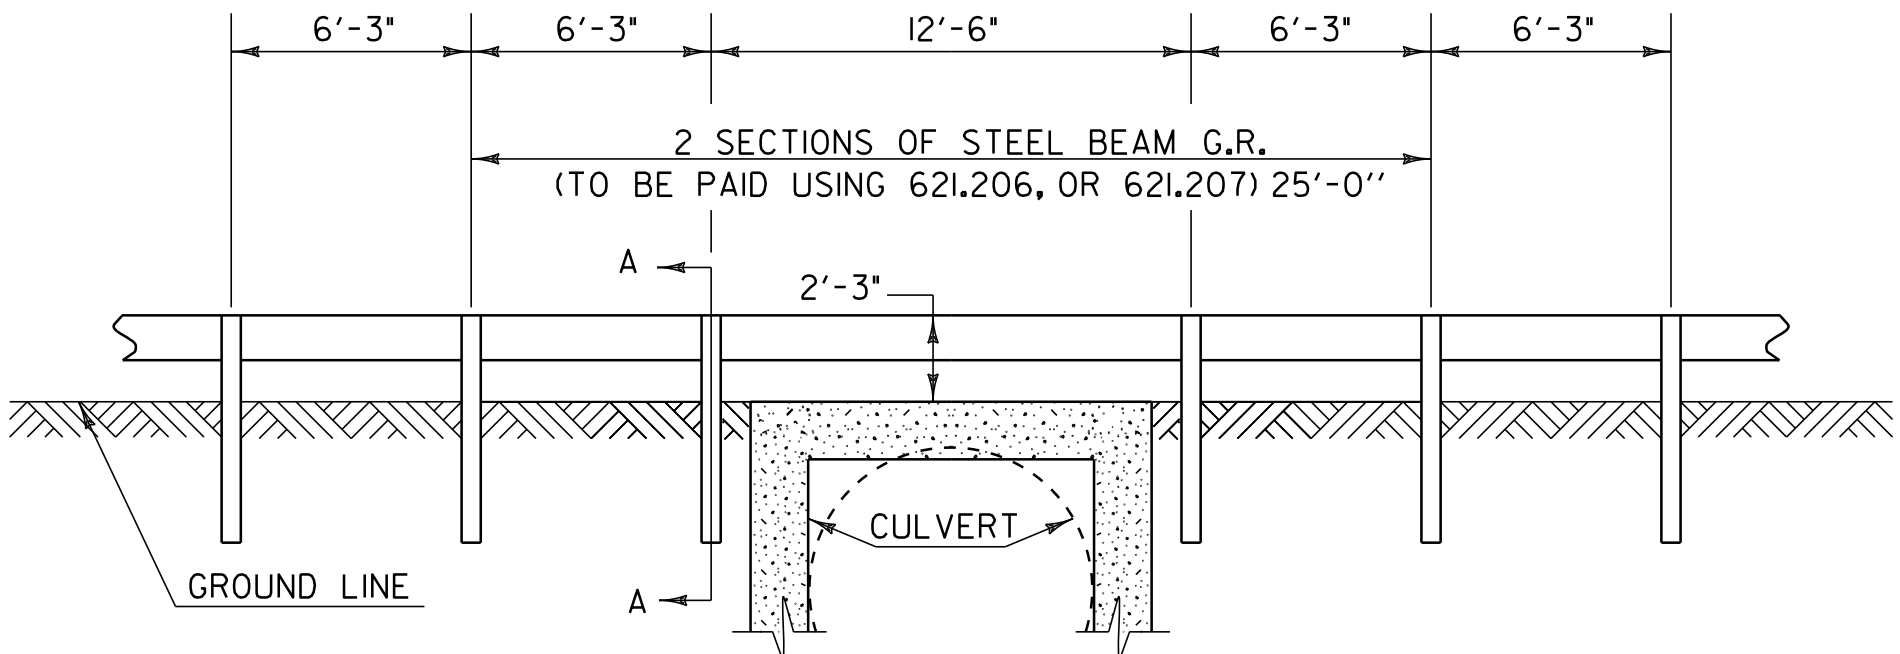

DETAIL OF STEEL BEAM GUARDRAIL AT SMALL CULVERTS


(CULVERTS UP TO 4' WIDE)

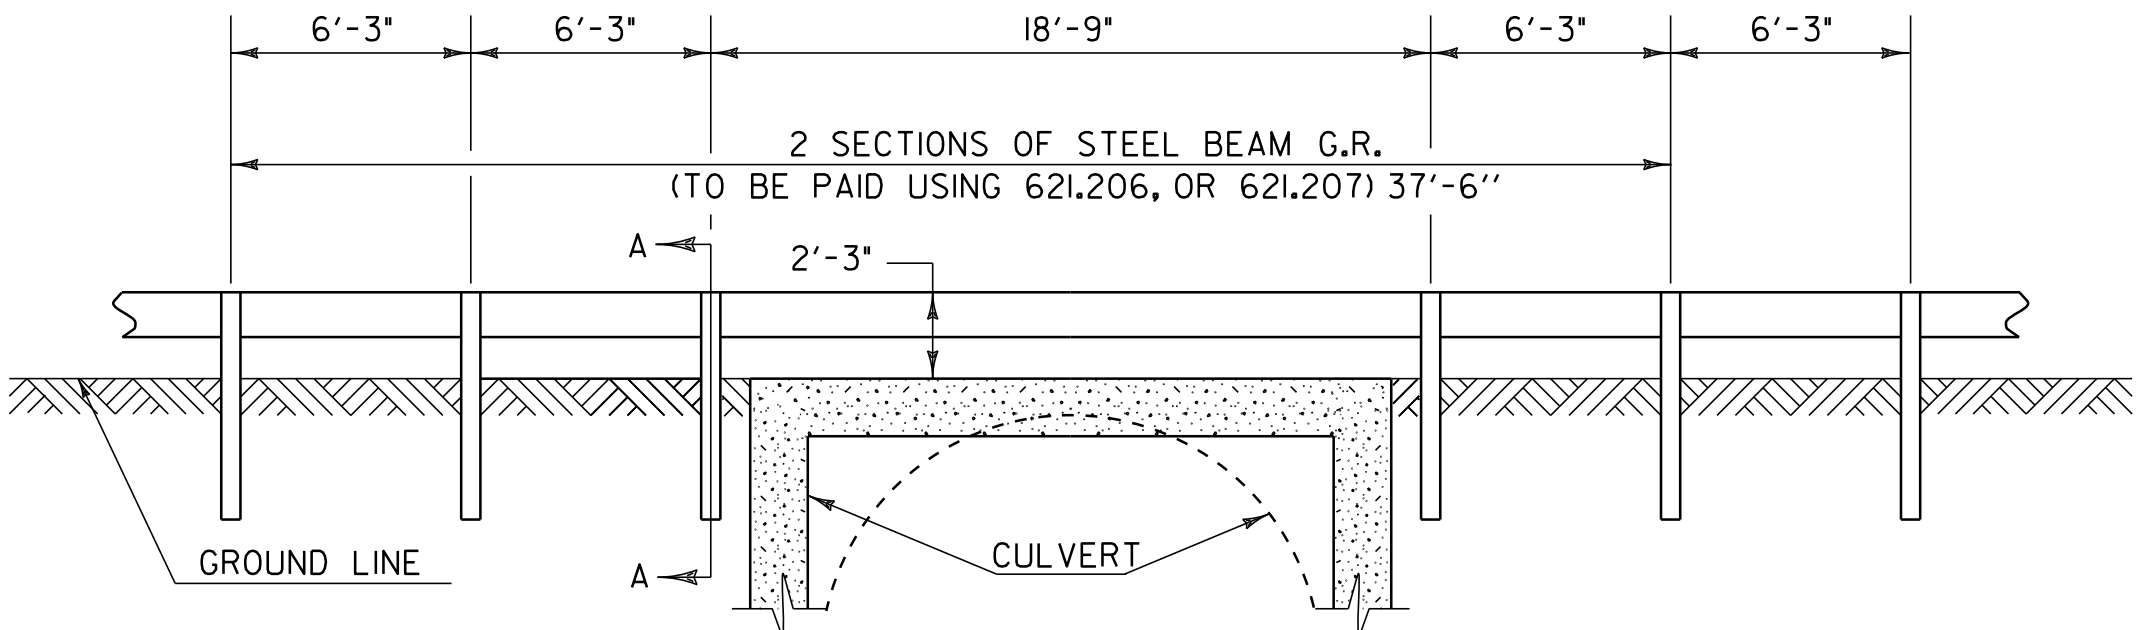

DETAIL OF STEEL BEAM GUARDRAIL AT LARGE CULVERTS


(CULVERTS GREATER THAN 4' WIDE)

GUILDHALL
MM 1.350 LT
MM 1.350 RT
MM 4.785 RT
MM 4.785 LT

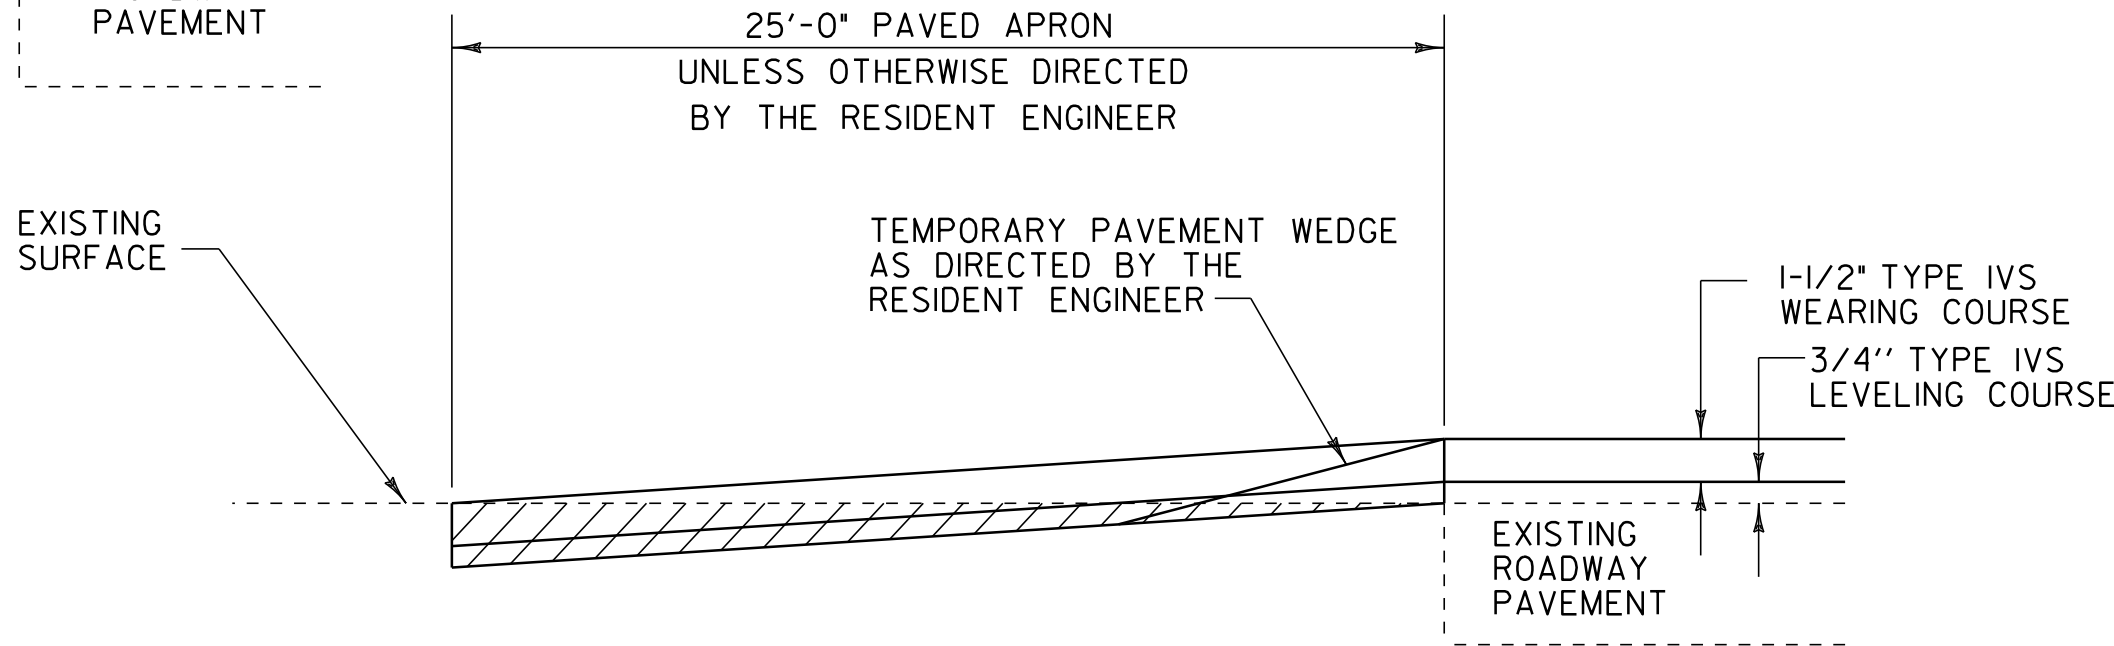


TRANSITION AREAS FOR SIDE ROADS - OVERLAY SECTIONS

GUILDHALL
TH 8, MM 1.131 LT
TH 1, MM 4.986 LT
TH 6, MM 4.986 RT
TH 5, MM 5.273 LT
TH 5, MM 5.303 LT
TH 3, MM 5.830 LT

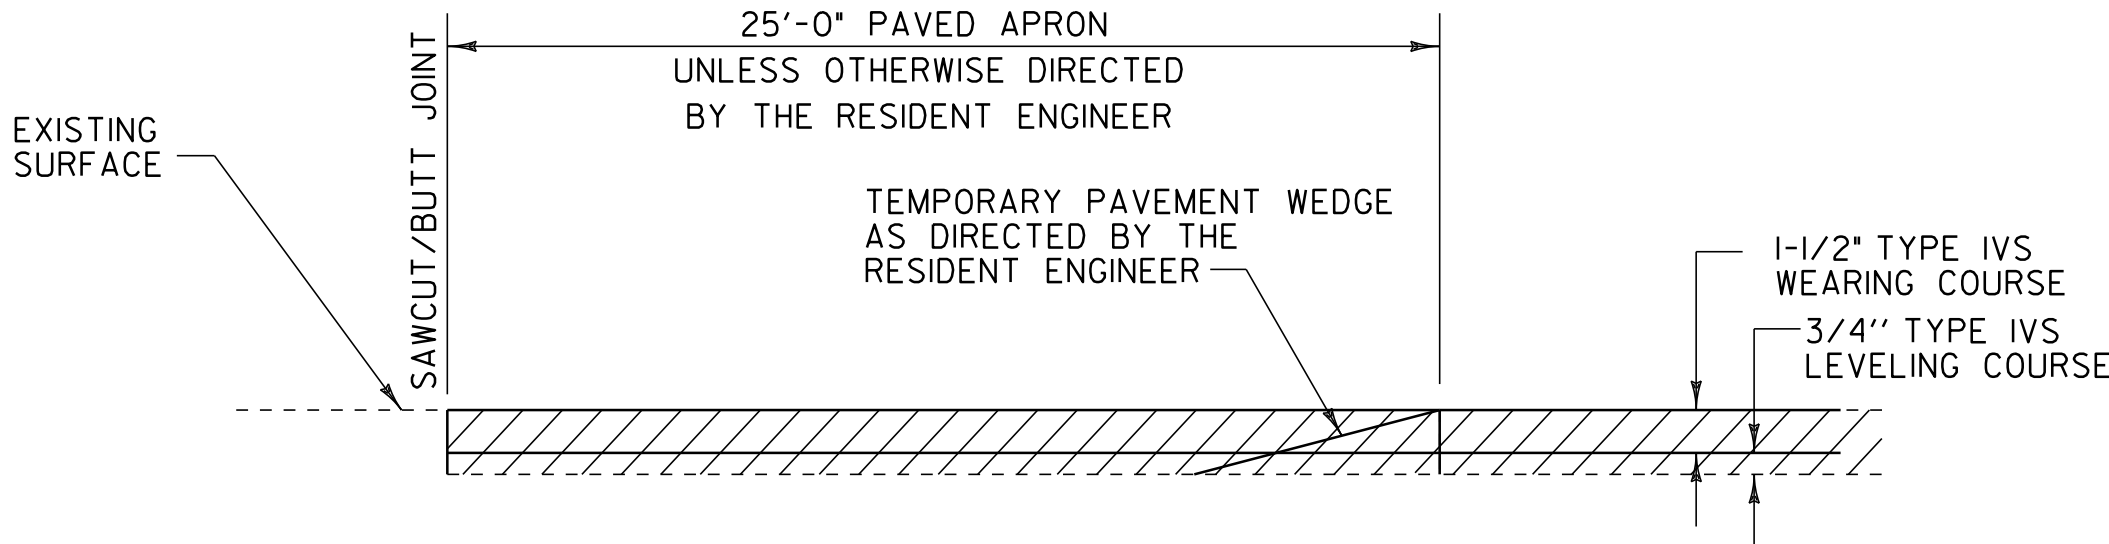

TRANSITION AREAS FOR SIDE ROADS - COLD PLANE SECTIONS

GUILDHALL
TH 4, MM 7.137 LT
TH 2, MM 7.180 RT
TH 2, MM 7.262 RT
TH 4, MM 7.253 LT

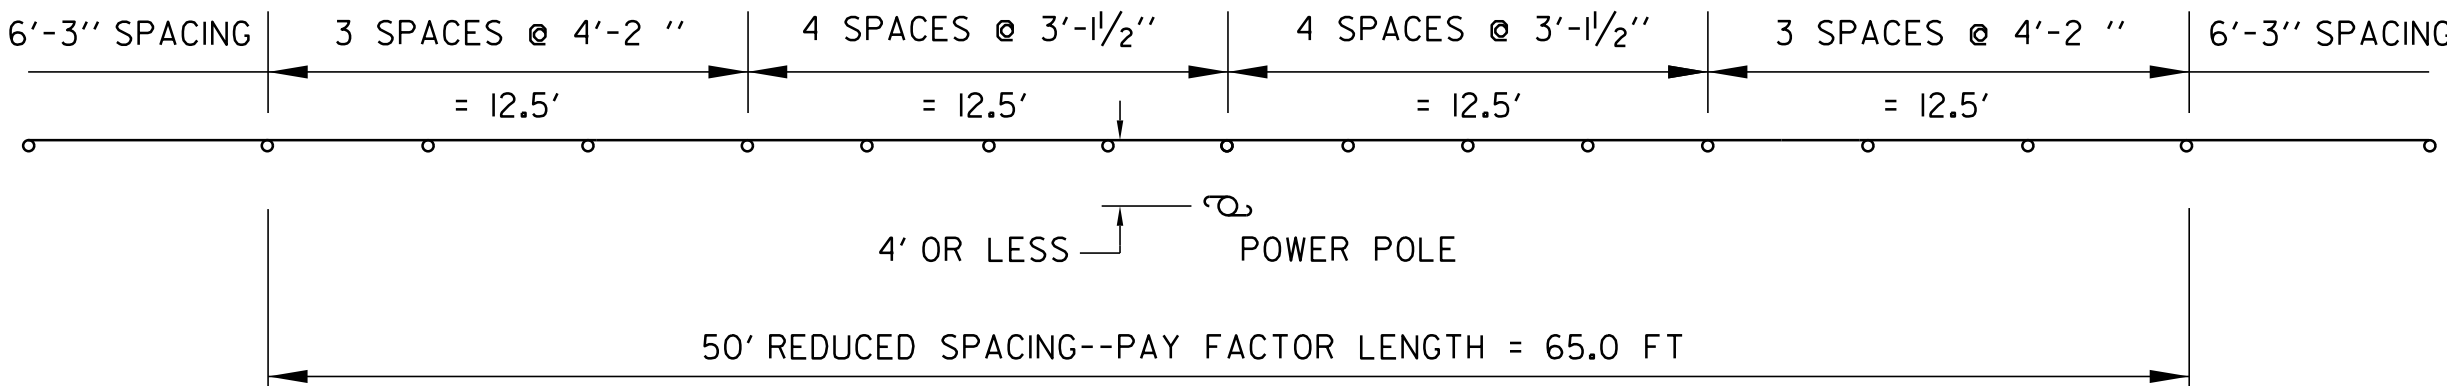

GUARDRAIL DETAIL

(OBJECTS WITHIN 4.0' OF GUARDRAIL)

GUILDHALL
MM 1.322 LT
MM 1.372 LT
MM 4.755 RT
MM 5.315 LT
MM 5.350 LT

MAIDSTONE
MM 5.385 LT
MM 5.890 RT
MM 7.680 RT

NOT TO SCALE

**PROJECT
DETAILS
SHEET**

PROJECT NAME: GUILDHALL-MAIDSTONE
PROJECT NUMBER: STP 2706 (I)

FILE NAME: ...07CI62\...07CI62.dgn
PROJECT LEADER: DOMEY
DESIGNED BY: PAVT MGMT
IPARM FILE NAME: 07CI62_04.i

PLOT DATE: 31-OCT-2011 10:43
DRAWN BY: PAVT MGMT
CHECKED BY: PAVT MGMT
SHEET 4 OF 18