


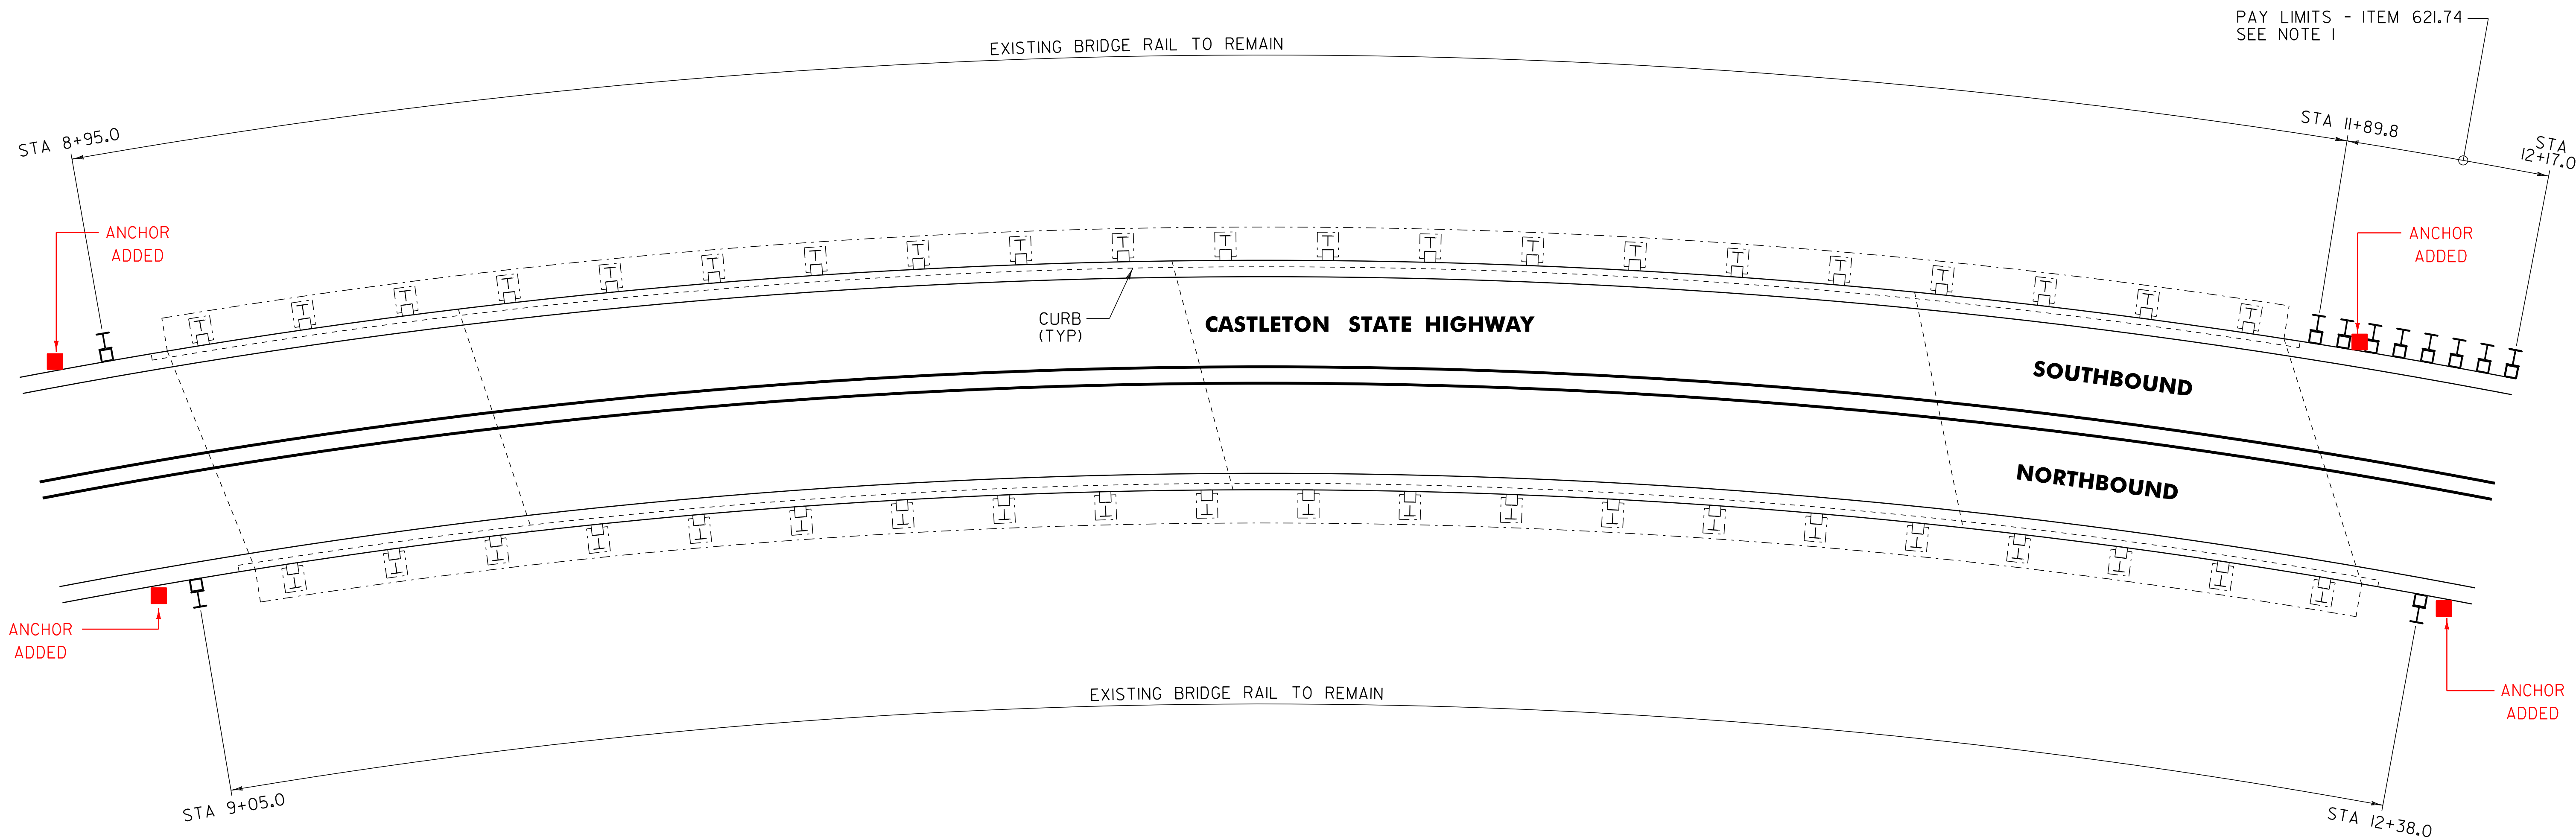

BR 2 CASTLETON STATE HIGHWAY MM 0.201 = STA 10+61.28

NOTE:

1. REFERENCE THIS SHEET ALONG WITH SHEETS 76 THRU 78 FOR ALUMINUM APPROACH RAILING CONNECTION DETAILS.

NOT TO SCALE

**BRIDGE
DETAIL
SHEET #6**

PROJECT NAME: CASTLETON - WEST RUTLAND

PROJECT NUMBER: STP 2705(1)

FILE NAME: p07cl68.dgn

PROJECT LEADER: D.E.G.

DESIGNED BY: M.J.M.

IPARM FILE: p07cl68bd6.i

PLOT DATE: 04-JUN-2013 09:3

DRAWN BY: W.G.P.

CHECKED BY: D.E.G.

SHEET 86 OF 152