

646.402 DURABLE 4 INCH WHITE LINE, THERMOPLASTIC OR
646.403 DURABLE 4 INCH WHITE LINE, EPOXY PAINT OR
646.404 DURABLE 4 INCH WHITE LINE, POLYUREA
(ALL LINES WILL INCLUDE EDGE LINE BREAKS AND
RADIUS FOR TOWN HIGHWAYS)
CASTLETON:
STA 159+25.00 - STA 165+25.00 EDGE LINE LT & RT

646.412 DURABLE 4 INCH YELLOW LINE, THERMOPLASTIC OR
646.413 DURABLE 4 INCH YELLOW LINE, EPOXY PAINT OR
646.414 DURABLE 4 INCH YELLOW LINE, POLYUREA
(ALL LINES WILL INCLUDE C/L BREAKS FOR
TOWN HIGHWAYS) S=SOLID, D=DASHED
CASTLETON:
STA 159+25.00 - STA 165+25.00


LT C RT
S - S

646.602 TEMPORARY 4 INCH WHITE LINE, PAINT
(ALL LINES WILL INCLUDE EDGE LINE BREAKS AND
RADIUS FOR TOWN HIGHWAYS)
CASTLETON:
STA 159+25.00 - STA 165+25.00

LT C RT
S - S

646.442 DURABLE 8 INCH WHITE LINE, THERMOPLASTIC OR
646.443 DURABLE 8 INCH WHITE LINE, EPOXY PAINT OR
646.444 DURABLE 8 INCH WHITE LINE, POLYUREA
CASTLETON:
STA 161+00.0 - STA 161+12.0 FIRE HYDRANT NO PARKING ZONE LT

675.50 REMOVING SIGNS
AS SHOWN - 5 7

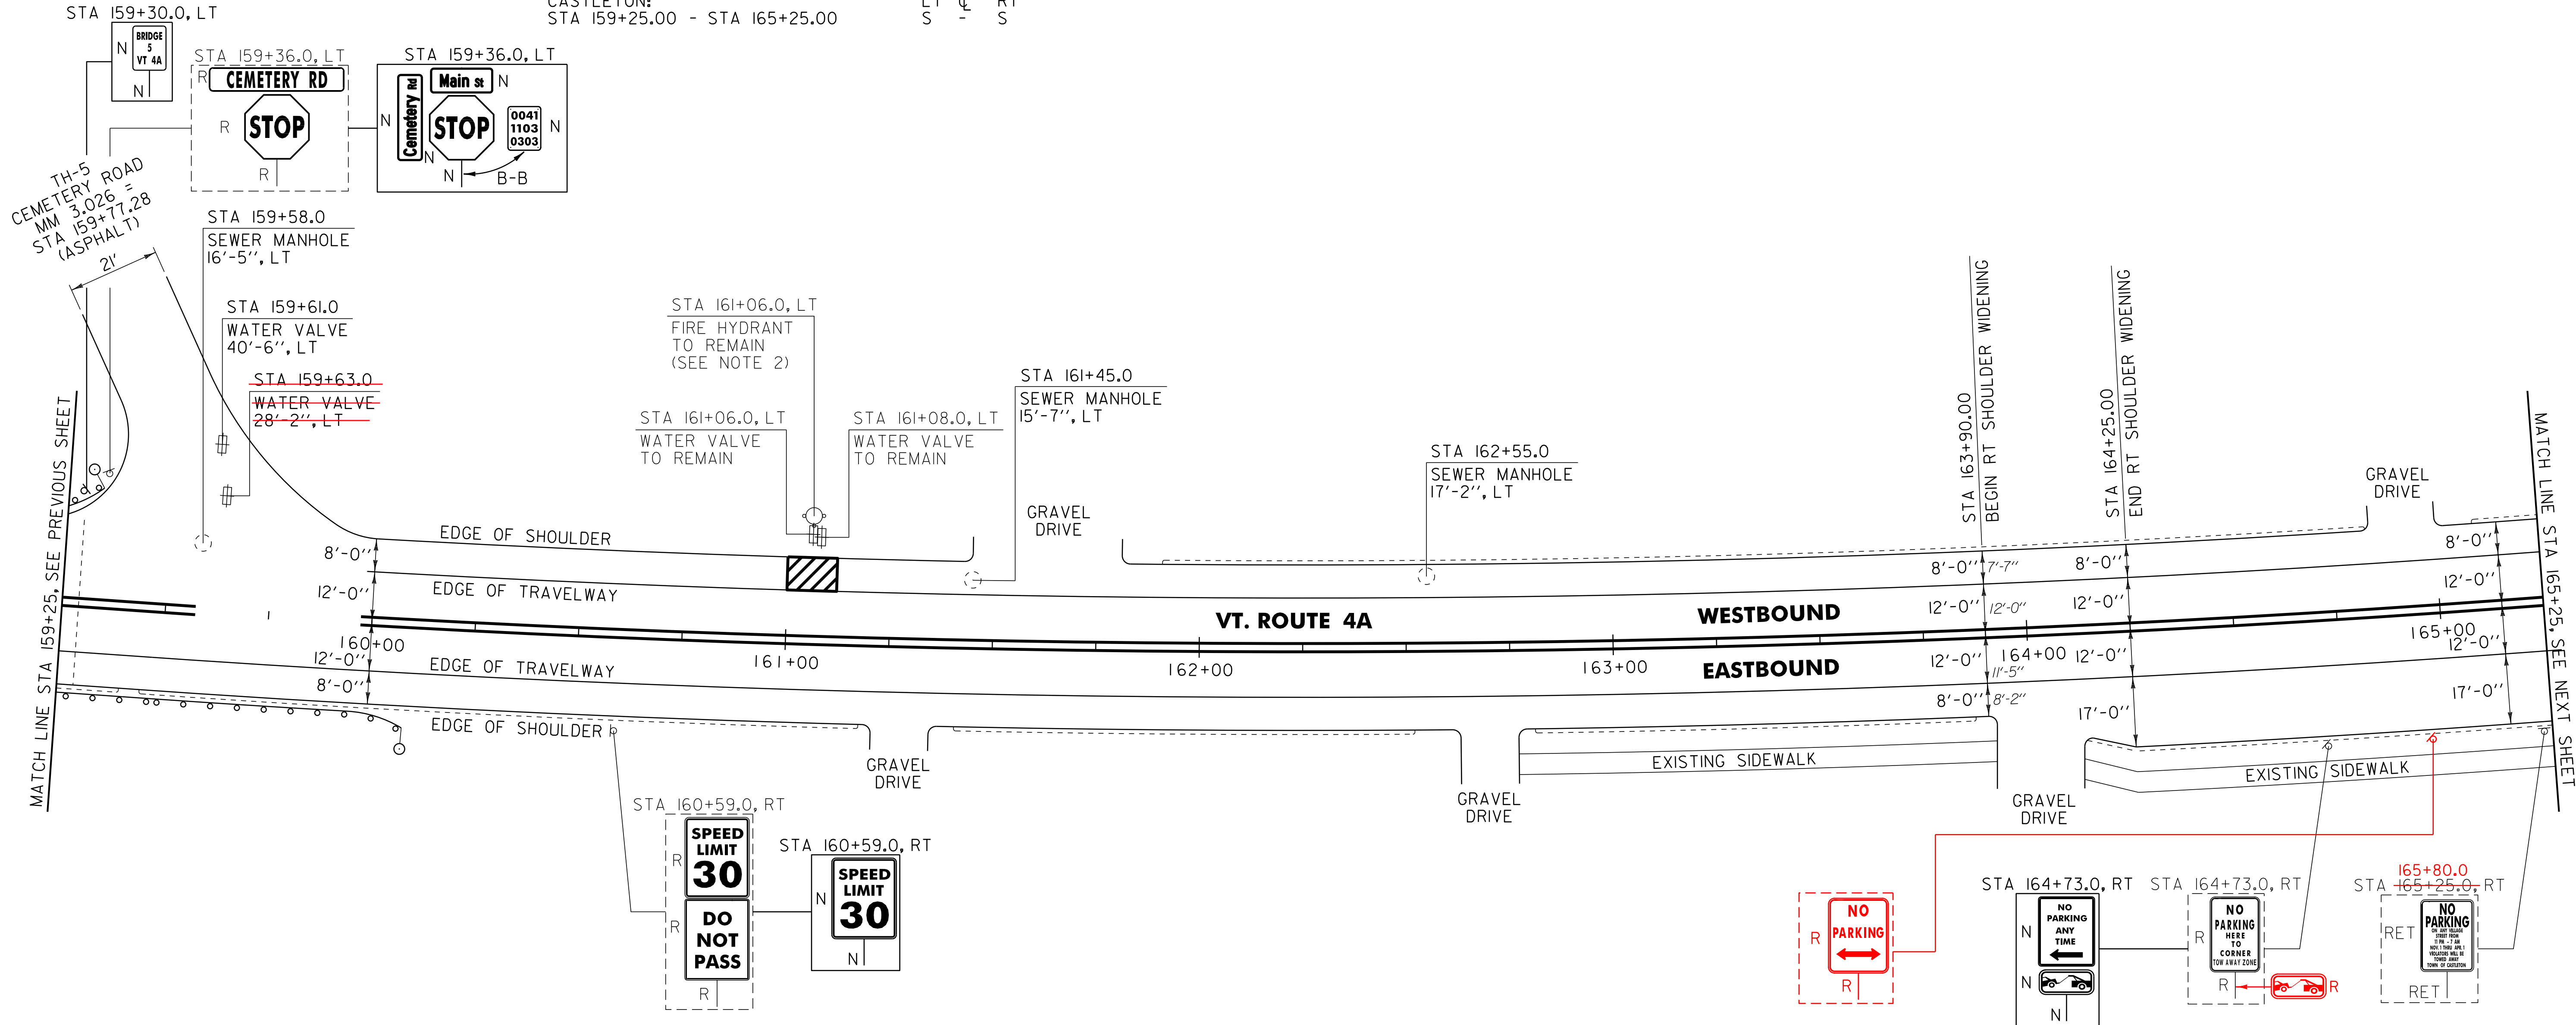

525.10 REMOVAL OF EXISTING RAILING

CASTLETON:
STA 159+25.0 - STA 159+32.5 LT (7.5 LF)
STA 159+25.0 - STA 159+32.5 RT (7.5 LF)

525.50 BRIDGE RAILING REPAIR, TYPE I

CASTLETON:
STA 159+25.0 - STA 159+32.5 LT (7.5 LF)
STA 159+25.0 - STA 159+32.5 RT (7.5 LF)

604.42 CHANGING ELEVATION OF SEWER MANHOLES

CASTLETON:
STA 159+58.0 LT
STA 161+45.0 LT
STA 162+55.0 LT

621.20 STEEL BEAM GUARDRAIL, GALVANIZED

CASTLETON:
STA 159+32.5 - STA 159+47.0 LT (14.5 LF)
STA 159+57.5 - STA 160+09.5 RT (52.0 LF)

621.21HD STEEL BEAM GUARDRAIL, GALVANIZED

CASTLETON:
STA 159+32.5 - STA 159+57.5 RT (32.5 LF)

621.60 ANCHOR FOR STEEL BEAM RAIL

CASTLETON:
STA 159+40.5 LT
STA 160+03.0 RT

621.80 REMOVAL AND DISPOSAL OF GUARDRAIL

CASTLETON:
STA 159+32.5 - STA 159+35.0 LT (2.5 LF)
STA 159+32.5 - STA 160+10.0 RT (77.5 LF)

629.20 ADJUST ELEVATION OF VALVE BOX

CASTLETON:
STA 159+61.0 LT
STA 159+63.0 LT

676.10 DELINEATOR WITH STEEL POST

CASTLETON:
STA 159+47.0 LT
STA 160+09.5 RT

NOTES:

1. PAVING LIMIT ON ALL TOWN HIGHWAYS SHALL BE MEASURED 25 FT BACK FROM VT. ROUTE 4A EDGE OF SHOULDER UNLESS DENOTED OTHERWISE ON THE PLANS OR AS DIRECTED BY THE RESIDENT ENGINEER.

2. SEE SHEET 8 FOR FIRE HYDRANT PAVEMENT MARKING DETAIL.

SIGN LEGEND
R = REMOVE
S = SALVAGE
N = NEW
RET = RETAIN
B-B = BACK TO BACK
EXISTING = _____
NEW = _____

NOT TO SCALE

PROJECT LAYOUT SHEET #3

PROJECT NAME: CASTLETON
PROJECT NUMBER: STP 2908(1)

FILE NAME: p10c210.dgn
PROJECT LEADER: D.E.G.
DESIGNED BY: M.J.M.
IPARM FILE: p10c210I03.i

PLOT DATE: 04-JUN-2013 09:3
DRAWN BY: W.G.P.
CHECKED BY: D.E.G.
SHEET 100 OF 152