

TEMPORARY 4 INCH WHITE LINE, PAINT
DURABLE 4 INCH WHITE LINE (OPTION BID ITEM)
409+25 TO 413+50 SOLID LT & RT

TEMPORARY 4 INCH YELLOW LINE, PAINT
DURABLE 4 INCH YELLOW LINE (OPTION BID ITEM)
409+25 TO 413+50 SOLID LT & RT

STEEL BEAM GUARDRAIL, GALVANIZED
409+31 TO 410+18.5 RT
409+56 TO 410+18.5 LT
411+81 TO 412+43.5 RT
411+81 TO 412+68.5 LT

GUARDRAIL APPROACH SECTION,
GALV HD STEEL BEAM
410+18.5 TO 410+43.5 RT
410+18.5 TO 410+43.5 LT
411+56 TO 411+81 RT
411+56 TO 411+81 LT


DELINEATOR WITH STEEL POST
409+31 RT
409+56 LT
412+43.5 RT
412+68.5 LT

REMOVAL AND DISPOSAL OF GUARDRAIL
409+31 TO 410+43.5 RT
409+58 TO 410+43.5 LT
411+56 TO 412+46 RT
411+56 TO 412+66 LT

ANCHOR FOR STEEL BEAM RAIL
409+31 RT
409+56 LT
412+43.5 RT
412+68.5 LT

REMOVING SIGNS
AS SHOWN - 1

BEGIN VT ROUTE 114
STA 409+25.00 (MM 7.751)
BEGIN COLD PLANE AND OVERLAY

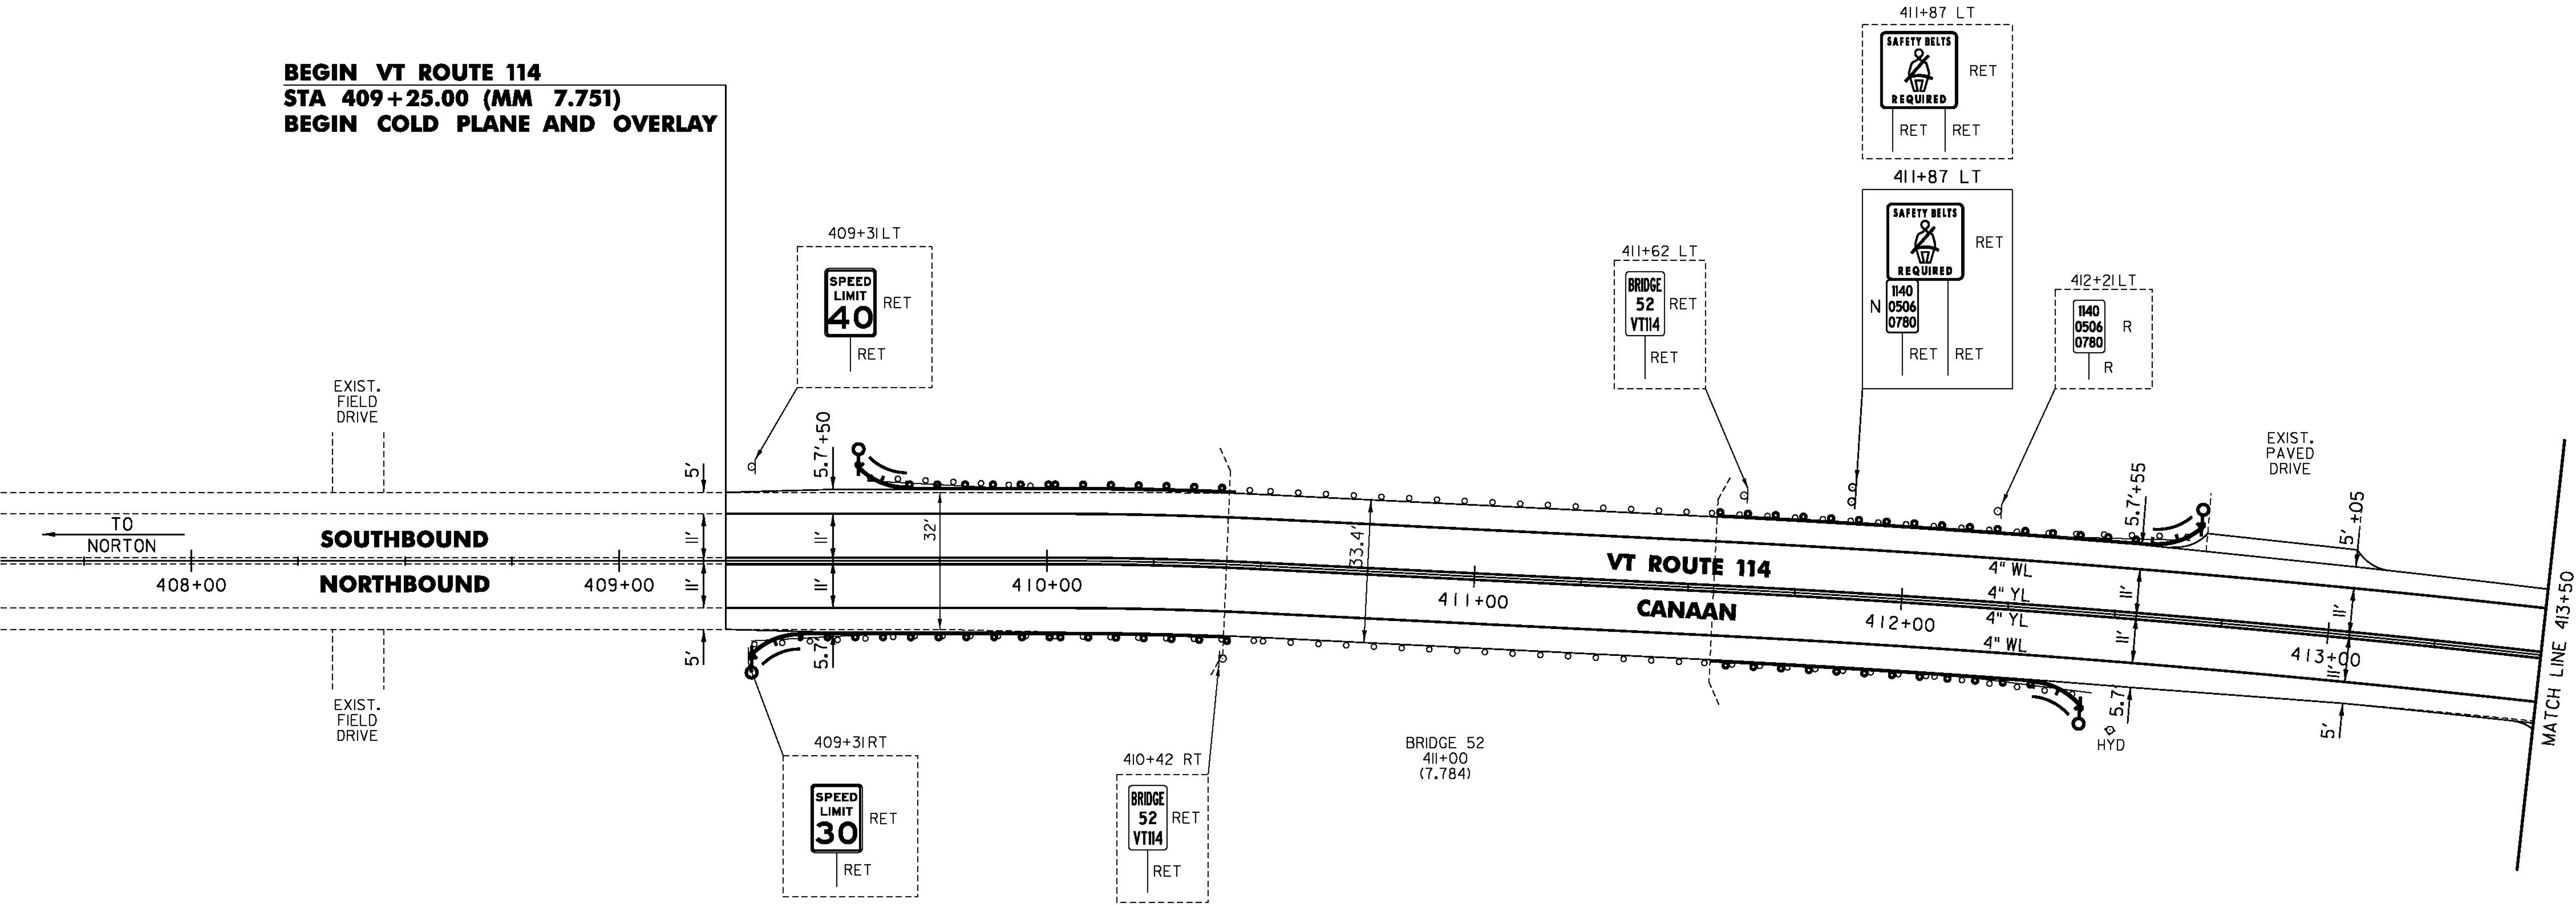

NOT TO SCALE

PROJECT NAME: LEMINGTON-CANAAN
PROJECT NUMBER: STP 2723(1)

FILE NAME: z07c2i4bdr.dgn
PROJECT LEADER: P. SHEDD
DESIGNED BY: N. LEMAY
VT 114 PLAN SHEET 1

PLOT DATE: 2/28/2015
DRAWN BY: W. GORDON
CHECKED BY: P. SHEDD
SHEET 117 OF 162