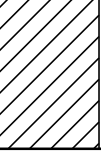


STATE OF VERMONT AGENCY OF TRANSPORTATION										TRAFFIC SIGN SUMMARY SHEET 8																											
MILEMARKER, STATION, OR SIGN NUMBER	SIGN LEGEND	SIGN DIMENSIONS			NEW & SALVAGED SIGNS				EXIST POST RE TAIN S ALV AGE	NO. OF POST S	NEW SIGN POSTS												RE QUI RE D S I G N E E	REMARKS	SIGN DETAIL												
		E A	WIDTH (in)	HEIGHT (in)	“A”	“B”	SALV SIGN	SALV TIS			FLANGED CHANNEL			SQUARE STEEL (in)			TUBULAR ALUMINUM Ø (in)			TUBULAR STEEL Ø (in)					W-SHAPE STEEL			FTG. SIZE	WEIGHT	POST SIZE	DETAIL ON DWG. NUMBER	STD. SHEET NUMBER					
											lb/ft	1.75	2.0	2.5	ANCHOR	SLEEVE	3.0	4.0	4.0 MOD	FOUND- ATION	3.0	3.5			4.0	5.0	24"						30"				
												1.12	2.0	3.0			1.88	2.42	3.35		1.3	1.7			1.7	7.6	9.0						10.8	14.6	24"	30"	
MORGAN: 142+22.0, RT		I	6	8	0.33						I				X			X														SIGN ID CODE VD-701		E-134			
											I				X			X														SIGN ID CODE VD-701		E-134			
											I				X			X														SIGN ID CODE VD-701		E-134			
162+73.0, RT	<table><tr><td>WARREN GORE</td><td>MORGAN</td></tr><tr><td>ESSEX CO</td><td>ORLEANS CO</td></tr></table>	WARREN GORE	MORGAN	ESSEX CO	ORLEANS CO	I	60	7.5	3.13						I					X		X															E-124 E-124
WARREN GORE	MORGAN																																				
ESSEX CO	ORLEANS CO																																				
		I	6	10	0.42																										SIGN ID CODE VD-700		E-138				
		I	6	10	0.42																										SIGN ID CODE VD-700		E-138				
WARREN GORE: 0+60.0, RT		I	30	30	6.25						I				X		X														SIGN ID CODE VW-001		E-153				
		I	24	18	3.00																										SIGN ID CODE W16-4		E-153				
FINAL POST LENGTHS ARE TO BE DETERMINED IN THE FIELD. POST SIZES ARE COMPUTED BASED ON INFORMATION FURNISHED ON THE STANDARD SHEETS AND THE VTRANS "SIGN POST DESIGN GUIDELINE."												LF	LF	LF	LF 56	LF 28	LF		EA.	LB	LB	LB		LB	LB	LB	LB										
												LF			LF 84				LB		EA.	LB			EA.	EA.	LB	TRAFFIC SIGN SUMMARY SHEET #8		PROJECT NAME: BRIGHTON - WARREN GORE PROJECT NUMBER: STP 272400S		FILE NAME: p07c216.dgn PROJECT LEADER: D.E.G. DESIGNED BY: M.J.L. IPARM FILE: p07c216+ss8.i		PLOT DATE: 31-OCT-2011 11:53 DRAWN BY: C.A.K. CHECKED BY: D.W.E. SHEET 65 OF 107			