

604.40 CHANGING ELEVATION OF DROP INLETS,
CATCH BASINS, OR MANHOLES
STA. 82+64 LT (TEL.)

604.412, 604.415, 604.418 REHAB. DROP
INLETS, CATCH BASINS, OR MANHOLES, CLASS I,
CLASS II OR CLASS III
STA. 82+38 RT "TYPE D GRATE"
STA. 82+39 LT "TYPE D GRATE"
STA. 82+74 RT "TYPE D GRATE"

604.42 CHANGING ELEVATION
OF SEWER MANHOLES
STA. 82+09 RT STA. 82+48 LT

629.20 ADJUST ELEVATION OF VALVE BOX
STA. 78+23 LT (WSV) STA. 82+48 LT (GSV)
STA. 78+60 RT (WSV) STA. 82+49 LT (GSV)
STA. 79+85 LT (WSV) STA. 82+50 LT (GSV)
STA. 80+43 RT (GSV) STA. 82+51 LT (GSV)
STA. 81+01 RT (WSV) STA. 82+75 LT (WSV)
STA. 82+23 LT (WSV) STA. 82+91 LT (WSV)
STA. 82+44 LT (WSV)

646.486 DURABLE 24" STOP BAR, RECESSED POLYUREA
STA. 82+37 - STA. 82+54 LT
STA. 82+53 - STA. 82+74 RT
STA. 82+86 LT & RT

646.682 TEMPORARY 24" STOP BAR, PAINT
STA. 82+37 - STA. 82+54 LT
STA. 82+53 - STA. 82+74 RT
STA. 82+86 LT & RT

646.491 DURABLE LETTER OR SYMBOL, TYPE I TAPE
STA. 81+95 LT ARROW STA. 82+07 LT BIKE


646.692 TEMPORARY LETTER OR SYMBOL, PAINT
STA. 81+95 LT ARROW STA. 82+07 LT BIKE

646.406 DURABLE 4" WHITE LINE, RECESSED POLYUREA
STA. 77+50 - STA. 82+26 (SOLID LT)
STA. 82+80 - STA. 83+50 (SOLID LT)
STA. 83+01 - STA. 83+50 (SOLID RT)
646.602 TEMPORARY 4" WHITE LINE, PAINT
STA. 77+50 - STA. 82+26 (SOLID LT)
STA. 82+80 - STA. 83+50 (SOLID LT)
STA. 83+01 - STA. 83+50 (SOLID RT)
646.426 DURABLE 6" WHITE LINE, RECESSED POLYUREA
STA. 77+50 - STA. 82+26 (SOLID LT)
STA. 82+80 - STA. 83+50 (SOLID LT)

646.622 TEMPORARY 6" WHITE LINE, PAINT
STA. 77+50 - STA. 82+26 (SOLID LT)
STA. 82+80 - STA. 83+50 (SOLID LT)

646.416 DURABLE 4" YELLOW LINE, RECESSED POLYUREA
STA. 82+53 RT (CENTERLINE NORTH ST.)
STA. 82+54 LT (CENTERLINE NORTH ST.)

646.612 TEMPORARY 4" YELLOW LINE, PAINT
STA. 82+53 RT (CENTERLINE NORTH ST.)
STA. 82+54 LT (CENTERLINE NORTH ST.)

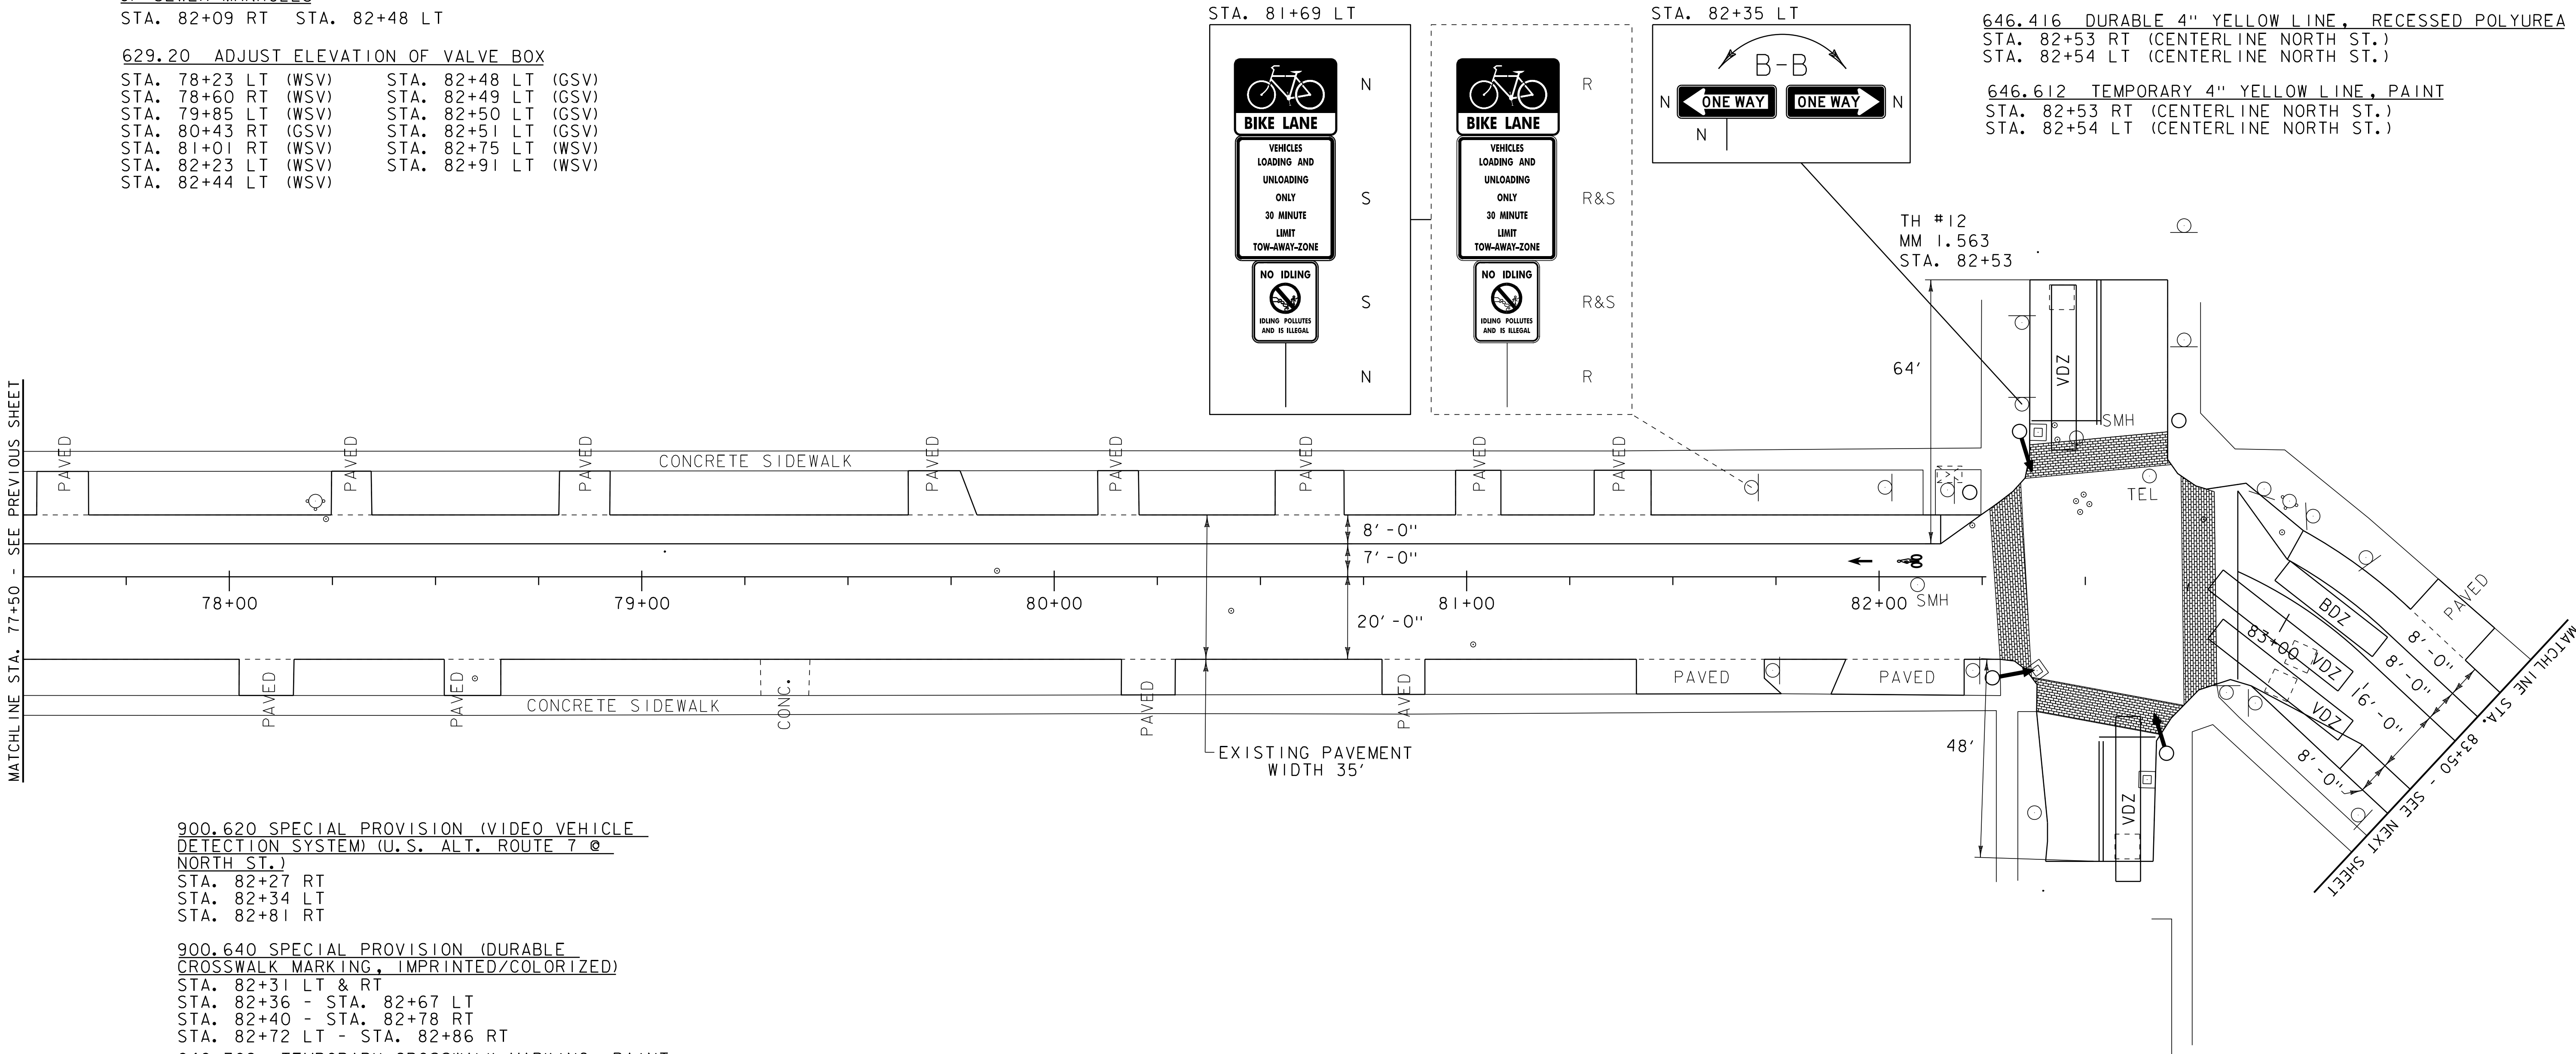

900.620 SPECIAL PROVISION (VIDEO VEHICLE
DETECTION SYSTEM) (U.S. ALT. ROUTE 7 @
NORTH ST.)
STA. 82+27 RT
STA. 82+34 LT
STA. 82+81 RT

900.640 SPECIAL PROVISION (DURABLE
CROSSWALK MARKING, IMPRINTED/COLORIZED)
STA. 82+31 LT & RT
STA. 82+36 - STA. 82+67 LT
STA. 82+40 - STA. 82+78 RT
STA. 82+72 LT - STA. 82+86 RT
646.702 TEMPORARY CROSSWALK MARKING, PAINT
STA. 82+31 LT & RT
STA. 82+36 - STA. 82+67 LT
STA. 82+40 - STA. 82+78 RT
STA. 82+72 LT - STA. 82+86 RT

675.50 REMOVING SIGNS
AS SHOWN - 3
675.60 ERECTING SALVAGED SIGNS
AS SHOWN - 2

LEGEND	
	HYDRANT
	MANHOLE
	VALVE
	GAS PIPELINE MARKER
	CATCH BASIN / DROP INLET
	CURB INLET
	TRAFFIC CONTROL BOX
	PARKING METER
	VIDEO DETECTION ZONE
	VIDEO DETECTION ZONE (BIKE LANE)
	VIDEO CAMERA

SIGN LEGEND	
R	= REMOVE
R&S	= REMOVE AND SALVAGE
RET	= RETAIN
S	= SALVAGE
N	= NEW
B-B	= BACK TO BACK

NOT TO SCALE

PROJECT
LAYOUT
SHEET 14

PROJECT NAME: BURLINGTON (CLASS I)
PROJECT NUMBER: STP 2722 (I)

FILE NAME: 07d028.dgn	PLOT DATE: 05-JUN-2014 11:20
PROJECT LEADER: EPD	DRAWN BY: SJL
DESIGNED BY: CDL	CHECKED BY: EPD
PLOT FILE: 07d028.28.i	SHEET 28 OF 61