

INDEX OF SHEETS

SEE SHEET 2 OF 62

STATE OF VERMONT AGENCY OF TRANSPORTATION



PROPOSED IMPROVEMENT CITY OF NEWPORT AND VILLAGE OF DERBY COUNTY OF ORLEANS


**NEWPORT CITY
STP 2719(1)
ALT U.S. ROUTE 5**

SEE SHEET 6 OF 62


**DERBY
STP 2703(1)
U.S. ROUTE 5 &
ALT U.S. ROUTE 5**

SEE SHEET 25 OF 62

**PROJECT LOCATION
STP 2719(1)
STP 2703(1)**

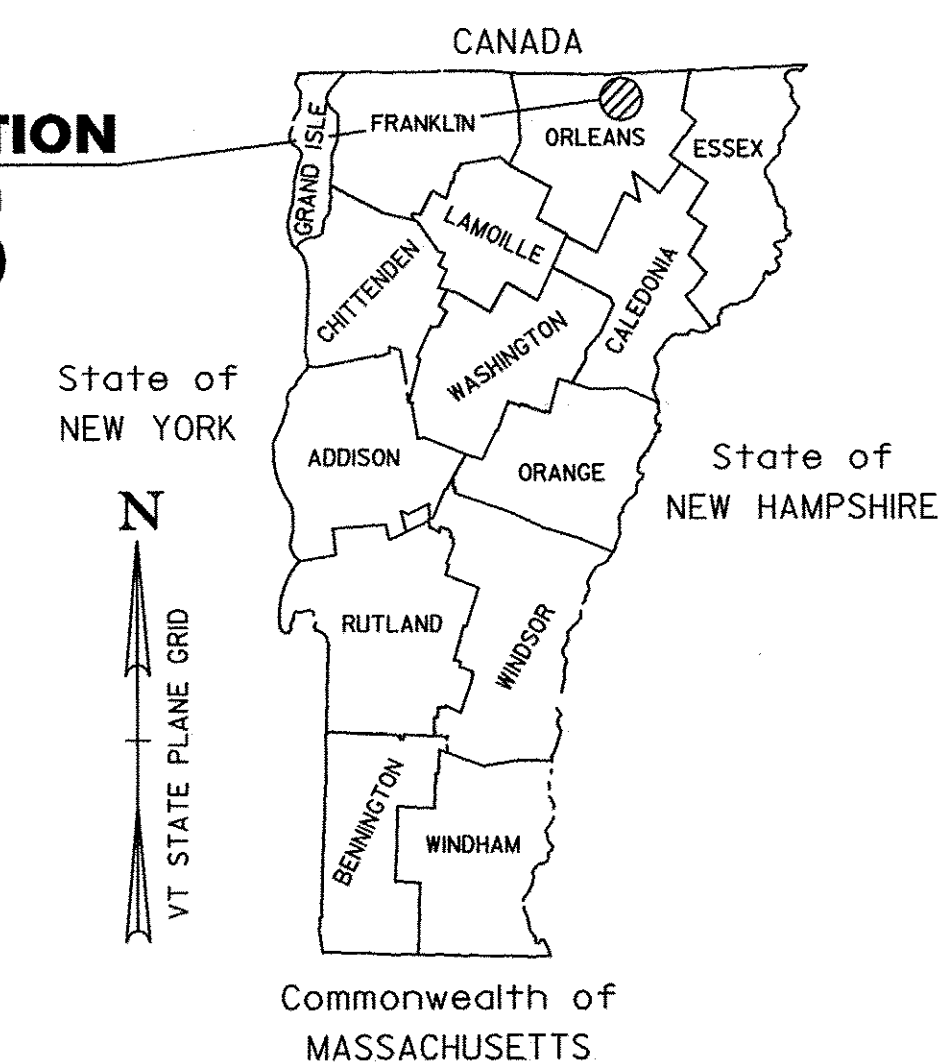

RECORD PLANS	
CONTRACTOR:	PIKE INDUSTRIES, INC. - BERLIN, VT
RESIDENT ENGINEER:	SETH HISMAN
CONSTRUCTION BEGAN:	AUGUST 2, 2010
CONSTRUCTION COMPLETE:	JUNE 22, 2011
RECORD PLANS BY:	SETH HISMAN & JENNA HYDE
I HEREBY CERTIFY THAT ALL THE CONSTRUCTION REQUIRED BY THIS SET OF DRAWINGS HAS BEEN ACCOMPLISHED AS INDICATED HEREIN.	
BY: <i>Seth Hisman</i>	RESIDENT ENGINEER
DATE: 1/16/13	
NOTE: Any further information concerning final quantities, amounts or other details relative to this project may be found at Central Files in the electronic archives.	

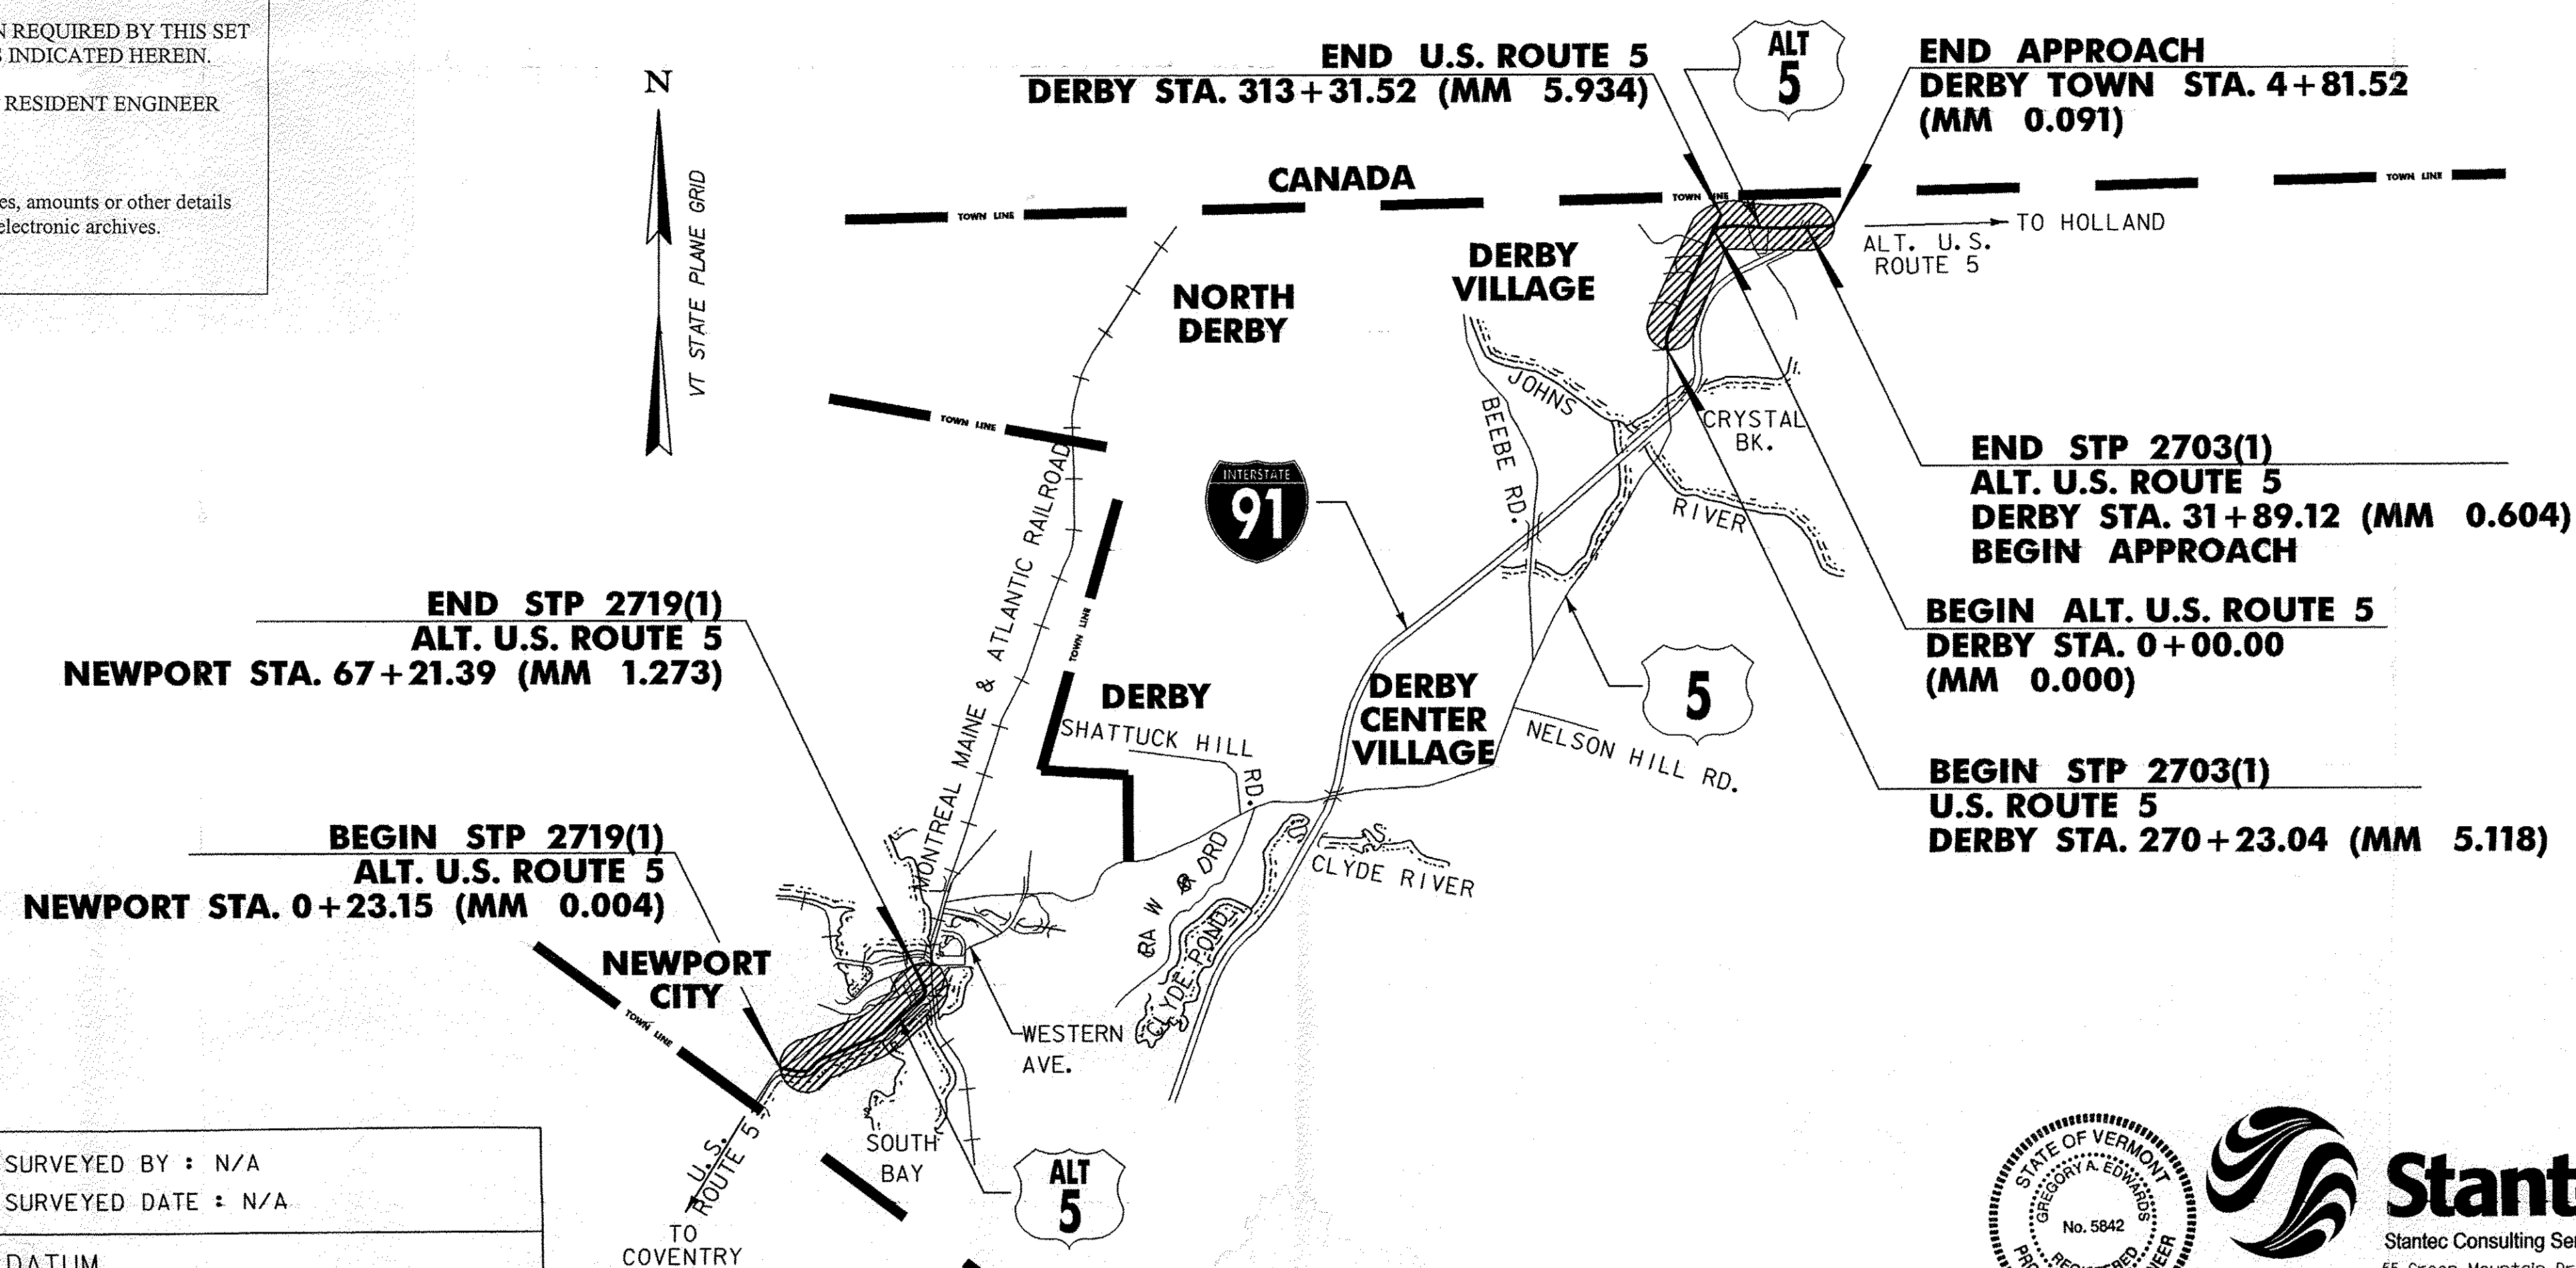

COUNTY LINE	
TOWN LINE	
LIMITS OF ACCESS	
POINT OF ACCESS	
FENCE LINE	
STONE WALL	
TRAVELED WAY	
GUARD RAIL	
RAILROAD	
SURVEY LINE	
CULVERT	
POWER POLE	
TELEPHONE POLE	
TREES	
CONTROL OF ACCESS	
PROPERTY LINE	
R.O.W. TAKING LINE	
SLOPE RIGHTS	
TOP OF CUT	
TOE OF SLOPE	

SURVEYED BY : N/A
SURVEYED DATE : N/A

DATUM
VERTICAL N/A
HORIZONTAL N/A



NOTES:

RIGHT-OF-WAY LIMITS, IF APPLICABLE, ARE PROVIDED SOLELY FOR THE CONVENIENCE OF THE STATE AND ITS CONTRACTOR DURING THE COURSE OF THIS PAVING PROJECT. ANY REFERENCES TO OFFSETS ON THESE PLANS ARE APPROXIMATE AND SHOULD NOT BE RELIED UPON FOR ANY PURPOSES.

THESE PLANS ARE SUBJECT TO SUCH ENGINEERING CHANGES AS MAY BE REQUIRED BY THE FEDERAL HIGHWAY ADMINISTRATION OR THE DIRECTOR OF PROGRAM DEVELOPMENT.

CONSTRUCTION IS TO BE CARRIED ON IN ACCORDANCE WITH THESE PLANS AND THE STANDARD SPECIFICATIONS FOR CONSTRUCTION DATED 2006, AS APPROVED BY THE FEDERAL HIGHWAY ADMINISTRATION ON JUNE 15, 2006 FOR USE ON THIS PROJECT, INCLUDING ALL SUBSEQUENT REVISIONS AND SUCH REVISED SPECIFICATIONS AND SPECIAL PROVISIONS AS ARE INCORPORATED IN THESE PLANS.

UNLESS OTHERWISE NOTED, ALL DRAWINGS AND DETAILS ON THESE PLANS ARE DRAWN 'NOT TO SCALE'.

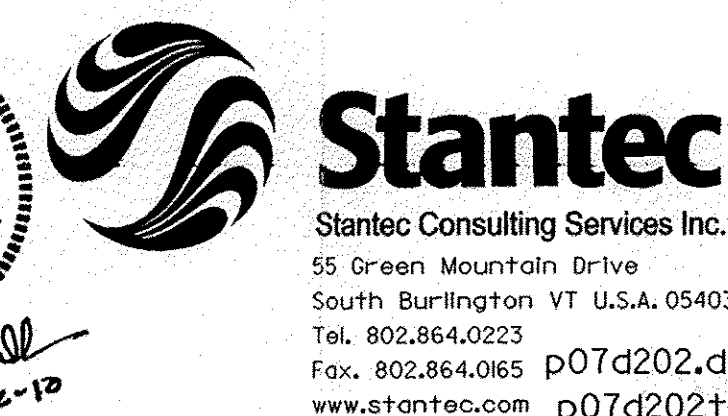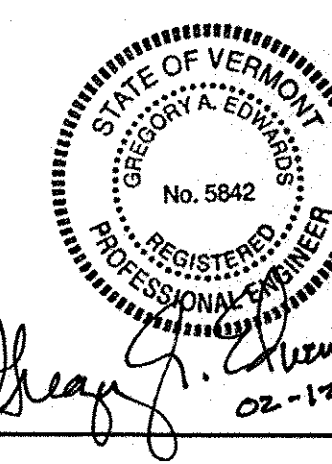

DIRECTOR OF PROGRAM DEVELOPMENT	
APPROVED: <i>Kevin Marsha</i>	DATE: 2/22/10
PROJECT MANAGER : KEVIN MARSHIA	
PROJECT NAME : NEWPORT CITY / DERBY	
PROJECT NUMBER : STP 2719(1) / STP 2703(1)	
SHEET 1 OF 62 SHEETS	

INDEX OF SHEETS

1	COMPOSITE TITLE SHEET
2	COMPOSITE INDEX OF SHEETS & VAOT STANDARDS
3-5	COMPOSITE QUANTITY SHEETS

NEWPORT STP 2719(1) ALT. U.S. ROUTE 5

6	TITLE SHEET
7	PROJECT TYPICAL SHEET
8-9	QUANTITY SHEETS
10	ITEM DETAIL SUMMARY SHEET
11	DRIVE DETAIL SHEET
12-19	PROJECT LAYOUT SHEETS
20-21	TRAFFIC SIGN SUMMARY SHEETS
22	VEHICLE LOOP DETECTOR DETAIL SHEET
23	MISCELLANEOUS DETAIL SHEET
24	TEMPORARY TRAFFIC CONTROL PLAN

DERBY STP 2703(1) U.S. ROUTE 5 /ALT. U.S. ROUTE 5

25	TITLE SHEET
26-27	PROJECT TYPICAL SHEETS
28	ASPHALTIC PLUG JOINT DETAILS SHEET
29-30	QUANTITY SHEETS
31-32	ITEM DETAIL SUMMARY SHEETS
33	DRIVE DETAIL SHEET
34-47	PROJECT LAYOUT SHEETS
48-53	TRAFFIC SIGN SUMMARY SHEETS
54-55	BRIDGE DETAIL SHEETS
56-57	ALUMINUM APPROACH RAILING DETAIL SHEETS
58	MISCELLANEOUS DETAIL SHEET
59	PAVEMENT MARKING DETAIL SHEET
60	STRUCTURE LOCATIONS SHEET
61	FRENCH CONSTRUCTION SIGN DETAIL SHEET
62	TEMPORARY TRAFFIC CONTROL PLAN

VAOT STANDARDS

C-2A	10-14-05
C-2B	10-14-05
C-3A	03-10-08
C-3B	03-10-08
C-10	02-11-08
D-8	01-03-00
D-9	06-01-94
D-15	06-01-94
D-16	06-01-94
E-100	01-02-04
E-100A	01-02-04
E-101	05-30-03
E-102	06-30-03
E-102A	05-01-04
E-103	03-01-04
E-106	03-01-04
E-107	06-30-03
E-107A	06-08-09
E-108	06-08-09
E-108A	06-08-09
E-110	08-08-95
E-120	08-08-95
E-121	08-08-95
E-136A	08-08-95
E-138	05-30-03
E-143	06-15-04
E-145A	12-23-94
E-150	05-01-04
E-152	05-01-04
E-164	06-08-09
E-172	08-09-95
E-191	02-01-99
E-192	10-12-00
E-193	08-18-95
G-1	01-03-2000
G-1d	01-03-2000
G-19	11-15-02
ESFM	07-10-97
PSF-3M	07-10-97

NOT TO SCALE

COMPOSITE INDEX OF SHEETS & VAOT STANDARDS

PROJECT NAME:	NEWPORT CITY / DERBY
PROJECT NUMBER:	STP 2719(1) / STP 2703(1)

FILE NAME: 07D202.dgn	PLOT DATE: 29-JAN-2013 09:2
PROJECT LEADER: JLL	DRAWN BY: STANTEC
DESIGNED BY: MCF	CHECKED BY: JLL
IPARM FILE: 07D202_02.i	SHEET 2 OF 62

COMPOSITE QUANTITY SHEET 1

				NEWPORT CITY STP 2719 (I)			DERBY STP 2703 (I)				TOTALS		DESCRIPTIONS					DETAILED SUMMARY OF QUANTITIES		
				ROADWAY	EROSION CONTROL	FULL C.E.	ROADWAY	BRIDGE	EROSION CONTROL	FULL C.E.	GRAND TOTAL	FINAL	UNIT	ITEMS	ITEM NO.	ROUND	QUANTITIES	UNIT	ITEMS	
				9			38				47		CY	COMMON EXCAVATION	203.15	-				
				6			17				23		CY	SOLID ROCK EXCAVATION	203.16	-				
				730							730		LF	SHOULDER BERM REMOVAL	203.40	-				
				1			1				2		CY	TRENCH EXCAVATION OF EARTH, EXPLORATORY (N.A.B.I.)	204.22	-				
				25000			31400				56400		SY	COLD PLANING, BITUMINOUS PAVEMENT	210.10	-				
				8			30				38		CY	SUBBASE OF CRUSHED GRAVEL, FINE GRADED	301.26	-				
				13			43				56		TON	AGGREGATE SHOULDERS, RAP	402.13	-				
				104			132				236		CWT	EMULSIFIED ASPHALT	404.65	-				
				1			1				2		LU	PRICE ADJUSTMENT, ASPHALT CEMENT (N.A.B.I.)	406.50	-				
				3100			3950				7050		TON	SUPERPAVE BITUMINOUS CONCRETE PAVEMENT	490.30	-				
				1			1				2		LU	AIR VOIDS PAY ADJUSTMENT (N.A.B.I.)	490.31	-				
								70			70		LF	BRIDGE EXPANSION JOINT, ASPHALTIC PLUG	516.10	-				
								100			100		CF	RAPID SETTING CONCRETE REPAIR MATERIAL WITH COARSE AGGREGATE	580.20	-				
				1			1				2		EA	CHANGING ELEVATION OF DROP INLETS, CATCH BASINS, OR MANHOLES	604.40	-				
				3			11				14		EA	REHAB. DROP INLETS, CATCH BASINS, OR MANHOLES, CLASS I	604.412	-				
				2			11				13		EA	REHAB. DROP INLETS, CATCH BASINS, OR MANHOLES, CLASS II	604.415	-				
				2			11				13		EA	REHAB. DROP INLETS, CATCH BASINS, OR MANHOLES, CLASS III	604.418	-				
				20			26				46		EA	CHANGING ELEVATION OF SEWER MANHOLES	604.42	-				
				70			80				150		HR	POWER GRADER RENTAL	608.15	-				
				70			80				150		HR	ALL PURPOSE EXCAVATOR RENTAL, TYPE I	608.25	-				
				25			25				50		HR	POWER BROOM RENTAL, TYPE I	608.30	-				
				40			40				80		HR	POWER BROOM RENTAL, TYPE II	608.31	-				
				40			40				80		HR	TRUCK RENTAL	608.37	-				
				40			40				80		HR	LOADER RENTAL, TYPE I	608.40	-				
				70			45				115		LF	CAST-IN-PLACE CONCRETE CURB, TYPE B	616.28	-				
				70			45				115		LF	REMOVAL OF EXISTING CURB	616.41	-				
							4.5				4.5		TON	BITUMINOUS CONCRETE GUTTERS AND TRAFFIC ISLANDS	616.47	-				
				45			180				225		SY	PORTLAND CEMENT CONCRETE SIDEWALK, 5 INCH	618.10	-				
				50			300				350		SF	DETECTABLE WARNING SURFACE	618.30	-				
				23			18				41		EA	YIELDING MARKER POSTS	619.17	-				
							280				280		LF	SNOW BARRIER, GALVANIZED	620.75	-				
				375			1000				1375		LF	STEEL BEAM GUARDRAIL, GALVANIZED	621.20	-				
				2			4				6		EA	ANCHOR FOR STEEL BEAM RAIL	621.60	-				
							100				100		LF	ALUMINUM APPROACH RAILING	621.74	-	PROJECT NAME: NEWPORT CITY / DERBY PROJECT NUMBER: STP 2719(I) / STP 2703(I) FILE NAME: 07D202.dgn PROJECT LEADER: JLL DESIGNED BY: STANTEC IPARM FILE: 07D202_03.I PLOT DATE: 29-JAN-2013 09:2 DRAWN BY: STANTEC CHECKED BY: JLL SHEET 3 OF 62			
				315			1073				1388		LF	REMOVAL AND DISPOSAL OF GUARDRAIL	621.80	-				
				4			14				18		EA	ADJUST ELEVATION OF VALVE BOX	629.20	-				
				960			1340				2300		HR	UNIFORMED TRAFFIC OFFICERS	630.10	-				

COMPOSITE QUANTITY SHEET 2

				NEWPORT CITY STP 2719 (I)			DERBY STP 2703 (I)				TOTALS		DESCRIPTIONS					DETAILED SUMMARY OF QUANTITIES		
				ROADWAY	EROSION CONTROL	FULL C.E.	ROADWAY	BRIDGE	EROSION CONTROL	FULL C.E.	GRAND TOTAL	FINAL	UNIT	ITEMS	ITEM NO.	ROUND	QUANTITIES	UNIT	ITEMS	
				2880			4020				6900		HR	FLAGGERS	630.15	-				
						0.5				0.5	1		LS	FIELD OFFICE, ENGINEERS	631.10	-				
						0.5				0.5	1		LS	TESTING EQUIPMENT, CONCRETE	631.16	-				
						0.5				0.5	1		LS	TESTING EQUIPMENT, BITUMINOUS	631.17	-				
						0.5				0.5	1		LU	FIELD OFFICE TELEPHONE (N.A.B.I.)	631.25	-				
				0.5			0.5				1		LS	MOBILIZATION/DEMOBILIZATION	635.11	-				
				1							1		LS	TRAFFIC CONTROL (STP 2719 (I))	641.10	-				
							1				1		LS	TRAFFIC CONTROL (STP 2703 (I))	641.10	-				
				0.5			0.5				1		LS	PUBLIC RELATIONS OFFICER	641.12	-				
							2				2		EA	PORTABLE CHANGEABLE MESSAGE SIGN	641.15	-				
				13100							13100		LF	4 INCH WHITE LINE	646.20	-				
				13300							13300		LF	4 INCH YELLOW LINE	646.21	-				
				75							75		LF	24 INCH STOP BAR	646.26	-				
				21							21		EA	LETTER OR SYMBOL	646.30	-				
				120							120		LF	CROSSWALK MARKING	646.31	-				
							16900				16900		LF	DURABLE 4 INCH WHITE LINE, THERMOPLASTIC	646.402	-				
							15300				15300		LF	DURABLE 4 INCH YELLOW LINE, THERMOPLASTIC	646.412	-				
							240				240		LF	DURABLE 24 INCH STOP BAR, THERMOPLASTIC	646.482	-				
							115				115		EA	DURABLE LETTER OR SYMBOL, THERMOPLASTIC	646.492	-				
							1040				1040		LF	DURABLE CROSSWALK MARKING, THERMOPLASTIC	646.502	-				
				26200			33800				60000		LF	TEMPORARY 4 INCH WHITE LINE, PAINT	646.602	-				
				26600			30700				57300		LF	TEMPORARY 4 INCH YELLOW LINE, PAINT	646.612	-				
				150			480				630		LF	TEMPORARY 24 INCH STOP BAR, PAINT	646.682	-				
				42			230				272		EA	TEMPORARY LETTER OR SYMBOL, PAINT	646.692	-				
				240			2070				2310		LF	TEMPORARY CROSSWALK MARKING, PAINT	646.702	-				
				680			940				1620		EA	LINE STRIPING TARGETS	646.76	-				
					40				40		80		LB	SEED	651.15	-				
					250				250		500		LB	FERTILIZER	651.18	-				
					1				1		2		TON	AGRICULTURAL LIMESTONE	651.20	-				
					1				1		2		TON	HAY MULCH	651.25	-				
					25				25		50		CY	TOPSOIL	651.35	-				
					200				200		400		SY	TEMPORARY EROSION MATTING	653.20	-				
				71			245				316		SF	TRAFFIC SIGNS, TYPE A	675.20	-				
				150			485				635		LF	SQUARE TUBE SIGN POST AND ANCHOR	675.341	-	PROJECT NAME: NEWPORT CITY / DERBY PROJECT NUMBER: STP 2719(I) / STP 2703(I) FILE NAME: 07D202.dgn PROJECT LEADER: JLL DESIGNED BY: STANTEC IPARM FILE: 07D202_04.I PLOT DATE: 29-JAN-2013 09:2 DRAWN BY: STANTEC CHECKED BY: JLL SHEET 4 OF 62			
				8			47				55		EA	REMOVING SIGNS	675.50	-				
				3			16				19		EA	ERECTING SALVAGED SIGNS	675.60	-				
				2			4				6		EA	DELINEATOR WITH STEEL POST	676.10	-				

STATE OF VERMONT
AGENCY OF TRANSPORTATION





PROPOSED IMPROVEMENT
CLASS 1 TOWN HIGHWAY
CITY OF NEWPORT
COUNTY OF ORLEANS
ALT. U.S. ROUTE 5

BEGINNING IN THE CITY OF NEWPORT NEAR THE INTERSECTION OF PLEASANT STREET (U.S. ROUTE 5) AT STA. 0+23.15 (MM 0.004) AND EXTENDING NORTHERLY ALONG ALT. U.S. ROUTE 5 FOR A DISTANCE OF 6698.24 FEET (1.269 MILES) TO THE INTERSECTION OF WEST MAIN STREET (U.S. ROUTE 5) AT STA 67+21.39 (MM 1.273).

PROJECT DATA:	LENGTH (FEET)	LENGTH (MILES)
CITY OF NEWPORT ALT. U.S. ROUTE 5 STA. 0+23.15 TO 67+21.39 MM 0.004 TO 1.273	6698.24	1.269
TOTAL LENGTH OF PROJECT:	6698.24	1.269
TOTAL LENGTH OF ROADWAY:	6698.24	1.269

WORK TO BE PERFORMED UNDER THIS PROJECT INCLUDES COLD PLANING AND RESURFACING OF THE EXISTING HIGHWAY WITH A LEVELING COURSE AND WEARING COURSE, NEW PAVEMENT MARKINGS, GUARD RAIL, SIGNS AND OTHER INCIDENTAL ITEMS

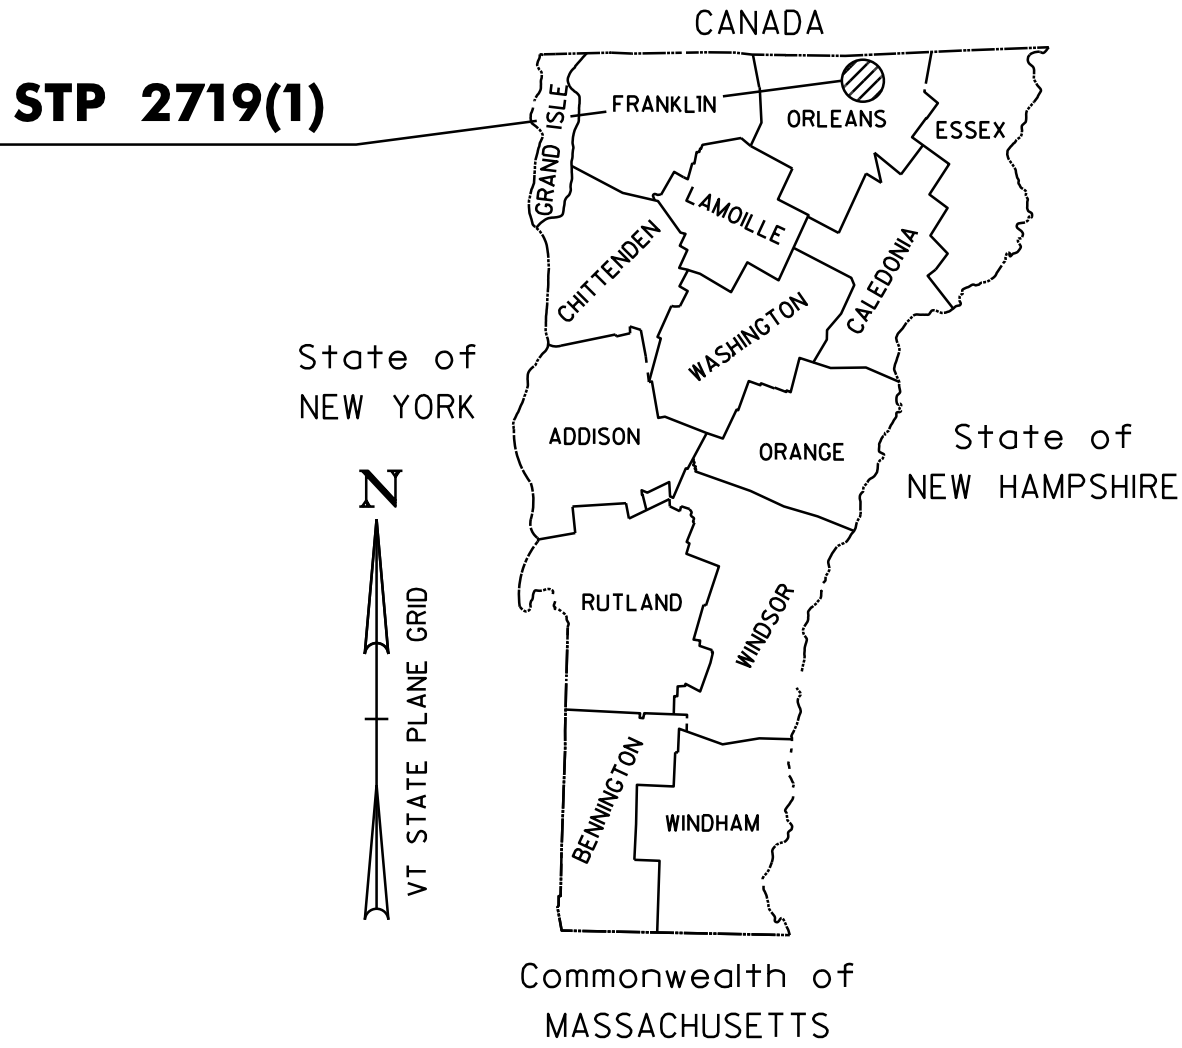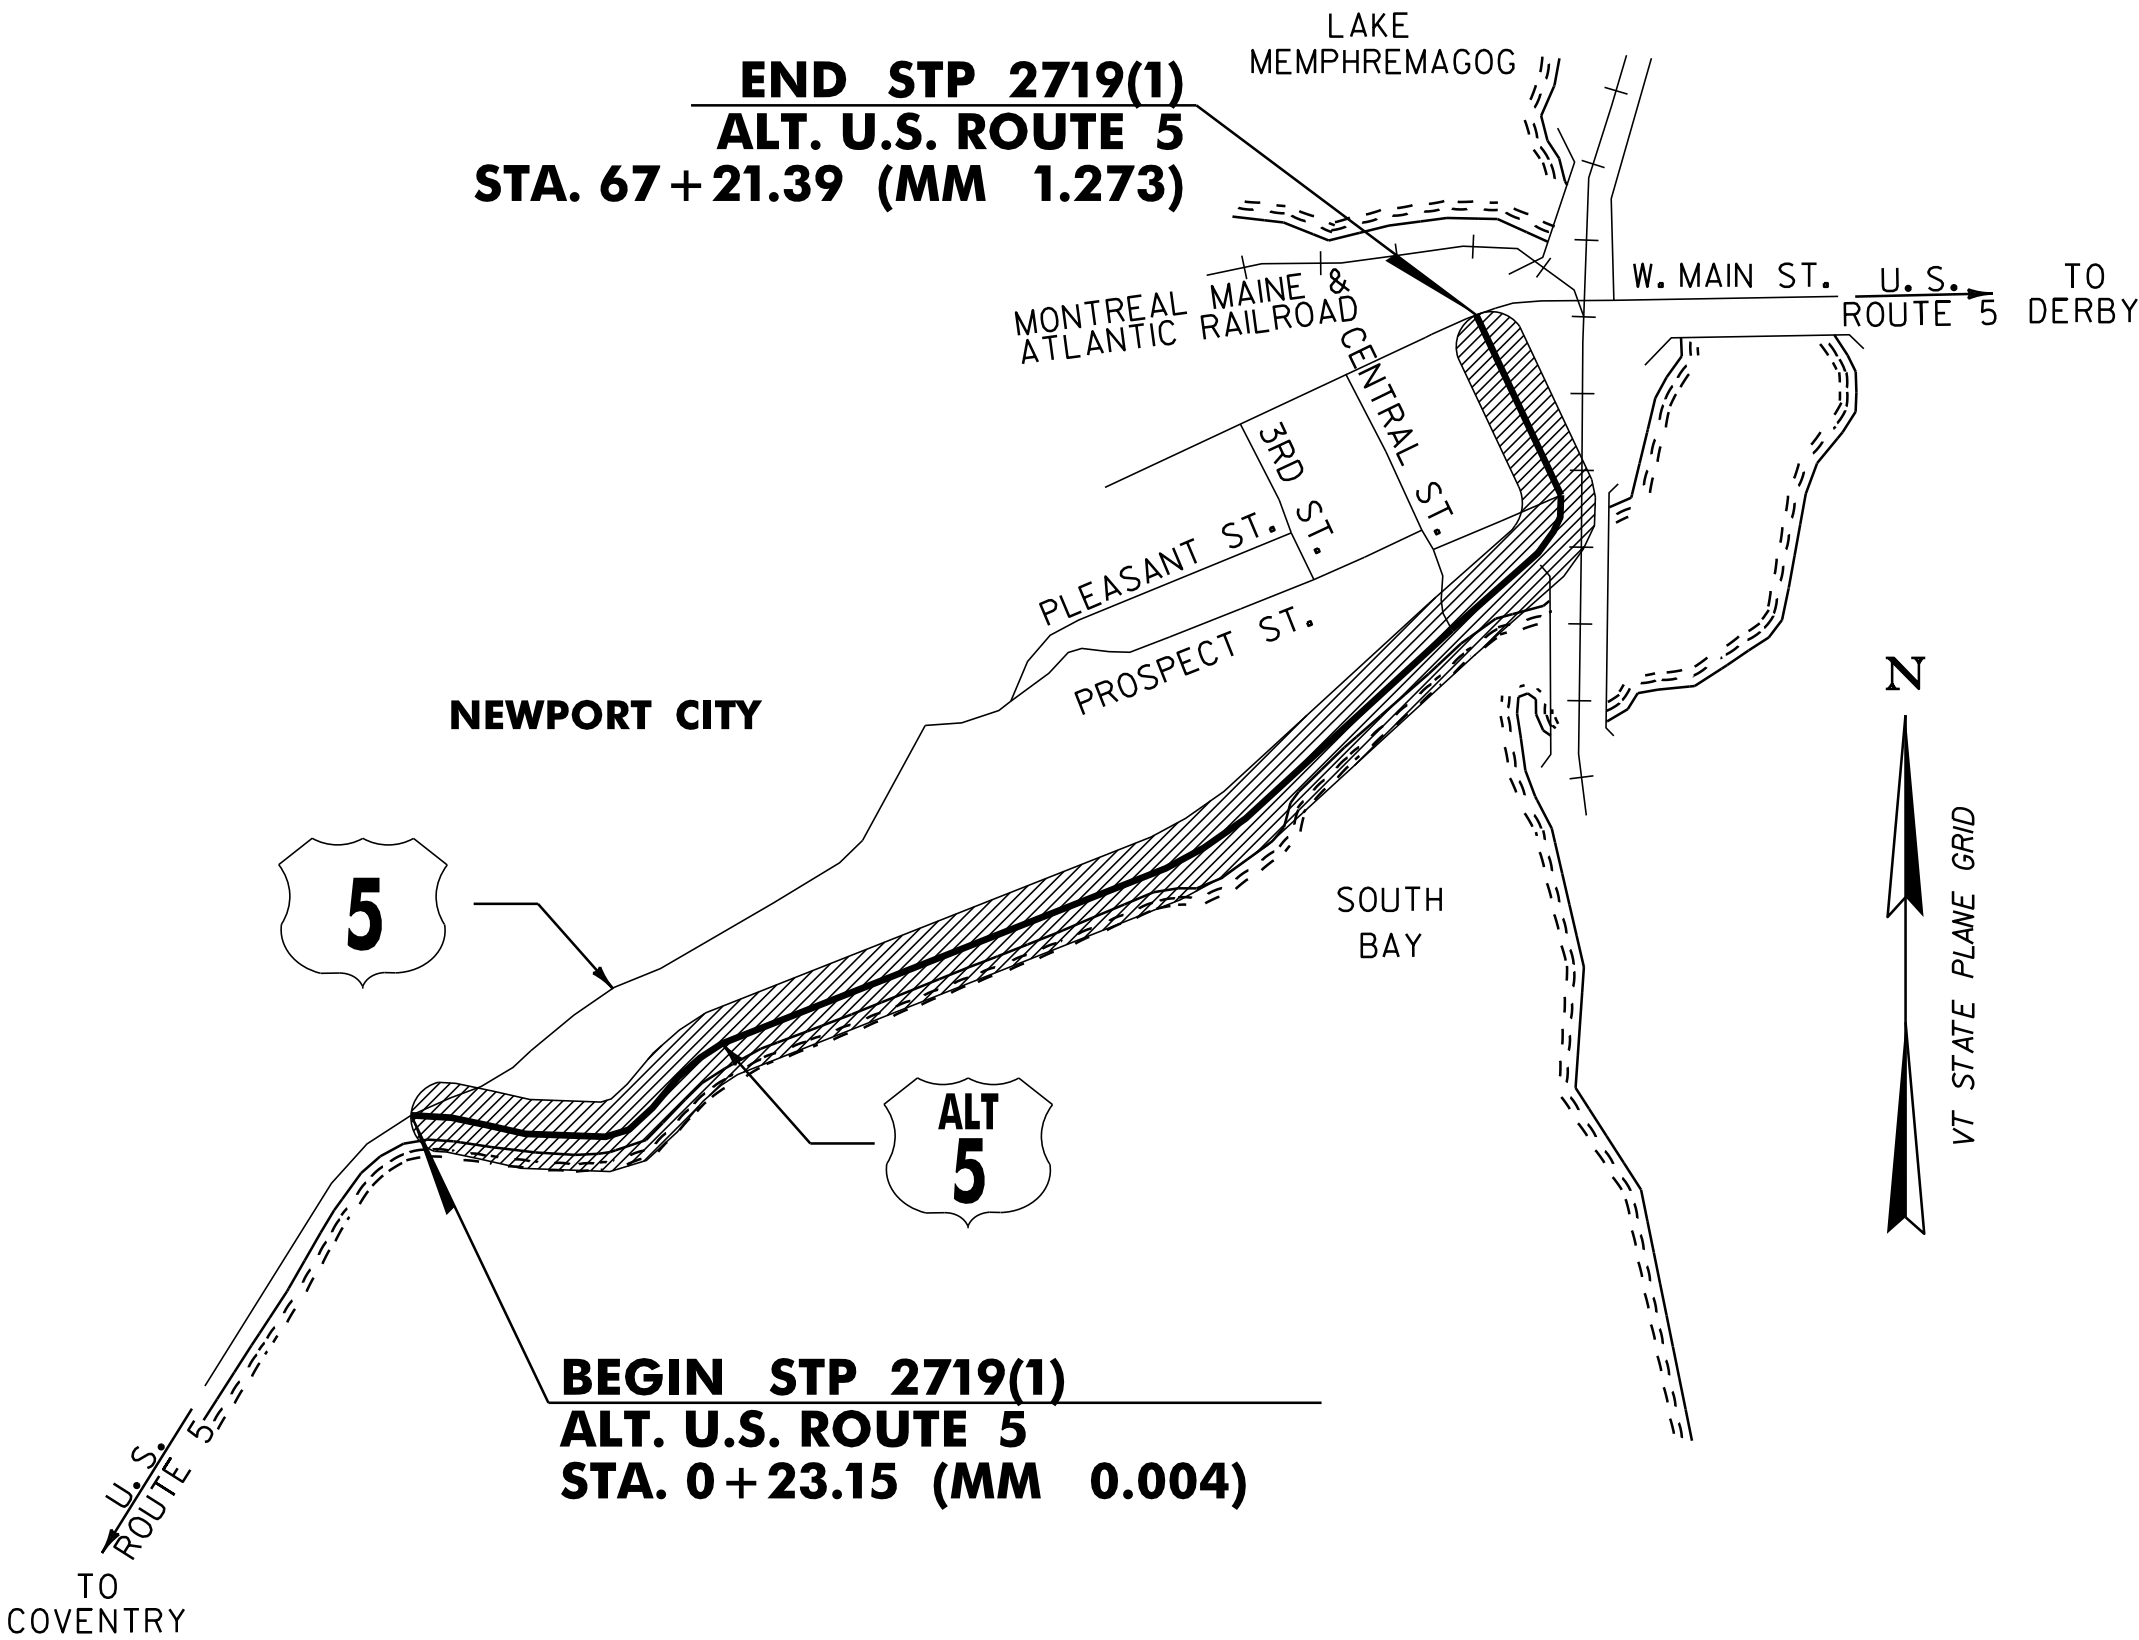

TRAFFIC DATA
ALT. U.S. ROUTE 5

LOCATION	AADT		DHV		ESALS	
	2010	2030	2010	2030	2010-2030	2010-2050
BEGIN PROJECT MM 0.000 TO END PROJECT MM 1.283	4800	5500	540	620	783,000	1,836,000
-						

SUPERPAVE BITUMINOUS CONCRETE PAVEMENT
MIXTURE DESIGN CRITERIA

DESIGN LANE/DESIGN LIFE ESALS	918,000
DESIGN NUMBER OF GYRATIONS	65
PERFORMANCE GRADE ASPHALT BINDER	SEE SECTION 490 GENERAL SPECIAL PROVISIONS

RIGHT-OF-WAY LIMITS, IF APPLICABLE, ARE PROVIDED SOLELY FOR THE CONVENIENCE OF THE STATE AND ITS CONTRACTOR DURING THE COURSE OF THIS PAVING PROJECT. ANY REFERENCES TO OFFSETS ON THESE PLANS ARE APPROXIMATE AND SHOULD NOT BE RELIED UPON FOR ANY PURPOSES.

THESE PLANS ARE SUBJECT TO SUCH ENGINEERING CHANGES AS MAY BE REQUIRED BY THE FEDERAL HIGHWAY ADMINISTRATION OR THE DIRECTOR OF PROGRAM DEVELOPMENT.

CONSTRUCTION IS TO BE CARRIED ON IN ACCORDANCE WITH THESE PLANS AND THE STANDARD SPECIFICATIONS FOR CONSTRUCTION DATED 2006, AS APPROVED BY THE FEDERAL HIGHWAY ADMINISTRATION ON JUNE 15, 2006 FOR USE ON THIS PROJECT, INCLUDING ALL SUBSEQUENT REVISIONS AND SUCH REVISED SPECIFICATIONS AND SPECIAL PROVISIONS AS ARE INCORPORATED IN THESE PLANS.

UNLESS OTHERWISE NOTED, ALL DRAWINGS AND DETAILS ON THESE PLANS ARE DRAWN "NOT TO SCALE".

CONVENTIONAL SYMBOLS

COUNTY LINE	COUNTY LINE
TOWN LINE	TOWN LINE
LIMITS OF ACCESS	
POINT OF ACCESS	X
FENCE LINE	X X X X
STONE WALL	o o o o o o o o
TRAVELED WAY	
GUARD RAIL	o o o o o o
RAILROAD	
SURVEY LINE	
CULVERT	
POWER POLE	
TELEPHONE POLE	
TREES	
CONTROL OF ACCESS	///
PROPERTY LINE	
R.O.W. TAKING LINE	SR SR SR
SLOPE RIGHTS	
TOP OF CUT	
TOE OF SLOPE	

SURVEYED BY : N/A
SURVEYED DATE : N/A

DATUM
VERTICAL N/A
HORIZONTAL N/A

PROJECT MANAGER : KEVIN MARSHIA

PROJECT NAME : NEWPORT CITY
PROJECT NUMBER : STP 2719(1)

SHEET 6 OF 62 SHEETS

NOTES

1. THE PAVEMENT WEARING COURSE SHALL BE SUPERPAVE BITUMINOUS CONCRETE PAVEMENT TYPE IVS. THE ESTIMATED 1/2" LEVELING COURSE SHALL BE SUPERPAVE BITUMINOUS CONCRETE PAVEMENT TYPE IVS UNLESS OTHERWISE DIRECTED BY THE RESIDENT ENGINEER.
2. GRASS GROWING ADJACENT TO PAVEMENT OR THROUGH CRACKS IN THE PAVEMENT WHICH MAY HAMPER THE PLACEMENT OF NEW BITUMINOUS CONCRETE SHALL BE REMOVED BY THE CONTRACTOR AS DIRECTED BY THE RESIDENT ENGINEER. PAYMENT FOR THIS WORK WILL NOT BE MADE DIRECTLY, BUT WILL BE INCLUDED IN THE UNIT PRICE BID FOR ITEM 490.30 SUPERPAVE BITUMINOUS CONCRETE PAVEMENT.
3. SUPERPAVE BITUMINOUS CONCRETE PAVEMENT TOLERANCE = +1/4". (TOTAL THICKNESS EXCLUDING LEVELING)
4. EMULSIFIED ASPHALT SHALL BE APPLIED ON EXISTING PAVEMENT SURFACES, BETWEEN ALL COURSES OF PAVEMENT AND ON COLD PLANED SURFACES, AT THE RATE OF 0.025 GAL/SY OR AS DIRECTED BY THE RESIDENT ENGINEER.
5. COLD PLANING TO BE COMPLETED ACCORDING TO TYPICAL OR AS NOTED OTHERWISE ON THE PLANS. THE COLD PLANING AND PAVING SHALL MATCH THE EXISTING CONDITIONS AT THE BEGINNING AND END OF CONSTRUCTION AREAS BY THE USE OF A VERTICAL COLD PLANE JOINT. SEE DETAIL BELOW.
6. ALL PUBLIC, PRIVATE OR FIELD DRIVES SHALL RECEIVE A MINIMUM 4' PAVED APRON PAYABLE UNDER ITEM 900.675 SPECIAL PROVISION (HAND-PLACED BITUMINOUS CONCRETE MATERIAL, DRIVES) UNLESS OTHERWISE DIRECTED BY THE RESIDENT ENGINEER. ALL OTHER BITUMINOUS MATERIALS PLACED WITHIN THE PROJECT LIMITS WHETHER BY HAND OR MECHANICAL METHODS SHALL BE PAID AS ITEM 490.30 SUPERPAVE BITUMINOUS CONCRETE PAVEMENT.
7. SIDEWALK RAMP DETECTABLE WARNING SURFACES SHALL BE TRUNCATED DOME DETECTABLE WARNING PLATES FROM THE AGENCY'S APPROVED PRODUCT LIST.
8. AN ESTIMATED QUANTITY OF ITEM 619.17 YIELDING MARKER POSTS HAS BEEN INCLUDED TO DELINEATE PIPE INLETS, PIPE OUTLETS AND DROP INLETS LOCATED OUTSIDE OF THE PAVEMENT SURFACE OR AS DIRECTED BY THE RESIDENT ENGINEER.
9. A QUANTITY FOR ITEM 604.412 REHAB. DROP INLETS, CATCH BASINS, OR MANHOLES, CLASS I, ITEM 604.415 REHAB. DROP INLETS, CATCH BASINS, OR MANHOLES, CLASS II, ITEM 604.418 REHAB. DROP INLETS, CATCH BASINS, OR MANHOLES, CLASS III AND ITEM 604.40 CHANGING ELEVATION OF DI, CB, OR MH HAS BEEN INCLUDED TO BE USED AS INDICATED ON THE PLANS OR AS DIRECTED BY THE RESIDENT ENGINEER. ALL DI'S SHALL BE RAISED OR REHABILITATED SUCH THAT THE NEW GRATE ELEVATION IS EVEN WITH THE SURROUNDING TERRAIN. DRAINAGE STRUCTURES CALLING FOR REHAB HAVE BEEN EVENLY DISTRIBUTED BETWEEN ITEMS 604.412, 604.415, AND 604.418 FOR ESTIMATING PURPOSES.
10. STEEL BEAM GUARDRAIL WITH STEEL POSTS SHALL BE USED ON THIS PROJECT. PAYMENT FOR CONNECTING NEW STEEL BEAM GUARDRAIL TO EXISTING STEEL BEAM GUARDRAIL WILL NOT BE PAID SEPARATELY BUT WILL BE INCLUDED IN THE UNIT PRICE BID FOR ITEM 621.20 STEEL BEAM GUARDRAIL, GALVANIZED.

SEEDING FORMULA

RATE: DOUBLE IF HYDROSEEDING

% WT.	LBS./A.	NAME	PUR %	GERM %
38	32	CREEPING RED FESCUE	98	90
29	24	SPARTAN HARD FESCUE	95	85
15	12	AZAY SHEEP'S FESCUE	95	87
15	12	ANNUAL RYE GRASS	95	90
3	--	INERTS	--	--
100.0	80 LB/A			

NOTES

SEED MIXTURE: SHALL NOT HAVE A WEED CONTENT EXCEEDING 0.40% BY WEIGHT AND SHALL BE FREE OF ALL NOXIOUS SEED.

SEED ITEM 651.15: TO BE APPLIED PER SEEDING FORMULAS OR AS DIRECTED BY THE RESIDENT ENGINEER.

FERTILIZER ITEM 651.18: FORMULA 10-20-10, TO BE USED WITH SEED, APPLIED AT THE RATE OF 500 LBS./ACRE. (HYDRO SEEDERS MAY USE 19-19-19 FORMULA)

AGRICULTURAL LIMESTONE ITEM 651.20: TO BE APPLIED AT THE RATE OF 2 TONS/ACRE, OR AS DIRECTED BY THE RESIDENT ENGINEER.

HAY MULCH ITEM 651.25: TO BE PLACED ON THE EARTH SLOPES AT THE RATE OF 2 TONS/ACRE, OR AS DIRECTED BY THE RESIDENT ENGINEER.

TOPSOIL ITEM 651.35: TO BE USED WITH SEED AS INDICATED ON THE PLANS, OR AS DIRECTED BY THE RESIDENT ENGINEER.

GRADES LESS THAN 1 PERCENT SHALL USE ITEM 651.15, SEED AND ITEM 651.25, HAY MULCH. GRADES BETWEEN 1 AND 2.5 PERCENT SHALL USE ITEM 651.25, HAY MULCH OR ITEM 653.20, TEMPORARY EROSION MATTING AS DIRECTED BY THE RESIDENT ENGINEER. GRADES OVER 2.5 PERCENT SHALL USE ITEM 649.31, GEOTEXTILE UNDER STONE FILL AND ITEM 613.10, STONE FILL TYPE I AS DIRECTED BY THE RESIDENT ENGINEER.


PIPE INLET AND OUTLET AREAS, AND DITCH CLEANING THROUGHOUT THE PROJECT, SHALL BE PERFORMED AT LOCATIONS INDICATED ON THIS SHEET AND AS DIRECTED BY THE RESIDENT ENGINEER. PAYMENT WILL BE UNDER THE APPLICABLE EQUIPMENT RENTAL ITEM(S).

NOT TO SCALE

PROJECT
TYPICAL
SHEET


PROJECT NAME: NEWPORT CITY
PROJECT NUMBER: STP 2719(I)

FILE NAME: 07D202.dgn
PROJECT LEADER: JLL
DESIGNED BY: MCF
IPARM FILE: 07D202_07.1
PLOT DATE: 29-JAN-2013 09:2
DRAWN BY: STANTEC
CHECKED BY: JLL
SHEET 7 OF 62

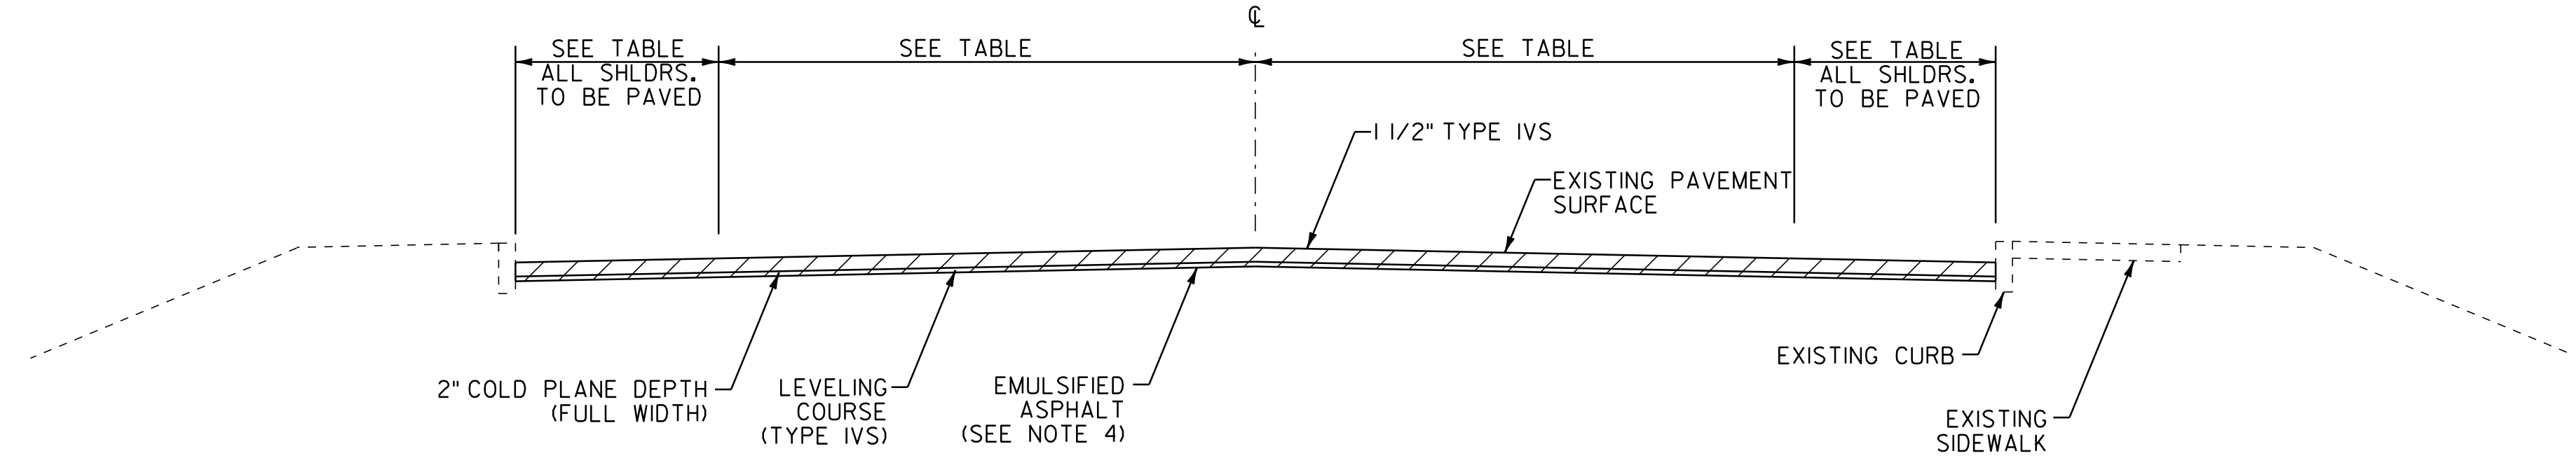

COLD PLANE TYPICAL SECTION - CURBED

ALT. U.S. ROUTE 5 NEWPORT CITY STA. 58+02 TO 67+21.39

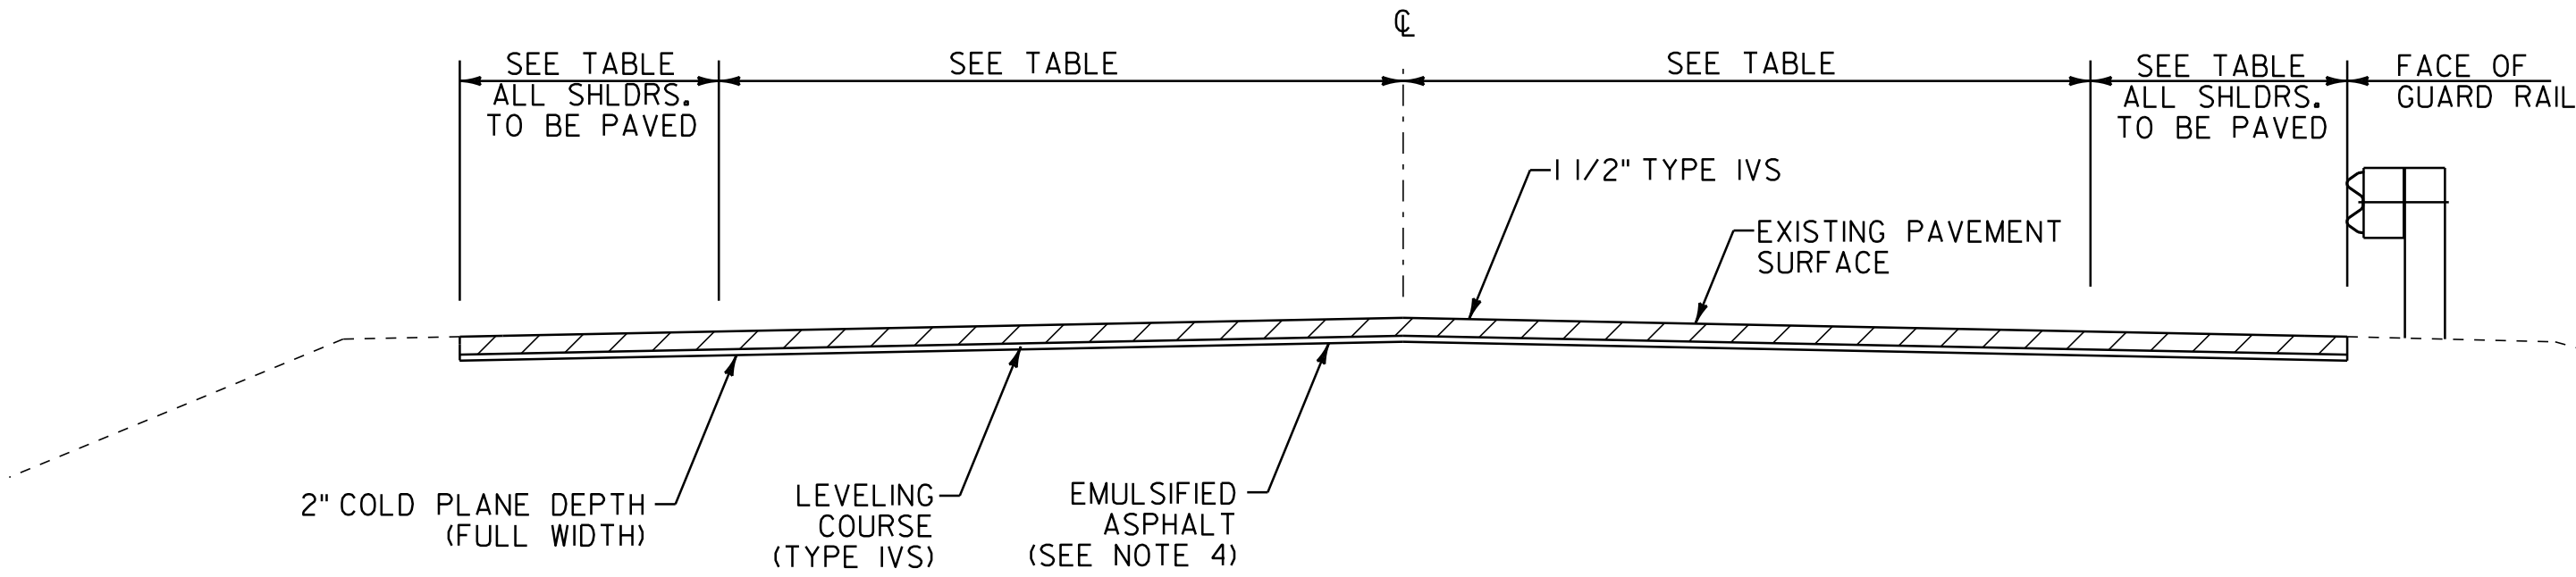


COLD PLANE TYPICAL SECTION - UNCURBED

ALT. U.S. ROUTE 5 NEWPORT CITY STA. 0+23.15 TO 58+02

PROJECT PAVING LIMITS

TOWN & ROUTE	BEGIN STATION	END STATION	LANE TYPICAL	WEARING DEPTH	LEVELING DEPTH	NOTES
NEWPORT CITY ALT. U.S. ROUTE 5	0+23.15	5+00.00	VARIABLE - SEE LAYOUT SHEETS	1 1/2"	1/2"	COLD PLANE 2", LEVEL AND THEN PAVE WITH 1 1/2" TYPE IVS.
NEWPORT CITY ALT. U.S. ROUTE 5	5+00.00	29+50.00	1'-0" - 11'-0" - 11'-0" - 1'-0"	1 1/2"	1/2"	COLD PLANE 2", LEVEL AND THEN PAVE WITH 1 1/2" TYPE IVS.
NEWPORT CITY ALT. U.S. ROUTE 5	29+50.00	30+00.00	VARIABLE - SEE LAYOUT SHEETS	1 1/2"	1/2"	COLD PLANE 2", LEVEL AND THEN PAVE WITH 1 1/2" TYPE IVS.
NEWPORT CITY ALT. U.S. ROUTE 5	30+00.00	34+50.00	1'-0" - 11'-0" - 11'-0" - 2'-0"	1 1/2"	1/2"	COLD PLANE 2", LEVEL AND THEN PAVE WITH 1 1/2" TYPE IVS.
NEWPORT CITY ALT. U.S. ROUTE 5	34+50.00	35+00.00	VARIABLE - SEE LAYOUT SHEETS	1 1/2"	1/2"	COLD PLANE 2", LEVEL AND THEN PAVE WITH 1 1/2" TYPE IVS.
NEWPORT CITY ALT. U.S. ROUTE 5	35+00.00	40+00.00	2'-0" - 11'-0" - 11'-0" - 2'-0"	1 1/2"	1/2"	COLD PLANE 2", LEVEL AND THEN PAVE WITH 1 1/2" TYPE IVS.
NEWPORT CITY ALT. U.S. ROUTE 5	40+00.00	41+00.00	VARIABLE - SEE LAYOUT SHEETS	1 1/2"	1/2"	COLD PLANE 2", LEVEL AND THEN PAVE WITH 1 1/2" TYPE IVS.
NEWPORT CITY ALT. U.S. ROUTE 5	41+00.00	52+08.00	1'-0" - 11'-0" - 11'-0" - 1'-0"	1 1/2"	1/2"	COLD PLANE 2", LEVEL AND THEN PAVE WITH 1 1/2" TYPE IVS.
NEWPORT CITY ALT. U.S. ROUTE 5	52+08.00	67+21.39	VARIABLE - SEE LAYOUT SHEETS	1 1/2"	1/2"	COLD PLANE 2", LEVEL AND THEN PAVE WITH 1 1/2" TYPE IVS.

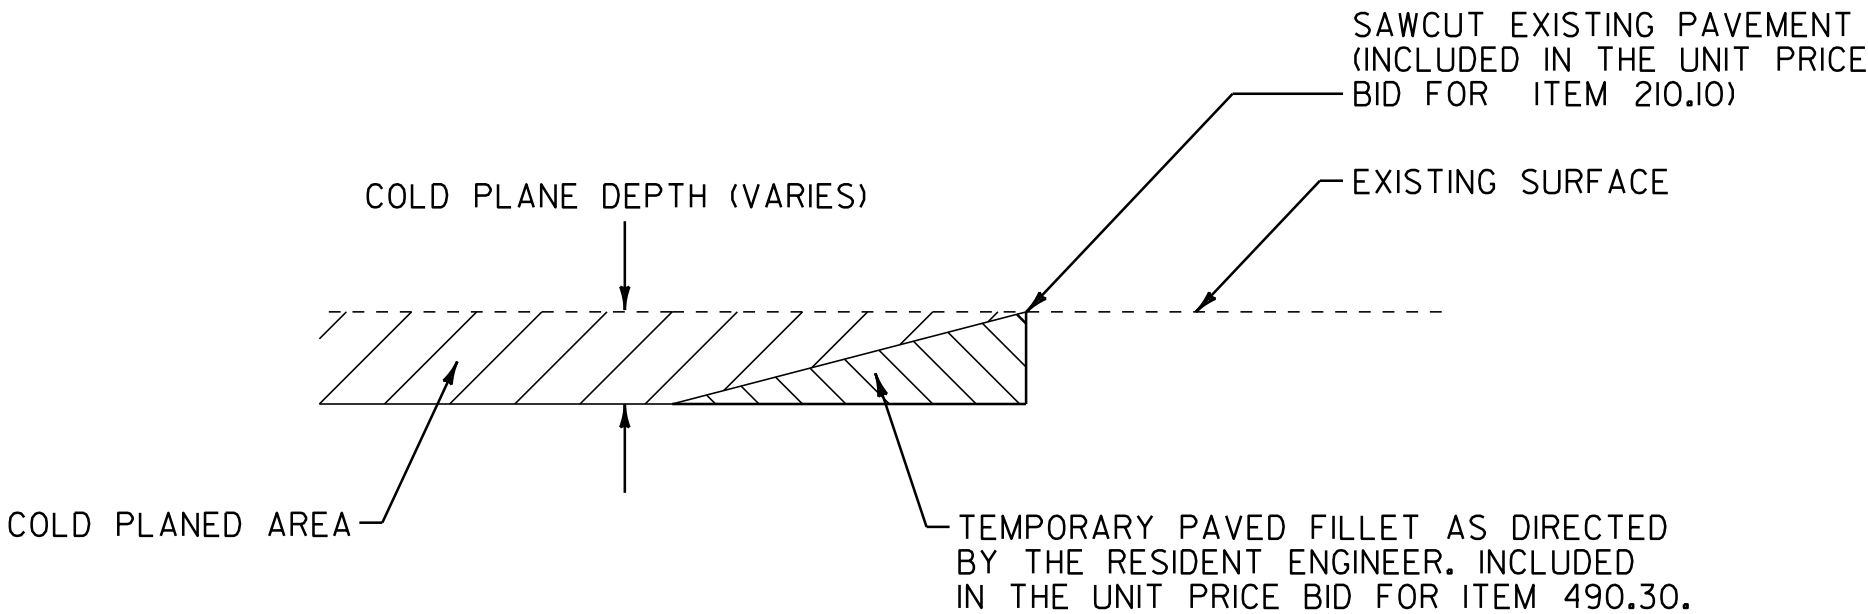

DETAIL AT VERTICAL COLD PLANE JOINTS

NOTE: THIS DETAIL SHALL BE USED FOR THE SIDE ROADS LISTED BELOW AND AT ALL DRIVES AS DIRECTED BY THE RESIDENT ENGINEER.


FULL ROADWAY WIDTH

STA. 0+23.15 (BEGIN PROJECT)
STA. 51+34, LT (SECOND ST.)
STA. 59+06, LT (EASTERN AVE.)
STA. 67+21.39 (END PROJECT)


ITEM DETAIL SUMMARY SHEET

[illegible]

ITEM DETAIL SUMMARY SHEET	PROJECT NAME: NEWPORT CITY	
	PROJECT NUMBER: STP 2719(I)	
	FILE NAME: 07D202.dgn	PLOT DATE: 29-JAN-2013 09:2
	PROJECT LEADER: JLL	DRAWN BY: STANTEC
	DESIGNED BY: STANTEC	CHECKED BY: JLL
	IPARM FILE: 07D202_IO.i	SHEET 10 OF 62

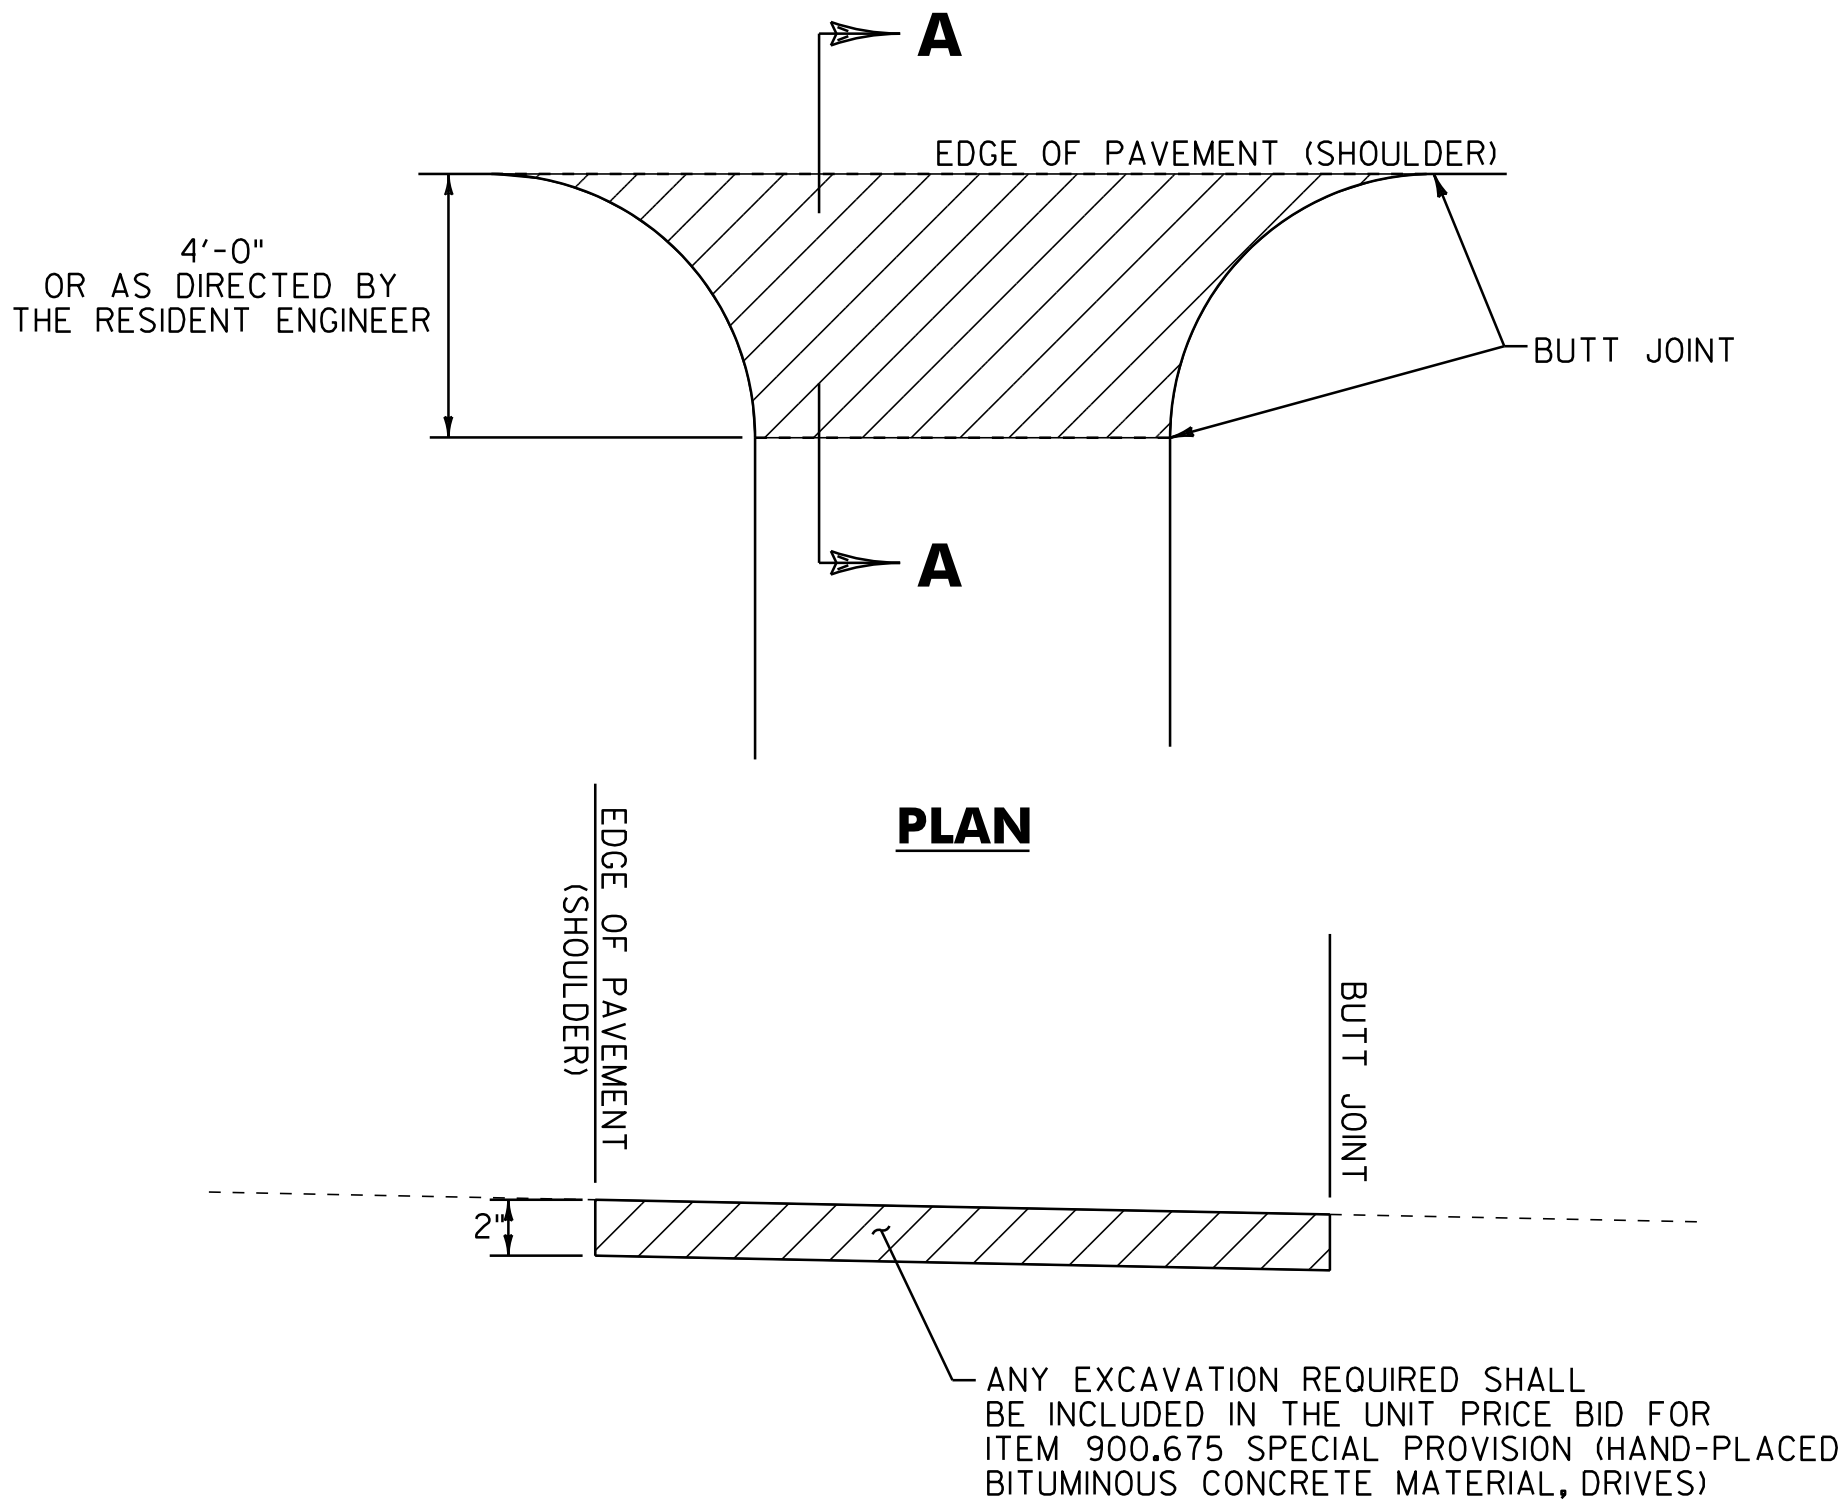

SECTION A-A
HANDWORK DETAILS FOR PAVED DRIVES

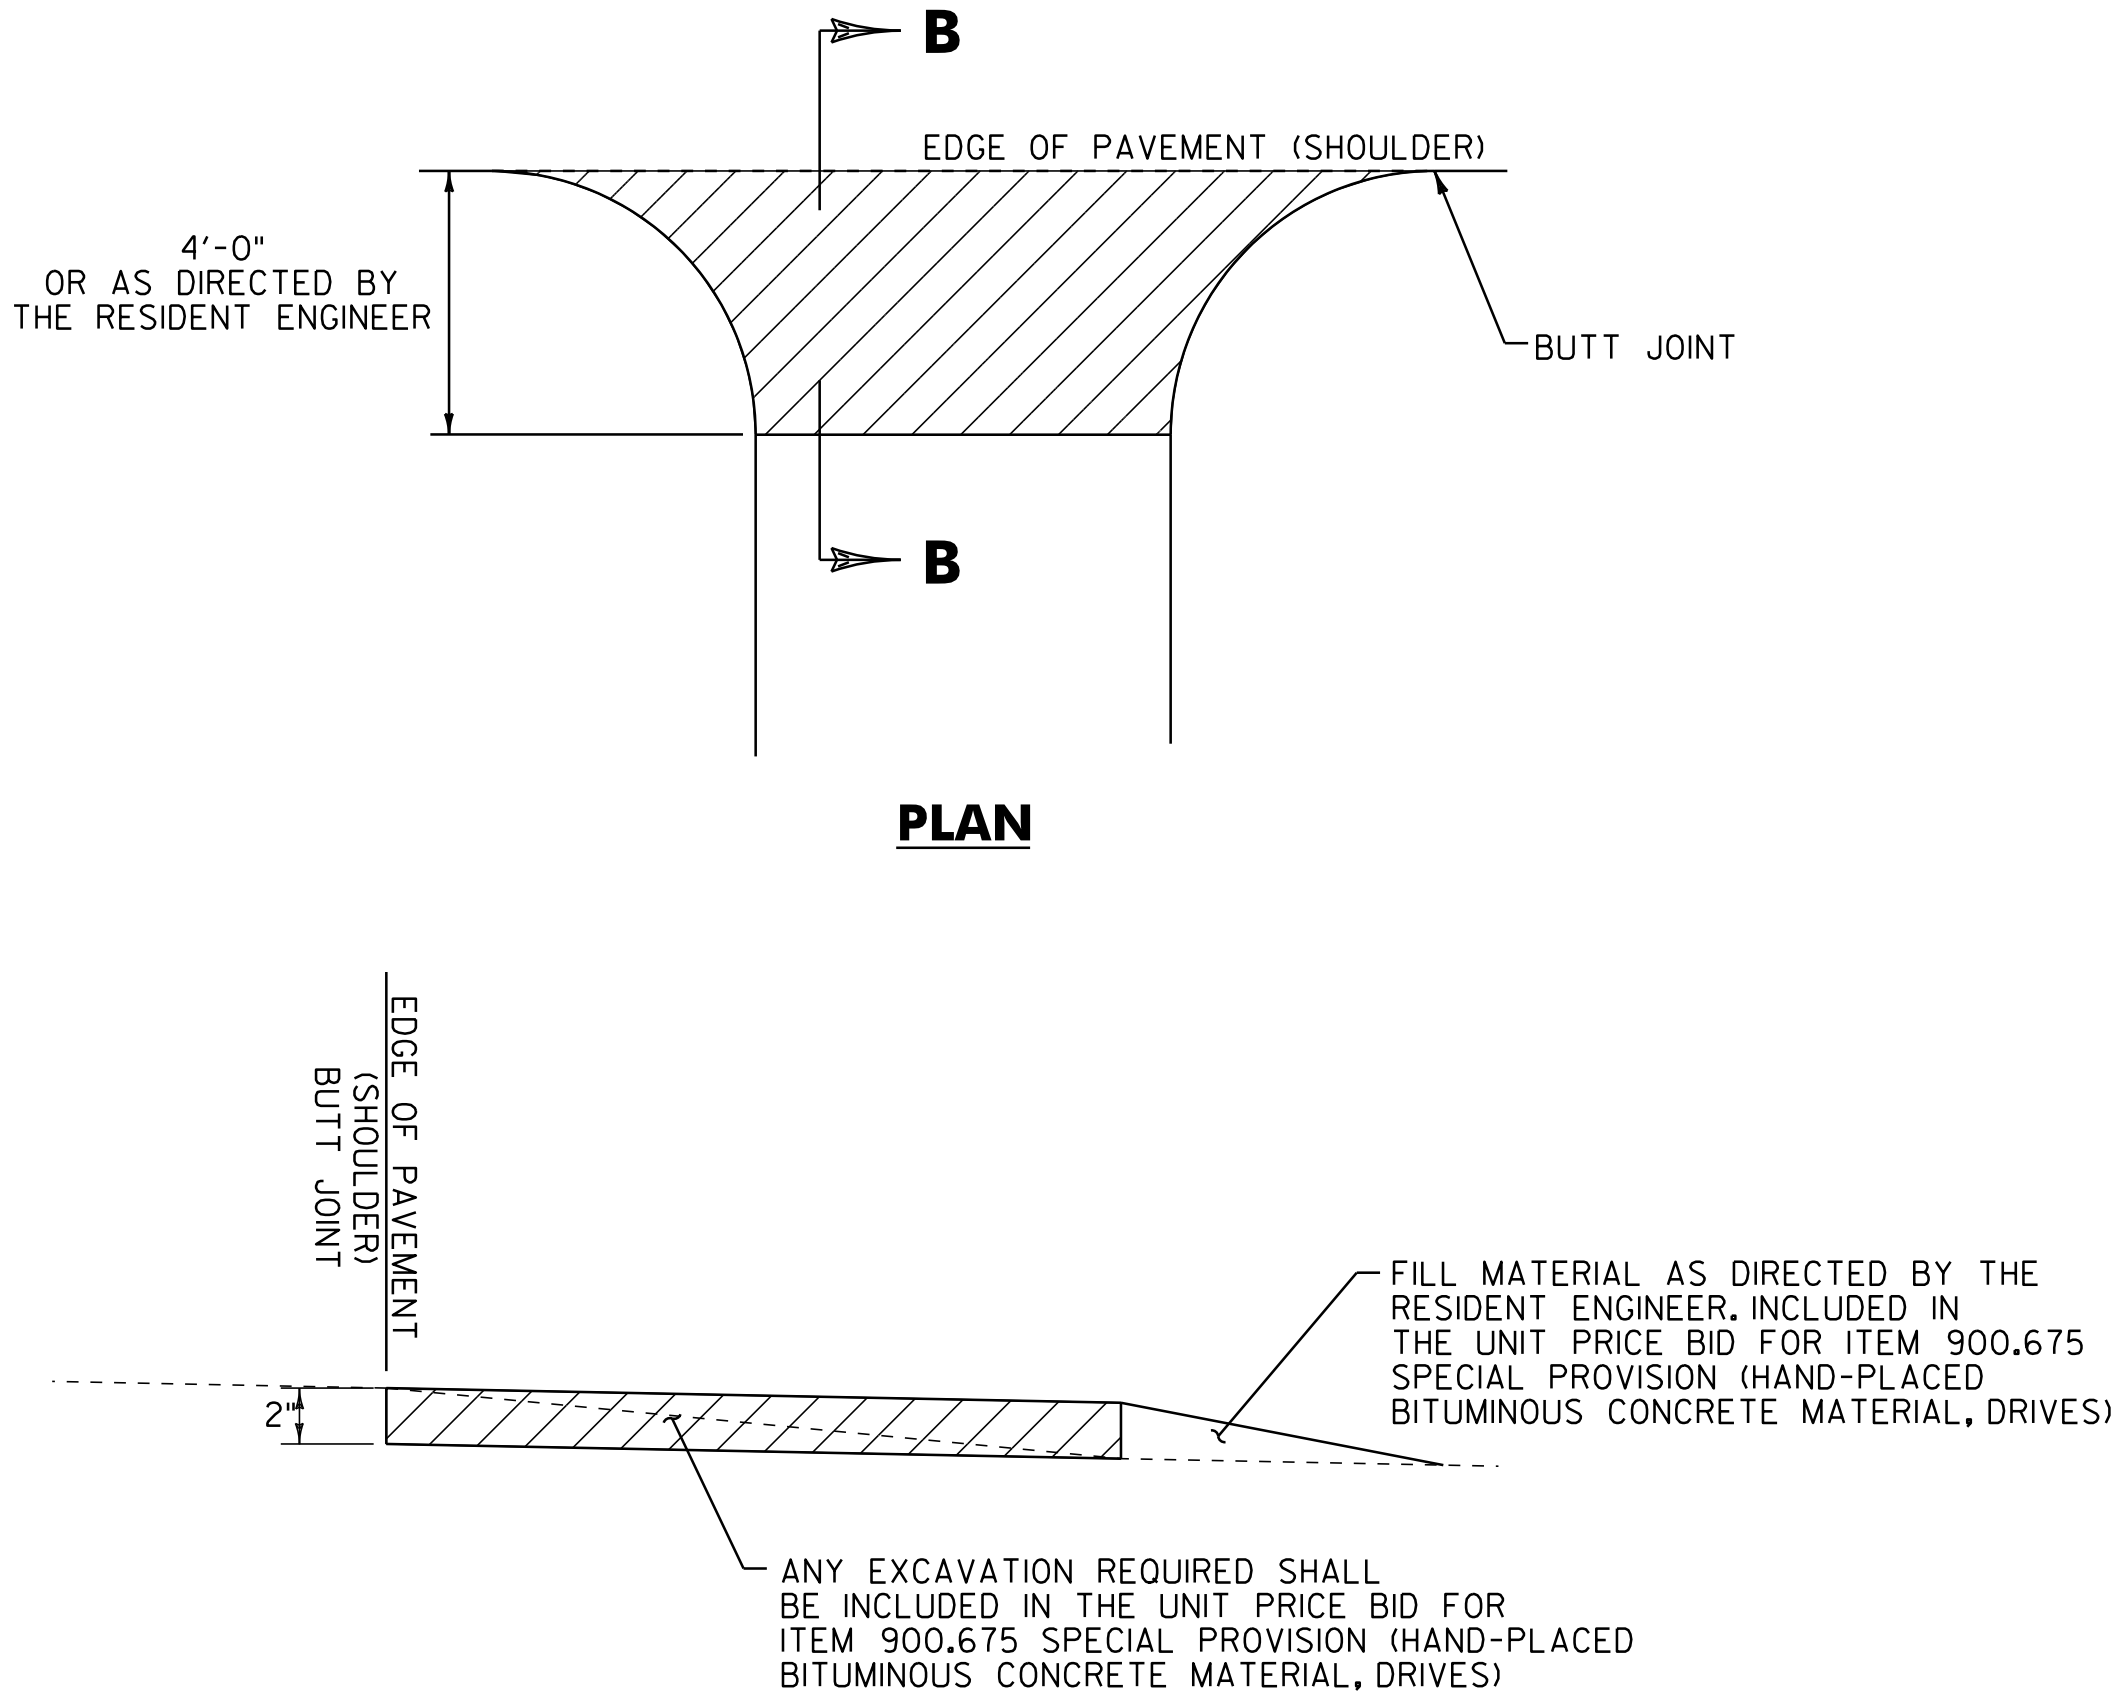

SECTION B-B

HANDWORK DETAILS FOR GRAVEL DRIVES


STATION	POSITION	QUANTITY (SY)
2+65	RT	20
3+59	RT	35
3+85	LT	11
5+42	RT	13
5+71	LT	18
6+41	RT	8
12+26	LT	24
17+62	RT	12
18+13	LT	7
18+74	LT	9
25+44	LT	11
31+83	RT	8
32+99	RT	10
35+27	RT	21
39+08	RT	11
45+80	LT	23
52+01	LT	30
53+13	RT	26
53+99	RT	28
55+07	RT	13
56+90	RT	102
57+36	LT	28
58+15	RT	17
58+90	RT	52
SUBTOTAL		537

STATION	POSITION	QUANTITY (SY)
59+70	RT	21
60+28	RT	32
60+76	RT	12
61+74	RT	42
63+36	RT	20
63+70	RT	4
63+76	LT	12
65+00	LT	7
65+36	RT	36
65+70	LT	10
66+11	RT	15
66+24	LT	5
SUBTOTAL		216
COLUMN 1		537
COLUMN 2		216
SUBTOTAL		753
ROUNDING		7
TOTAL		760

NOTES:

- PAVING LIFT SHALL BE A MINIMUM OF 1 1/2 " AND A MAXIMUM OF 2".
- THE COST OF PROVIDING AND PLACING SUBBASE MATERIAL, CLEANING EXISTING PAVED SURFACES, INCLUDING POWER EQUIPMENT, AND FOR FILLING JOINTS, CRACKS AND HOLES WILL NOT BE PAID DIRECTLY BUT WILL BE INCLUDED IN THE UNIT PRICE BID FOR ITEM 900.675 SPECIAL PROVISION (HAND-PLACED BITUMINOUS CONCRETE MATERIAL, DRIVES).
- EXCAVATION NEEDED TO ACHIEVE PROPER DRIVE SLOPES WILL NOT BE PAID DIRECTLY BUT WILL BE INCLUDED IN THE UNIT PRICE BID FOR ITEM 900.675 SPECIAL PROVISION (HAND-PLACED BITUMINOUS CONCRETE MATERIAL, DRIVES).

LEGEND

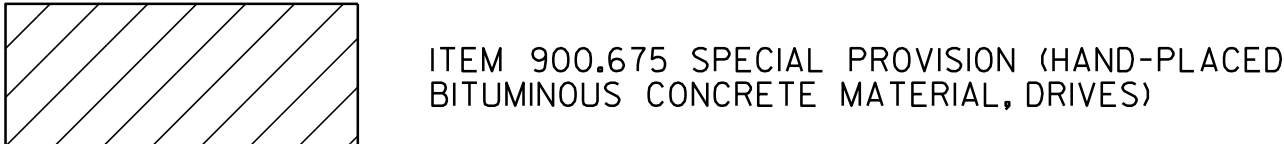

NOT TO SCALE

DRIVE
DETAIL
SHEET

PROJECT NAME:	NEWPORT CITY
PROJECT NUMBER:	STP 2719(1)
FILE NAME:	07D202.dgn
PROJECT LEADER:	JLL
DESIGNED BY:	MCF
IPARM FILE:	07D202_ILI
PLOT DATE:	29-JAN-2013 09:2
DRAWN BY:	STANTEC
CHECKED BY:	JLL
SHEET	11 OF 62

646.20 4 INCH WHITE LINE
STA. 0+23.15 TO 3+50, SOLID LT & RT

646.21 4 INCH YELLOW LINE
STA. 0+45 TO 3+50, SOLID LT & RT

646.26 24 INCH STOP BAR
STA. 0+47 TO 0+76, LT

646.30 LETTER OR SYMBOL
STA. 0+67, LT - "STOP"

646.602 TEMPORARY 4 INCH WHITE LINE, PAINT
STA. 0+23.15 TO 3+50, SOLID LT & RT


646.612 TEMPORARY 4 INCH YELLOW LINE, PAINT
STA. 0+45 TO 3+50, SOLID LT & RT

646.682 TEMPORARY 24 INCH STOP BAR, PAINT
STA. 0+47 TO 0+76, LT

646.692 TEMPORARY LETTER OR SYMBOL, PAINT
STA. 0+67, LT - "STOP"

675.50 REMOVING SIGNS
AS SHOWN - 1

BEGIN STP 2719(1) ALT. U.S. ROUTE 5
NEWPORT CITY STA. 0+23.15=MM 0.004

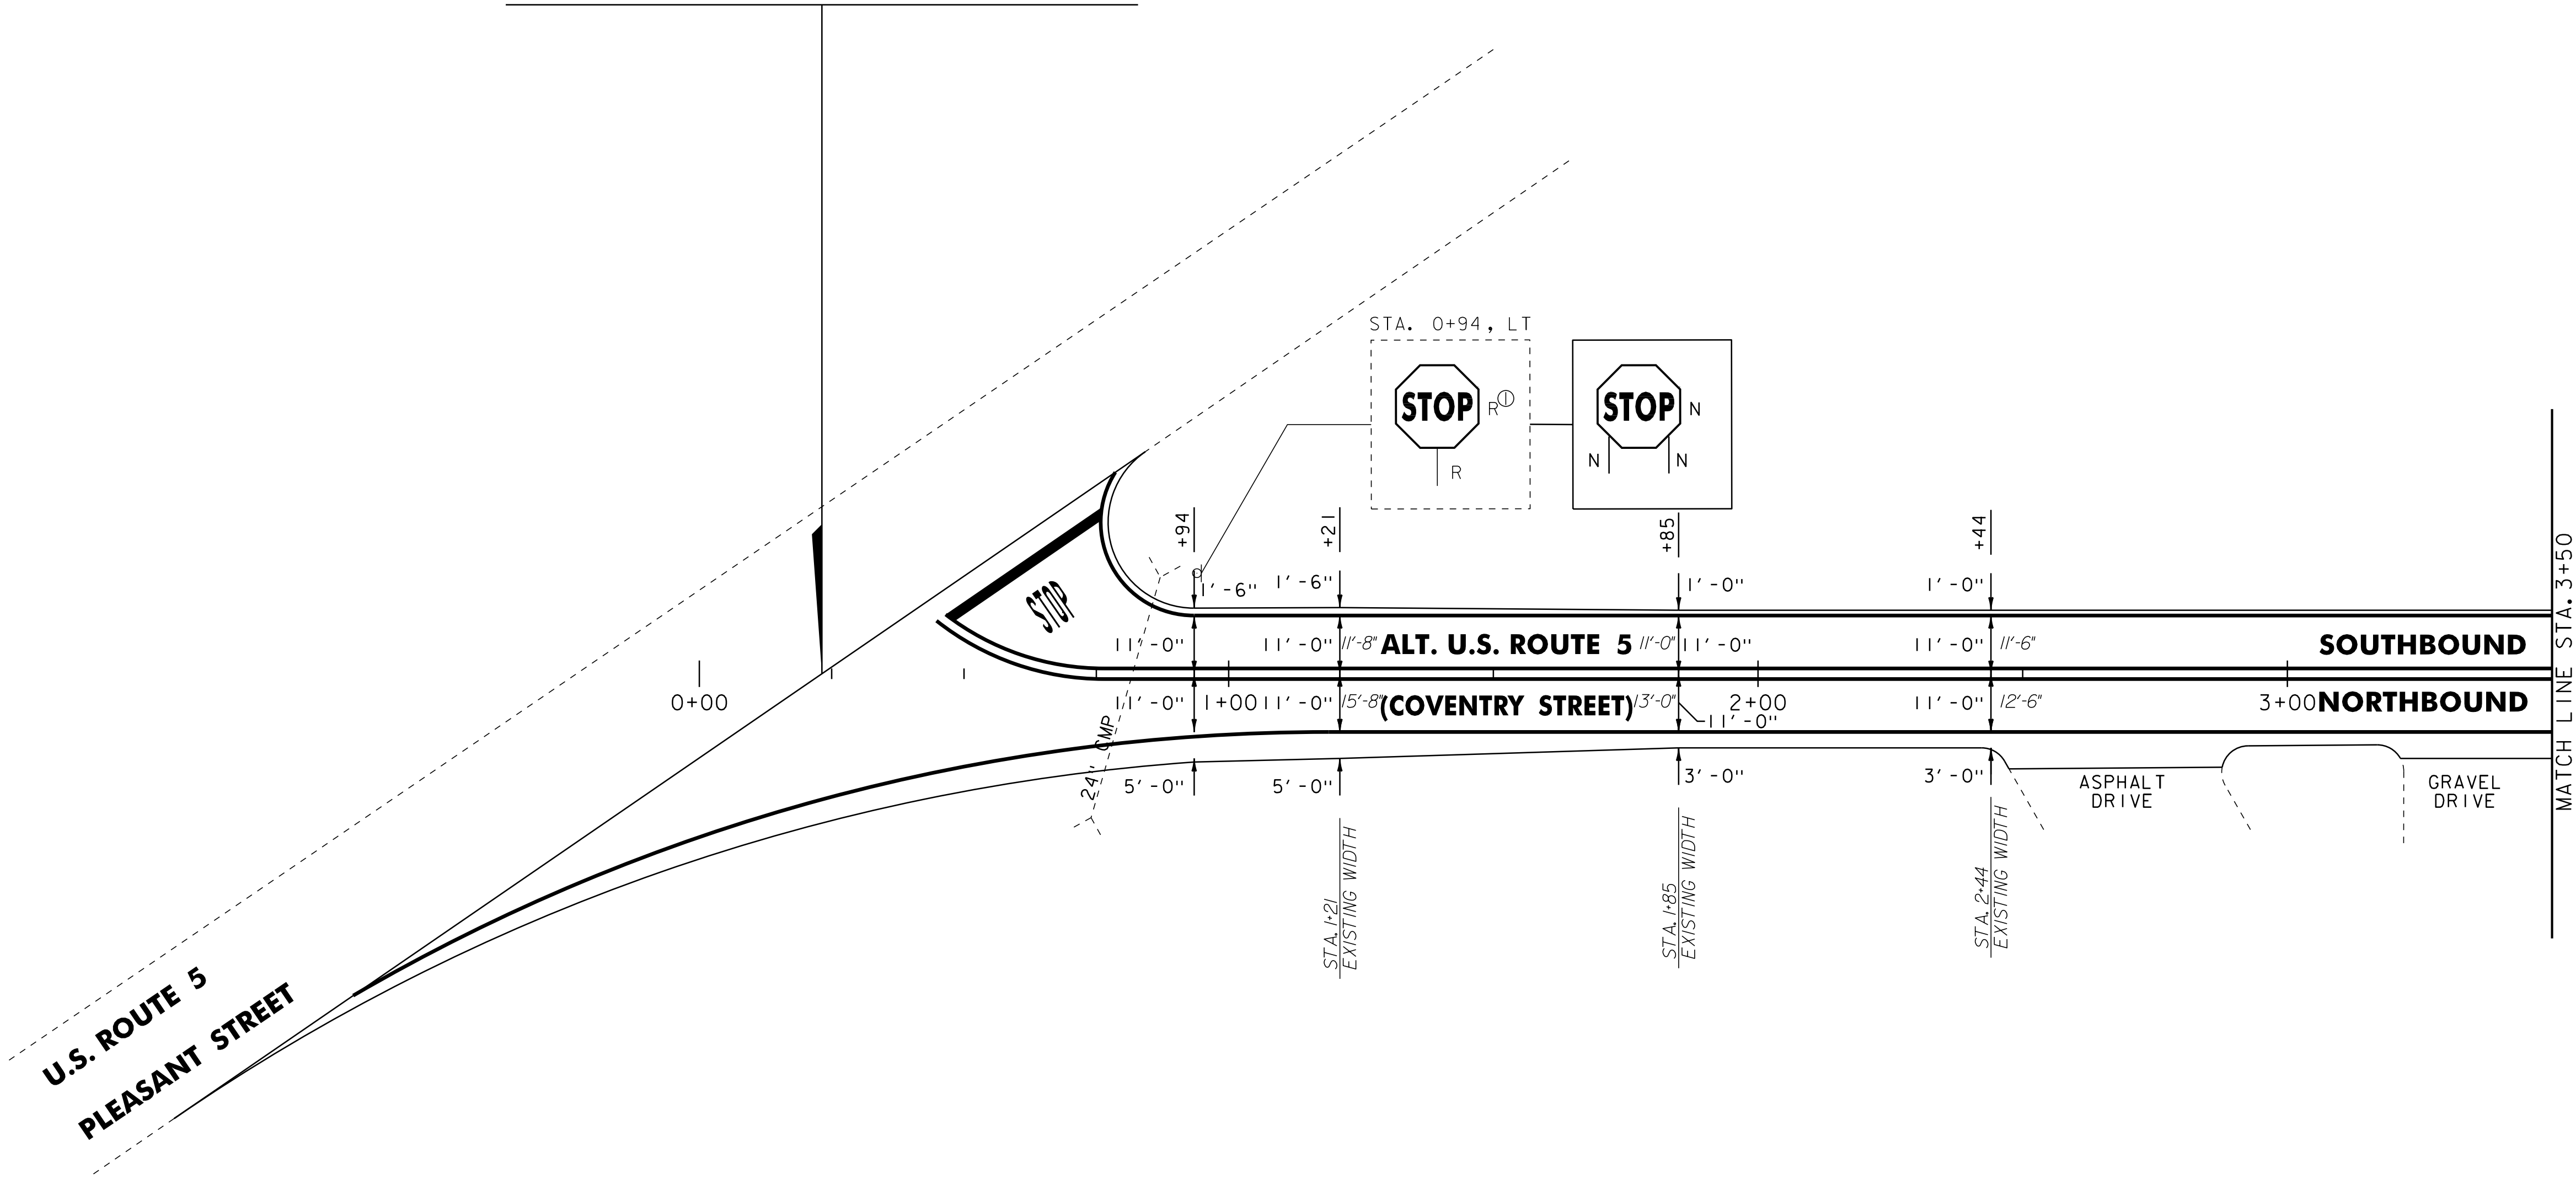

UTILITY LEGEND

= EXISTING HYDRANT

= EXISTING DI

= EXISTING MANHOLE

= EXISTING TELEPHONE MANHOLE

= EXISTING ELECTRIC MANHOLE

= EXISTING SEWER MANHOLE

= EXISTING WATER SHUTOFF

= EXISTING GAS SHUTOFF

= EXISTING MONITORING WELL

= EXISTING MAILBOX

= EXISTING POWER POLE

= EXISTING TELEPHONE POLE

= EXISTING UTILITY POLE

= EXISTING SIGNAL HEAD

= EXISTING CONTROLLER

= EXISTING PULL BOX

= EXISTING VIDEO VEHICLE DETECTORS

= PROPOSED VIDEO VEHICLE DETECTORS

= PROPOSED VIDEO DETECTION AREA

= EXISTING GUARDRAIL

= EXISTING RAILROAD

= EXISTING FENCE

= EXISTING STONE WALL

SIGN LEGEND

N

R

R&S

S

RET

B-B

Ⓢ

= NEW

= REMOVE

= REMOVE & SALVAGE

= SALVAGE SIGN

= RETAIN

= BACK TO BACK

Ⓢ RETURN TO THE CITY OF NEWPORT

NOTE:
ALL EXISTING SIGNS NOT SHOWN SHALL BE RETAINED.

NOT TO SCALE

PROJECT LAYOUT SHEET #1

PROJECT NAME: NEWPORT CITY

PROJECT NUMBER: STP 2719(1)S

FILE NAME: 07D202.dgn

PROJECT LEADER: JLL

DESIGNED BY: STANTEC



IPARM FILE: 07D202_12.i

PLOT DATE: 29-JAN-2013 09:2

DRAWN BY: STANTEC

CHECKED BY: JLL

SHEET 12 OF 62

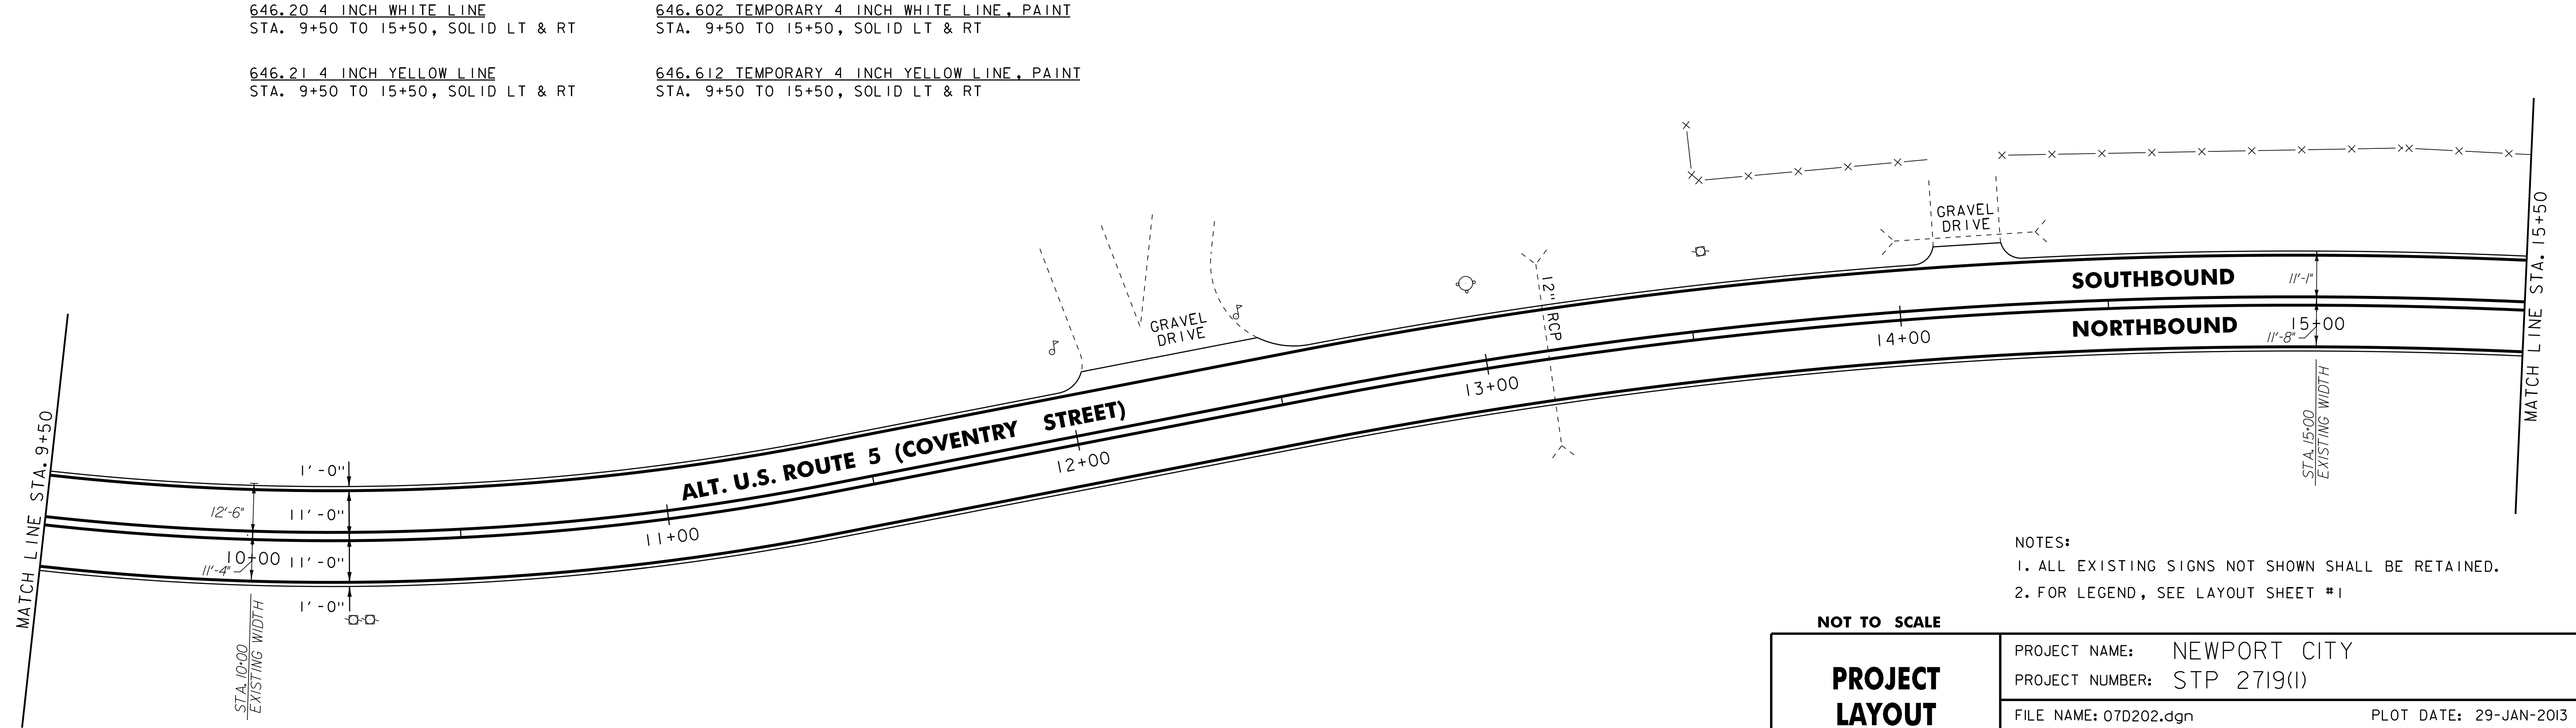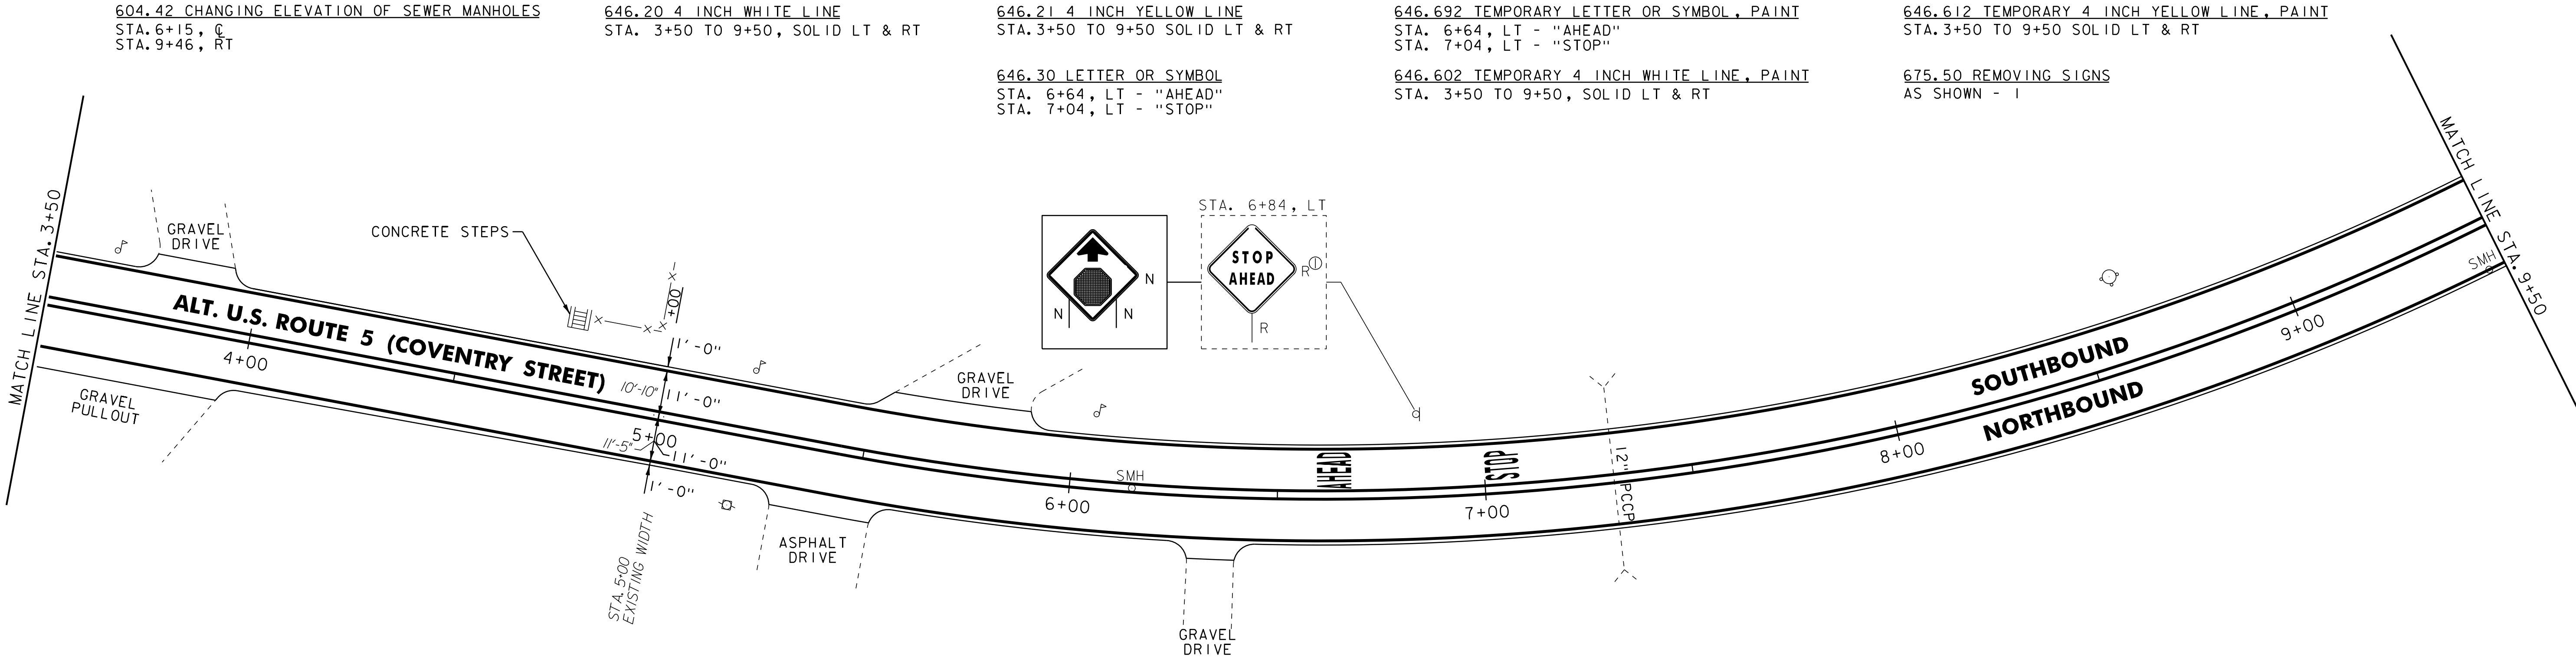

- NOTES:
- 1. ALL EXISTING SIGNS NOT SHOWN SHALL BE RETAINED.
 - 2. FOR LEGEND, SEE LAYOUT SHEET #1



NOT TO SCALE

PROJECT
LAYOUT
SHEET #2

PROJECT NAME: NEWPORT CITY
PROJECT NUMBER: STP 2719(1)

FILE NAME: 07D202.dgn
PROJECT LEADER: JLL
DESIGNED BY: STANTEC
IPARM FILE: 07D202_13.i

PLOT DATE: 29-JAN-2013 09:2
DRAWN BY: STANTEC
CHECKED BY: JLL
SHEET 13 OF 62

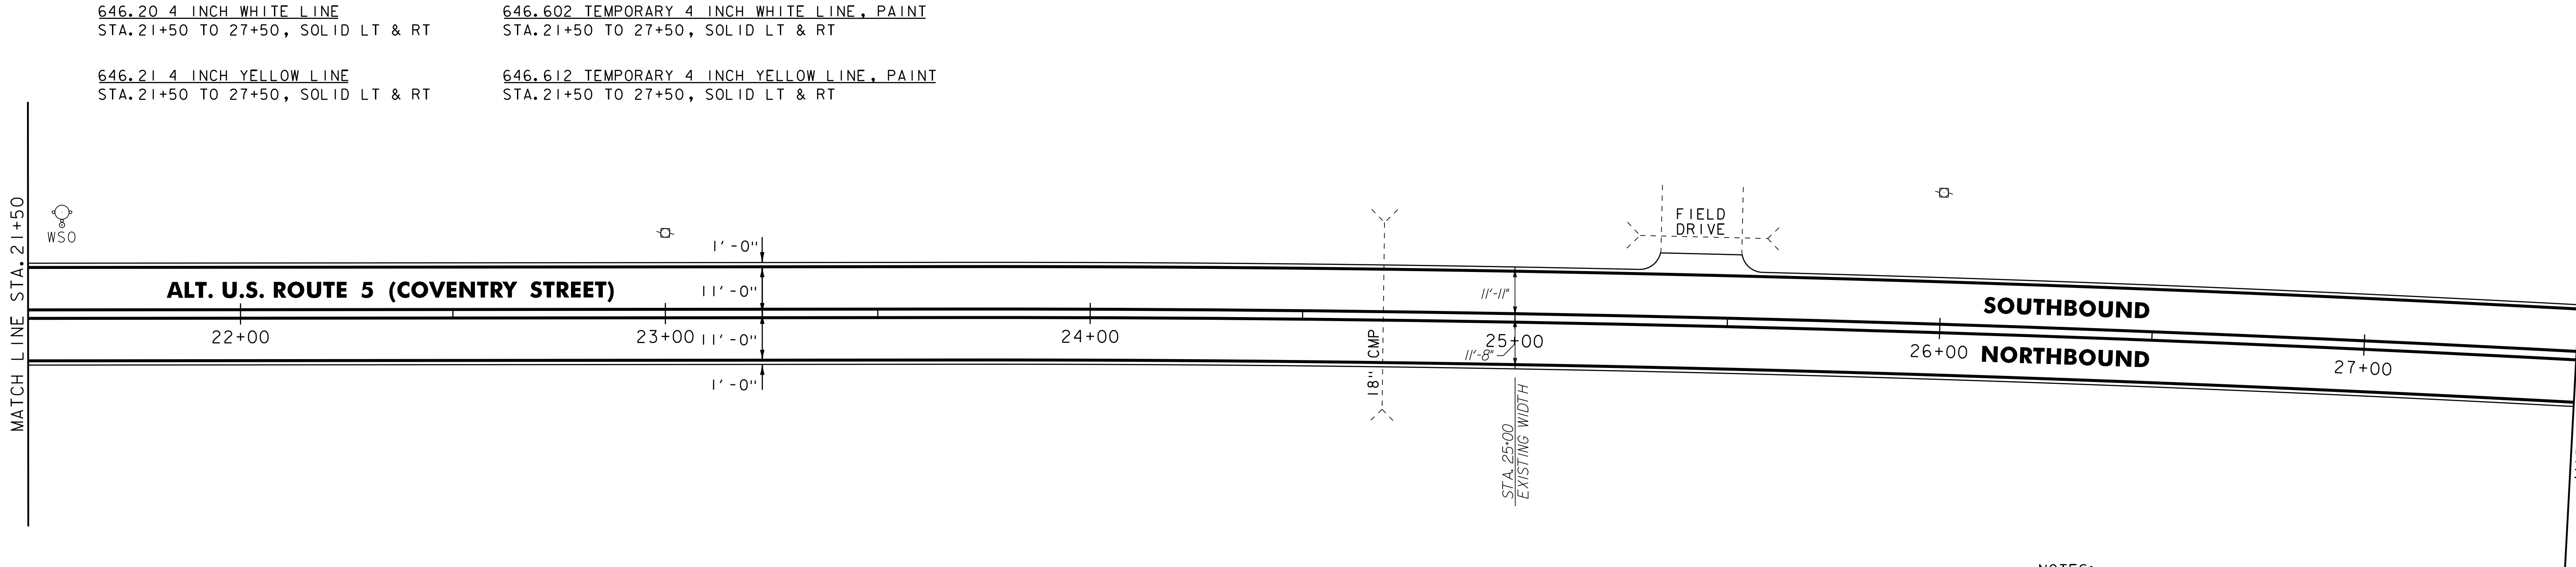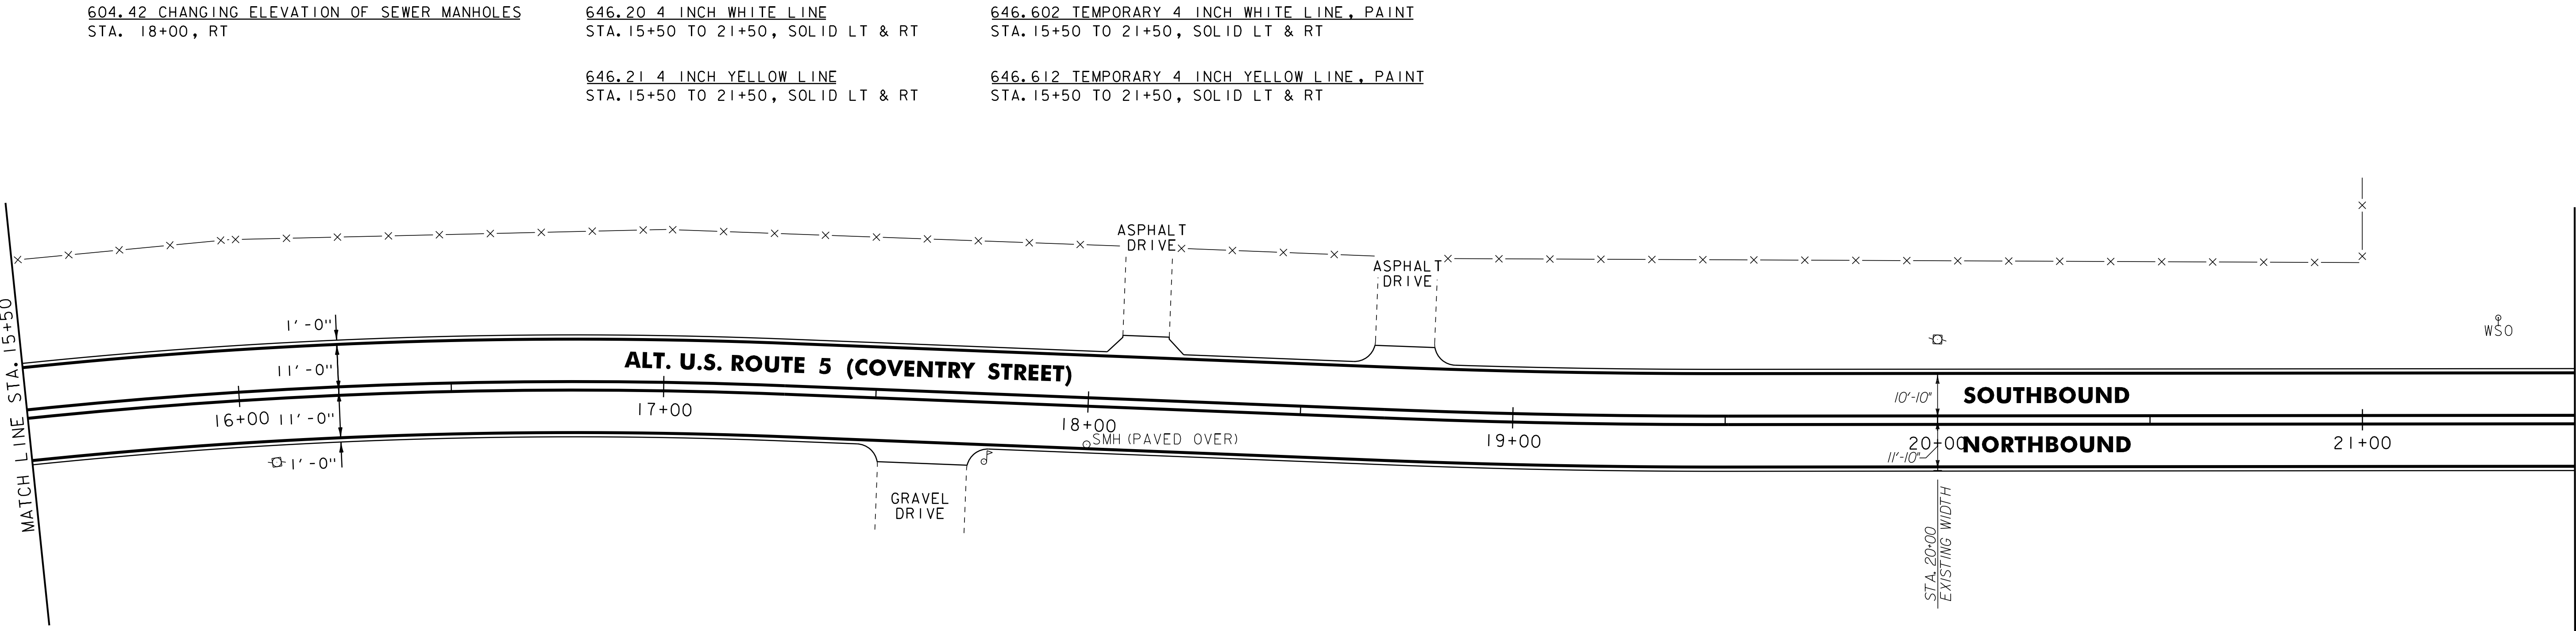

- NOTES:
- 1. ALL EXISTING SIGNS NOT SHOWN SHALL BE RETAINED.
 - 2. FOR LEGEND, SEE LAYOUT SHEET #1


NOT TO SCALE	PROJECT LAYOUT SHEET #3		PROJECT NAME: NEWPORT CITY	
			PROJECT NUMBER: STP 2719(1)	
			FILE NAME: 07D202.dgn	PLOT DATE: 29-JAN-2013 09:2
			PROJECT LEADER: JLL	DRAWN BY: STANTEC
			DESIGNED BY: STANTEC	CHECKED BY: JLL
			IPARM FILE: 07D202_14.i	SHEET 14 OF 62

646.20 4 INCH WHITE LINE
STA. 27+50 TO 33+50, SOLID LT & RT

646.602 TEMPORARY 4 INCH WHITE LINE, PAINT
STA. 27+50 TO 33+50, SOLID LT & RT

646.21 4 INCH YELLOW LINE
STA. 27+50 TO 33+50, SOLID LT & RT

646.612 TEMPORARY 4 INCH YELLOW LINE, PAINT
STA. 27+50 TO 33+50, SOLID LT & RT

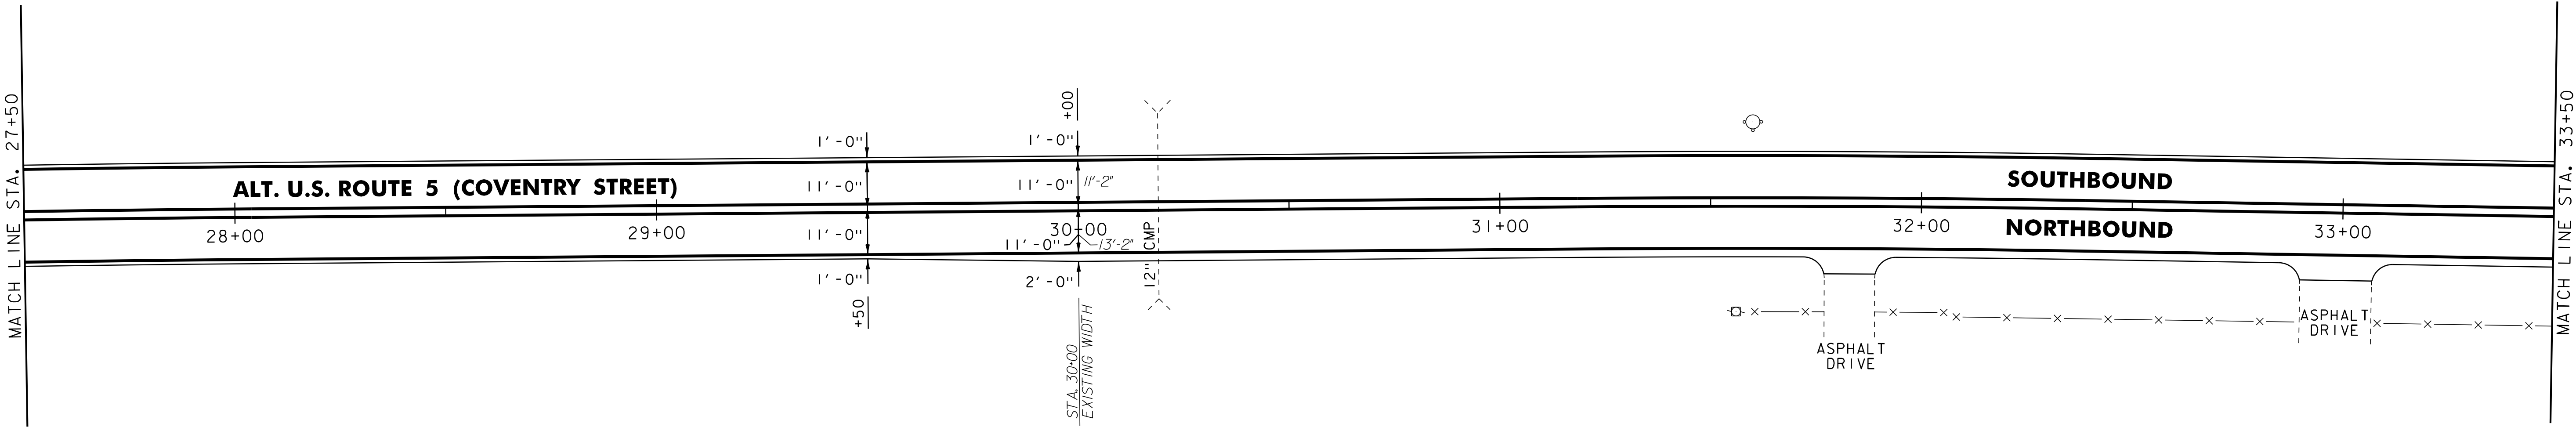


646.20 4 INCH WHITE LINE
STA. 33+50 TO 39+50, SOLID LT & RT

646.602 TEMPORARY 4 INCH WHITE LINE, PAINT
STA. 33+50 TO 39+50, SOLID LT & RT

646.21 4 INCH YELLOW LINE
STA. 33+50 TO 39+50, SOLID LT & RT

646.612 TEMPORARY 4 INCH YELLOW LINE, PAINT
STA. 33+50 TO 39+50, SOLID LT & RT

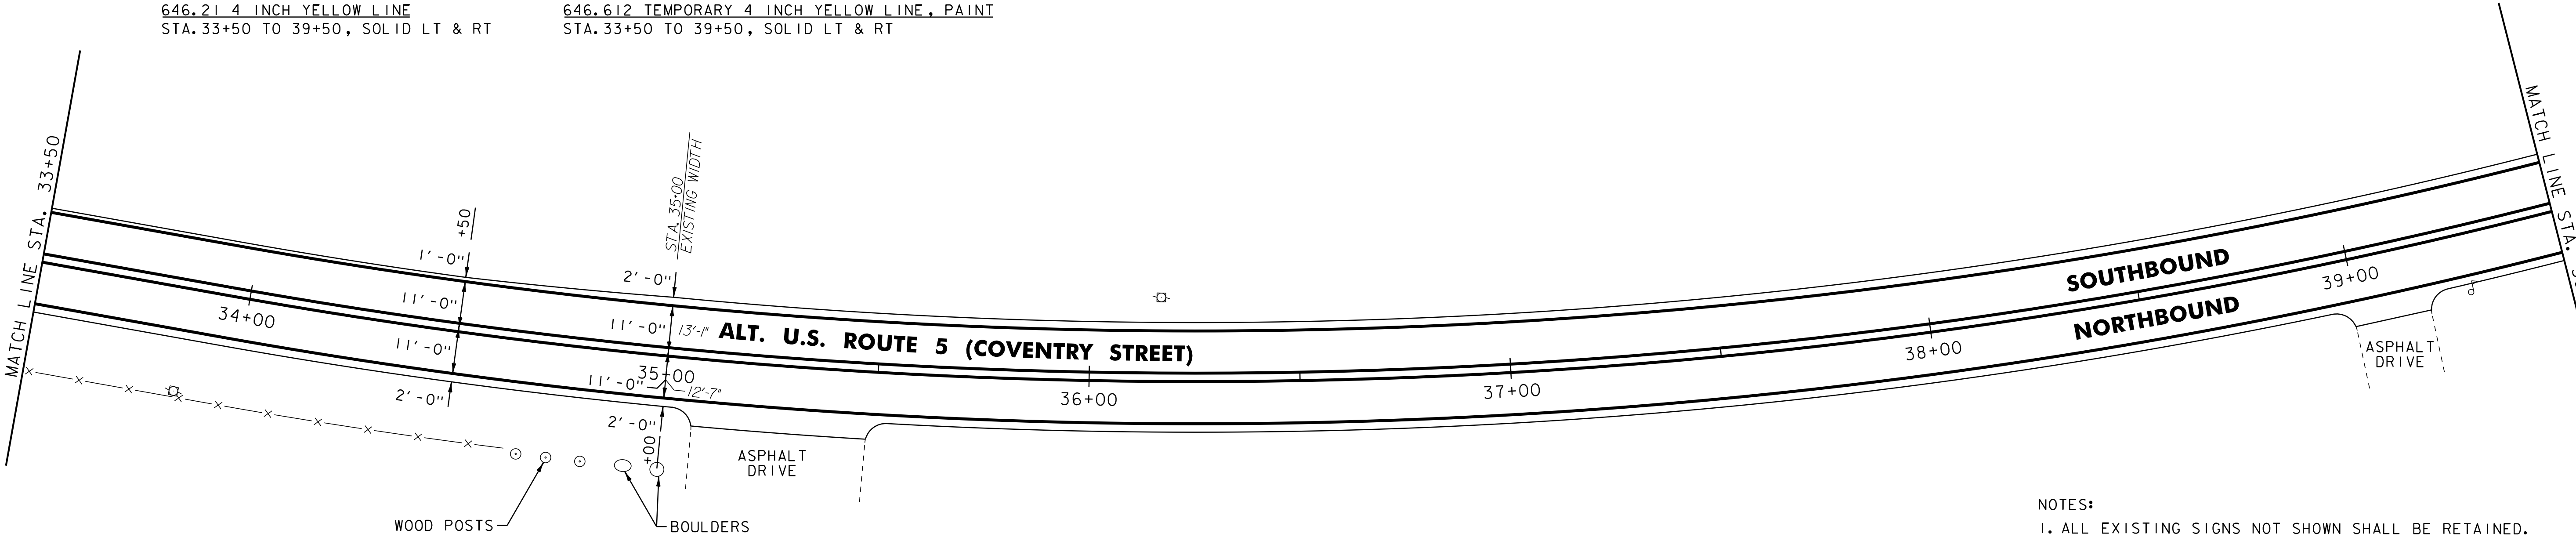

- NOTES:
1. ALL EXISTING SIGNS NOT SHOWN SHALL BE RETAINED.
 2. FOR LEGEND, SEE LAYOUT SHEET #1



NOT TO SCALE

PROJECT
LAYOUT
SHEET #4

PROJECT NAME: NEWPORT CITY
PROJECT NUMBER: STP 2719(I)

FILE NAME: 07D202.dgn
PROJECT LEADER: JLL
DESIGNED BY: STANTEC
IPARM FILE: 07D202_I5.i

PLOT DATE: 29-JAN-2013 09:2
DRAWN BY: STANTEC
CHECKED BY: JLL
SHEET 15 OF 62

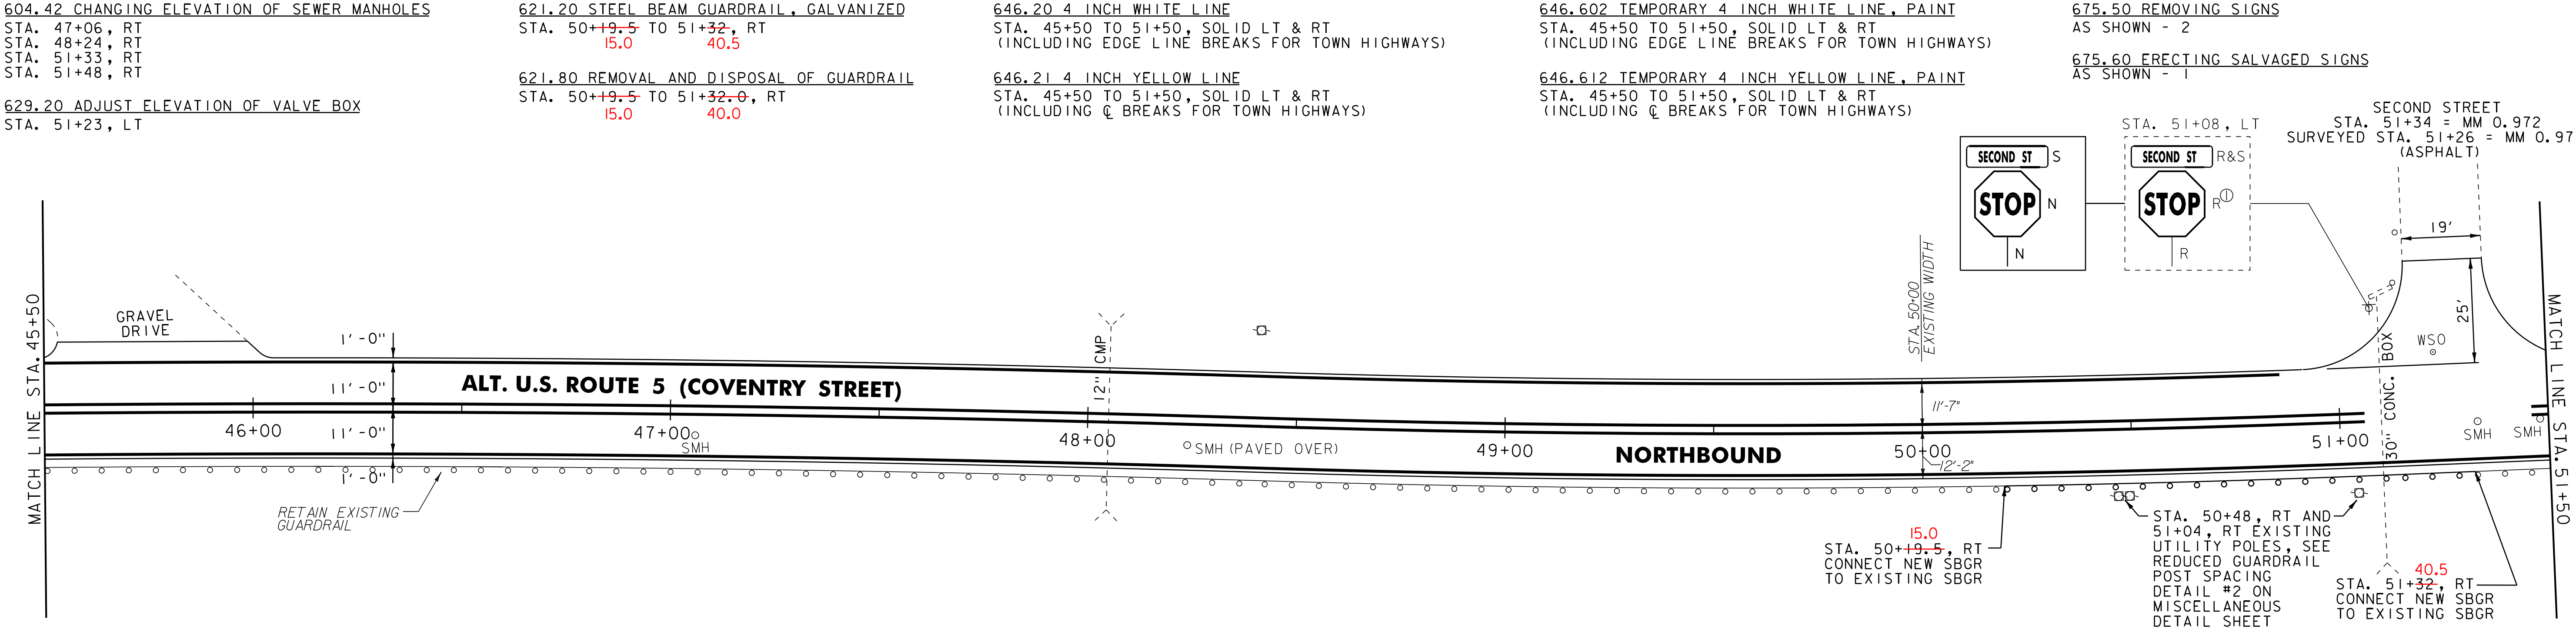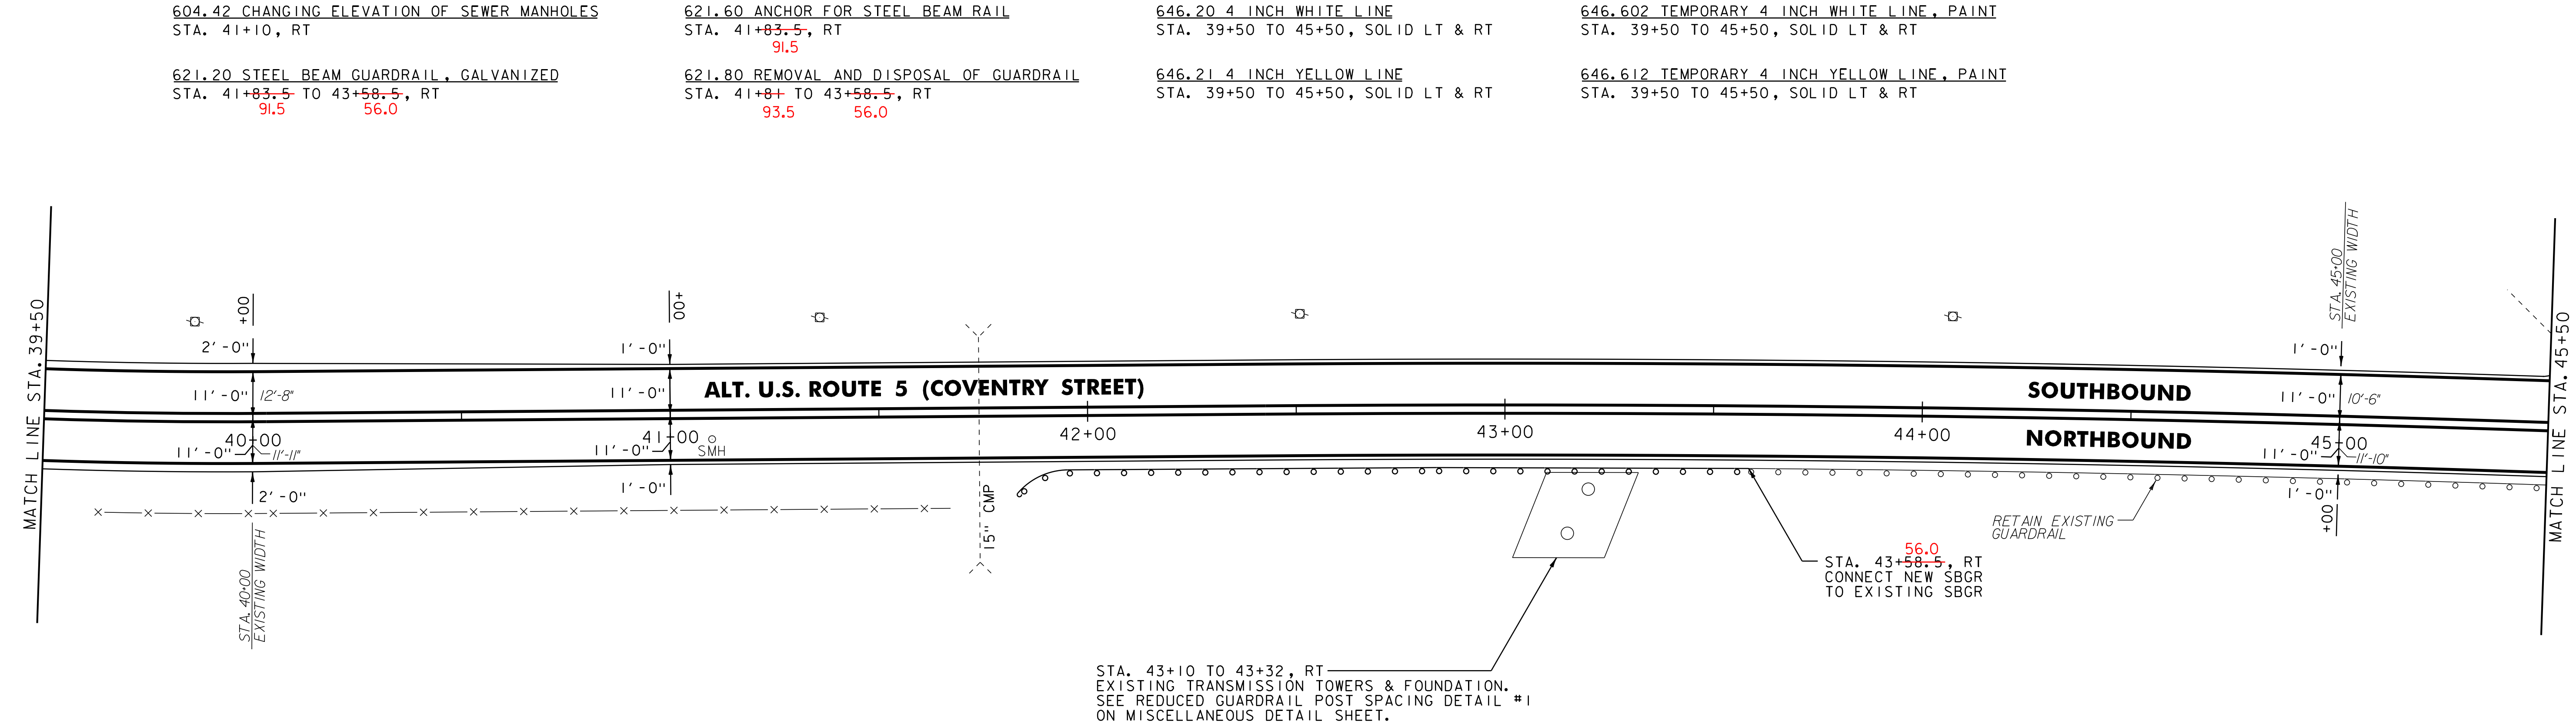

NOTES:

1. ALL EXISTING SIGNS NOT SHOWN SHALL BE RETAINED.

2. FOR LEGEND, SEE LAYOUT SHEET #1

NOT TO SCALE	
PROJECT LAYOUT SHEET #5	PROJECT NAME: NEWPORT CITY
	PROJECT NUMBER: STP 2719(I)
	FILE NAME: 07D202.dgn
	PROJECT LEADER: JLL
DESIGNED BY: STANTEC	DRAWN BY: STANTEC
	CHECKED BY: JLL
	IPARM FILE: 07D202_I6.i
PLOT DATE: 29-JAN-2013 09:2	
SHEET 16 OF 62	

604.42 CHANGING ELEVATION OF SEWER MANHOLES
STA. 53+88, RT
STA. 55+94, RT

629.20 ADJUST ELEVATION OF VALVE BOX
STA. 56+31, RT
STA. 57+08, RT

621.20 STEEL BEAM GUARDRAIL, GALVANIZED
STA. 51+95 TO 52+20, RT
90 17

621.60 ANCHOR FOR STEEL BEAM RAIL
STA. 52+20, RT
17


621.80 REMOVAL AND DISPOSAL OF GUARDRAIL
STA. 51+95 TO 52+20, RT
90 15

646.20 4 INCH WHITE LINE
STA.51+50 TO 57+50, SOLID LT & RT
(INCLUDE EDGE LINE BREAKS FOR TOWN HIGHWAYS)

646.21 4 INCH YELLOW LINE
STA. 51+50 TO 57+50, SOLID LT & RT

646.602 TEMPORARY 4 INCH WHITE LINE, PAINT
STA.51+50 TO 57+50, SOLID LT & RT
(INCLUDE EDGE LINE BREAKS FOR TOWN HIGHWAYS)

646.612 TEMPORARY 4 INCH YELLOW LINE, PAINT
STA. 51+50 TO 57+50, SOLID LT & RT

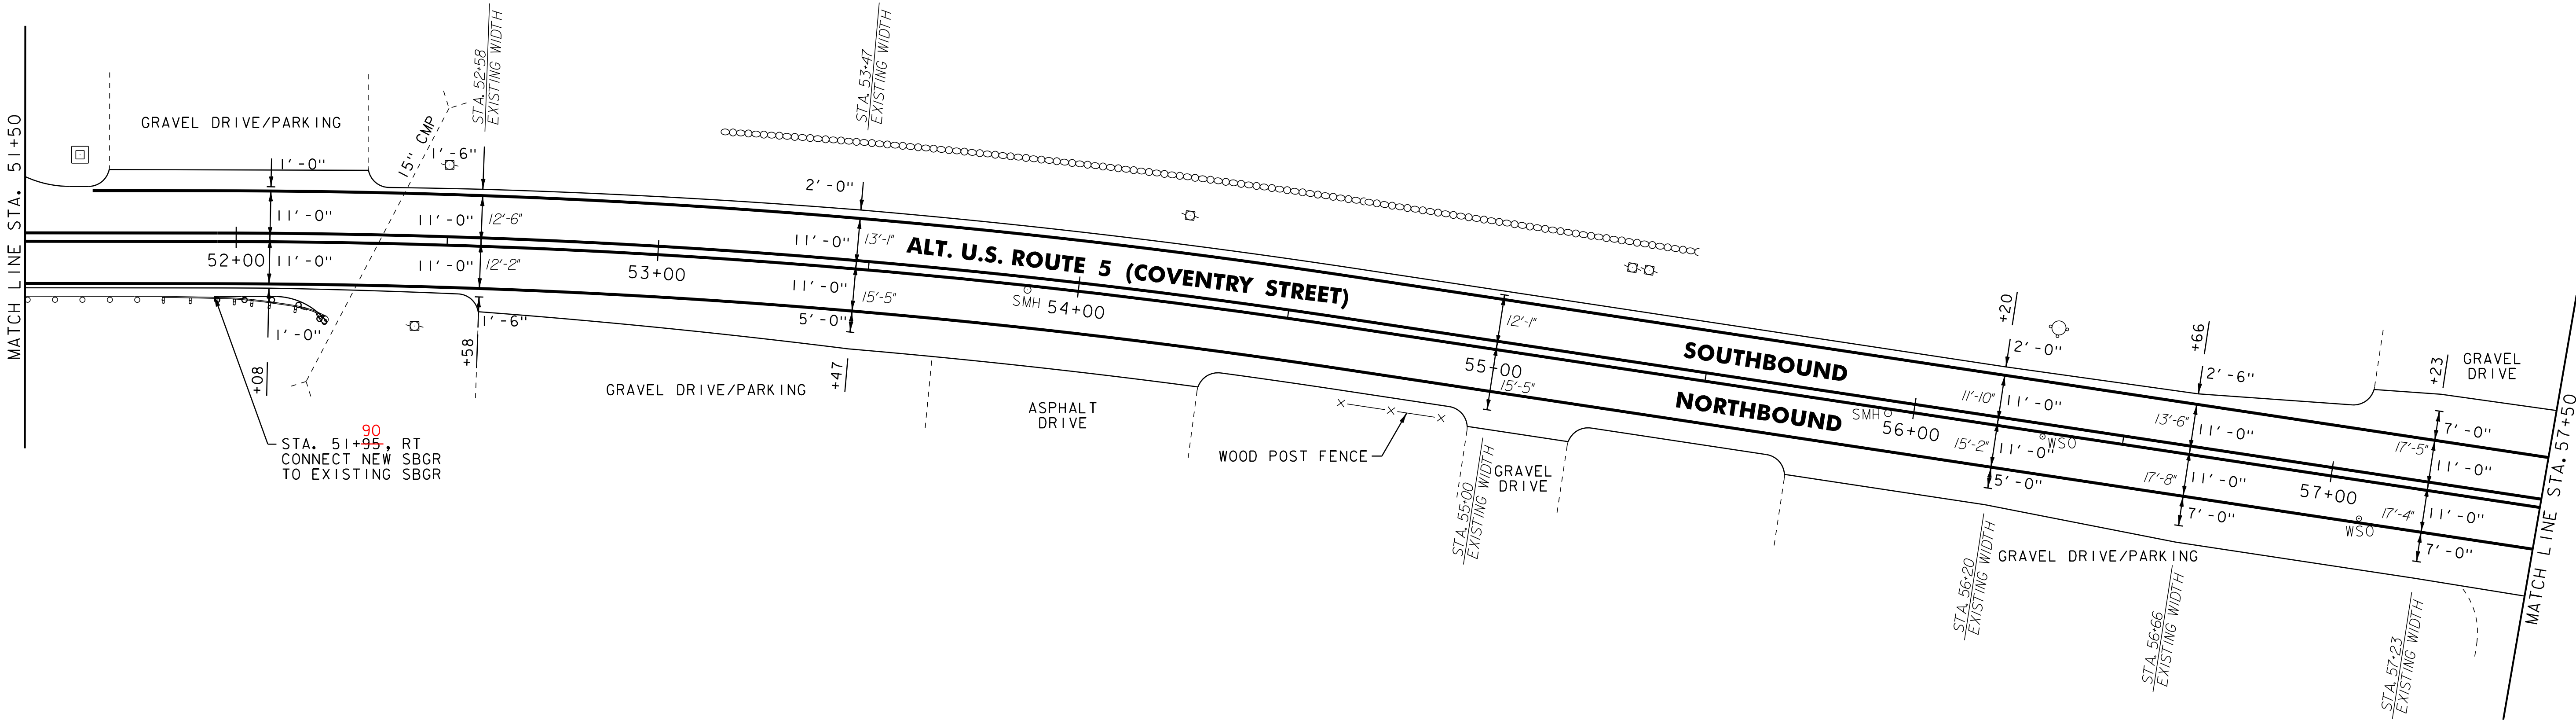

NOTES:
1. ALL EXISTING SIGNS NOT SHOWN SHALL BE RETAINED.
2. FOR LEGEND, SEE LAYOUT SHEET #1

NOT TO SCALE

PROJECT
LAYOUT
SHEET #6

PROJECT NAME: NEWPORT CITY
PROJECT NUMBER: STP 2719(I)

FILE NAME: 07D202.dgn
PROJECT LEADER: JLL
DESIGNED BY: STANTEC
IPARM FILE: 07D202_17.i

PLOT DATE: 29-JAN-2013 09:2
DRAWN BY: STANTEC
CHECKED BY: JLL
SHEET 17 OF 62

604.412, 604.415 OR 604.418 REHAB.
DIS, CBS OR MHS, CLASS I, II OR III
STA. 58+52, LT
STA. 58+69, RT
STA. 58+97, LT
STA. 59+11, LT
STA. 61+46, LT

604.42 CHANGING ELEVATION OF SEWER MANHOLES
STA. 57+93, RT
STA. 59+09, RT
STA. 61+40, LT
STA. 61+56, RT
STA. 62+40, RT
STA. 63+02, LT

616.28 CAST-IN-PLACE CONCRETE CURB, TYPE B
STA. 59+04, LT

616.41 REMOVAL OF EXISTING CURB
STA. 59+04, LT

618.10 PORTLAND CEMENT CONCRETE SIDEWALK, 5 INCH
STA. 59+04, LT

618.30 DETECTABLE WARNING SURFACE
STA. 59+04, LT

629.20 ADJUST ELEVATION OF VALVE BOX
STA. 60+57, LT

646.20 4 INCH WHITE LINE
STA. 57+50 TO 63+50, SOLID LT & RT
(INCLUDE EDGE LINE BREAKS FOR TOWN HIGHWAYS)

646.21 4 INCH YELLOW LINE
STA. 57+50 TO 63+50, SOLID LT & RT
(INCLUDE C BREAKS FOR TOWN HIGHWAYS)
STA. 59+06, DOUBLE SOLID LT (EASTERN AVE.)

646.26 24 INCH STOP BAR
STA. 59+06, LT (EASTERN AVE.)

646.30 LETTER OR SYMBOL
STA. 59+06, LT - "STOP" (EASTERN AVE.)

646.31 CROSSWALK MARKING
STA. 59+04, LT TO 59+15, RT

646.602 TEMPORARY 4 INCH WHITE LINE, PAINT
STA. 57+50 TO 63+50, SOLID LT & RT
(INCLUDE EDGE LINE BREAKS FOR TOWN HIGHWAYS)


646.612 TEMPORARY 4 INCH YELLOW LINE, PAINT
STA. 57+50 TO 63+50, SOLID LT & RT
(INCLUDE C BREAKS FOR TOWN HIGHWAYS)
STA. 59+06, DOUBLE SOLID LT (EASTERN AVE.)

646.682 TEMPORARY 24 INCH STOP BAR, PAINT
STA. 59+06, LT (EASTERN AVE.)

646.692 TEMPORARY LETTER OR SYMBOL, PAINT
STA. 59+06, LT - "STOP" (EASTERN AVE.)

646.702 TEMPORARY CROSSWALK MARKING, PAINT
STA. 59+04, LT TO 59+15, RT

675.50 REMOVING SIGNS
AS SHOWN - 1

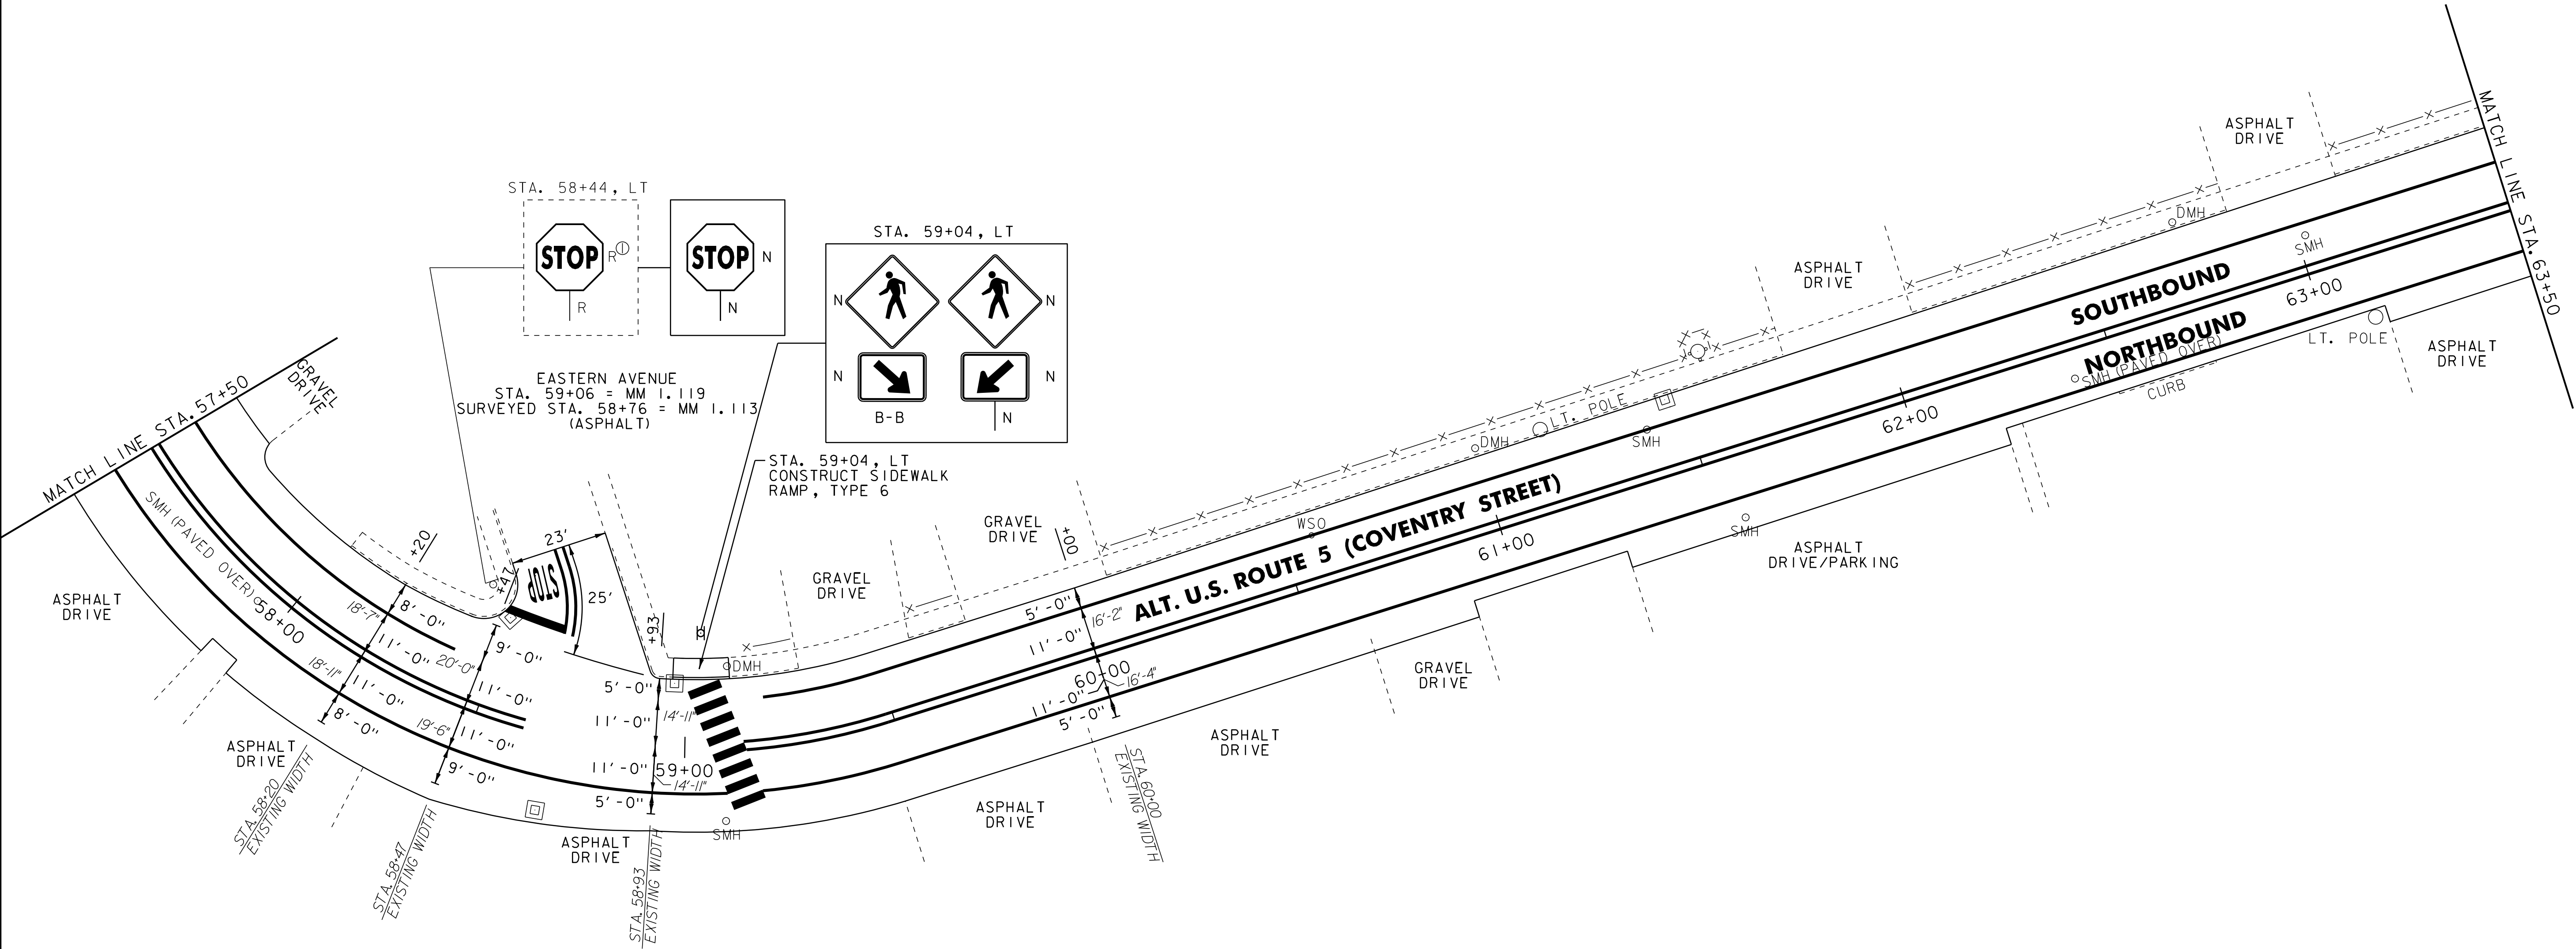

NOTES:
1. ALL EXISTING SIGNS NOT SHOWN SHALL BE RETAINED.
2. FOR LEGEND, SEE LAYOUT SHEET #1

NOT TO SCALE

PROJECT
LAYOUT
SHEET #7




PROJECT NAME: NEWPORT CITY
PROJECT NUMBER: STP 2719(I)

FILE NAME: 07D202.dgn
PROJECT LEADER: JLL
DESIGNED BY: STANTEC
IPARM FILE: 07D202_I8.i


PLOT DATE: 29-JAN-2013 09:2
DRAWN BY: STANTEC
CHECKED BY: JLL
SHEET 18 OF 62

PLOT DATE: 29-JAN-2013 09:2
DRAWN BY: STANTEC
CHECKED BY: JLL
SHEET 19 OF 62

TRAFFIC SIGN SUMMARY SHEET 01

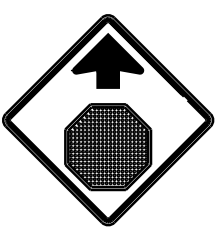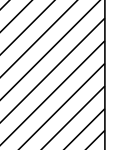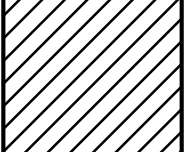MILEMARKER, STATION, OR SIGN NUMBER	SIGN LEGEND	SIGN DIMENSIONS			NEW & SALVAGED SIGNS				EXIST POST RETAIN		NO. OF POSTS	NEW SIGN POSTS											REMARKS	SIGN DETAIL											
												FLANGED CHANNEL			SQUARE STEEL (in)			TUBULAR ALUMINUM Ø (in)			TUBULAR STEEL Ø (in)				W-SHAPE STEEL			DETAIL ON SHEET NUMBER	STD. SHEET NUMBER						
		EA	WIDTH (in)	HEIGHT (in)	"A"	"B"	SALV SIGN	SALV TIS	1.75	2.0		2.5	ANCHOR	SLEEVE	3.0	4.0	4.0 MOD	FOUND-ATION	3.0	3.5	4.0	5.0		FTG. SIZE		WEIGHT	POST SIZE								
																								1.75	2.0					2.5	3.0	4.0	4.0 MOD	24"	30"
ALT. U.S. ROUTE 5												OPTION ITEMS																							
0+94, LT		I	36	36	9.00						2					X		X														SIGN ID CODE RI-I		SEE FHWA SHS	
6+50, RT		I	24	30	5.00						1					X		X														SEE FHWA SHS			
6+84, LT		I	36	36	9.00						2					X		X													SIGN ID CODE W3-1A		SEE FHWA SHS		
24+00, RT		I	24	30	5.00						1					X		X													SEE FHWA SHS				
51+08, LT	SECOND ST 	I	30	30	6.25			I			1					X		X													INSTALL SALVAGED STREET SIGN 90 DEGREES TO AND 6" ABOVE STOP SIGN.		SEE FHWA SHS		
29+65, LT		I	24	30	5.00						1					X		X													SEE FHWA SHS				
58+44, LT		I	30	30	6.25						1					X		X													SIGN ID CODE RI-I		SEE FHWA SHS		
46+95, LT		I	24	30	5.00						1					X		X													SEE FHWA SHS				
59+04, LT	 B-B	2	30	30	12.50						1					X		X													SIGN ID CODE W11-2 (FLUORESCENT YELLOW-GREEN)		SEE FHWA SHS		
		2	24	12	4.00																										SIGN ID CODE W16-7P (FLUORESCENT YELLOW-GREEN)		SEE FHWA SHS		
49+50, RT							2																								DAMAGED POST, EXISTING REGULATORY SIGNS SALVAGED TO NEW POST				
63+95, RT	 	I	30	30	6.25						1					X		X													SIGN ID CODE W11-2 (FLUORESCENT YELLOW-GREEN)		SEE FHWA SHS		
		I	24	12	2.00																										SIGN ID CODE W16-7P (FLUORESCENT YELLOW-GREEN)		SEE FHWA SHS		
64+00, LT	 	I	30	30	6.25						1					X		X													SIGN ID CODE W11-2 (FLUORESCENT YELLOW-GREEN)		SEE FHWA SHS		
		I	24	12	2.00																										SIGN ID CODE W16-7P (FLUORESCENT YELLOW-GREEN)		SEE FHWA SHS		
FINAL POST LENGTHS ARE TO BE DETERMINED IN THE FIELD. POST SIZES ARE COMPUTED BASED ON INFORMATION FURNISHED ON THE STANDARD SHEETS AND THE VTRANS "SIGN POST DESIGN GUIDELINE."												FT	FT	FT	FT	FT	135	FT		EA	LB	LB	LB		LB	LB	LB	LB					PROJECT NAME: NEWPORT CITY PROJECT NUMBER: STP 2719(I)		
												FT			FT						EA	LB										FILE NAME: 07D202.dgn PROJECT LEADER: JLL DESIGNED BY: STANTEC IPARM FILE: 07D202_20.1		PLOT DATE: 29-JAN-2013 09: DRAWN BY: STANTEC CHECKED BY: JLL SHEET 20 OF 62	
TOTALS					SF	SF	EA	SF				FT			FT								LB												

VEHICLE LOOP DETECTORS												
LAYOUT SHEET	LOOP NO.	LANE	CALL Ø	SIZE (FT)	TYPE & NO. TURNS	DELAY OR PRESENCE	INDUCTANCE		RESISTANCE		LEAKAGE TO GROUND	LOCKING MEMORY
							CALC.	ACT.	CALC.	ACT.		
8	1	ALT. U.S ROUTE 5 LEFT ONLY		6' X 35'	QUAD - 2	PRESENCE	340		0.496			YES
8	2	ALT. U.S. ROUTE 5 RIGHT/THROUGH		6' X 35'	QUAD - 2	PRESENCE	338		0.460			NO
ALL CALCULATED VALUES ARE AT THE CONTROLLER. MEASURED VALUES MUST BE FILLED IN PRIOR TO TEST PERIOD.												

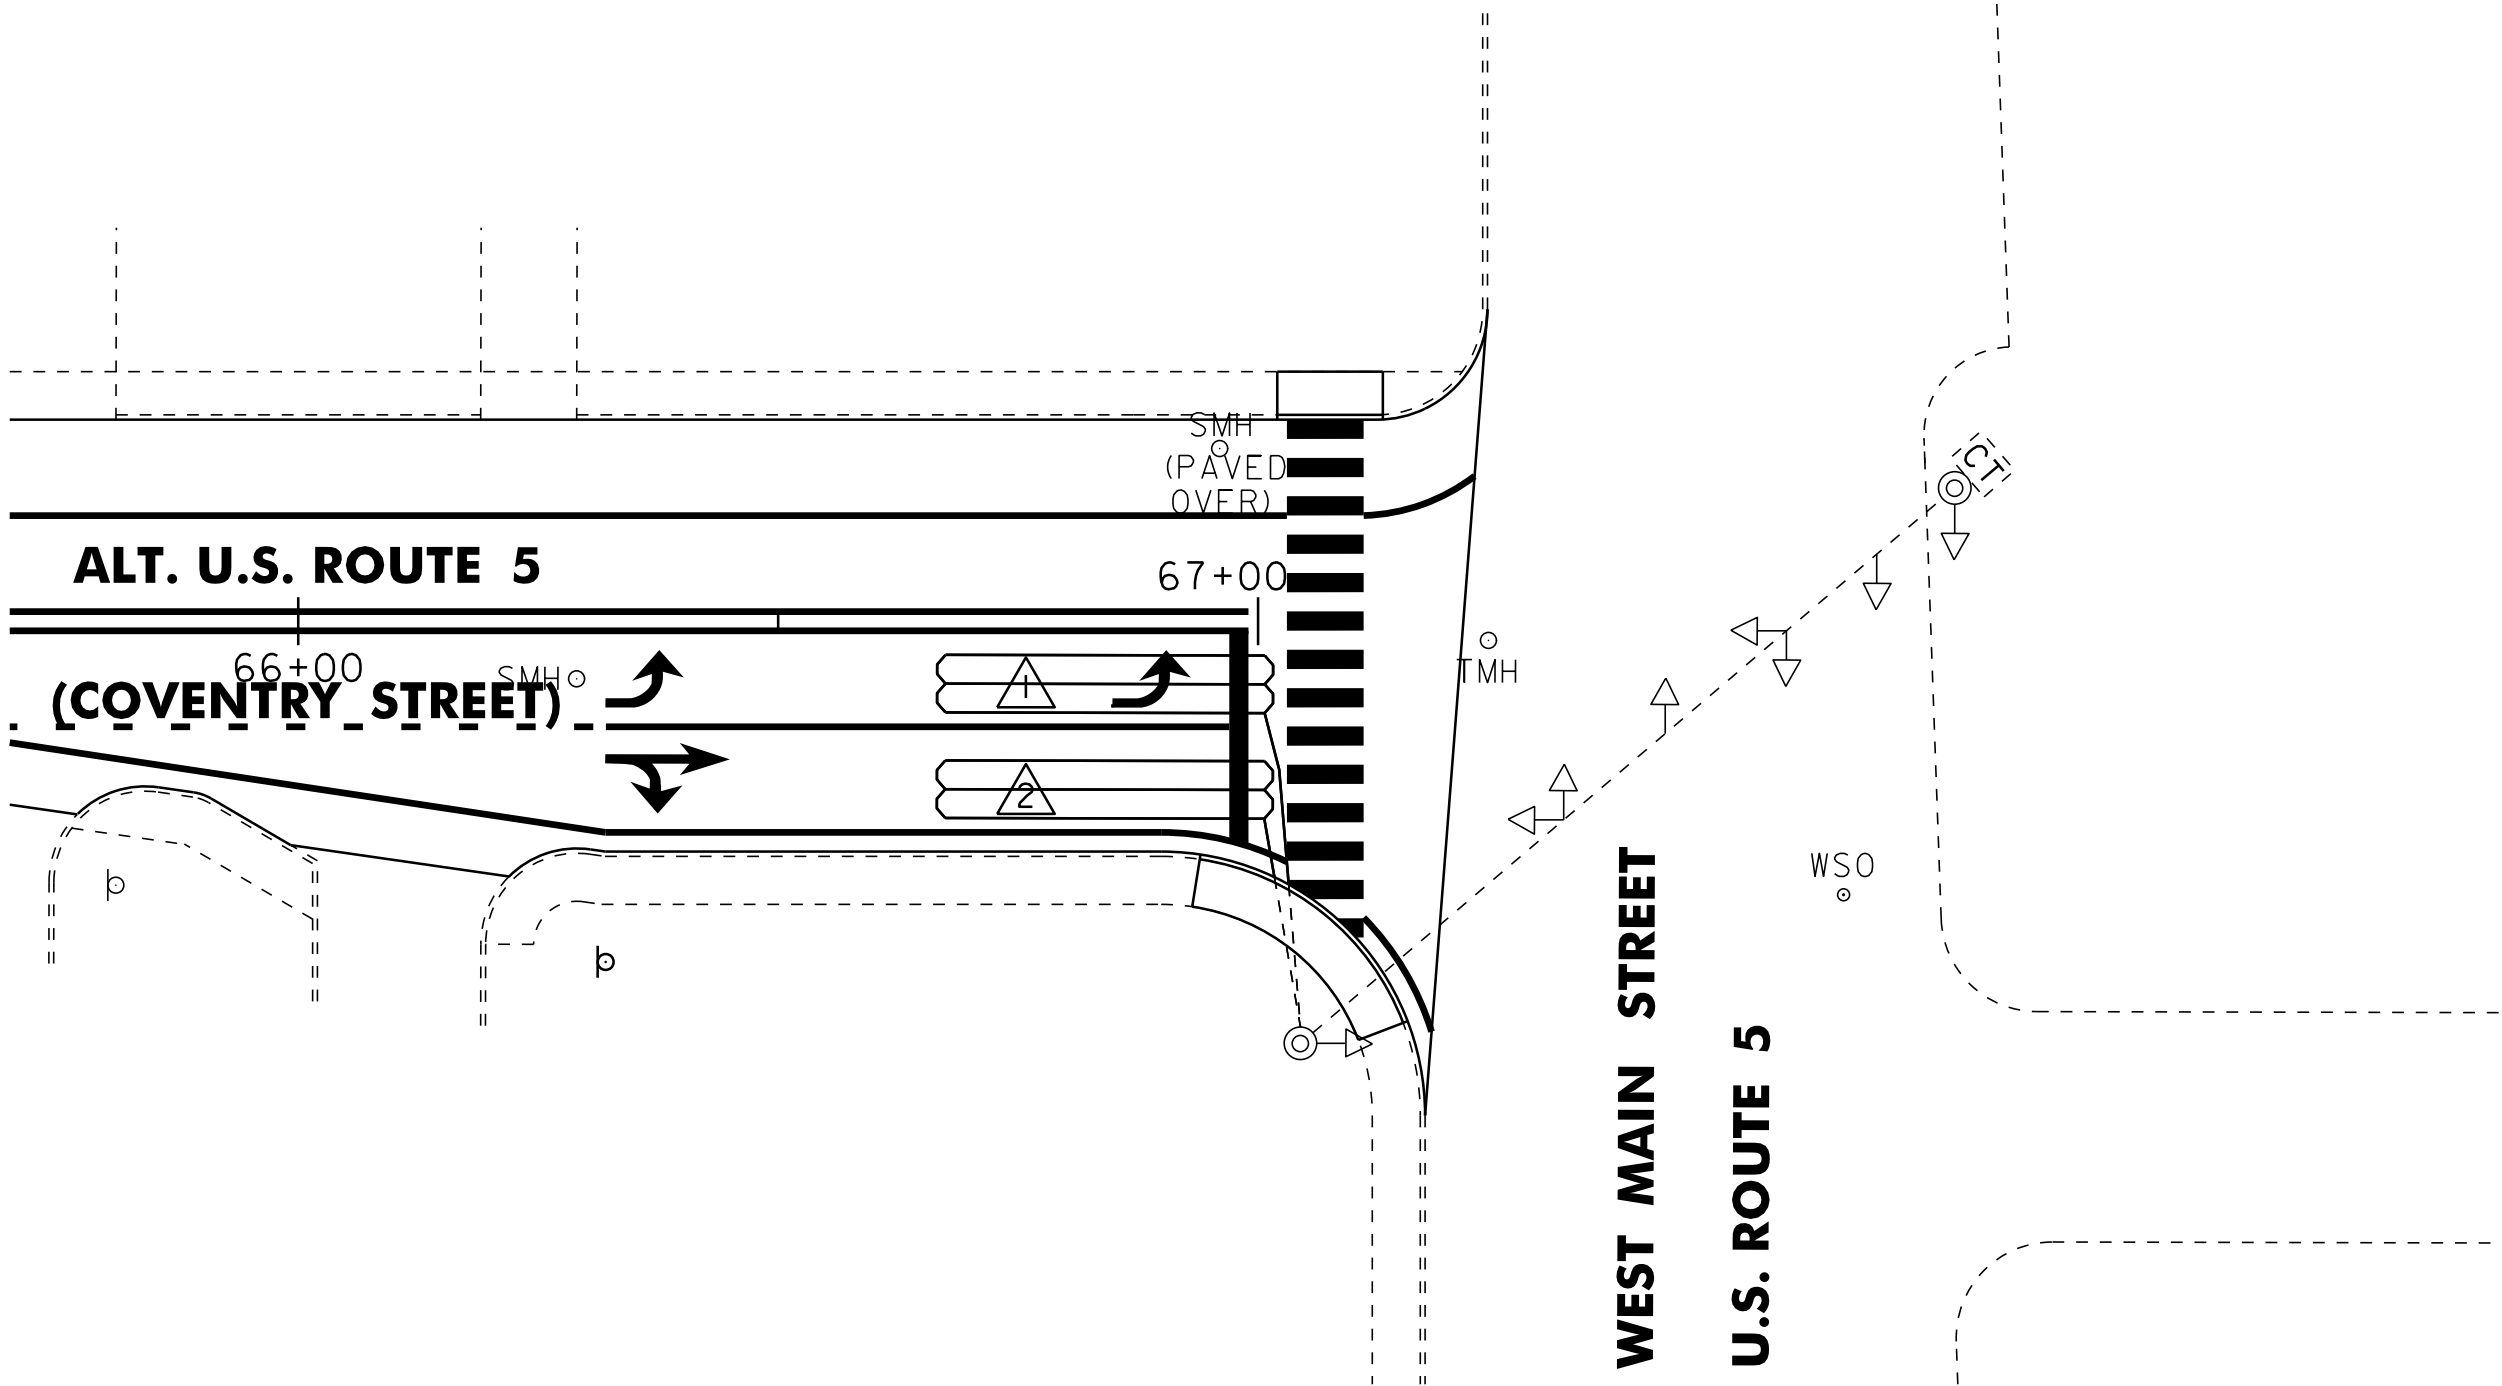

ALT. U.S. ROUTE 5 – WEST MAIN STREET (U.S. ROUTE 5) INTERSECTION

LEGEND	
DESCRIPTION	
---	EXISTING CONDUIT
□	EXISTING JUNCTION BOX
⊙	EXISTING CONTROLLER CABINET
⊙	EXISTING STRAIN POLE
▭	VEHICLE LOOP DETECTOR
◁	EXISTING SIGNAL
⊠	EXISTING PULL BOX
△	LOOP NO.

NOTES:

PRIOR TO COLD PLANING, ANY VEHICLE LOOP DETECTORS SHALL BE DISCONNECTED IN THE CONTROLLER CABINET AND CUT AT THE CURB.


ONCE THE LOOP IS DISCONNECTED, THE SIGNAL PHASE THAT IT WAS CALLING SHALL BE PUT ON MAX RECALL OR THE SIGNAL PUT ON FLASH AND TRAFFIC CONTROLLED BY A UNIFORMED TRAFFIC OFFICER.

ALL BITUMINOUS AREAS TO RECEIVE NEW VEHICLE LOOP DETECTORS SHALL BE LEVELED WITH TYPE IVS SUPERPAVE BITUMINOUS CONCRETE PAVEMENT AS DIRECTED BY THE RESIDENT ENGINEER PRIOR TO THE INSTALLATION OF THE NEW LOOP DETECTORS.

AFTER THE NEW LOOPS ARE INSTALLED, THE INDUCTANCE RESISTANCE AND LEAKAGE TO GROUND SHALL BE TESTED USING PROPERLY CALIBRATED EQUIPMENT. THE TEST RESULTS SHALL BE COMPARED WITH THE CALCULATED VALUES AND RECORDED ON THE PLANS. ALL LOAD TESTING SHALL BE PERFORMED AS PER VTRANS STANDARD E-172.

AFTER ACCEPTANCE OF THE LOOP INSTALLATION BY THE RESIDENT ENGINEER, RETURN THE SIGNAL TO NORMAL OPERATION. ALL WORK REQUIRED SHALL BE INCLUDED IN THE UNIT PRICE BID FOR ITEM 678.22, VEHICLE LOOP DETECTOR.

NOT TO SCALE VEHICLE LOOP DETECTOR DETAIL SHEET	PROJECT NAME: NEWPORT CITY	
	PROJECT NUMBER: STP 2719(I)	
	FILE NAME: 07D202.dgn	PLOT DATE: 29-JAN-2013 09:2
	PROJECT LEADER: JLL	DRAWN BY: STANTEC
DESIGNED BY: STANTEC		CHECKED BY: JLL
IPARM FILE: 07D202_22.i		SHEET 22 OF 62

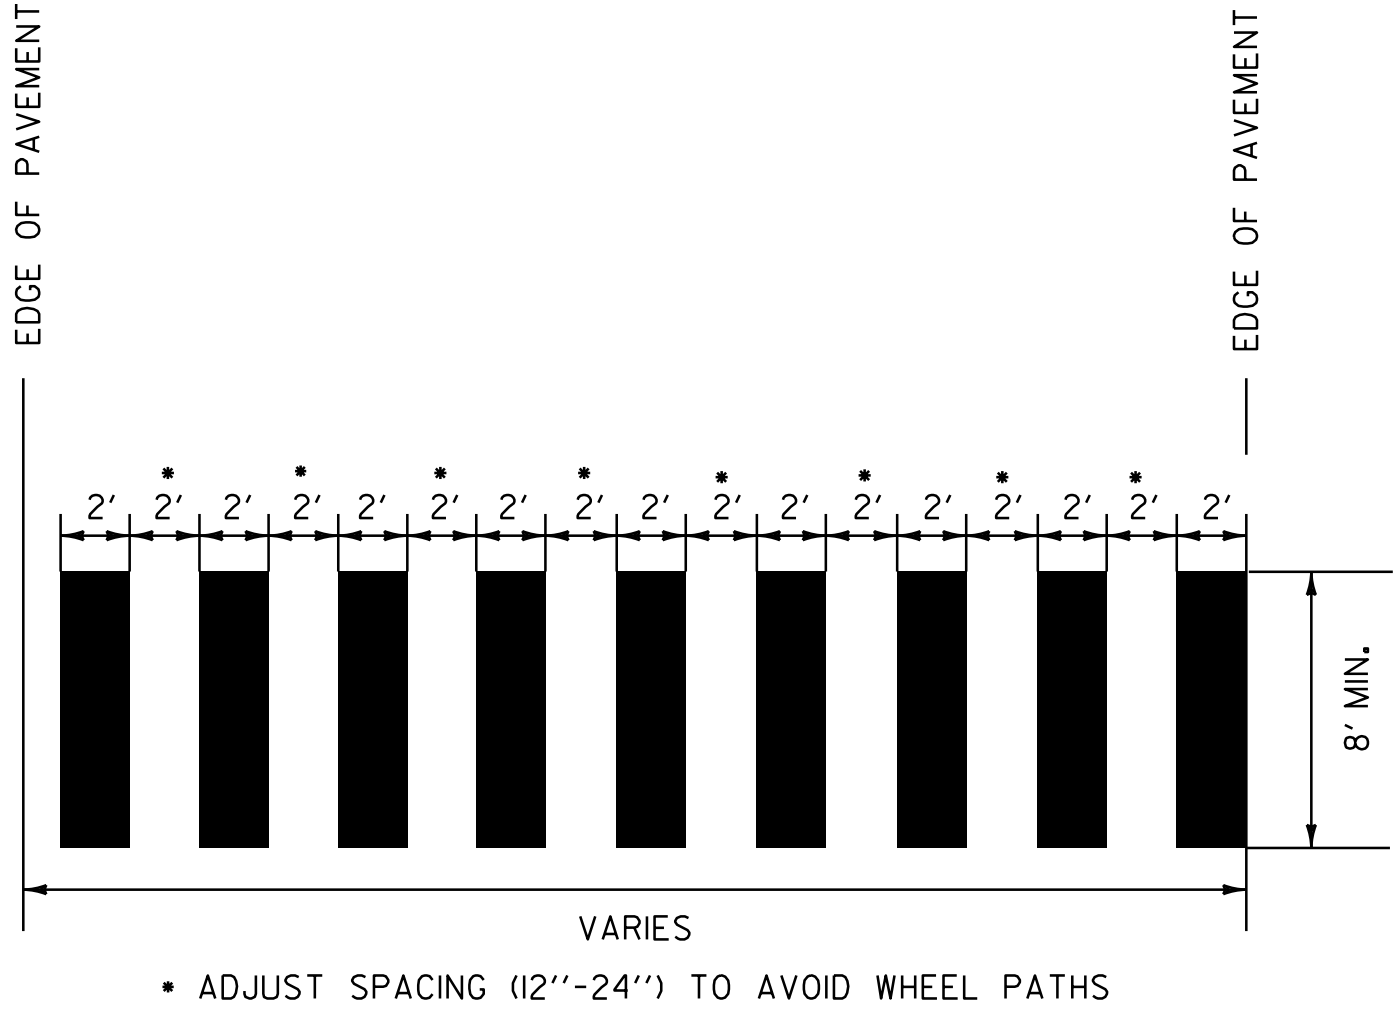

BLOCK PATTERN CROSSWALK DETAIL

SEE LAYOUT SHEETS FOR LOCATIONS.
ALL BLOCK PATTERN CROSS WALKS SHALL BE
INSTALLED PARALLEL WITH WHEEL PATHS.

REHAB. DI'S, CB'S or MH'S, CLASS I, II, OR III
(ITEM 604.412, 604.415, OR 604.418)


ALT. U.S. ROUTE 5

STATION	POSITION	DESCRIPTION
58+52	LT	DI
58+69	RT	DI
58+97	LT	DI
59+11	LT	DMH
61+46	LT	DI
64+75	LT	DI
64+95	LT	DMH

CHANGING ELEVATION OF SEWER MANHOLES
(ITEM 604.42)


ALT. U.S. ROUTE 5

STATION	POSITION	DESCRIPTION
6+15	C/L	SMH
9+46	RT	SMH
18+00	RT	SMH
41+10	RT	SMH
47+06	RT	SMH
48+24	RT	SMH
51+33	RT	SMH
51+48	RT	SMH
53+88	RT	SMH
55+94	RT	SMH
57+93	RT	SMH
59+09	RT	SMH
61+40	LT	SMH
61+56	RT	SMH
62+40	RT	SMH
63+02	LT	SMH
65+00	LT	SMH
65+00	RT	SMH
66+29	RT	SMH
66+96	LT	SMH

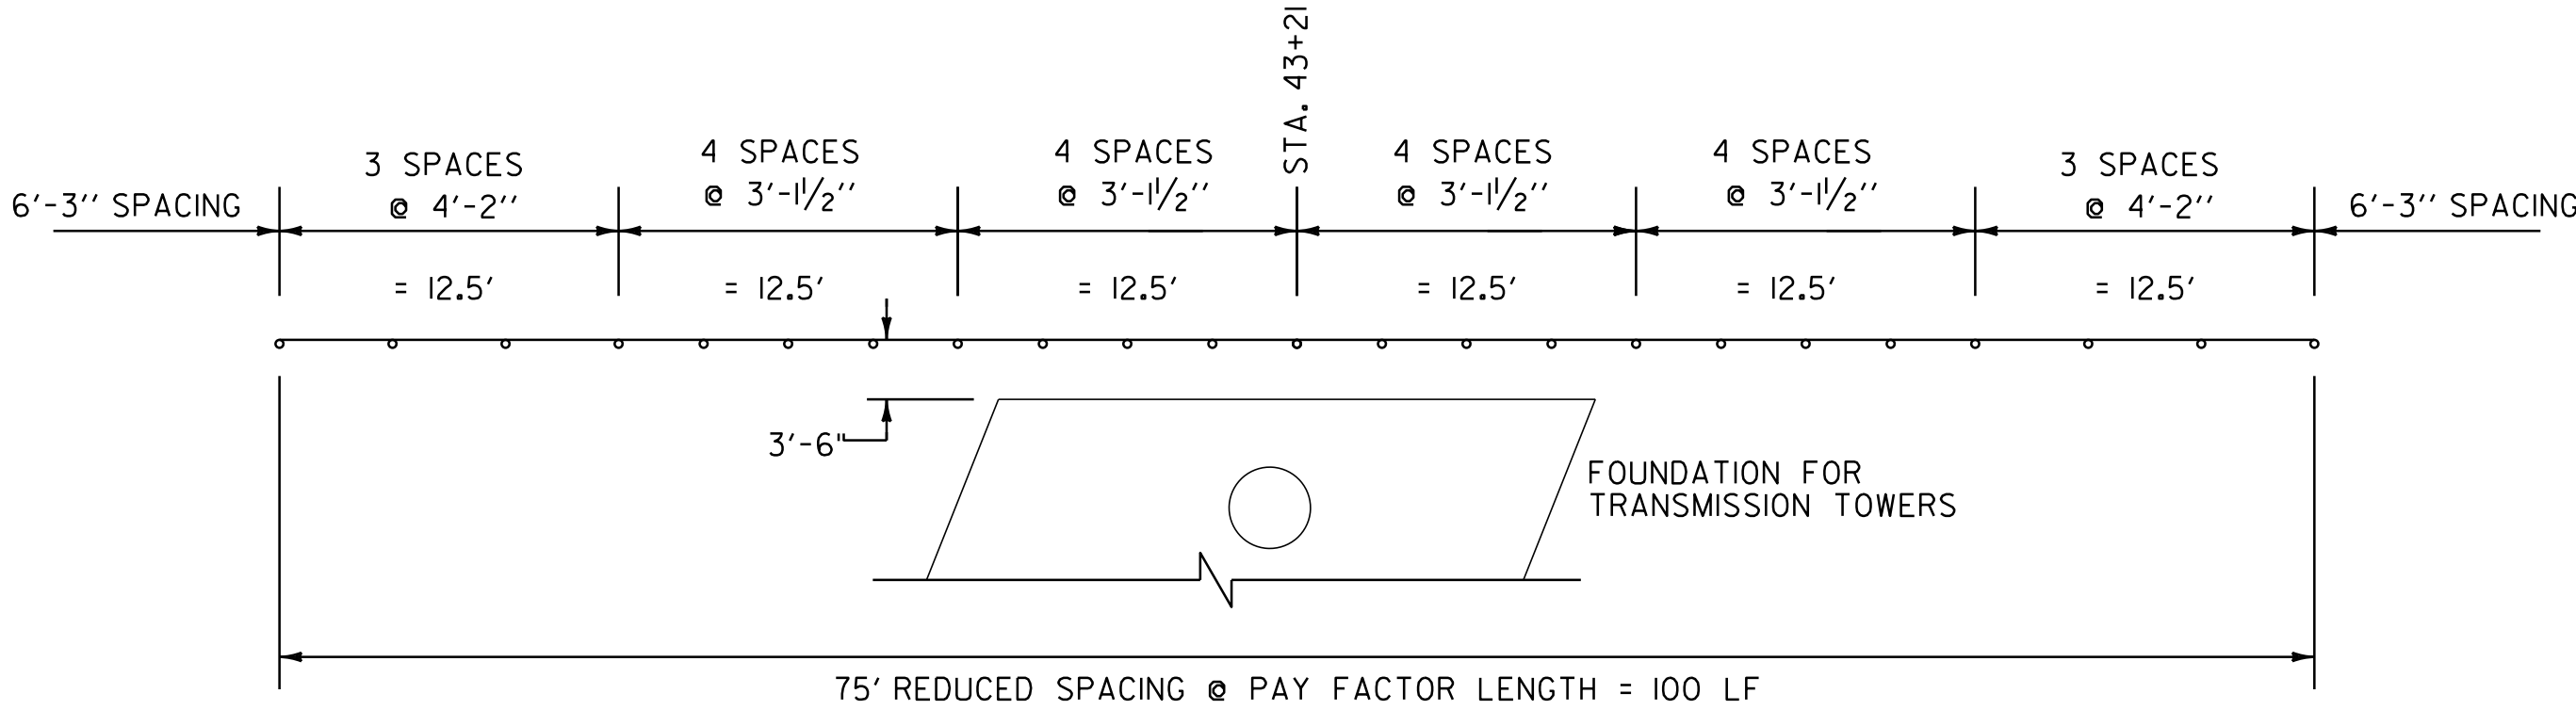

REDUCED GUARDRAIL POST SPACING DETAIL #1

TRANSMISSION TOWER FOUNDATION
(N.T.S.)
STA. 43+10 - 43+32, RT

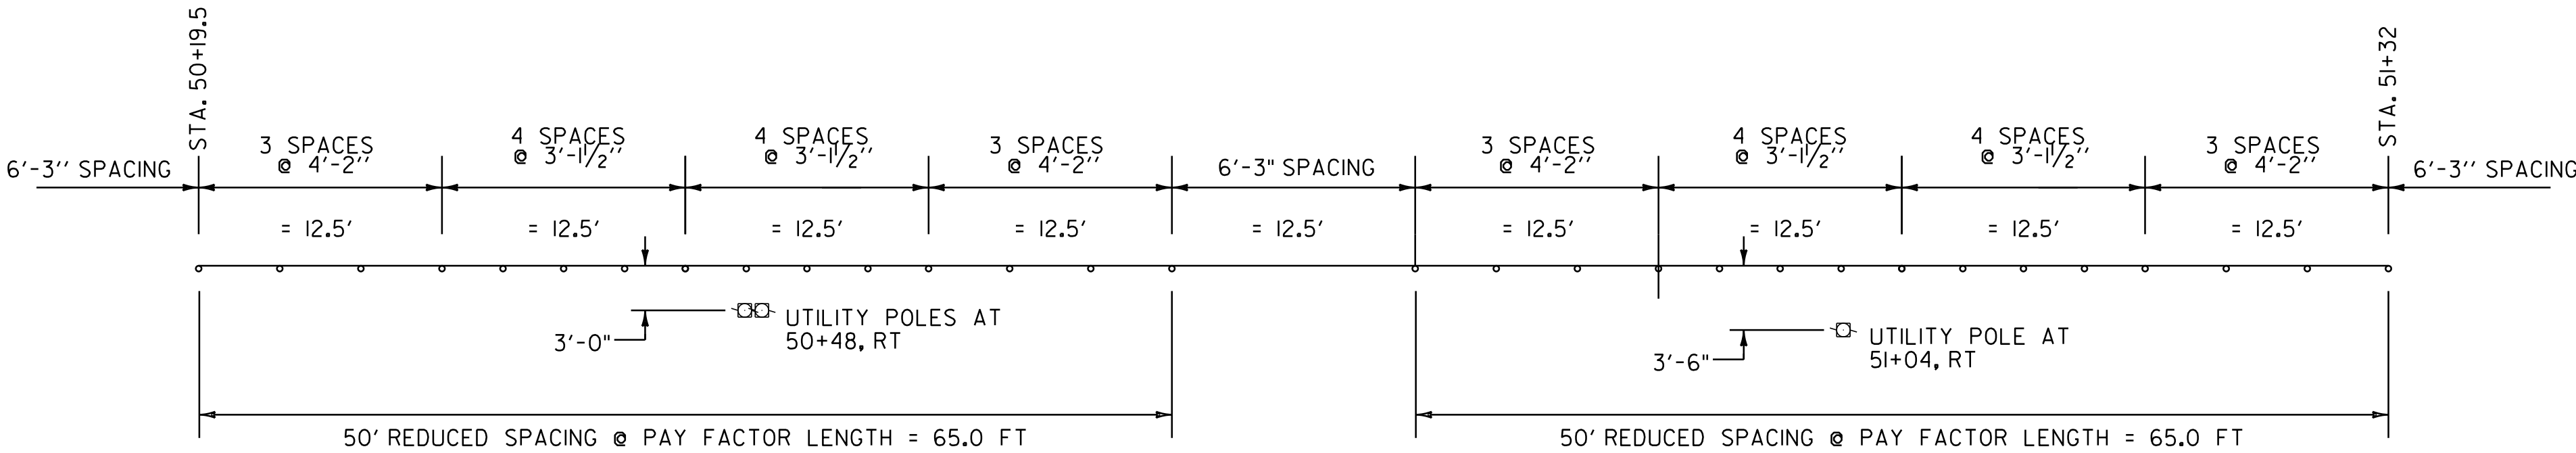

REDUCED GUARDRAIL POST SPACING DETAIL #2

UTILITY POLES
(N.T.S.)
STA. 50+48, RT - (2) UTILITY POLES
STA. 51+04, RT - UTILITY POLE

ADJUST ELEVATION OF VALVE BOX
(ITEM 629.20)


ALT. U.S. ROUTE 5

STATION	POSITION	DESCRIPTION
51+23	LT	WSO
56+31	RT	WSO
57+08	RT	WSO
60+57	LT	WSO

NOT TO SCALE

**MISCELLANEOUS
DETAIL
SHEET**

PROJECT NAME:	NEWPORT CITY
PROJECT NUMBER:	STP 2719(I)
FILE NAME: 07D202.dgn	PLOT DATE: 29-JAN-2013 09:2
PROJECT LEADER: JLL	DRAWN BY: STANTEC
DESIGNED BY: STANTEC	CHECKED BY: JLL
IPARM FILE: 07D202_23.i	SHEET 23 OF 62

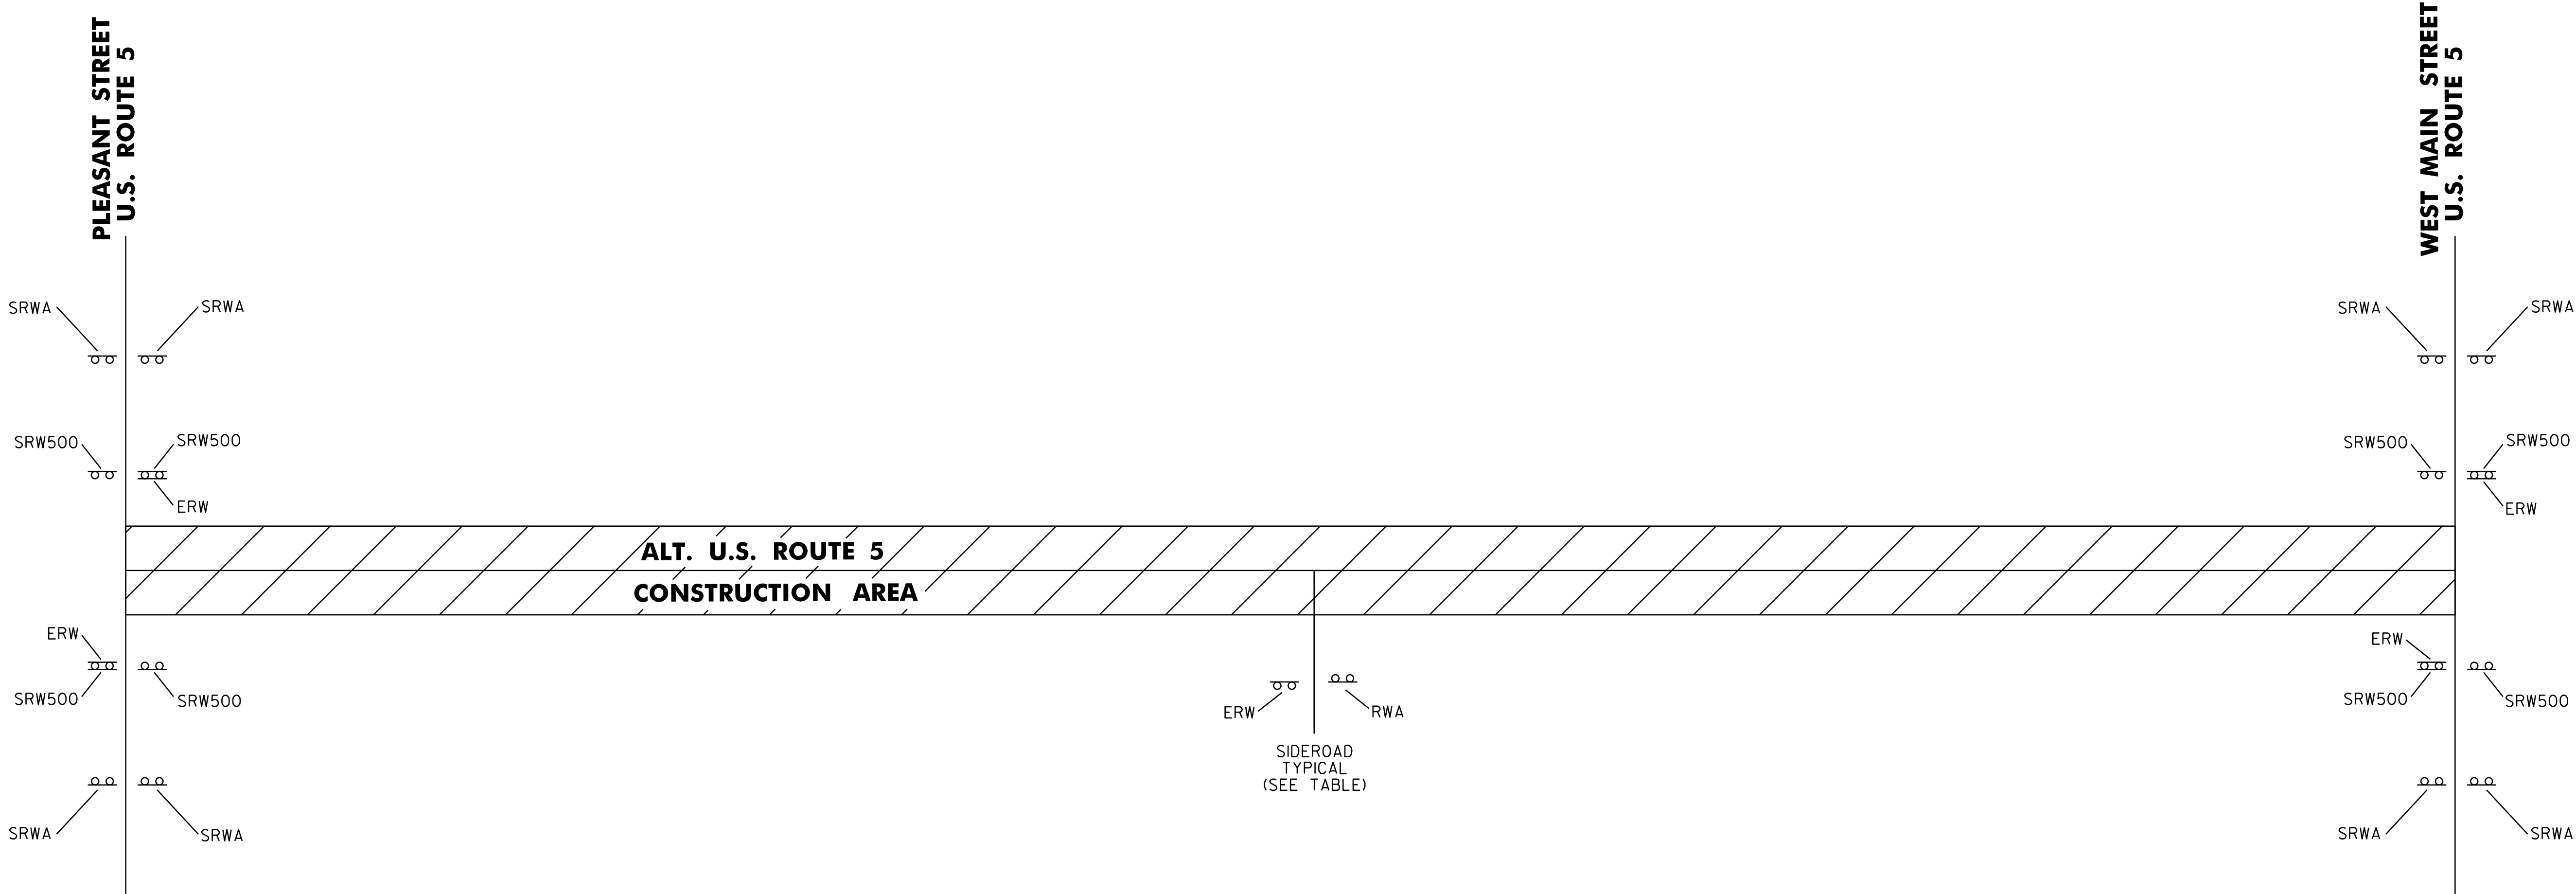

SEE VAOT STANDARDS E-100 AND E-100A FOR SIGN PLACEMENT.

LOCATION	ERW	RWA	SRWA	SRW500
NEWPORT CITY				
ALT. U.S. ROUTE 5 - BEGIN PROJECT				
U.S. ROUTE 5 - EASTBOUND (BEGIN PROJECT)	1		2	2
U.S. ROUTE 5 - WESTBOUND (BEGIN PROJECT)	1		2	2
SECOND ST.	1	1		
EASTERN AVE.	1	1		
MAIN ST. - EASTBOUND	1		2	2
MAIN ST. - WESTBOUND	1		2	2
ALT. U.S. ROUTE 5 - END PROJECT				
TOTALS	6	2	8	8

LEGEND

- ERW = END ROAD WORK
RWA = ROAD WORK AHEAD
SRWA = SIDE ROAD WORK AHEAD
SRW500 = SIDE ROAD WORK 500 FT

NOTES:

1. THE CONTRACTOR SHALL SUBMIT A TRAFFIC CONTROL PLAN FOR APPROVAL PRIOR TO THE START OF CONSTRUCTION. THE COST OF PREPARING THIS PLAN (AND MAKING CHANGES IF NECESSARY) SHALL BE INCLUDED IN THE UNIT PRICE BID FOR ITEM 641.10, TRAFFIC CONTROL.
2. THE BID PRICE FOR TRAFFIC CONTROL, ITEM 641.10, SHALL INCLUDE ALL OF THE FOLLOWING, AS NEEDED: APPROACH AND ON-PROJECT CONSTRUCTION SIGNING, PORTABLE FLASHING ARROW BOARDS, BARRIERS, BARRELS, CONES, BARRICADES, TEMPORARY REGULATORY AND WARNING SIGNS, AND POSTS AS DETAILED IN VTRANS STANDARDS. ALL ADJUSTING, RELOCATING AND REMOVING OF THESE DEVICES AS DIRECTED BY THE RESIDENT ENGINEER SHALL ALSO BE INCLUDED.
3. THE LATEST EDITION OF THE MANUAL ON UNIFORM TRAFFIC CONTROL DEVICES (MUTCD) SHALL BE THE STANDARD FOR ALL TRAFFIC CONTROL DEVICES. EXISTING SIGNS AND MARKING SHALL BE VALID UNTIL SUCH TIME AS THEY ARE REPLACED OR RECONSTRUCTED. WHEN NEW TRAFFIC DEVICES ARE ERECTED OR PLACED, OR EXISTING TRAFFIC CONTROL DEVICES ARE REPLACED OR REPAIRED, THE EQUIPMENT, DESIGN, METHOD OF INSTALLATION, PLACEMENT OR REPAIR SHALL CONFORM WITH SUCH STANDARDS.
4. NO CONSTRUCTION SIGNS SHALL BE INSTALLED AS TO INTERFERE OR OBSTRUCT THE VIEW OF EXISTING TRAFFIC CONTROL DEVICES, STOPPING SIGHT DISTANCE, AND CORNER SIGHT DISTANCE FROM DRIVES AND TOWN HIGHWAYS.
5. ALL PERMANENT SIGNS THAT CONFLICT WITH TEMPORARY TRAFFIC CONTROL SHALL BE COMPLETELY COVERED, THE PAYMENT FOR WHICH SHALL BE INCLUDED IN THE UNIT PRICE BID FOR ITEM 641.10 TRAFFIC CONTROL.
6. THE CONTRACTOR SHALL INCLUDE A CONSTRUCTION SIGN PACKAGE FOR EXPECTED LANE CLOSURES AND WORK ZONE SPEED REDUCTIONS IN COMPLIANCE WITH STANDARD E-103. PAYMENT FOR PROVIDING THIS PACKAGE SHALL BE INCLUDED IN THE UNIT PRICE BID FOR ITEM 641.10, TRAFFIC CONTROL.
7. ADA ACCESSIBLE PEDESTRIAN ACCOMMODATIONS SHALL BE MAINTAINED AT ALL TIMES, THE PAYMENT FOR WHICH SHALL BE INCLUDED IN THE UNIT PRICE BID FOR ITEM 641.10 TRAFFIC CONTROL.
8. SEE VAOT STANDARD E-100 FOR ADDITIONAL SIGN PLACEMENT DETAILS.
9. CONSTRUCTION ZONE SIGN LAYOUT SHALL BE IN ACCORDANCE WITH SECTION 6 OF THE LATEST EDITION OF THE MANUAL ON UNIFORM TRAFFIC CONTROL DEVICES (MUTCD).
10. CONSTRUCTION SIGNS SHALL BE IN NEW OR LIKE NEW CONDITION PER VAOT STANDARDS AND SPECIAL PROVISIONS.
11. DIAMOND SHAPED SIGNS SHALL BE 4' X 4' WITH BLACK TEXT AND BORDER ON A RETROREFLECTIVE FLUORESCENT ORANGE BACKGROUND.
12. RETROREFLECTIVE SHEETING SHALL BE TYPE III OR VIII AS NOTED ON VAOT STANDARD E-100 AND IN THE SPECIAL PROVISIONS.
13. CONSTRUCTION ZONE SIGNS SHALL BE INSTALLED AS OUTLINED IN THE SPECIAL PROVISIONS.
14. WHERE TEMPORARY SIGNS ARE PLACED BEHIND GUARDRAIL, THEY SHALL BE ADJUSTED SUCH THAT THE BOTTOM OF THE SIGNS IS ABOVE THE TOP OF GUARDRAIL.
15. AS THE PAVING OPERATION MOVES, FLAGGER SIGNS SHALL BE MOVED ACCORDINGLY. AT NO TIME SHOULD THE FLAGGER SYMBOL SIGN BE MORE THAN 1000 FEET FROM THE FLAGGER STATION. FLAGGER SIGNS SHALL BE COVERED OR TURNED AWAY FROM TRAFFIC WHEN FLAGGING OPERATIONS CEASE FOR LONGER THAN 15 MINUTES.
16. CONES SHALL BE USED TO CLEARLY DEFINE THE TRAVEL SPACE AND PROVIDE SEPARATION FROM THE WORK SPACE ALONG ITS ENTIRE LENGTH.

TEMPORARY TRAFFIC CONTROL PLAN	PROJECT NAME: NEWPORT CITY	
	PROJECT NUMBER: STP 2719(1)	
	FILE NAME: 07D202.dgn	PLOT DATE: 29-JAN-2013 09:2
	PROJECT LEADER: JLL	DRAWN BY: STANTEC
	DESIGNED BY: MCF	CHECKED BY: JLL
	IPARM FILE: 07D202_24.i	SHEET 24 OF 62

STATE OF VERMONT
AGENCY OF TRANSPORTATION



PROPOSED IMPROVEMENT
VILLAGE OF DERBY
CLASS I TOWN HIGHWAY
COUNTY OF ORLEANS
U.S. ROUTE 5 & ALT. U.S. ROUTE 5

BEGINNING IN THE VILLAGE OF DERBY ON U.S. ROUTE 5 AT STA. 270+23.04 (MM 5.118) AND EXTENDING NORTHERLY ALONG U.S. ROUTE 5 FOR A DISTANCE OF 4308.48 FEET (0.816 MILE) TO THE U.S./CANADIAN BORDER AT STA. 313+31.52 (MM 5.934). ALSO BEGINNING IN THE VILLAGE OF DERBY ON ALT. U.S. ROUTE 5 AT STA. 0+00.00 (MM 0.000) AT THE INTERSECTION OF U.S. ROUTE 5 AND EXTENDING EASTERLY ALONG ALT. U.S. ROUTE 5 FOR A DISTANCE OF 3189.12 FEET (0.604 MILE) TO THE DERBY TOWN LINE AT STA. 31+89.12 (MM 0.604). A 481.52 FOOT (0.091 MILE) APPROACH WILL END AT DERBY TOWN STA. 4+81.52 (MM 0.091)

PROJECT DATA:	LENGTH (FEET)	LENGTH (MILES)
VILLAGE OF DERBY U.S. ROUTE 5 STA. 270+23.04 TO 313+31.52 MM 5.118 TO 5.934	4308.48	0.816
ALT. U.S. ROUTE 5 STA. 0+00.00 TO 31+89.12 MM 0.000 TO 0.604	3189.12	0.604
TOTAL LENGTH OF PROJECT:	7497.60	= 1,420
TOTAL LENGTH OF ROADWAY:	7979.12	= 1,511

TRAFFIC DATA
U.S. ROUTE 5 & ALT. U.S. ROUTE 5

LOCATION	AADT		DHV		ESALS	
	2010	2020	2010	2020	2010-2020	2010-2030
US 5 FROM THE START OF THE PROJECT TO VALENTINE AVE.	2600	2800	290	320	867,000	1,935,000
US 5 FROM VALENTINE AVE. TO ELM STREET	2500	2600	280	290	881,000	2,137,000
US 5 FROM ELM STREET TO THE CANADIAN BORDER	2900	3100	330	350	887,000	2,185,000
ALT. US 5 FROM US 5 TO I-91 EXIT 29 RAMP B	2200	2300	250	260	517,000	1,279,000
ALT. US 5 FROM I-91 EXIT 29 RAMP B TO END OF PROJECT	2100	2200	240	250	495,000	1,225,000


CONVENTIONAL SYMBOLS

COUNTY LINE		COUNTY LINE
TOWN LINE		TOWN LINE
LIMITS OF ACCESS		
POINT OF ACCESS		
FENCE LINE		
STONE WALL		
TRAVELED WAY		
GUARD RAIL		
RAILROAD		
SURVEY LINE		
CULVERT		
POWER POLE		
TELEPHONE POLE		
TREES		
CONTROL OF ACCESS		
PROPERTY LINE		
R.O.W. TAKING LINE		
SLOPE RIGHTS		
TOP OF CUT		
TOE OF SLOPE		

SURVEYED BY : N/A
SURVEYED DATE : N/A


DATUM
VERTICAL N/A
HORIZONTAL N/A

PROJECT
STP 2703(1)

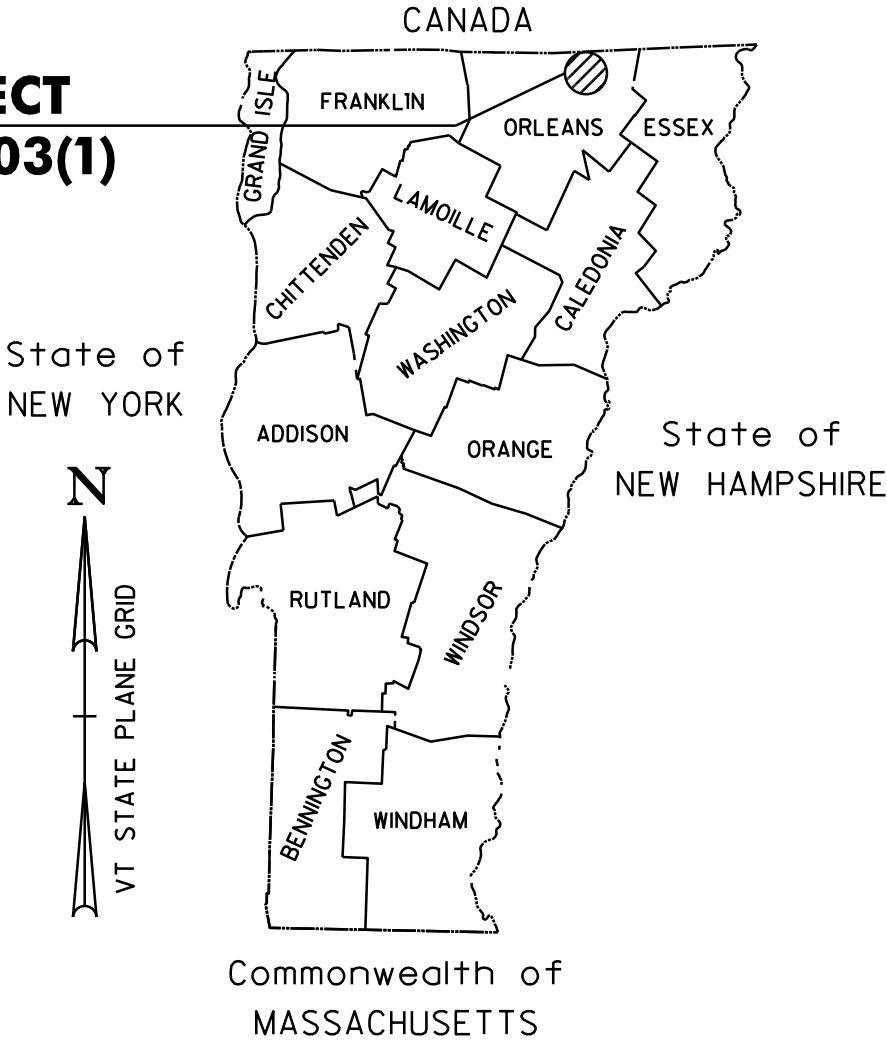

SUPERPAVE BITUMINOUS CONCRETE PAVEMENT
MIXTURE DESIGN CRITERIA

DESIGN LANE/DESIGN LIFE ESALS	1,092,500
DESIGN NUMBER OF GYRATIONS	65
PERFORMANCE GRADE ASPHALT BINDER	SEE SECTION 490 GENERAL SPECIAL PROVISIONS

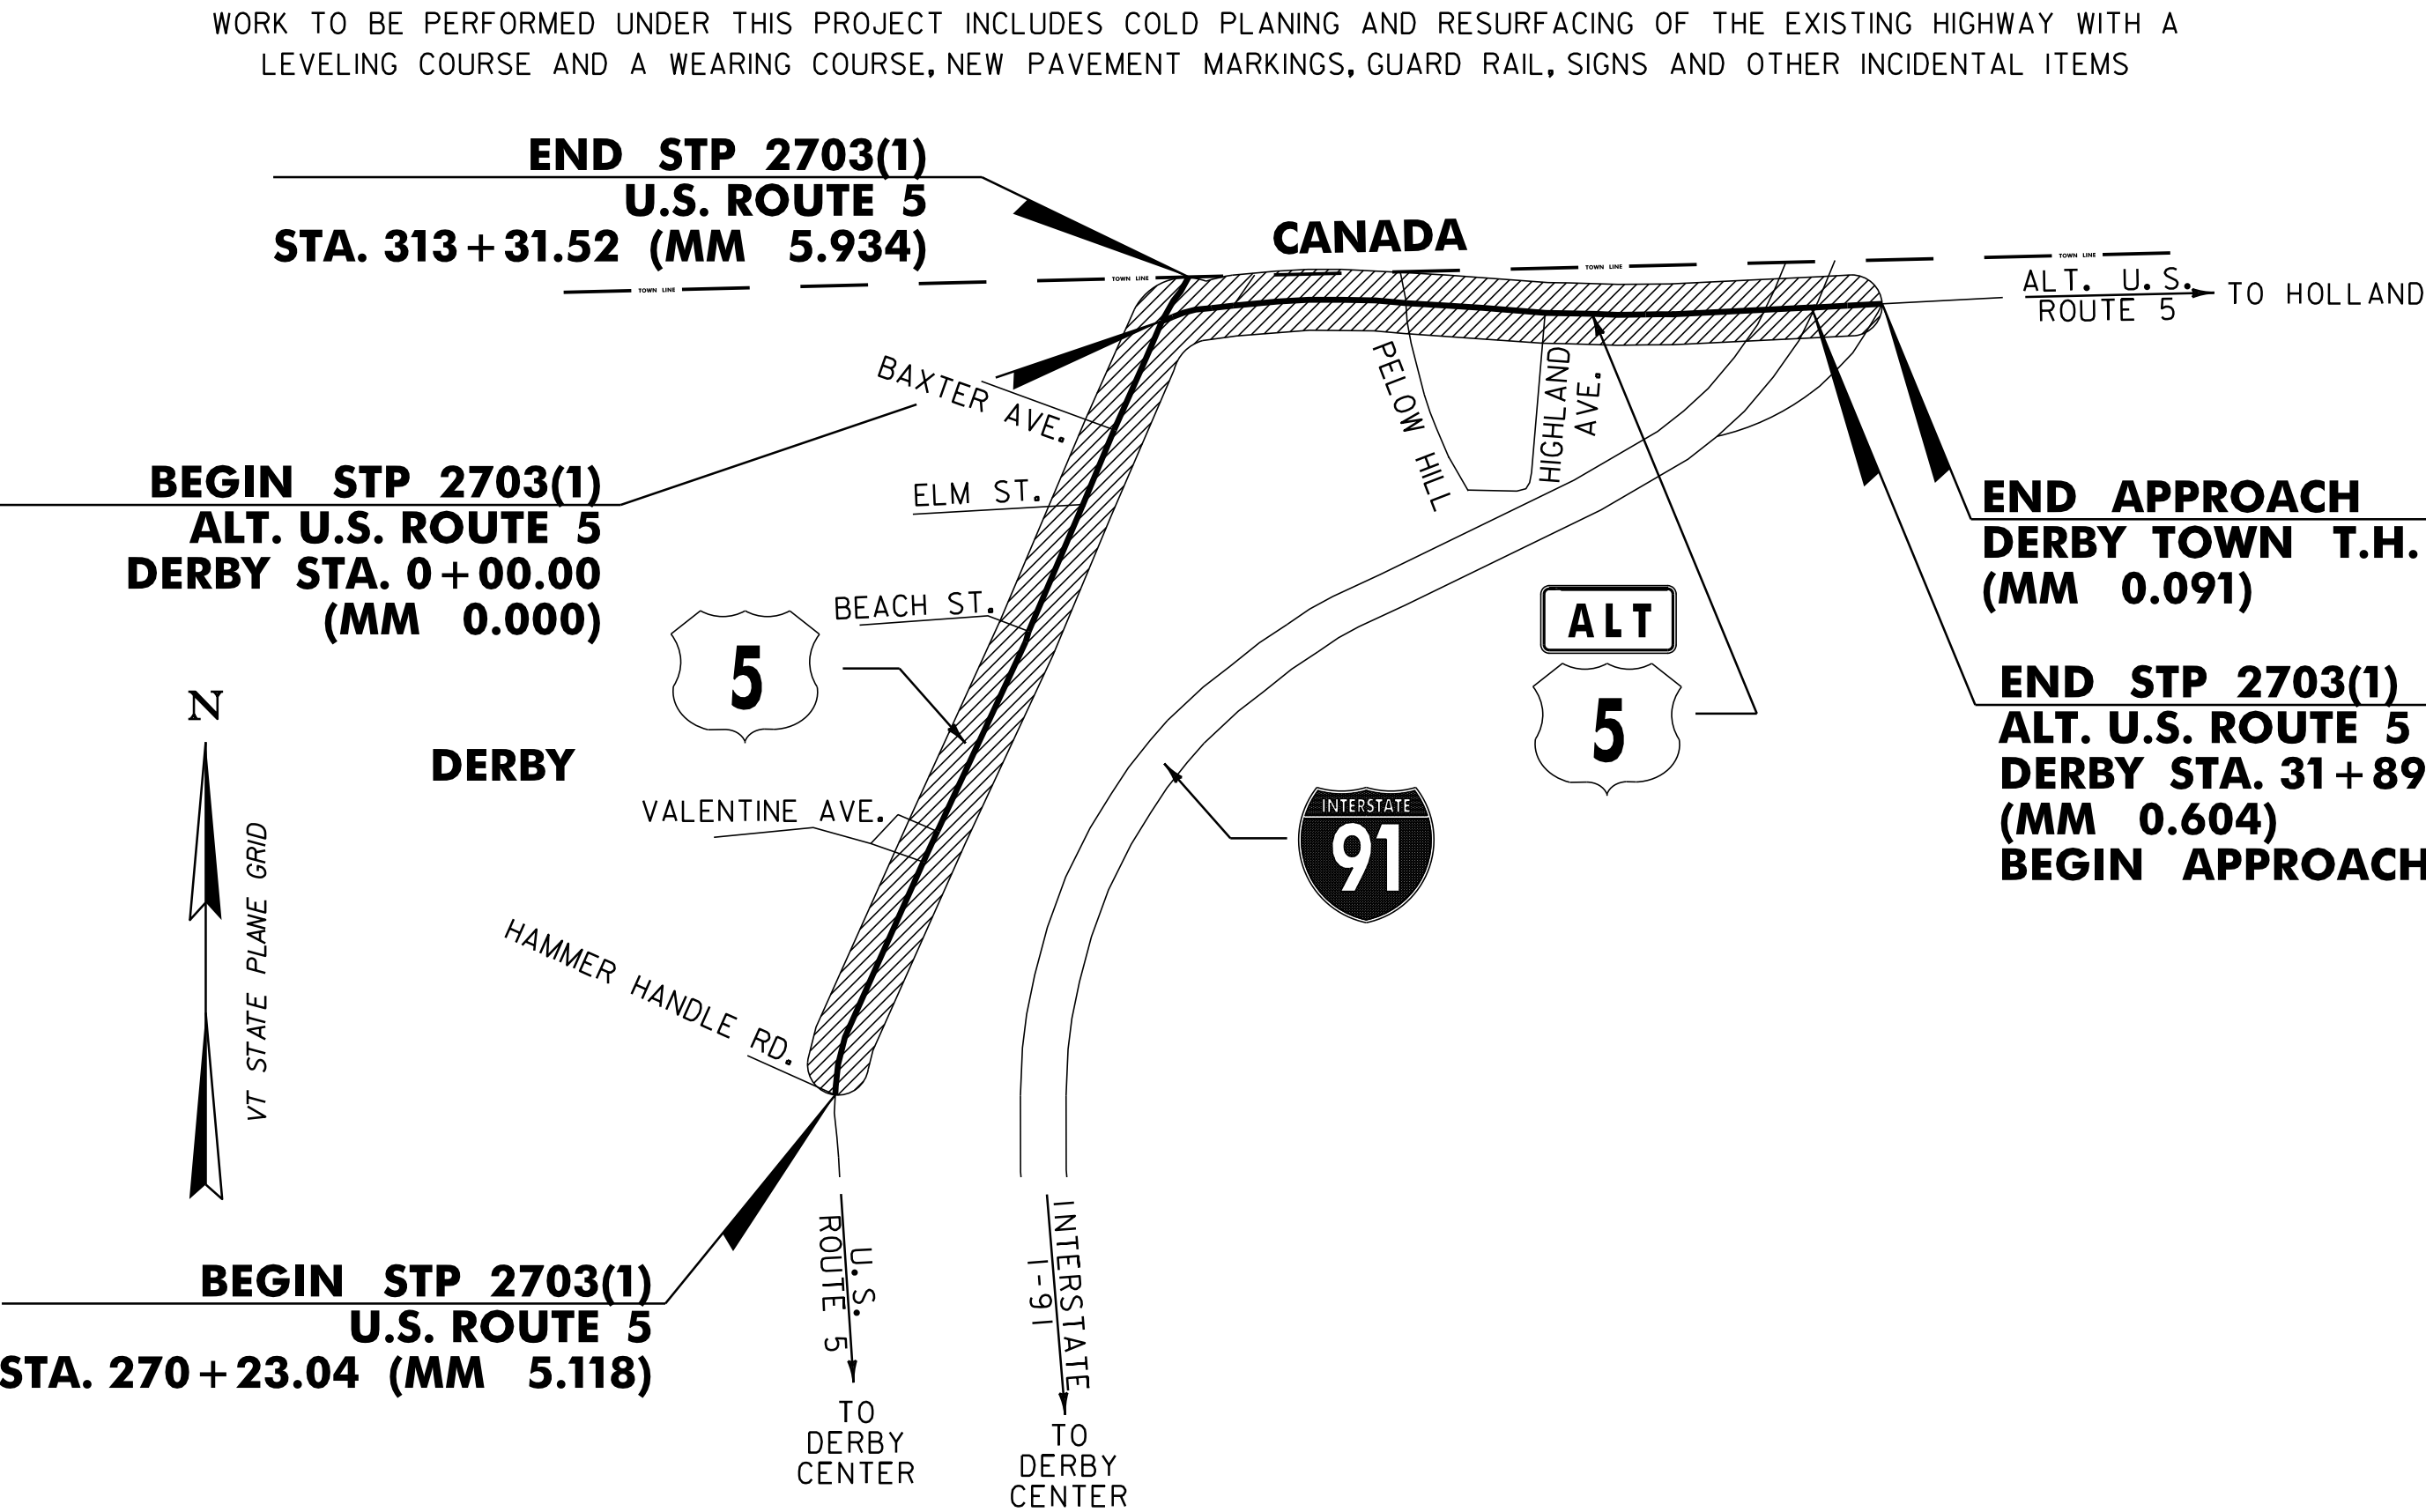

RIGHT-OF-WAY LIMITS, IF APPLICABLE, ARE PROVIDED SOLELY FOR THE CONVENIENCE OF THE STATE AND ITS CONTRACTOR DURING THE COURSE OF THIS PAVING PROJECT. ANY REFERENCES TO OFFSETS ON THESE PLANS ARE APPROXIMATE AND SHOULD NOT BE RELIED UPON FOR ANY PURPOSES.

THESE PLANS ARE SUBJECT TO SUCH ENGINEERING CHANGES AS MAY BE REQUIRED BY THE FEDERAL HIGHWAY ADMINISTRATION OR THE DIRECTOR OF PROGRAM DEVELOPMENT.

CONSTRUCTION IS TO BE CARRIED ON IN ACCORDANCE WITH THESE PLANS AND THE STANDARD SPECIFICATIONS FOR CONSTRUCTION DATED 2006, AS APPROVED BY THE FEDERAL HIGHWAY ADMINISTRATION ON JUNE 15, 2006 FOR USE ON THIS PROJECT, INCLUDING ALL SUBSEQUENT REVISIONS AND SUCH REVISED SPECIFICATIONS AND SPECIAL PROVISIONS AS ARE INCORPORATED IN THESE PLANS.

UNLESS OTHERWISE NOTED, ALL DRAWINGS AND DETAILS ON THESE PLANS ARE DRAWN "NOT TO SCALE".

PROJECT MANAGER : KEVIN MARSHIA

PROJECT NAME : DERBY
PROJECT NUMBER : STP 2703(1)

SHEET 25 OF 62 SHEETS

NOTES

- I.

THE PAVEMENT WEARING COURSE SHALL BE SUPERPAVE BITUMINOUS CONCRETE PAVEMENT TYPE IVS.THE ESTIMATED 1/2 "LEVELING COURSE SHALL BE SUPERPAVE BITUMINOUS CONCRETE PAVEMENT TYPE IVS UNLESS OTHERWISE DIRECTED BY THE RESIDENT ENGINEER.
2.

GRASS GROWING ADJACENT TO PAVEMENT OR THROUGH CRACKS IN THE PAVEMENT WHICH MAY HAMPER THE PLACEMENT OF NEW BITUMINOUS CONCRETE SHALL BE REMOVED BY THE CONTRACTOR AS DIRECTED BY THE RESIDENT ENGINEER.PAYMENT FOR THIS WORK WILL NOT BE MADE DIRECTLY,BUT WILL BE INCLUDED IN THE UNIT PRICE BID FOR ITEM 490.30 SUPERPAVE BITUMINOUS CONCRETE PAVEMENT.
3.

SUPERPAVE BITUMINOUS CONCRETE PAVEMENT TOLERANCE = ±1/4". (TOTAL THICKNESS EXCLUDING LEVELING)
4.

EMULSIFIED ASPHALT SHALL BE APPLIED ON EXISTING PAVEMENT SURFACES, BETWEEN ALL COURSES OF PAVEMENT AND ON COLD PLANED SURFACES, AT THE RATE OF 0.025 GAL/SY OR AS DIRECTED BY THE RESIDENT ENGINEER.
5.

COLD PLANING TO BE COMPLETED ACCORDING TO TYPICAL OR AS NOTED OTHERWISE ON THE PLANS. THE COLD PLANING AND PAVING SHALL MATCH THE EXISTING CONDITIONS AT THE BEGINNING AND END OF CONSTRUCTION AREAS BY THE USE OF A VERTICAL COLD PLANE JOINT. SEE DETAIL ON NEXT SHEET.
6.

IF THE BRIDGE MEMBRANE IS DAMAGED AT ANY TIME DURING THE COLD PLANING OR PAVING OPERATIONS,IT SHALL BE REPAIRED,AT THE CONTRACTOR'S EXPENSE,AS DIRECTED BY THE RESIDENT ENGINEER.
7.


ALL PUBLIC,PRIVATE OR FIELD DRIVES SHALL RECEIVE A MINIMUM 4' PAVED APRON PAYABLE UNDER ITEM 900.675 SPECIAL PROVISION (HAND-PLACED BITUMINOUS CONCRETE MATERIAL,DRIVES) UNLESS OTHERWISE DIRECTED BY THE RESIDENT ENGINEER. ALL OTHER BITUMINOUS MATERIALS PLACED WITHIN THE PROJECT LIMITS WHETHER BY HAND OR MECHANICAL METHODS SHALL BE PAID AS ITEM 490.30 SUPERPAVE BITUMINOUS CONCRETE PAVEMENT.
8.

SIDEWALK RAMP DETECTABLE WARNING SURFACES SHALL BE TRUNCATED DOME DETECTABLE WARNING PLATES FROM THE AGENCY'S APPROVED PRODUCT LIST.
9.

AN ESTIMATED QUANTITY OF ITEM 619.17 YIELDING MARKER POSTS HAS BEEN INCLUDED TO DELINEATE PIPE INLETS,PIPE OUTLETS AND DROP INLETS LOCATED OUTSIDE OF THE PAVEMENT SURFACE OR AS DIRECTED BY THE RESIDENT ENGINEER.
10.


A QUANTITY FOR ITEM 604.412 REHAB.DROP INLETS,CATCH BASINS,OR MANHOLES,CLASS I,ITEM 604.415 REHAB.DROP INLETS,CATCH BASINS,OR MANHOLES,CLASS II,ITEM 604.418 REHAB.DROP INLETS,CATCH BASINS,OR MANHOLES,CLASS III AND ITEM 604.40 CHANGING ELEVATION OF DI,CB,OR MH HAS BEEN INCLUDED TO BE USED AS INDICATED ON THE PLANS OR AS DIRECTED BY THE RESIDENT ENGINEER.ALL DI'S SHALL BE RAISED OR REHABILITATED SUCH THAT THE NEW GRATE ELEVATION IS EVEN WITH THE SURROUNDING TERRAIN.DRAINAGE STRUCTURES CALLING FOR REHAB HAVE BEEN EVENLY DISTRIBUTED BETWEEN ITEMS 604.412, 604.415, AND 604.418 FOR ESTIMATING PURPOSES.
- II.

STEEL BEAM GUARDRAIL WITH STEEL POSTS SHALL BE USED ON THIS PROJECT.

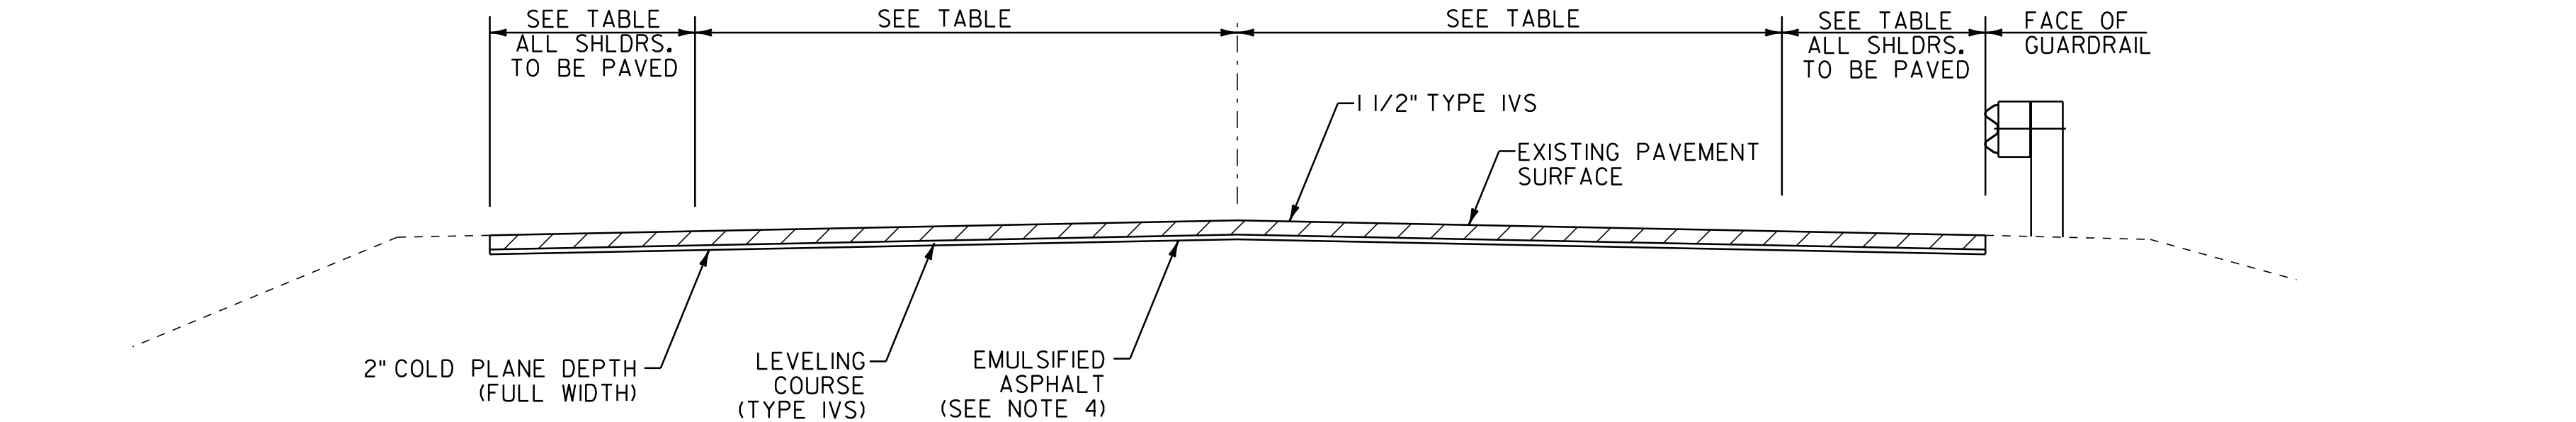


COLD PLANE TYPICAL SECTION – UNCURBED

U.S.ROUTE 5 DERBY STA.270+23.04 TO 305+97.00
ALT.U.S.ROUTE 5 DERBY STA.0+00.00 TO 0+73.52
ALT.U.S.ROUTE 5 DERBY STA.2+49.18 TO 3+50.70
ALT.U.S.ROUTE 5 DERBY STA.6+45.95 TO 29+39.45
APPROACH - DERBY STA.0+28.00 TO 4+81.52

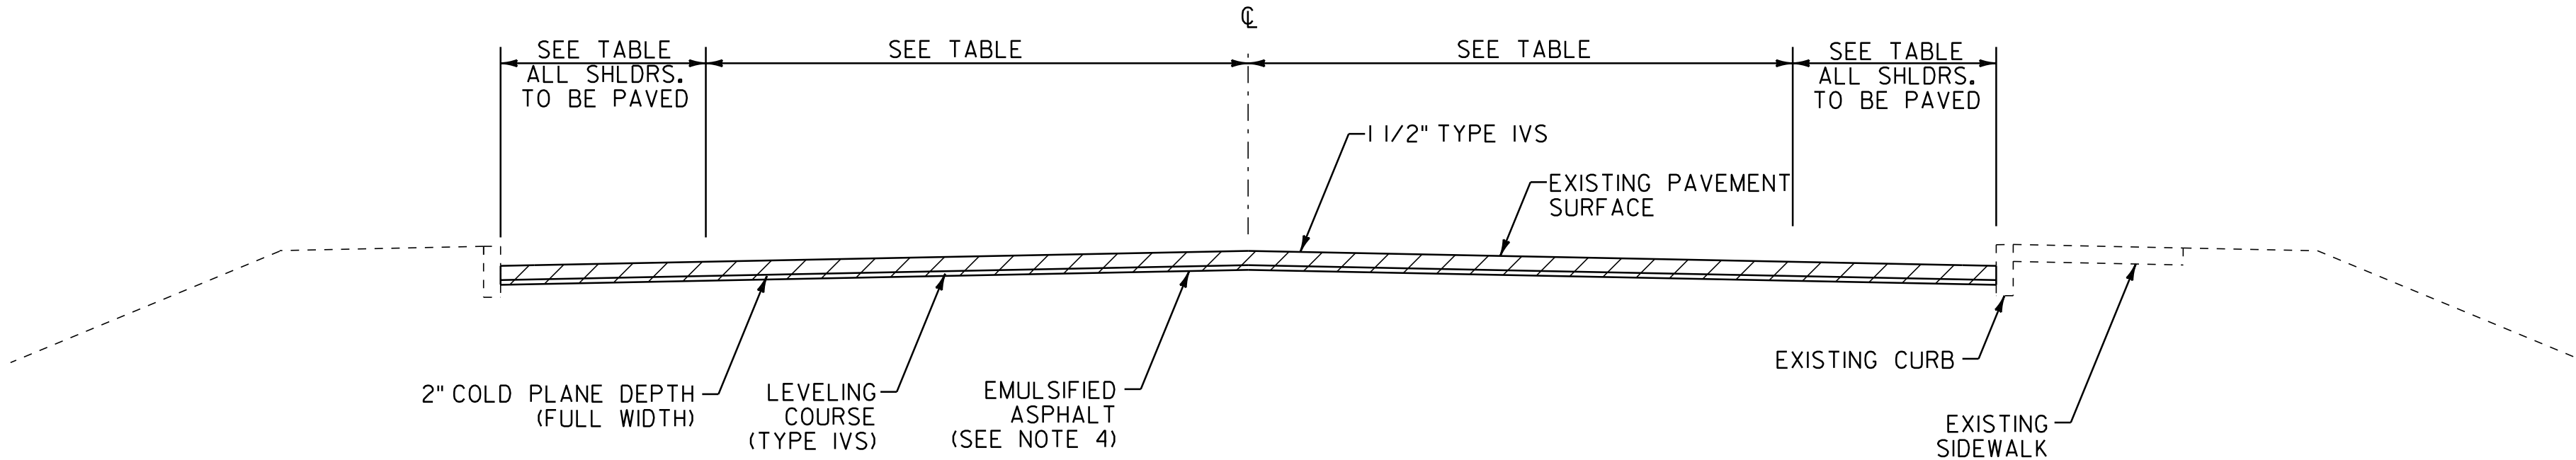

COLD PLANE TYPICAL SECTION – CURBED

U.S.ROUTE 5 DERBY STA.305+97.00 TO 313+31.52
ALT.U.S.ROUTE 5 DERBY STA.0+73.52 TO 2+49.18
ALT.U.S.ROUTE 5 DERBY STA.3+50.70 TO 6+45.95

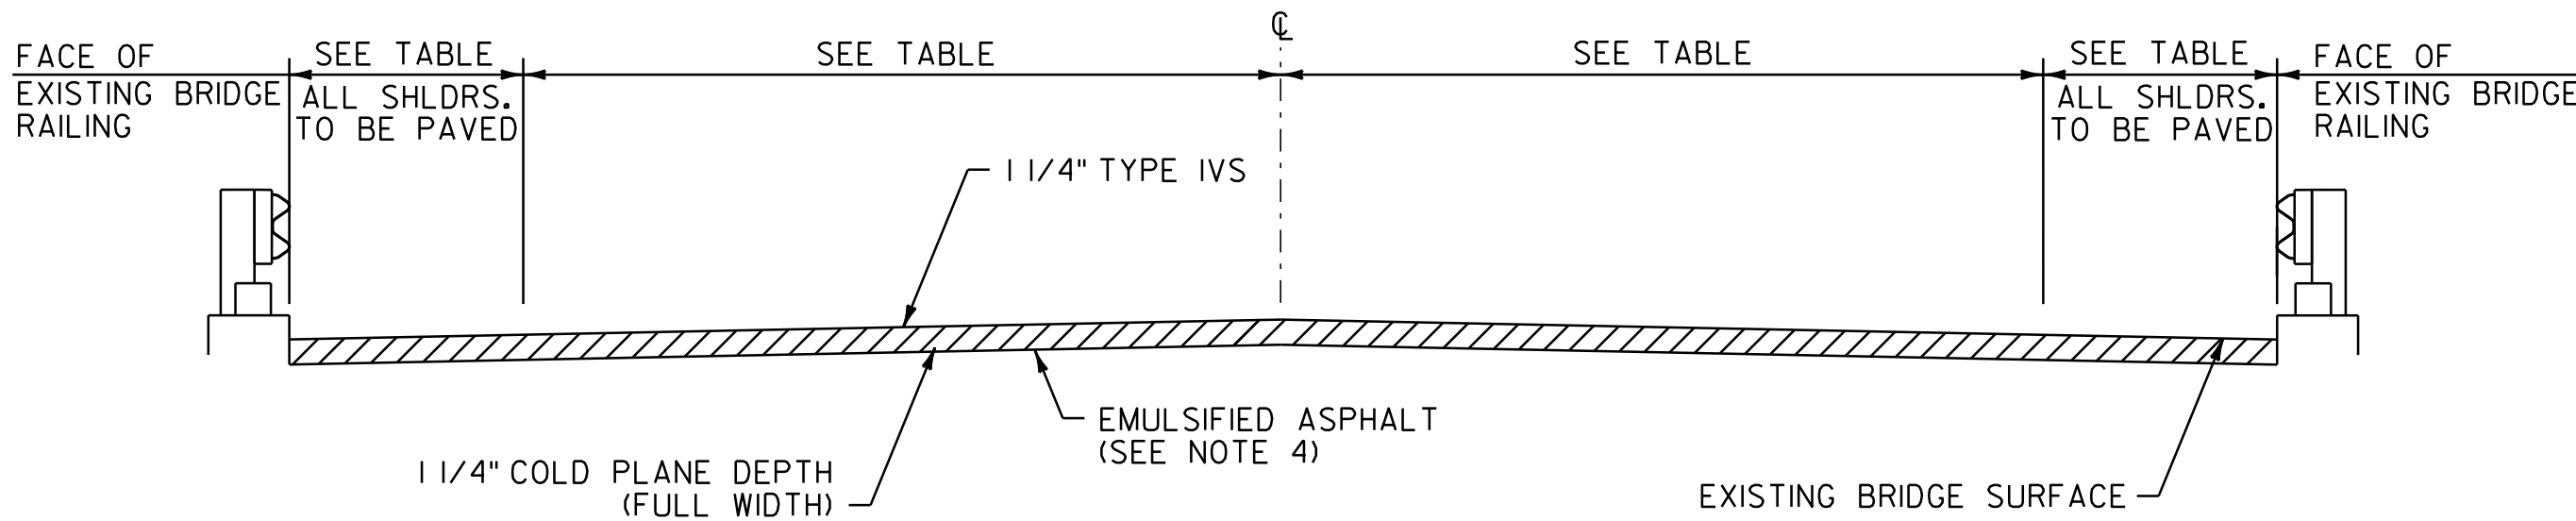

COLD PLANE TYPICAL SECTION – BRIDGE

BR*II4 ALT.U.S.ROUTE 5 DERBY STA.29+39.45 TO DERBY TOWN STA.0+28.00

PROJECT PAVING LIMITS

TOWN & ROUTE	BEGIN STATION	END STATION	LANE TYPICAL	WEARING DEPTH	LEVELING DEPTH	NOTES
DERBY U.S.ROUTE 5	270+23.04	313+31.52	VARIES - SEE LAYOUT SHEETS	1-1/2"	1/2"	COLD PLANE 2", LEVEL AND THEN PAVE WITH 1 1/2" TYPE IVS.
DERBY ALT.U.S.ROUTE 5	0+00.00	29+39.45	VARIES - SEE LAYOUT SHEETS	1-1/2"	1/2"	COLD PLANE 2", LEVEL AND THEN PAVE WITH 1 1/2" TYPE IVS.
DERBY ALT.U.S.ROUTE 5	29+39.45	0+28.00	4'-0" - 11'-0" - 11'-0" - 4'-0"	1-1/4"	-	BR II4 - COLD PLANE 1 1/4" AND PAVE WITH 1 1/4" TYPE IVS.
DERBY TOWN (APPROACH)	0+28.00	4+81.52	VARIES - SEE LAYOUT SHEETS	1-1/2"	1/2"	COLD PLANE 2", LEVEL AND THEN PAVE WITH 1 1/2" TYPE IVS.


NOT TO SCALE

PROJECT TYPICAL SHEET #1

PROJECT NAME: DERBY
PROJECT NUMBER: STP 2703(1)


FILE NAME: 07D202.dgn
PROJECT LEADER: JLL
DESIGNED BY: STANTEC
IPARM FILE: 07C194_26.i

PLOT DATE: 29-JAN-2013 09:2
DRAWN BY: STANTEC
CHECKED BY: JLL
SHEET 26 OF 62

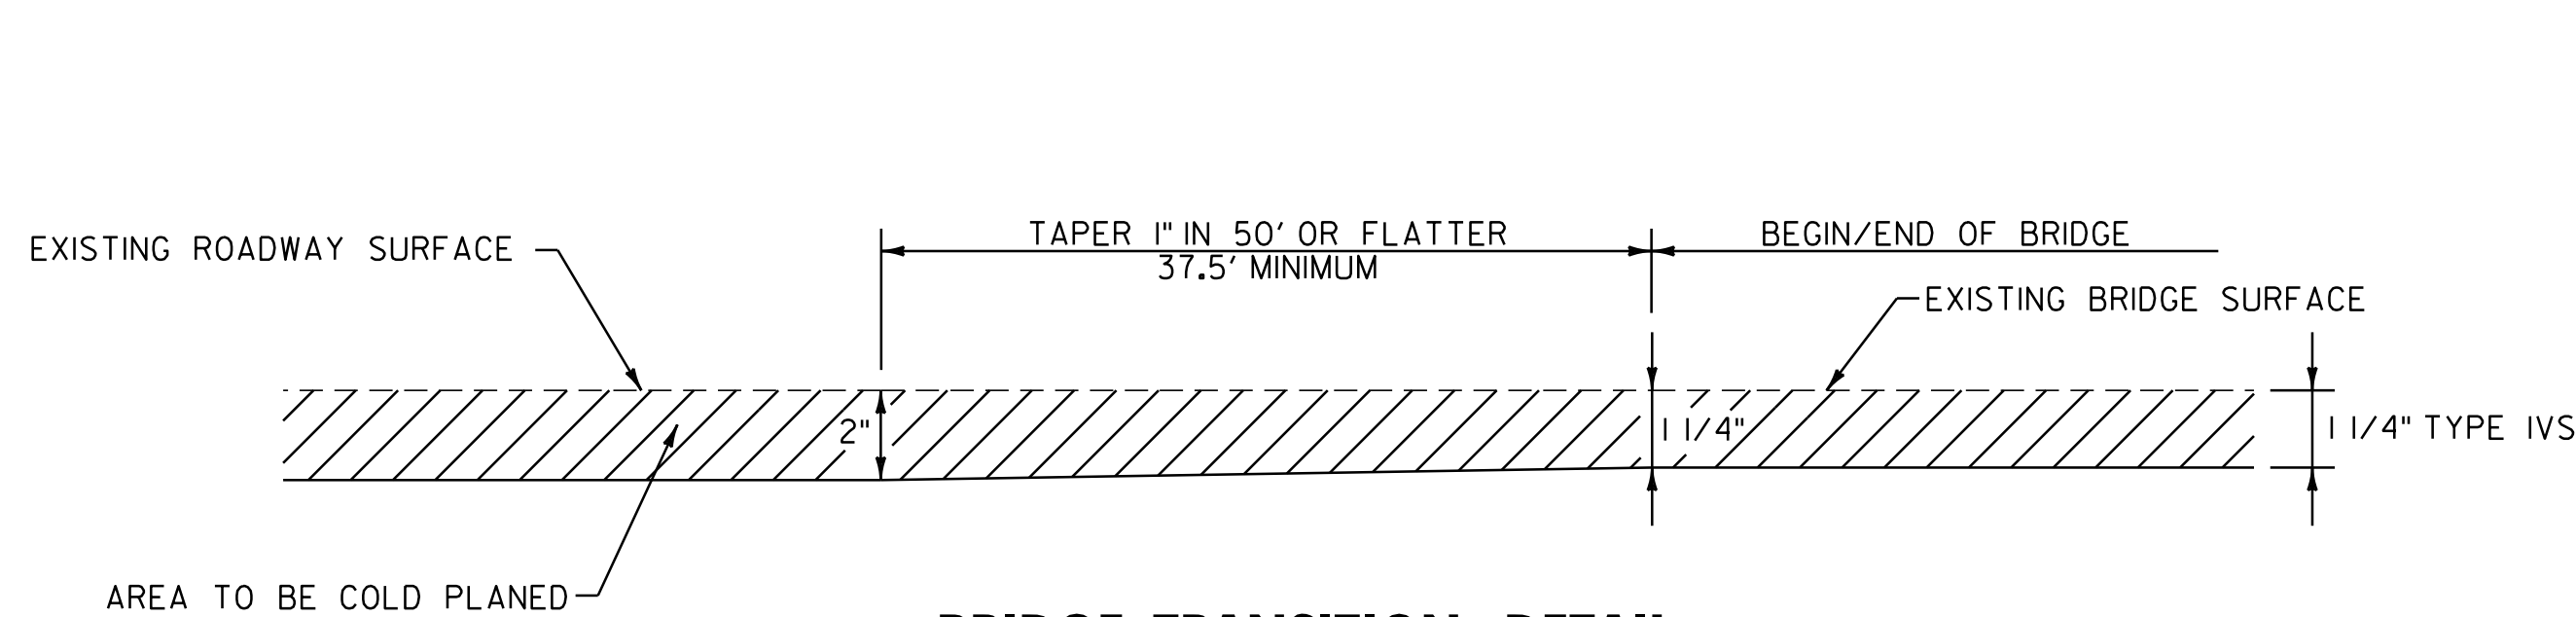

BRIDGE TRANSITION DETAIL

BR*II4 DERBY STA. 29+01.95 TO 29+39.45
BR*II4 DERBY TOWN STA. 0+28.00 TO 0+65.50

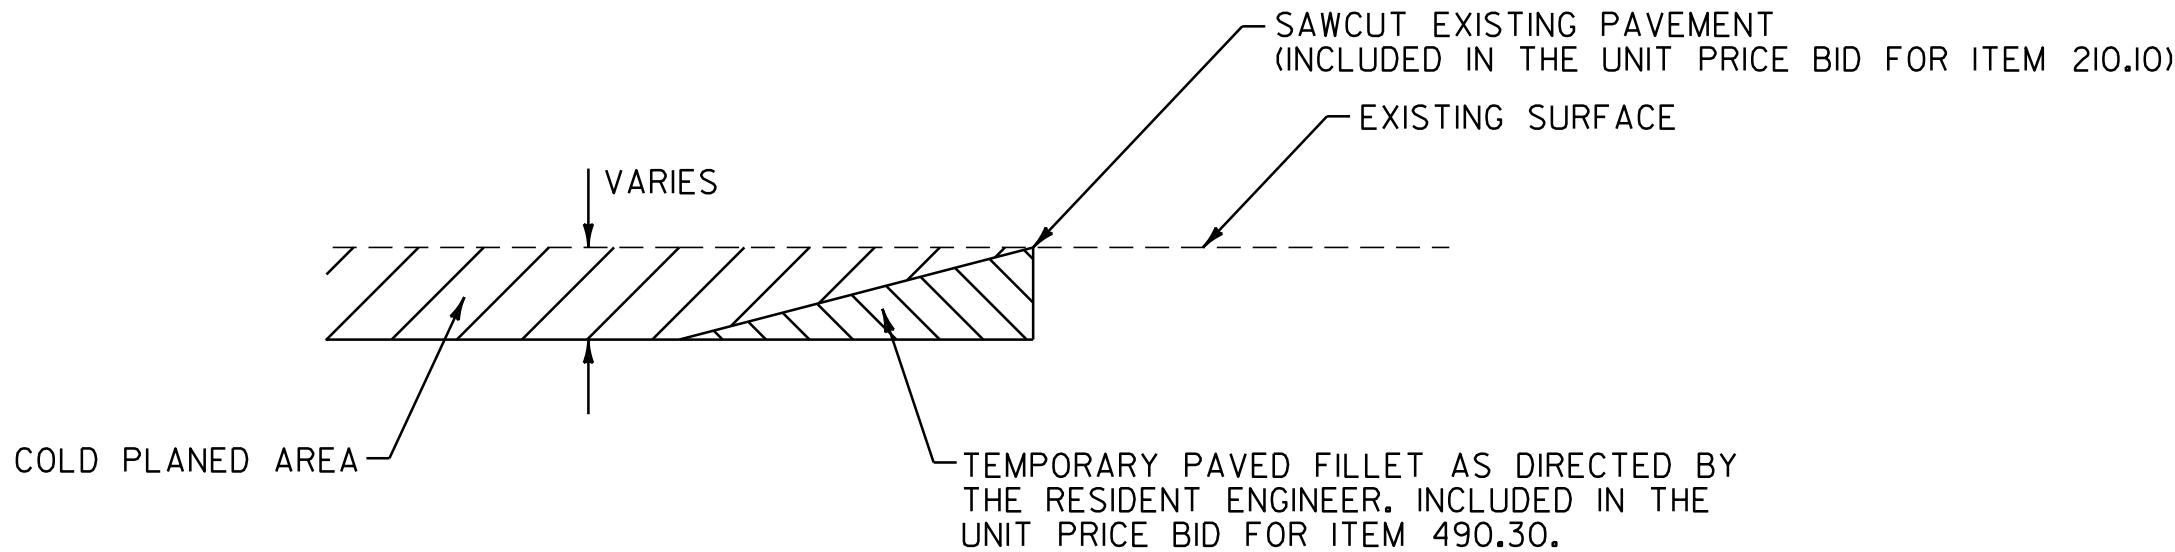

DETAIL AT VERTICAL COLD PLANE JOINTS

NOTE: THIS DETAIL SHALL BE USED AT THE LOCATIONS LISTED BELOW AND AT ALL DRIVES AS DIRECTED BY THE RESIDENT ENGINEER.

FULL ROADWAY WIDTH

U.S. ROUTE 5 STA. 270+23.04 (BEGIN PROJECT)
U.S. ROUTE 5 STA. 282+14, LT (VALENTINE AVE.)
U.S. ROUTE 5 STA. 284+01, LT (LAYTHE ST.)
U.S. ROUTE 5 STA. 295+05, RT (LOUIS ST.)
U.S. ROUTE 5 STA. 295+34, LT (BEACH ST.)
U.S. ROUTE 5 STA. 301+89, LT (ELM ST.)
U.S. ROUTE 5 STA. 305+30, LT (BAXTER AVE.)
U.S. ROUTE 5 STA. 313+31.52 (U.S. ROUTE 5 - END PROJECT)
ALT. U.S. ROUTE 5 STA. 0+63, RT (DUCHARME DR.)
ALT. U.S. ROUTE 5 STA. 2+79, RT (DUCHARME DR.)
ALT. U.S. ROUTE 5 STA. 4+17, LT (CHURCH ST.)
ALT. U.S. ROUTE 5 STA. 12+00, LT (LEE ST.)
ALT. U.S. ROUTE 5 STA. 12+00, RT (PELOW HILL)
ALT. U.S. ROUTE 5 STA. 18+93, RT (HIGHLAND AVE.)
ALT. U.S. ROUTE 5 STA. 23+88, RT (MAPLE ST.)
ALT. U.S. ROUTE 5 STA. 23+94, LT (PHELPS ST.)
ALT. U.S. ROUTE 5 STA. 24+88, RT (INTERSTATE 91 SB ON/OFF RAMP B)
DERBY TOWN T.H. I STA. 2+81, RT (INTERSTATE 91 NB ON/OFF RAMP A)
DERBY TOWN T.H. I STA. 4+41, RT (HERRICK RD.)
DERBY TOWN T.H. I STA. 4+81.52 (END APPROACH)

SEEDING FORMULA

RATE: DOUBLE IF HYDROSEEDING

% WT.	LBS./A.	NAME	PUR %	GERM %
38	32	CREeping RED FESCUE	98	90
29	24	SPARTAN HARD FESCUE	95	85
15	12	AZAY SHEEP'S FESCUE	95	87
15	12	ANNUAL RYE GRASS	95	90
3	--	INERTS	--	--
100.0	80 LB/A			

NOTES

SEED MIXTURE: SHALL NOT HAVE A WEED CONTENT EXCEEDING 0.40% BY WEIGHT AND SHALL BE FREE OF ALL NOXIOUS SEED.

SEED ITEM 651.15: TO BE APPLIED PER SEEDING FORMULAS OR AS DIRECTED BY THE RESIDENT ENGINEER.

FERTILIZER ITEM 651.18: FORMULA 10-20-10, TO BE USED WITH SEED, APPLIED AT THE RATE OF 500 LBS./ACRE. (HYDRO SEEDERS MAY USE 19-19-19 FORMULA)

AGRICULTURAL LIMESTONE ITEM 651.20: TO BE APPLIED AT THE RATE OF 2 TONS/ACRE, OR AS DIRECTED BY THE RESIDENT ENGINEER.

HAY MULCH ITEM 651.25: TO BE PLACED ON THE EARTH SLOPES AT THE RATE OF 2 TONS/ACRE, OR AS DIRECTED BY THE RESIDENT ENGINEER.


TOPSOIL ITEM 651.35: TO BE USED WITH SEED AS INDICATED ON THE PLANS, OR AS DIRECTED BY THE RESIDENT ENGINEER.

GRADES LESS THAN 1 PERCENT SHALL USE ITEM 651.15, SEED AND ITEM 651.25, HAY MULCH. GRADES BETWEEN 1 AND 2.5 PERCENT SHALL USE ITEM 651.25, HAY MULCH OR ITEM 653.20, TEMPORARY EROSION MATTING AS DIRECTED BY THE RESIDENT ENGINEER. GRADES OVER 2.5 PERCENT SHALL USE ITEM 649.31, GEOTEXTILE UNDER STONE FILL AND ITEM 613.10, STONE FILL TYPE 1 AS DIRECTED BY THE RESIDENT ENGINEER.

PIPE INLET AND OUTLET AREAS, AND DITCH CLEANING THROUGHOUT THE PROJECT, SHALL BE PERFORMED AT LOCATIONS INDICATED ON THIS SHEET AND AS DIRECTED BY THE RESIDENT ENGINEER. PAYMENT WILL BE UNDER THE APPLICABLE EQUIPMENT RENTAL ITEM(S).

NOT TO SCALE


PROJECT TYPICAL SHEET #2	PROJECT NAME: DERBY	
	PROJECT NUMBER: STP 2703(1)	
	FILE NAME: 07D202.dgn	PLOT DATE: 29-JAN-2013 09:2
	PROJECT LEADER: JLL	DRAWN BY: STANTEC
	DESIGNED BY: STANTEC	CHECKED BY: JLL
	IPARM FILE: 07CI94_27.i	SHEET 27 OF 62

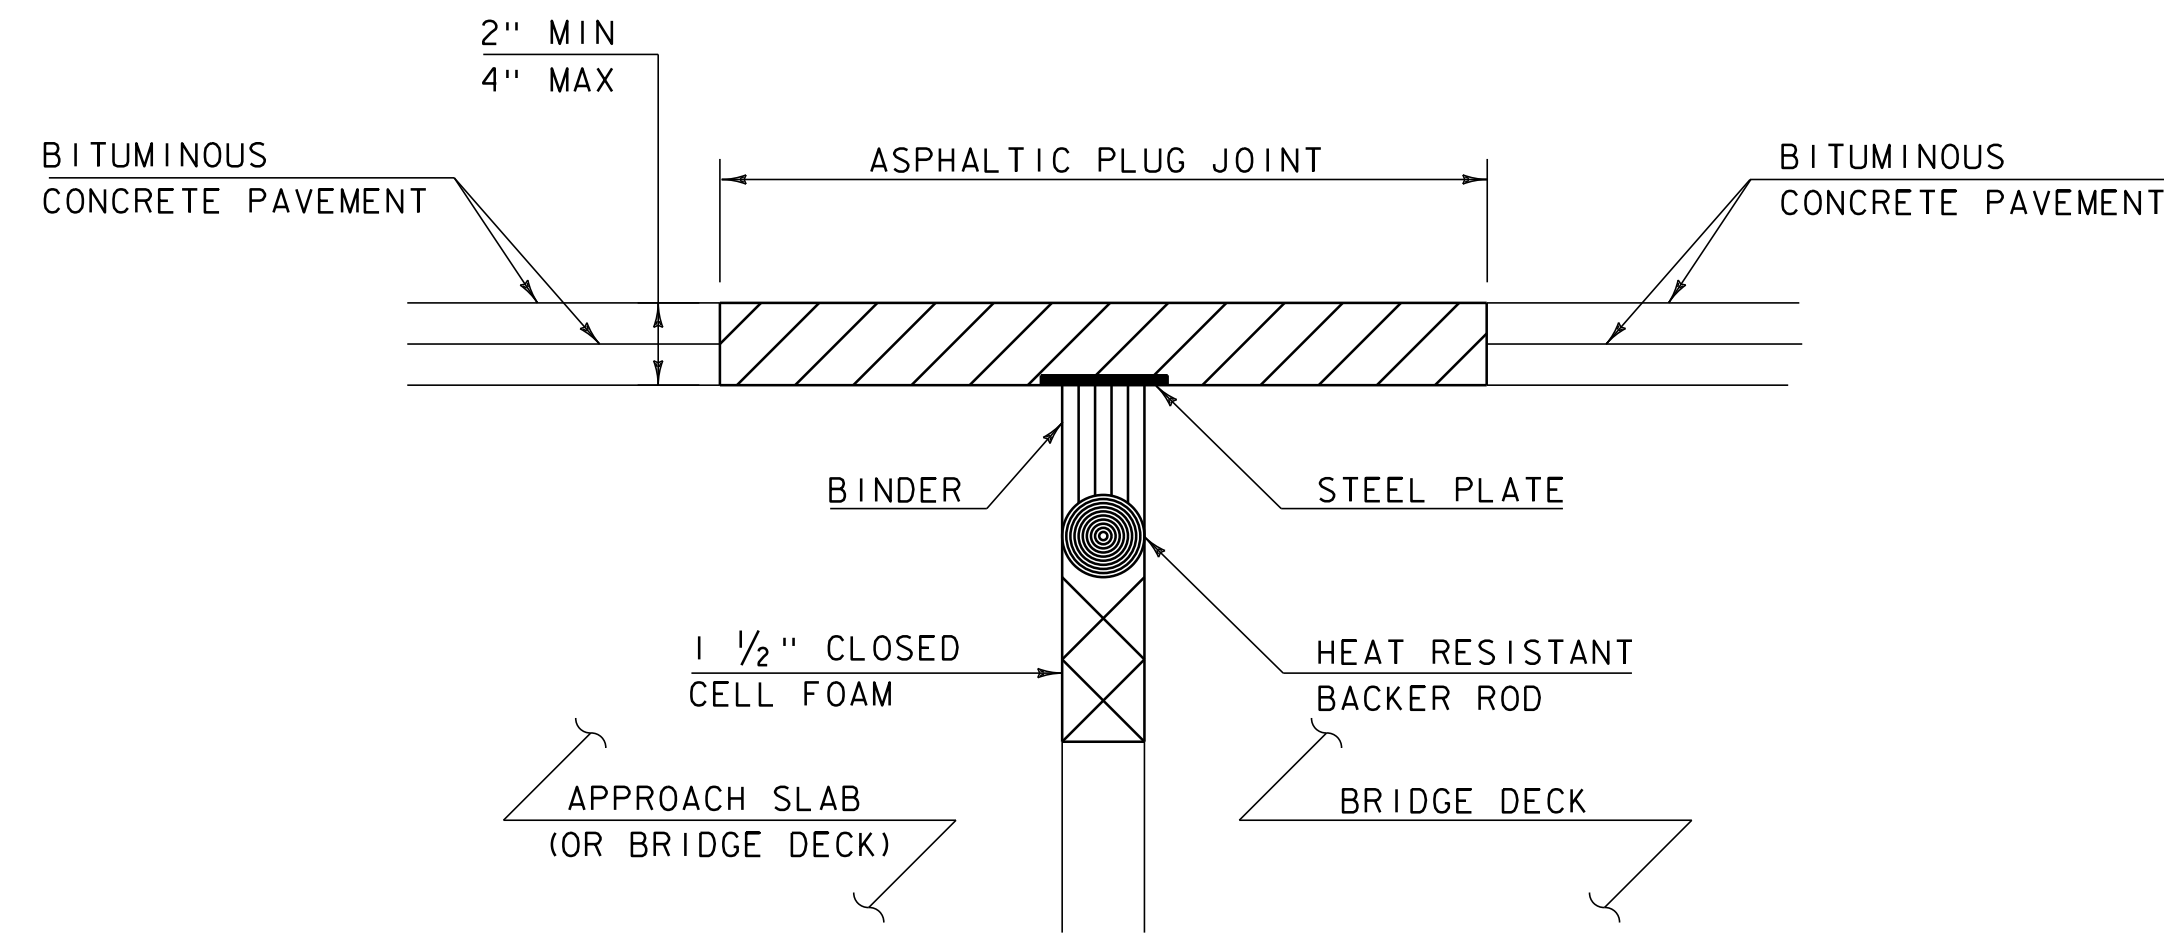

ASPHALTIC PLUG-TYPE JOINT DETAIL

(NOT TO SCALE)

BR 114 DERBY ALT U.S. ROUTE 5 STA. 29+39.45 (34LF)
BR 114 DERBY TOWN T.H.1 STA. 0+28.00 (34LF)

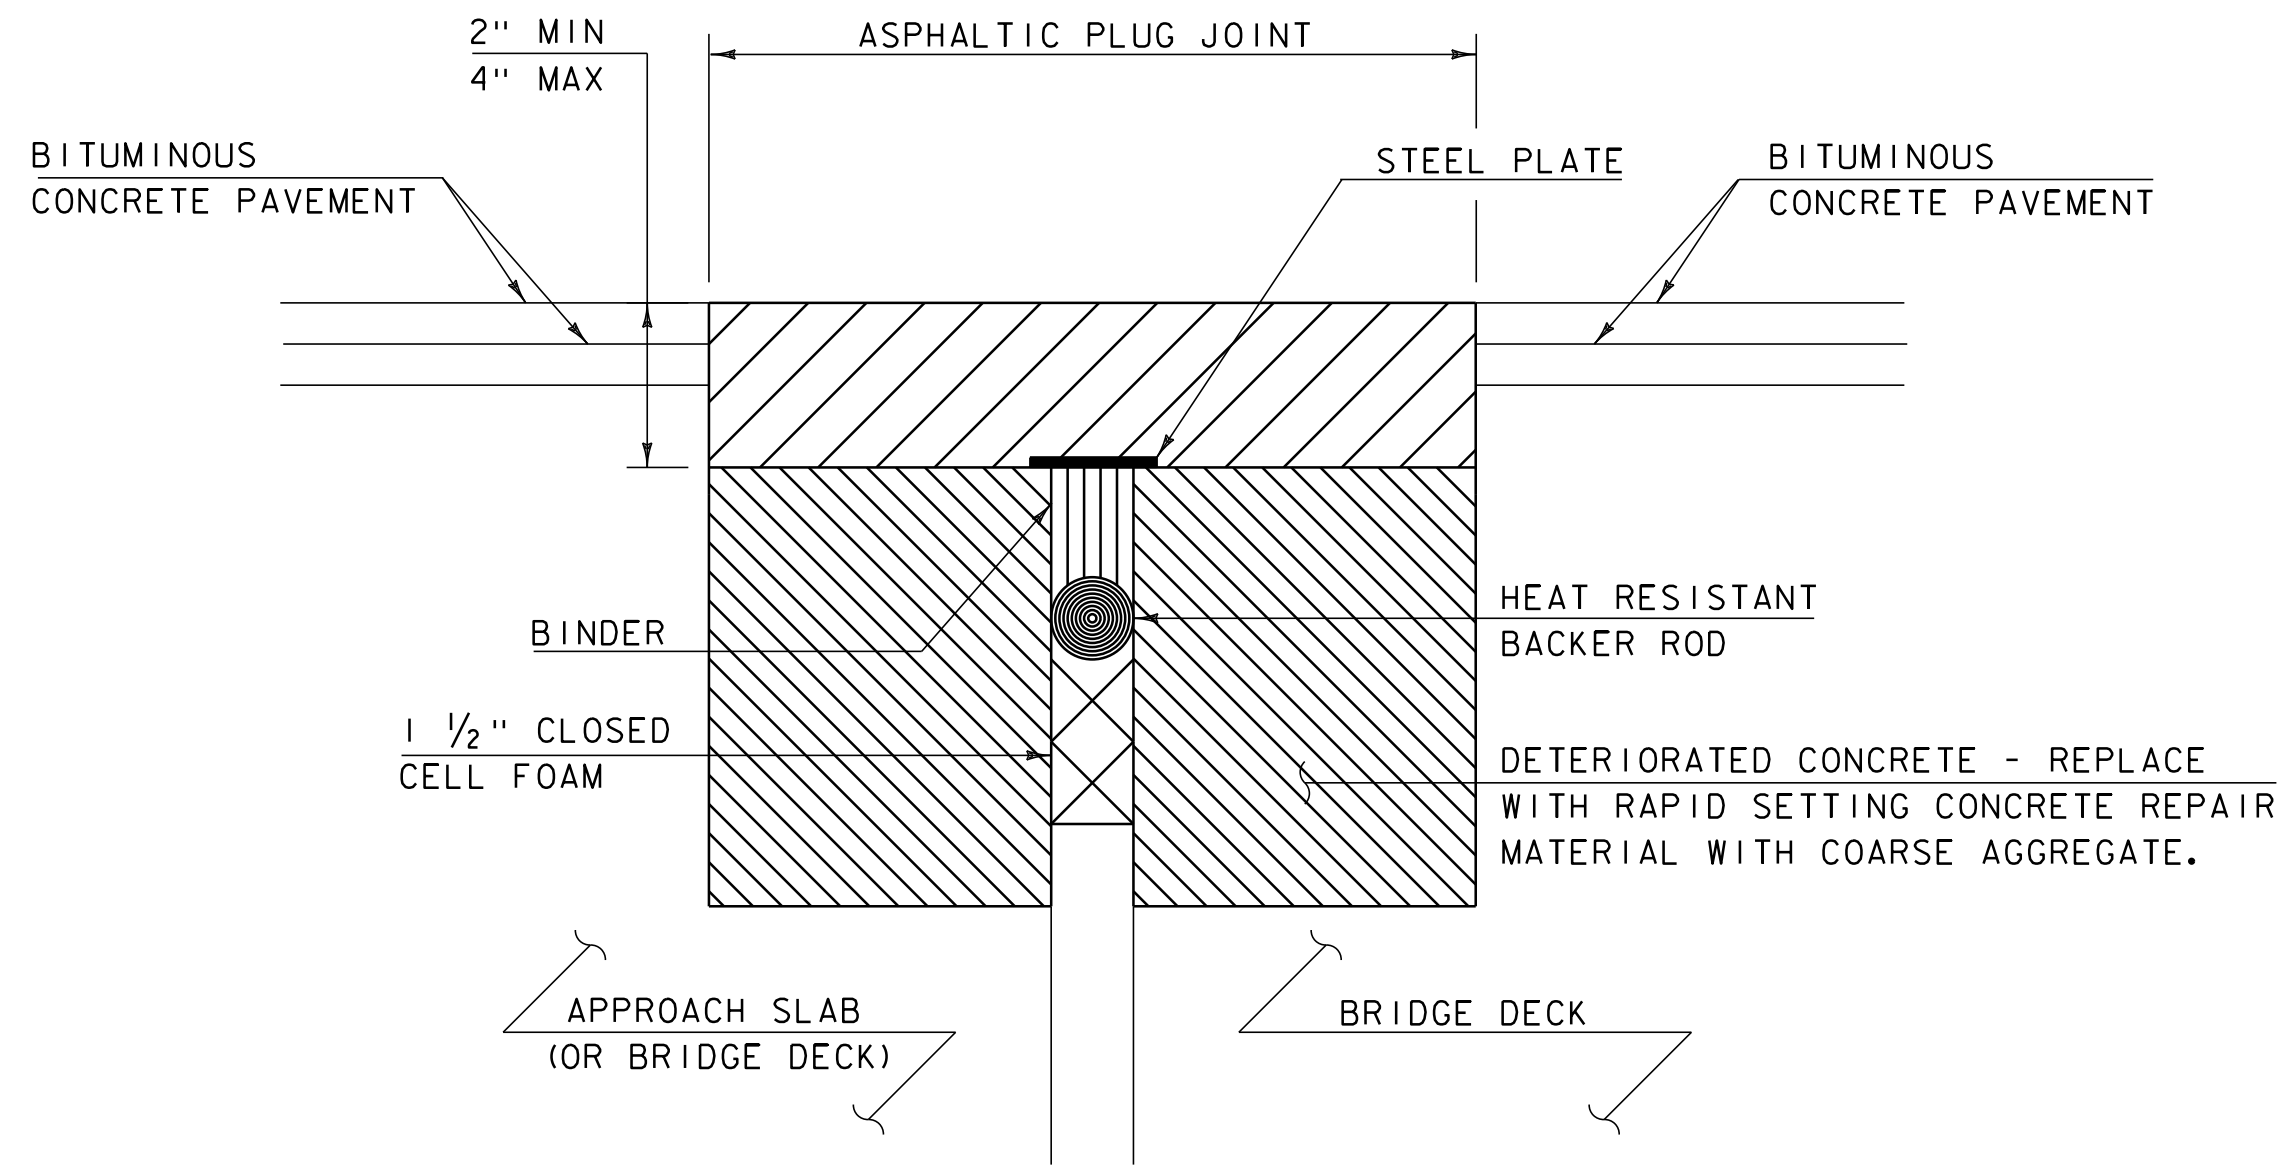


ASPHALTIC PLUG-TYPE JOINT DETAIL REMOVAL OF > 2" DETERIORATED CONCRETE

(NOT TO SCALE)

NOTES:

- UPON ENCOUNTERING GREATER THAN 2" AVERAGE OF DETERIORATED CONCRETE, THE CONTRACTOR SHALL REMOVE THE DETERIORATED MATERIAL AND REPLACE IT WITH RAPID SETTING CONCRETE REPAIR MATERIAL WITH COARSE AGGREGATE FORMED TO EXISTING ELEVATION.
- REMOVAL OF THE DETERIORATED CONCRETE WILL BE INCLUDED IN THE UNIT BID PRICE FOR ITEM 580.20 "RAPID SETTING CONCRETE REPAIR MATERIAL WITH COARSE AGGREGATE".
- REINFORCING STEEL NOT SHOWN FOR CLARITY.

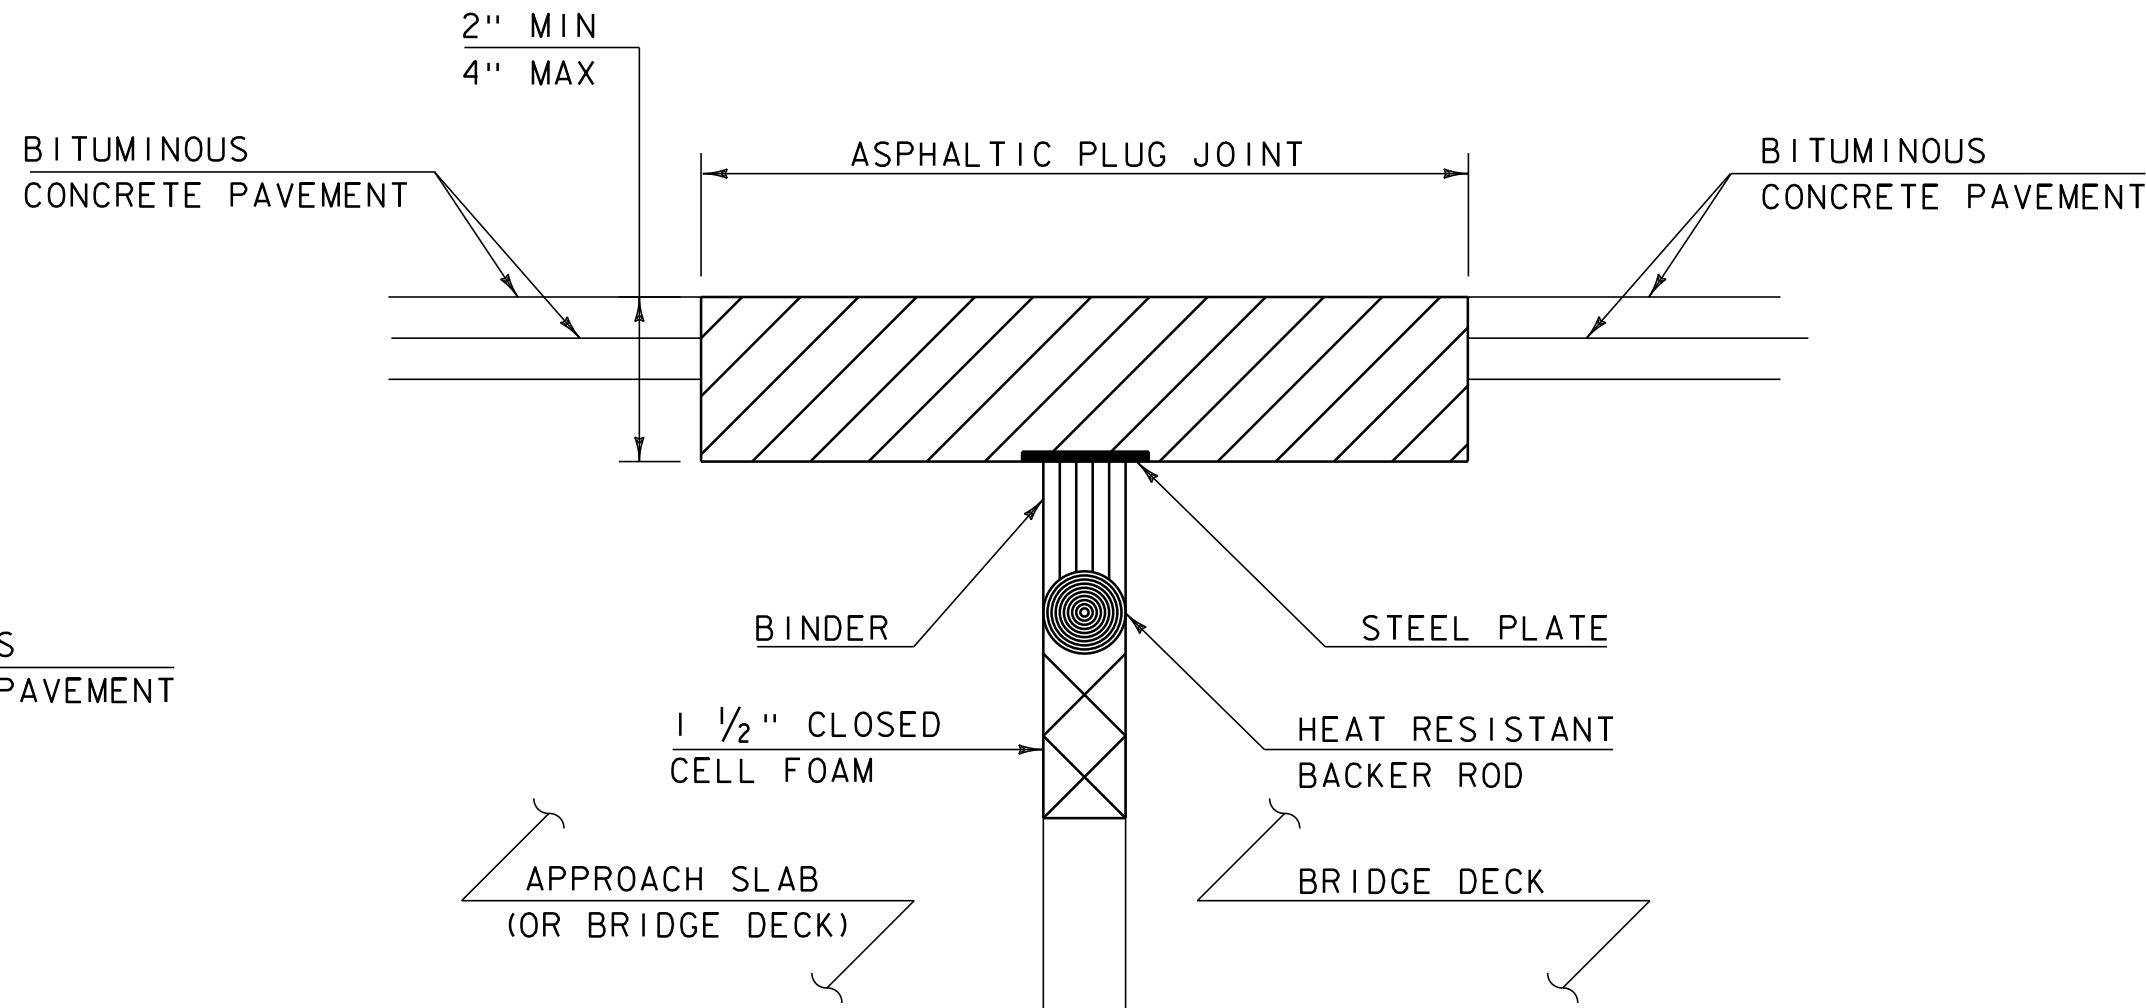

ASPHALTIC PLUG-TYPE JOINT DETAIL REMOVAL OF < 2" DETERIORATED CONCRETE

(NOT TO SCALE)

NOTES:

- UPON ENCOUNTERING UP TO 2" AVERAGE OF DETERIORATED CONCRETE, THE CONTRACTOR SHALL REMOVE THE DETERIORATED MATERIAL AND REPLACE IT WITH THE ASPHALTIC PLUG JOINT MATERIAL AS DIRECTED BY THE RESIDENT ENGINEER.
- REMOVAL OF THE DETERIORATED CONCRETE WILL NOT BE PAID SEPARATELY BUT WILL BE CONSIDERED INCIDENTAL TO THE UNIT BID PRICE FOR THE ITEM 516.10. THE ADDITIONAL PLUG JOINT MATERIAL BELOW THE DESIGN DEPTH TO REPLACE THE DETERIORATED CONCRETE WILL BE CONSIDERED INCIDENTAL TO THE UNIT BID PRICE FOR THE ITEM 516.10.

ASPHALTIC PLUG JOINT NOTES

I. INSTALLATION

- LOCATE THE JOINT CENTRALLY OVER THE DECK OVERLAY EXPANSION GAP OR FIXED JOINT MARKED OUT TO THE MANUFACTURER'S RECOMMENDED WIDTH.
- REMOVE THE BITUMINOUS CONCRETE PAVEMENT FULL DEPTH AS SHOWN ON THE PLANS. THE PAVEMENT SHALL BE DRY AND SAW CUT TO THE LIMITS REQUIRED TO PLACE THE JOINT. A PNEUMATIC HAMMER AND CHISEL MAY BE USED ADJACENT TO THE CURB ONLY WHEN SAW CUTTING IS NOT POSSIBLE.
- BLAST CLEAN THE JOINT AREA OF DEBRIS, ASPHALT AND SHEET MEMBRANE. THOROUGHLY DRY THE JOINT AREA WITH COMPRESSED AIR PRIOR TO APPLYING BINDER MATERIAL.
- REPAIR SPALLED AND DEFECTIVE CONCRETE WITH AN APPROVED MATERIAL AS AGREED UPON BY THE ENGINEER.
- PLACE PROPERLY SIZED HEAT RESISTANT BACKER ROD IN THE MOVEMENT GAP ALLOWING FOR 1" +/- OF BINDER ABOVE THE ROD.
- HEAT AND PLACE THE BINDER MATERIAL AS RECOMMENDED BY THE MANUFACTURER.

G. PLACE 1/4" THICK BY 8" WIDE SECTIONS OF STEEL PLATE OVER THE CENTER OF THE MOVEMENT GAP. SECURE THE PLATES FROM MOVING BY INSERTING LOCATING PINS THROUGH THE PRESTAMPED HOLES INTO BACKER ROD AND COVER WITH HOT BINDER. THE STEEL PLATES MAY BE OMITTED WHERE THE ENGINEER DETERMINES THAT THE APPROACH SLAB OR BRIDGE DECK WILL PROVIDE INADEQUATE SUPPORT AND WHERE VERTICAL MOVEMENT OF THE PLATES MIGHT OCCUR.

H. HEAT AND MIX THE BINDER MATERIAL AND AGGREGATE AS RECOMMENDED BY THE MANUFACTURER.

I. INSTALLATION OF MATERIAL, COMPACTION, AND TOP COATING SHALL BE AS RECOMMENDED BY THE MANUFACTURER.

J. IMMEDIATELY AFTER TOP COATING, CAST AN ANTI-SKID MATERIAL OVER THE JOINT TO REDUCE THE RISK OF TRACKING.

K. ONCE THE JOINT REACHES 82 DEG C (180 DEG F) +/-, WATER MAY BE USED TO EXPEDITE THE COOLING PROCESS.

L. PROTECT JOINT FROM TRAFFIC UNTIL THE MATERIAL HAS COOLED TO 51 DEG C (125 DEG F) +/-.

2. WEATHER LIMITATIONS. (APPLY BINDER MATERIAL ONLY WHEN THE FOLLOWING CONDITIONS PREVAIL OR AS RECOMMENDED BY THE MANUFACTURER):

- THE AMBIENT AIR TEMPERATURE IS AT LEAST 10 DEG C (50 DEG F) AND RISING.
- THE ROAD SURFACE IS DRY.
- WEATHER CONDITIONS OR OTHER CONDITIONS ARE FAVORABLE AND ARE EXPECTED TO REMAIN SO FOR THE PERFORMANCE OF SATISFACTORY WORK.

NOT TO SCALE

ASPHALTIC PLUG JOINT DETAILS SHEET

PROJECT NAME: DERBY
PROJECT NUMBER: STP 2703(1)

FILE NAME: 07D202.dgn
PROJECT LEADER: JLL
DESIGNED BY: STANTEC
IPARM FILE: 07C194_28.1


PLOT DATE: 29-JAN-2013 09:2
DRAWN BY: STANTEC
CHECKED BY: JLL
SHEET 28 OF 62

QUANTITY SHEET 1


[illegible]

ITEM DETAIL SUMMARY SHEET 1																												
LOCATION			GUARDRAIL				MISCELLANEOUS																		REMARKS			
BEGIN STATION	END STATION	POS.	621.20	621.60	621.74	621.80	203.15	203.16	301.26	604.40	604.412	604.415	604.418	616.28	616.41	616.47	618.10	618.30	619.17	620.75	653.20	676.10	676.12					
			S.B. GR. GALV. LF	ANCHOR FOR S.B. RAIL EA	ALUMINUM APPROACH RAILING LF	REMOVAL & DISPOSAL OF GUARDRAIL LF	COMMON EXCAVATION CY	SOLID ROCK EXCAV. CY	SUBBASE CRUSHED GRAVEL CY	CHAN ELEV OF DI, CB OR MH EA	REHAB DI, CB, OR MH, CLASS I EA	REHAB DI, CB, OR MH, CLASS II EA	REHAB DI, CB, OR MH, CLASS III EA	C-I-P CONC. CURB TYPE B LF	REMOVAL OF EXIST. CURB LF	BIT. CONC. GUTTERS & TRAFF. ISL. TON	PORT. CEM. CONC. SIDEWALK, 5 INCH SY	DET. WARNING SURFACE SF	YIELDING MARKER POSTS EA	SNOW BARRIER, GALV. EA	TEMP. EROSION MATTING SY	DELINEATOR WITH STEEL POST EA	REMOVAL OF EXISTING DELINEATOR EA					
U.S. ROUTE 5 DERBY																												
270+23	313+32	LT&RT								I	6	5	5						10		200				QUANTITIES FOR USE AS DIRECTED BY THE RESIDENT ENGINEER			
282+02		LT					0.4	0.4	0.4								2.7	8							CONSTRUCT SIDEWALK RAMP, TYPE 1			
282+29		LT					0.5	0.4	0.5								2.9	8							CONSTRUCT SIDEWALK RAMP, TYPE 1			
283+89		LT					0.4	0.4	0.4								2.7	8							CONSTRUCT SIDEWALK RAMP, TYPE 1			
284+18		LT					0.8		0.5								2.8	8							CONSTRUCT SIDEWALK LANDING AND DETECTABLE WARNING SURFACE			
294+92		RT					0.4	0.4	0.4								2.7	8							CONSTRUCT SIDEWALK RAMP, TYPE 1			
295+18		RT					1.8	0.4	1.2								7.0	16							CONSTRUCT SIDEWALK RAMPS, TYPE 6			
295+19		LT					0.7	0.6	0.7								4.4	8							CONSTRUCT SIDEWALK RAMP, TYPE 6			
295+64		LT					1.1	0.9	1.1								4.4	8							CONSTRUCT SIDEWALK RAMP, TYPE 1			
301+21		RT					2.1		1.1								6.9	8							CONSTRUCT SIDEWALK RAMP, TYPE 2			
301+25		LT					0.8	0.7	0.8								5.0	8							CONSTRUCT SIDEWALK RAMP, TYPE 6			
302+07		LT					1.2		0.7								4.0	12							CONSTRUCT SIDEWALK LANDING AND DETECTABLE WARNING SURFACE			
304+72		LT					1.2		0.6								3.9	12							CONSTRUCT SIDEWALK RAMP, TYPE 1			
305+50		LT					0.7	0.6	0.7								4.4	8							CONSTRUCT SIDEWALK RAMP, TYPE 1			
305+95		RT					4.0	1.2	2.8					18	18		17.1	8							CONSTRUCT SIDEWALK RAMP, TYPE 1			
307+74		LT					1.4	1.2	1.4								8.5	16							CONSTRUCT SIDEWALK RAMP, TYPE 1			
307+78		RT					2.6	2.2	2.6					5	5		15.6	8							CONSTRUCT SIDEWALK RAMP, TYPE 2			
309+72		RT					0.6	0.5	0.6								3.3	8							CONSTRUCT SIDEWALK RAMP, TYPE 6			
309+78		LT					1.0		0.6								3.3	8							CONSTRUCT SIDEWALK LANDING AND DETECTABLE WARNING SURFACE			
ALT. U.S. ROUTE 5																												
0+00	31+89	LT&RT									5	6	6						8						QUANTITIES FOR USE AS DIRECTED BY THE RESIDENT ENGINEER			
0+85		RT					1.5	1.3	1.5					19	19		9.3	8							CONSTRUCT SIDEWALK RAMP, TYPE 6			
0+85		LT					0.5	0.4	0.5								2.7	12							CONSTRUCT SIDEWALK RAMP, TYPE 6			
1+88		LT					0.6	0.5	0.6								3.9	12							CONSTRUCT SIDEWALK RAMP, TYPE 6			
1+89		RT					1.2	1.0	1.2								7.0	12							CONSTRUCT SIDEWALK RAMP, TYPE 6			
2+47		RT					0.6	0.5	0.6								3.6	8							CONSTRUCT SIDEWALK RAMP, TYPE 1			
2+91		RT					0.5	0.4	0.5								2.8	8							CONSTRUCT SIDEWALK RAMP, TYPE 1			
5+67		RT					2.1		2.1								12.7	8							CONSTRUCT SIDEWALK LANDING AND DETECTABLE WARNING SURFACE			
5+67		LT					0.8	0.4	0.5								2.8	8							CONSTRUCT SIDEWALK LANDING AND DETECTABLE WARNING SURFACE			
SHEET SUBTOTALS:							29.5	14.4	24.6	I	II	II	II	42	42		146.4	244	18		200							
																					ITEM DETAIL SUMMARY SHEET #1		PROJECT NAME: DERBY					
																							PROJECT NUMBER: STP 2703(I)					
																							FILE NAME: 07D202.dgn					
																							PLOT DATE: 29-JAN-2013 09:2					
																							PROJECT LEADER: JLL					
																							DRAWN BY: STANTEC					
																							DESIGNED BY: STANTEC					
																							IPARM FILE: 07CI94_31.i					
																							SHEET 31 OF 62					

ITEM DETAIL SUMMARY SHEET 2																									
LOCATION			GUARDRAIL				MISCELLANEOUS																		REMARKS
BEGIN STATION	END STATION	POS.	621.20 S.B. GR. GALV. LF	621.60 ANCHOR FOR S.B. RAIL EA	621.74 ALUMINUM APPROACH RAILING LF	621.80 REMOVAL & DISPOSAL OF GUARDRAIL LF	203.15 COMMON EXCAVATION CY	203.16 SOLID ROCK EXCAV. CY	301.26 SUBBASE CRUSHED GRAVEL CY	604.40 CHAN ELEV OF DI, CB OR MH EA	604.412 REHAB DI, CB, OR MH, CLASS I EA	604.415 REHAB DI, CB, OR MH, CLASS II EA	604.418 REHAB DI, CB, OR MH, CLASS III EA	616.28 C-I-P CONC. CURB TYPE B LF	616.41 REMOVAL OF EXIST. CURB LF	616.47 BIT. CONC. GUTTERS & TRAFF. ISL. TON	618.10 PORT. CEM. CONC. SIDEWALK, 5 INCH SY	618.30 DET. WARNING SURFACE SF	620.75 SNOW BARRIER, GALV. EA	619.17 YIELDING MARKER POSTS EA	653.20 TEMP. EROSION MATTING SY	676.10 DELINEATOR WITH STEEL POST EA	676.12 REMOVAL OF EXISTING DELINEATOR EA		
ALT. U.S. ROUTE 5 (CONT.) DERBY (CONT.)																									
8+87		LT					2.5		1.4								8.3	8						CONSTRUCT SIDEWALK RAMP, TYPE 6	
8+92		RT					3.3		1.8								10.7	8						CONSTRUCT SIDEWALK RAMP, TYPE 1	
8+95	9+74	LT														4.1								CONSTRUCT BITUMINOUS CONCRETE GUTTER (4' WIDE)	
11+90		RT					0.6	0.5	0.6								3.6	8						CONSTRUCT SIDEWALK RAMP, TYPE 1	
12+26		RT					0.6	0.5	0.6								3.6	8						CONSTRUCT SIDEWALK RAMP, TYPE 1	
18+81		RT					0.3	0.2	0.3								1.8	8						CONSTRUCT SIDEWALK LANDING AND DETECTABLE WARNING SURFACE	
19+07		RT					0.3	0.2	0.3								1.8	8						CONSTRUCT SIDEWALK LANDING AND DETECTABLE WARNING SURFACE	
25+69	28+58	RT	264.5	I	25	289																I	I	INSTALL ANCHOR AT 25+70.5, RT; CONNECT ALUMINUM APPROACH RAILING TO EXISTING BRIDGE RAIL ON BRIDGE #4	
26+04	28+79	LT	252	I	25	266																I	I	INSTALL ANCHOR AT 26+04, LT; CONNECT ALUMINUM APPROACH RAILING TO EXISTING BRIDGE RAIL ON BRIDGE #4	
29+26	29+98	RT																	72						
29+74	30+42	LT																	68						
30+69	31+41	RT																	72						
31+18	31+80	LT																	62						
APPROACH (DERBY TOWN)																									
0+50.8	2+27.8	RT	152	I	25	177																I	I	INSTALL ANCHOR AT 2+25.8, RT; CONNECT ALUMINUM APPROACH RAILING TO EXISTING BRIDGE RAIL ON BRIDGE #4	
0+72.8	4+13.8	LT	314.5	I	25	341																I	I	INSTALL ANCHOR AT 4+10.3, LT; CONNECT ALUMINUM APPROACH RAILING TO EXISTING BRIDGE RAIL ON BRIDGE #4	
SHEET 1 SUBTOTALS:			-	-	-	-	29.5	14.4	24.6	I	II	II	II	42	42	-	146.4	244	-	18	200	-	-		
SHEET																									

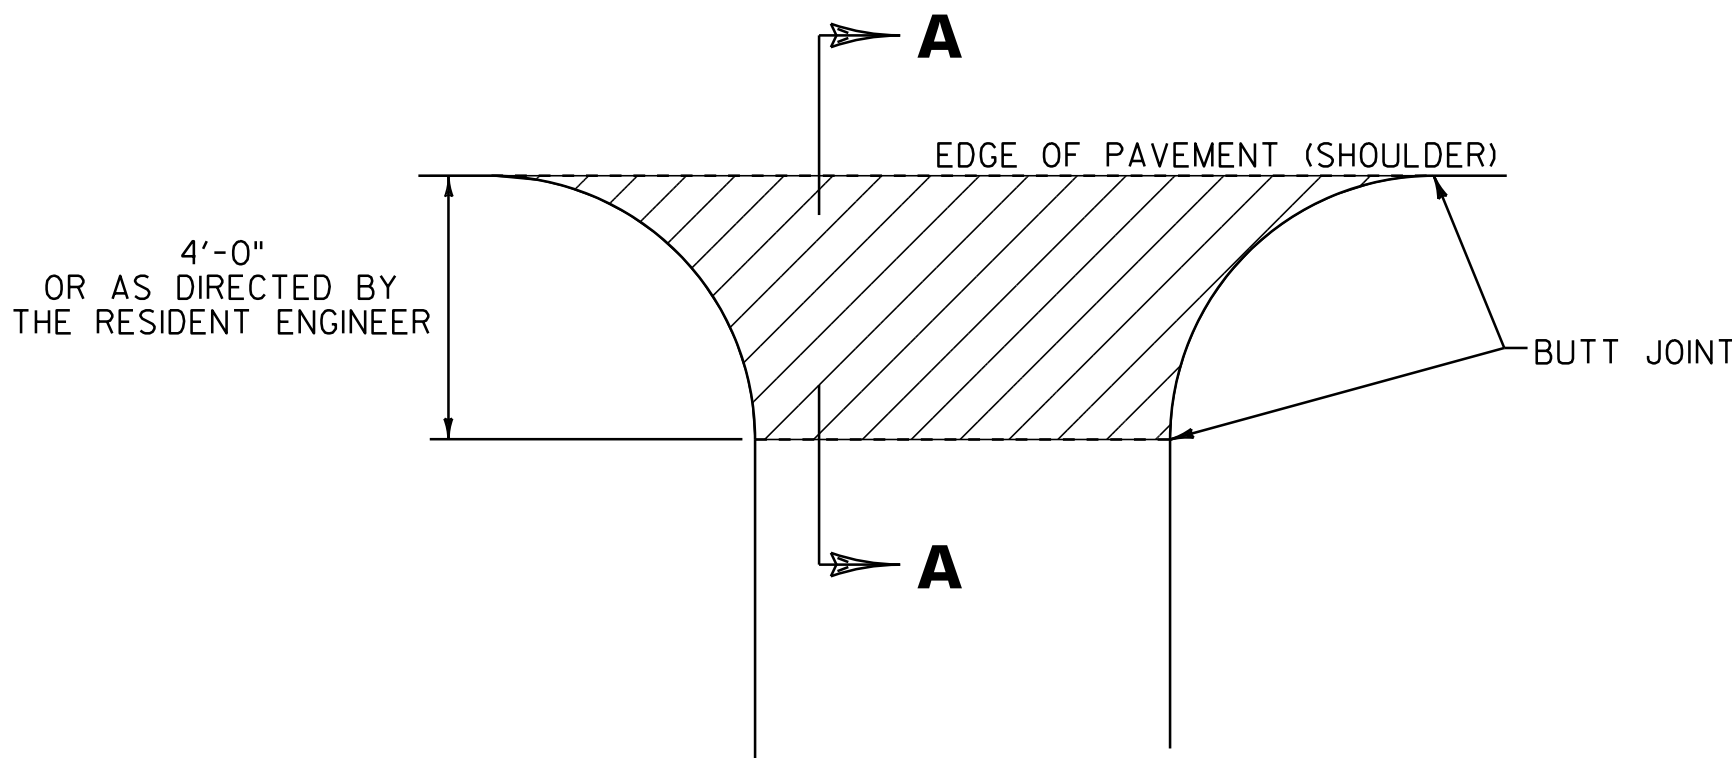

PLAN

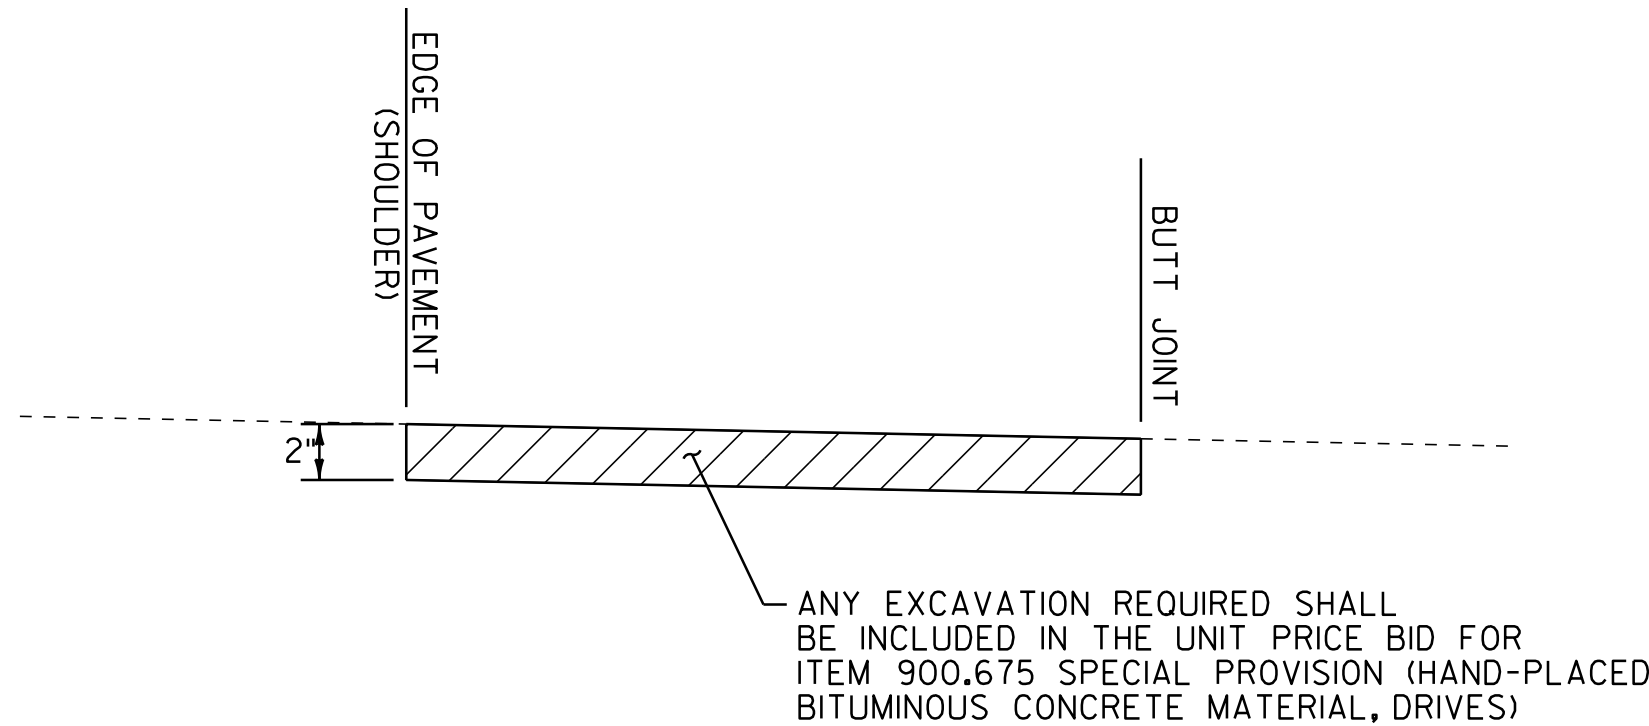

SECTION A-A

HANDWORK DETAILS FOR PAVED DRIVES


STATION	POSITION	QUANTITY (SY)
U.S. ROUTE 5		
271+09	RT	5
272+21	RT	9
273+19	LT	14
273+47	RT	6
273+78	LT	8
274+88	LT	8
276+46	LT	11
276+74	RT	10
277+37	RT	12
278+02	LT	13
278+03	RT	8
278+94	LT	9
279+78	LT	5
280+28	RT	6
281+66	RT	7
283+09	LT	5
283+66	RT	7
284+17	RT	8
285+11	LT	7
286+19	RT	9
286+60	LT	7
SUBTOTAL		174

STATION	POSITION	QUANTITY (SY)
U.S. ROUTE 5 (CONTINUED)		
287+29	LT	7
287+41	RT	8
289+34	RT	7
289+98	LT	8
290+29	RT	7
290+86	LT	6
291+05	RT	6
292+71	RT	5
293+56	RT	6
294+71	RT	5
295+94	RT	10
297+36	RT	8
299+38	RT	8
300+28	RT	8
301+33	RT	6
302+82	RT	43
304+92	RT	9
306+30	RT	21
308+04	LT	20
308+33	RT	19
308+85	RT	10
SUBTOTAL		227


STATION	POSITION	QUANTITY (SY)
U.S. ROUTE 5 (CONTINUED)		
309+06	LT	38
309+65	LT	9
310+38	LT	6
311+24	LT	5
ALT. U.S. ROUTE 5		
2+61	RT	11
3+54	RT	11
4+49	RT	6
6+14	RT	11
6+67	LT	22
8+61	RT	5
9+06	RT	10
9+65	RT	5
10+55	LT	8
11+54	LT	16
11+61	RT	6
12+80	LT	11
13+54	RT	5
14+57	RT	8
16+27	RT	9
17+49	RT	6
SUBTOTAL		208

STATION	POSITION	QUANTITY (SY)
ALT. U.S. ROUTE 5 (CONTINUED)		
17+75	RT	4
18+28	LT	6
18+84	LT	6
20+01	LT	7
20+19	RT	4
20+81	RT	6
20+99	LT	7
22+30	LT	52
22+39	RT	8
23+00	RT	5
25+67	LT	13
SUBTOTAL		118
COLUMN 1		174
COLUMN 2		227
COLUMN 3		208
COLUMN 4		118
SUBTOTAL		727
ROUNDING		3
TOTAL		730

HANDWORK DETAILS FOR GRAVEL DRIVES

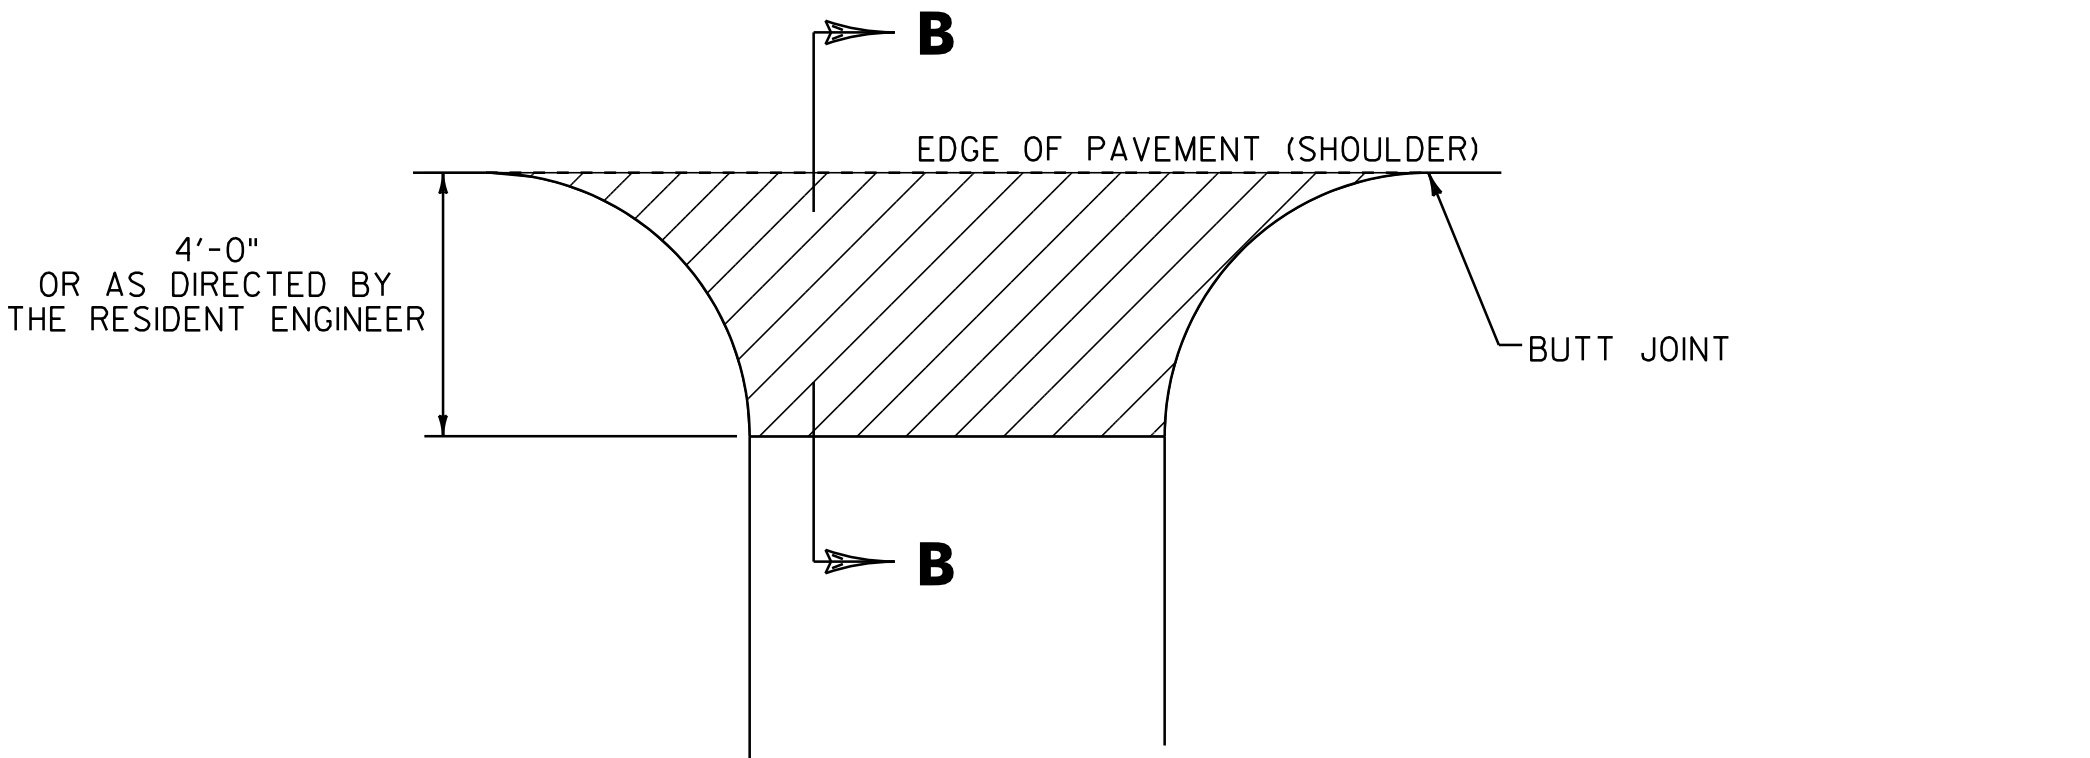

PLAN

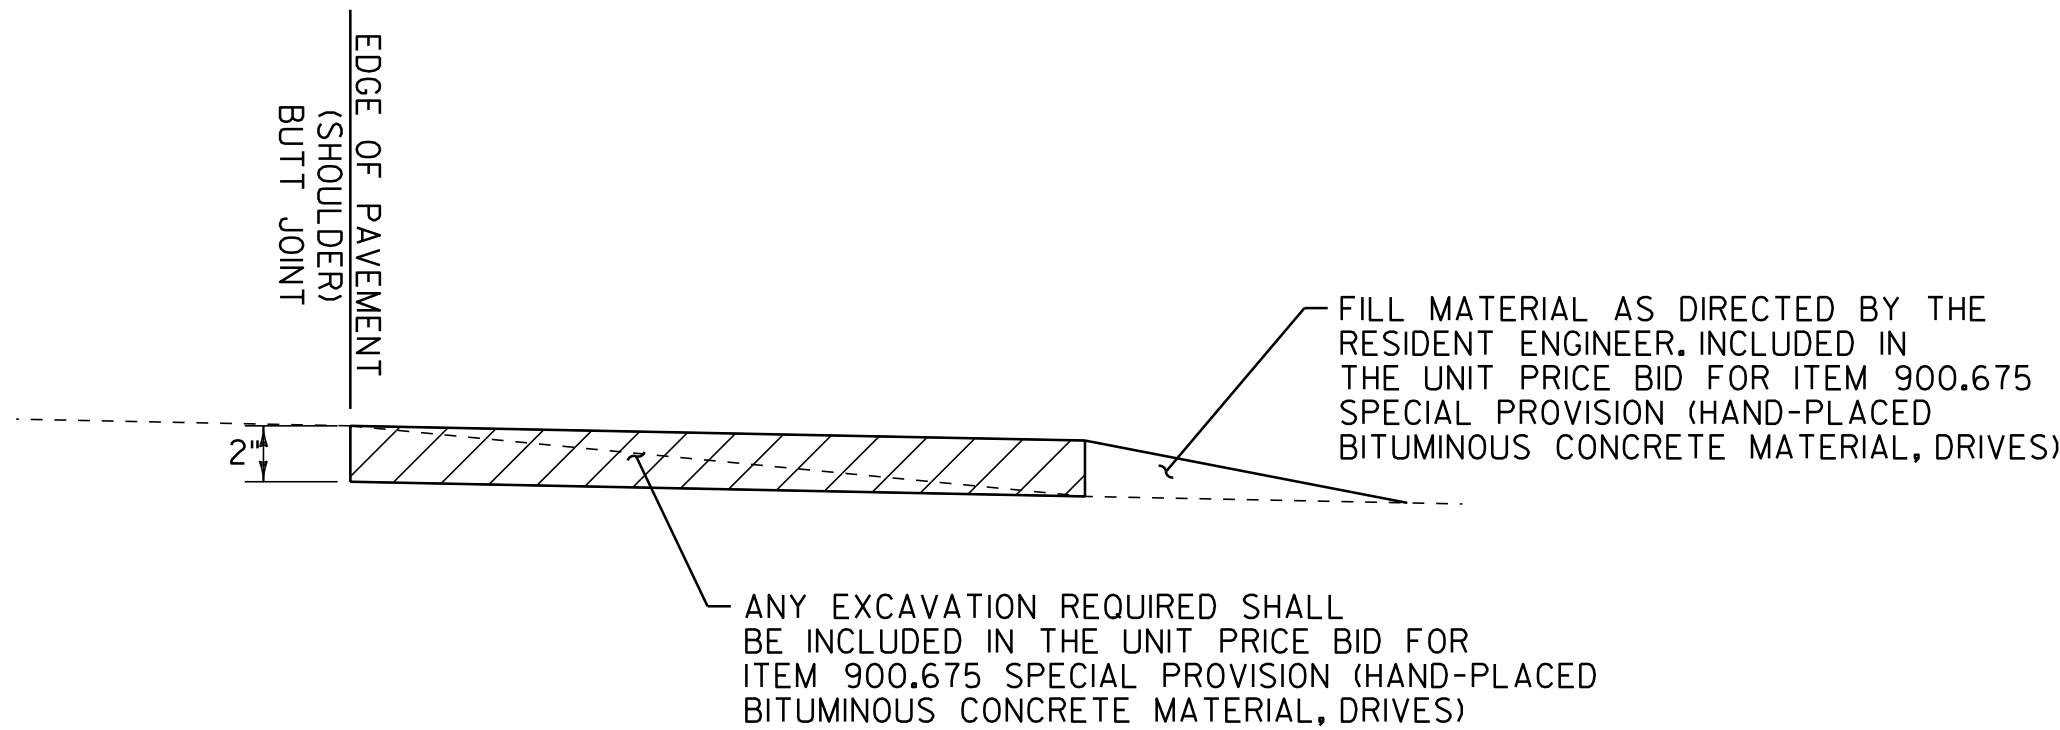


SECTION B-B

NOTES:

- PAVING LIFT SHALL BE A MINIMUM OF 1 1/2 " AND A MAXIMUM OF 2".
- THE COST OF PROVIDING AND PLACING SUBBASE MATERIAL, CLEANING EXISTING PAVED SURFACES, INCLUDING POWER EQUIPMENT, AND FOR FILLING JOINTS, CRACKS AND HOLES WILL NOT BE PAID DIRECTLY BUT WILL BE INCLUDED IN THE UNIT PRICE BID FOR ITEM 900.675 SPECIAL PROVISION (HAND-PLACED BITUMINOUS CONCRETE MATERIAL, DRIVES).
- EXCAVATION NEEDED TO ACHIEVE PROPER DRIVE SLOPES WILL NOT BE PAID DIRECTLY BUT WILL BE INCLUDED IN THE UNIT PRICE BID FOR ITEM 900.675 SPECIAL PROVISION (HAND-PLACED BITUMINOUS CONCRETE MATERIAL, DRIVES).

LEGEND

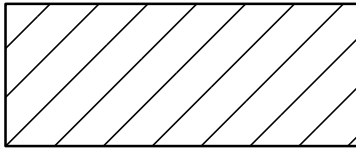

ITEM 900.675 SPECIAL PROVISION (HAND-PLACED BITUMINOUS CONCRETE MATERIAL, DRIVES)

NOT TO SCALE

DRIVE
DETAIL
SHEET

PROJECT NAME: DERBY
PROJECT NUMBER: STP 2703(1)

FILE NAME: 07D202.dgn
PROJECT LEADER: JLL
DESIGNED BY: MCF
IPARM FILE: 07C194_33.1


PLOT DATE: 29-JAN-2013 09:2
DRAWN BY: STANTEC
CHECKED BY: JLL
SHEET 33 OF 62

646.402 DURABLE 4 INCH WHITE LINE, THERMOPLASTIC
STA. 270+23.04 TO 273+50, SOLID LT & RT

646.602 TEMPORARY 4 INCH WHITE LINE, PAINT
STA. 270+23.04 TO 273+50, SOLID LT & RT

646.412 DURABLE 4 INCH YELLOW LINE, THERMOPLASTIC
STA. 270+23.04 TO 273+50, SOLID LT & RT

646.612 TEMPORARY 4 INCH YELLOW LINE, PAINT
STA. 270+23.04 TO 273+50, SOLID LT & RT

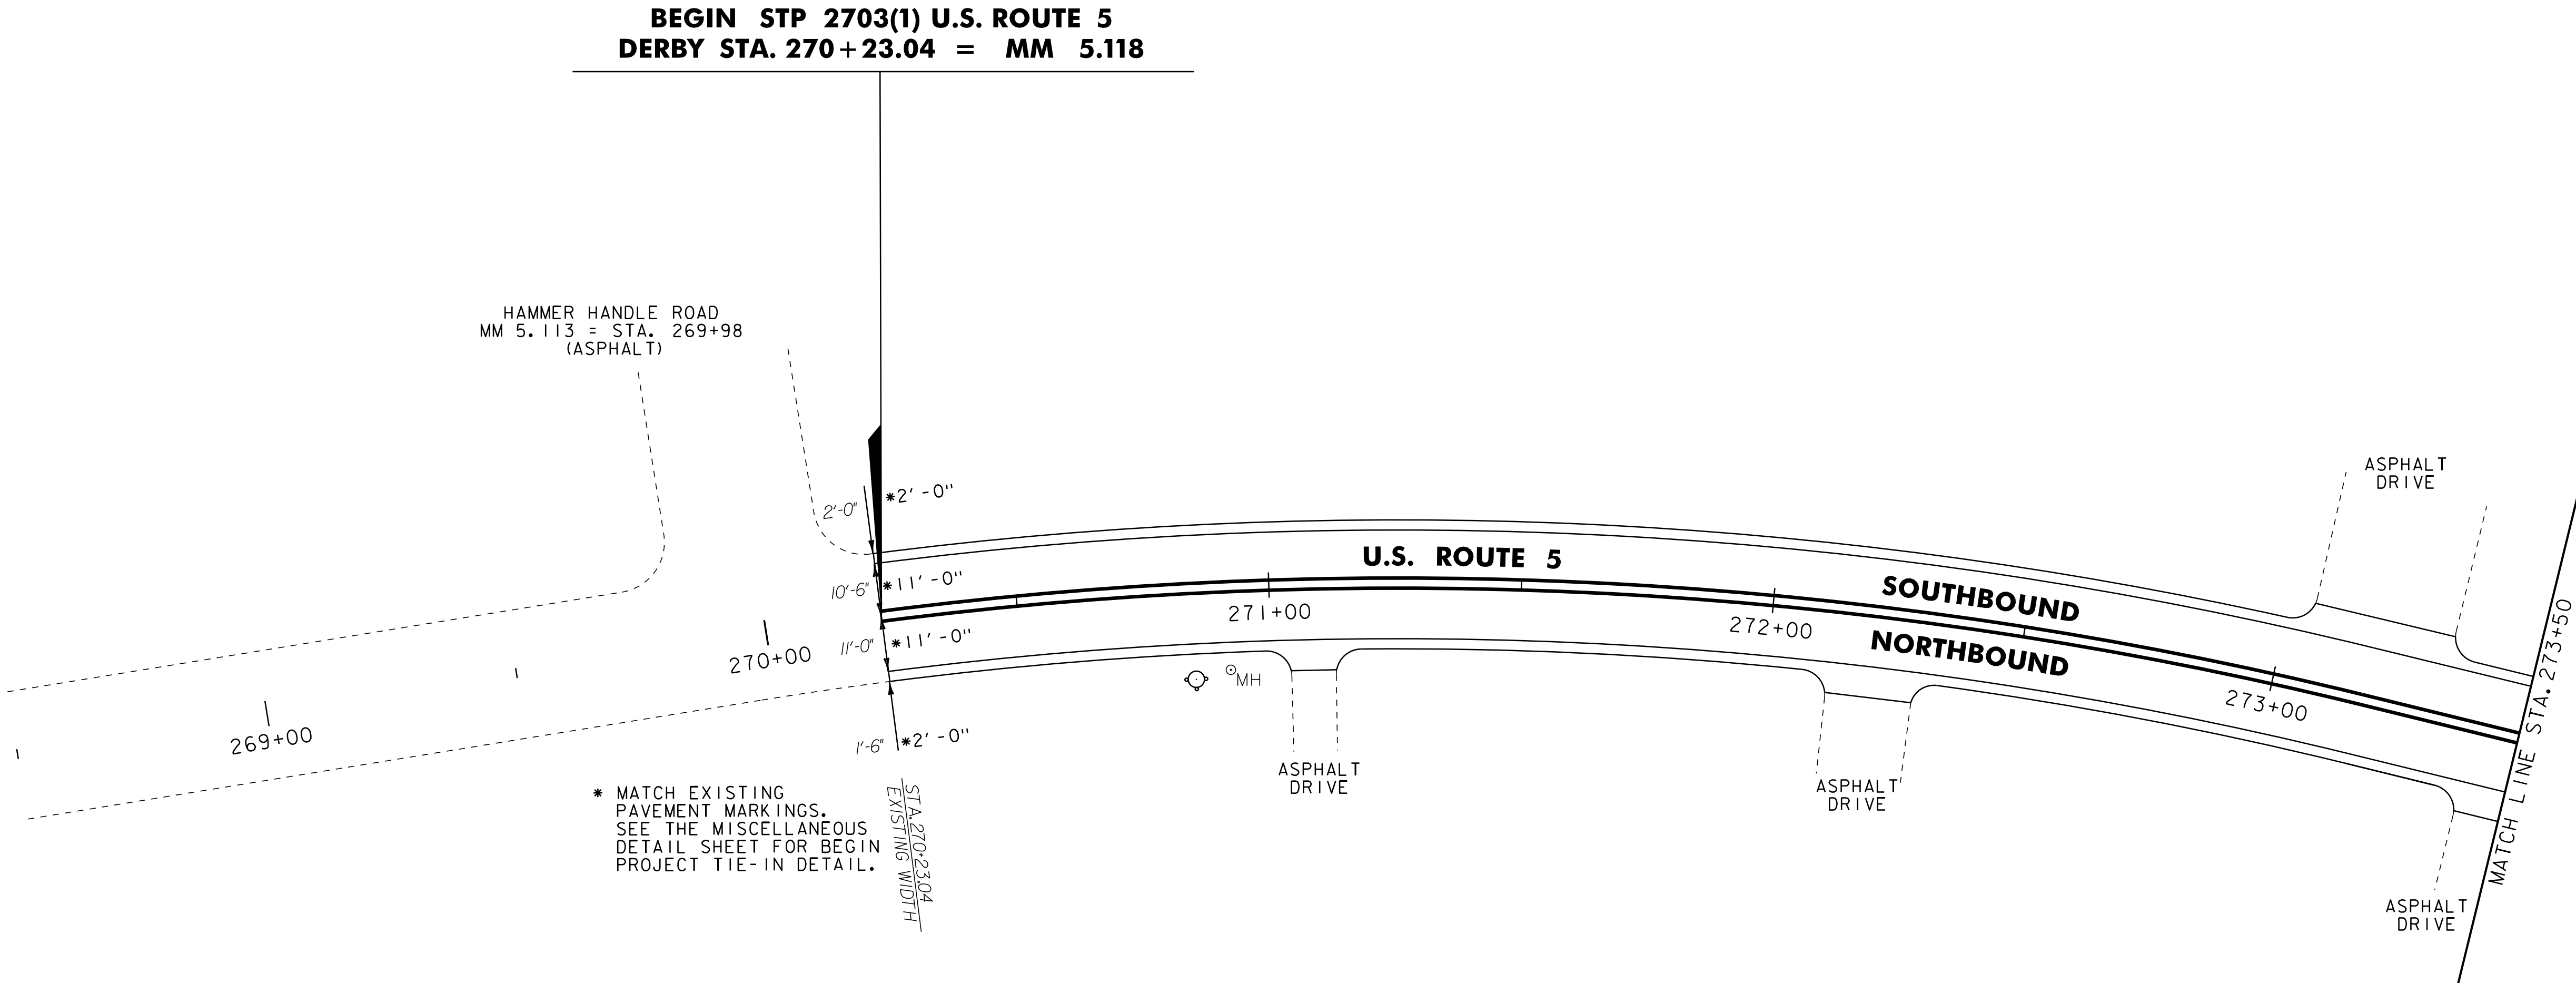

UTILITY LEGEND	
	= EXISTING HYDRANT
	= EXISTING DI
	= EXISTING MANHOLE
	= EXISTING TELEPHONE MANHOLE
	= EXISTING ELECTRIC MANHOLE
	= EXISTING SEWER MANHOLE
	= EXISTING WATER SHUTOFF
	= EXISTING GAS SHUTOFF
	= EXISTING MONITORING WELL
	= EXISTING MAILBOX
	= EXISTING POWER POLE
	= EXISTING TELEPHONE POLE
	= EXISTING UTILITY POLE
	= EXISTING SIGNAL HEAD
	= EXISTING CONTROLLER
	= EXISTING PULL BOX
	= EXISTING VIDEO VEHICLE DETECTORS
	= PROPOSED VIDEO VEHICLE DETECTORS
	= PROPOSED VIDEO DETECTION AREA
	= EXISTING GUARDRAIL
	= EXISTING RAILROAD
	= EXISTING FENCE
	= EXISTING STONE WALL

SIGN LEGEND	
N	= NEW
R	= REMOVE
R&S	= REMOVE & SALVAGE
S	= SALVAGE SIGN
RET	= RETAIN
B-B	= BACK TO BACK
①	= RETURN TO THE VILLAGE OF DERBY

NOT TO SCALE	NOTE: ALL EXISTING SIGNS NOT SHOWN SHALL BE RETAINED.	
	PROJECT NAME:	DERBY
	PROJECT NUMBER:	STP 2703(1)
	FILE NAME: 07D202.dgn	PLOT DATE: 29-JAN-2013 09:2
PROJECT LAYOUT SHEET #1	PROJECT LEADER: JLL	DRAWN BY: STANTEC
	DESIGNED BY: STANTEC	CHECKED BY: JLL
	IPARM FILE: 07C194_34.i	SHEET 34 OF 62


604.42 CHANGING ELEVATION OF SEWER MANHOLES
STA. 279+49, RT

646.402 DURABLE 4 INCH WHITE LINE, THERMOPLASTIC
STA. 273+50 TO 279+50, SOLID LT & RT

646.602 TEMPORARY 4 INCH WHITE LINE, PAINT
STA. 273+50 TO 279+50, SOLID LT & RT

646.412 DURABLE 4 INCH YELLOW LINE, THERMOPLASTIC
STA. 273+50 TO 279+50, SOLID LT & RT

646.612 TEMPORARY 4 INCH YELLOW LINE, PAINT
STA. 273+50 TO 279+50, SOLID LT & RT

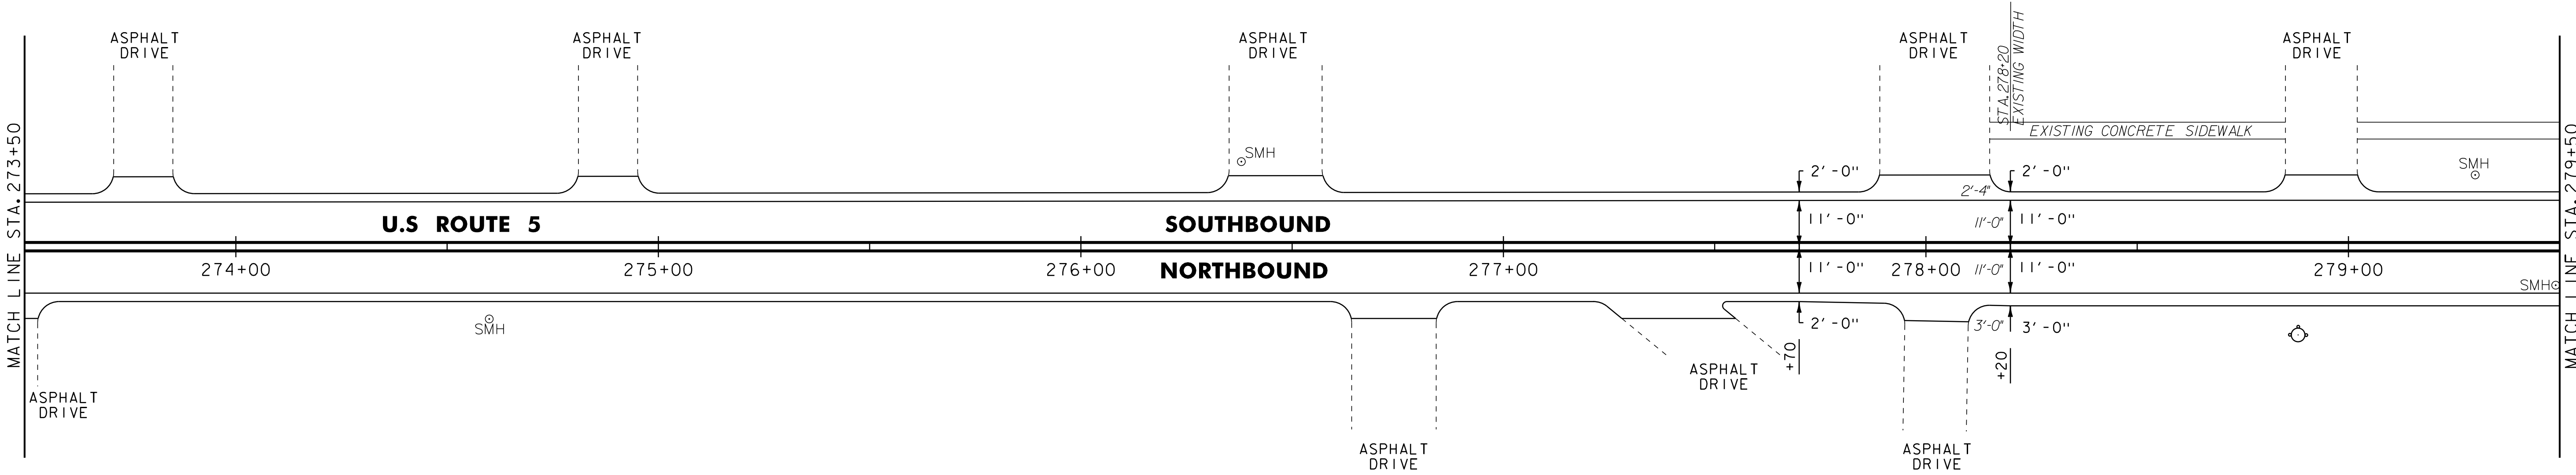

- NOTE:
- FOR LEGENDS, SEE LAYOUT SHEET #1.
 - ALL EXISTING SIGNS NOT SHOWN SHALL BE RETAINED.

NOT TO SCALE

PROJECT
LAYOUT
SHEET #2

PROJECT NAME: DERBY
PROJECT NUMBER: STP 2703(I)

FILE NAME: 07D202.dgn
PROJECT LEADER: JLL
DESIGNED BY: STANTEC
IPARM FILE: 07CI94_35.i

PLOT DATE: 29-JAN-2013 09:2
DRAWN BY: STANTEC
CHECKED BY: JLL
SHEET 35 OF 62

604.412, 604.415 OR 604.418 REHAB,
Dis. CBS OR MHS, CLASS I, II OR III
STA. 282+29, RT

604.42 CHANGING ELEVATION OF SEWER MANHOLES
STA. 282+27, LT
STA. 282+38, RT
STA. 284+01, LT

618.10 PORTLAND CEMENT CONCRETE SIDEWALK, 5 INCH
STA. 282+02, LT
STA. 282+29, LT
STA. 283+89, LT
STA. 284+18, LT

618.30 DETECTABLE WARNING SURFACE
STA. 282+02, LT
STA. 282+29, LT
STA. 283+89, LT
STA. 284+18, LT

629.20 ADJUSTING ELEVATION OF VALVE BOX
STA. 281+91, RT
STA. 284+08, RT

646.402 DURABLE 4 INCH WHITE LINE, THERMOPLASTIC
(ALL LINES WILL INCLUDE EDGE LINE BREAKS AND
RADI1 FOR SIDE ROADS)
STA. 279+50 TO 285+50, SOLID LT & RT

646.412 DURABLE 4 INCH YELLOW LINE, THERMOPLASTIC
(ALL LINES WILL INCLUDE C BREAKS FOR SIDE ROADS)
STA. 279+50 TO 285+50, SOLID LT & RT

646.502 DURABLE CROSSWALK MARKING, THERMOPLASTIC
STA. 282+02 TO 282+28, LT
STA. 283+90 TO 284+17, LT


646.602 TEMPORARY 4 INCH WHITE LINE, PAINT
(ALL LINES WILL INCLUDE EDGE LINE BREAKS AND
RADI1 FOR SIDE ROADS)
STA. 279+50 TO 285+50, SOLID LT & RT

646.612 TEMPORARY 4 INCH YELLOW LINE, PAINT
(ALL LINES WILL INCLUDE C BREAKS FOR SIDE ROADS)
STA. 279+50 TO 285+50, SOLID LT & RT

646.702 TEMPORARY CROSSWALK MARKING, PAINT
STA. 282+02 TO 282+28, LT
STA. 283+90 TO 284+17, LT

675.50 REMOVING SIGNS
AS SHOWN - 8

675.60 ERECTING SALVAGED SIGNS
AS SHOWN - 3

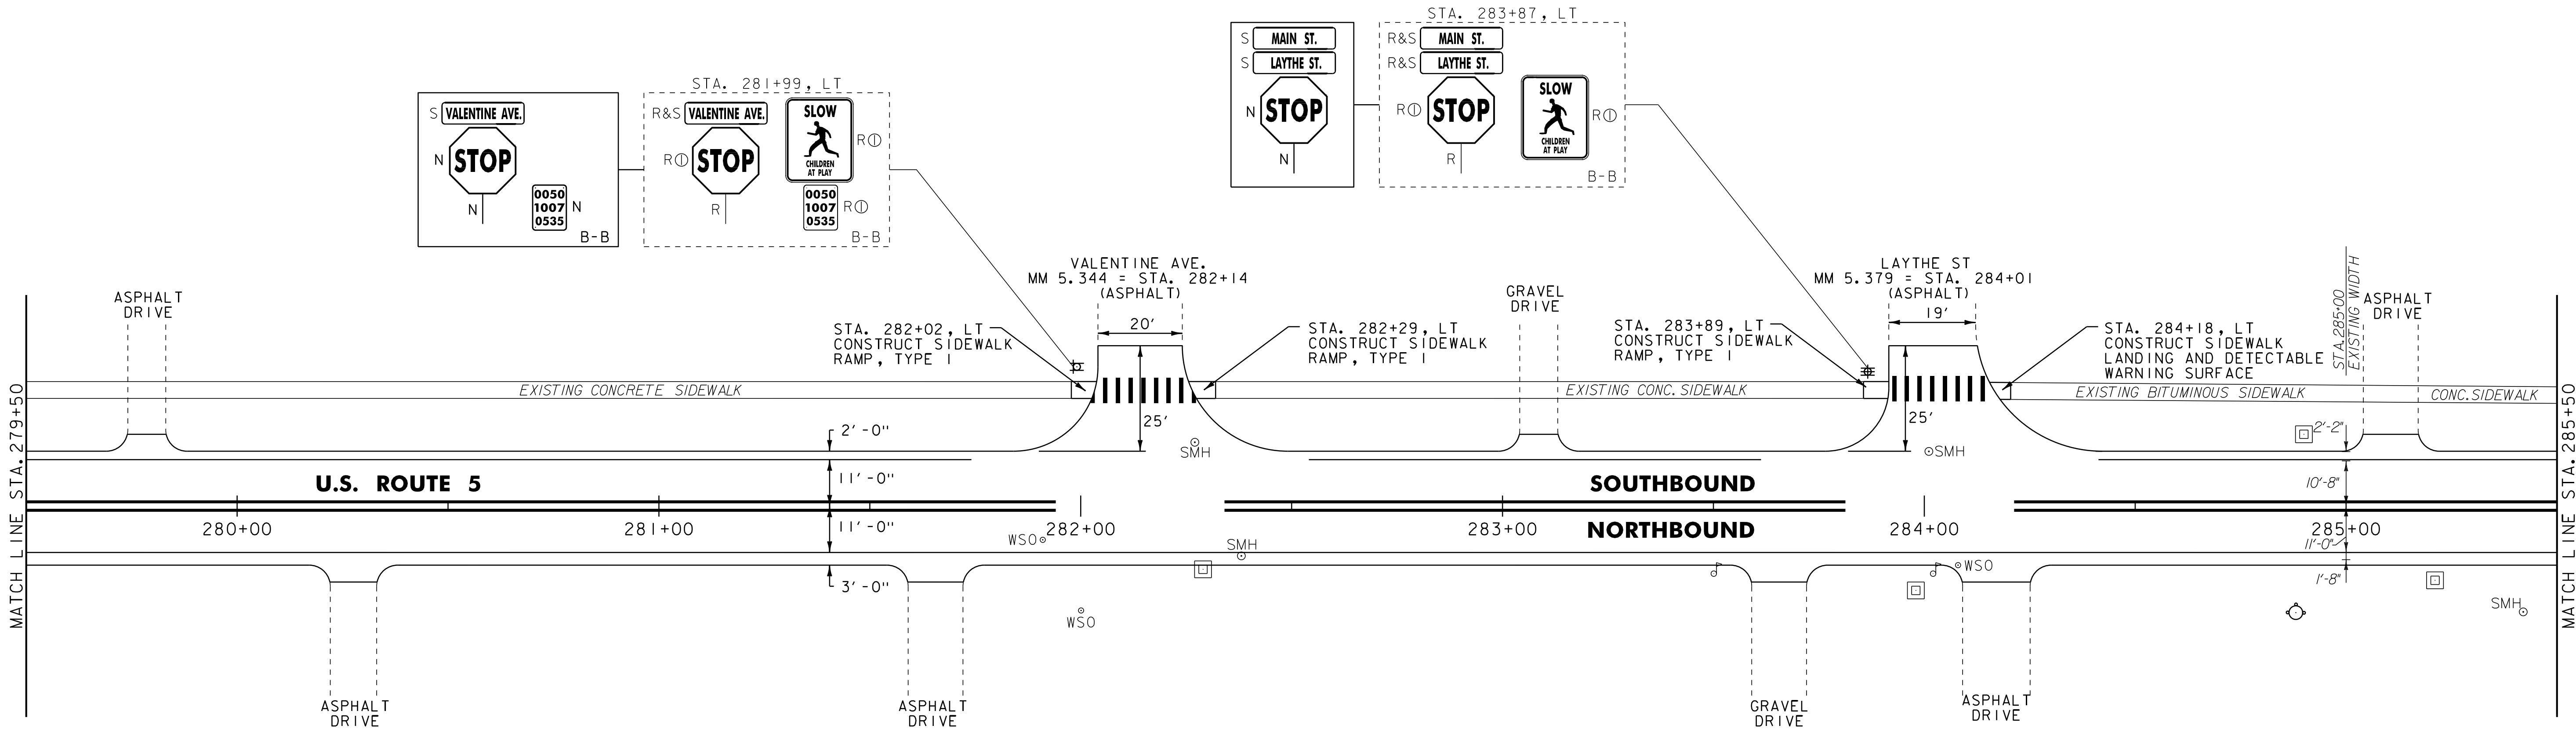

NOTE:

1. FOR LEGENDS, SEE LAYOUT SHEET #1.

2. ALL EXISTING SIGNS NOT SHOWN SHALL BE RETAINED.

NOT TO SCALE

PROJECT
LAYOUT
SHEET #3


PROJECT NAME: DERBY
PROJECT NUMBER: STP 2703(1)

FILE NAME: 07D202.dgn
PROJECT LEADER: JLL
DESIGNED BY: STANTEC
IPARM FILE: 07C194_36.i

PLOT DATE: 29-JAN-2013 09:2
DRAWN BY: STANTEC
CHECKED BY: JLL
SHEET 36 OF 62

646.602 TEMPORARY 4 INCH WHITE LINE, PAINT
STA. 285+50 TO 291+50, SOLID LT & RT

646.612 TEMPORARY 4 INCH YELLOW LINE, PAINT
STA. 285+50 TO 291+50, SOLID LT & RT

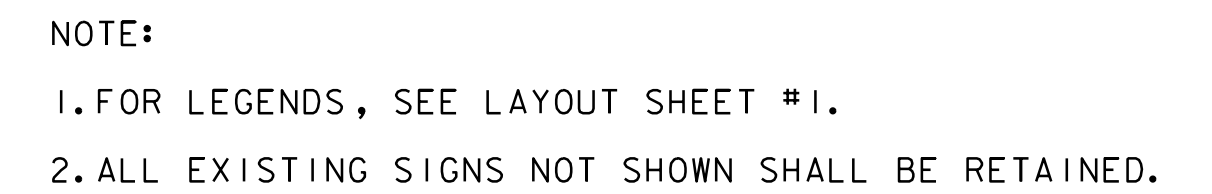

PROJECT LAYOUT SHEET #4

FILE NAME: 07D202.dgn
PROJECT LEADER: JLL
DESIGNED BY: STANTEC
IPARM FILE: 07CI94_37.i

PLOT DATE: 29-JAN-2013 09:2
DRAWN BY: STANTEC
CHECKED BY: JLL
SHEET 37 OF 62

604.412, 604.415 OR 604.418 REHAB,
Dis, CBs OR MHS, CLASS I, II OR III
STA. 292+59, LT
STA. 293+25, RT
~~STA. 295+09, LT~~ ELIMINATED - FILLED WITH FLOWABLE FILL

604.42 CHANGING ELEVATION OF SEWER MANHOLES
STA. 292+37, LT
STA. 295+03, RT
STA. 295+33, LT

618.10 PORTLAND CEMENT CONCRETE SIDEWALK, 5 INCH
STA. 294+92, RT
STA. 295+18, RT
STA. 295+19, LT
STA. 295+21, RT
STA. 295+64, LT

618.30 DETECTABLE WARNING SURFACE
STA. 294+92, RT
STA. 295+18, RT
STA. 295+19, LT
STA. 295+21, RT
STA. 295+64, LT

629.20 ADJUST ELEVATION OF VALVE BOX
STA. 295+04, RT
STA. 295+09, RT
STA. 295+11, RT
~~STA. 296+40, LT~~ ELIMINATED BY TOWN OF DERBY LINE

646.402 DURABLE 4 INCH WHITE LINE, THERMOPLASTIC
STA. 291+50 TO 297+50, SOLID LT & RT
STA. 295+34, LT (BEACH STREET EDGELINES)

646.412 DURABLE 4 INCH YELLOW LINE, THERMOPLASTIC
(ALL LINES WILL INCLUDE C BREAKS FOR SIDE ROADS)
STA. 291+50 TO 297+50, SOLID LT & RT
STA. 295+34, DOUBLE SOLID LT (BEACH ST. CENTERLINE.)

646.482 DURABLE 24 INCH STOP BAR, THERMOPLASTIC
STA. 295+28, LT (BEACH ST.)

646.492 DURABLE LETTER OR SYMBOL, THERMOPLASTIC
STA. 295+28, LT - "STOP"

646.502 DURABLE CROSSWALK MARKING, THERMOPLASTIC
STA. 294+95 TO 295+15, RT
STA. 295+19 LT - RT
STA. 295+20 TO 295+56, LT

646.602 TEMPORARY 4 INCH WHITE LINE, PAINT
STA. 291+50 TO 297+50, SOLID LT & RT
STA. 295+34, LT (BEACH STREET EDGELINES)


646.612 TEMPORARY 4 INCH YELLOW LINE, PAINT
(ALL LINES WILL INCLUDE C BREAKS FOR SIDE ROADS)
STA. 291+50 TO 297+50, SOLID LT & RT
STA. 295+34, DOUBLE SOLID LT (BEACH ST CENTERLINE.)

646.682 TEMPORARY 24 INCH STOP BAR, PAINT
STA. 295+28, LT (BEACH ST.)

646.692 TEMPORARY LETTER OR SYMBOL, PAINT
STA. 295+28, LT - "STOP"

646.702 TEMPORARY CROSSWALK MARKING, PAINT
STA. 294+95 TO 295+15, RT
STA. 295+19 LT - RT
STA. 295+20 TO 295+56, LT

675.50 REMOVING SIGNS
AS SHOWN - I

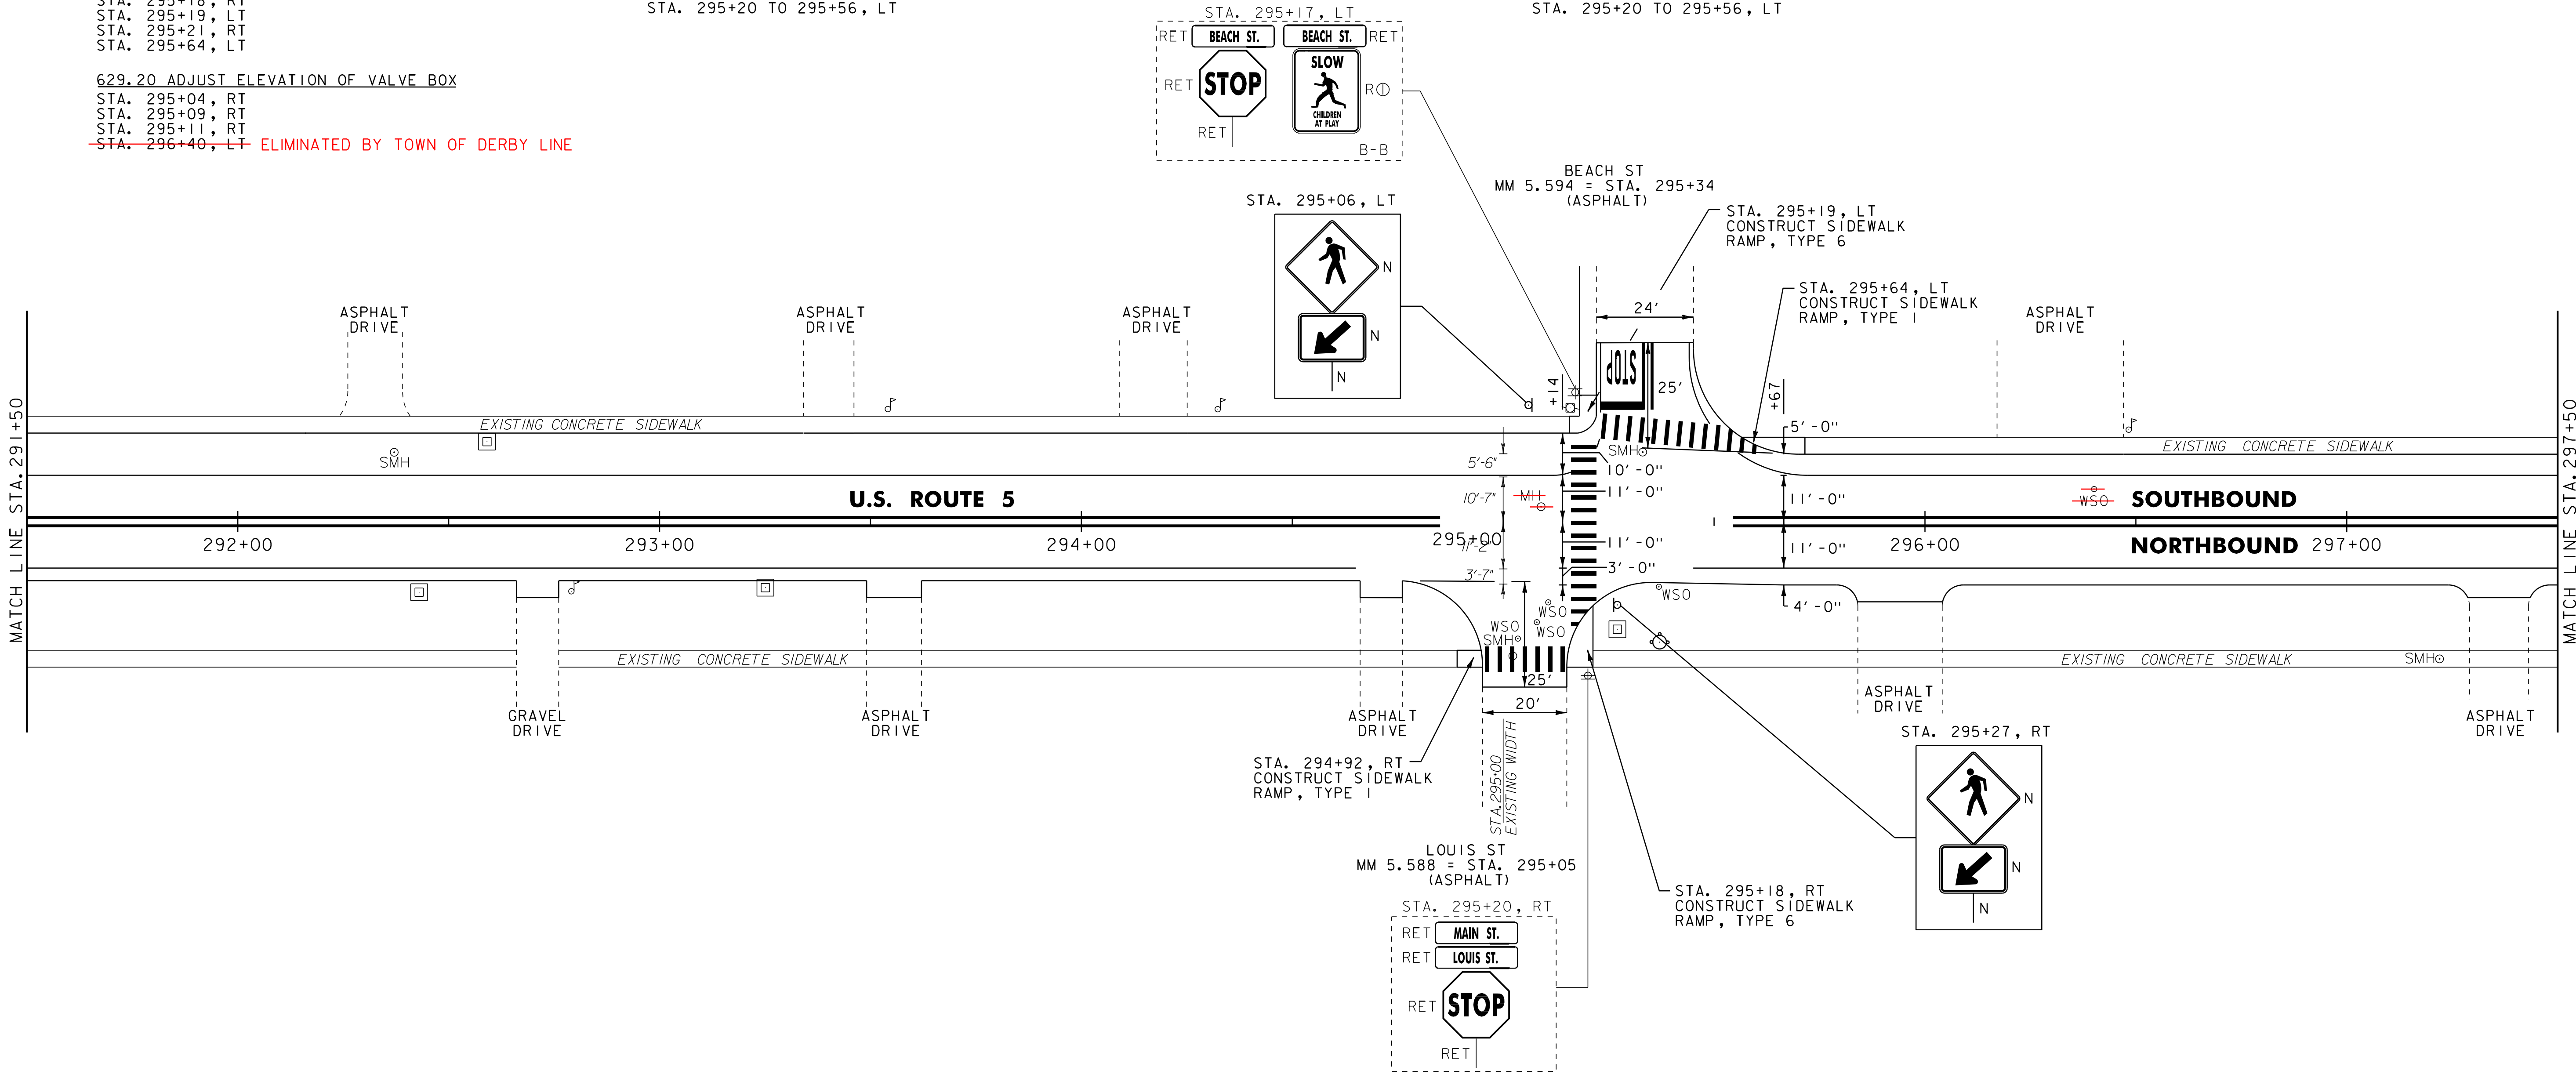

NOTE:
1. FOR LEGENDS, SEE LAYOUT SHEET #1.
2. ALL EXISTING SIGNS NOT SHOWN SHALL BE RETAINED.

NOT TO SCALE

PROJECT
LAYOUT
SHEET #5

PROJECT NAME: DERBY
PROJECT NUMBER: STP 2703(I)

FILE NAME: 070202.dgn
PROJECT LEADER: JLL
DESIGNED BY: STANTEC
IPARM FILE: 07C194_38.i

PLOT DATE: 29-JAN-2013 09:2
DRAWN BY: STANTEC
CHECKED BY: JLL
SHEET 38 OF 62

604.412, 604.415 OR 604.418 REHAB.
DIS, CBS OR MHS, CLASS I, II OR III
STA. 302+19, RT
STA. 303+34, RT

604.42 CHANGING ELEVATION OF SEWER MANHOLES
STA. 298+31, LT
STA. 301+35, LT

618.10 PORTLAND CEMENT CONCRETE SIDEWALK, 5 INCH
STA. 301+21, RT
STA. 301+25, LT
STA. 302+07, LT

618.30 DETECTABLE WARNING SURFACE
STA. 301+21, RT
STA. 301+25, LT
STA. 302+07, LT

646.402 DURABLE 4 INCH WHITE LINE, THERMOPLASTIC
(ALL LINES WILL INCLUDE EDGE LINE BREAKS AND
RADIi FOR SIDE ROADS)
STA. 297+50 TO 303+50, SOLID LT & RT
STA. 301+89, LT (ELM STREET EDGE LINES)

646.412 DURABLE 4 INCH YELLOW LINE, THERMOPLASTIC
(ALL LINES WILL INCLUDE & BREAKS FOR SIDE ROADS)
STA. 297+50 TO 303+50, SOLID LT & RT
STA. 301+89, DOUBLE SOLID LT (ELM ST. CENTERLINE)

646.482 DURABLE 24 INCH STOP BAR, THERMOPLASTIC
STA. 301+42, LT (ELM ST.)
STA. 301+80, LT (ELM ST.)

646.492 DURABLE LETTER OR SYMBOL, THERMOPLASTIC
STA. 301+44, LT - "STOP"
STA. 301+58, LT - YIELD LINE
STA. 301+76, LT - "STOP"

646.502 DURABLE CROSSWALK MARKING, THERMOPLASTIC
STA. 301+21, LT - RT
STA. 301+26 TO 302+07, LT

646.602 TEMPORARY 4 INCH WHITE LINE, PAINT
(ALL LINES WILL INCLUDE EDGE LINE BREAKS AND
RADIi FOR SIDE ROADS)
STA. 297+50 TO 303+50, SOLID LT & RT
STA. 301+89, LT (ELM STREET EDGE LINES)


646.612 TEMPORARY 4 INCH YELLOW LINE, PAINT
(ALL LINES WILL INCLUDE & BREAKS FOR SIDE ROADS)
STA. 297+50 TO 303+50, SOLID LT & RT
STA. 301+89, DOUBLE SOLID LT (ELM ST. CENTERLINE)

646.682 TEMPORARY 24 INCH STOP BAR, PAINT
STA. 301+42, LT (ELM ST.)
STA. 301+80, LT (ELM ST.)

646.692 TEMPORARY LETTER OR SYMBOL, PAINT
STA. 301+44, LT - "STOP"
STA. 301+58, LT - YIELD LINE
STA. 301+76, LT - "STOP"

646.702 TEMPORARY CROSSWALK MARKING, PAINT
STA. 301+21, LT - RT
STA. 301+26 TO 302+07, LT

675.50 REMOVING SIGNS
AS SHOWN - I

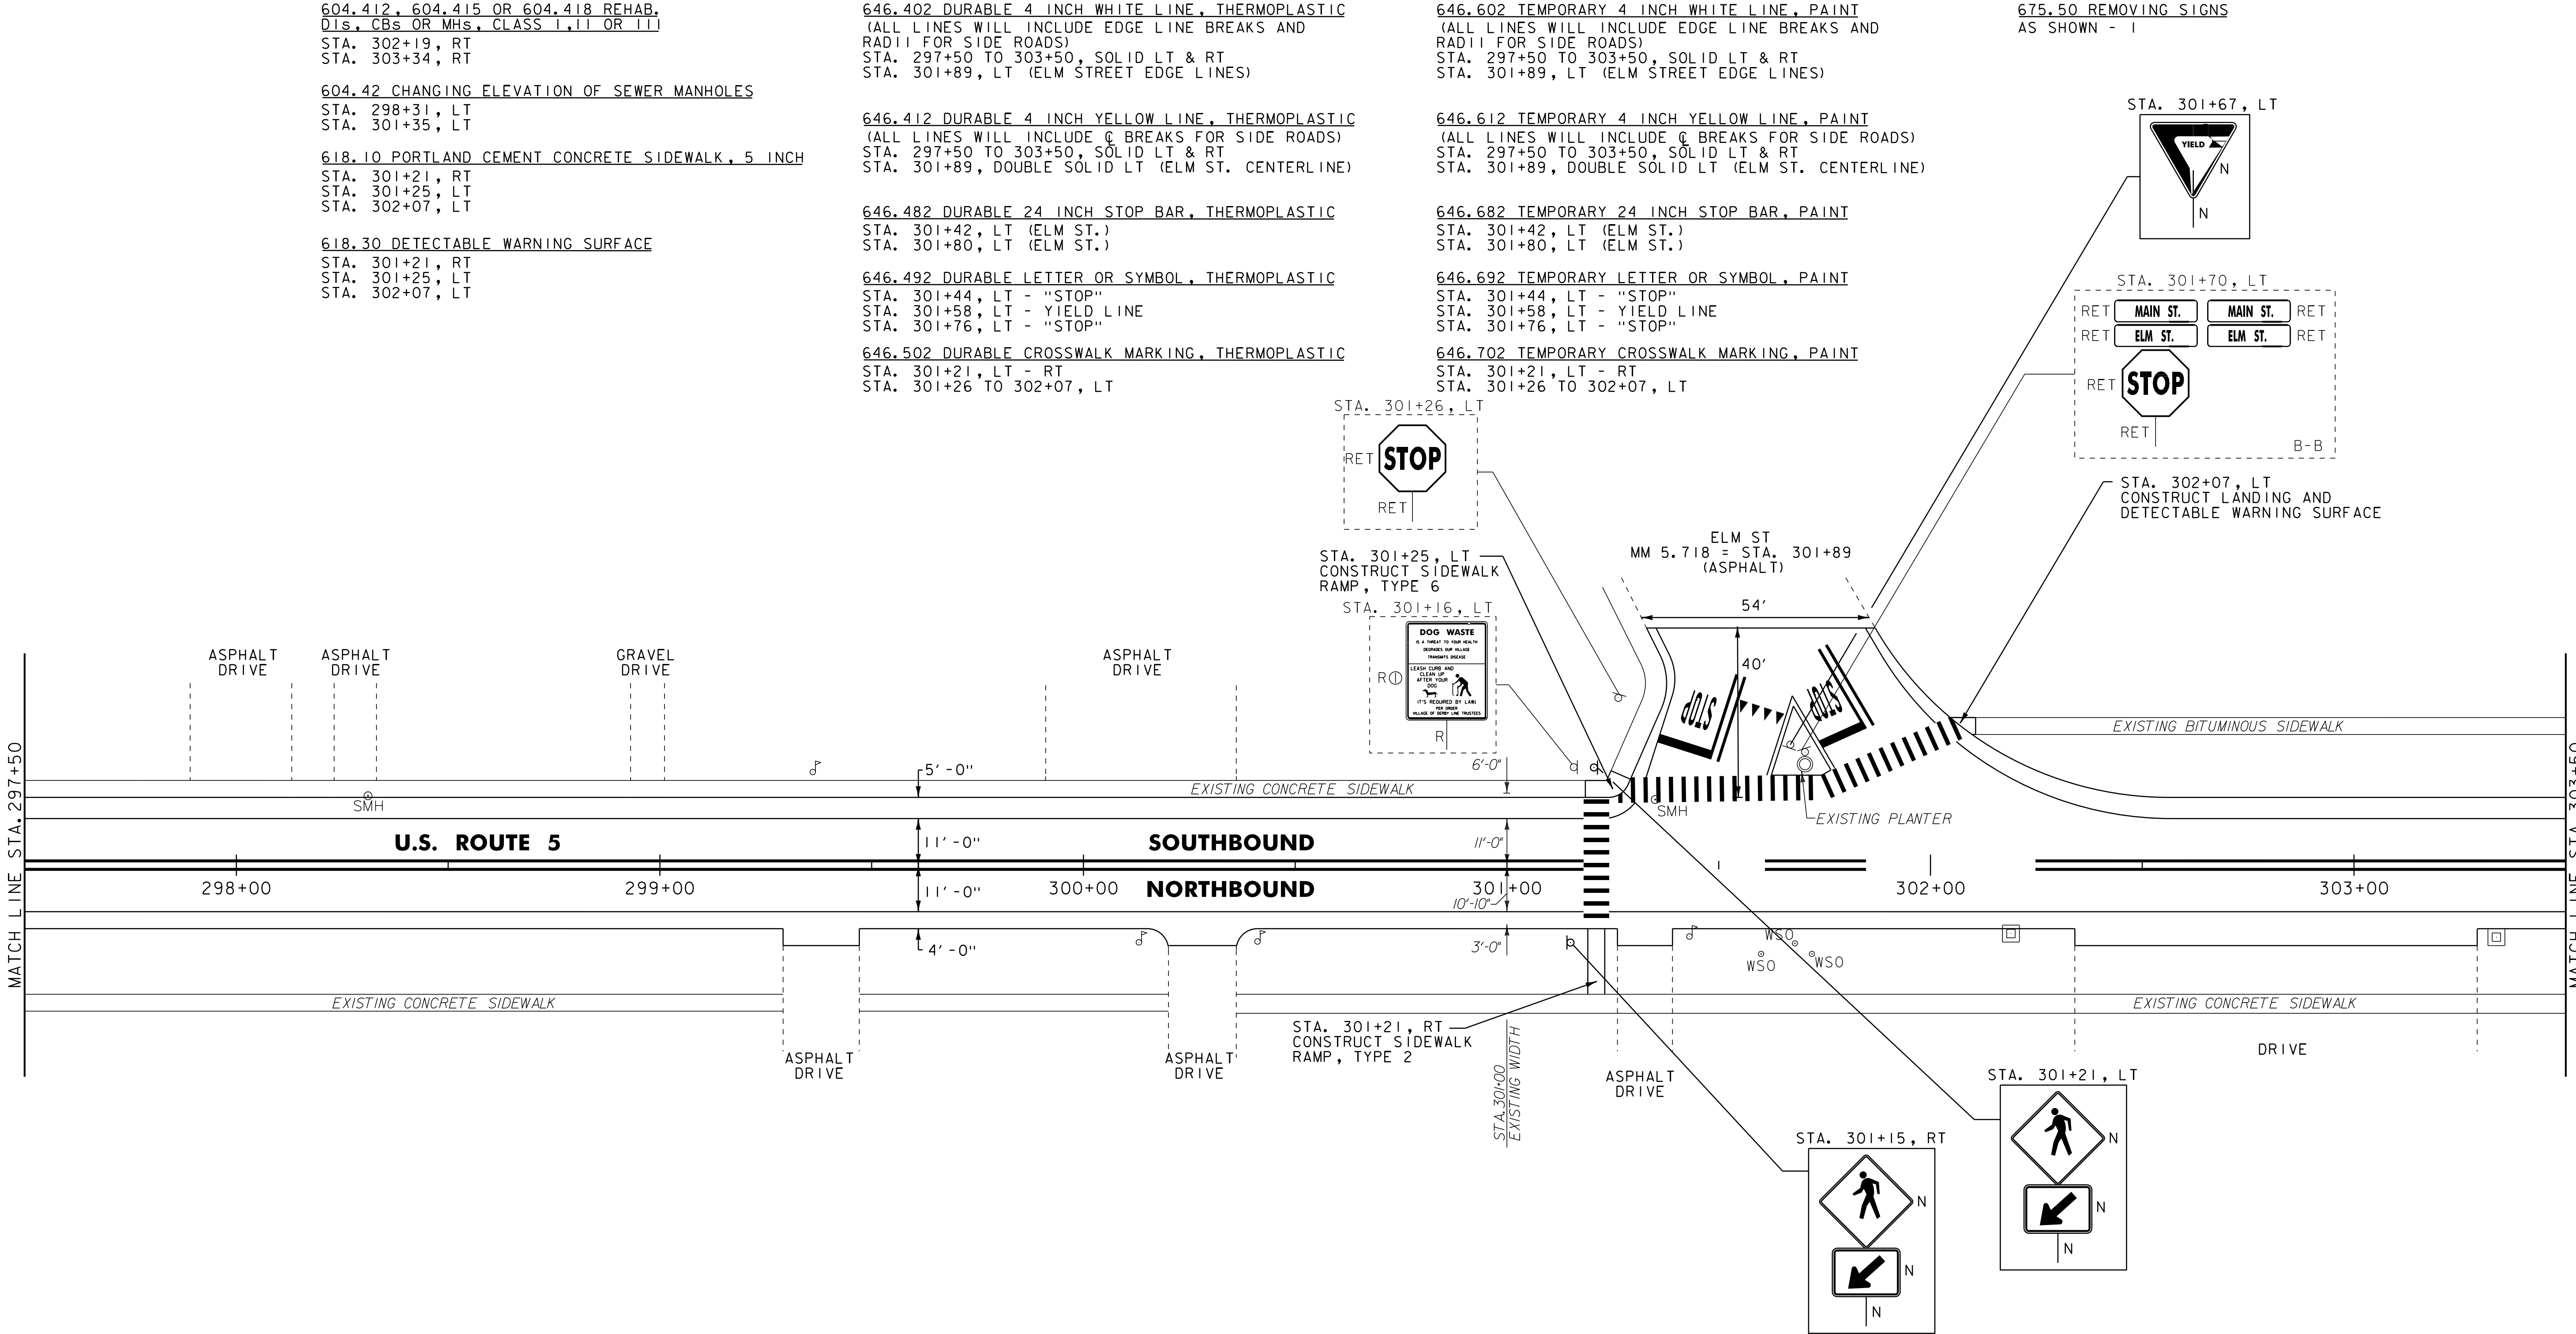

NOTE:
1. FOR LEGENDS, SEE LAYOUT SHEET #1.
2. ALL EXISTING SIGNS NOT SHOWN SHALL BE RETAINED.
3. SEE THE PAVEMENT MARKING DETAIL SHEET FOR THE YIELD LINE DETAIL.

NOT TO SCALE

PROJECT
LAYOUT
SHEET #6

PROJECT NAME: DERBY
PROJECT NUMBER: STP 2703(I)

FILE NAME: 070202.dgn
PROJECT LEADER: JLL
DESIGNED BY: STANTEC
IPARM FILE: 07C194_39.i

PLOT DATE: 29-JAN-2013 09:2
DRAWN BY: STANTEC
CHECKED BY: JLL
SHEET 39 OF 62

STA. 306+26, LT
STA. 306+54, RT
STA. 307+17, LT
STA. 307+63, RT
STA. 308+67, LT
STA. 308+91, RT
STA. 309+41, LT

STA. 305+87, LT
STA. 306+06, RT
STA. 307+96, LT
STA. 307+97, RT
STA. 306+15, LT

STA. 305+95, RT
STA. 307+78, RT

STA. 305+95, RT
STA. 307+78, RT

STA. 304+72, LT
STA. 305+50, LT
STA. 305+95, RT
STA. 307+74, LT
STA. 307+78, RT

STA. 304+72, LT
STA. 305+50, LT
STA. 305+95, RT
STA. 307+74, LT
STA. 307+78, RT

STA. 307+54, RT
STA. 307+67, RT
STA. 307+69, RT
~~STA. 308+68, RT~~
STA. 308+96, RT

646.412 DURABLE 4 INCH YELLOW LINE, THERMOPLASTIC
(ALL LINES WILL INCLUDE @ BREAKS FOR SIDE ROADS)
STA. 303+50 TO 309+50, SOLID LT & RT
STA. 305+30, DOUBLE SOLID LT (BAXTER AVE. CENTERLINE

646.492 DURABLE LETTER OR SYMBOL, THERMOPLASTIC
STA. 304+97, LT - "STOP"

STA. 304+72 TO 305+45, LT
STA. 305+50, LT TO 305+89, RT
STA. 307+71, LT TO 307+78, RT
STA. 307+81 TO 309+50, LT

646.612 TEMPORARY 4 INCH YELLOW LINE, PAINT
(ALL LINES WILL INCLUDE 4' BREAKS FOR SIDE ROADS)
STA. 303+50 TO 309+50, SOLID LT & RT
E) STA. 305+30, DOUBLE SOLID LT (BAXTER AVE. CENTER

646.692 TEMPORARY LETTER OR SYMBOL, PAINT
STA. 304+97, LT - "STOP"


STA. 304+72 TO 305+45, LT
STA. 305+50, LT TO 305+89, RT
STA. 307+71, LT TO 307+78, RT
STA. 307+81 TO 309+50, LT
STA. 307+79, LT

STA. 309+50, LT

VEHICLES ENTERING FROM CANADA
REPORT FOR INSPECTION
ARRÊTER POUR L'INSPECTION

RET

The diagram shows two stop signs. The top stop sign is a standard octagonal stop sign with the text "STOP" in large letters, followed by "REPORT FOR INSPECTION" in smaller letters. The bottom stop sign is a rectangular sign with the text "STOP FOR INSPECTION" at the top, a large black arrow pointing to the right in the middle, and "ARRETEZ POUR INSPECTION" at the bottom.

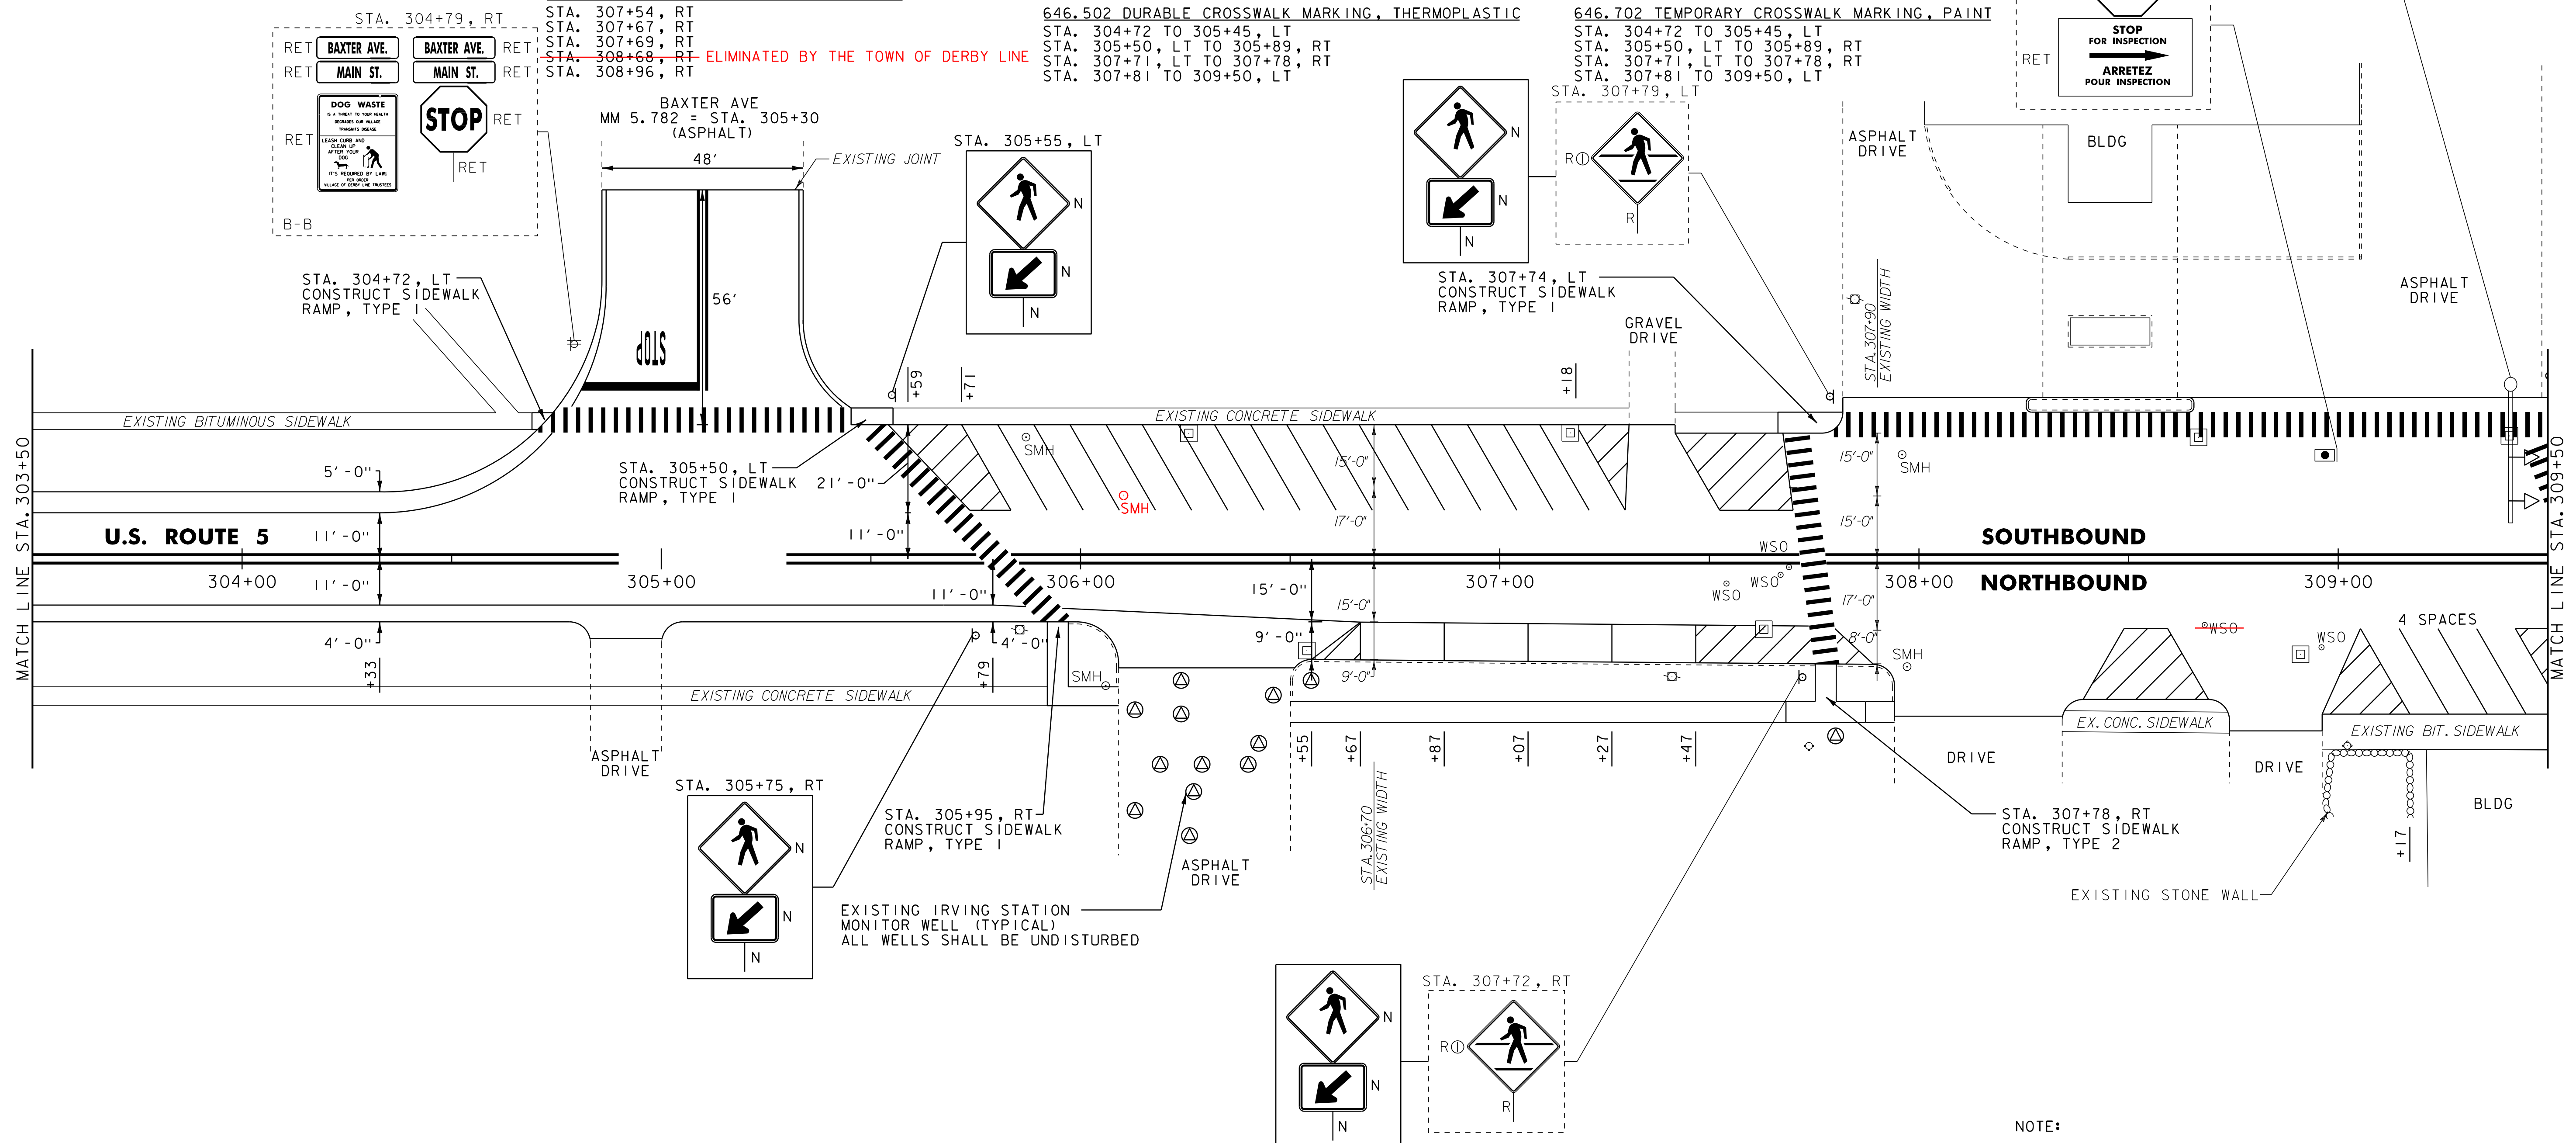

1. FOR LEGENDS, SEE LAYOUT SHEET #1.
2. ALL EXISTING SIGNS NOT SHOWN SHALL BE RETAINED.
3. SEE THE PAVEMENT MARKING DETAIL SHEET FOR THE ANGLED PARKING STALL DETAILS.

PROJECT LAYOUT SHEET #7

FILE NAME: 07CI94.dgn
PROJECT LEADER: JLL
DESIGNED BY: STANTEC
IPARM FILE: 07CI94_40.i

PLOT DATE: 29-JAN-2013 09:2
DRAWN BY: STANTEC
CHECKED BY: JLL
SHEET 40 OF 62

U. S. ROUTE 5 STA. 310+09, RT
U. S. ROUTE 5 STA. 311+09, LT
U. S. ALT ROUTE 5 STA. 0+47, CL
U. S. ALT ROUTE 5 STA. 0+58, RT
U. S. ALT ROUTE 5 STA. 0+64, RT
U. S. ALT ROUTE 5 STA. 0+70, LT
U. S. ALT ROUTE 5 STA. 1+20, RT
U.S. ROUTE 5 STA. 313+17 RT

U.S. ROUTE 5 STA. 311+19, LT	ROUTE 5 STA. 311+35 LT
U.S. ROUTE 5 STA. 313+05, LT	ROUTE 5 STA. 311+80 LT
U.S. ALT ROUTE 5 STA. 0+49, RT	ROUTE 5 STA. 310+30 LT

616.41 REMOVAL OF EXISTING CURB
U.S. ALT ROUTE 5 STA 0+85 BT

U.S. ROUTE 5 STA. 309+72, RT
U.S. ROUTE 5 STA. 309+78, LT
U.S. ALT ROUTE 5 STA. 0+85, RT
U.S. ALT ROUTE 5 STA. 0+85, LT

~~U.S. ROUTE 5 STA. 309+78, LT~~
~~U.S. ALT ROUTE 5 STA. 0+85, RT~~ } ELIMINATED BY THE VILLAGE
~~U.S. ALT ROUTE 5 STA. 0+85, LT~~ } OF DERBY LINE

U.S. ALT. ROUTE 5 STA. 0+60 TO 1+50 LT

(ALL LINES WILL INCLUDE 6" BREAKS FOR SIDE ROADS)
U.S. ROUTE 5 STA. 309+50 TO 313+31.52, SOLID LT & RT
U.S. ALT. ROUTE 5 STA. 0+60 TO 1+50 LT & RT

U. S. ALT ROUTE 5 STA. 0+60, LT

```

U. S. ROUTE 5 STA. 309+64, LT - "ARROW"
U. S. ROUTE 5 STA. 310+22, LT - "CUSTOMS"
U. S. ROUTE 5 STA. 310+32, LT - "US"
U. S. ROUTE 5 STA. 310+97, LT - "ARROW"
U. S. ROUTE 5 STA. 311+54, LT - "CUSTOMS"
U. S. ROUTE 5 STA. 311+64, LT - "US"
U. S. ROUTE 5 STA. 311+76, LT - "TO"
U. S. ROUTE 5 STA. 311+85, LT - "REPORT"
U. S. ROUTE 5 STA. 312+19, LT - "AHEAD"
U. S. ROUTE 5 STA. 312+30, LT - "STOP"
U. S. ROUTE 5 STA. 312+62, LT - "CUSTOMS"
U. S. ROUTE 5 STA. 312+72, LT - "US"
U. S. ROUTE 5 STA. 312+83, LT - "TO"
U. S. ROUTE 5 STA. 312+93, LT - "REPORT"
U. S. ALT. ROUTE 5 STA. 0+70, LT - "STOP"

```

~~U.S. ROUTE 5 STA. 309+50 TO 309+75, LT~~
~~U.S. ALT ROUTE 5 STA. 0+54 TO 0+74, RT~~
~~U.S. ALT ROUTE 5 STA. 0+85, LT - RT~~ } ELIMINATED BY
 VILLAGE OF DERBY
 LINE

S.S. RET. ROUTE 5 STA. 0+00 TO 1+50 ET

U.S. ALT. ROUTE 5 STA. 0+60 TO 1+50 LT & RT


646.692 TEMPORARY LETTER OR SYMBOL, PAINT

U. S.	ROUTE	5	STA.	310+22,	LT -	"CUSTOMS"
U. S.	ROUTE	5	STA.	310+32, LT -	"US"	
U. S.	ROUTE	5	STA.	310+97, LT -	ARROW	
U. S.	ROUTE	5	STA.	311+54, LT -	"CUSTOMS"	
U. S.	ROUTE	5	STA.	311+64, LT -	"US"	
U. S.	ROUTE	5	STA.	311+76, LT -	"TO"	
U. S.	ROUTE	5	STA.	311+85, LT -	"REPORT"	
U. S.	ROUTE	5	STA.	312+19, LT -	"AHEAD"	
U. S.	ROUTE	5	STA.	312+30, LT -	"STOP"	
U. S.	ROUTE	5	STA.	312+62, LT -	"CUSTOMS"	
U. S.	ROUTE	5	STA.	312+72, LT -	"US"	
U. S.	ROUTE	5	STA.	312+83, LT -	"TO"	
U. S.	ROUTE	5	STA.	312+93, LT -	"REPORT"	
U. S.	ALT. ROUTE	5	STA.	0+70, LT -	"STOP"	

U.S. ALT ROUTE 5 STA. 0+54 TO 0+74, RT
U.S. ALT ROUTE 5 STA. 0+85 LT - RT

AS SHOWN - 4

AS SHOWN - I

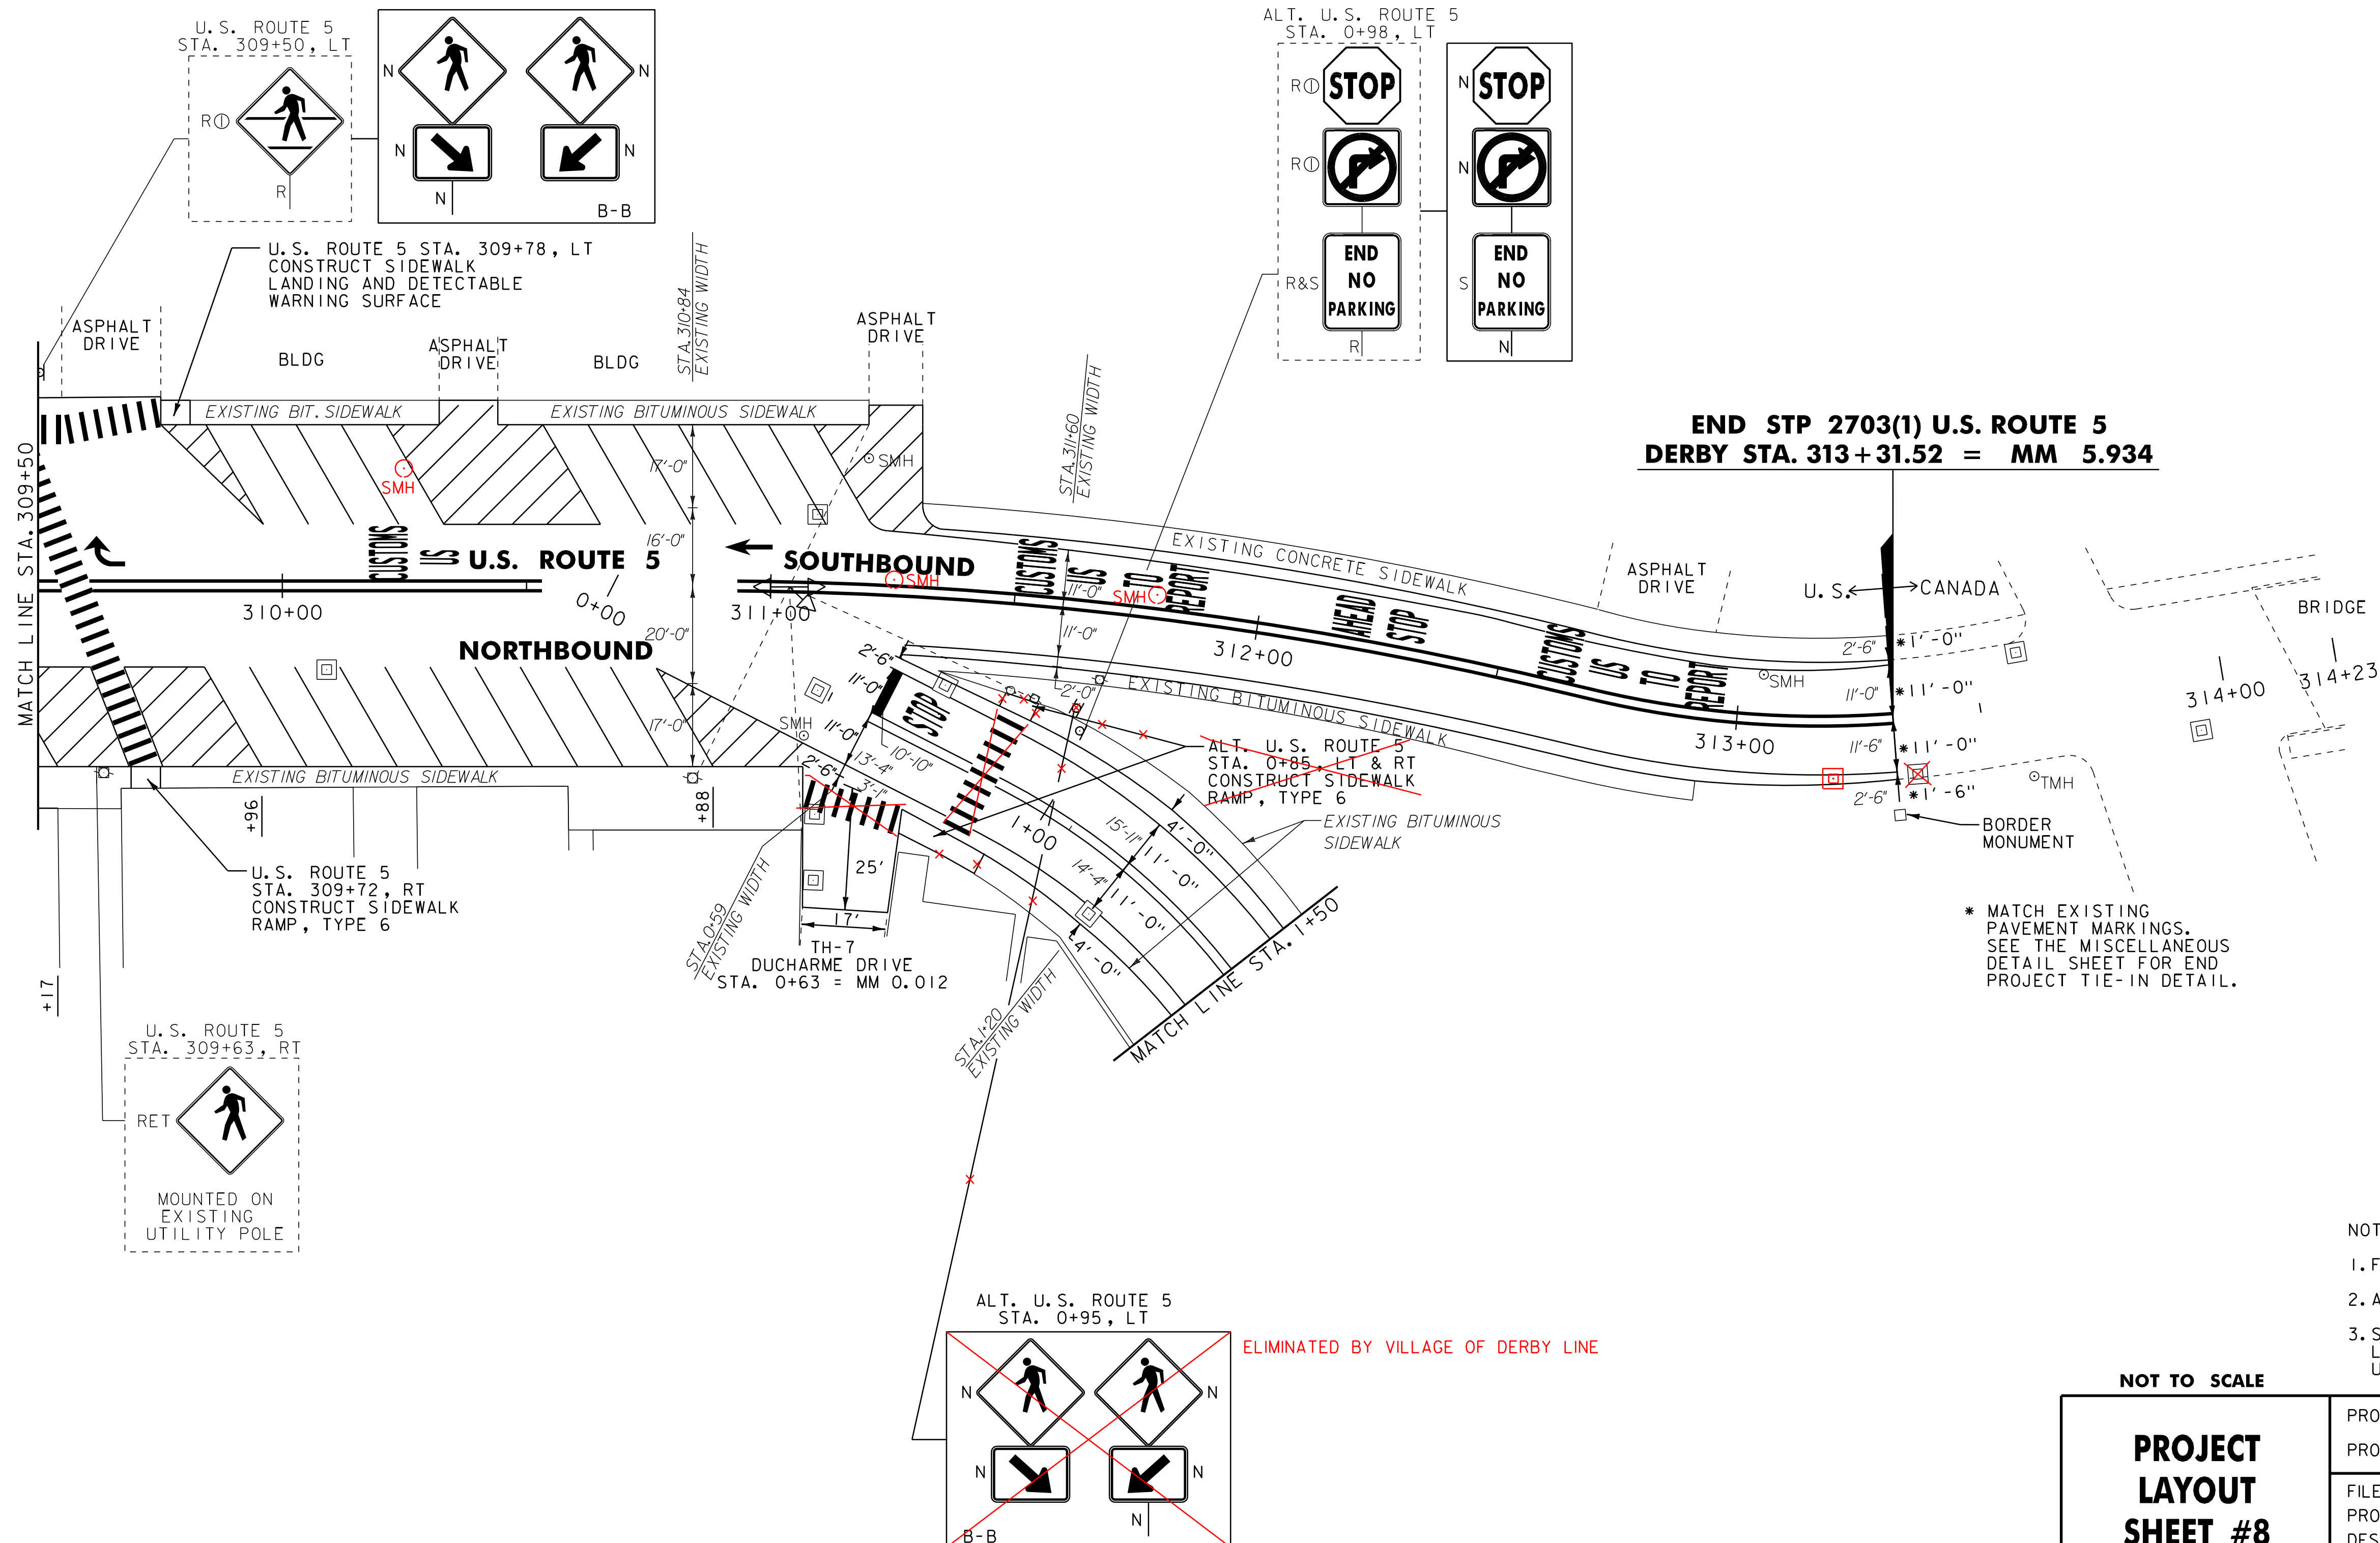

3. SEE THE PAVEMENT MARKING DETAIL SHEET FOR THE LETTER AND SYMBOL LAYOUT FOR THE APPROACH TO U.S. CUSTOMS, AND THE ANGLED PARKING DETAILS.

PROJECT LAYOUT SHEET #8

DESIGNED BY: STAN

CHECKED BY: JLL

604.412, 604.415 OR 604.418 REHAB.
DIS, CBS OR MHS, CLASS 1,11 OR 111

STA. 3+64, LT
STA. 3+83, RT
STA. 4+86, LT
STA. 7+02, RT
STA. 7+11, LT

604.42 CHANGING ELEVATION OF SEWER MANHOLES

STA. 1+54, CL
STA. 2+15, CL
STA. 3+69, RT
STA. 3+78, LT
STA. 4+01, RT
~~STA. 5+42, RT ELIMINATED BY TOWN OF DERBY LINE~~

618.10 PORTLAND CEMENT CONCRETE SIDEWALK, 5 INCH

STA. 1+88, LT
STA. 1+89, RT
STA. 2+47, RT
STA. 2+91, RT
STA. 5+67, LT & RT

618.30 DETECTABLE WARNING SURFACE

STA. 1+88, LT
STA. 1+89, RT
STA. 2+47, RT
STA. 2+91, RT
STA. 5+67, LT & RT

629.20 ADJUST ELEVATION OF VALVE BOX

~~STA. 5+55, RT ELIMINATED BY TOWN OF DERBY LINE~~

646.402 DURABLE 4 INCH WHITE LINE, THERMOPLASTIC
(ALL LINES WILL INCLUDE EDGE LINE BREAKS AND
RADII FOR SIDE ROADS)
STA. 1+50 TO 7+50, SOLID LT & RT
STA. 4+17, LT (CHURCH STREET EDGELINES)

646.412 DURABLE 4 INCH YELLOW LINE, THERMOPLASTIC
(ALL LINES WILL INCLUDE @ BREAKS FOR SIDE ROADS)
STA. 1+50 TO 7+50, SOLID LT & RT
STA. 4+17, DOUBLE SOLID LT (CHURCH ST. CENTERLINE)

646.482 DURABLE 24 INCH STOP BAR, THERMOPLASTIC

STA. 4+18, LT (CHURCH ST.)
STA. 5+11, LT (CHURCH ST.)
STA. 5+23, LT (CHURCH ST.)

646.492 DURABLE LETTER OR SYMBOL, THERMOPLASTIC

STA. 4+25, LT - "STOP"
STA. 5+11, LT - "STOP"
STA. 5+26, LT - "STOP"

646.502 DURABLE CROSSWALK MARKING, THERMOPLASTIC

STA. 1+89, LT - RT
STA. 2+49 TO 2+88, RT
STA. 4+52 TO 5+34, LT
STA. 5+67, LT - RT

646.602 TEMPORARY 4 INCH WHITE LINE, PAINT
(ALL LINES WILL INCLUDE EDGE LINE BREAKS AND
RADII FOR SIDE ROADS)
STA. 1+50 TO 7+50, SOLID LT & RT
STA. 4+17, LT (CHURCH STREET EDGELINES)

646.612 TEMPORARY 4 INCH YELLOW LINE, PAINT
(ALL LINES WILL INCLUDE @ BREAKS FOR SIDE ROADS)
STA. 1+50 TO 7+50, SOLID LT & RT
STA. 4+17, DOUBLE SOLID LT (CHURCH ST. CENTERLINE)

646.682 TEMPORARY 24 INCH STOP BAR, PAINT

STA. 4+18, LT (CHURCH ST.)
STA. 5+11, LT (CHURCH ST.)
STA. 5+23, LT (CHURCH ST.)

646.692 TEMPORARY LETTER OR SYMBOL, PAINT


STA. 4+25, LT - "STOP"
STA. 5+11, LT - "STOP"
STA. 5+26, LT - "STOP"

646.702 TEMPORARY CROSSWALK MARKING, PAINT

STA. 1+89, LT - RT
STA. 2+49 TO 2+88, RT
STA. 4+52 TO 5+34, LT
STA. 5+67, LT - RT

675.50 REMOVING SIGNS
AS SHOWN - 6

675.60 ERECTING SALVAGED SIGNS
AS SHOWN - 1

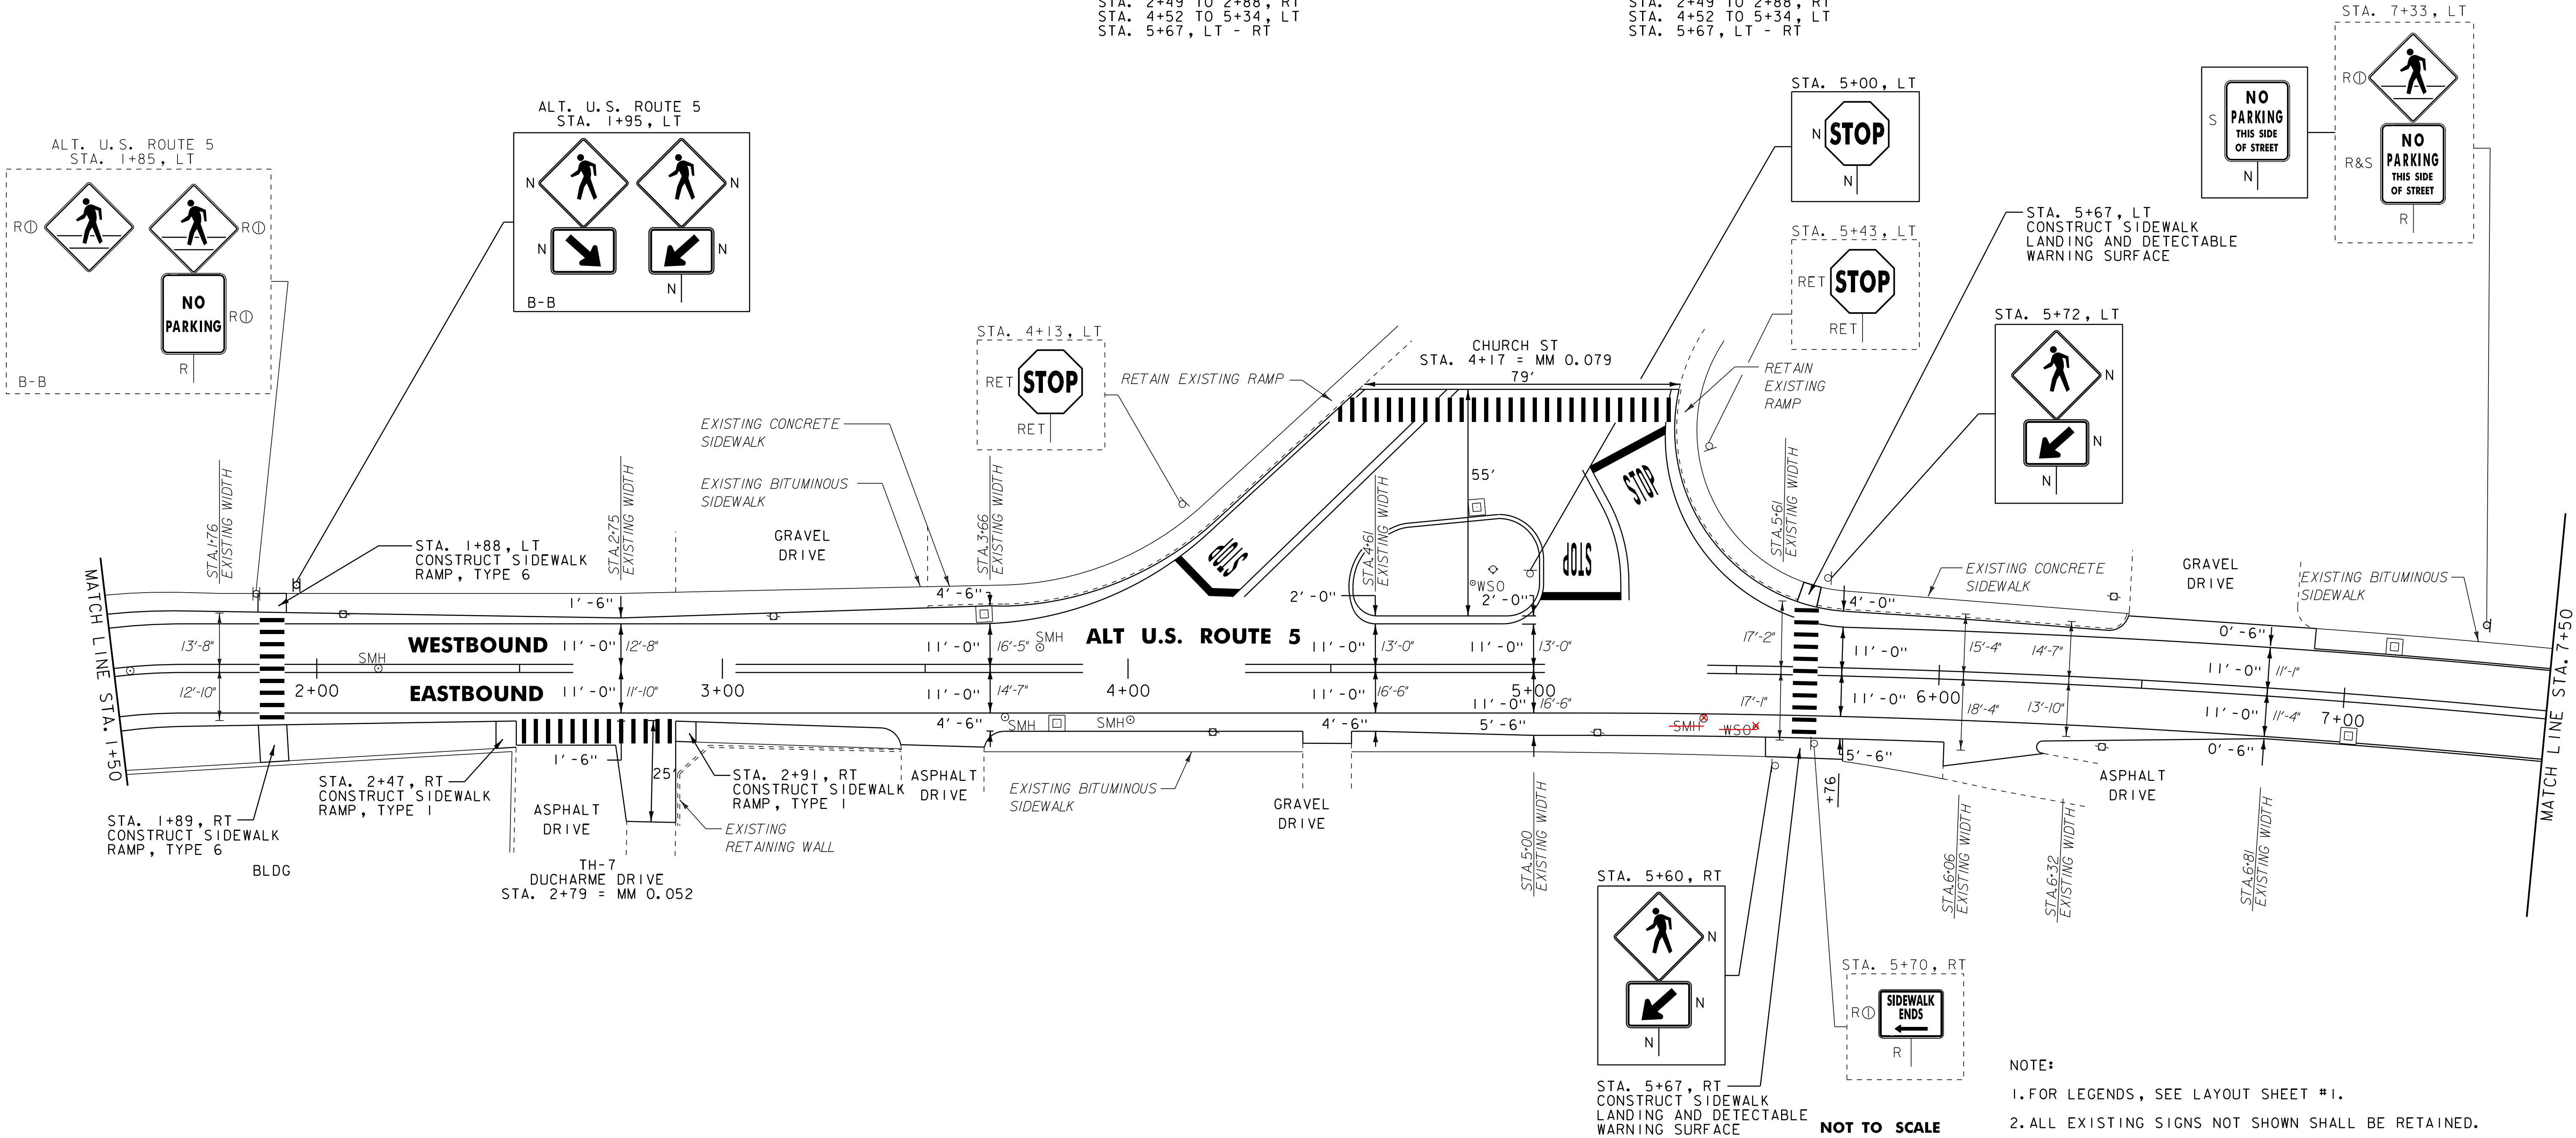

**PROJECT
LAYOUT
SHEET #9**

PROJECT NAME: DERBY
PROJECT NUMBER: STP 2703(1)

FILE NAME: 070202.dgn
PROJECT LEADER: JLL
DESIGNED BY: STANTEC
IPARM FILE: 07C194_42.i

PLOT DATE: 29-JAN-2013 09:2
DRAWN BY: STANTEC
CHECKED BY: JLL
SHEET 42 OF 62

604.412, 604.415 OR 604.418 REHAB.
DIS, CBS OR MHS, CLASS I, II OR III
STA. 8+72, RT
STA. 11+85, RT
STA. 12+27, RT

604.42 CHANGING ELEVATION OF SEWER MANHOLES
STA. 9+94, RT
STA. 11+87, RT

616.47 BITUMINOUS CONCRETE GUTTERS AND TRAFFIC ISLANDS
STA. 8+95 TO 9+74, LT
(SEE MISCELLANEOUS DETAIL SHEET)

618.10 PORTLAND CEMENT CONCRETE SIDEWALK, 5 INCH
STA. 8+87, LT
STA. 8+92, RT
STA. 11+90, RT
STA. 12+26, RT

618.30 DETECTABLE WARNING SURFACE
STA. 8+87, LT
STA. 8+92, RT
STA. 11+90, RT
STA. 12+26, RT

646.402 DURABLE 4 INCH WHITE LINE, THERMOPLASTIC
(ALL LINES WILL INCLUDE EDGE LINE BREAKS AND
RADI FOR SIDE ROADS)
STA. 7+50 TO 13+50, SOLID LT & RT

646.412 DURABLE 4 INCH YELLOW LINE, THERMOPLASTIC
(ALL LINES WILL INCLUDE C BREAKS FOR SIDE ROADS)
STA. 7+50 TO 13+50, SOLID LT & RT
STA. 12+00, DOUBLE SOLID RT (PELOW HILL CENTERLINE)

646.482 DURABLE 24 INCH STOP BAR, THERMOPLASTIC
STA. 12+17, RT (PELOW HILL)

646.492 DURABLE LETTER OR SYMBOL, THERMOPLASTIC
STA. 12+19, RT - "STOP"

646.502 DURABLE CROSSWALK MARKING, THERMOPLASTIC
STA. 8+87, LT TO 8+92, RT
STA 11+94 TO 12+22, RT

646.602 TEMPORARY 4 INCH WHITE LINE, PAINT
(ALL LINES WILL INCLUDE EDGE LINE BREAKS AND
RADI FOR SIDE ROADS)
STA. 7+50 TO 13+50, SOLID LT & RT

646.612 TEMPORARY 4 INCH YELLOW LINE, PAINT
(ALL LINES WILL INCLUDE C BREAKS FOR SIDE ROADS)
STA. 7+50 TO 13+50, SOLID LT & RT
STA. 12+00, DOUBLE SOLID RT (PELOW HILL CENTERLINE)


646.682 TEMPORARY 24 INCH STOP BAR, PAINT
STA. 12+17, RT (PELOW HILL)

646.692 TEMPORARY LETTER OR SYMBOL, PAINT
STA. 12+19, RT - "STOP"

646.702 TEMPORARY CROSSWALK MARKING, PAINT
STA. 8+87, LT TO 8+92, RT
STA 11+94 TO 12+22, RT

675.50 REMOVING SIGNS
AS SHOWN - 10

675.60 ERECTING SALVAGED SIGNS
AS SHOWN - 5

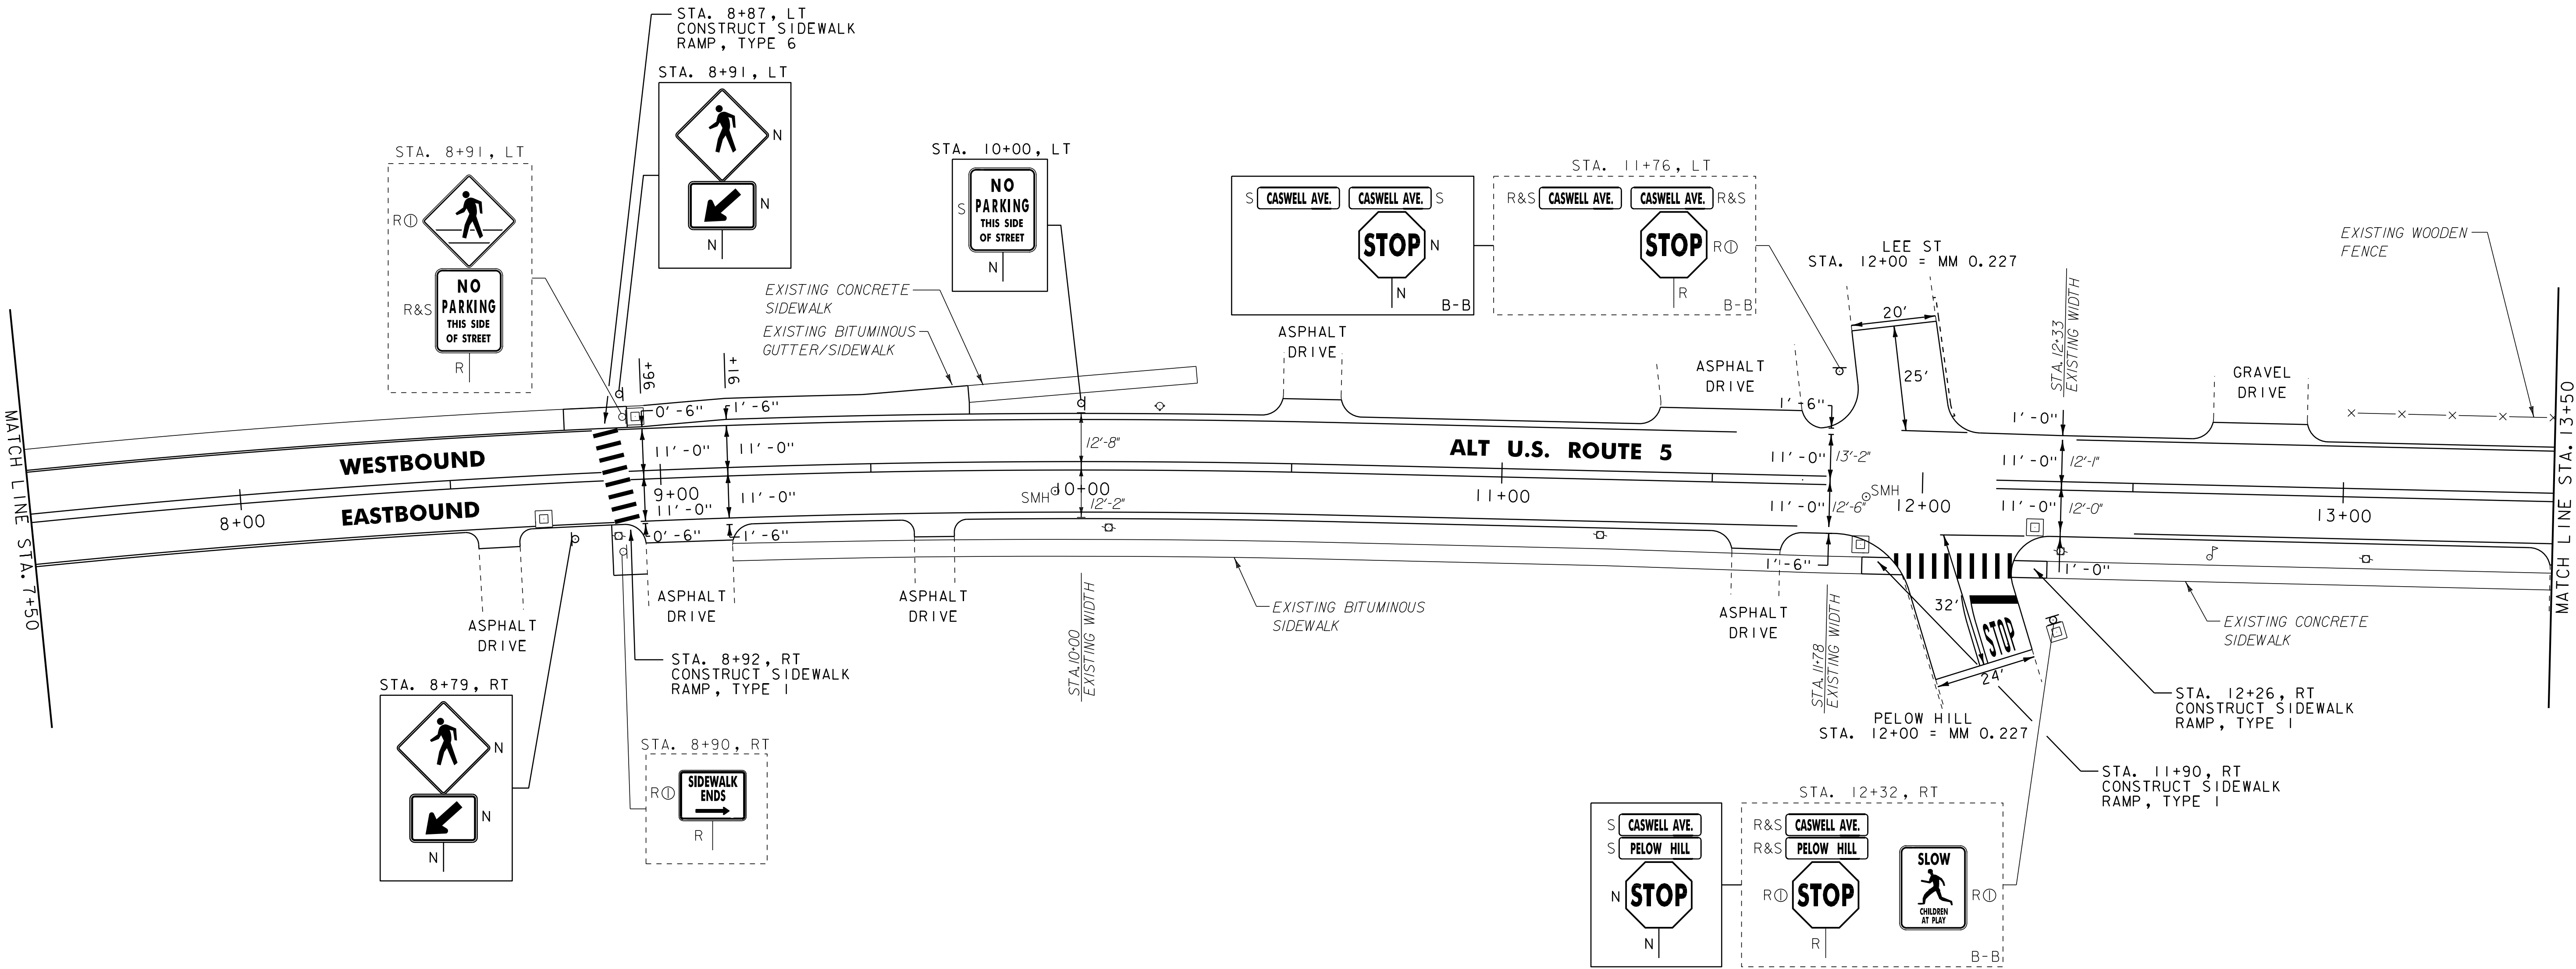

- NOTE:
1. FOR LEGENDS, SEE LAYOUT SHEET #1.
 2. ALL EXISTING SIGNS NOT SHOWN SHALL BE RETAINED.

NOT TO SCALE

PROJECT
LAYOUT
SHEET #10

PROJECT NAME: DERBY
PROJECT NUMBER: STP 2703(1)

FILE NAME: 07D202.dgn
PROJECT LEADER: JLL
DESIGNED BY: STANTEC
IPARM FILE: 07C194_43.i

PLOT DATE: 29-JAN-2013 09:2
DRAWN BY: STANTEC
CHECKED BY: JLL
SHEET 43 OF 62

604.412, 604.415 OR 604.418 REHAB.
DIS. CBS OR MHS, CLASS 1,11 OR 111

STA. 18+65, RT
STA. 18+81, RT
STA. 18+96, LT
STA. 19+19, RT

618.10 PORTLAND CEMENT CONCRETE SIDEWALK, 5 INCH

STA. 18+81, RT
STA. 19+07, RT

618.30 DETECTABLE WARNING SURFACE

STA. 18+81, RT
STA. 19+07, RT

646.402 DURABLE 4 INCH WHITE LINE, THERMOPLASTIC
(ALL LINES WILL INCLUDE EDGE LINE BREAKS AND
RADII FOR SIDE ROADS)

STA. 13+50 TO 19+50, SOLID LT & RT

646.412 DURABLE 4 INCH YELLOW LINE, THERMOPLASTIC

(ALL LINES WILL INCLUDE C BREAKS FOR SIDE ROADS)
STA. 13+50 TO 19+50, SOLID LT & RT
STA. 18+93, DOUBLE SOLID RT (HIGHLAND AVE. CENTERLINE)

646.482 DURABLE 24 INCH STOP BAR, THERMOPLASTIC

STA. 19+00, RT (HIGHLAND AVE.)

646.492 DURABLE LETTER OR SYMBOL, THERMOPLASTIC

STA. 19+00, RT - "STOP"

646.502 DURABLE CROSSWALK MARKING, THERMOPLASTIC

STA. 18+83 TO 19+05, RT

646.602 TEMPORARY 4 INCH WHITE LINE, PAINT

(ALL LINES WILL INCLUDE EDGE LINE BREAKS AND
RADII FOR SIDE ROADS)

STA. 13+50 TO 19+50, SOLID LT & RT

646.612 TEMPORARY 4 INCH YELLOW LINE, PAINT

(ALL LINES WILL INCLUDE C BREAKS FOR SIDE ROADS)
STA. 13+50 TO 19+50, SOLID LT & RT
STA. 18+93, DOUBLE SOLID RT (HIGHLAND AVE. CENTERLINE)

646.682 TEMPORARY 24 INCH STOP BAR, PAINT

STA. 19+00, RT (HIGHLAND AVE.)

646.692 TEMPORARY LETTER OR SYMBOL, PAINT

STA. 19+00, RT - "STOP"

646.702 TEMPORARY CROSSWALK MARKING, PAINT


STA. 18+83 TO 19+05, RT

675.50 REMOVING SIGNS

AS SHOWN - 4

675.60 ERECTING SALVAGED SIGNS

AS SHOWN - 2

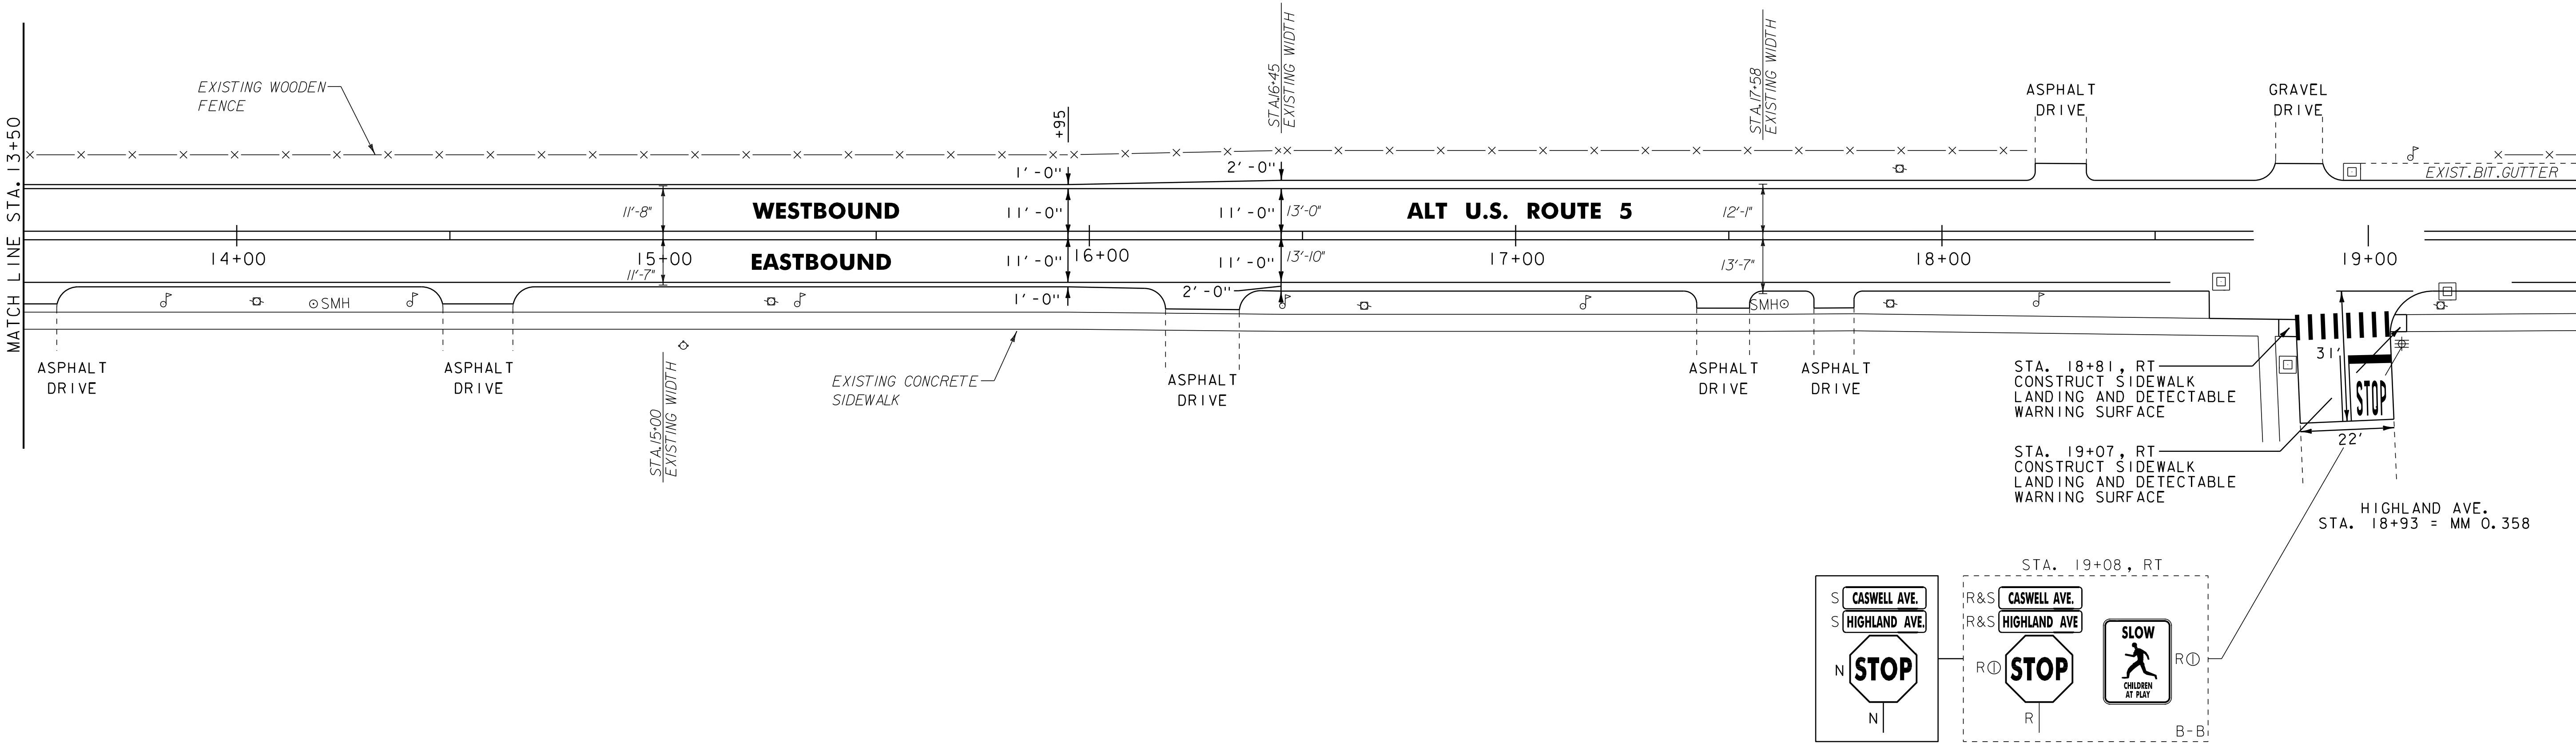

NOTE:

1. FOR LEGENDS, SEE LAYOUT SHEET #1.

2. ALL EXISTING SIGNS NOT SHOWN SHALL BE RETAINED.

NOT TO SCALE

PROJECT
LAYOUT
SHEET #11

PROJECT NAME: DERBY
PROJECT NUMBER: STP 2703(1)

FILE NAME: 07D202.dgn
PROJECT LEADER: JLL
DESIGNED BY: STANTEC
IPARM FILE: 07C194_44.i

PLOT DATE: 29-JAN-2013 09:2
DRAWN BY: STANTEC
CHECKED BY: JLL
SHEET 44 OF 62

604.42 CHANGING ELEVATION OF SEWER MANHOLES
STA. 23+74, RT

629.20 ADJUST ELEVATION OF VALVE BOX
STA. 23+82, LT
STA. 23+82, RT

646.402 DURABLE 4 INCH WHITE LINE, THERMOPLASTIC
(ALL LINES WILL INCLUDE EDGE LINE BREAKS AND
RADI FOR SIDE ROADS)
STA. 19+50 TO 25+50, SOLID LT & RT
STA. 24+88, SOLID RT (SB ON/OFF RAMP B EDGELINES)

646.412 DURABLE 4 INCH YELLOW LINE, THERMOPLASTIC
(ALL LINES WILL INCLUDE C BREAKS FOR SIDE ROADS)
STA. 19+50 TO 25+50, SOLID LT & RT
STA. 23+88, DOUBLE SOLID RT (MAPLE ST. CENTERLINE)
STA. 24+88, DOUBLE SOLID RT (SB ON/OFF RAMP B CENTERLINE)

646.482 DURABLE 24 INCH STOP BAR, THERMOPLASTIC
STA. 23+94, RT (MAPLE ST.)
STA. 24+90, RT (SB ON/OFF RAMP B)

646.492 DURABLE LETTER OR SYMBOL, THERMOPLASTIC
STA. 23+94, RT - "STOP"
STA. 24+89, RT - "STOP"

646.602 TEMPORARY 4 INCH WHITE LINE, PAINT
(ALL LINES WILL INCLUDE EDGE LINE BREAKS AND
RADI FOR SIDE ROADS)
STA. 19+50 TO 25+50, SOLID LT & RT
STA. 24+88, SOLID RT (SB ON/OFF RAMP B EDGELINES)



646.612 TEMPORARY 4 INCH YELLOW LINE, PAINT
(ALL LINES WILL INCLUDE C BREAKS FOR SIDE ROADS)
STA. 19+50 TO 25+50, SOLID LT & RT
STA. 23+88, DOUBLE SOLID RT (MAPLE ST. CENTERLINE)
STA. 24+88, DOUBLE SOLID RT (SB ON/OFF RAMP B CENTERLINE)

646.682 TEMPORARY 24 INCH STOP BAR, PAINT
STA. 23+94, RT (MAPLE ST.)
STA. 24+90, RT (SB ON/OFF RAMP B)

646.692 TEMPORARY LETTER OR SYMBOL, PAINT
STA. 23+94, RT - "STOP"
STA. 24+89, RT - "STOP"

675.50 REMOVING SIGNS
AS SHOWN - 9

675.60 ERECTING SALVAGED SIGNS
AS SHOWN - 4

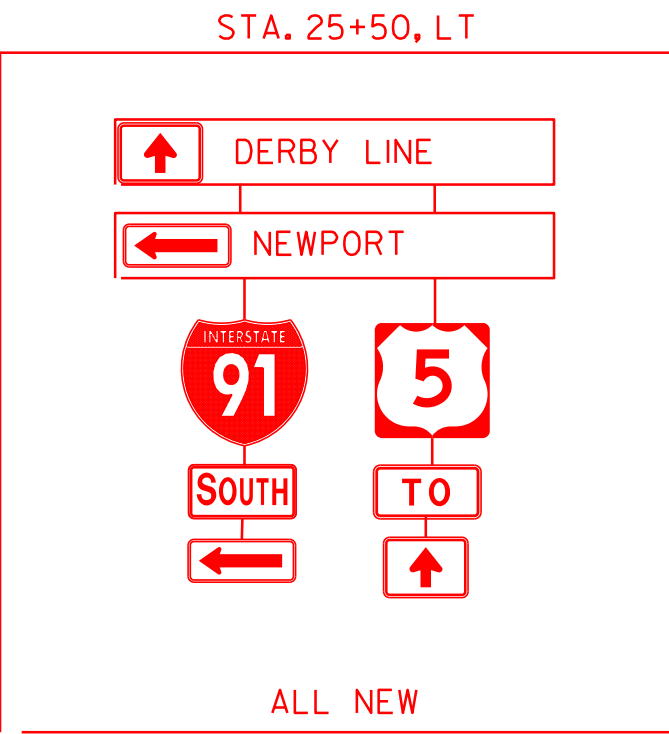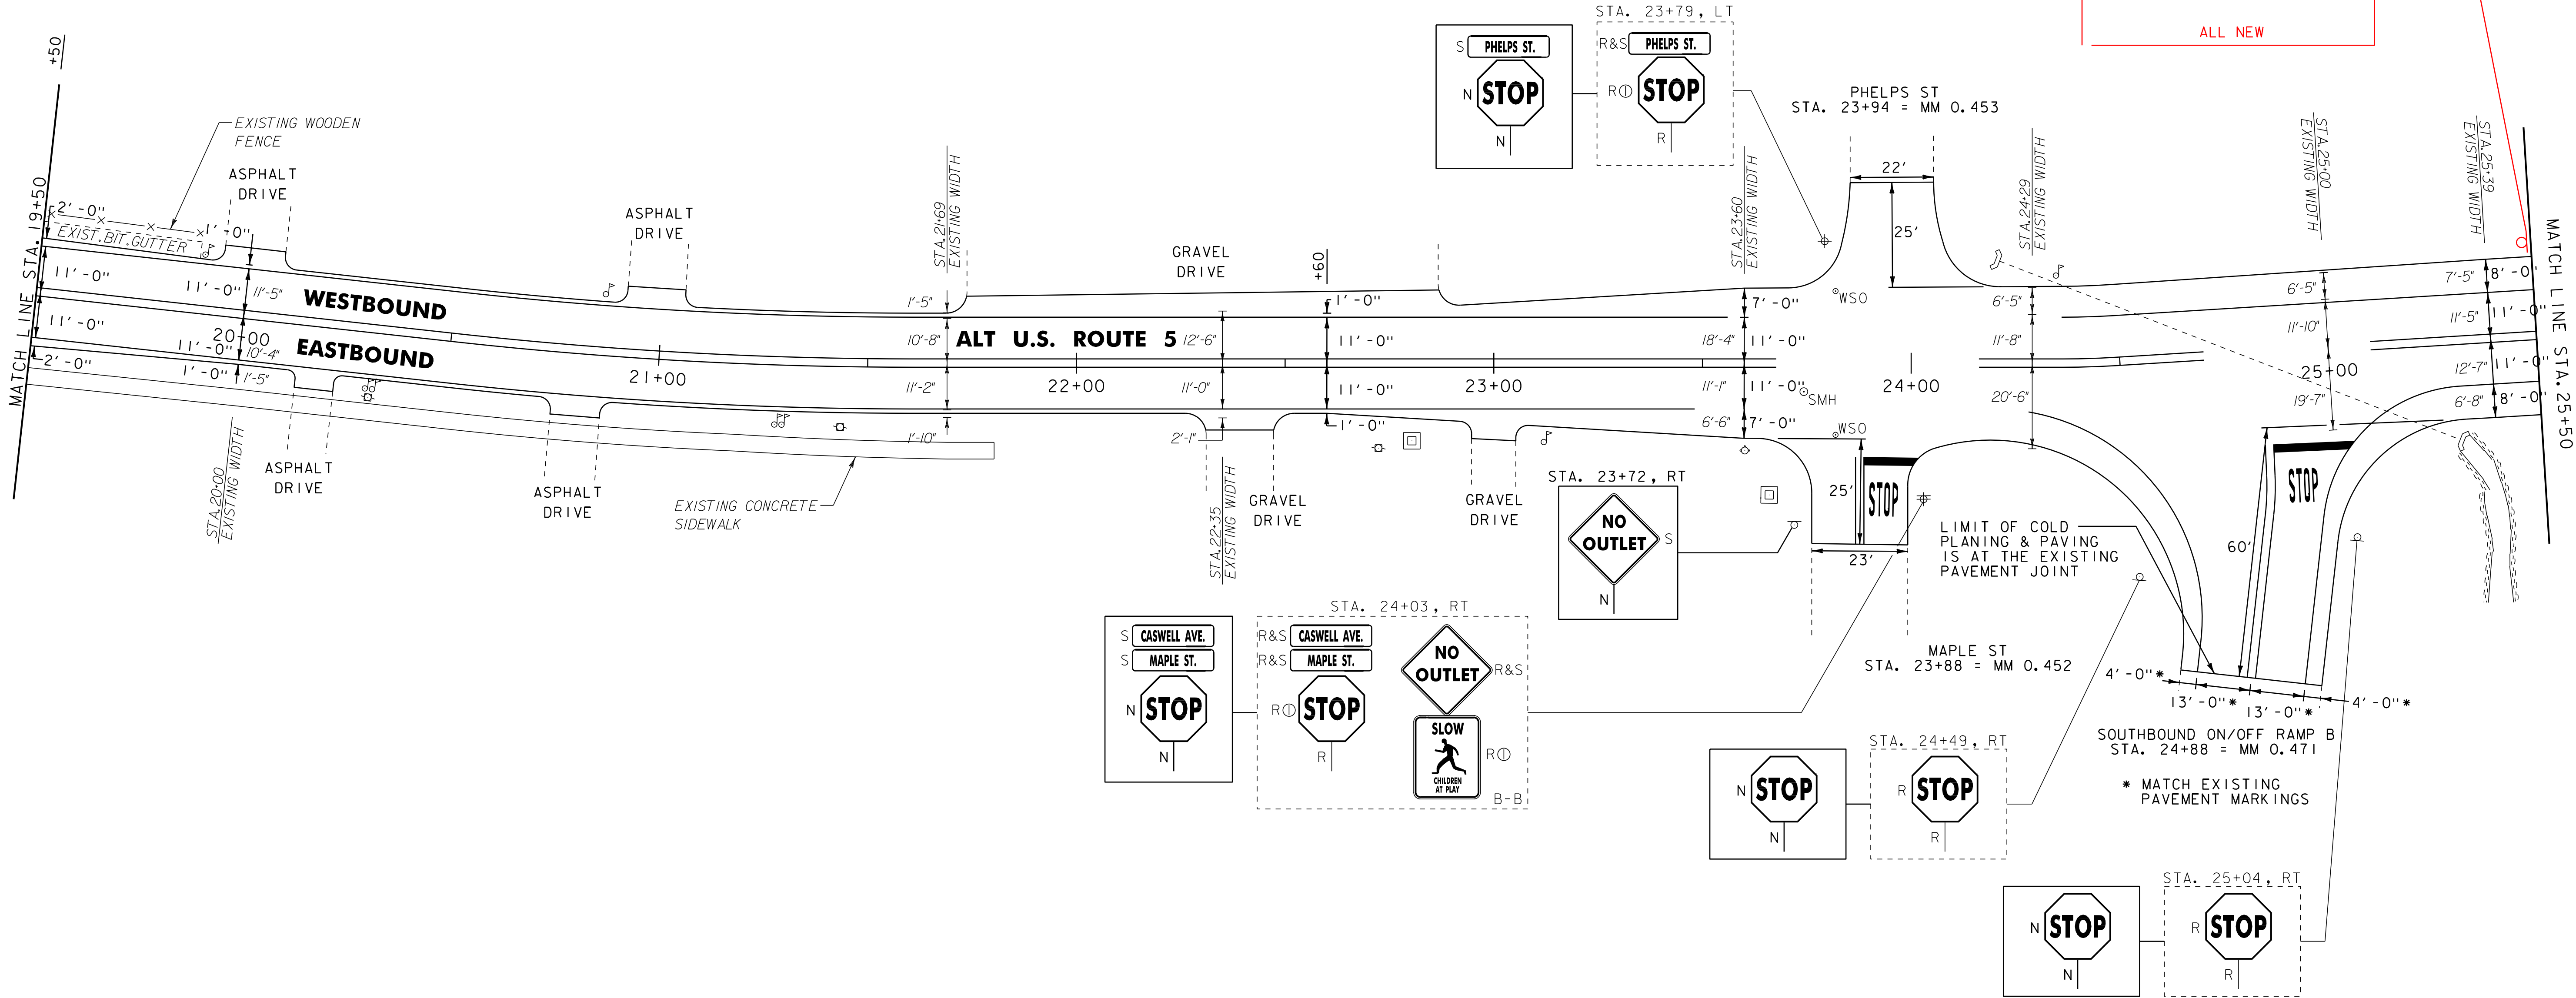

- NOTE:
1. FOR LEGENDS, SEE LAYOUT SHEET #1.
 2. ALL EXISTING SIGNS NOT SHOWN SHALL BE RETAINED.

NOT TO SCALE

PROJECT
LAYOUT
SHEET #12

PROJECT NAME: DERBY
PROJECT NUMBER: STP 2703(I)

FILE NAME: 07D202.dgn
PROJECT LEADER: JLL
DESIGNED BY: STANTEC
IPARM FILE: 07C194_45.i

PLOT DATE: 29-JAN-2013 09:2
DRAWN BY: STANTEC
CHECKED BY: JLL
SHEET 45 OF 62

~~620.75 SNOW BARRIER, GALVANIZED~~
~~STA. 29+26 TO 29+98, RT~~
~~STA. 29+74 TO 30+42, LT~~
~~STA. 30+69 TO 31+41, RT~~
~~STA. 31+18 TO 31+50, LT~~

THIS ITEM ELIMINATED
FROM THE CONTRACT

~~621.20 STEEL BEAM GUARDRAIL, GALVANIZED~~
~~STA. 25+70.5 TO 28+33, RT~~ STA. 25+95.5 TO 28+58, RT
~~STA. 26+04 TO 28+54, LT~~ STA. 25+91.5 TO 28+79, LT

~~621.60 ANCHOR FOR STEEL BEAM RAIL~~
~~STA. 25+70.5, RT~~ STA. 25+95.5, RT
~~STA. 26+04, LT~~ STA. 25+91.5, LT

~~621.74 ALUMINUM APPROACH RAILING~~
~~STA. 28+33 TO 28+58, RT~~ STA. 28+58 TO 28+83, RT
~~STA. 28+54 TO 28+79, LT~~ STA. 28+79 TO 29+04, LT


~~621.80 REMOVAL AND DISPOSAL OF GUARDRAIL~~
~~STA. 25+69 TO 28+58, RT~~ STA. 25+95.5 TO 28+83, RT
~~STA. 26+13 TO 28+79, LT~~ STA. 25+91.5 TO 29+04, LT

~~646.402 DURABLE 4 INCH WHITE LINE, THERMOPLASTIC~~
STA. 25+50 TO 31+50, SOLID LT & RT

~~646.412 DURABLE 4 INCH YELLOW LINE, THERMOPLASTIC~~
(ALL LINES WILL INCLUDE C BREAKS FOR SIDE ROADS)
STA. 25+50 TO 31+50, SOLID LT & RT

~~646.602 TEMPORARY 4 INCH WHITE LINE, PAINT~~
STA. 25+50 TO 31+50, SOLID LT & RT

~~646.612 TEMPORARY 4 INCH YELLOW LINE, PAINT~~
(ALL LINES WILL INCLUDE C BREAKS FOR SIDE ROADS)
STA. 25+50 TO 31+50, SOLID LT & RT

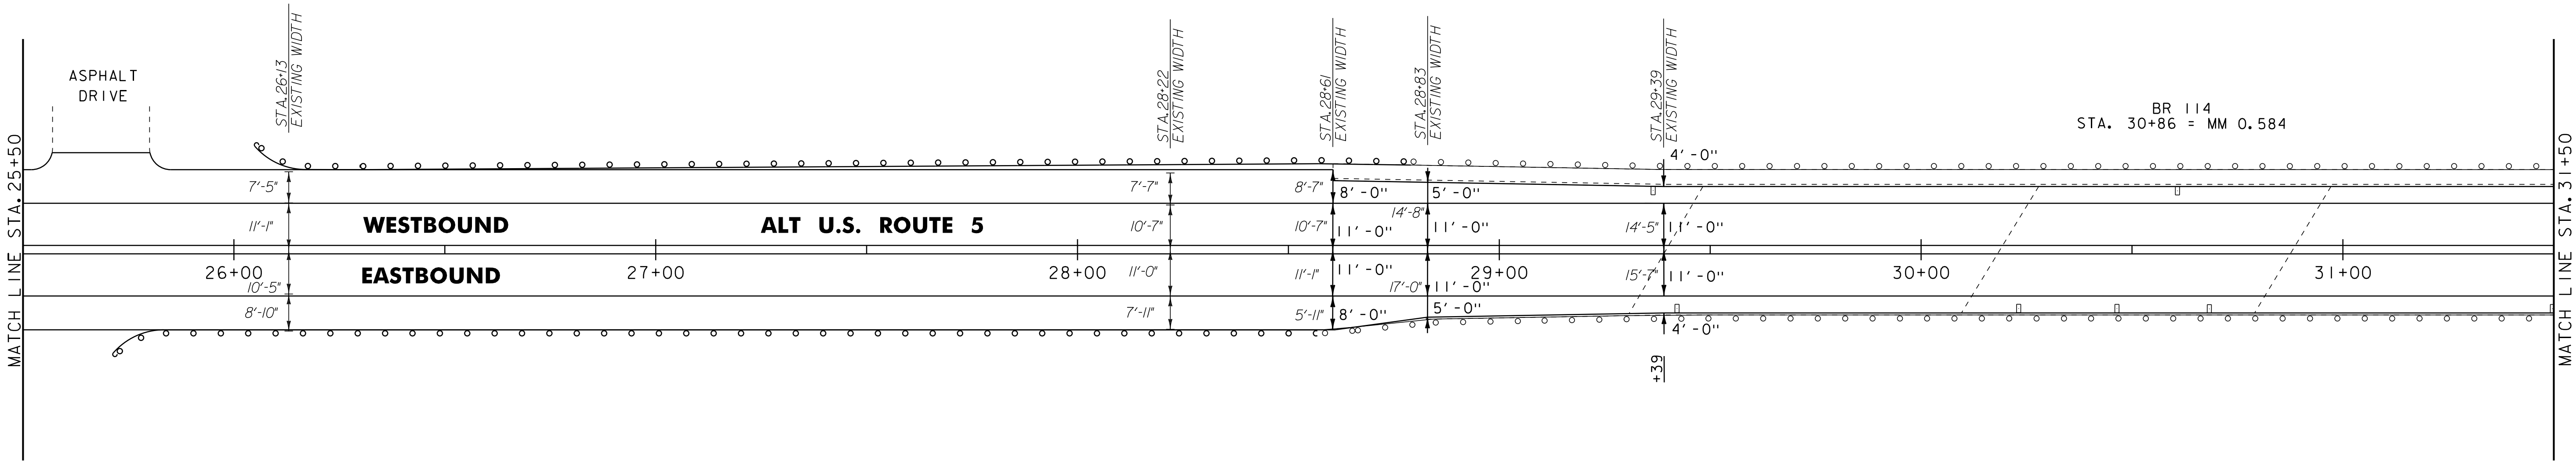

- NOTE:
- FOR LEGENDS, SEE LAYOUT SHEET #1.
 - ALL EXISTING SIGNS NOT SHOWN SHALL BE RETAINED.

NOT TO SCALE

PROJECT
LAYOUT
SHEET #13

PROJECT NAME: DERBY
PROJECT NUMBER: STP 2703(I)

FILE NAME: 07D202.dgn
PROJECT LEADER: JLL
DESIGNED BY: STANTEC
IPARM FILE: 07C194_46.i

PLOT DATE: 29-JAN-2013 09:2
DRAWN BY: STANTEC
CHECKED BY: JLL
SHEET 46 OF 62

621.74 ALUMINUM APPROACH RAILING
DERBY TOWN STA. ~~0+50.8 TO 0+75.8, RT~~ 0+25.8 TO 0+50.8, RT
DERBY TOWN STA. ~~0+72.8 TO 0+97.8, LT~~ 0+47.8 TO 0+72.8, LT

621.80 REMOVAL AND DISPOSAL OF GUARDRAIL
DERBY TOWN STA. ~~0+50.8 TO STA. 2+27.8, RT~~ 0+25.8 TO 2+25.8, RT
DERBY TOWN STA. ~~0+72.8 TO STA. 4+13.8, LT~~ 0+47.8 TO 4+10.3, LT

621.60 ANCHOR FOR STEEL BEAM RAIL
DERBY TOWN STA. 2+25.8, RT
DERBY TOWN STA. 4+10.3, LT

646.402 DURABLE 4 INCH WHITE LINE, THERMOPLASTIC
(ALL LINES WILL INCLUDE EDGE LINE BREAKS AND
RADII FOR SIDE ROADS)
DERBY STA. 31+50 TO 31+89.12, SOLID LT & RT
DERBY TOWN STA. 0+00 TO 4+81.52, SOLID LT & RT
DERBY TOWN STA. 2+81, SOLID RT (NB ON/OFF RAMP A EDGELINES)
DERBY TOWN STA. 4+41, SOLID RT (HERRICK ROAD EDGELINES)

646.412 DURABLE 4 INCH YELLOW LINE, THERMOPLASTIC
(ALL LINES WILL INCLUDE C BREAKS FOR SIDE ROADS)
DERBY STA. 31+50 TO 31+89.12, SOLID LT & RT
DERBY TOWN STA. 0+00 TO 4+81.52, SOLID LT & RT
DERBY TOWN STA. 2+81, DOUBLE SOLID RT (NB ON/OFF RAMP A)
DERBY TOWN STA. 4+41, DOUBLE SOLID RT (HERRICK ROAD)

646.482 DURABLE 24 INCH STOP BAR, THERMOPLASTIC
DERBY TOWN STA. 2+96, RT (NB ON/OFF RAMP A)
DERBY TOWN STA. 4+53, RT (HERRICK ROAD)

646.492 DURABLE LETTER OR SYMBOL, THERMOPLASTIC
DERBY TOWN STA. 2+95, RT - "STOP"
DERBY TOWN STA. 4+51, RT - "STOP"

646.602 TEMPORARY 4 INCH WHITE LINE, PAINT
(ALL LINES WILL INCLUDE EDGE LINE BREAKS AND
RAIL FOR SIDE ROADS)
DERBY STA. 31+50 TO 31+89.12, SOLID LT & RT
DERBY TOWN STA. 0+00 TO 4+81.52, SOLID LT & RT
DERBY TOWN STA. 2+81, SOLID RT (NB ON/OFF RAMP A EDGELINES)
DERBY TOWN STA. 4+41, SOLID RT (HERRICK ROAD EDGELINES)

646.612 TEMPORARY 4 INCH YELLOW LINE, PAINT
(ALL LINES WILL INCLUDE 6 BREAKS FOR SIDE ROADS)
DERBY STA. 31+50 TO 31+89.12, SOLID LT & RT
DERBY TOWN STA. 0+00 TO 4+81.52, SOLID LT & RT
DERBY TOWN STA. 2+81, DOUBLE SOLID RT (NB ON/OFF RAMP A)
DERBY TOWN STA. 4+41, DOUBLE SOLID RT (HERRICK ROAD)


646.682 TEMPORARY 24 INCH STOP BAR, PAINT
DERBY TOWN STA. 2+96, RT (NB ON/OFF RAMP A)
DERBY TOWN STA. 4+53, RT (HERRICK ROAD)

646.692 TEMPORARY LETTER OR SYMBOL, PAINT
DERBY TOWN STA. 2+95, RT - "STOP"
DERBY TOWN STA. 4+51, RT - "STOP"

675.50 REMOVING SIGNS
AS SHOWN - 2

**END STP 2703(1) ALT U.S. ROUTE 5
DERBY STA. 31+89.12 = MM 0.604
BEGIN APPROACH**

END APPROACH
DERBY TOWN T.H. 1 STA. 4+81.52 = MM 0.091

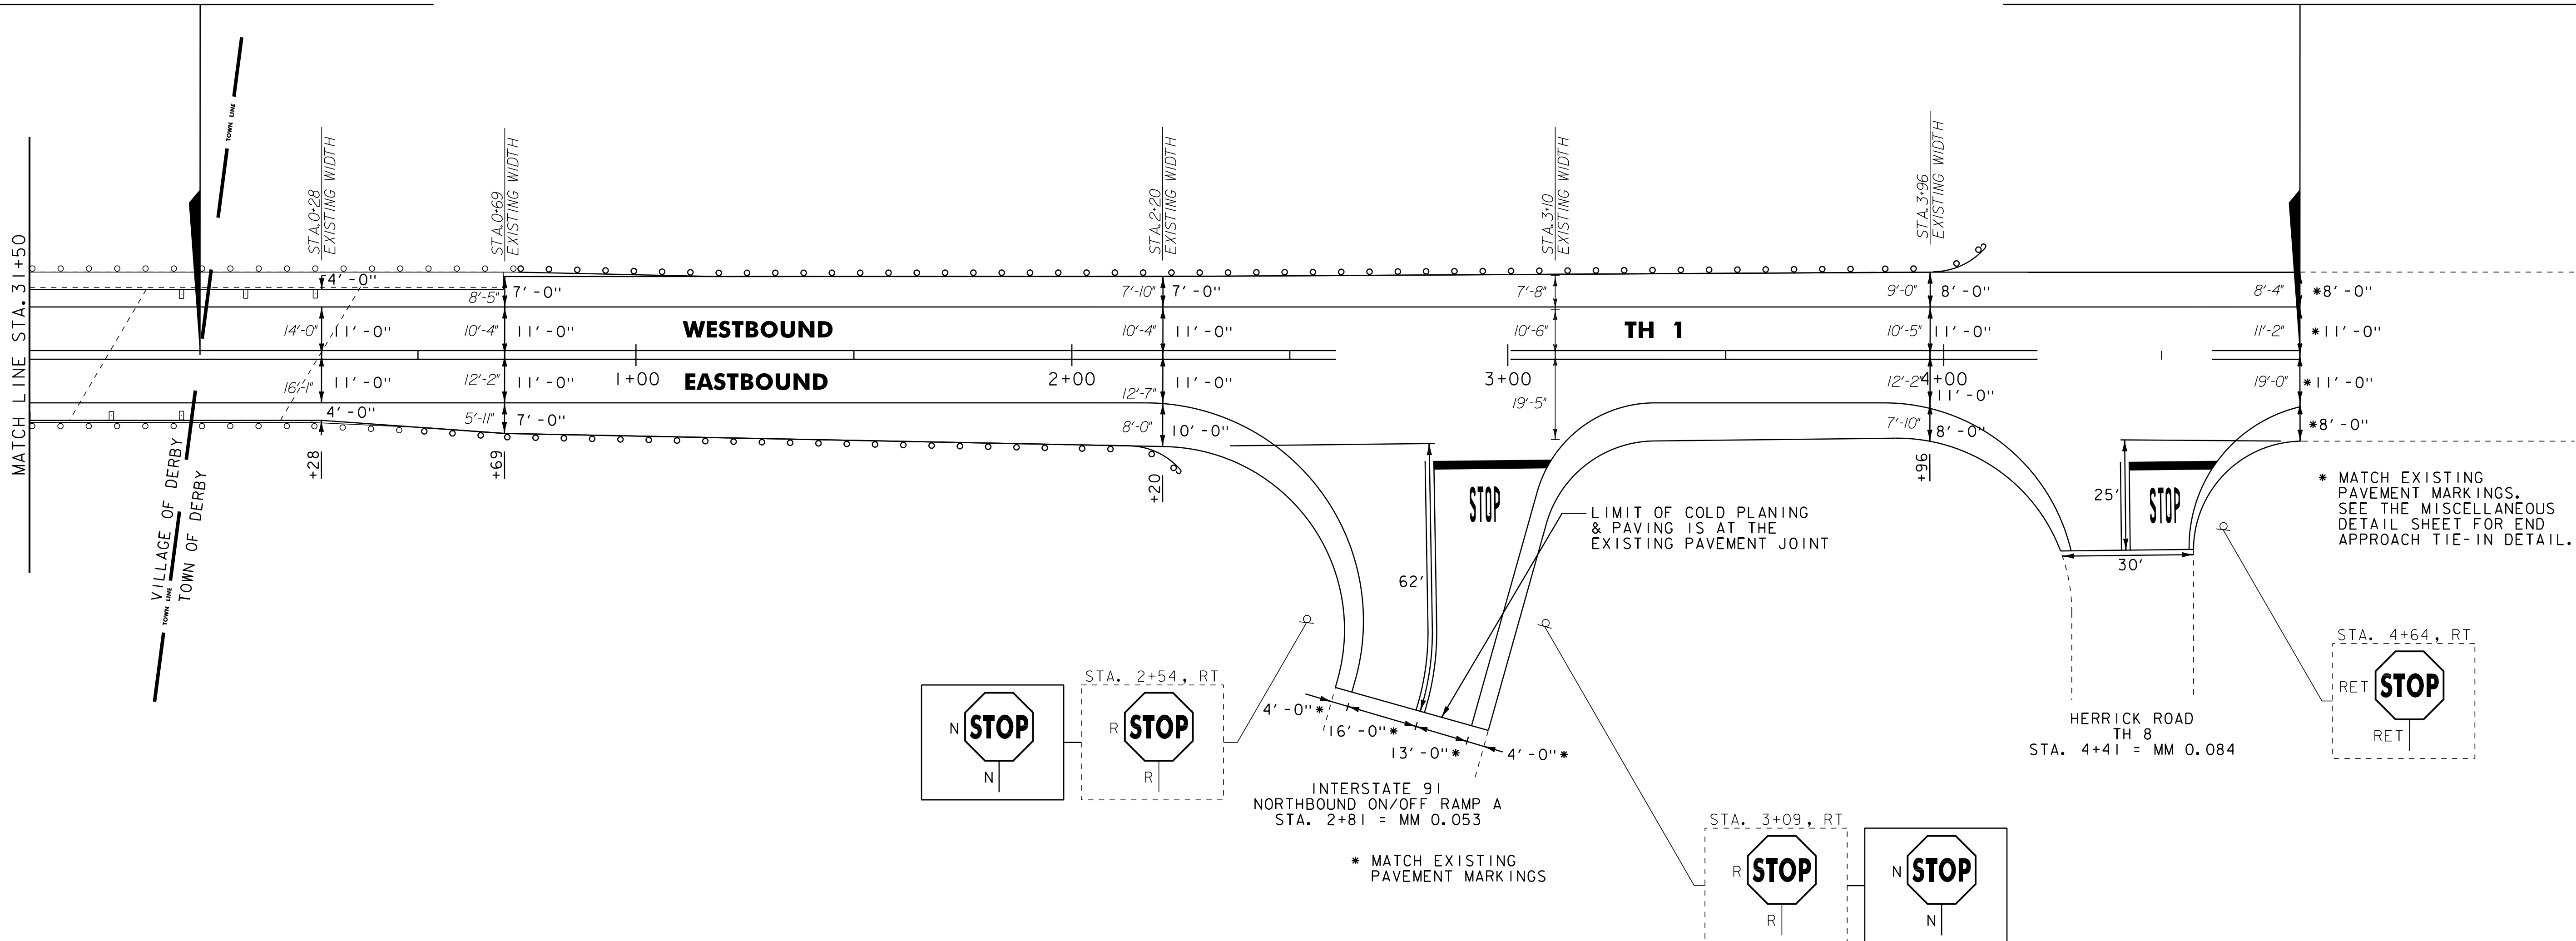

NOTE:

1. FOR LEGENDS, SEE LAYOUT SHEET #1.
2. ALL EXISTING SIGNS NOT SHOWN SHALL BE RETAINED.

NOT TO SCALE

PROJECT LAYOUT SHEET #14

PROJECT NAME: DERBY
PROJECT NUMBER: STP 2703(I)

FILE NAME: 07D202.dgn
PROJECT LEADER: JLL
DESIGNED BY: STANTEC
IPARM FILE: 07CI94_47.i






PLOT DATE: 29-JAN-2013 09:2
DRAWN BY: STANTEC
CHECKED BY: JLL
SHEET 47 OF 62

TRAFFIC SIGN SUMMARY SHEET 01




MILEMARKER, STATION, OR SIGN NUMBER	SIGN LEGEND	SIGN DIMENSIONS			NEW & SALVAGED SIGNS				EXIST POST RETAIN	SALVAGE	NO. OF POSTS	NEW SIGN POSTS																REMARKS	SIGN DETAIL																																																																																																																																																																																																																																																																																																																																																																																																																																																																																																		
												FLANGED CHANNEL				SQUARE STEEL (in)				TUBULAR ALUMINUM Ø (in)			TUBULAR STEEL Ø (in)				W-SHAPE STEEL				S C R E W S P L A C E M E N T P L A C E M E N T	R O U N D P L A C E M E N T	DETAIL ON SHEET NUMBER	STD. SHEET NUMBER																																																																																																																																																																																																																																																																																																																																																																																																																																																																																													
		1.75	2.0	2.5	A N C H O R	S L E E V E	3.0	4.0								4.0 MOD	FOUND- ATION	3.0	3.5	4.0	5.0	FTG. SIZE		WEIGHT	POST SIZE																																																																																																																																																																																																																																																																																																																																																																																																																																																																																																						
		lb/ft					lb/ft									lb/ft				24"	30"																																																																																																																																																																																																																																																																																																																																																																																																																																																																																																										
		1.12	2.0	3.0			1.88	2.42								3.35		1.3	1.7			1.7	7.6			9.0	10.8		14.6																																																																																																																																																																																																																																																																																																																																																																																																																																																																																																		
U.S. ROUTE 5 DERBY												OPTION ITEMS																																																																																																																																																																																																																																																																																																																																																																																																																																																																																																																			
281+99, LT	VALENTINE AVE. STOP 0050 1007 0535 B-B	I	30	30	6.25		I				I					X		X															INSTALL SALVAGED STREET SIGN 90 DEGREES TO AND 6 INCHES ABOVE STOP SIGN. PLACE MM PLAQUE BACK TO BACK AND BELOW STOP SIGN	-	-																																																																																																																																																																																																																																																																																																																																																																																																																																																																																												
283+87, LT	MAIN ST. LAYTHE ST. STOP	I	30	30	6.25		I				I					X		X															INSTALL SALVAGED STREET SIGNS 90 DEGREES TO EACH OTHER AND 6 INCHES ABOVE STOP SIGN.	-	-																																																																																																																																																																																																																																																																																																																																																																																																																																																																																												
295+06, LT		I	30	30	6.25						I					X		X															SIGN ID CODE W11-2 (FLUORESCENT YELLOW-GREEN)		SEE FHWA SHS																																																																																																																																																																																																																																																																																																																																																																																																																																																																																												
																																				SEE FHWA SHS																																																																																																																																																																																																																																																																																																																																																																																																																																																																																											
295+27, RT		I	30	30	6.25						I					X		X															SIGN ID CODE W11-2 (FLUORESCENT YELLOW-GREEN)		SEE FHWA SHS																																																																																																																																																																																																																																																																																																																																																																																																																																																																																												
																																				SEE FHWA SHS																																																																																																																																																																																																																																																																																																																																																																																																																																																																																											
301+15, RT		I	30	30	6.25						I					X		X															SIGN ID CODE W11-2 (FLUORESCENT YELLOW-GREEN)		SEE FHWA SHS																																																																																																																																																																																																																																																																																																																																																																																																																																																																																												
																																				SEE FHWA SHS																																																																																																																																																																																																																																																																																																																																																																																																																																																																																											
FINAL POST LENGTHS ARE TO BE DETERMINED IN THE FIELD. POST SIZES ARE COMPUTED BASED ON INFORMATION FURNISHED ON THE STANDARD SHEETS AND THE VTRANS "SIGN POST DESIGN GUIDELINE."												FT	FT	FT	FT	FT	75	FT		EA	LB	LB	LB		LB	LB	LB	LB					PROJECT NAME: DERBY PROJECT NUMBER: STP 2703(I)																																																																																																																																																																																																																																																																																																																																																																																																																																																																																														

MILEMARKER, STATION, OR SIGN NUMBER	SIGN LEGEND	SIGN DIMENSIONS			NEW & SALVAGED SIGNS				EXIST POST RETAIN		NO. OF POSTS	NEW SIGN POSTS												REMARKS								SIGN DETAIL							
												FLANGED CHANNEL			SQUARE STEEL (in)			TUBULAR ALUMINUM Ø (in)			TUBULAR STEEL Ø (in)													W-SHAPE STEEL					
		EA	WIDTH (in)	HEIGHT (in)	“A”	“B”	SALV SIGN	SALV TIS	1.2	2.0	3.0	1.75	2.0	2.5	ANCHOR	SLEEVE	3.0	4.0	4.0 MOD	FOUND- ATION	3.0	3.5	4.0	5.0	FTG. SIZE		WEIGHT	POST SIZE	SIGN TYPE	R-ROAD USE									
																									lb/ft						lb/ft			lb/ft			24"	30"	
																									1.2	2.0					3.0	1.88	2.42	3.35	1.3	1.7			1.7
U.S. ROUTE 5 (CONTINUED)												OPTION ITEMS																											
30I+2I, LT		I	30	30	6.25						I					X		X												SIGN ID CODE WII-2 (FLUORESCENT YELLOW-GREEN)		SEE FHWA SHS							
		I	24	12	2.00																									SIGN ID CODE WI6-7P (FLUORESCENT YELLOW-GREEN)		SEE FHWA SHS							
30I+67, LT		I	30	30	3.13						I					X		X												SIGN ID CODE RI-2		SEE FHWA SHS							
305+55, LT		I	30	30	6.25						I					X		X												SIGN ID CODE WII-2 (FLUORESCENT YELLOW-GREEN)		SEE FHWA SHS							
		I	24	12	2.00																									SIGN ID CODE WI6-7P (FLUORESCENT YELLOW-GREEN)		SEE FHWA SHS							
305+75, RT		I	30	30	6.25						I					X		X												SIGN ID CODE WII-2 (FLUORESCENT YELLOW-GREEN)		SEE FHWA SHS							
		I	24	12	2.00																									SIGN ID CODE WI6-7P (FLUORESCENT YELLOW-GREEN)		SEE FHWA SHS							
307+72, RT		I	30	30	6.25						I					X		X												SIGN ID CODE WII-2 (FLUORESCENT YELLOW-GREEN)		SEE FHWA SHS							
		I	24	12	2.00																									SIGN ID CODE WI6-7P (FLUORESCENT YELLOW-GREEN)		SEE FHWA SHS							
307+79, LT		I	30	30	6.25						I					X		X												SIGN ID CODE WII-2 (FLUORESCENT YELLOW-GREEN)		SEE FHWA SHS							
		I	24	12	2.00																									SIGN ID CODE WI6-7P (FLUORESCENT YELLOW-GREEN)		SEE FHWA SHS							
FINAL POST LENGTHS ARE TO BE DETERMINED IN THE FIELD. POST SIZES ARE COMPUTED BASED ON INFORMATION FURNISHED ON THE STANDARD SHEETS AND THE VTRANS "SIGN POST DESIGN GUIDELINE."												FT	FT	FT	FT	FT	90	FT			EA	LB	LB	LB		LB	LB	LB	LB				PROJECT NAME: DERBY PROJECT NUMBER: STP 2703(I)						
																																FILE NAME: 07D202.dgn DESIGNED BY: JLL IPARM FILE: 07CI94_49.i	PLOT DATE: 29-JAN-2013 09: DRAWN BY: JLL CHECKED BY: JLL SHEET 49 OF 62						
TOTALS					SF 44.38	SF	EA.	SF				FT	FT 90				LB			EA.	LB				EA.	EA.	LB												


TRAFFIC SIGN SUMMARY SHEET 03

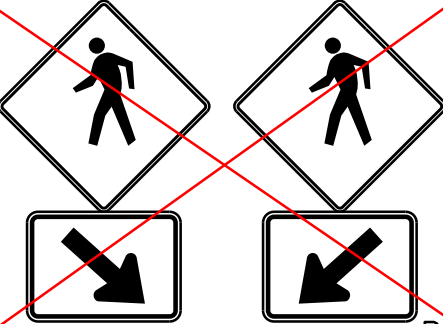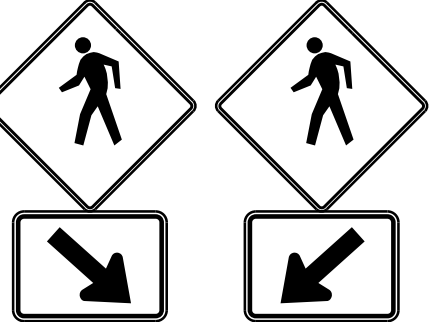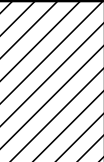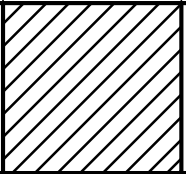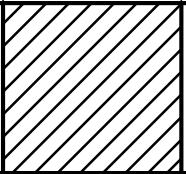MILEMARKER, STATION, OR SIGN NUMBER	SIGN LEGEND	SIGN DIMENSIONS			NEW & SALVAGED SIGNS				EXIST POST RETAIN		NO. OF POSTS	NEW SIGN POSTS																		REMARKS				SIGN DETAIL													
												FLANGED CHANNEL			SQUARE STEEL (in)			ANCHOR	SLEEVE	TUBULAR ALUMINUM Ø (in)			TUBULAR STEEL Ø (in)				W-SHAPE STEEL																				
		EA	WIDTH (in)	HEIGHT (in)	"A"	"B"	SALV SIGN	SALV TIS				lb/ft			lb/ft					3.0	4.0	4.0 MOD	FOUND-ATION	3.0	3.5	4.0	5.0	FTG. SIZE						WEIGHT	POST SIZE	SLOPE	CURVE										
												1.12	2.0	3.0	1.75	2.0	2.5							lb/ft				24"	30"																		
												1.12	2.0	3.0	1.88	2.42	3.35							lb/ft				1.3	1.7									1.7	7.6	9.0	10.8	14.6	24"	30"			
U.S. ROUTE 5 (CONTINUED)												OPTION ITEMS																																			
309+50, LT		2	30	30	12.50							1					X		X														MOUNT SIGNS BACK TO BACK		SEE FHWA SHS												
		2	24	12	4.00																												SIGN ID CODE W16-7P (FLUORESCENT YELLOW-GREEN)		SEE FHWA SHS												
ALT. U.S. ROUTE 5 -0+95, LT- ELIMINATED BY VILLAGE OF DERBY LINE		2	30	30	12.50							1					X		X													MOUNT SIGNS BACK TO BACK		SEE FHWA SHS													
		2	24	12	4.00																												SIGN ID CODE W16-7P (FLUORESCENT YELLOW-GREEN)		SEE FHWA SHS												
0+98, LT	  	1	30	30	6.25												X		X													SIGN ID CODE RI-1		SEE FHWA SHS													
		1	30	30	6.25							1																					SIGN ID CODE R3-2		SEE FHWA SHS												
1+95, LT		2	30	30	12.50							1					X		X													MOUNT SIGNS BACK TO BACK		SEE FHWA SHS													
		2	24	12	4.00																												SIGN ID CODE W16-7P (FLUORESCENT YELLOW-GREEN)		SEE FHWA SHS												
5+00, LT		1	30	30	6.25							1					X		X													SIGN ID CODE RI-1		SEE FHWA SHS													
FINAL POST LENGTHS ARE TO BE DETERMINED IN THE FIELD. POST SIZES ARE COMPUTED BASED ON INFORMATION FURNISHED ON THE STANDARD SHEETS AND THE VTRANS "SIGN POST DESIGN GUIDELINE."												FT	FT	FT	FT	FT 75	FT		EA	LB	LB	LB		LB	LB	LB	LB						PROJECT NAME: DERBY PROJECT NUMBER: STP 2703(I)														
													FT	FT 75					EA.	LB					EA.	LB			EA.	EA.	LB		FILE NAME: 07D202.dgn PROJECT LEADER: JLL DESIGNED BY: STANTEC IPARM FILE: 07C194_50.i	PLOT DATE: 29-JAN-2013 09: DRAWN BY: STANTEC CHECKED BY: JLL SHEET 50 OF 62													
					TOTALS	SF 68.25	SF	EA. 1	SF			FT	FT 75						EA.	LB					EA.	EA.	LB																				


TRAFFIC SIGN SUMMARY SHEET 04

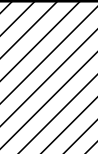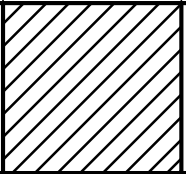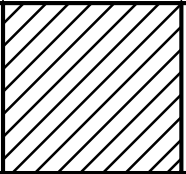MILEMARKER, STATION, OR SIGN NUMBER	SIGN LEGEND	SIGN DIMENSIONS			NEW & SALVAGED SIGNS				EXIST POST RETAIN		NO. OF POSTS	NEW SIGN POSTS																REMARKS				SIGN DETAIL											
												FLANGED CHANNEL			SQUARE STEEL (in)			ANCHOR	SLEEVE	TUBULAR ALUMINUM Ø (in)			TUBULAR STEEL Ø (in)				W-SHAPE STEEL																
		EA	WIDTH (in)	HEIGHT (in)	"A"	"B"	SALV SIGN	SALV TIS				1.75	2.0	2.5	3.0	4.0	4.0 MOD			FOUND- ATION	3.0	3.5	4.0	5.0	FTG. SIZE		WEIGHT					POST SIZE	S- C- P- F- R- E- D										
																									1b/ft	1.75								2.0	2.5	1b/ft	1.3	1.7	1.7	24"	30"		
ALT. U.S. ROUTE 5 (CONTINUED)												OPTION ITEMS																															
5+60, RT	 	I	30	30	6.25						I					X		X															SIGN ID CODE W11-2 (FLUORESCENT YELLOW-GREEN)		SEE FHWA SHS								
		I	24	12	2.00																											SIGN ID CODE W16-7P (FLUORESCENT YELLOW-GREEN)		SEE FHWA SHS									
5+72, LT	 	I	30	30	6.25						I					X		X														SIGN ID CODE W11-2 (FLUORESCENT YELLOW-GREEN)		SEE FHWA SHS									
		I	24	12	2.00																											SIGN ID CODE W16-7P (FLUORESCENT YELLOW-GREEN)		SEE FHWA SHS									
7+33, LT											I					X		X													MOUNT SALVAGED SIGN ON NEW POST	-	-										
8+79, RT	 	I	30	30	6.25						I					X		X														SIGN ID CODE W11-2 (FLUORESCENT YELLOW-GREEN)		SEE FHWA SHS									
		I	24	12	2.00																											SIGN ID CODE W16-7P (FLUORESCENT YELLOW-GREEN)		SEE FHWA SHS									
8+91, LT	 	I	30	30	6.25						I					X		X														SIGN ID CODE W11-2 (FLUORESCENT YELLOW-GREEN)		SEE FHWA SHS									
		I	24	12	2.00																											SIGN ID CODE W16-7P (FLUORESCENT YELLOW-GREEN)		SEE FHWA SHS									
FINAL POST LENGTHS ARE TO BE DETERMINED IN THE FIELD. POST SIZES ARE COMPUTED BASED ON INFORMATION FURNISHED ON THE STANDARD SHEETS AND THE VTRANS "SIGN POST DESIGN GUIDELINE."												FT	FT	FT	FT	FT	75	FT		EA	LB	LB	LB		LB	LB	LB	LB					PROJECT NAME: DERBY PROJECT NUMBER: STP 2703(I)										
													FT	FT 75				LB			EA.	LB				EA.	EA.	LB	FILE NAME: 07D202.dgn PROJECT LEADER: JLL DESIGNED BY: STANTEC IPARM FILE: 07C194_51.i		PLOT DATE: 29-JAN-2013 09: DRAWN BY: STANTEC CHECKED BY: JLL SHEET 51 OF 62												
TOTALS					SF 33.00	SF	EA. 1	SF				FT	FT 75				LB			EA.	LB				EA.	EA.	LB																

TRAFFIC SIGN SUMMARY SHEET 05

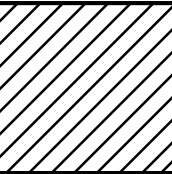
MILEMARKER, STATION, OR SIGN NUMBER	SIGN LEGEND	SIGN DIMENSIONS			NEW & SALVAGED SIGNS				EXIST POST RETAIN	SALVAGE	NO. OF POSTS	NEW SIGN POSTS																	REMARKS	SIGN DETAIL											
												FLANGED CHANNEL			SQUARE STEEL (in)			ANCHOR	SLEEVE	TUBULAR ALUMINUM Ø (in)			TUBULAR STEEL Ø (in)				W-SHAPE STEEL			DETAIL ON SHEET NUMBER	STD. SHEET NUMBER										
		EA	WIDTH (in)	HEIGHT (in)	"A"	"B"	SALV SIGN	SALV TIS												1.75	2.0	2.5	FOUND- ATION	3.0	4.0	4.0 MOD	3.0	3.5				4.0	5.0	FTG. SIZE		WEIGHT	POST SIZE				
												1.2	2.0	3.0	1.88	2.42	3.35	1.3	1.7															1.7	24"			30"			
ALT. U.S. ROUTE 5 (CONTINUED)												OPTION ITEMS																													
10+00, LT							I				I					X		X															MOUNT SALVAGED SIGN ON NEW POST	-	-						
11+76, LT		I	30	30	6.25		I				I					X		X														INSTALL SALVAGED STREET SIGNS BACK TO BACK TO EACH OTHER, 90 DEGREES TO AND 6 INCHES ABOVE STOP SIGN	- -	- -							
																																SIGN ID CODE RI-I		SEE FHWA SHS							
12+32, RT		I	30	30	6.25		I				I					X		X														INSTALL SALVAGED STREET SIGNS 90 DEGREES TO EACH OTHER AND 6 INCHES ABOVE STOP SIGN.	- -	- -							
																																SIGN ID CODE RI-I		SEE FHWA SHS							
19+08, RT		I	30	30	6.25		I				I					X		X														INSTALL SALVAGED STREET SIGNS 90 DEGREES TO EACH OTHER AND 6 INCHES ABOVE STOP SIGN.	- -	- -							
23+72, RT							I				I					X		X														MOUNT SALVAGED SIGN ON NEW POST	-	-							
FINAL POST LENGTHS ARE TO BE DETERMINED IN THE FIELD. POST SIZES ARE COMPUTED BASED ON INFORMATION FURNISHED ON THE STANDARD SHEETS AND THE VTRANS "SIGN POST DESIGN GUIDELINE."												FT	FT	FT	FT	FT 75	FT		EA	LB	LB	LB		LB	LB	LB	LB						PROJECT NAME: DERBY PROJECT NUMBER: STP 2703(I)								
																																			FILE NAME: 07D202.dgn PROJECT LEADER: JLL DESIGNED BY: STANTEC IPARM FILE: 07C194_52.i	PLOT DATE: 29-JAN-2013 09: DRAWN BY: STANTEC CHECKED BY: JLL SHEET 52 OF 62					
					TOTALS	SF 18.75	SF	EA. 8	SF			FT	FT 75				LB				EA.	LB				EA.	EA.	LB													

MILEMARKER, STATION, OR SIGN NUMBER	SIGN LEGEND	SIGN DIMENSIONS			NEW & SALVAGED SIGNS				NEW SIGN POSTS																				REMARKS				SIGN DETAIL				
		EA	WIDTH (in)	HEIGHT (in)	“A”	“B”	SALV SIGN	SALV TIS	EXIST POST RETAIN	SALV AGE	NO. OF POSTS	FLANGED CHANNEL			SQUARE STEEL (in)				ANCHOR	SLEEVE	TUBULAR ALUMINUM Ø (in)			TUBULAR STEEL Ø (in)				W-SHAPE STEEL					SIGN TYPE	R- CODE			
												1x2	2.0	3.0	1.75	2.0	2.5	3.0			4.0	MOD	FOUND- ATION	3.0	3.5	4.0	5.0	FTG. SIZE							WEIGHT	POST SIZE	
																												lb/ft									lb/ft
ALT. U.S. ROUTE 5 (CONTINUED)										OPTION ITEMS																											
23+79, LT	PHELPS ST. STOP	I	30	30	6.25		I			I					X		X													SIGN ID CODE RI-I	-	- SEE FHWA SHS					
24+03, RT	CASWELL AVE. MAPLE ST. STOP	I	30	30	6.25		I			I					X		X												INSTALL SALVAGED STREET SIGNS 90 DEGREES TO EACH OTHER AND 6 INCHES ABOVE STOP SIGN.	- -	- SEE FHWA SHS						
24+49, RT	↑ DERBY LINE ← NEWPORT	I	72"	12"	6.00																								SIGN ID CODE DI-I		E-123						
	STOP	I	30	30	6.25					I					X		X												SIGN ID CODE RI-I		SEE FHWA SHS						
25+04, RT	INTERSTATE 91 5	I	24	24	4.00																								SIGN ID CODE MI-I		E-135						
	STOP	I	24	24	4.00																								SIGN ID CODE MI-4		E-136A						
25+04, RT	STOP	I	30	30	6.25					I					X		X												SIGN ID CODE RI-I		SEE FHWA SHS						
25+50, LT ←	SOUTH ← TO ↑	I I I I	24 24 21 21	12 12 15 15	2.00 2.00 2.19 2.19					2					X		X											SIGN ID CODE M3-3 SIGN ID CODE M4-5 SIGN ID CODE M6-1 SIGN ID CODE M6-3		E-135 E-136A E-135 E-136A							
ALT. U.S. ROUTE 5 APPROACH DERBY																																					
2+54, RT	STOP	I	30	30	6.25					I					X		X												SIGN ID CODE RI-I		SEE FHWA SHS						
3+09, RT	STOP	I	30	30	6.25					I					X		X												SIGN ID CODE RI-I		SEE FHWA SHS						
	TSS SHEET 1 SUBTOTALS TSS SHEET 2 SUBTOTALS TSS SHEET 3 SUBTOTALS TSS SHEET 4 SUBTOTALS TSS SHEET 5 SUBTOTALS TSS SHEET 6 SUBTOTALS PROJECT SUBTOTALS ROUNDING				37.65 44.38 68.25 33.00 18.75 37.50 239.53 5.47		3 1 1 8 3 16 -							FT 485	FT 485	FT 485	EA 16	LB 485	LB 485	LB 485	EA 16	LB 485	LB 485	LB 485	EA 16	LB 485	LB 485				PROJECT NAME: DERBY PROJECT NUMBER: STP 2703(I) FILE NAME: 07D202.dgn PROJECT LEADER: JLL DESIGNED BY: STANTEC IPARM FILE: 07CI94_53.i	PLOT DATE: 29-JAN-2013 09: DRAWN BY: STANTEC CHECKED BY: JLL SHEET 53 OF 62					
FINAL POST LENGTHS ARE TO BE DETERMINED IN THE FIELD. POST SIZES ARE COMPUTED BASED ON INFORMATION FURNISHED ON THE STANDARD SHEETS AND THE VTRANS "SIGN POST DESIGN GUIDELINE."					TOTALS	SF 245	SF 16	EA 16	SF		FT	FT 485				LB			EA	LB				EA	EA	LB											

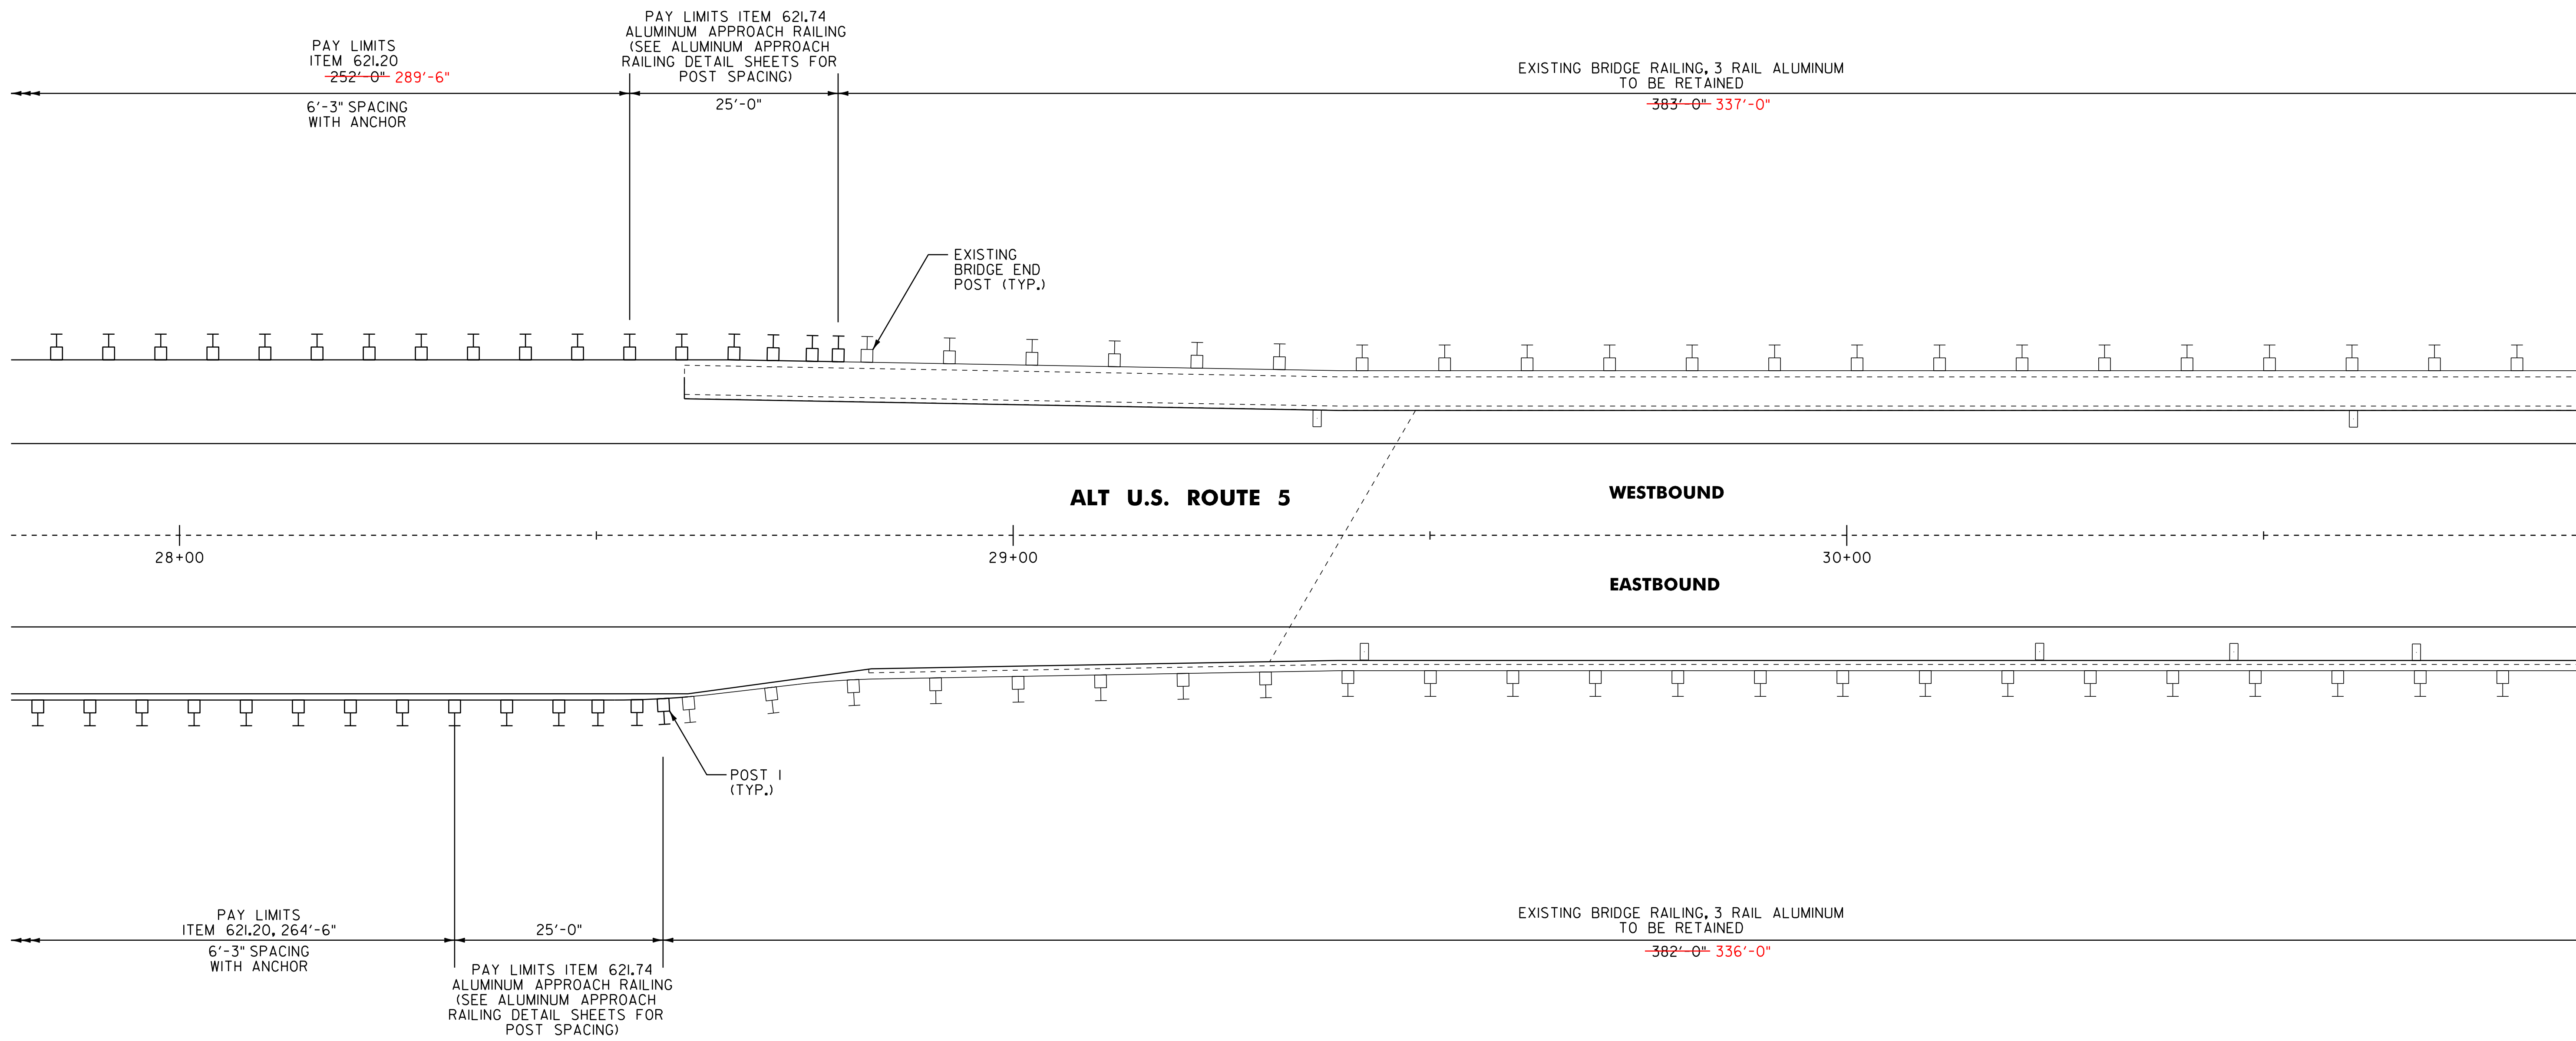


BR 114 ALT. U.S. ROUTE 5 MM 0.584 = STA. 30+86

NOT TO SCALE	
BRIDGE DETAIL SHEET NO. 1	PROJECT NAME: DERBY
	PROJECT NUMBER: STP 2703(I)
	FILE NAME: 07D202.dgn
	PLOT DATE: 29-JAN-2013 09:2
DESIGNED BY: STANTEC	
DRAWN BY: STANTEC	
IPARM FILE: 07C194_54.i	
CHECKED BY: JLL	
SHEET 54 OF 62	

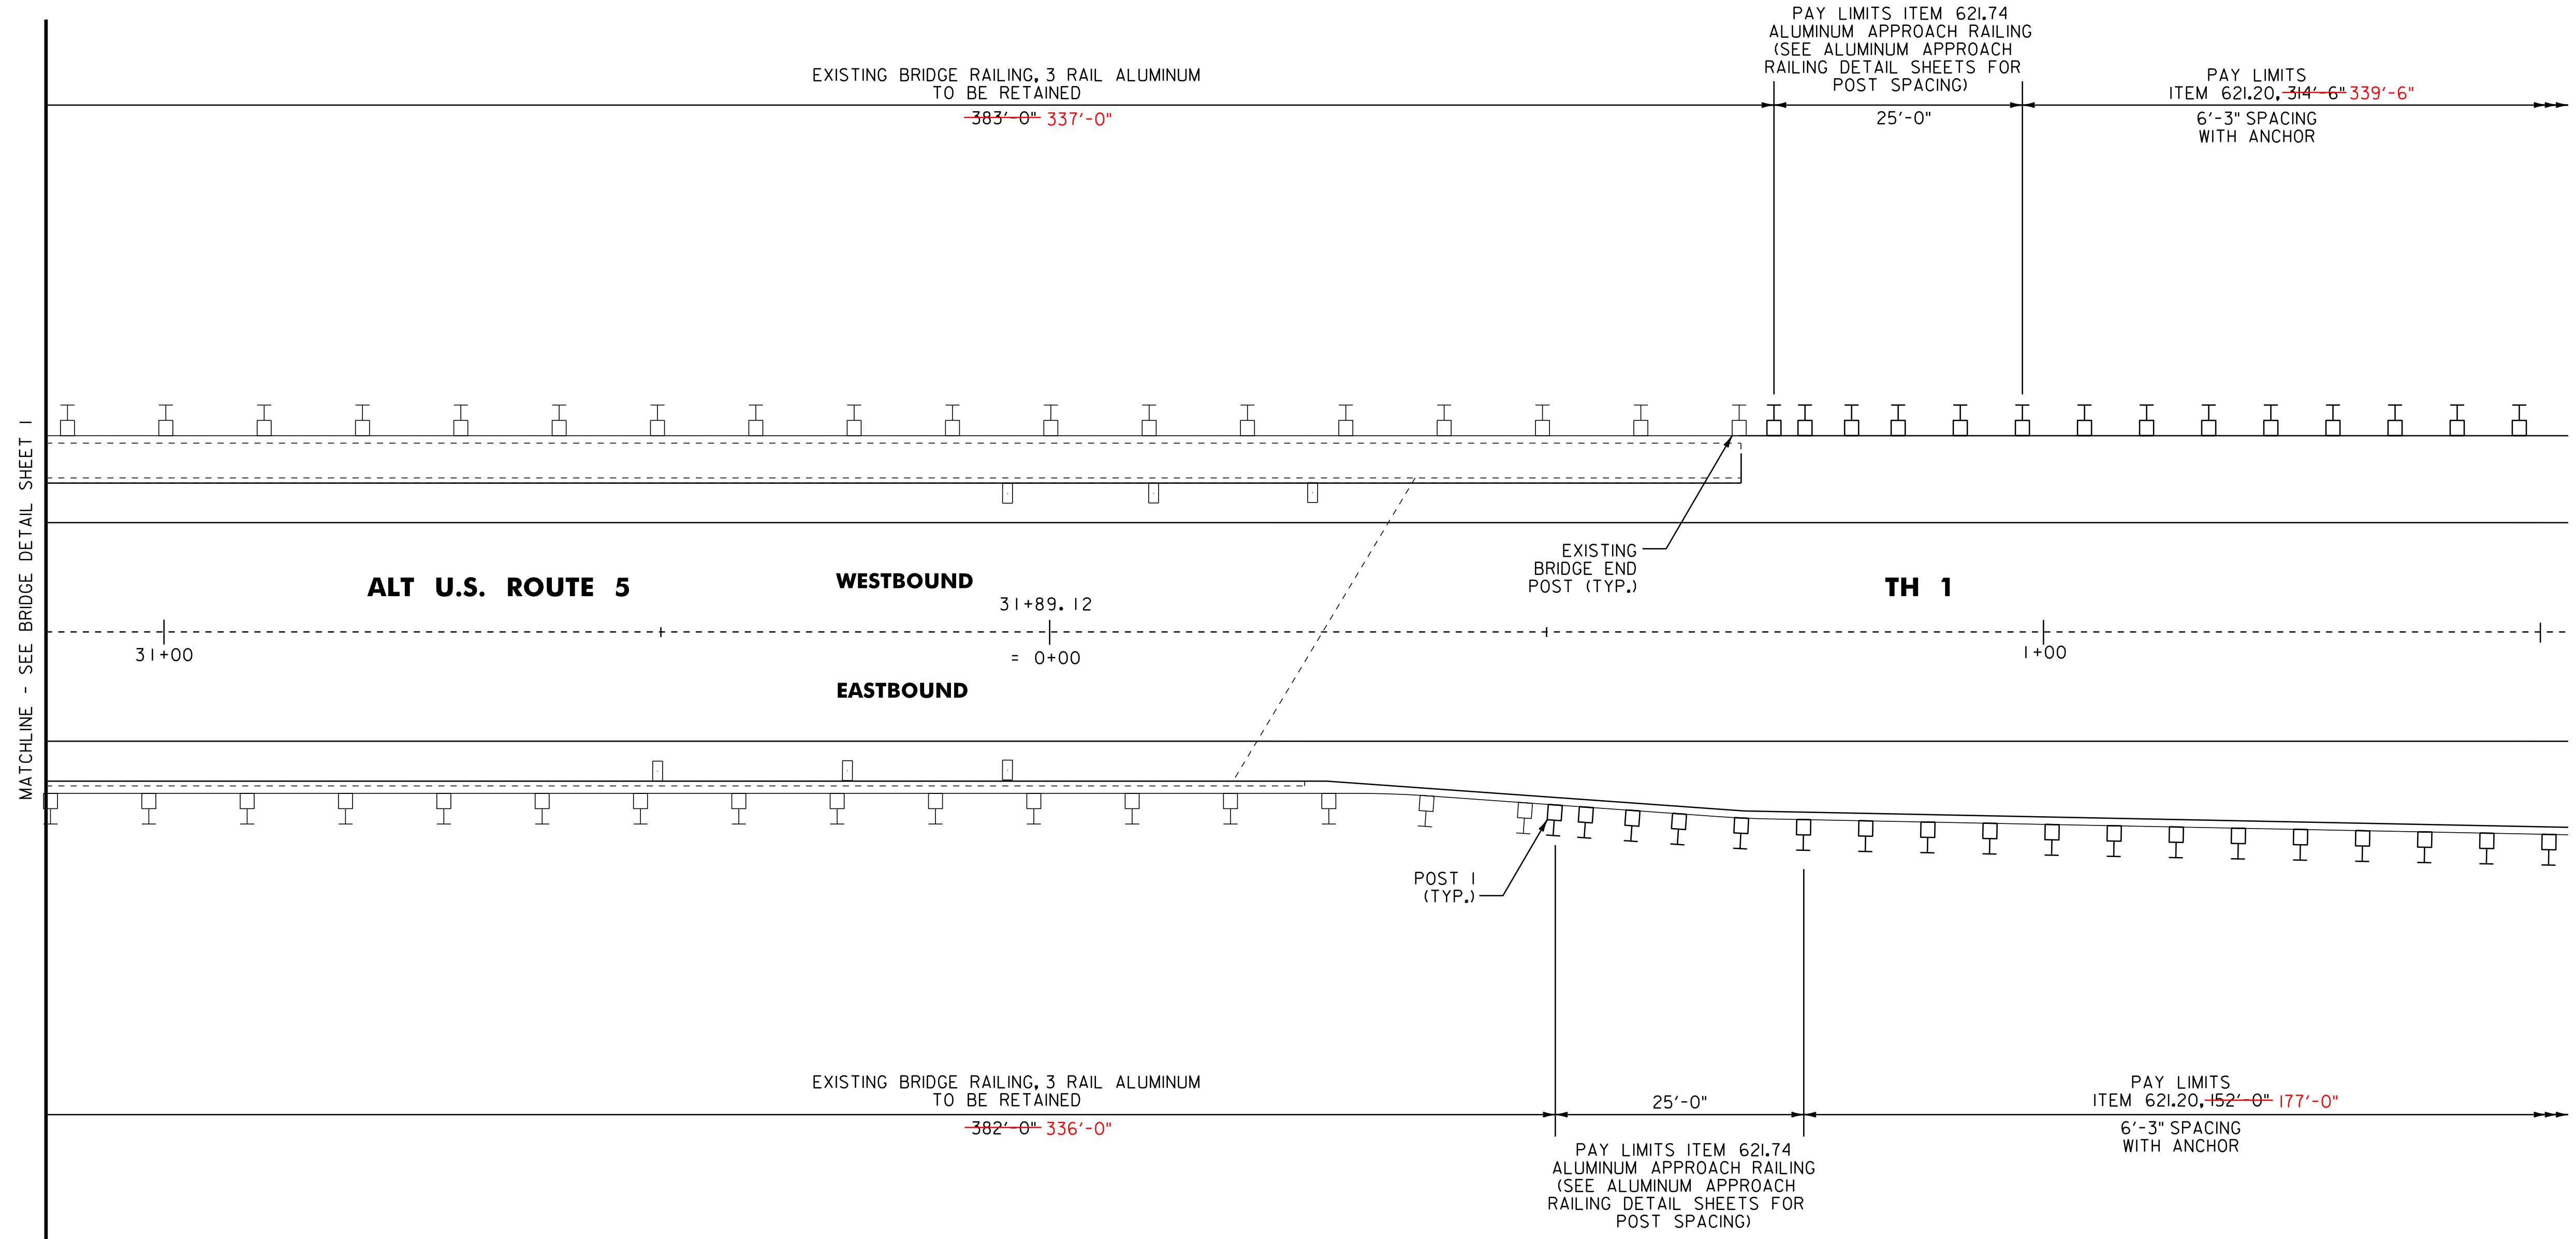


BR 114 ALT. U.S. ROUTE 5 MM 0.584 = STA. 30+86

NOT TO SCALE	
BRIDGE DETAIL SHEET NO. 2	PROJECT NAME: DERBY
	PROJECT NUMBER: STP 2703(1)
	FILE NAME: 07D202.dgn
	PLOT DATE: 29-JAN-2013 09:2
PROJECT LEADER: JLL	
DESIGNED BY: STANTEC	
IPARM FILE: 07C194_55.i	
DRAWN BY: STANTEC	
CHECKED BY: JLL	
SHEET 55 OF 62	

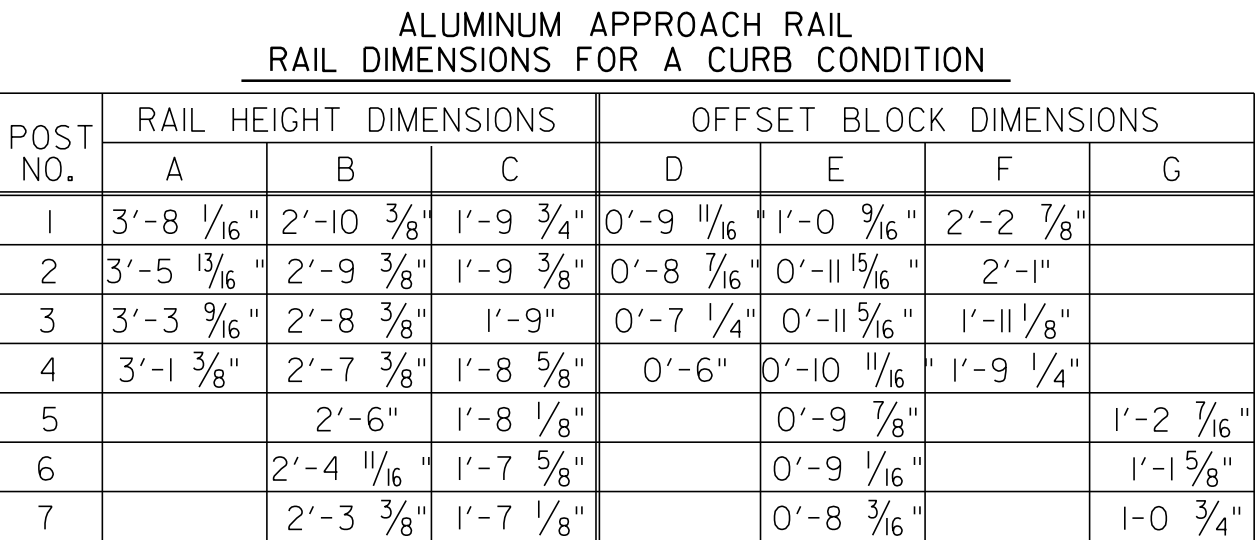


NOTES

1. POST 1 THROUGH 7 SHALL BE EXTRUDED ALUMINUM.
2. ALL STRUCTURAL STEEL SHALL BE AASHTO M270M/M270 GRADE 36 GALVANIZED AFTER FABRICATION.
3. ALL ITEMS NOT OTHERWISE INDICATED SHALL MEET THE SPECIFICATION REQUIREMENTS OF THE STANDARD SHEETS ON WHICH THEY ARE DETAILED.
4. SEE STANDARD G-1 FOR STEEL BEAM GUARD RAIL DETAILS. SEE THIS SHEET AND THE NEXT SHEET FOR ALUMINUM BRIDGE RAILING DETAILS.
5. THE COST OF ALL MATERIALS AND LABOR FOR THE SPLICE BETWEEN THE ALUMINUM APPROACH RAILING AND THE STEEL BEAM GUARD RAIL SHALL BE INCLUDED IN THE UNIT PRICE BID FOR ITEM 621.74, ALUMINUM APPROACH RAILING.
6. DETAILS ARE SHOWN FOR TRANSITION TO A 3 RAIL ALUMINUM BRIDGE RAILING.
7. DIMENSIONS SHOWN ARE FROM A REFERENCE LINE AT THE FACE OF POST FOR A NORMAL CROWNED SECTION. APPROPRIATE CORRECTIONS SHALL BE MADE FOR CROSS SLOPES OTHER THAN A NORMAL SECTION.

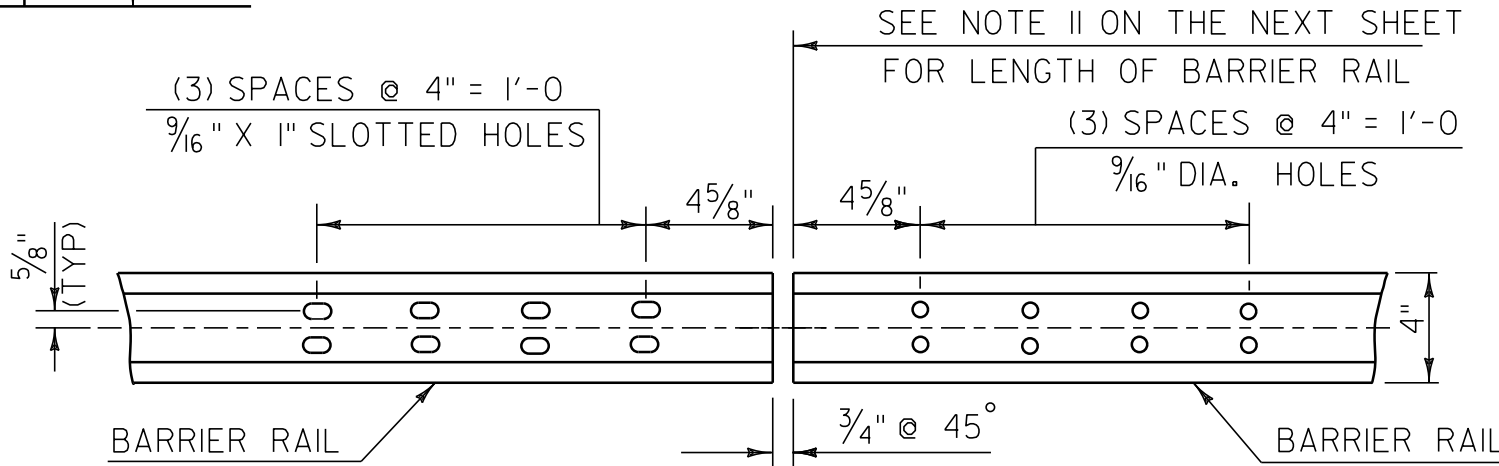


ELEVATION OF BARRIER RAIL (FROM BACK)
AT ALL INTERMEDIATE RAIL SPLICES


	SIDEWALK SIDE	CURB SIDE
"X"		11/16 "
"Y"		5/16 "
"Z"		1/8 "

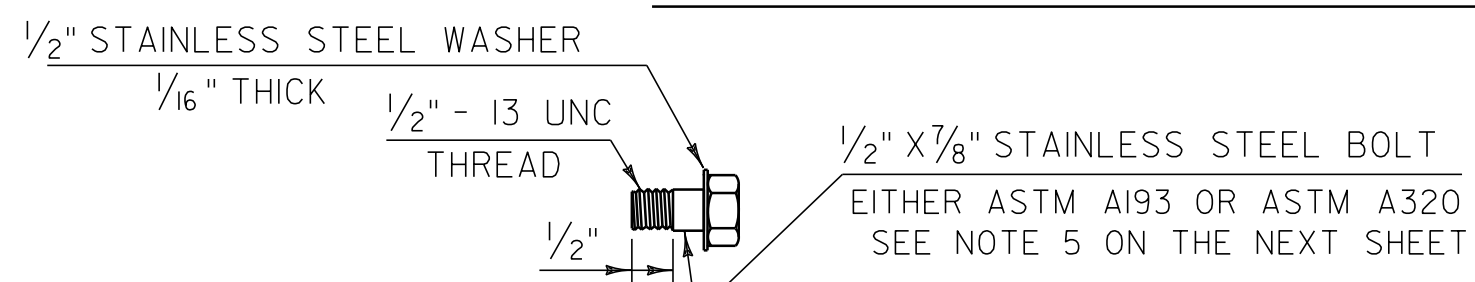

STAINLESS STEEL BOLT DETAILS

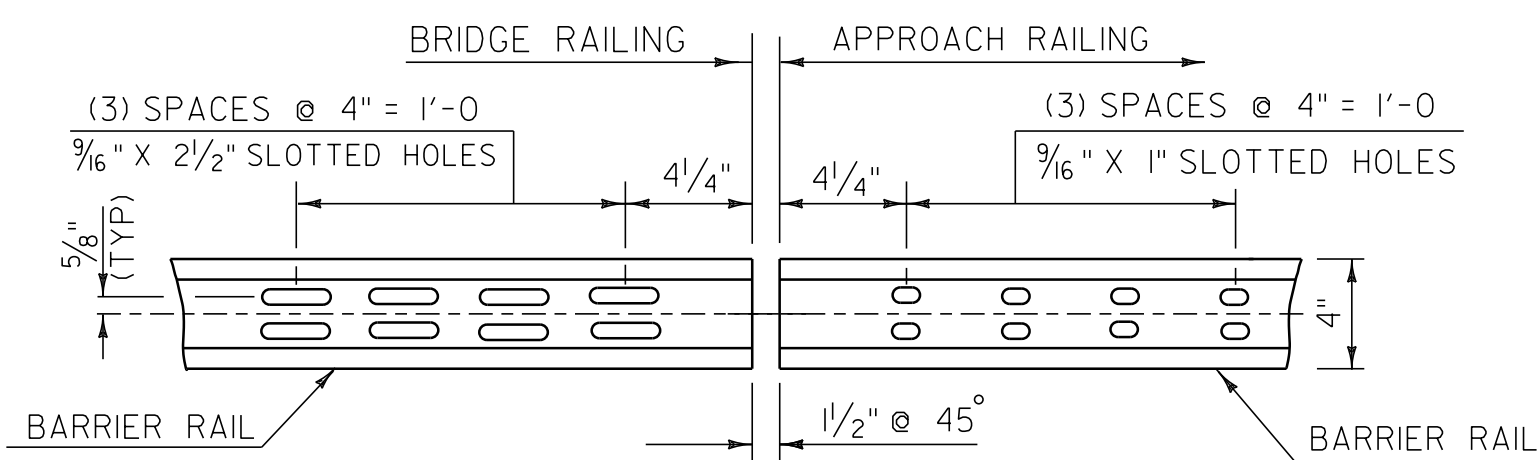

ELEVATION OF BARRIER RAIL (FROM BACK)

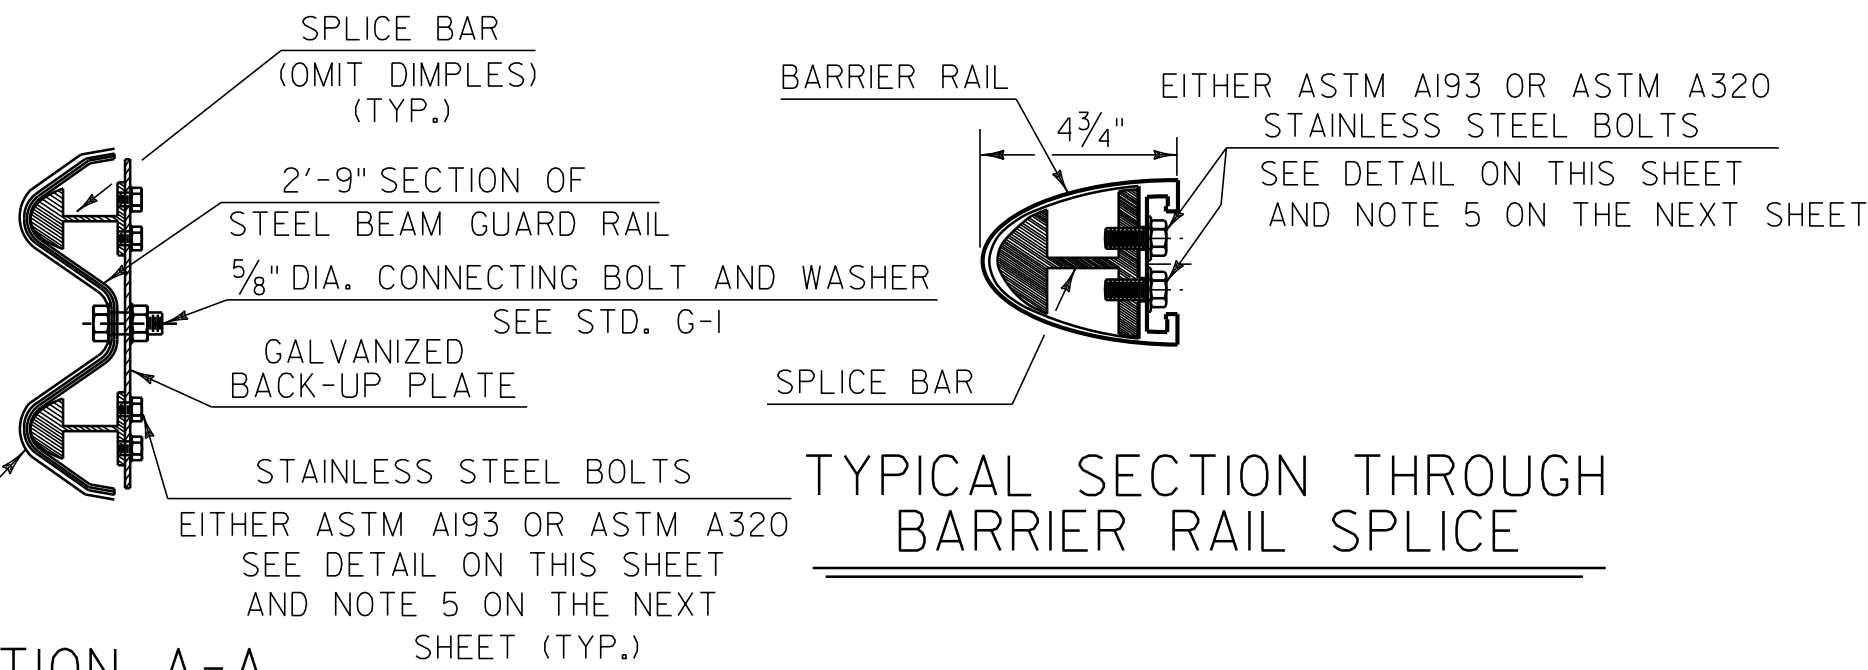

















TYPICAL SECTION THROUGH BARRIER RAIL SPLICE

SECTION A-A

BRIDGE 114

ALUMINUM APPROACH RAILING DETAIL SHEET 1

PROJECT NAME: DERBY	
PROJECT NUMBER: STP 2703(I)	
FILE NAME: 07D202.dgn	PLOT DATE: 29-JAN-2013 09:
PROJECT LEADER: JLL	DRAWN BY: STANTEC
DESIGNED BY: STANTEC	CHECKED BY: JLL
IPARM FILE: 07CI94_56.I	SHEET 56 OF 62

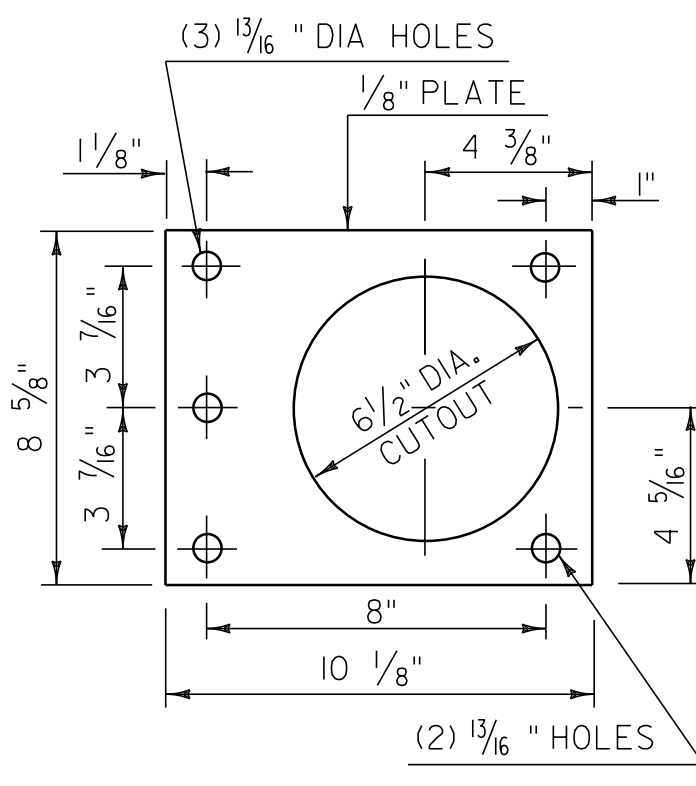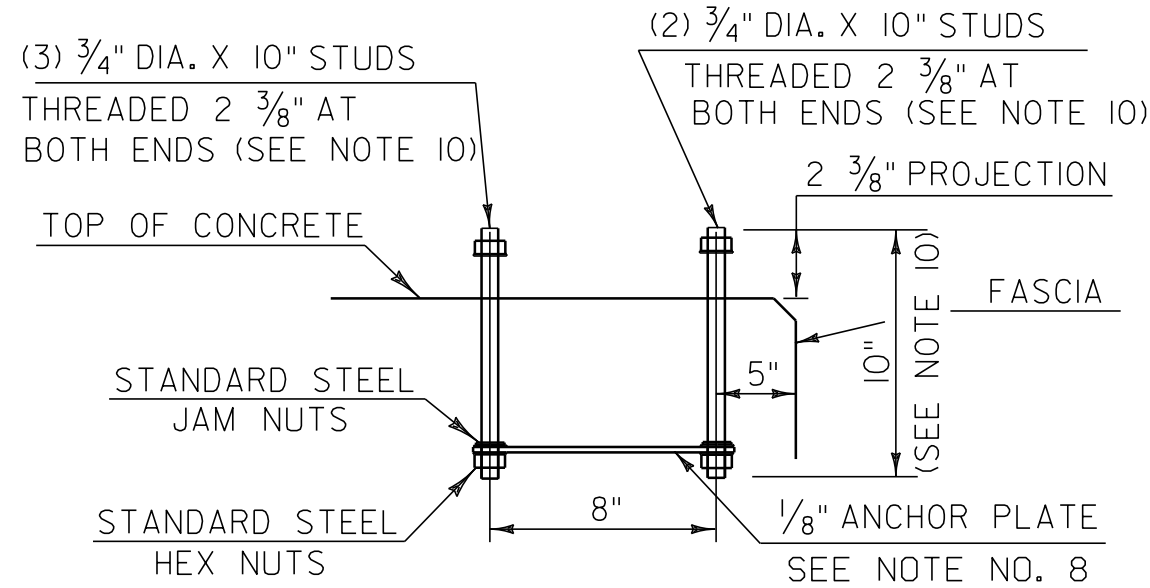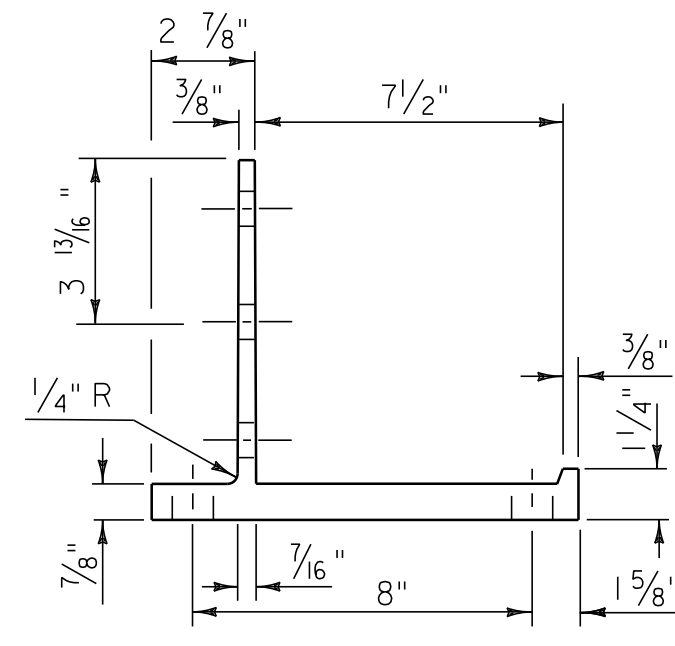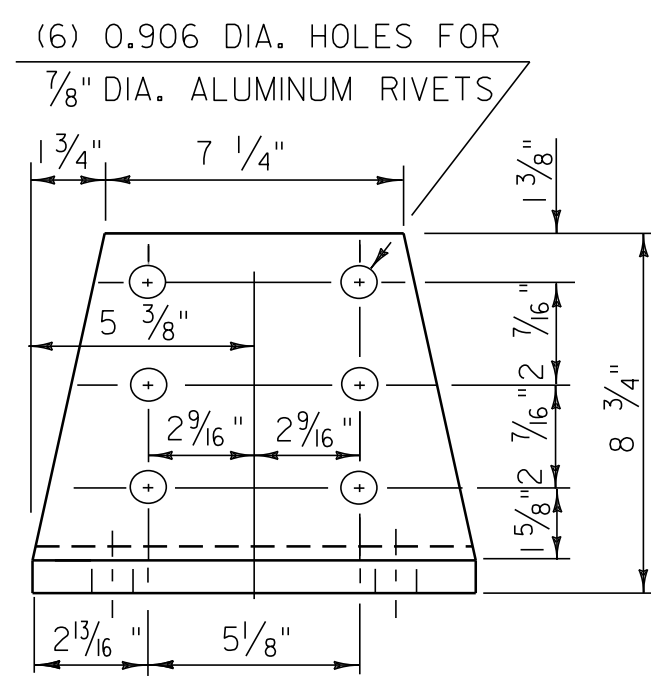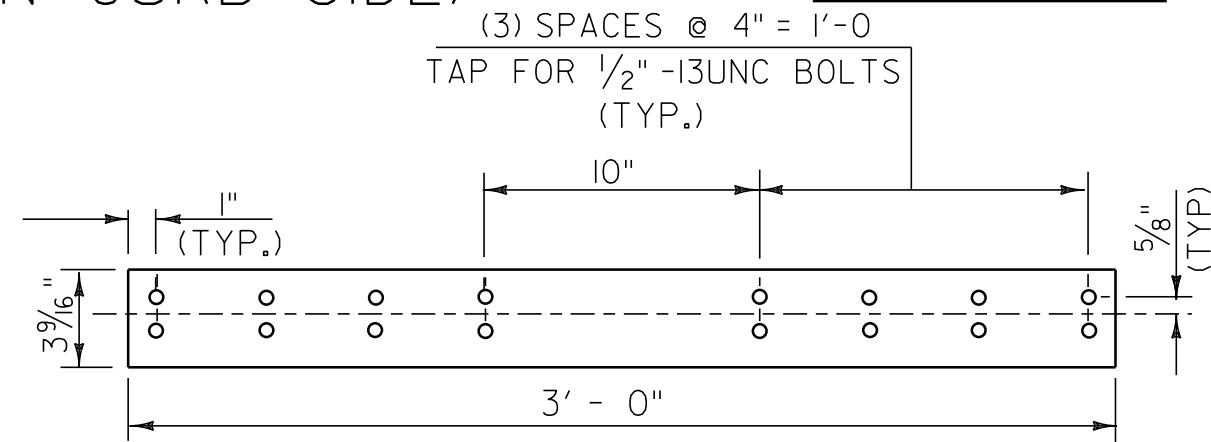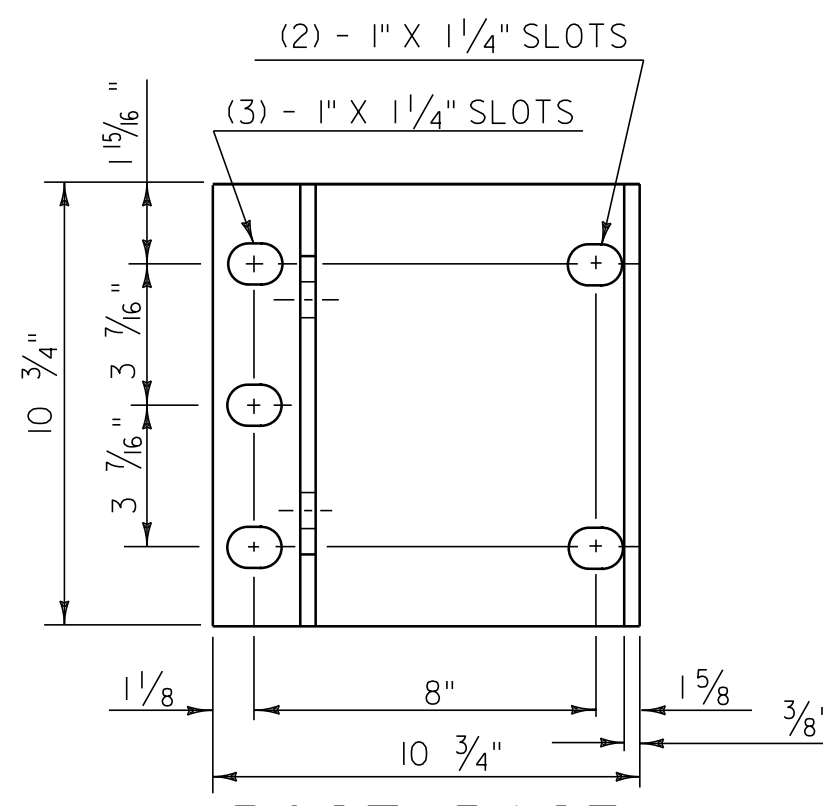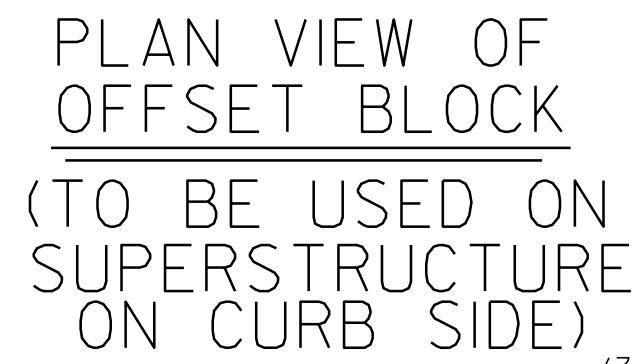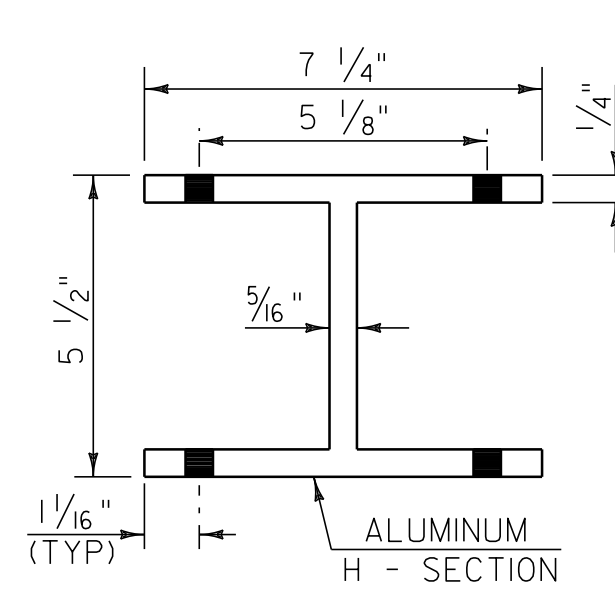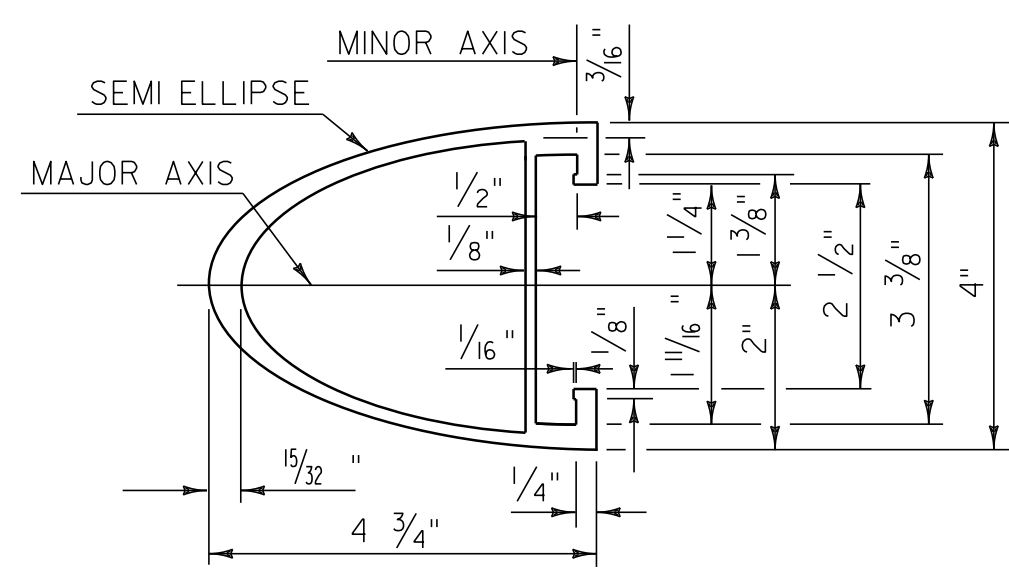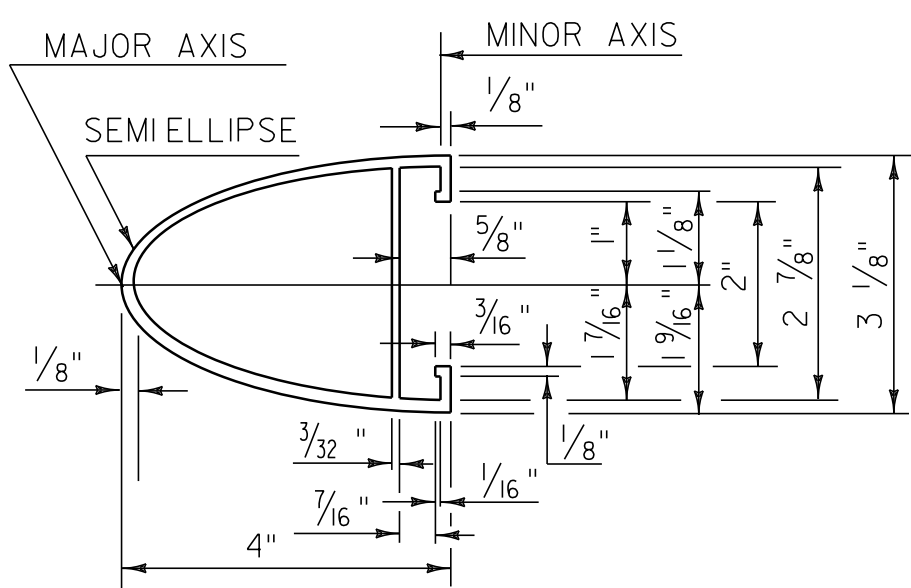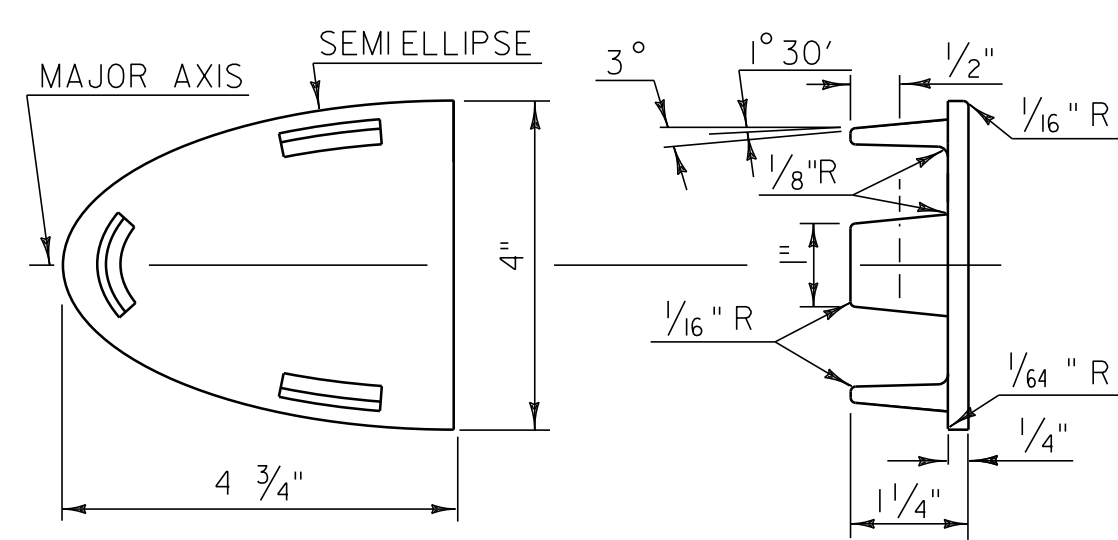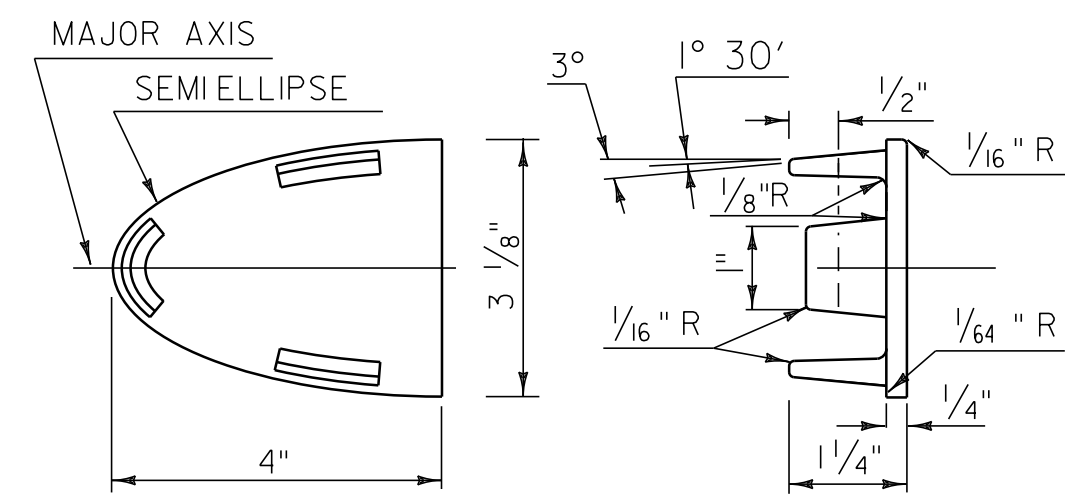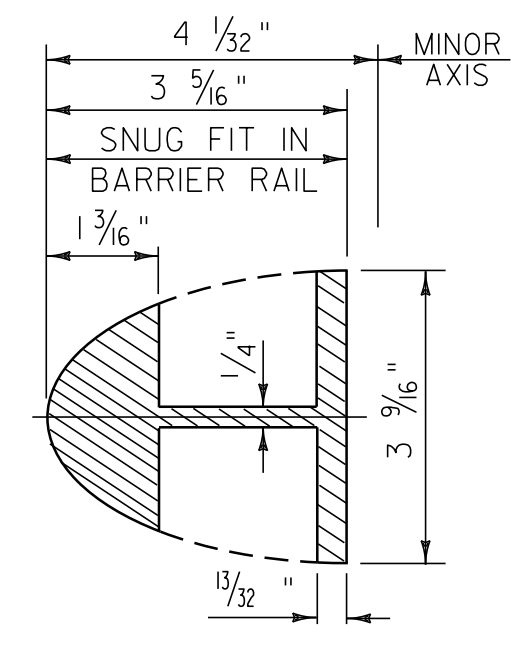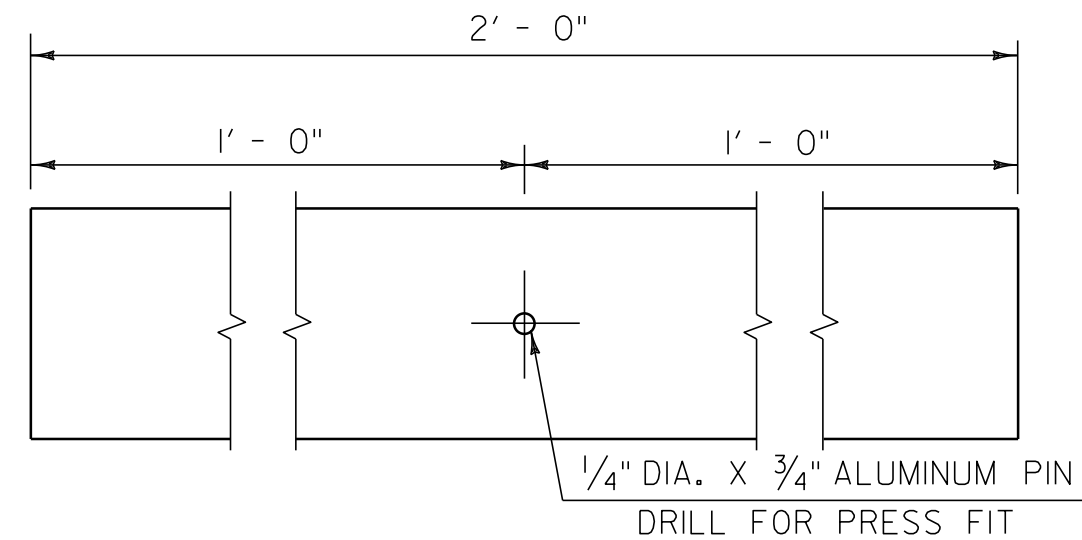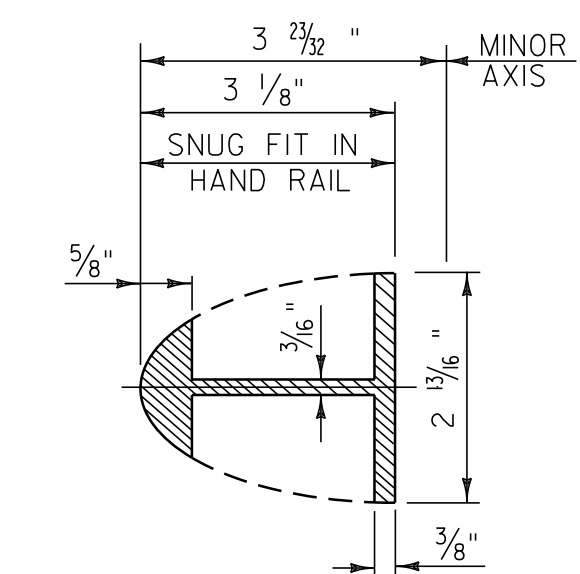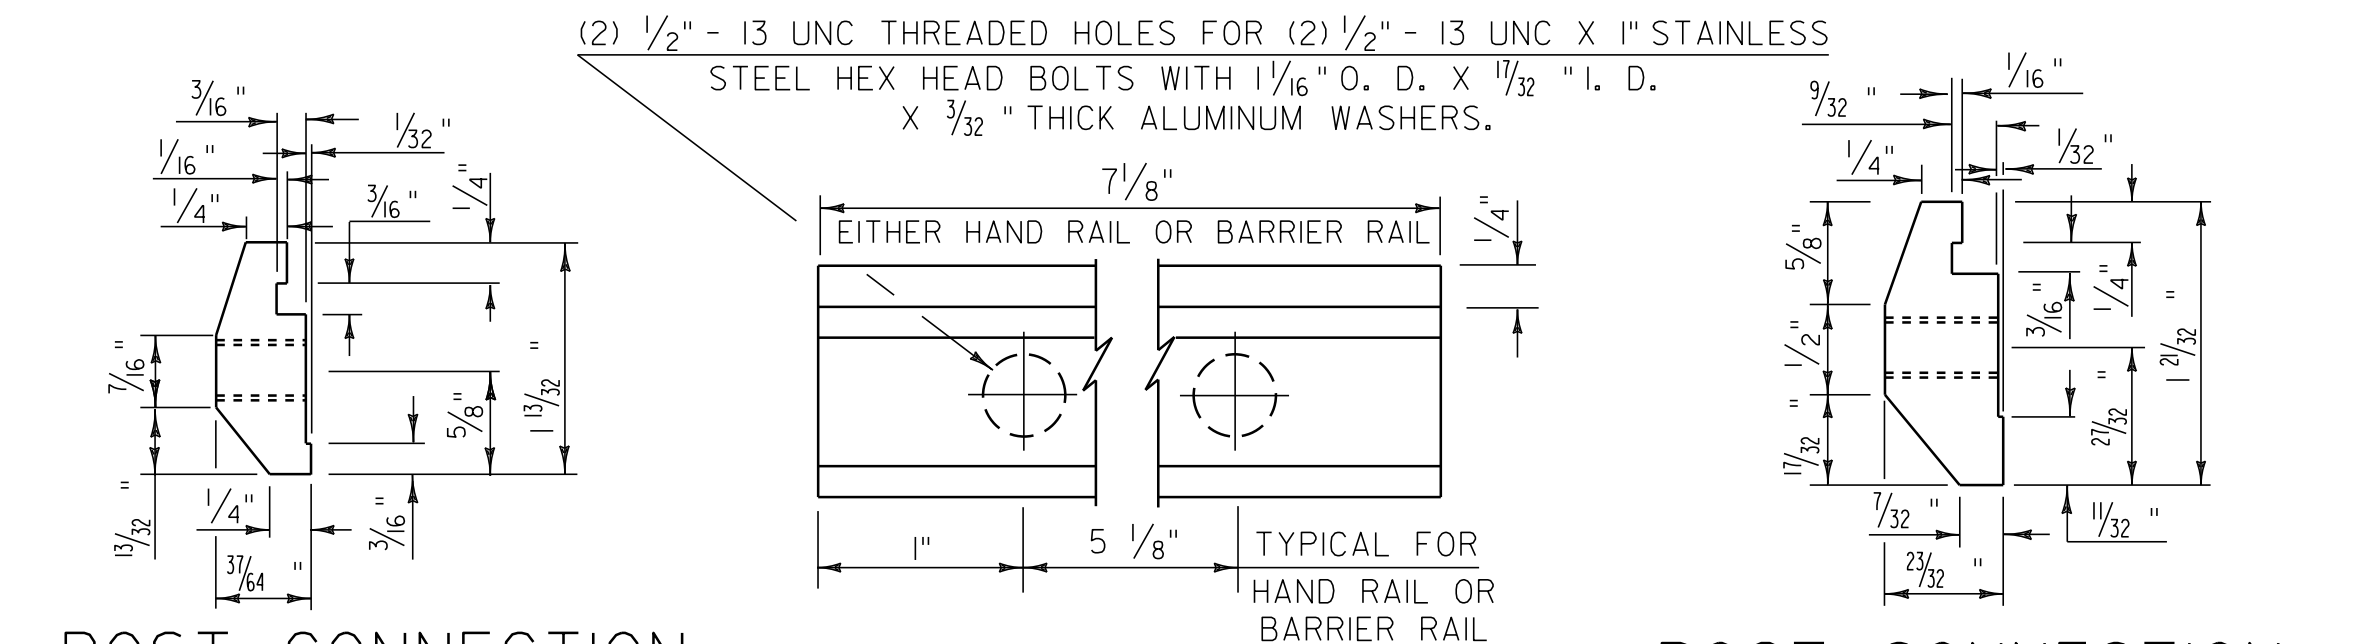


NOTES

- A. ASTM A449 GALVANIZED, OR
 - B. AASHTO M164 (ASTM A325) GALVANIZED
 - C. BOLTS AND WASHERS OF STAINLESS STEEL ASTM A276, TYPE 304 (MINIMUM ULTIMATE STRENGTH OF 100,000 PSI) WITH STAINLESS STEEL NUTS OF ASTM A194, GRADE 8NA.
2. ALUMINUM POSTS, POST BASES, SPLICE BARS, CONNECTION BARS, RAILS AND BALUSTER FRAMES SHALL CONFORM TO ASTM B221 ALLOY 6061-T6 OR ALLOY 6351-T5. MINIMUM ALLOWABLE STRESS $F_y = 35,000$ PSI.
 3. ALUMINUM BALUSTER TUBES SHALL CONFORM TO ASTM B210 ALLOY 6061-T5 OR 6063-T5.
 4. ALUMINUM RAIL END CAPS SHALL CONFORM TO ASTM B26 ALLOY 356-T6.
 5. THE POST, RAIL, AND OFFSET BLOCK CONNECTION BOLTS SHALL BE EITHER ASTM A193 OR ASTM A320. EITHER ONE SHALL BE CLASS 1, B8 GRADE AISI 304 WITH AN ULTIMATE TENSILE STRENGTH OF 75,000 PSI. NUTS FOR EITHER OF THE ABOVE BOLTS SHALL BE ASTM A194, GRADE 8, STAINLESS STEEL WITH AN ULTIMATE TENSILE STRENGTH OF 75,000 PSI.
 6. SET SCREWS FOR ATTACHING BALUSTERS TO RAILING SHALL BE ASTM F880, TYPE 303 MATERIAL.
 7. RIVETS SHALL BE COLD DRIVEN HIGH BUTTON HEAD "CONE POINT", CONFORMING TO ASTM B316 ALLOY 6061-T6.
 8. THE ANCHOR PLATE FOR THE POST ANCHOR ASSEMBLY SHALL BE ASTM A36 STRUCTURAL STEEL.
 9. WELDING SHALL CONFORM TO THE REQUIREMENTS OF SUBSECTION 506.10 USING THE GMAW-INERT GAS PROCESS AND AWS ER 5356 ELECTRODE WIRE.
 10. UNLESS OTHERWISE SPECIFIED, ANCHOR BOLTS SHALL BE CAST INTO THE CONCRETE AS DETAILED.
 11. WHENEVER FEASIBLE BARRIER RAIL AND HAND RAIL SECTIONS, SHALL BE FULL LENGTH SECTIONS ($40' \pm$) AND WHEN POSSIBLE SHALL BE ATTACHED TO THREE POSTS. RAILS SHALL BE SPLICED AT EACH DECK JOINT AND INTERMITTENTLY AS REQUIRED. SPLICES SHALL OCCUR WITHIN THE SAME PANEL.
 12. ENDS OF RAILS SHALL BE CUT SQUARE AND GROUND FREE OF BURRS OR RAGGED EDGES. EXPOSED ENDS SHALL BE CAPPED.
 13. THE CONCRETE CONTACT SURFACE AT THE POST BASE SHALL BE BUSH HAMMERED AND/OR SHIMMED AS REQUIRED FOR PROPER POST ALIGNMENT. POST HEIGHT ADJUSTMENTS LESS THAN 1/4" SHALL BE WITH 1/16" AND 1/8" SHIMS. CORRECTIONS EXCEEDING 1/4" SHALL BE WITH EPOXY MORTAR CONFORMING WITH SECTION 524. FABRIC BEARING PADS AND ANY REQUIRED SHIMS OR EPOXY MORTAR ARE INCLUDED IN THE UNIT PRICE BID FOR THE RAILING.
 14. SHIMS AND 1/8" FABRIC BEARING PADS SHALL BE 10 3/4" SQUARE WITH SLOTTED HOLES SIZED AND LOCATED THE SAME AS THE POST BASE DETAIL. FABRIC BEARING PADS SHALL CONFORM TO SUBSECTION 731.01 OR 731.02, SHIM MATERIAL SHALL BE ASTM B 209 ALLOY 1100-0.
 15. EXTRUDED SECTIONS ARE DETAILED TO COMPLY WITH CURRENT AASHTO-AGC-ARTBA STANDARDS. MINOR VARIATIONS OF THE DETAILS SHOWN MAY BE CONSIDERED PROVIDING THEY DO NOT REDUCE THE STRENGTH CAPACITY OF THE RAIL SYSTEM.
 16. ALUMINUM WASHERS SHALL BE ASTM B209 ALLOY ALCLAD 2024-T4.

BRIDGE 114

ALUMINUM APPROACH RAILING DETAIL SHEET 2


PROJECT NAME: DERBY	
PROJECT NUMBER: STP 2703(1)	
FILE NAME: 07D202.dgn	PLOT DATE: 29-JAN-2013 09:2
PROJECT LEADER: JLL	DRAWN BY: STANTEC
DESIGNED BY: STANTEC	CHECKED BY: JLL
IPARM FILE: 07CI94_57.I	SHEET 57 OF 62

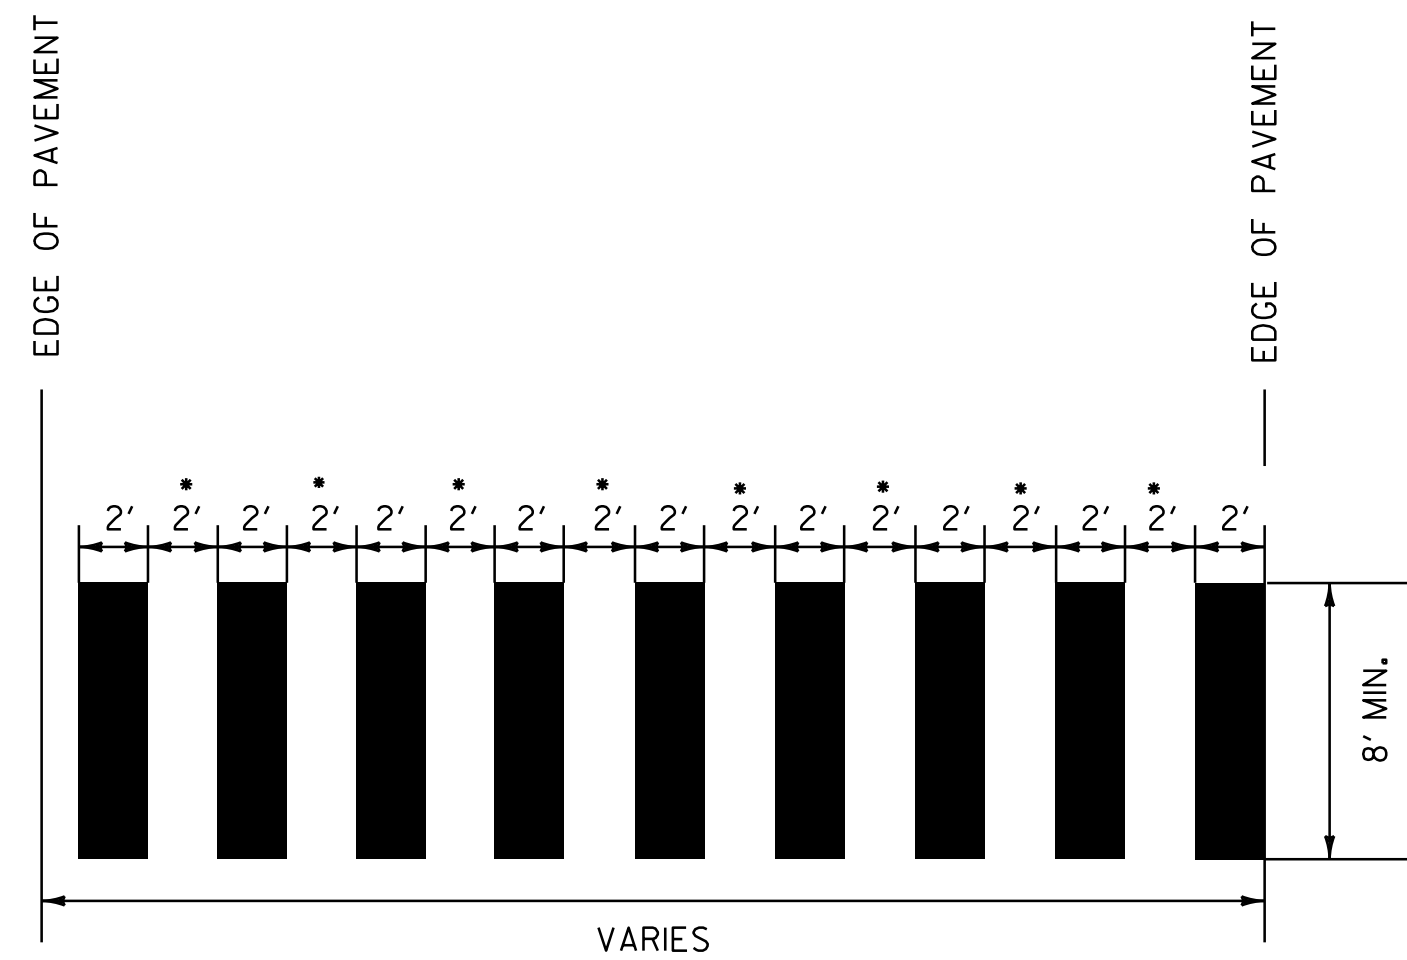

- ADJUST SPACING (12"-24") TO AVOID WHEEL PATHS


BLOCK PATTERN CROSSWALK DETAIL

SEE LAYOUT SHEETS FOR LOCATIONS.
ALL BLOCK PATTERN CROSS WALKS SHALL BE
INSTALLED PARALLEL WITH WHEEL PATHS.

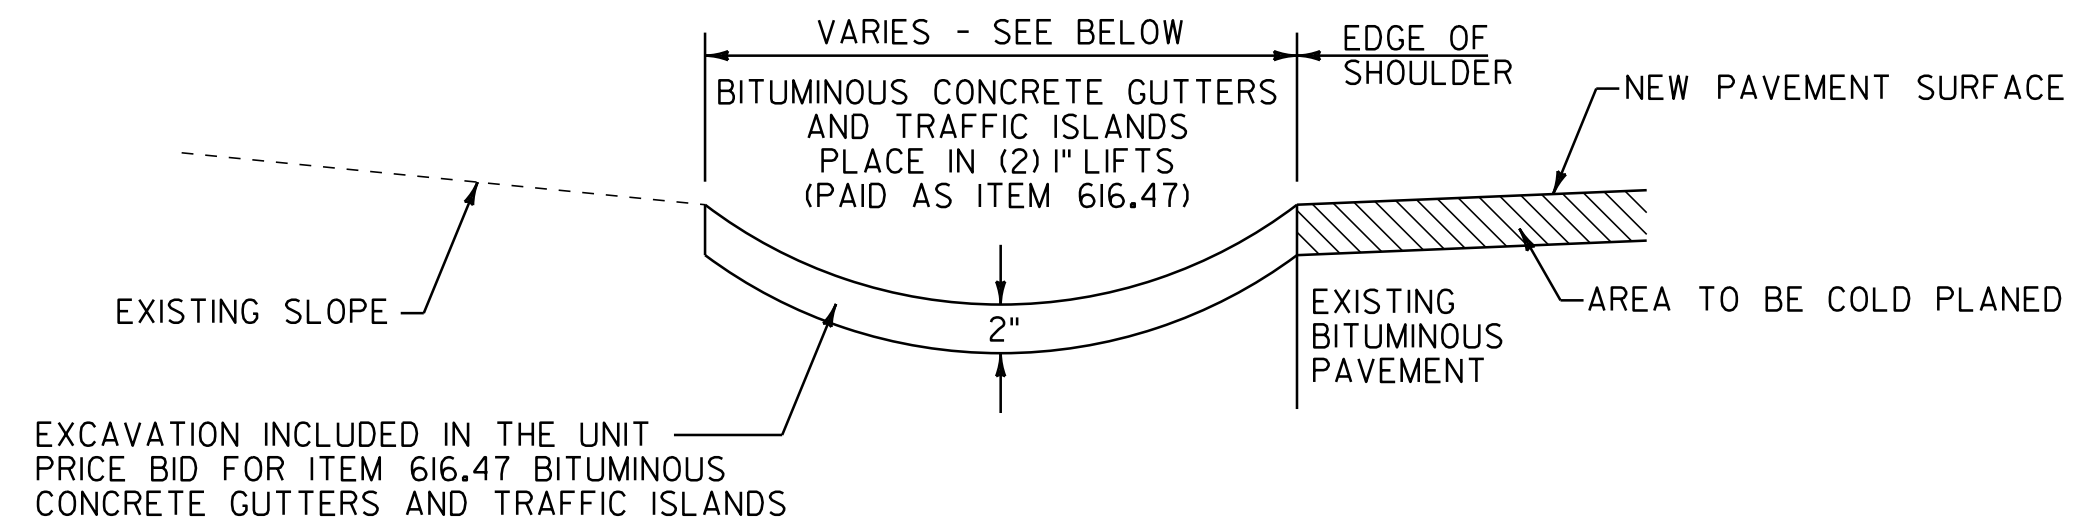


BITUMINOUS CONCRETE GUTTER DETAIL


ALT. U.S. ROUTE 5 STA. 8+95 TO 9+74, LT (4' WIDE)

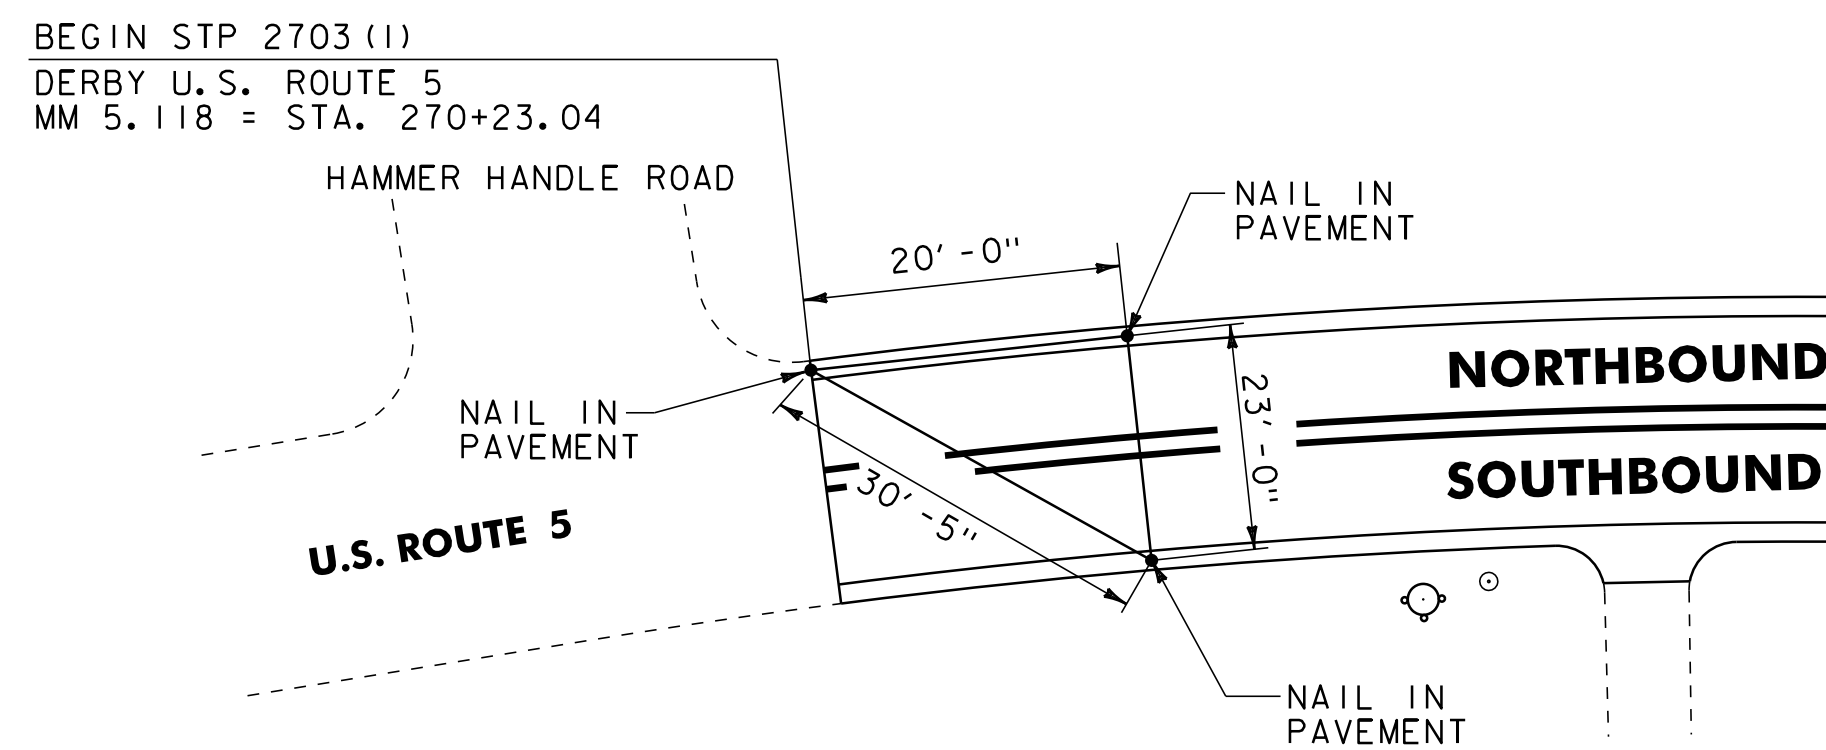

U.S. ROUTE 5 BEGIN PROJECT LOCATION TIES

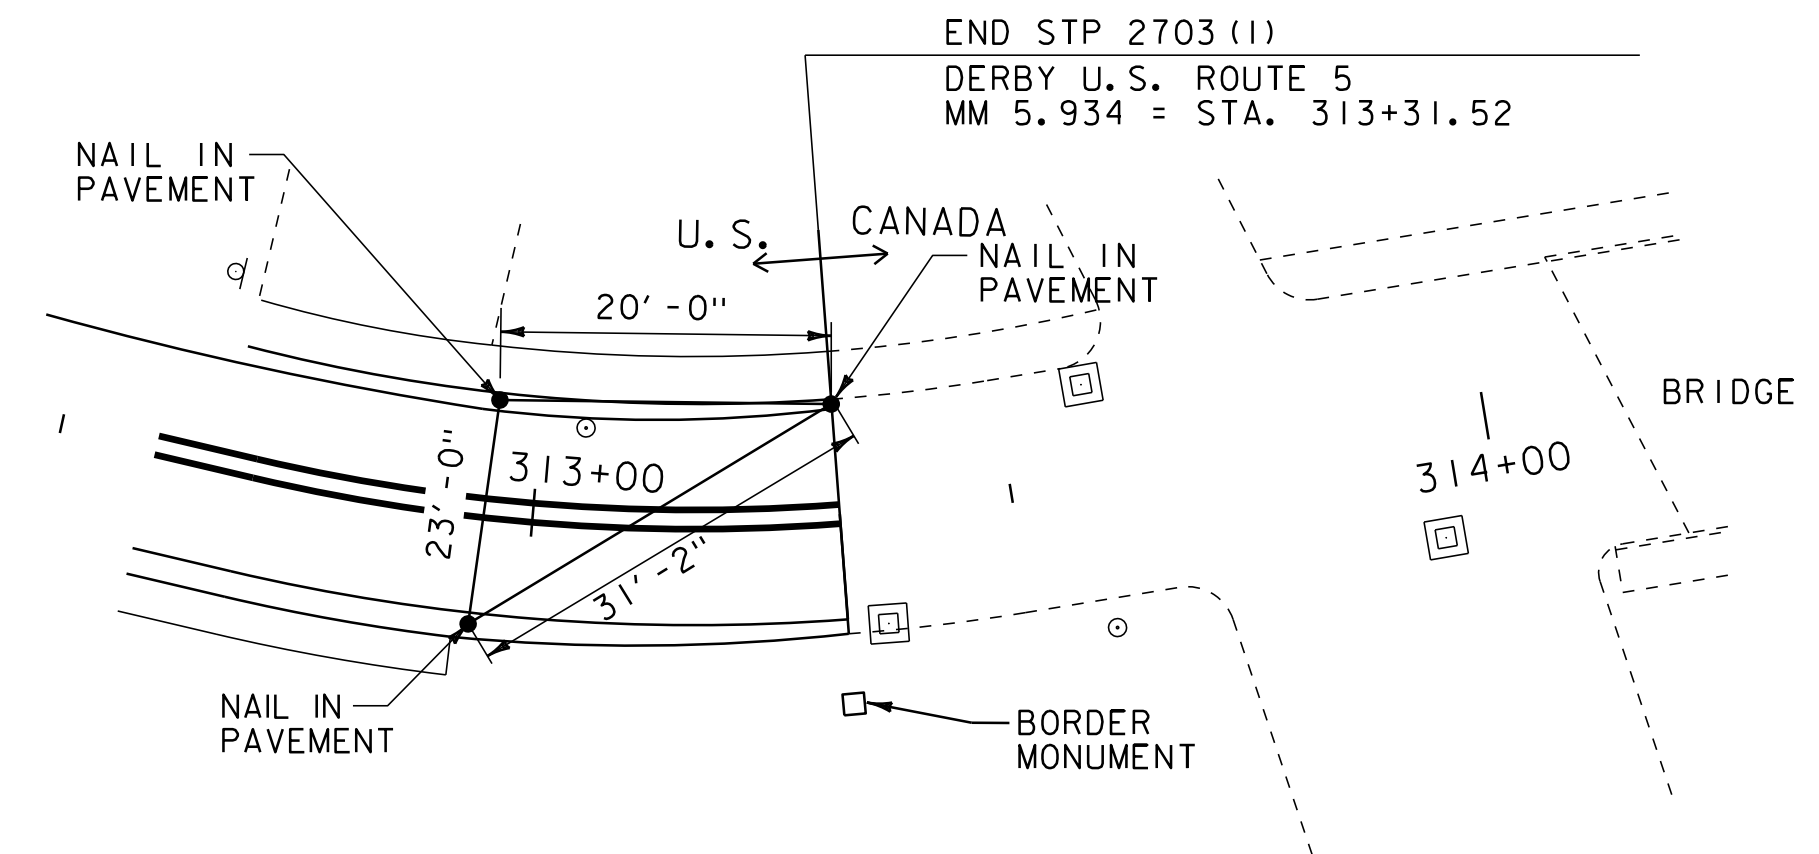

U.S. ROUTE 5 END PROJECT LOCATION TIES

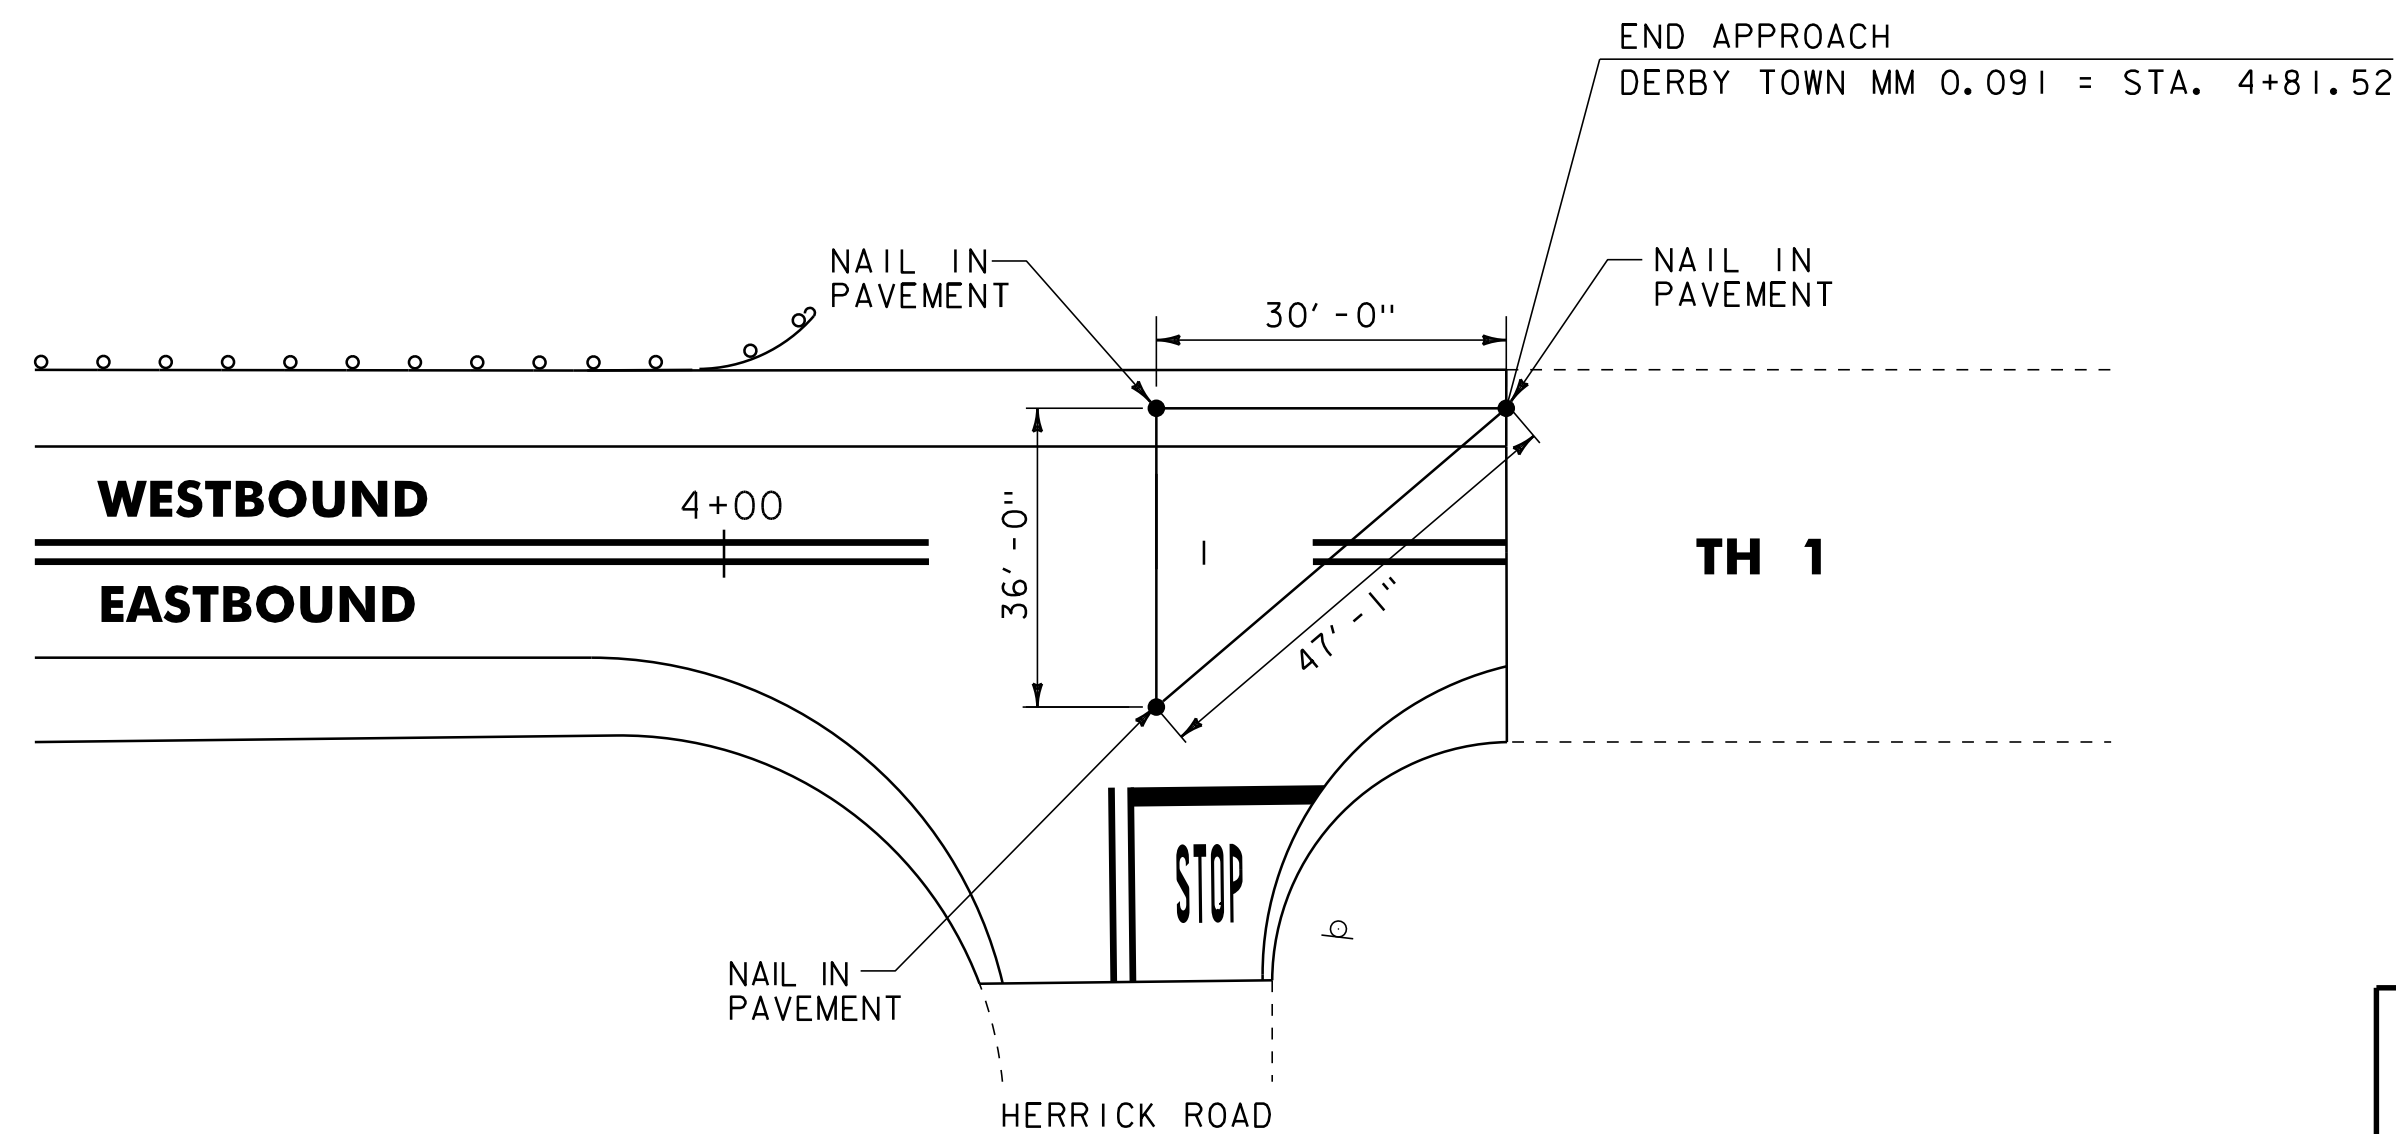

TH 1 END APPROACH LOCATION TIES


NOT TO SCALE

**MISCELLANEOUS
DETAIL
SHEET**


PROJECT NAME: DERBY
PROJECT NUMBER: STP 2703(1)

FILE NAME: 07D202.dgn
PROJECT LEADER: JLL
DESIGNED BY: STANTEC
IPARM FILE: 07C194_58.i


PLOT DATE: 29-JAN-2013 09:2
DRAWN BY: STANTEC
CHECKED BY: JLL
SHEET 58 OF 62

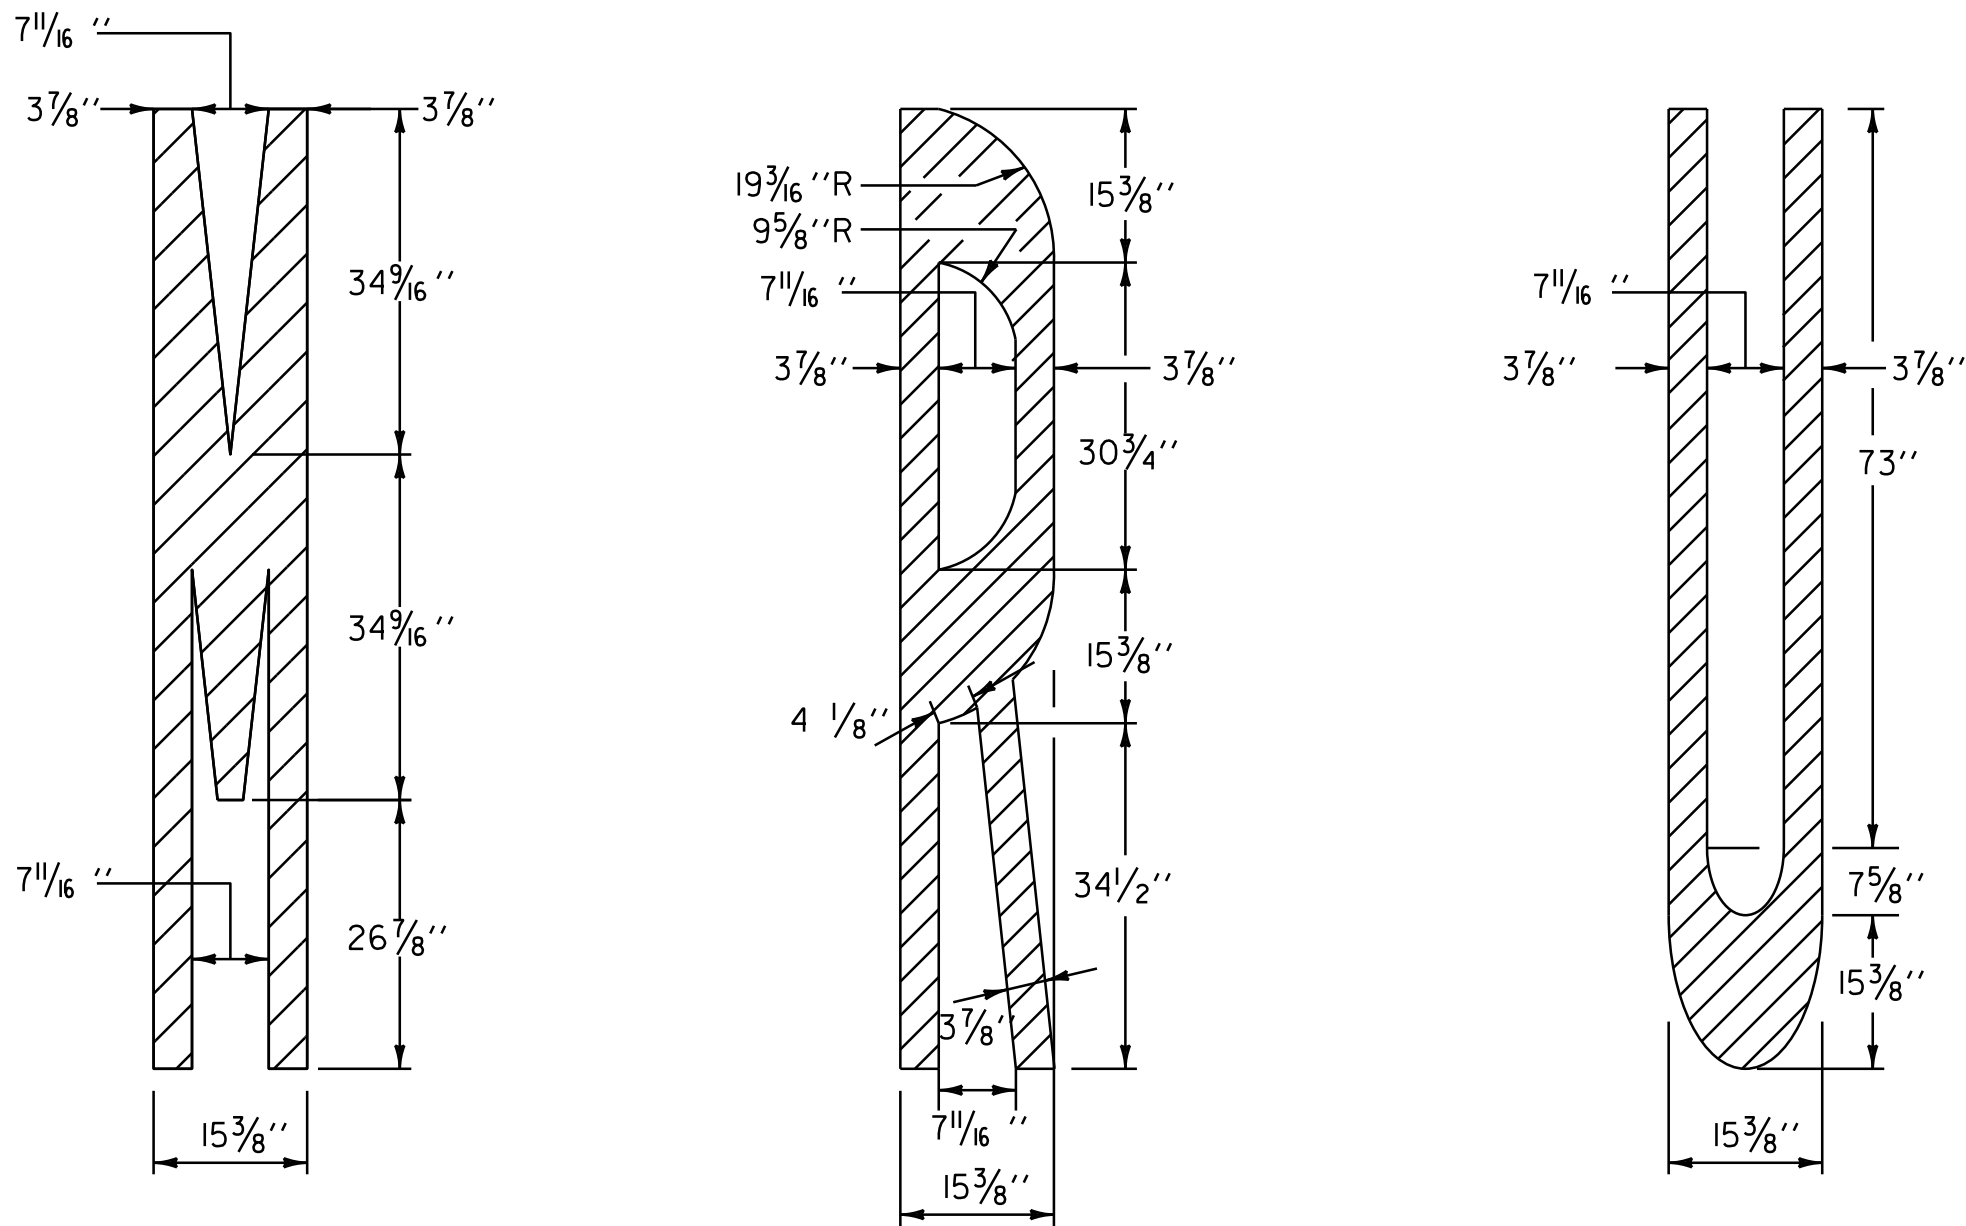

PAVEMENT MARKING LETTER DETAILS
SEE VAOT STANDARD E-191 FOR MORE INFORMATION

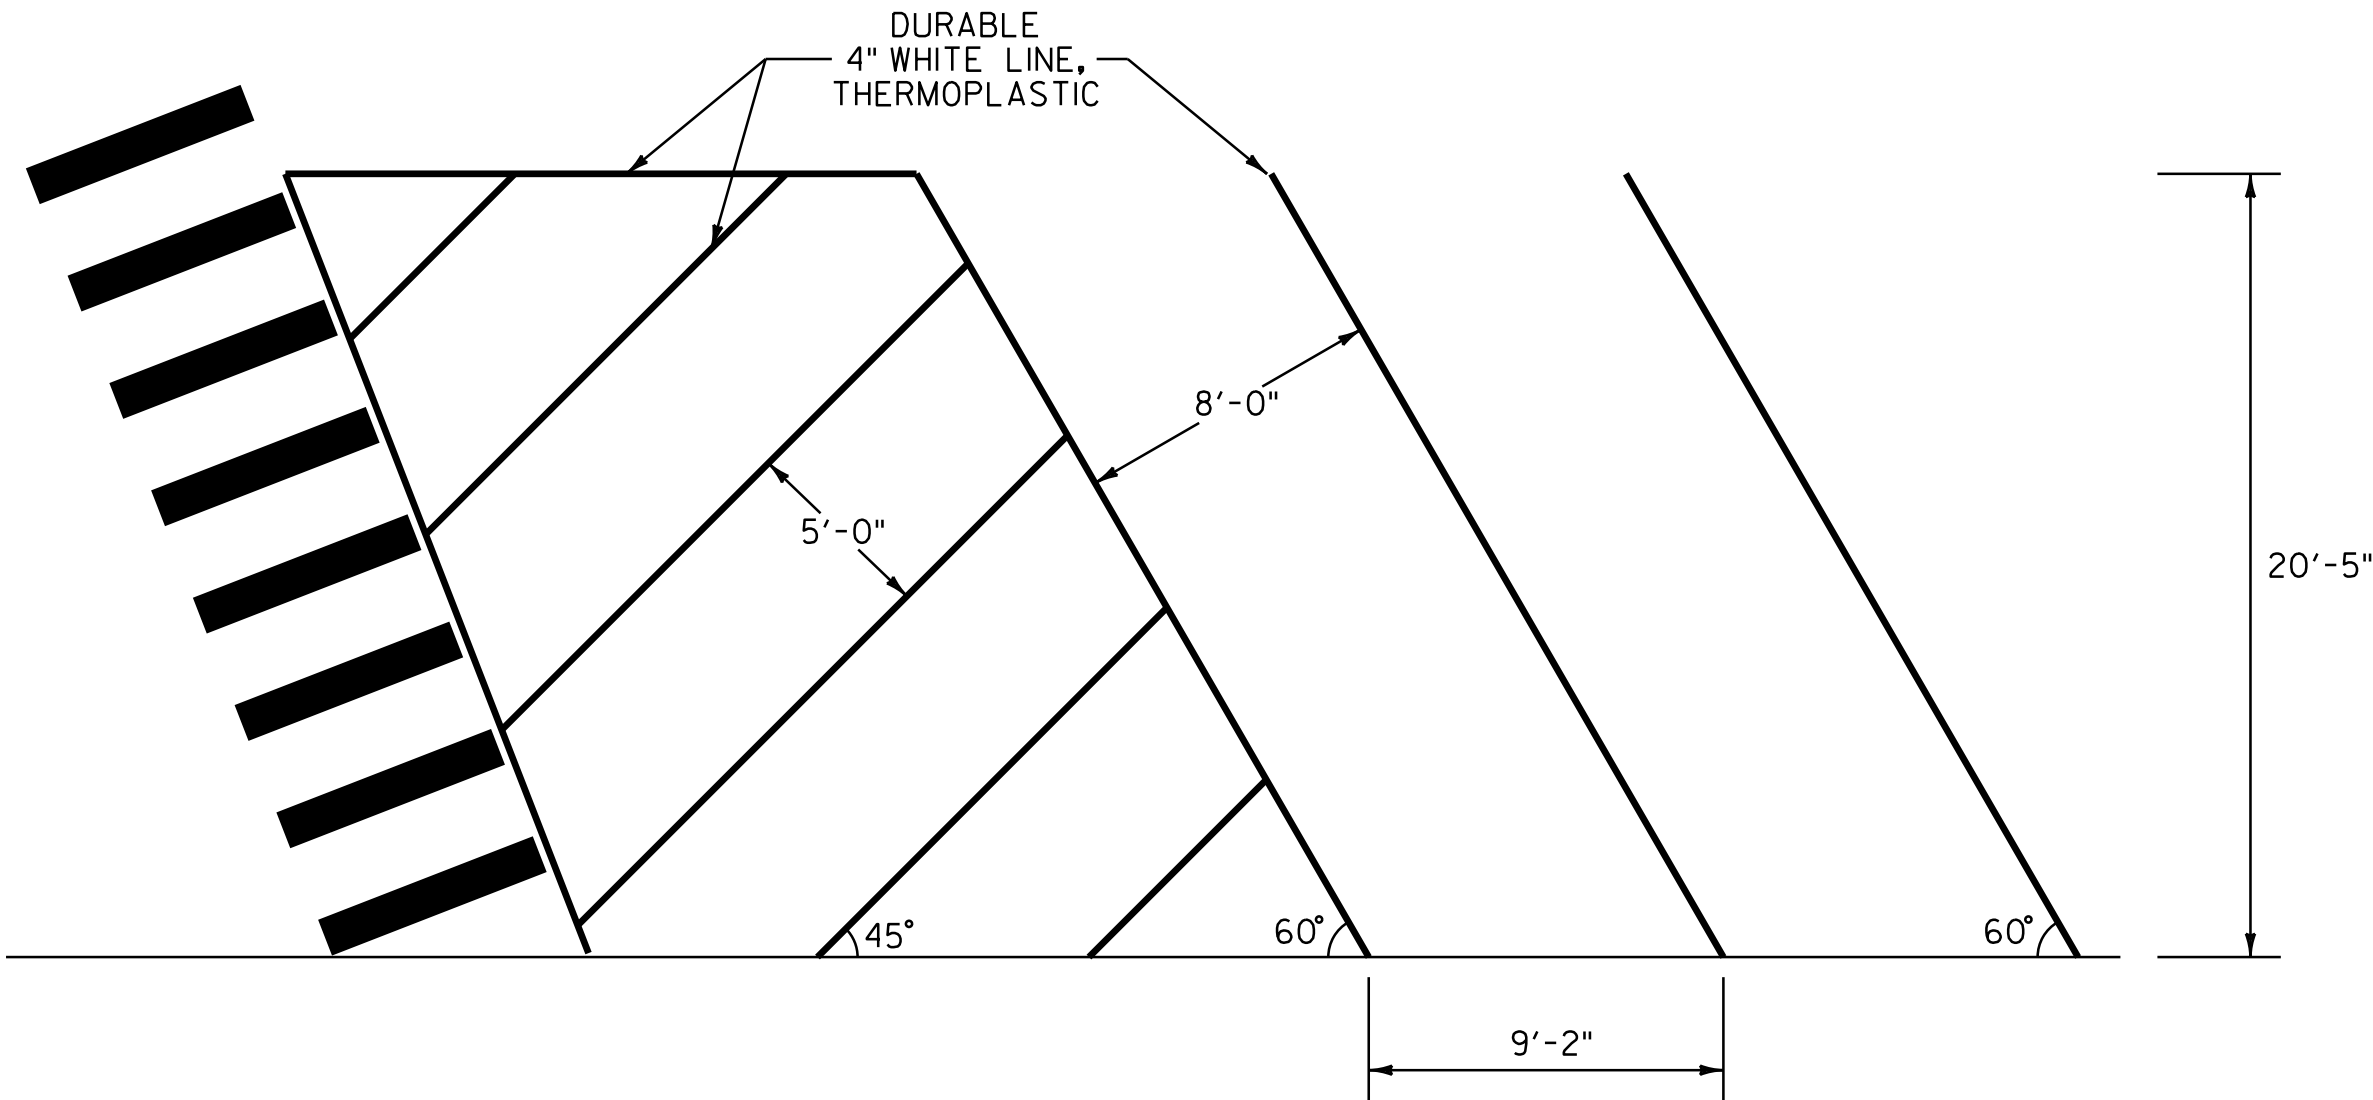


TYPICAL ANGLED PARKING PAVEMENT MARKING DETAIL
SEE LAYOUT SHEETS FOR LOCATIONS

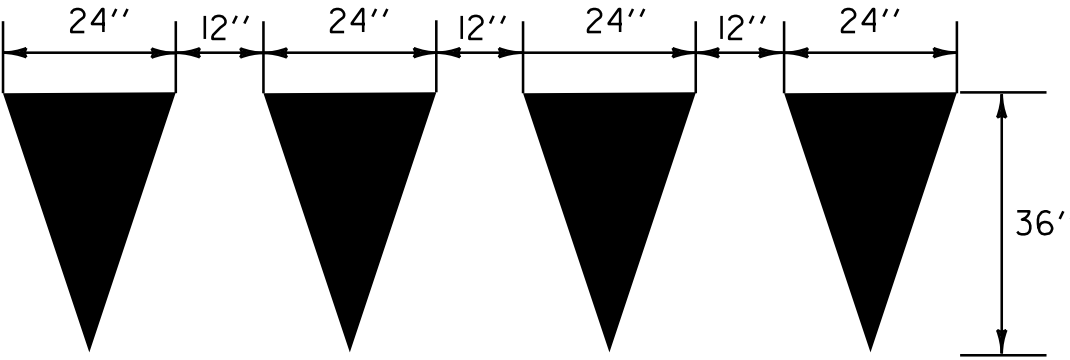

YIELD LINE DETAILS
U.S. ROUTE 5 STA. 301+58, LT

TO BE INSTALLED ONLY AT THE
DIRECTION OF THE RESIDENT ENGINEER
TO BE PAID AS ONE LETTER OR SYMBOL
PER TRIANGLE

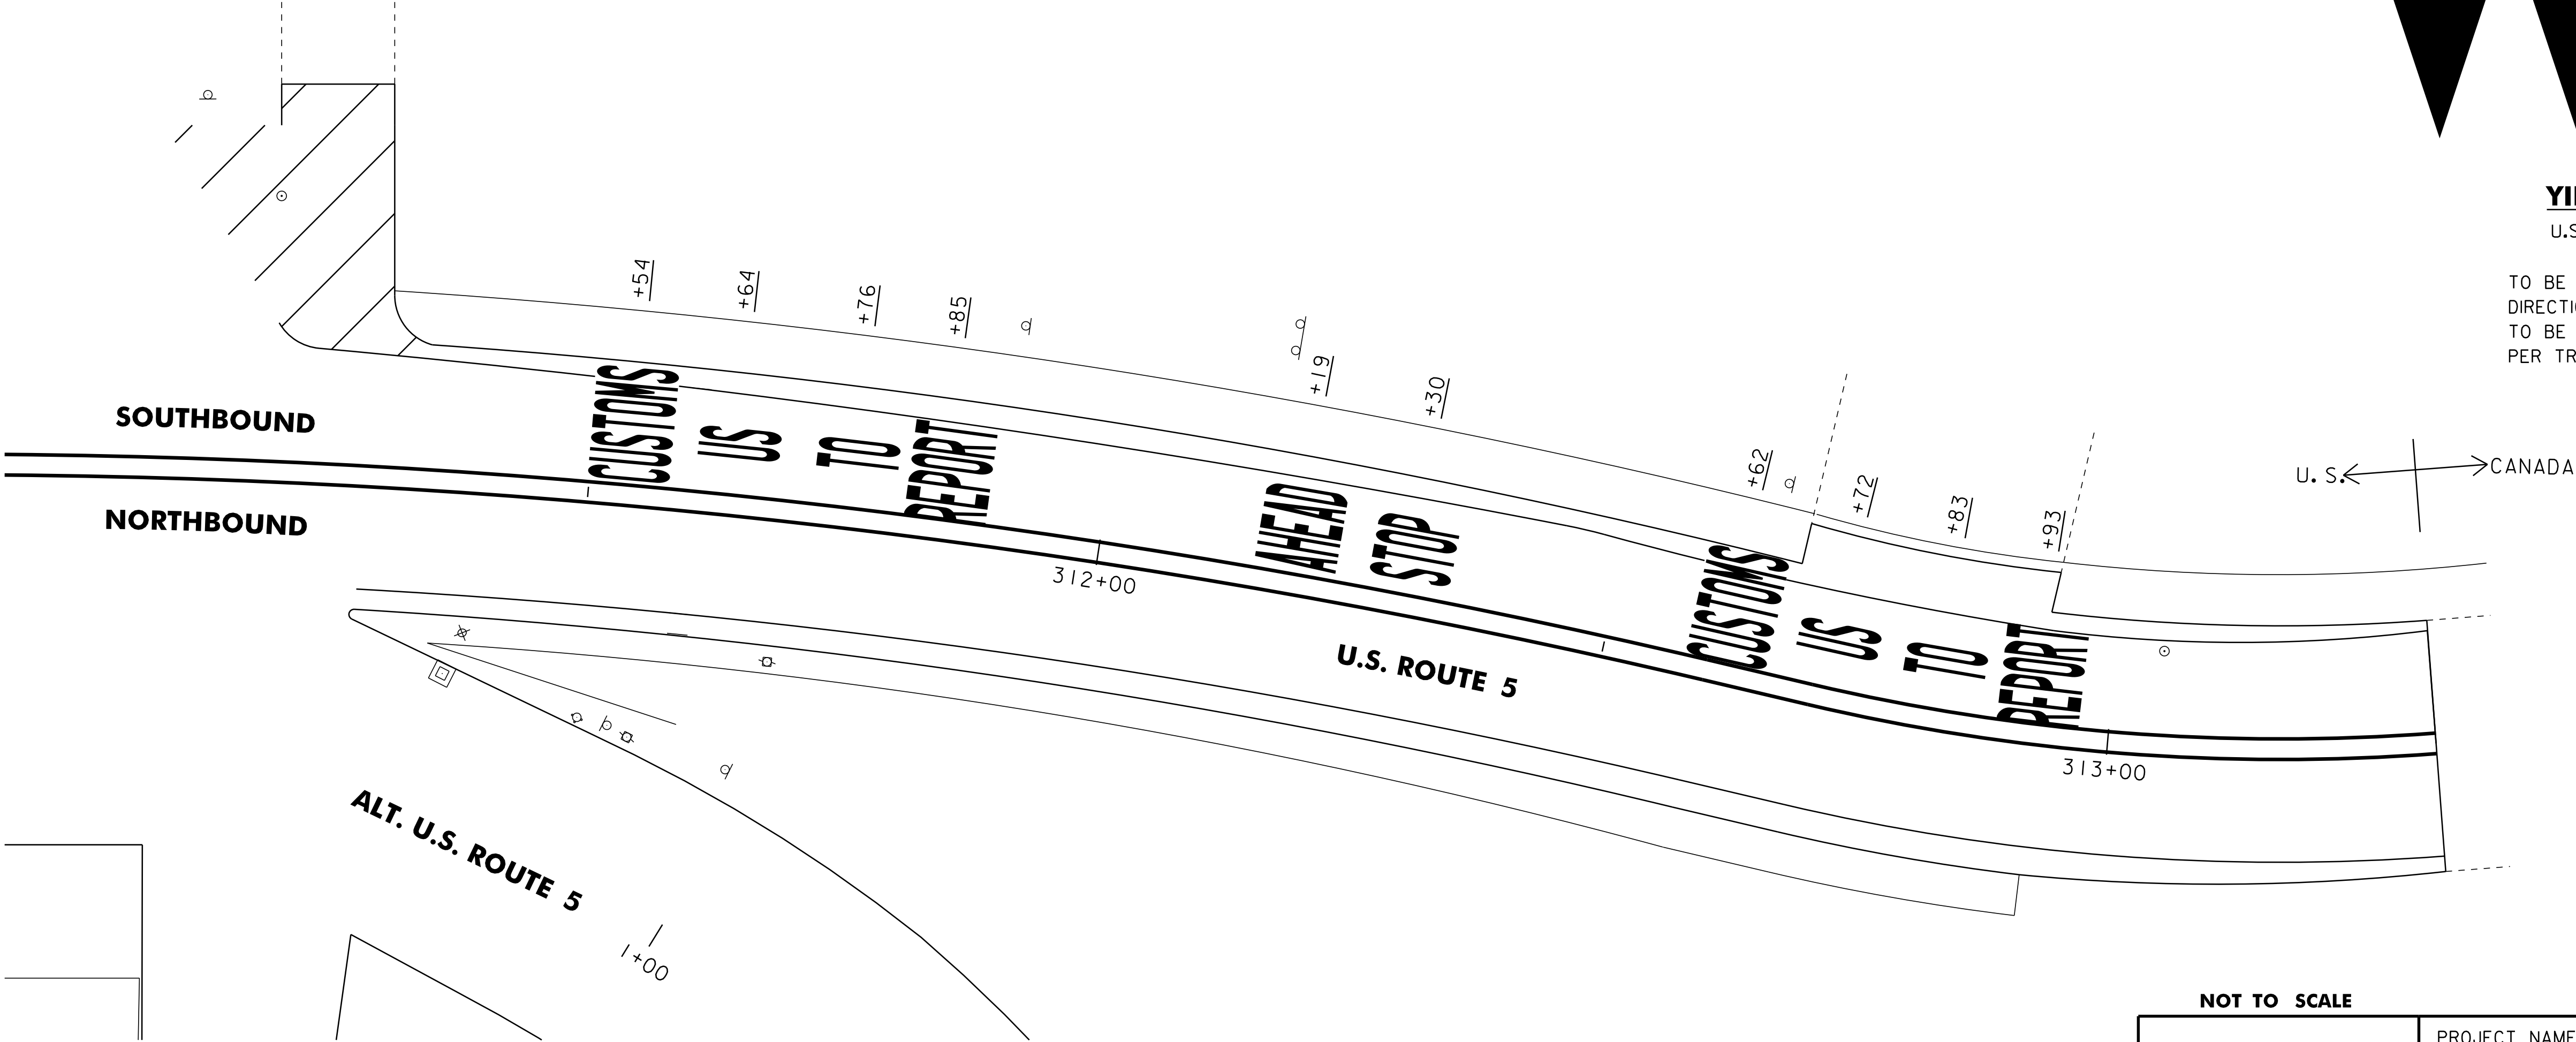

DURABLE LETTER OR SYMBOL, THERMOPLASTIC LAYOUT DETAIL - U.S. ROUTE 5
SEE LAYOUT SHEET #8 FOR ADDITIONAL INFORMATION

NOT TO SCALE

**PAVEMENT
MARKING
DETAIL SHEET**

PROJECT NAME: DERBY
PROJECT NUMBER: STP 2703(I)

FILE NAME: 07D202.dgn
PROJECT LEADER: JLL
DESIGNED BY: STANTEC
IPARM FILE: 07CI94_59.i

PLOT DATE: 29-JAN-2013 09:2
DRAWN BY: STANTEC
CHECKED BY: JLL
SHEET 59 OF 62

REHAB. DI'S, CB'S or MH'S, CLASS I, II, III
(ITEM 604.412, 604.415 OR 604.418)

STATION	POSITION	DESCRIPTION
U.S. ROUTE 5		
282+29	RT	DI
290+70	RT	DI
292+59	LT	DI
293+25	RT	DI
295+09	LT	MH
302+19	RT	DI
303+34	RT	DI
306+26	LT	DI
306+54	RT	DI
307+17	LT	DI
307+63	RT	DI
308+67	LT	DI
308+91	RT	DI
309+41	LT	DI
310+09	RT	DI
311+09	LT	DI
ALT. U.S. ROUTE 5		
0+47	C/L	DI
0+58	RT	DI
0+64	RT	DI
0+70	LT	DI
1+20	RT	DI
3+64	LT	DI
3+83	RT	DI
4+86	LT	DI
7+02	RT	DI
7+11	LT	DI
8+72	RT	DI
11+85	RT	DI
12+27	RT	DI
18+65	RT	DI
18+81	RT	DI
18+96	LT	DI
19+19	RT	DI

CHANGING ELEVATION OF SEWER MANHOLES

STATION	POSITION	DESCRIPTION
U.S. ROUTE 5		
279+49	RT	SMH
282+27	LT	SMH
282+38	RT	SMH
284+01	LT	SMH
289+46	LT	SMH
292+37	LT	SMH
295+03	RT	SMH
295+33	LT	SMH
298+31	LT	SMH
301+35	LT	SMH
305+87	LT	SMH
306+06	RT	SMH
307+96	LT	SMH
307+97	RT	SMH
311+19	LT	SMH
313+05	LT	SMH
ALT. U.S. ROUTE 5		
0+49	RT	SMH
1+54	C/L	SMH
2+15	C/L	SMH
3+69	RT	SMH
3+78	LT	SMH
4+01	RT	SMH
5+42	RT	SMH
9+94	RT	SMH
11+87	RT	SMH
23+74	RT	SMH

ADJUST ELEVATION OF VALVE BOX


[illegible]

STRUCTURE LOCATIONS SHEET


PROJECT NAME:	DERBY
PROJECT NUMBER:	STP 2703(I)

FILE NAME: 07D202.dgn
PROJECT LEADER: JLL
DESIGNED BY: STANTEC
IPARM FILE: 07CI94_60.i


PLOT DATE: 29-JAN-2013 09:2
DRAWN BY: STANTEC
CHECKED BY: JLL
SHEET 60 OF 62

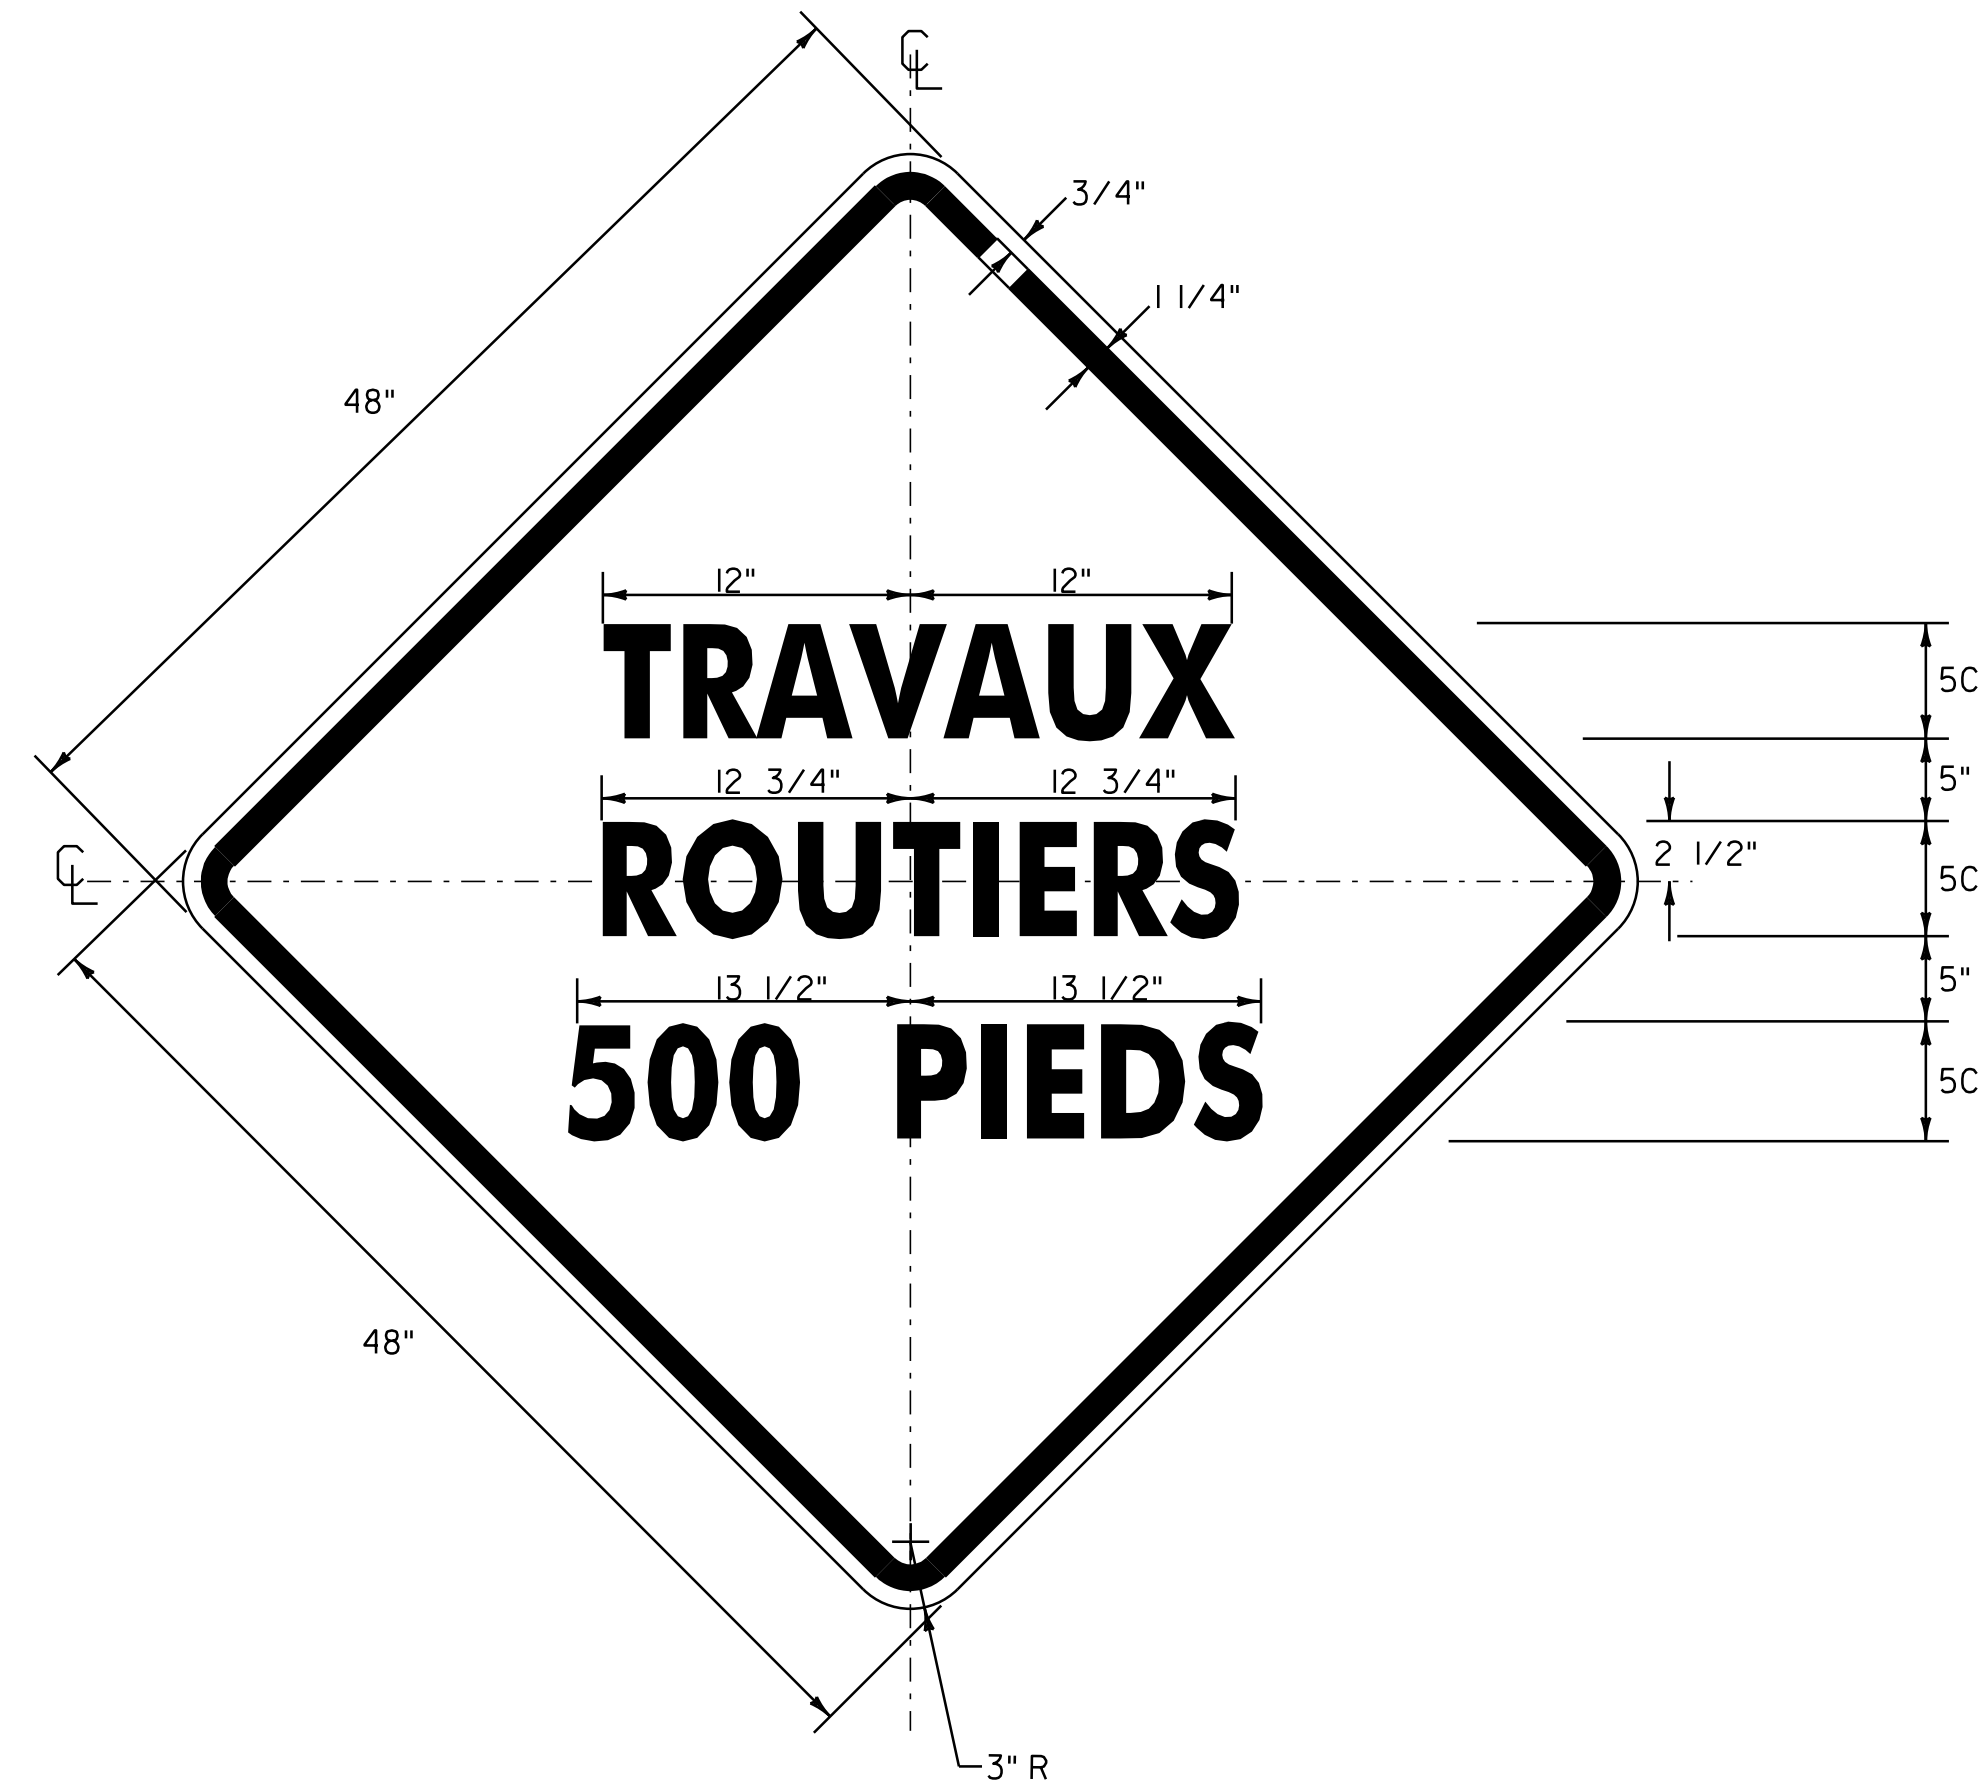

SEE NOTES ON TEMPORARY TRAFFIC CONTROL PLAN FOR
COLORS & MATERIALS (ENGLISH EQUIVALENT: ROAD WORK 500 FT)

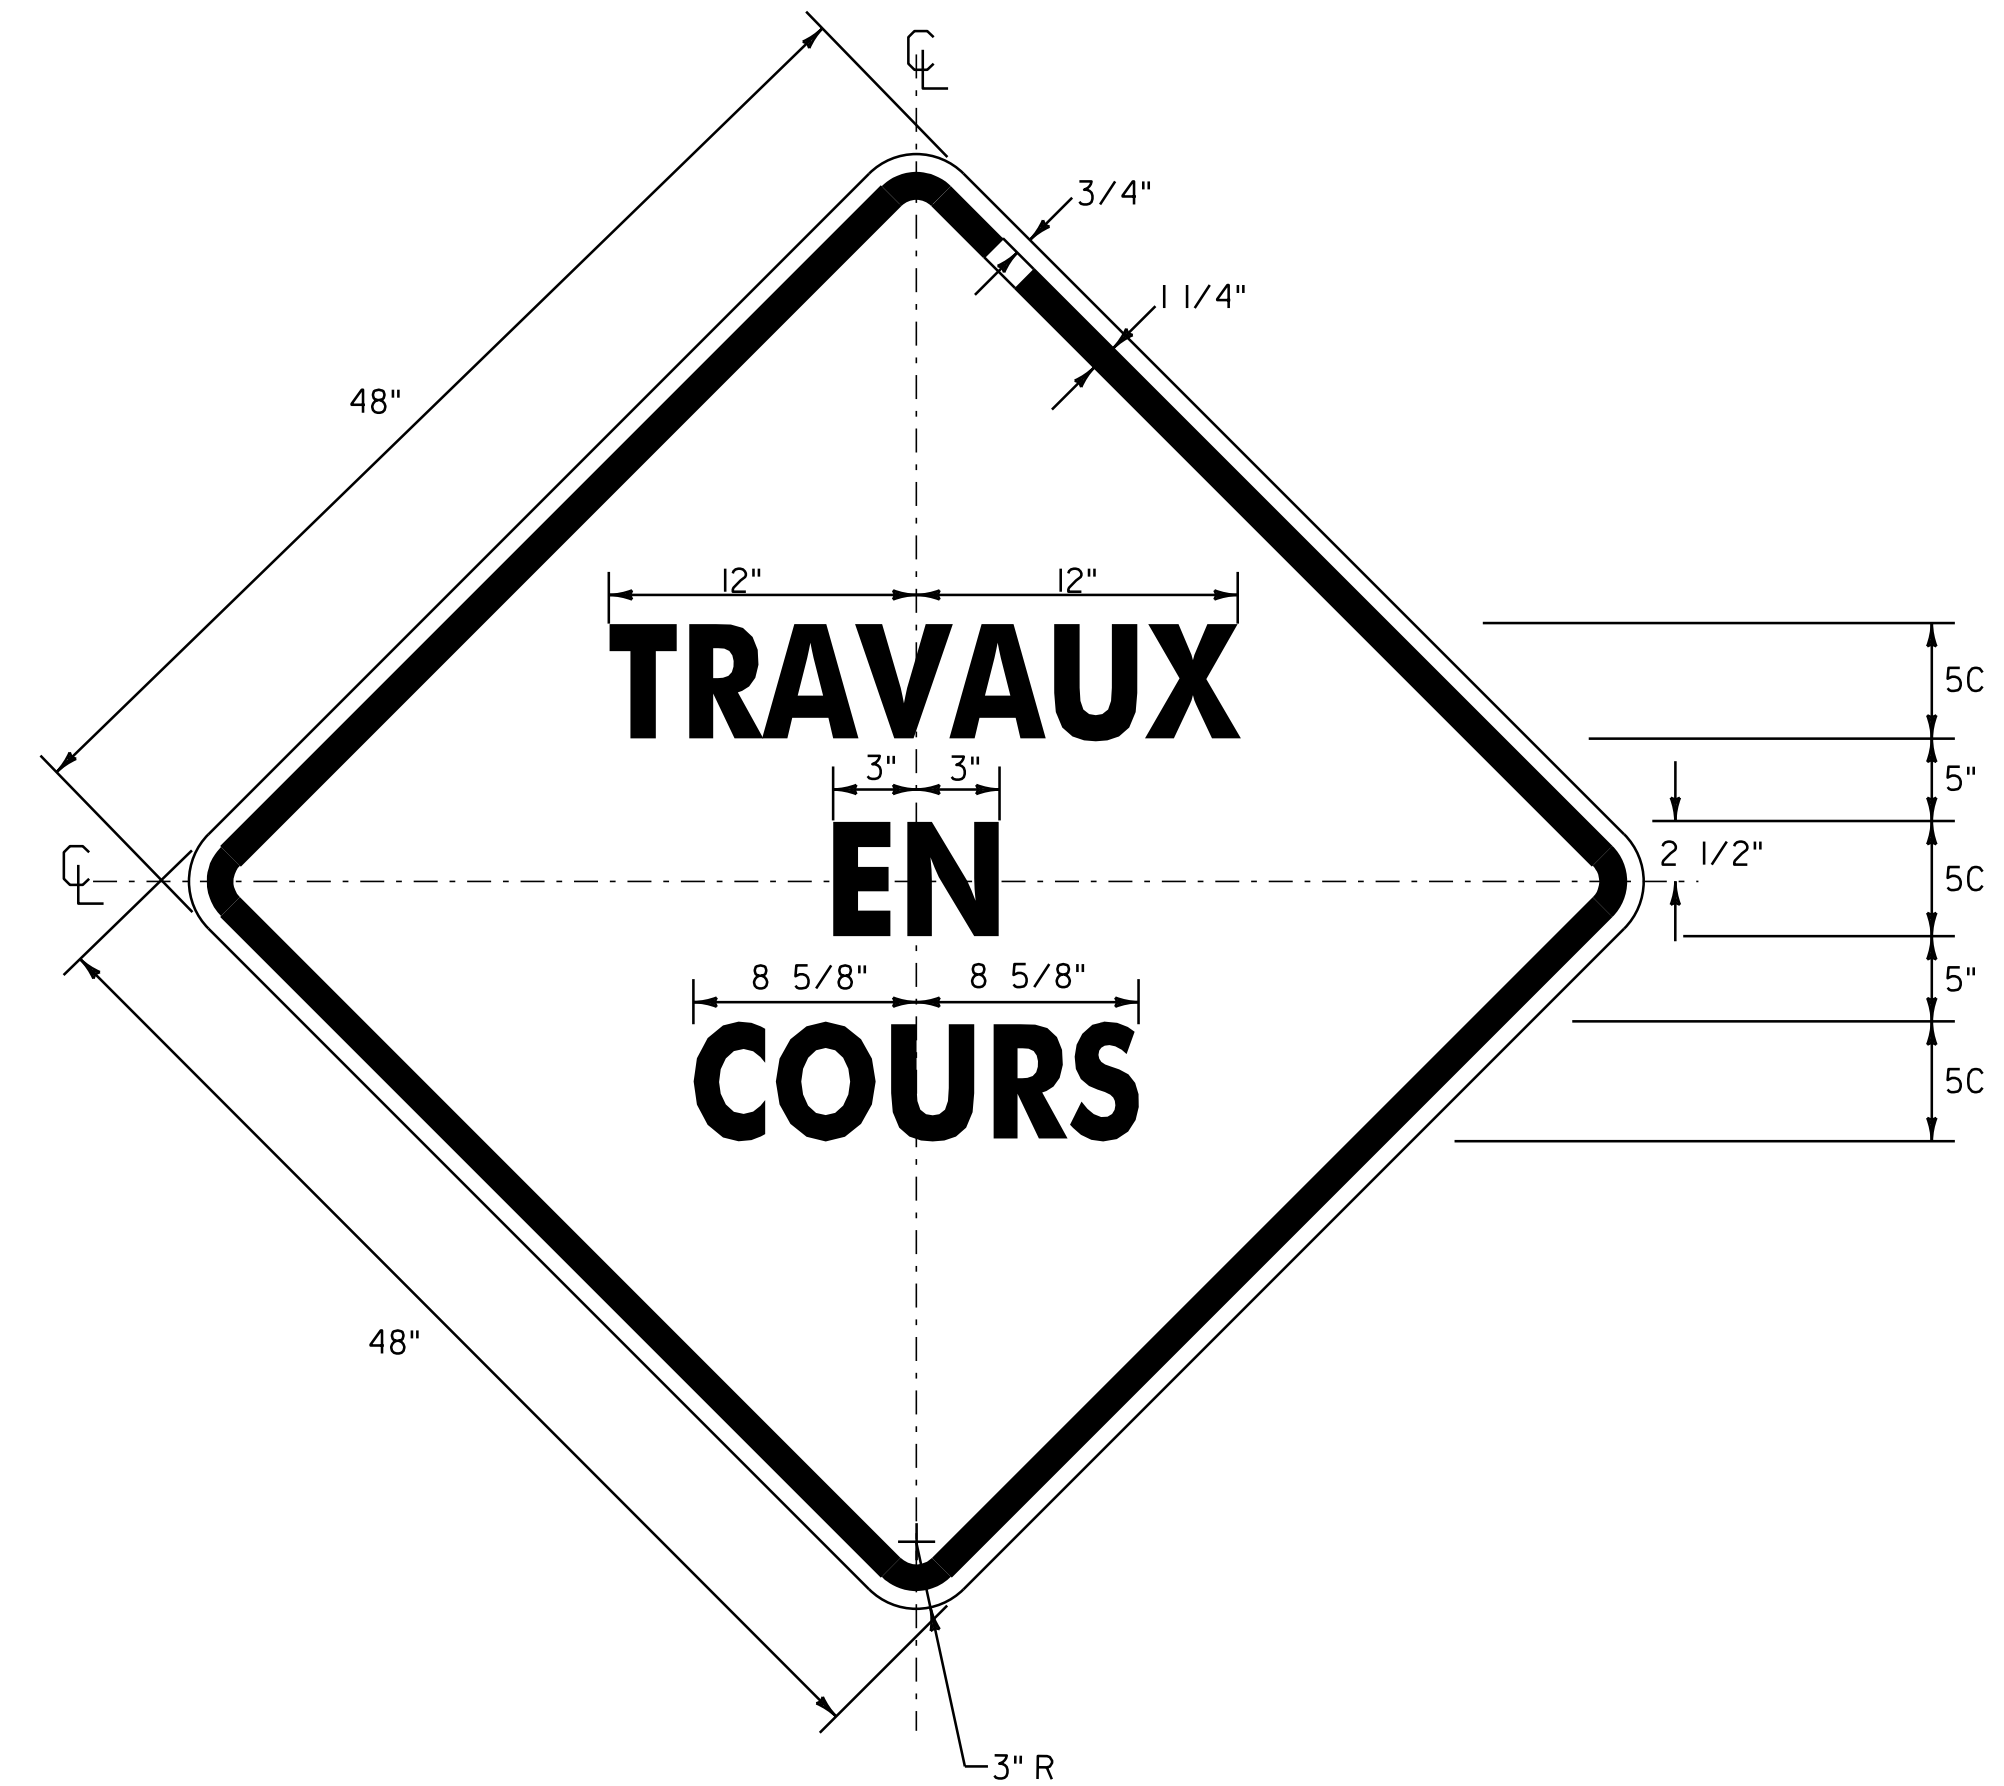

SEE NOTES ON TEMPORARY TRAFFIC CONTROL PLAN FOR
COLORS & MATERIALS (ENGLISH EQUIVALENT: ROAD WORK AHEAD)

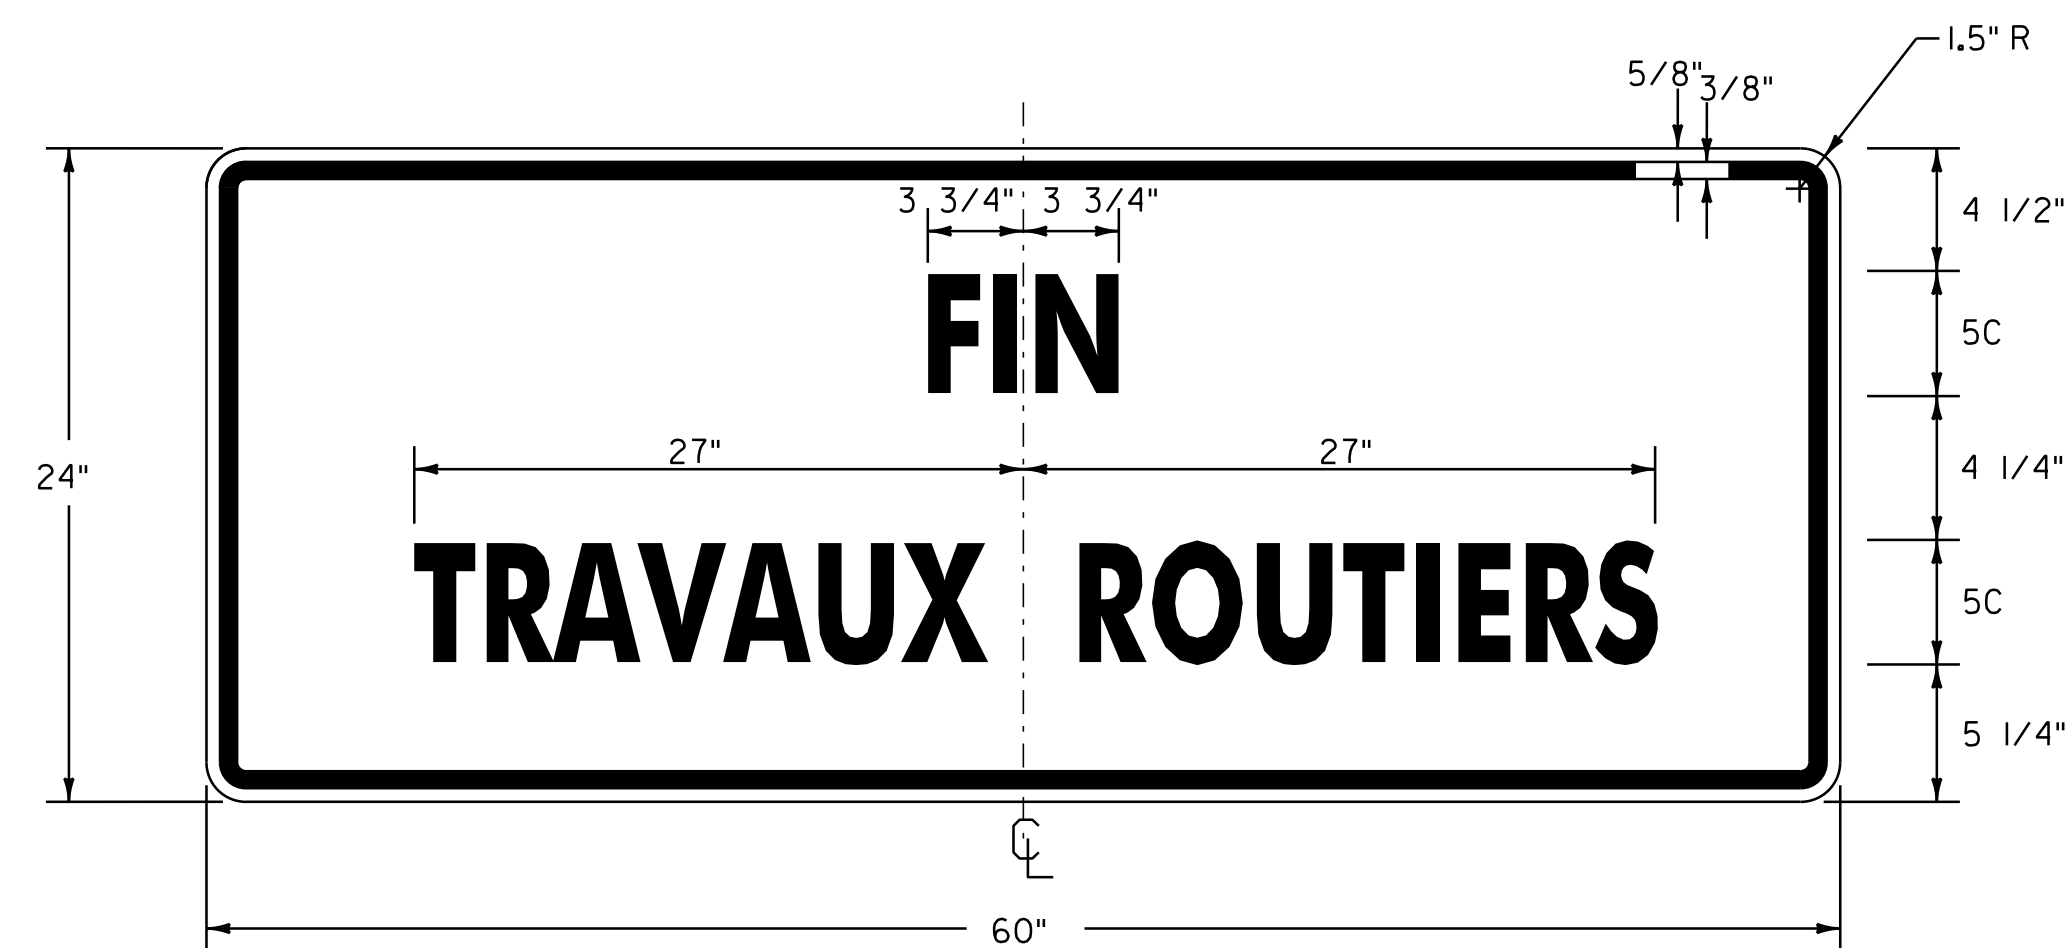

SEE NOTES ON TEMPORARY TRAFFIC CONTROL PLAN FOR
COLORS & MATERIALS (ENGLISH EQUIVALENT: END ROAD WORK)


NOT TO SCALE

**FRENCH
CONSTRUCTION
SIGN DETAIL
SHEET**

PROJECT NAME: DERBY
PROJECT NUMBER: STP 2703(I)

FILE NAME: 07D202.dgn
PROJECT LEADER: JLL
DESIGNED BY: MCF
IPARM FILE: 07C194_61.i

PLOT DATE: 29-JAN-2013 09:2
DRAWN BY: STANTEC
CHECKED BY: JLL
SHEET 61 OF 62

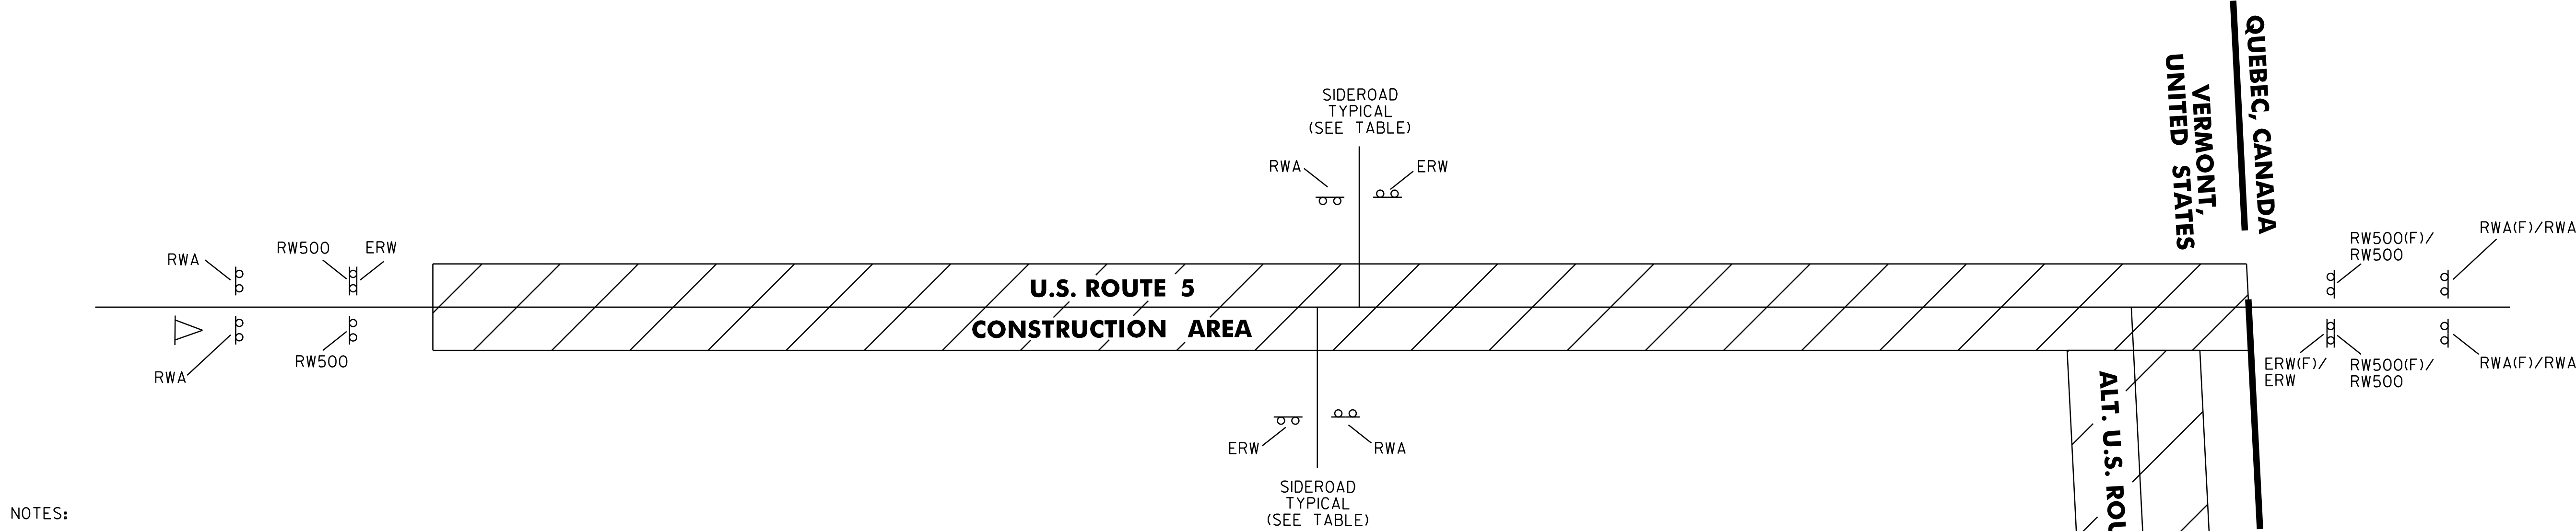

NOTES:

- THE CONTRACTOR SHALL SUBMIT A TRAFFIC CONTROL PLAN FOR APPROVAL PRIOR TO THE START OF CONSTRUCTION. THE COST OF PREPARING THIS PLAN (AND MAKING CHANGES IF NECESSARY) SHALL BE INCLUDED IN THE UNIT PRICE BID FOR ITEM 641.10, TRAFFIC CONTROL.
- THE BID PRICE FOR TRAFFIC CONTROL, ITEM 641.10, SHALL INCLUDE ALL OF THE FOLLOWING, AS NEEDED: APPROACH AND ON-PROJECT CONSTRUCTION SIGNING, PORTABLE FLASHING ARROW BOARDS, BARRIERS, BARRELS, CONES, BARRICADES, TEMPORARY REGULATORY AND WARNING SIGNS, AND POSTS AS DETAILED IN VTRANS STANDARDS. ALL ADJUSTING, RELOCATING AND REMOVING OF THESE DEVICES AS DIRECTED BY THE RESIDENT ENGINEER SHALL ALSO BE INCLUDED.
- THE LATEST EDITION OF THE MANUAL ON UNIFORM TRAFFIC CONTROL DEVICES (MUTCD) SHALL BE THE STANDARD FOR ALL TRAFFIC CONTROL DEVICES. EXISTING SIGNS AND MARKING SHALL BE VALID UNTIL SUCH TIME AS THEY ARE REPLACED OR RECONSTRUCTED. WHEN NEW TRAFFIC DEVICES ARE ERECTED OR PLACED, OR EXISTING TRAFFIC CONTROL DEVICES ARE REPLACED OR REPAIRED, THE EQUIPMENT, DESIGN, METHOD OF INSTALLATION, PLACEMENT OR REPAIR SHALL CONFORM WITH SUCH STANDARDS.
- NO CONSTRUCTION SIGNS SHALL BE INSTALLED AS TO INTERFERE OR OBSTRUCT THE VIEW OF EXISTING TRAFFIC CONTROL DEVICES, STOPPING SIGHT DISTANCE, AND CORNER SIGHT DISTANCE FROM DRIVES AND TOWN HIGHWAYS.
- ALL PERMANENT SIGNS THAT CONFLICT WITH TEMPORARY TRAFFIC CONTROL SHALL BE COMPLETELY COVERED, THE PAYMENT FOR WHICH SHALL BE INCLUDED IN THE UNIT PRICE BID FOR ITEM 641.10 TRAFFIC CONTROL.
- THE CONTRACTOR SHALL INCLUDE A CONSTRUCTION SIGN PACKAGE FOR EXPECTED LANE CLOSURES AND WORK ZONE SPEED REDUCTIONS IN COMPLIANCE WITH STANDARD E-103. PAYMENT FOR PROVIDING THIS PACKAGE SHALL BE INCLUDED IN THE UNIT PRICE BID FOR ITEM 641.10, TRAFFIC CONTROL.
- ADA ACCESSIBLE PEDESTRIAN ACCOMMODATIONS SHALL BE MAINTAINED AT ALL TIMES, THE PAYMENT FOR WHICH SHALL BE INCLUDED IN THE UNIT PRICE BID FOR ITEM 641.10 TRAFFIC CONTROL.
- SEE VAOT STANDARD E-100 FOR ADDITIONAL SIGN PLACEMENT DETAILS.
- CONSTRUCTION ZONE SIGN LAYOUT SHALL BE IN ACCORDANCE WITH SECTION 6 OF THE LATEST EDITION OF THE MANUAL ON UNIFORM TRAFFIC CONTROL DEVICES (MUTCD).
- CONSTRUCTION SIGNS SHALL BE IN NEW OR LIKE NEW CONDITION PER VAOT STANDARDS AND SPECIAL PROVISIONS.
- DIAMOND SHAPED SIGNS SHALL BE 4' X 4' WITH BLACK TEXT AND BORDER ON A RETROREFLECTIVE FLUORESCENT ORANGE BACKGROUND.
- RETROREFLECTIVE SHEETING SHALL BE TYPE III OR VIII AS NOTED ON VAOT STANDARD E-100 AND IN THE SPECIAL PROVISIONS.
- CONSTRUCTION ZONE SIGNS SHALL BE INSTALLED AS OUTLINED IN THE SPECIAL PROVISIONS.
- WHERE TEMPORARY SIGNS ARE PLACED BEHIND GUARDRAIL, THEY SHALL BE ADJUSTED SUCH THAT THE BOTTOM OF THE SIGNS IS ABOVE THE TOP OF GUARDRAIL.
- AS THE PAVING OPERATION MOVES, FLAGGER SIGNS SHALL BE MOVED ACCORDINGLY. AT NO TIME SHOULD THE FLAGGER SYMBOL SIGN BE MORE THAN 1000 FEET FROM THE FLAGGER STATION. FLAGGER SIGNS SHALL BE COVERED OR TURNED AWAY FROM TRAFFIC WHEN FLAGGING OPERATIONS CEASE FOR LONGER THAN 15 MINUTES.
- CONES SHALL BE USED TO CLEARLY DEFINE THE TRAVEL SPACE AND PROVIDE SEPARATION FROM THE WORK SPACE ALONG ITS ENTIRE LENGTH.
- PERMISSION MUST BE OBTAINED PRIOR TO PLACING CONSTRUCTION SIGNING IN CANADA. FOR THE APPROPRIATE PERMISSION AND PROTOCOL CONTACT: MR. MARC BOUCHARD AT CENTRE DE SERVICE DE SHERBROOKE ET COORDINATION TERRITORIALE DE L'EXPLOITATION, DIRECTION DE L'ESTRIE, 125 CHEMIN GEORGES-VALLIERES, SHERBROOKE (QUEBEC), J1H 0B7, (819) 562-2693 POSTE: 234.
- THE FRENCH CONSTRUCTION APPROACH SIGNING WILL BE INSTALLED ABOVE THE ENGLISH SIGNS AS DIRECTED BY THE RESIDENT ENGINEER.
- SEE FRENCH CONSTRUCTION SIGN DETAIL SHEET FOR FRENCH SIGN DETAILS AND THEIR ENGLISH EQUIVALENT.

SEE VAOT STANDARDS E-100 AND E-100A FOR SIGN PLACEMENT.

LOCATION	ERW	RW500	RWA	ERW(F)	RW500(F)	RWA(F)	
DERBY							
U.S. ROUTE 5 - BEGIN PROJECT	1	2	2				1
HAMMER HANDLE ROAD	1		1				
VALENTINE AVENUE	1		1				
LATHE STREET	1		1				
LOUIS STREET	1		1				
BEACH STREET	1		1				
ELM STREET	1		1				
BAXTER AVENUE	1		1				
U.S. ROUTE 5 - END PROJECT							
ALT. U.S. ROUTE 5 - BEGIN PROJECT	1	2	2	1	2	2	
DUCHARME DRIVE	1		1				
CHURCH STREET	1		1				
PELOW HILL	1		1				
LEE STREET	1		1				
HIGHLAND AVENUE	1		1				
PHELPS STREET	1		1				
MAPLE STREET	1		1				
I-91 SB ON/OFF RAMP	1						
DERBY TOWN							
I-91 NB ON/OFF RAMP	1		1				
HERRICK ROAD	1		1				
T.H. 1 - END PROJECT	1	2	2				1
TOTALS	20	6	22	1	2	2	2

LEGEND

- ERW = END ROAD WORK
RW500 = ROAD WORK 500 FT
RWA = ROAD WORK AHEAD
SRWA = SIDE ROAD WORK AHEAD
SRW500 = SIDE ROAD WORK 500 FT
ERW(F) = END ROAD WORK (FRENCH)
RW500(F) = ROAD WORK 500 FT (FRENCH)
RWA(F) = ROAD WORK AHEAD (FRENCH)
▶ = PORTABLE CHANGEABLE MESSAGE SIGN

NOT TO SCALE

TEMPORARY
TRAFFIC
CONTROL PLAN

PROJECT NAME: DERBY
PROJECT NUMBER: STP 2703(1)

FILE NAME: 07D202.dgn
PROJECT LEADER: JLL
DESIGNED BY: MCF
IPARM FILE: 07C194_62.i

PLOT DATE: 29-JAN-2013 09:2
DRAWN BY: STANTEC
CHECKED BY: JLL
SHEET 62 OF 62