

646.402 DURABLE 4 INCH WHITE LINE, THERMOPLASTIC OR
646.403 DURABLE 4 INCH WHITE LINE, EPOXY PAINT
(ALL LINES WILL INCLUDE EDGE LINE BREAKS AND
RADI FOR SIDE ROADS)
STA. 14+50 TO 20+50, SOLID LT & RT
STA. 15+73, SOLID RT (ALDERBROOK ROAD)

646.412 DURABLE 4 INCH YELLOW LINE, THERMOPLASTIC OR
646.413 DURABLE 4 INCH YELLOW LINE, EPOXY PAINT
(ALL LINES WILL INCLUDE C BREAKS FOR SIDE ROADS)
STA. 14+50 TO 20+50, SOLID LT & RT
STA. 15+73, DOUBLE SOLID RT (ALDERBROOK ROAD)

646.442 DURABLE 8 INCH WHITE LINE, THERMOPLASTIC OR
646.443 DURABLE 8 INCH WHITE LINE, EPOXY PAINT
STA. 18+44 TO TO 18+56, RT

646.482 DURABLE 24 INCH STOP BAR, THERMOPLASTIC OR
646.483 DURABLE 24 INCH STOP BAR, EPOXY PAINT
STA. 15+73, RT (ALDERBROOK ROAD)

646.492 DURABLE LETTER OR SYMBOL, THERMOPLASTIC OR
646.493 DURABLE LETTER OR SYMBOL, EPOXY PAINT
STA. 15+73, RT (ALDERBROOK ROAD) -"STOP"

646.602 TEMPORARY 4 INCH WHITE LINE, PAINT
(ALL LINES WILL INCLUDE EDGE LINE BREAKS AND
RADI FOR SIDE ROADS)
STA. 14+50 TO 20+50, SOLID LT & RT
STA. 15+73, SOLID RT (ALDERBROOK ROAD)

646.612 TEMPORARY 4 INCH YELLOW LINE, PAINT
(ALL LINES WILL INCLUDE C BREAKS FOR SIDE ROADS)
STA. 14+50 TO 20+50, SOLID LT & RT
STA. 15+73, DOUBLE SOLID RT (ALDERBROOK ROAD)


646.642 TEMPORARY 8 INCH WHITE LINE, PAINT
STA. 18+44 TO TO 18+56, RT

646.682 TEMPORARY 24 INCH STOP BAR, PAINT
STA. 15+73, RT (ALDERBROOK ROAD)

646.692 TEMPORARY LETTER OR SYMBOL, PAINT
STA. 15+73, RT (ALDERBROOK ROAD) -"STOP"

675.50 REMOVING SIGNS
AS SHOWN - 12

629.20 ADJUST ELEVATION OF VALVE BOX
ALDERBROOK ROAD - I

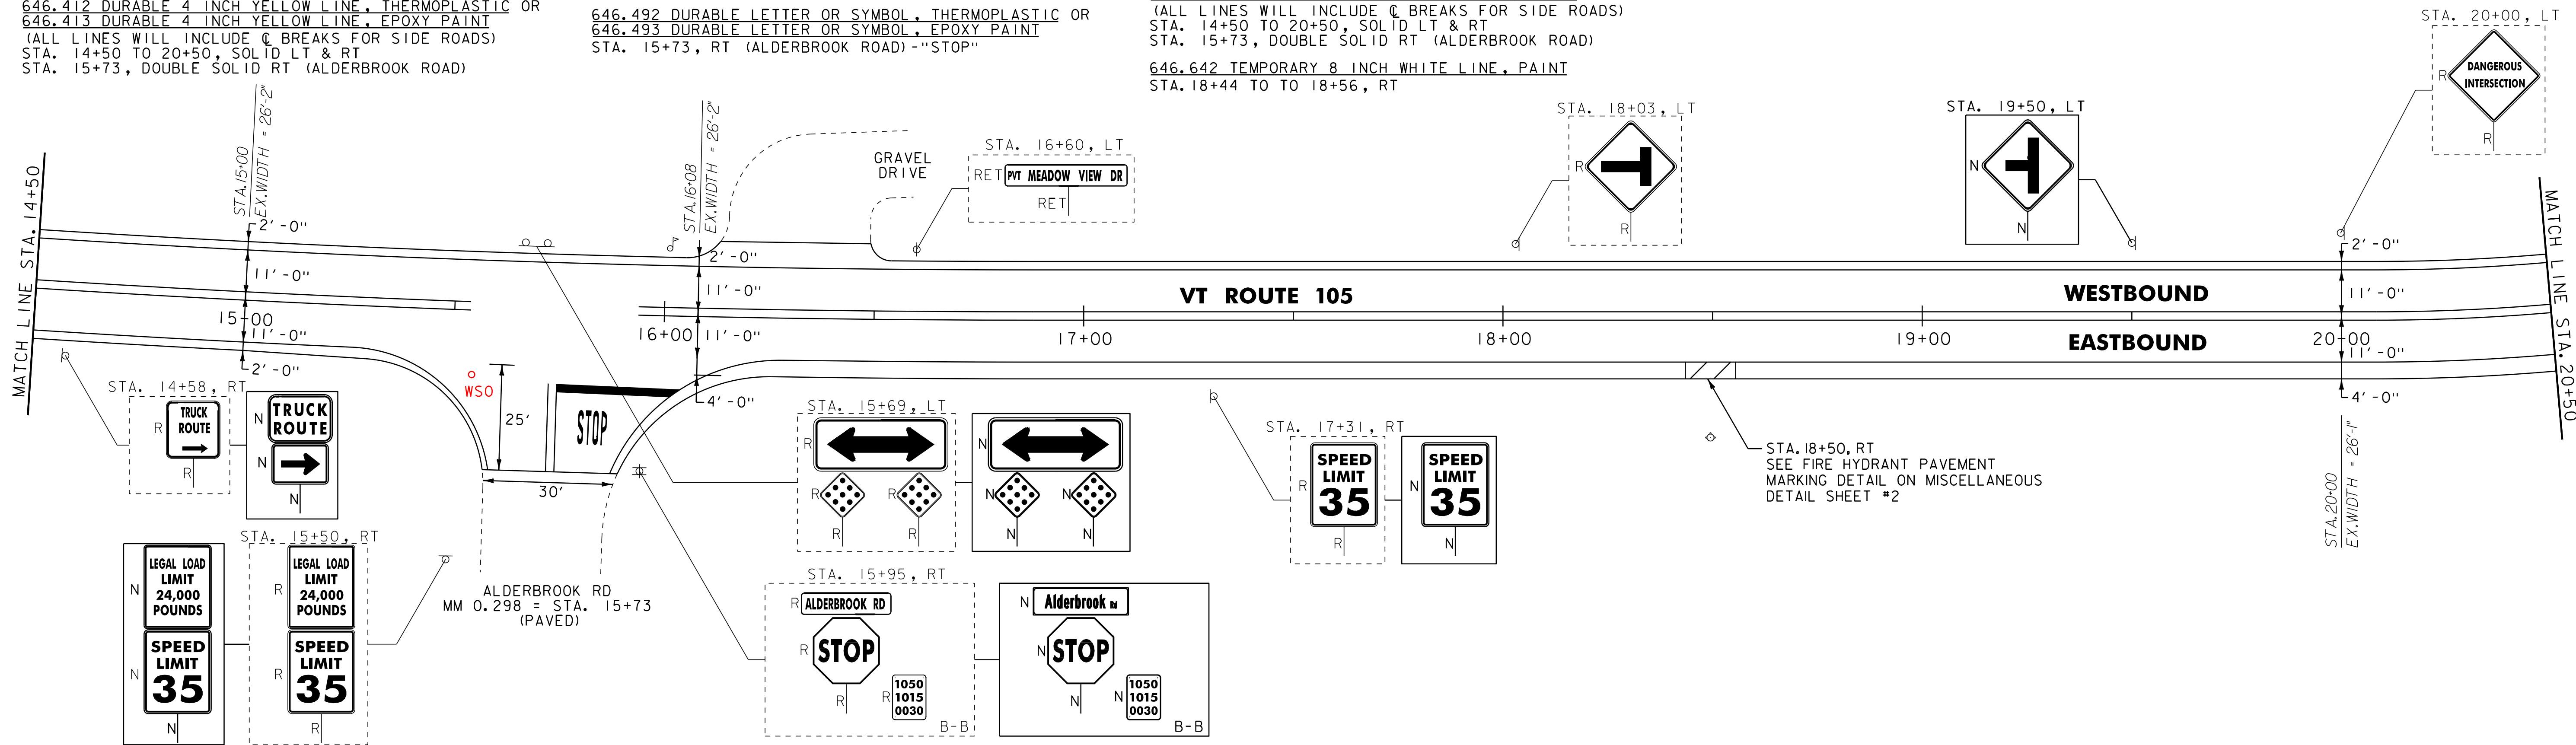

646.402 DURABLE 4 INCH WHITE LINE, THERMOPLASTIC OR
646.403 DURABLE 4 INCH WHITE LINE, EPOXY PAINT
(ALL LINES WILL INCLUDE EDGE LINE BREAKS AND
RADI FOR SIDE ROADS)
STA. 20+50 TO 26+50, SOLID LT & RT

646.412 DURABLE 4 INCH YELLOW LINE, THERMOPLASTIC OR
646.413 DURABLE 4 INCH YELLOW LINE, EPOXY PAINT
(ALL LINES WILL INCLUDE C BREAKS FOR SIDE ROADS)
STA. 20+50 TO 26+50, SOLID LT & RT

646.602 TEMPORARY 4 INCH WHITE LINE, PAINT
(ALL LINES WILL INCLUDE EDGE LINE BREAKS AND
RADI FOR SIDE ROADS)
STA. 20+50 TO 26+50, SOLID LT & RT


646.612 TEMPORARY 4 INCH YELLOW LINE, PAINT
(ALL LINES WILL INCLUDE C BREAKS FOR SIDE ROADS)
STA. 20+50 TO 26+50, SOLID LT & RT

613.10 STONE FILL TYPE 1
STA. 24+68 TO 24+96 LT

613.11 STONE FILL TYPE 11
STA. 25+39 TO 26+50 LT

675.50 REMOVING SIGNS
AS SHOWN - 1

675.60 ERECTING SALVAGED SIGNS
AS SHOWN - 1

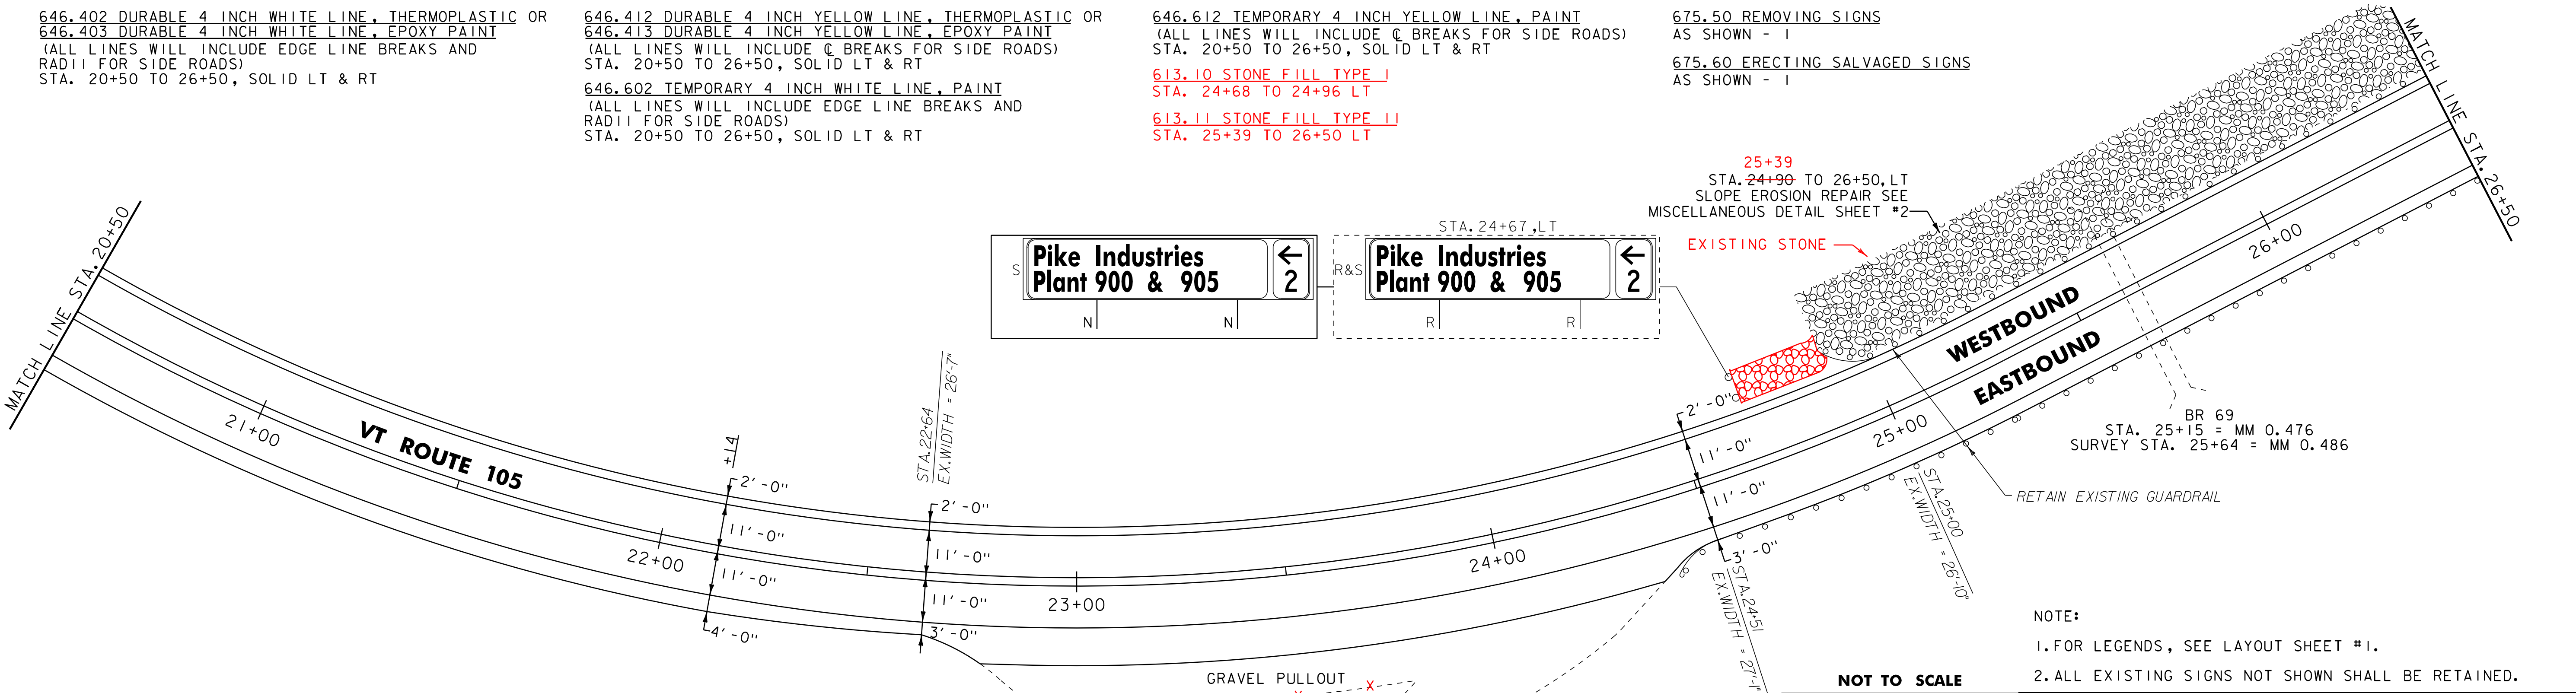

NOTE:
1. FOR LEGENDS, SEE LAYOUT SHEET #1.
2. ALL EXISTING SIGNS NOT SHOWN SHALL BE RETAINED.

NOT TO SCALE

PROJECT
LAYOUT
SHEET #3



PROJECT NAME: NEWPORT CITY	
PROJECT NUMBER: STP 2720(1)	
FILE NAME: p07d204.dgn	PLOT DATE: 28-NOV-2012 14:5
PROJECT LEADER: JLL	DRAWN BY: STANTEC
DESIGNED BY: STANTEC	CHECKED BY: STANTEC
IPARM FILE: p07d204103.i	SHEET 11 OF 30