
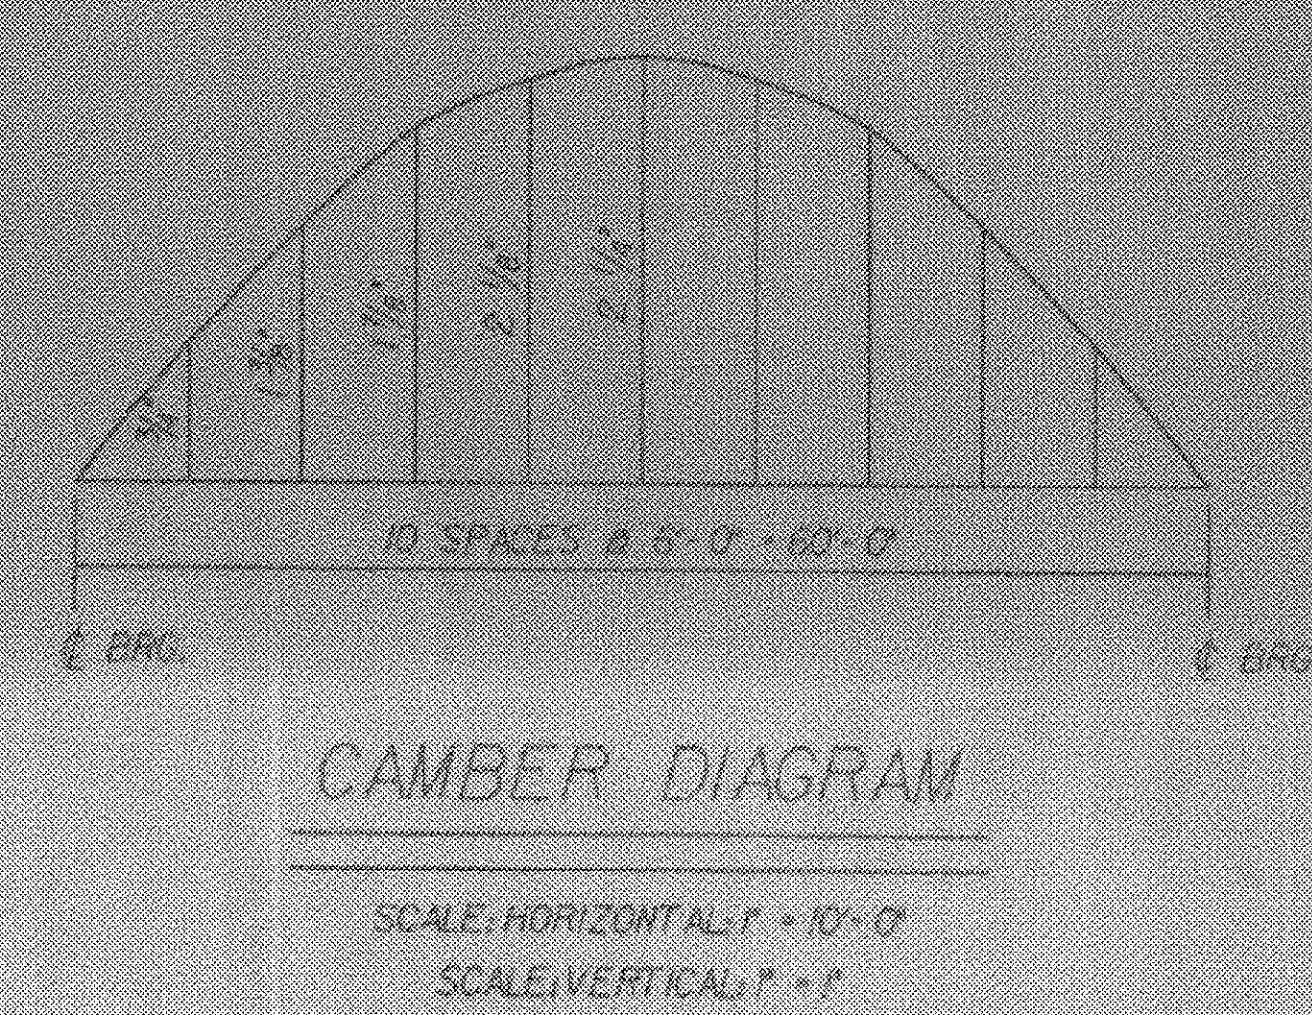
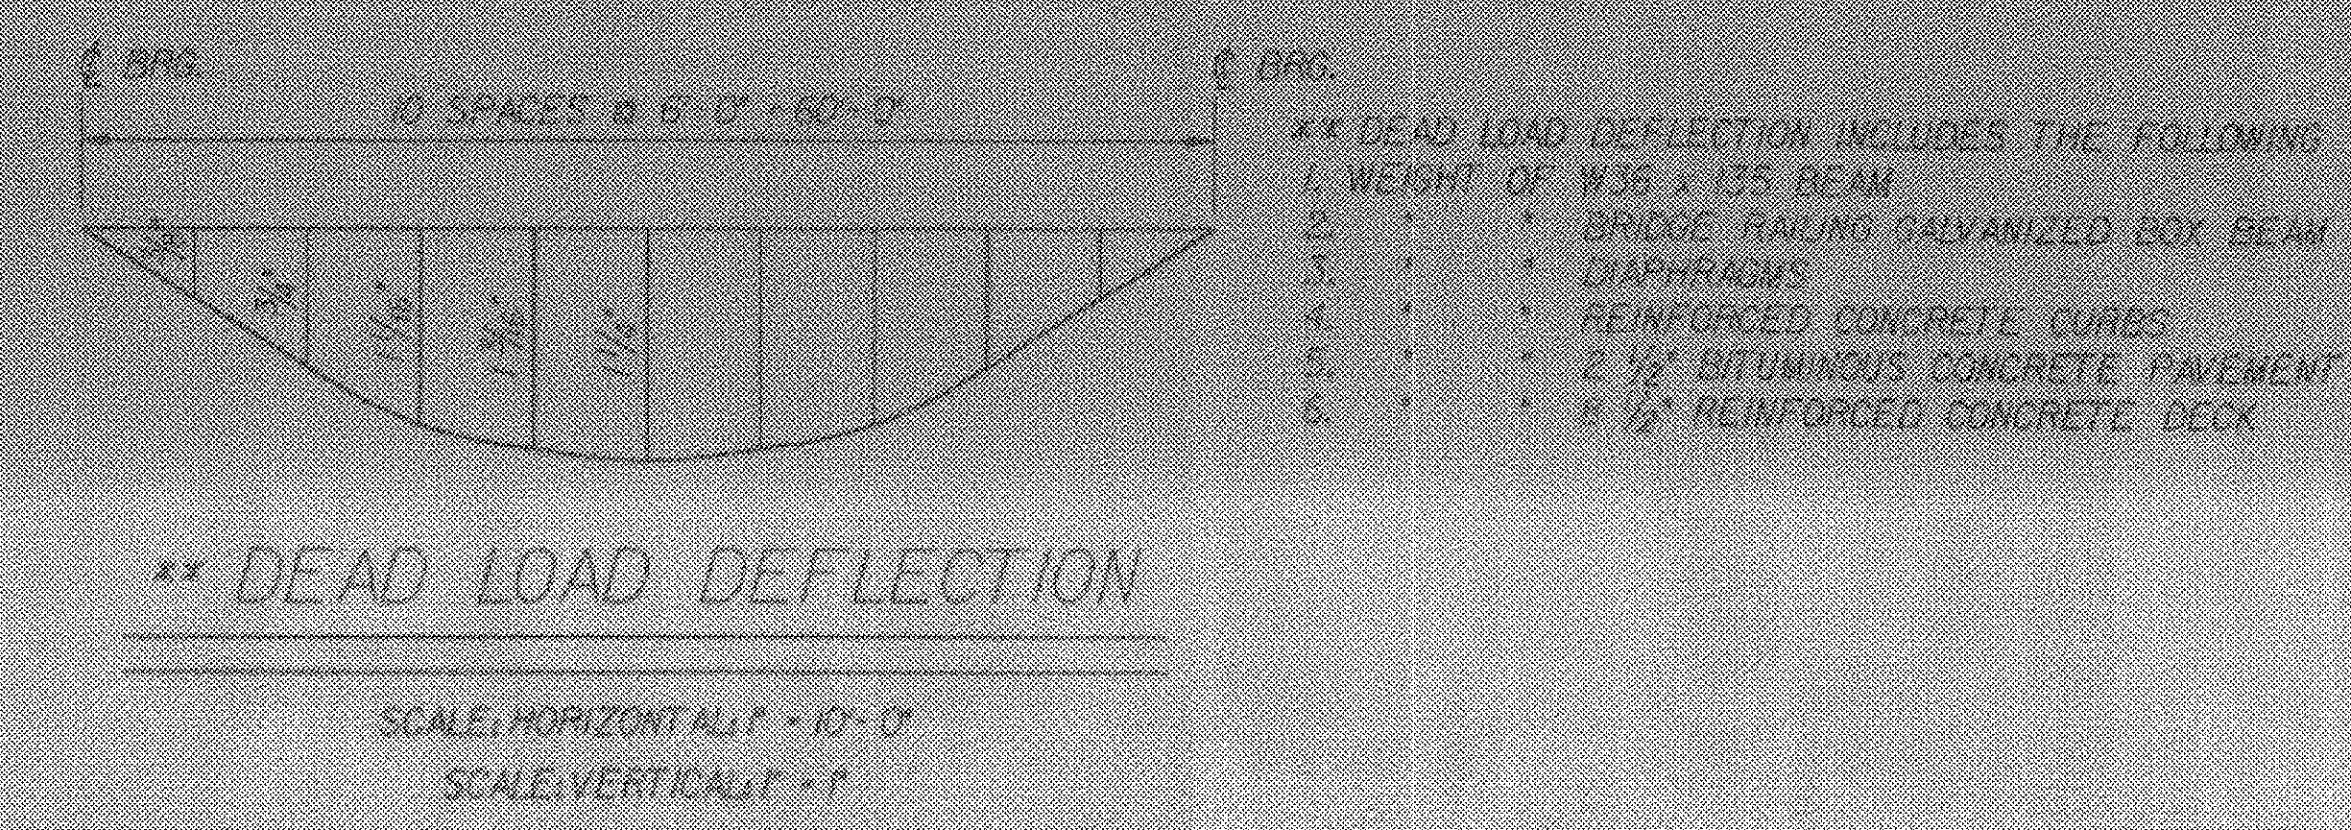
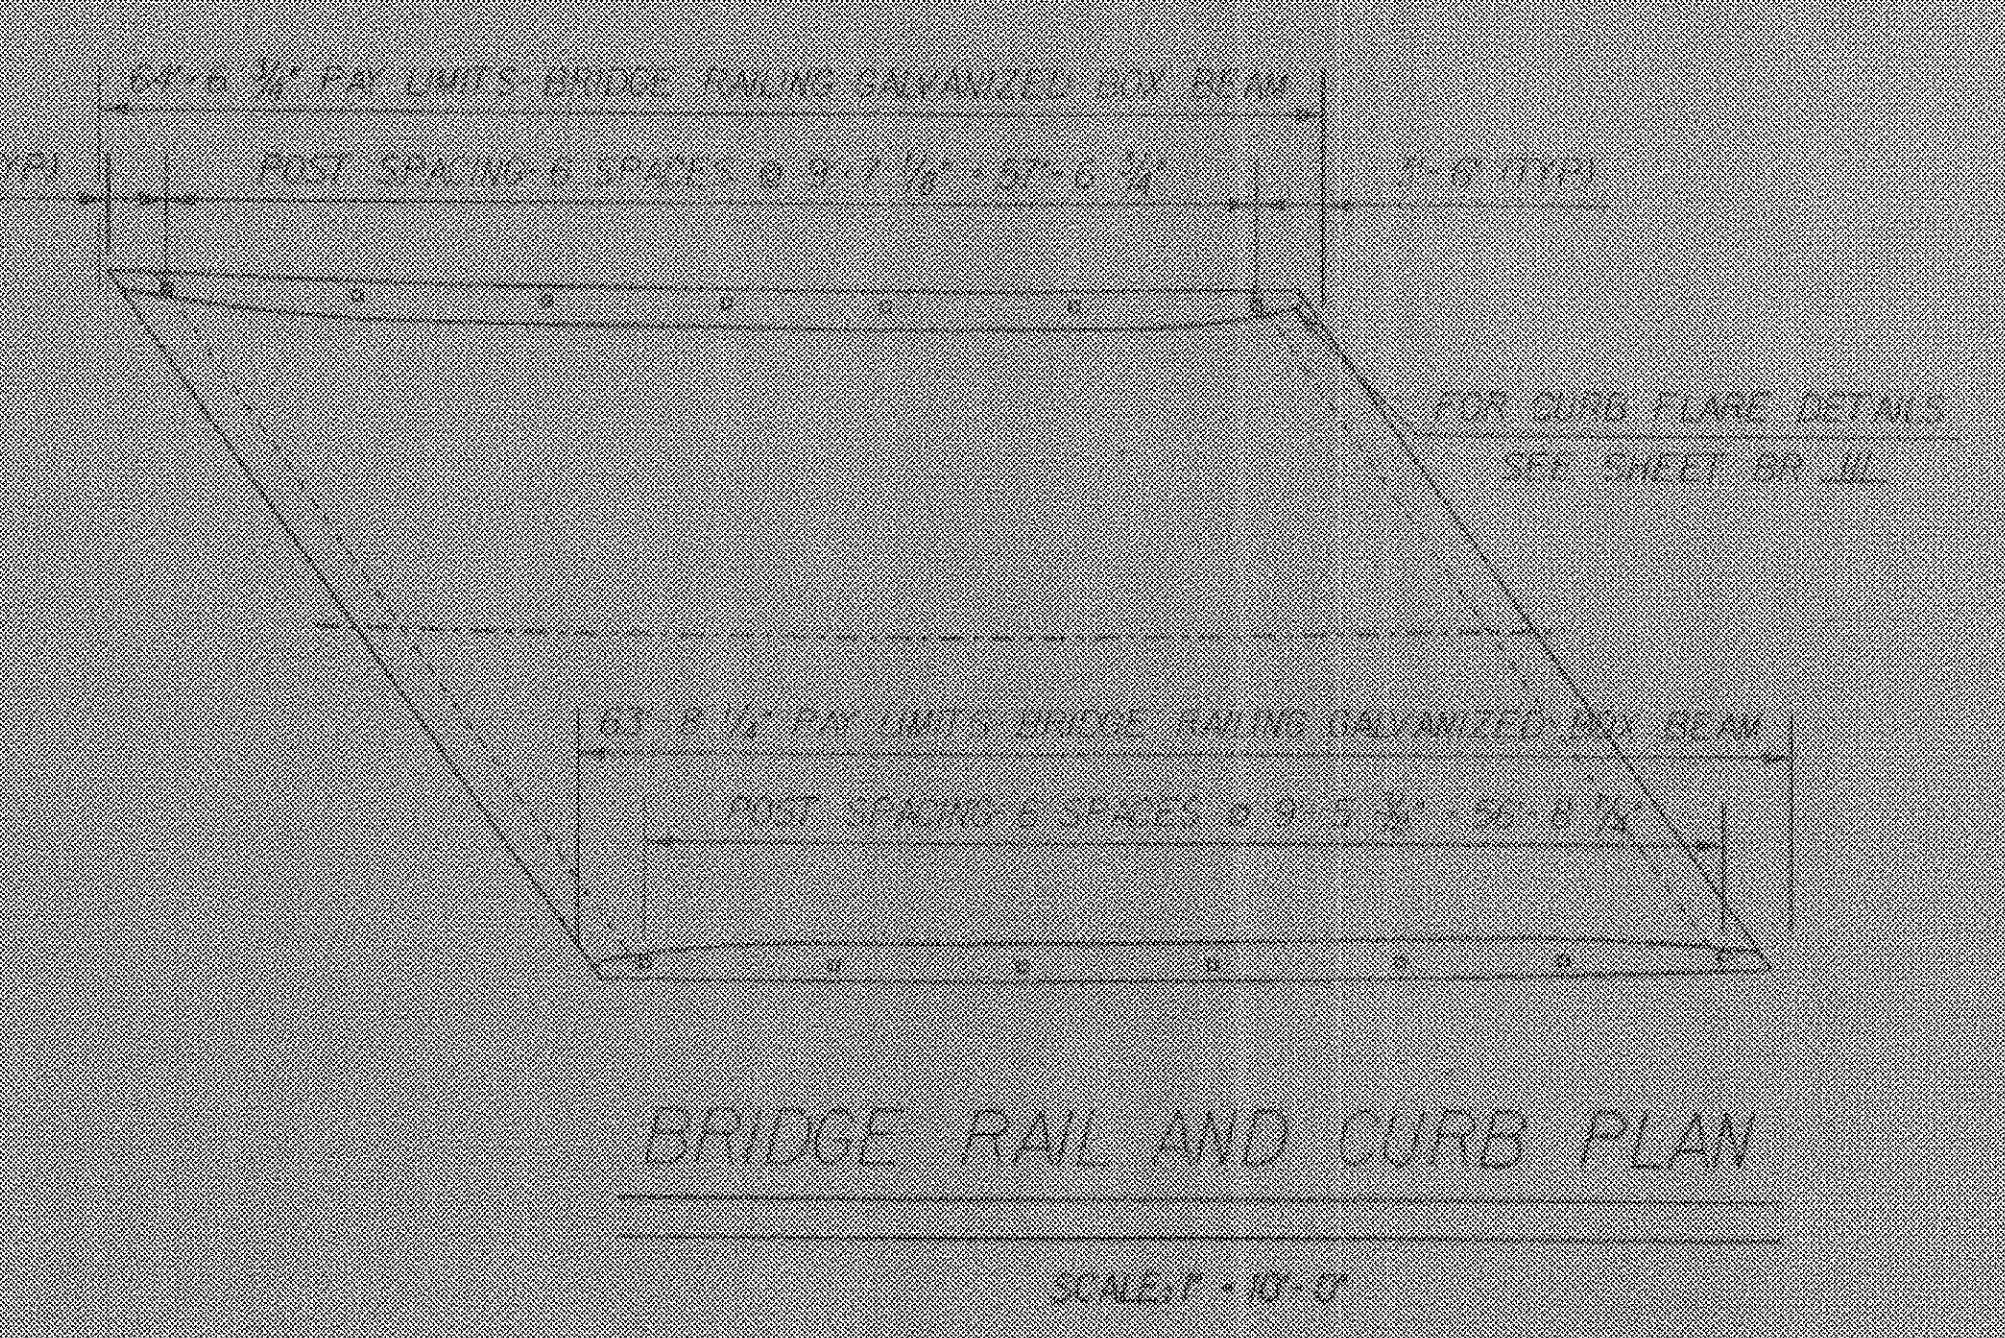
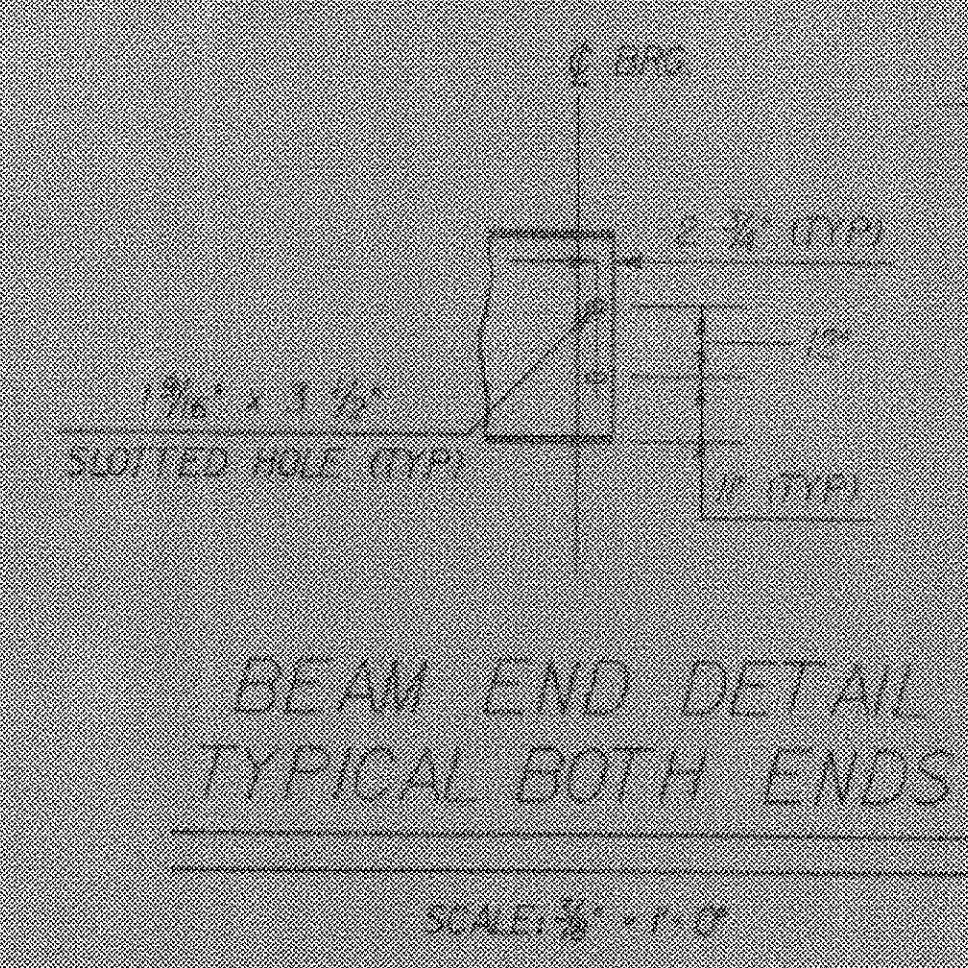
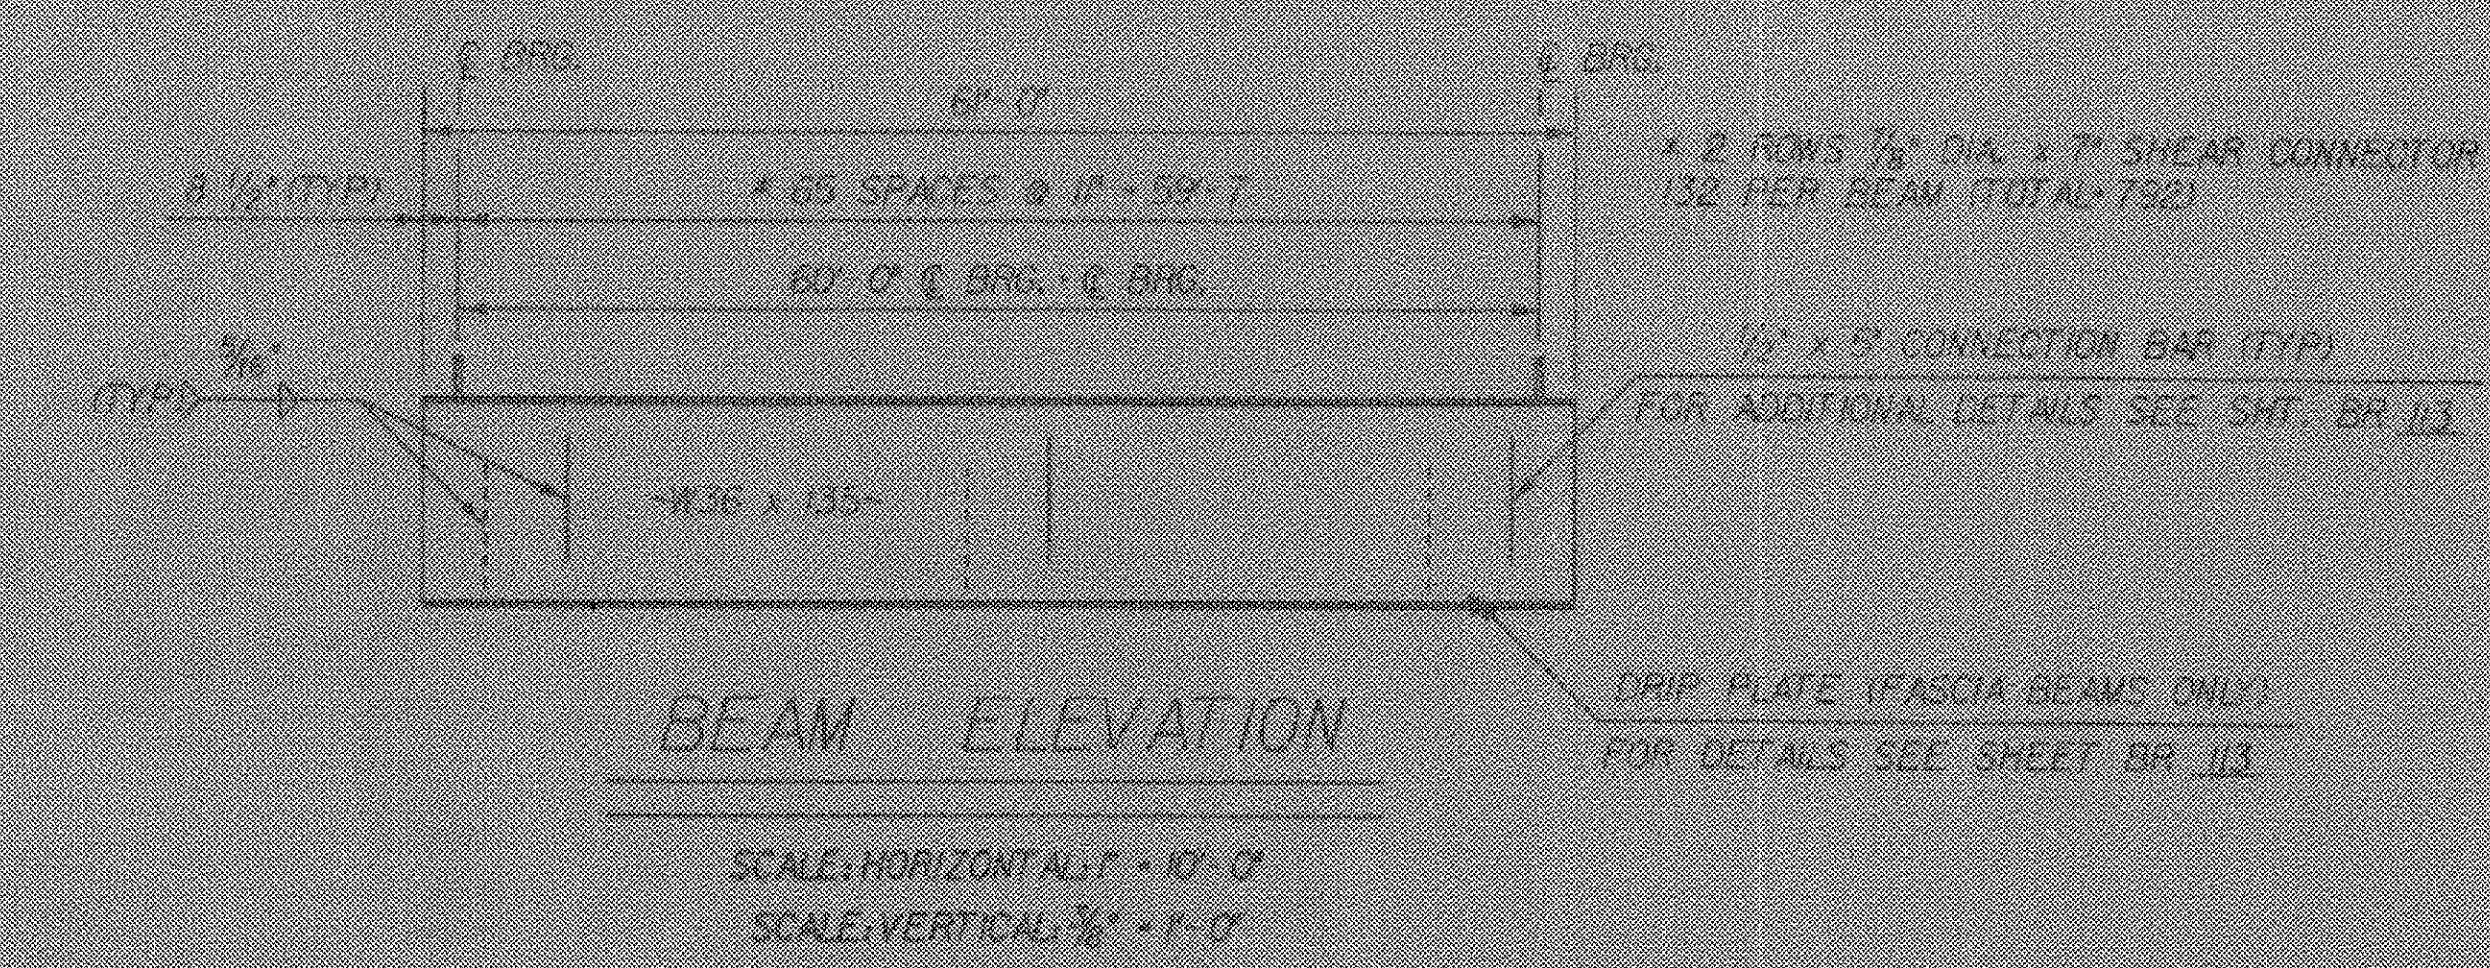
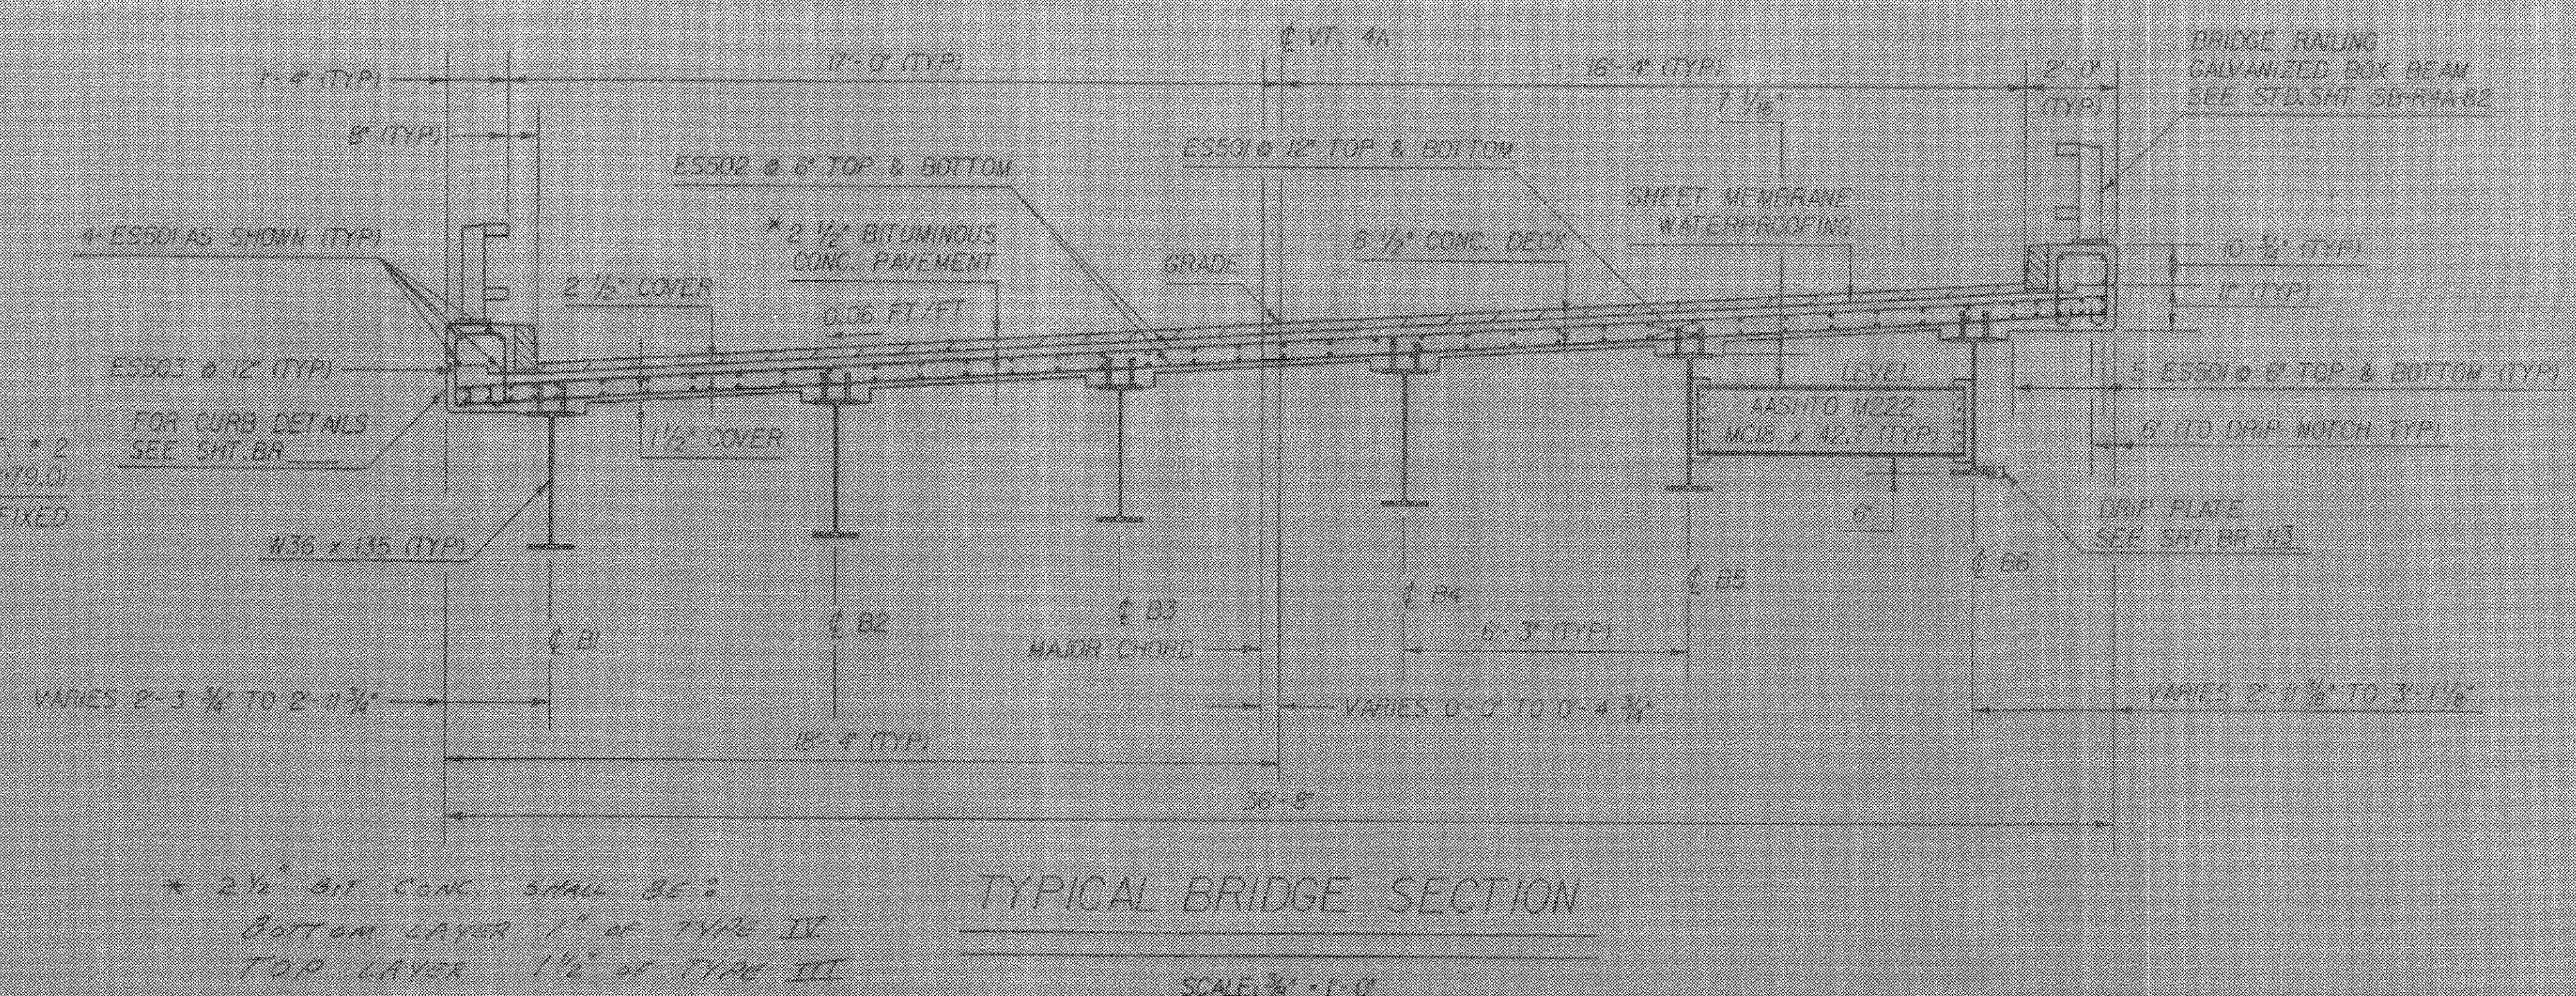


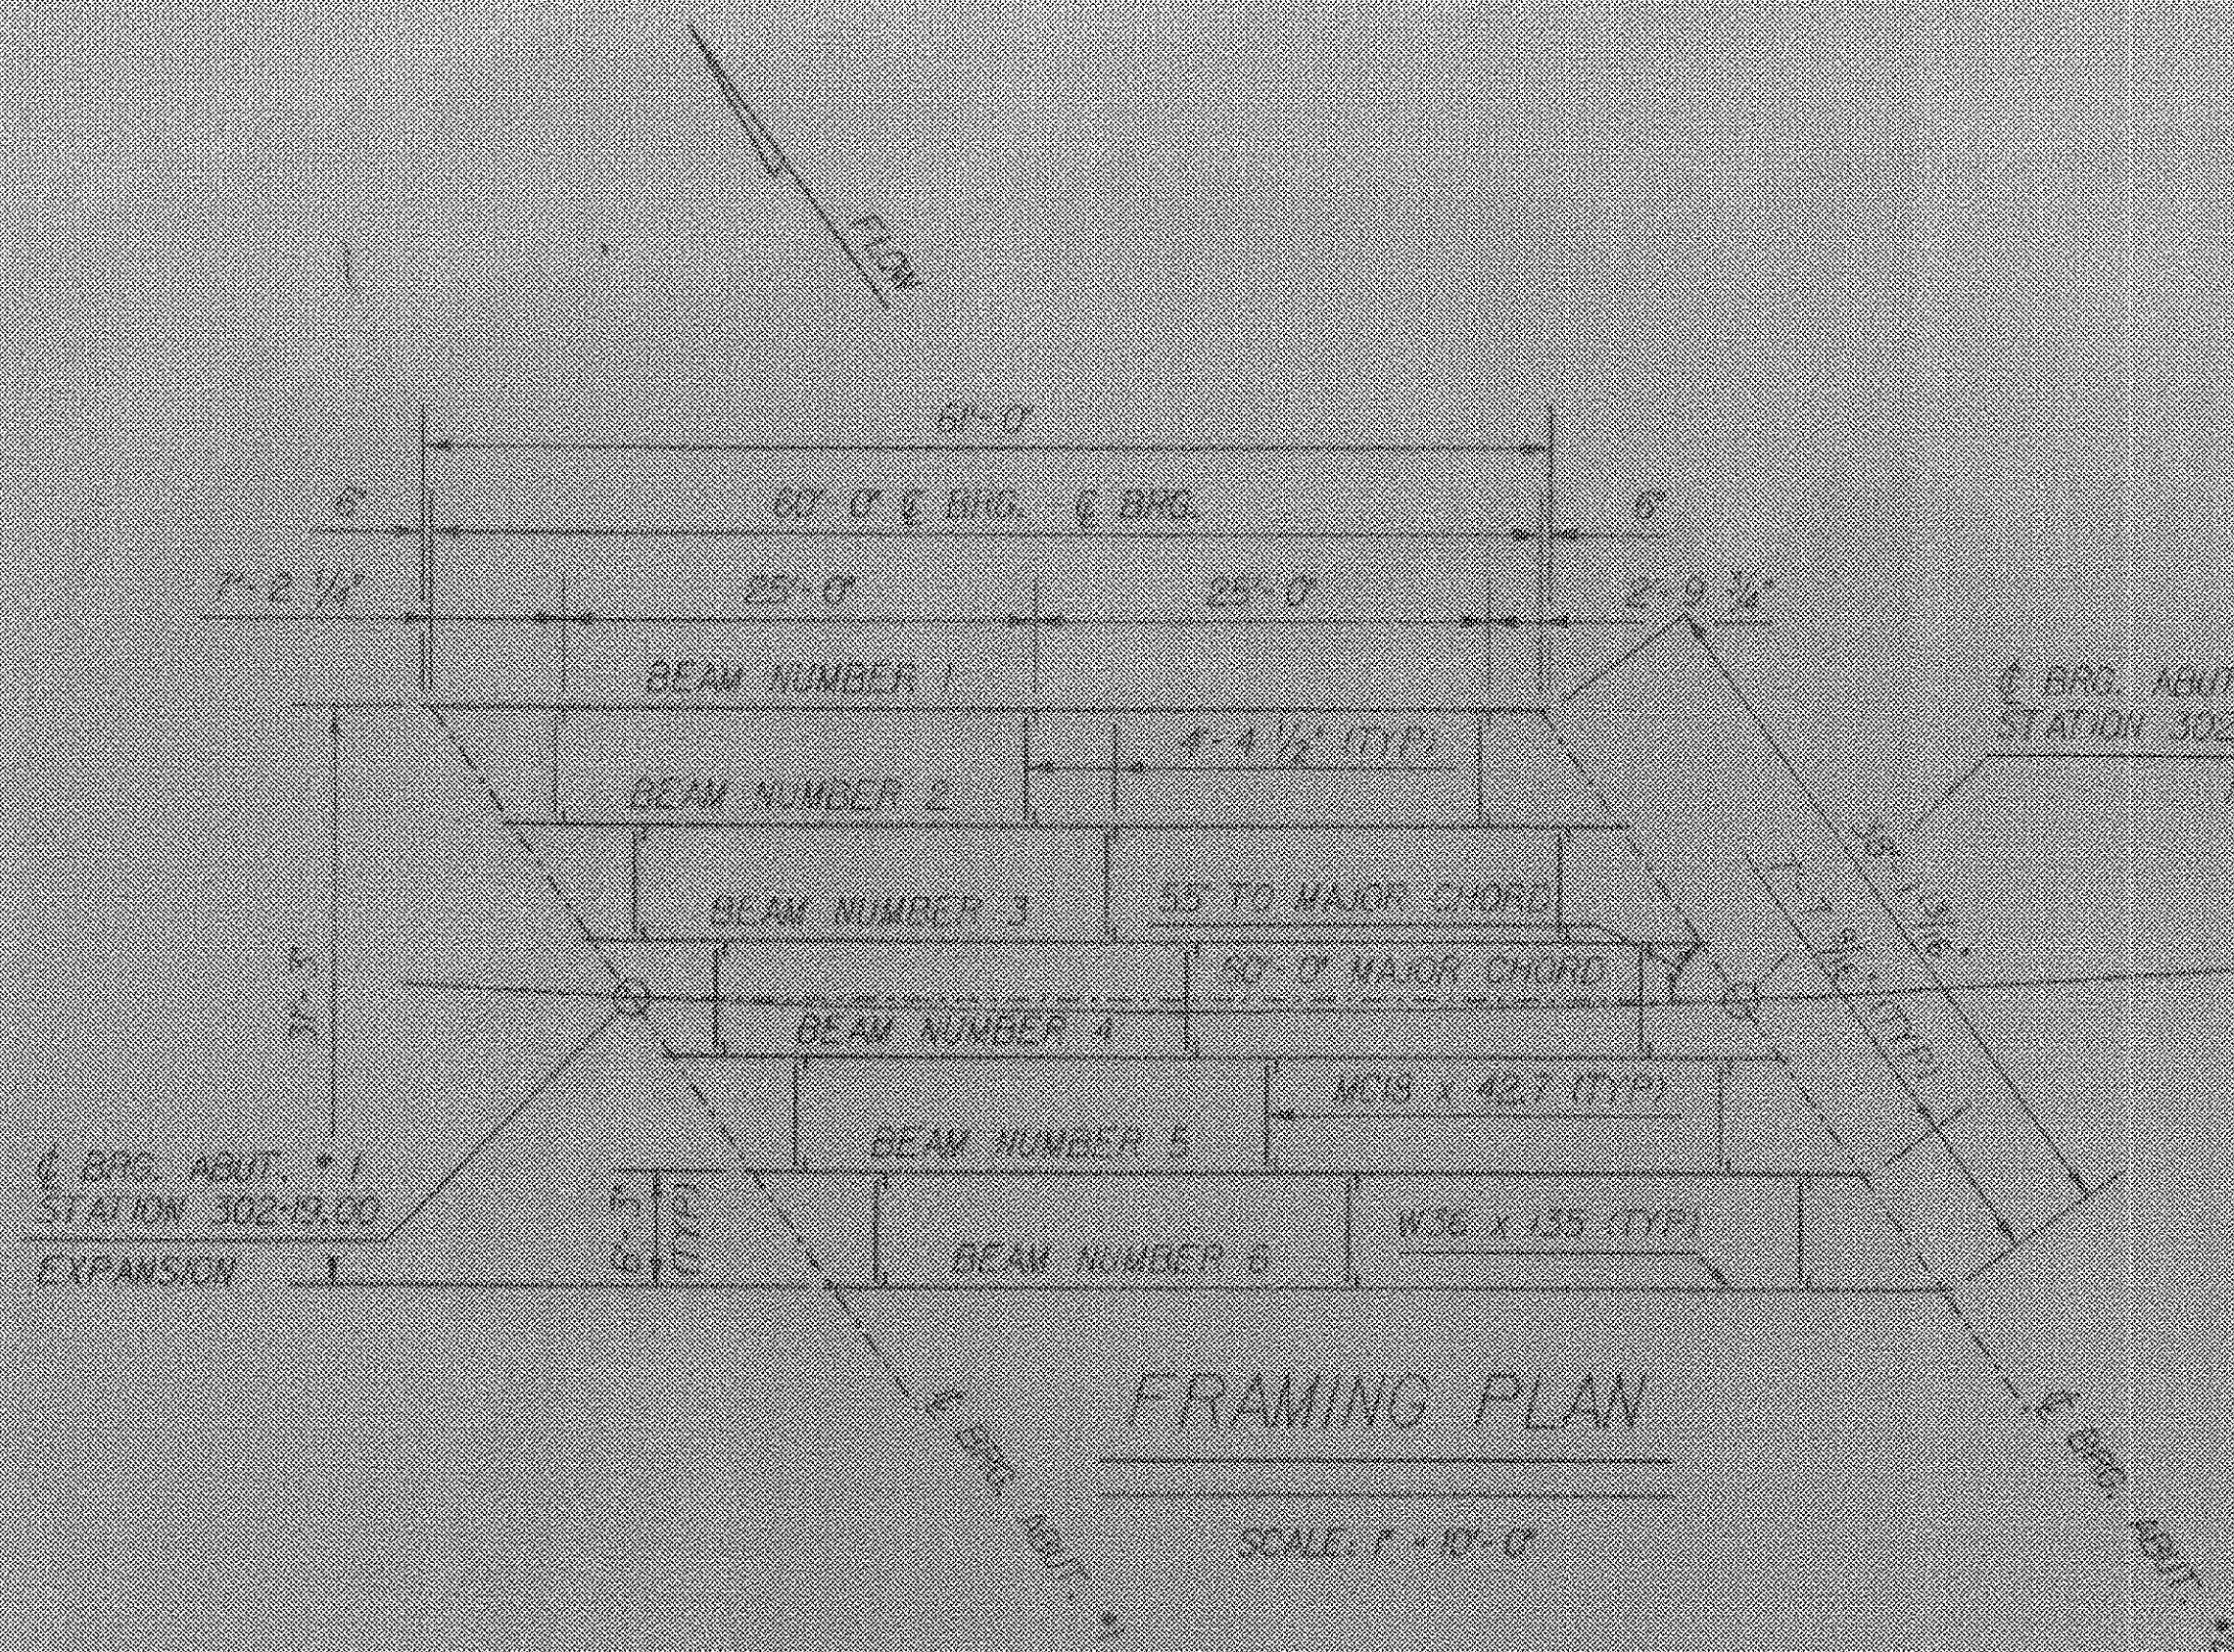

FAIR HAVEN - RUTLAND
BHF MEMB(2)
SHEET 42 OF 45
BRIDGE 11
FOR REFERENCE ONLY

STATE OF VERMONT AGENCY OF TRANSPORTATION			
Town Of	CASTLETON	Bridge No.	11
Highway No.	VT. 4A	Log Sta.	
		Surv. Sta.	302+50
SUPERSTRUCTURE DETAILS			
VT. 4A OVER THE CASTLETON RIVER			
Designed By	R. J. PANALIX	Drawn By	K. S. CLARIMONT
Checked By	M. J. POLCGRUTO	Date	1/87
		Bridge Design Supervisor	R. S. HAUPT
		Date	3/87
PROJECT	CASTLETON	PROJECT NO.	RS 0142(III)
LOG. INFO.	ZFAI 130.471 78F194SEC DGN 1	PRF 78F194SEC	
Bridge Sheet No.	BR103	Sheet	29 of 90