



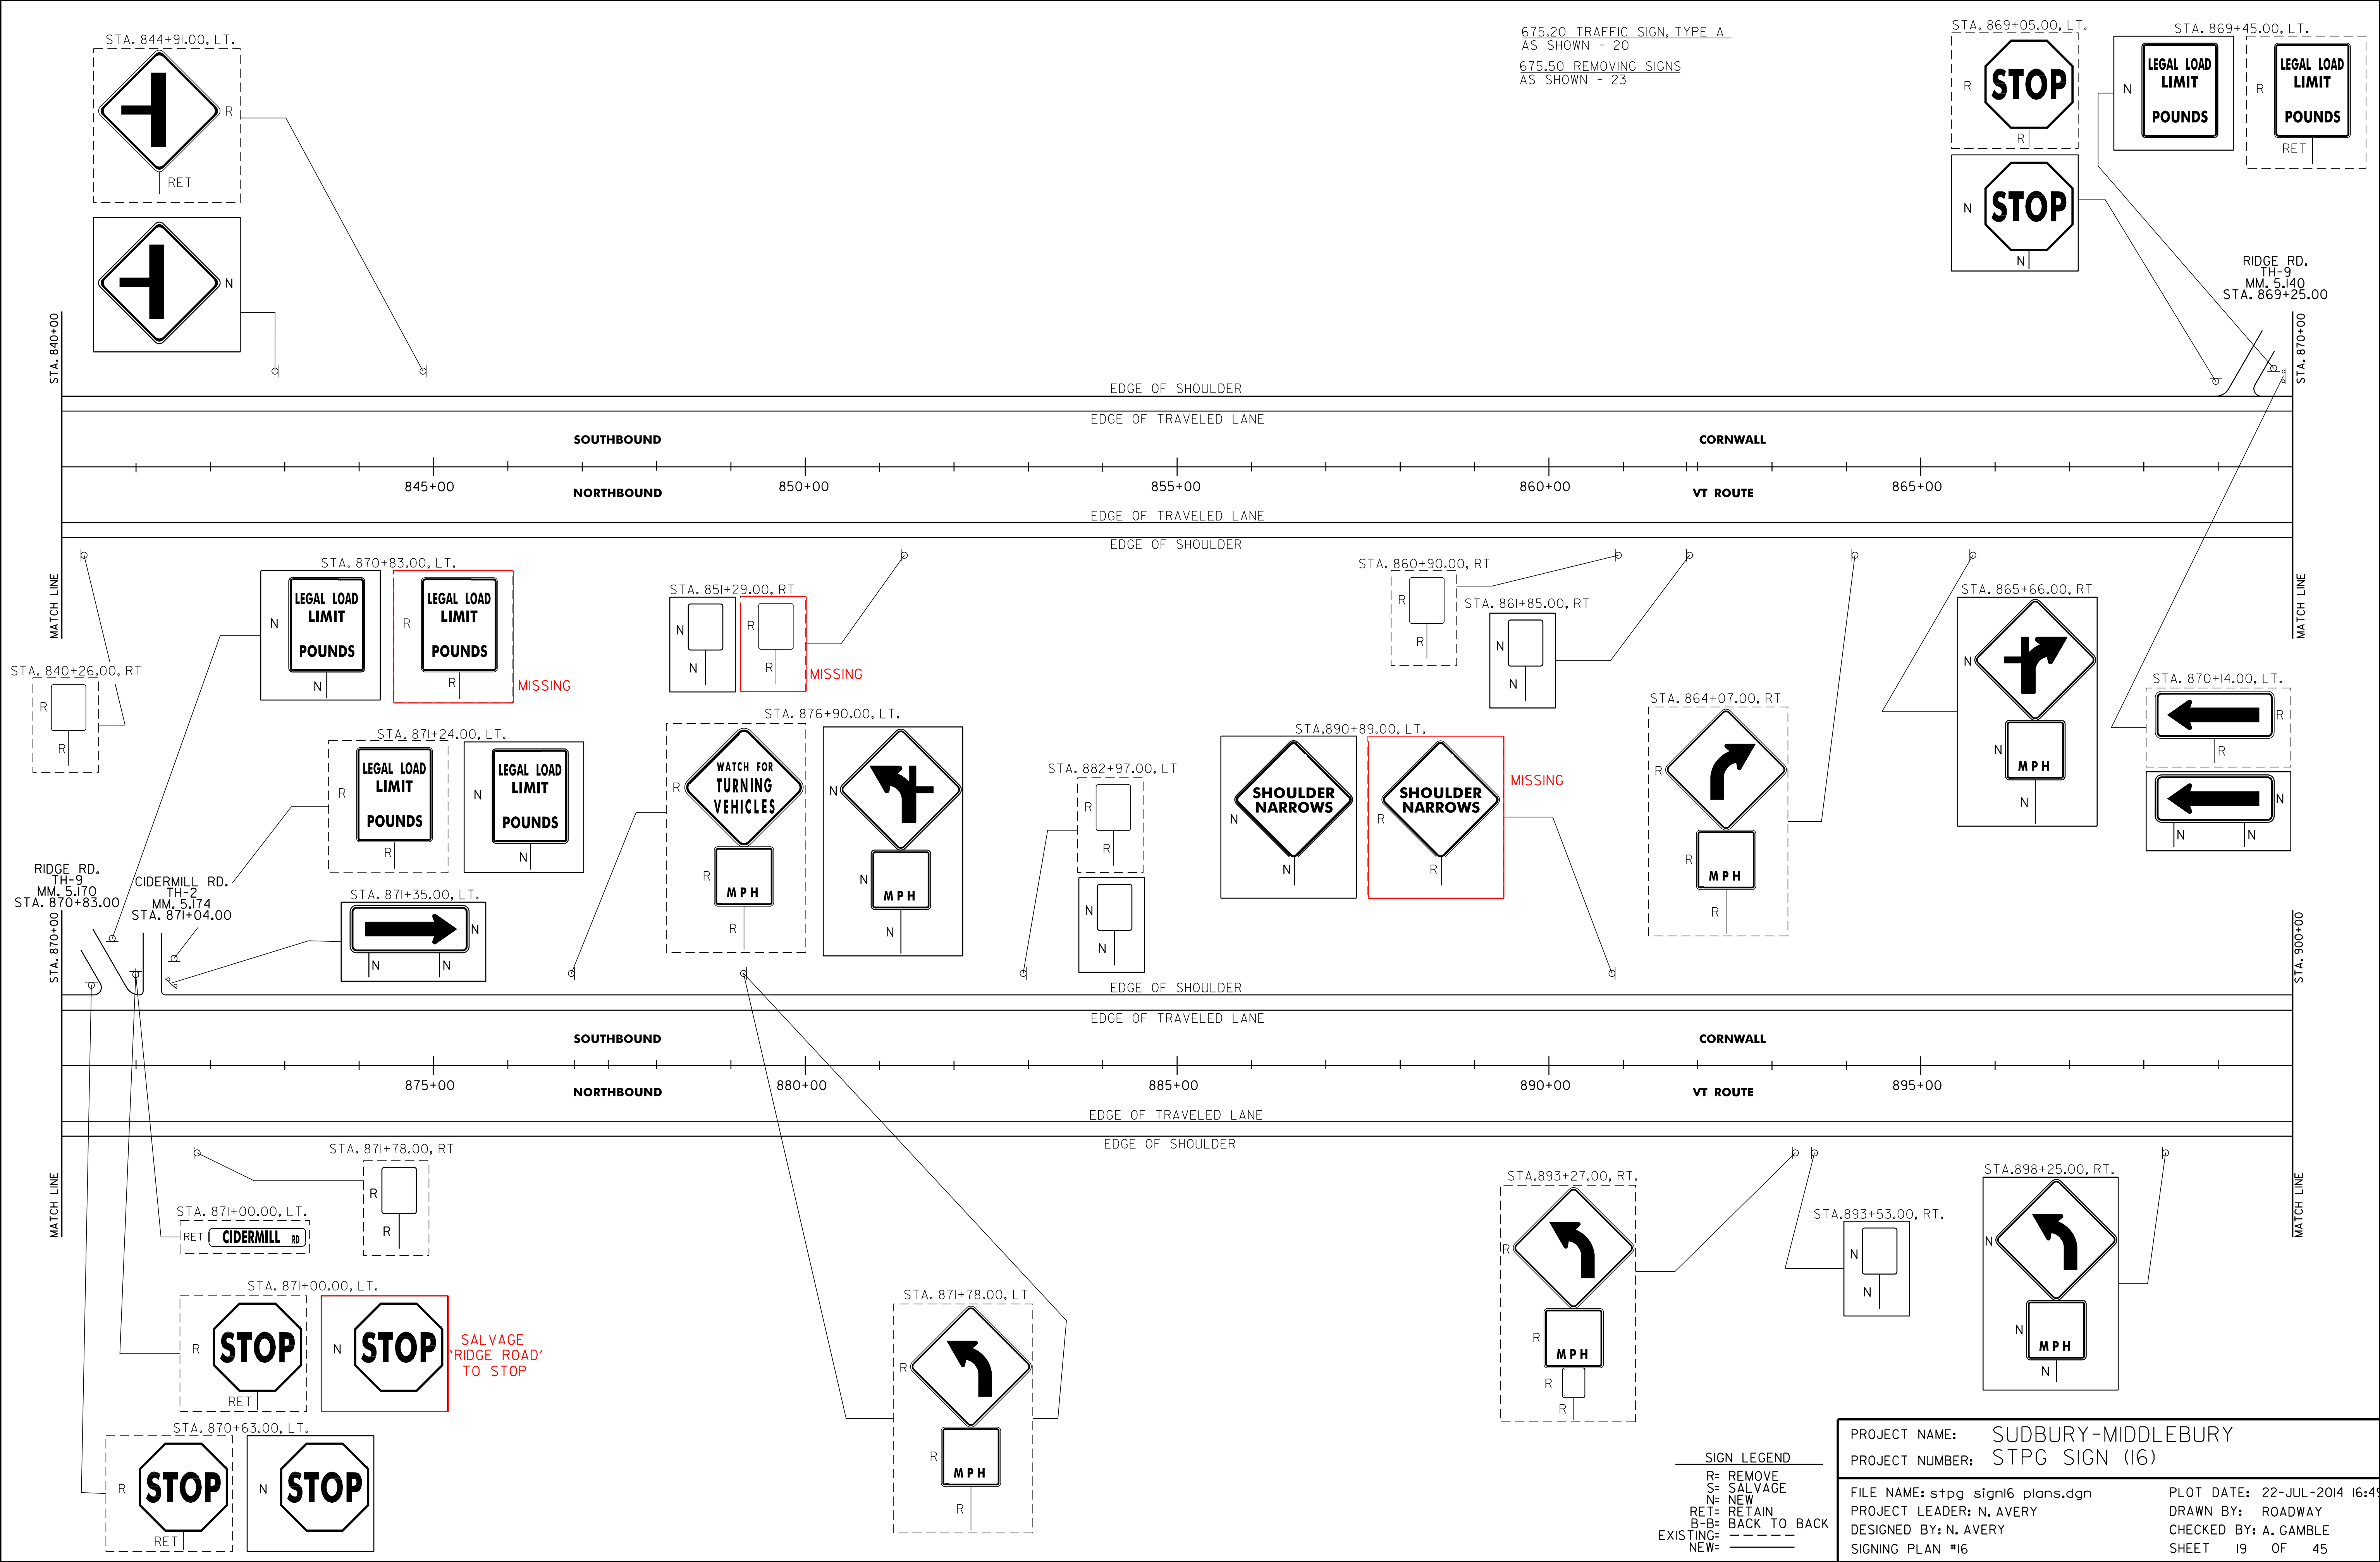

675.20 TRAFFIC SIGN, TYPE A
AS SHOWN - 20
675.50 REMOVING SIGNS
AS SHOWN - 23

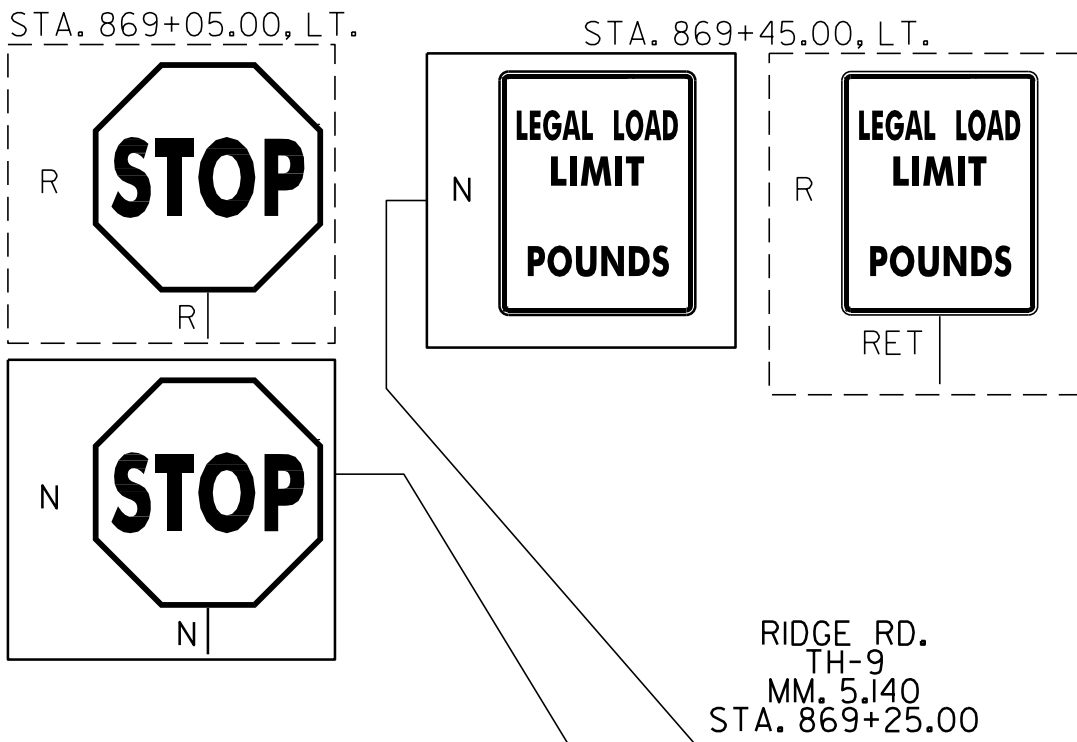

SIGN LEGEND

R= REMOVE
S= SALVAGE
N= NEW
RET= RETAIN
B-B= BACK TO BACK
EXISTING= ---
NEW= _____

PROJECT NAME: SUDBURY-MIDDLEBURY
PROJECT NUMBER: STPG SIGN (16)

FILE NAME: stpg sign16 plans.dgn
PROJECT LEADER: N. AVERY
DESIGNED BY: N. AVERY
SIGNING PLAN #16
PLOT DATE: 22-JUL-2014 16:49
DRAWN BY: ROADWAY
CHECKED BY: A. GAMBLE
SHEET 19 OF 45