

INDEX OF SHEETS

- 1 TITLE SHEET
- 2 PROJECT TYPICAL SHEET
- 3 PAVING DETAIL SHEET
- 4 ASPHALTIC PLUG JOINT DETAILS SHEET
- 5-6 QUANTITY SHEETS
- 7 ITEM DETAIL SUMMARY SHEET
- 8-16 PROJECT LAYOUT SHEETS
- 17-18 TRAFFIC SIGN SUMMARY SHEETS
- 19 TEMPORARY TRAFFIC CONTROL PLAN

VTrans STANDARDS

C-1	01-03-00
C-2A	10-14-05
C-3A	03-10-08
C-3B	03-10-08
E-100	01-02-04
E-100A	01-02-04
E-101	05-30-03
E-102	06-30-03
E-102A	05-01-04
E-106	03-01-04
E-108	08-18-95
E-110	08-08-95
E-121	08-08-95
E-145A	12-23-94
E-145B	12-23-94
E-152	05-01-04
E-160	05-20-99
E-161	08-18-95
E-162	05-20-99
E-163	05-20-99
E-164	05-20-99
E-191	02-01-99
E-192	10-12-00
E-193	08-18-95

RECORD PLANS

CONTRACTOR: PIKE INDUSTRIES, INC. - BERLIN, VT

RESIDENT ENGINEER: CARL FIELDER

CONSTRUCTION BEGAN: SEPTEMBER 22, 2008

CONSTRUCTION COMPLETE: JUNE 3, 2008

RECORD PLANS BY: CARL FIELDER & C. PIERCE


I HEREBY CERTIFY THAT ALL THE CONSTRUCTION REQUIRED BY THIS SET OF DRAWINGS HAS BEEN ACCOMPLISHED AS INDICATED HEREIN.

BY Carl Fielder RESIDENT ENGINEER

DATE 2/19/10

NOTE: Any further information concerning final quantities, amounts or other details relative to this project may be found at Central Files in the electronic archives.

STATE OF VERMONT AGENCY OF TRANSPORTATION

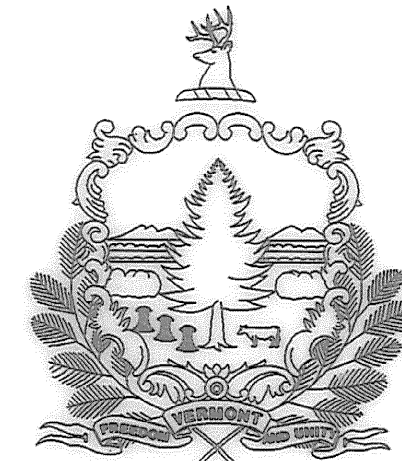


PROPOSED IMPROVEMENT CITY OF BARRE COUNTY OF WASHINGTON U.S. ROUTE 302

BEGINNING AT THE BERLIN/BARRE TOWN LINE AND EXTENDING EASTERLY ALONG
U.S. ROUTE 302 FOR A DISTANCE OF 8,943.5 FEET TO STA. 89+43.50

TOTAL LENGTH OF PROJECT: 8,943.5 FEET = 1.694 MILES
TOTAL LENGTH OF ROADWAY: 8,943.5 FEET = 1.694 MILES

WORK TO BE PERFORMED UNDER THIS PROJECT INCLUDES COLD PLANING, RESURFACING
OF THE EXISTING HIGHWAY, NEW PAVEMENT MARKINGS AND INCIDENTAL ITEMS

PROJECT STP 2801(1)S

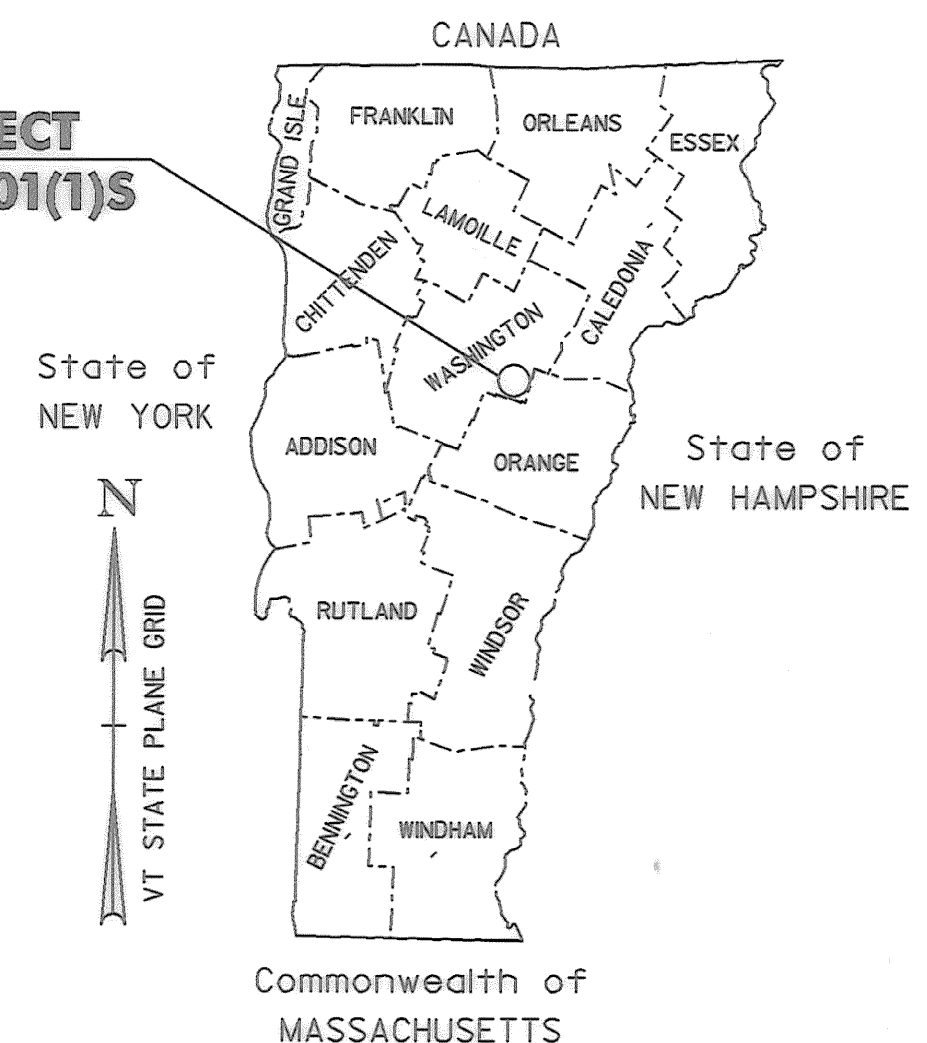


BITUMINOUS CONCRETE PAVEMENT SUPERPAVE MIXTURE DESIGN CRITERIA

DESIGN LANE/DESIGN LIFE ESALS	3,464,500
DESIGN NUMBER OF GYRATIONS	65
PERFORMANCE GRADED ASPHALT BINDER	64-28

TRAFFIC DATA U.S. ROUTE 302

LOCATION	AADT		DHV		ESALS	
	2008	2018	2008	2018	2008-2018	2008-2028
BEGIN PROJECT (BERLIN T/L) TO RICHARDSON ROAD	12,100	12,700	1,300	1,300	926,000	2,184,000
RICHARDSON ROAD TO BERLIN STREET	14,900	15,600	1,600	1,600	2,384,000	5,284,000
BERLIN STREET TO BECKLEY STREET	15,500	16,300	1,600	1,700	2,463,000	6,263,000
BECKLEY STREET TO END PROJECT (VT 14/VT 62)	15,700	16,300	1,600	1,700	2,737,000	6,929,000

BEGIN STP 2801(1)S
U.S. ROUTE 302
STA. 0+00.00

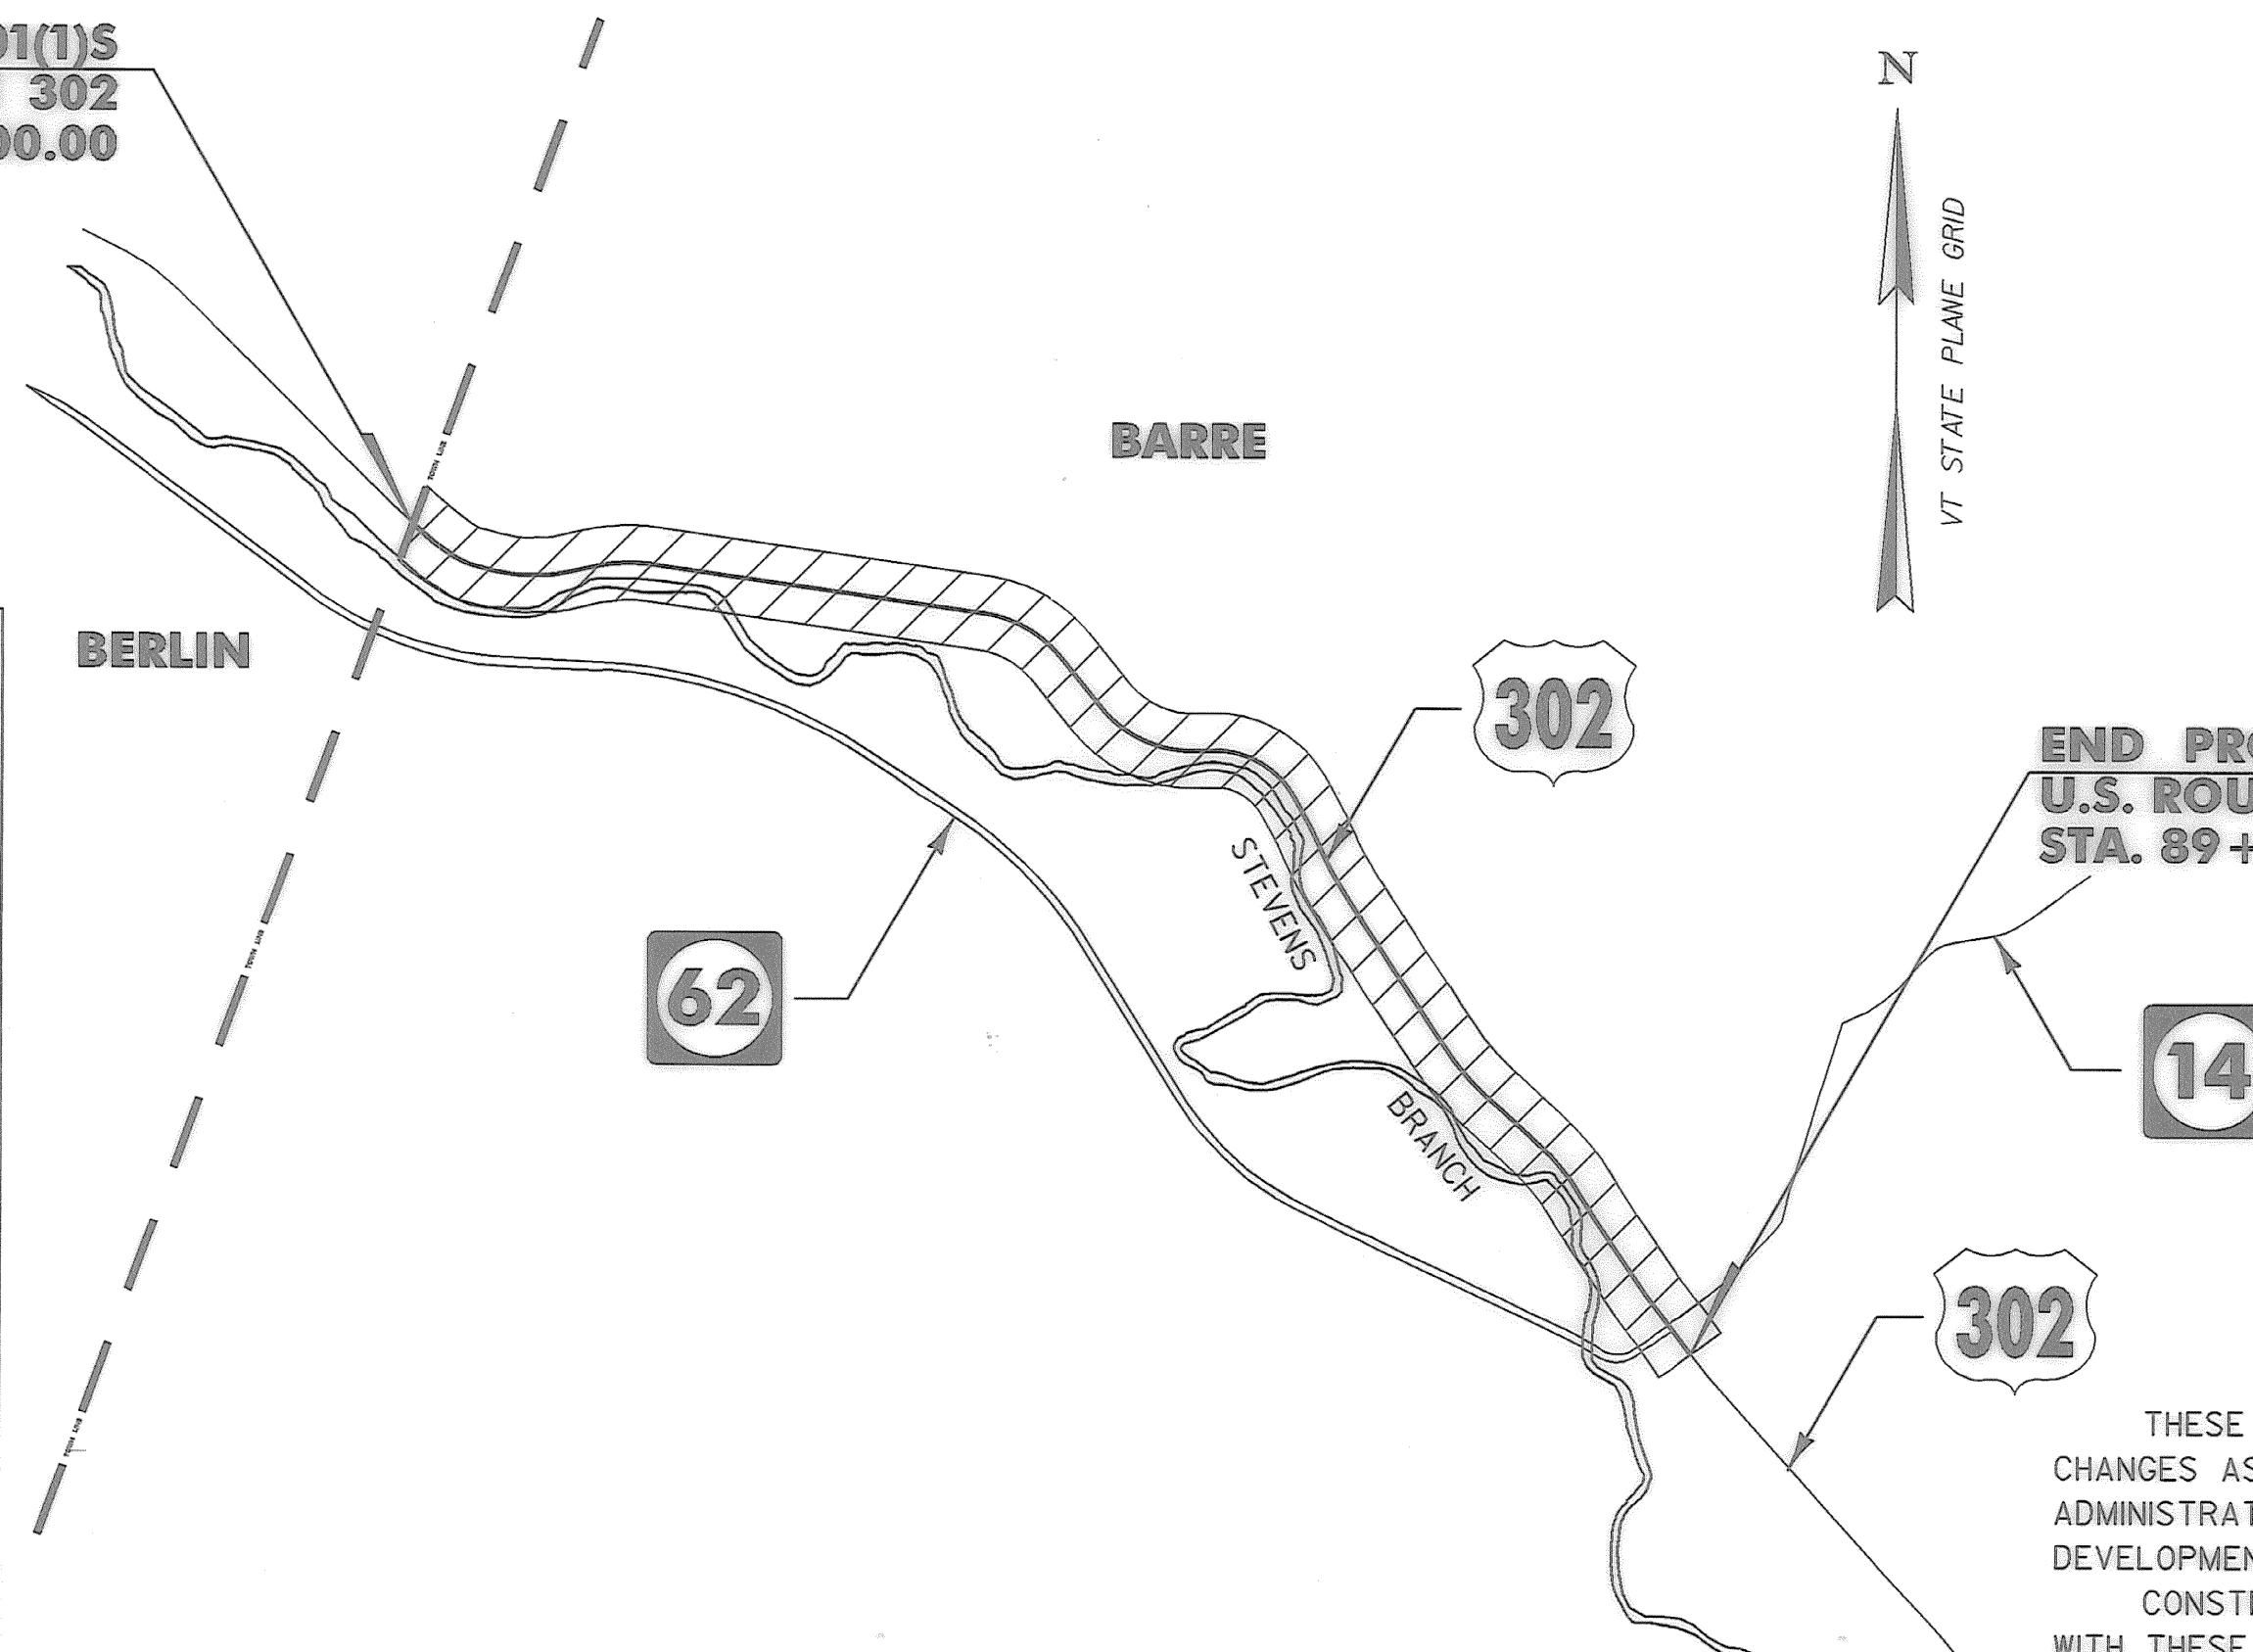

CONVENTIONAL SYMBOLS

COUNTY LINE	
TOWN LINE	
LIMITS OF ACCESS	
POINT OF ACCESS	
FENCE LINE	
STONE WALL	
TRAVELED WAY	
GUARD RAIL	
RAILROAD	
SURVEY LINE	
CULVERT	
POWER POLE	
TELEPHONE POLE	
TREES	
CONTROL OF ACCESS	
PROPERTY LINE	
R.O.W. TAKING LINE	
SLOPE RIGHTS	
TOP OF CUT	
TOE OF SLOPE	

UTILITY LEGEND	
	= EXISTING HYDRANT
	= EXISTING DI
	= EXISTING MANHOLE
	= EXISTING TELEPHONE MANHOLE
	= EXISTING ELECTRIC MANHOLE
	= EXISTING SEWER MANHOLE
	= EXISTING WATER SHUTOFF
	= EXISTING GAS SHUTOFF
	= EXISTING MAILBOX

SIGN LEGEND	
N	= NEW
R	= REMOVE
R&S	= REMOVE & SALVAGE
S	= SALVAGE SIGN
RET	= RETAIN
B-B	= BACK TO BACK
①	= RETURN TO CITY OF BARRE

SURVEYED BY : N/A
SURVEYED DATE : N/A

DATUM
VERTICAL N/A
HORIZONTAL N/A

END PROJECT STP 2801(1)S
U.S. ROUTE 302
STA. 89+43.50

THESE PLANS ARE SUBJECT TO SUCH ENGINEERING
CHANGES AS MAY BE REQUIRED BY THE FEDERAL HIGHWAY
ADMINISTRATION OR THE DIRECTOR OF PROGRAM
DEVELOPMENT.

CONSTRUCTION IS TO BE CARRIED ON IN ACCORDANCE
WITH THESE PLANS AND THE STANDARD SPECIFICATIONS
FOR CONSTRUCTION DATED 2006, AS APPROVED BY THE
FEDERAL HIGHWAY ADMINISTRATION ON JUNE 15, 2006
FOR USE ON THIS PROJECT, INCLUDING ALL SUBSEQUENT
REVISIONS AND SUCH REVISED SPECIFICATIONS AND
SPECIAL PROVISIONS AS ARE INCORPORATED IN THESE
PLANS.

NOTE:

RIGHT-OF-WAY LIMITS, IF APPLICABLE, ARE
PROVIDED SOLELY FOR THE CONVENIENCE
OF THE STATE AND ITS CONTRACTOR DURING
THE COURSE OF THIS PAVING PROJECT.
ANY REFERENCES TO OFFSETS ON THESE
PLANS ARE APPROXIMATE AND SHOULD NOT
BE RELIED UPON FOR ANY PURPOSES.

UNLESS OTHERWISE NOTED, ALL DRAWINGS
AND DETAILS ON THESE PLANS ARE DRAWN
"NOT TO SCALE".



DIRECTOR OF PROGRAM DEVELOPMENT	
APPROVED <u>Richard D. Dorney</u>	DATE <u>7-9-08</u>
PROJECT MANAGER : TED DOMEY	
PROJECT NAME : BARRE CITY	
PROJECT NUMBER : STP 2801(1)S	
SHEET 1 OF 19 SHEETS	

NOTES

1. THE PAVEMENT WEARING COURSE SHALL BE 65 GYRATION SUPERPAVE BITUMINOUS CONCRETE PAVEMENT TYPE IVS, THE ESTIMATED 1/2" LEVELING COURSE SHALL BE SUPERPAVE BITUMINOUS CONCRETE PAVEMENT TYPE IVS UNLESS OTHERWISE DIRECTED BY THE ENGINEER. ALL ASPHALT CEMENT USED IN THE SUPERPAVE BITUMINOUS CONCRETE PAVEMENT SHALL BE PG 64-28.
2. GRASS GROWING ADJACENT TO PAVEMENT OR THROUGH CRACKS IN THE PAVEMENT WHICH MAY HAMPER THE PLACEMENT OF NEW BITUMINOUS CONCRETE SHALL BE REMOVED BY THE CONTRACTOR AS DIRECTED BY THE ENGINEER. PAYMENT FOR THIS WORK WILL NOT BE MADE DIRECTLY, BUT WILL BE CONSIDERED INCIDENTAL TO ITEM 490.30 SUPERPAVE BITUMINOUS CONCRETE PAVEMENT.
3. SUPERPAVE BITUMINOUS CONCRETE PAVEMENT TOLERANCE = +1/4". (TOTAL THICKNESS EXCLUDING LEVELING)
4. EMULSIFIED ASPHALT SHALL BE APPLIED ON EXISTING PAVEMENT SURFACES, BETWEEN ALL COURSES OF PAVEMENT AND ON COLD PLANED SURFACES, AT THE RATE OF 0.025 GAL/SY OR AS DIRECTED BY THE ENGINEER.
5. COLD PLANING TO BE COMPLETED ACCORDING TO TYPICAL OR AS NOTED OTHERWISE ON THE PLANS. THE COLD PLANING AND PAVING SHALL MATCH THE EXISTING CONDITIONS AT THE BEGINNING AND END OF CONSTRUCTION AREAS BY THE USE OF A VERTICAL BUTT JOINT. SEE DETAIL ON SHEET 3. IF COLD PLANING 2" SHOULD EXPOSE CONCRETE, ANY JOINTS LARGER THAN 1" SHALL BE CLEANED OUT AND FILLED WITH TYPE VS. ANY AREAS THAT EXPOSE SUBBASE SHALL BE CLEANED TO A DEPTH OF 2" AND PATCHED WITH TYPE III AS DIRECTED BY THE ENGINEER. ESTIMATED QUANTITIES OF CONTRACT ITEM 490.30 HAVE BEEN INCLUDED FOR THESE SITUATIONS.
6. ALTHOUGH THERE ARE 71 STRUCTURE ADJUSTMENTS QUANTIFIED FOR THIS PROJECT, IT SHOULD BE NOTED THAT SOME OF THESE MAY BE ELIMINATED AS DIRECTED BY THE RESIDENT ENGINEER. THE CONTRACTOR SHALL COORDINATE WITH THE BARRE CITY DEPARTMENT OF PUBLIC WORKS.
7. BITUMINOUS CONCRETE PAVEMENT WORK WHICH COULD INVOLVE SOME HAND-WORK (SUCH AS AROUND SEWER MANHOLES AND DROP INLETS, ETC.) SHALL BE PAID AS ITEM 490.30, SUPERPAVE BITUMINOUS CONCRETE PAVEMENT (PG 64-28).
8. EXISTING SHOULDER MATERIAL DEEMED UNSUITABLE BY THE RESIDENT ENGINEER SHALL BE EXCAVATED TO A DEPTH OF 3" OR AS DIRECTED BY THE RESIDENT ENGINEER. EXCAVATION WILL BE PAID FOR AS ALL PURPOSE EXCAVATOR RENTAL, TYPE I. MATERIAL REMOVED SHALL BE REPLACED WITH SUBBASE OF CRUSHED GRAVEL, FINE GRADED. EXCAVATED MATERIAL SHALL BE SPREAD ON THE ADJACENT SLOPES OR REMOVED FROM THE PROJECT AS DIRECTED BY THE RESIDENT ENGINEER.
9. SIDEWALK RAMP DETECTABLE WARNING SURFACES SHALL BE ARMOR-TILE SURFACE APPLIED TRUNCATED DOME SURFACES BY ENGINEERED PLASTICS, INC., COLOR YELLOW, FROM THE AGENCY'S APPROVED PRODUCT LIST.

URBAN AREAS – SEED MIXTURE

% WT	LBS/A	NAME	PUR %	GERM %
42.5	34	CREPPING RED FESCUE	98	85
10.0	8	PERENNIAL RYE GRASS	95	90
42.5	34	KENTUCKY BLUE GRASS	85	85
0	4	ANNUAL RYE GRASS	95	85
100	80			

SEED MIXTURE:
SHALL NOT HAVE A WEED CONTENT EXCEEDING 0.40% BY WEIGHT
AND SHALL BE FREE OF ALL NOXIOUS SEED.

SEED:
TO BE APPLIED PER SEEDING FORMULAS OR AS DIRECTED BY THE ENGINEER.

FERTILIZER:
FORMULA 10-20-10, TO BE USED WITH SEED, APPLIED AT THE RATE
OF 500 LBS/ACRE. (HYDRO SEEDERS MAY USE 19-19-19 FORMULA.)


AGRICULTURAL LIMESTONE:
TO BE APPLIED AT THE RATE OF 2 TONS/ACRE, OR AS DIRECTED
BY THE ENGINEER.

TEMPORARY EROSION MATTING (ITEM 653.20):
TO BE PLACED ON EARTH SLOPES AS DIRECTED BY THE ENGINEER.

TOPSOIL:
TO BE USED AS INDICATED ON THE PLANS, OR AS DIRECTED BY
THE ENGINEER.


COLD PLANE TYPICAL SECTION – BRIDGE NO. 5

STA. 81+16 TO 81+40

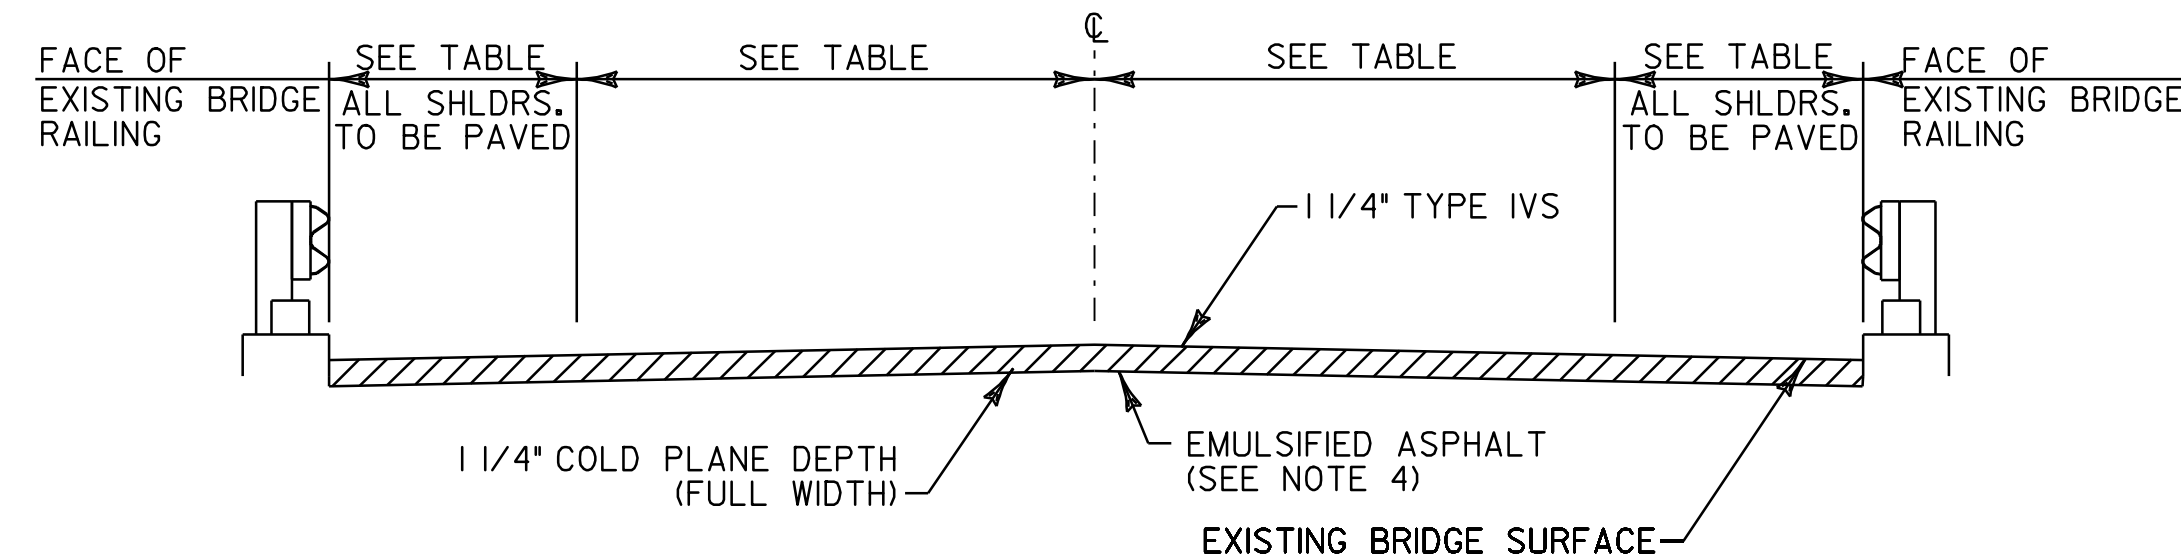

COLD PLANE TYPICAL SECTION – CURBED

STA. 0+00 TO 81+16
STA. 81+40 TO 89+43.5

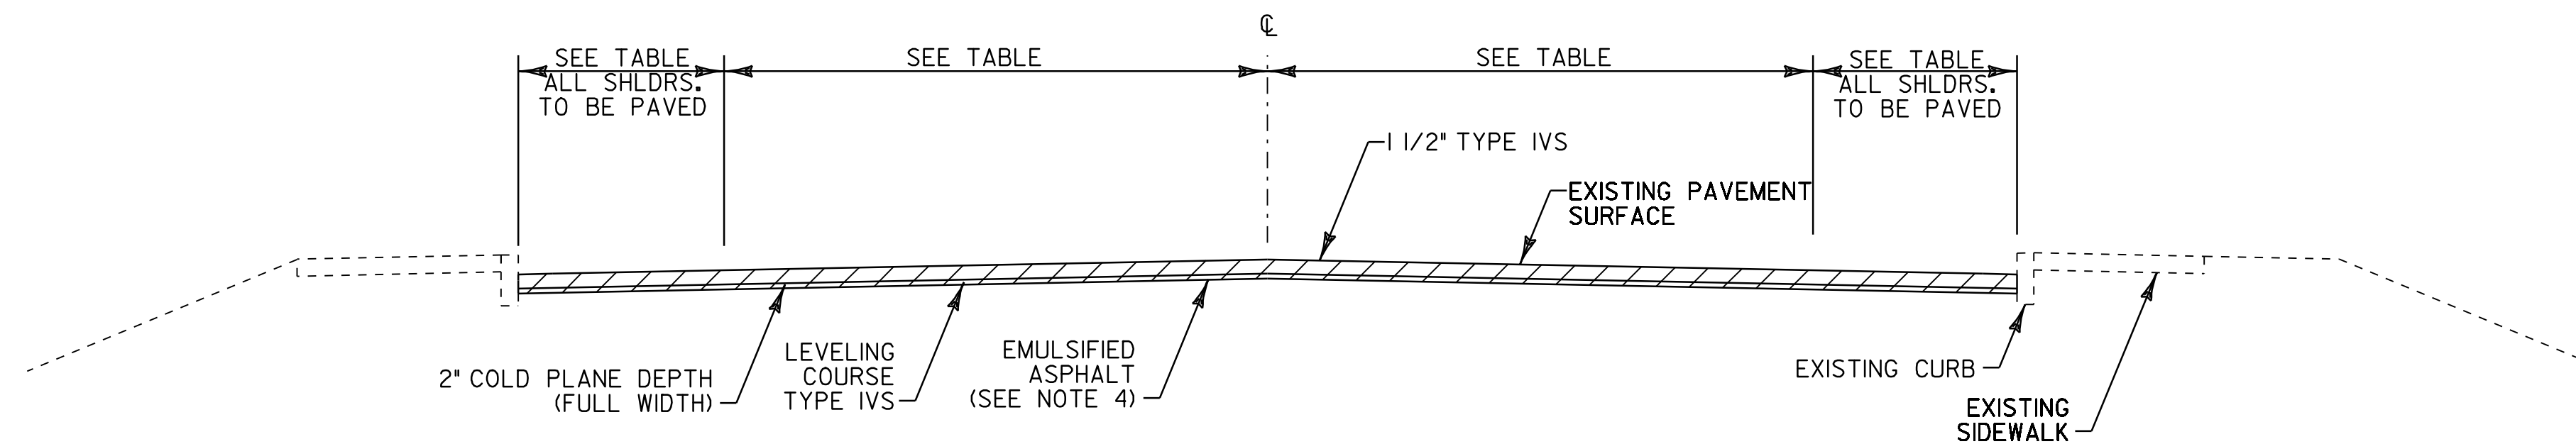

PROJECT PAVING LIMITS


[illegible]

NOT TO SCALE

PROJECT TYPICAL SHEET

PROJECT NAME:	BARRE CITY
PROJECT NUMBER:	STP 2801(1)S


FILE NAME: p08d022.dgn	PLOT DATE: 14-APR-2010
PROJECT LEADER: JLL	DRAWN BY: STANTEC
DESIGNED BY: STANTEC	CHECKED BY: JLL
IPARM FILE: p08d022pt.i	SHEET 2 OF 19

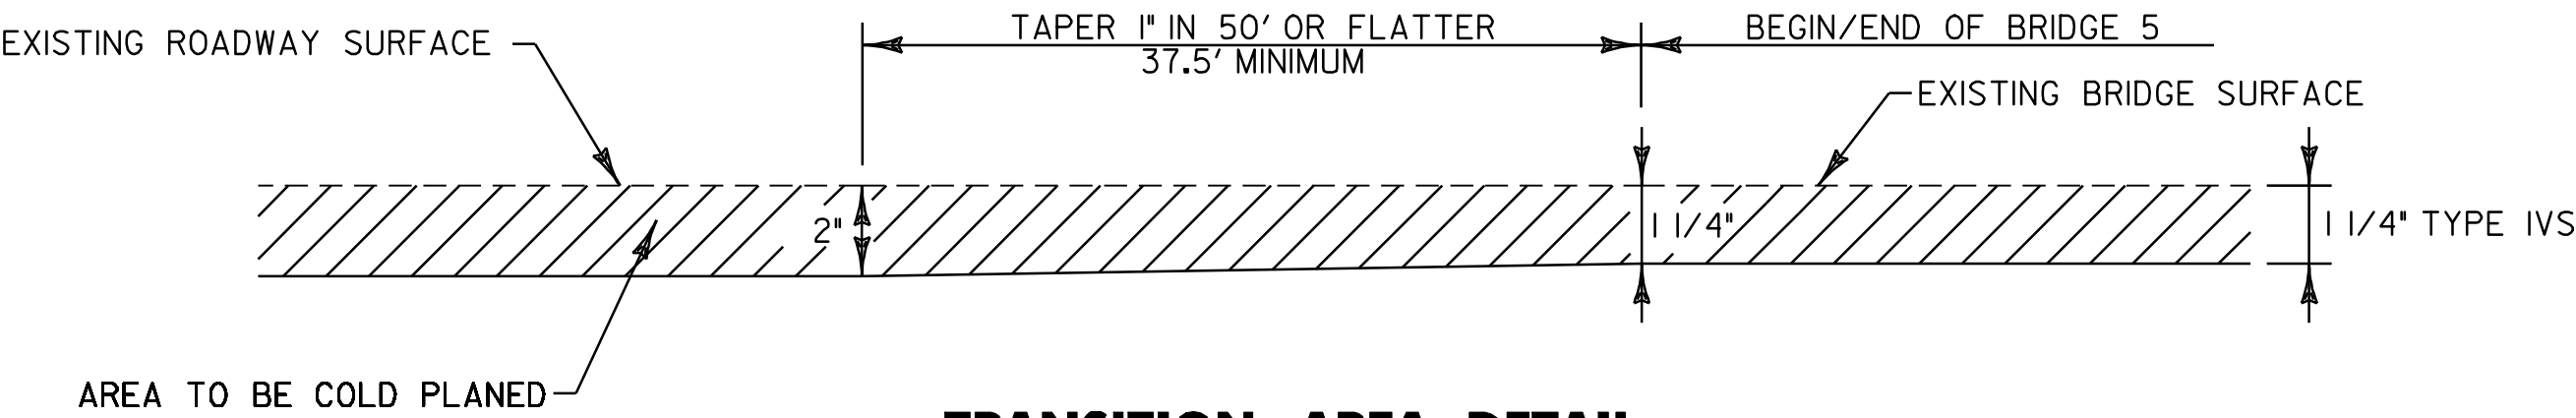

TRANSITION AREA DETAIL

FULL ROADWAY WIDTH

STA. 80+78.5 TO 81+16.0
STA. 81+40.0 TO 81+77.5

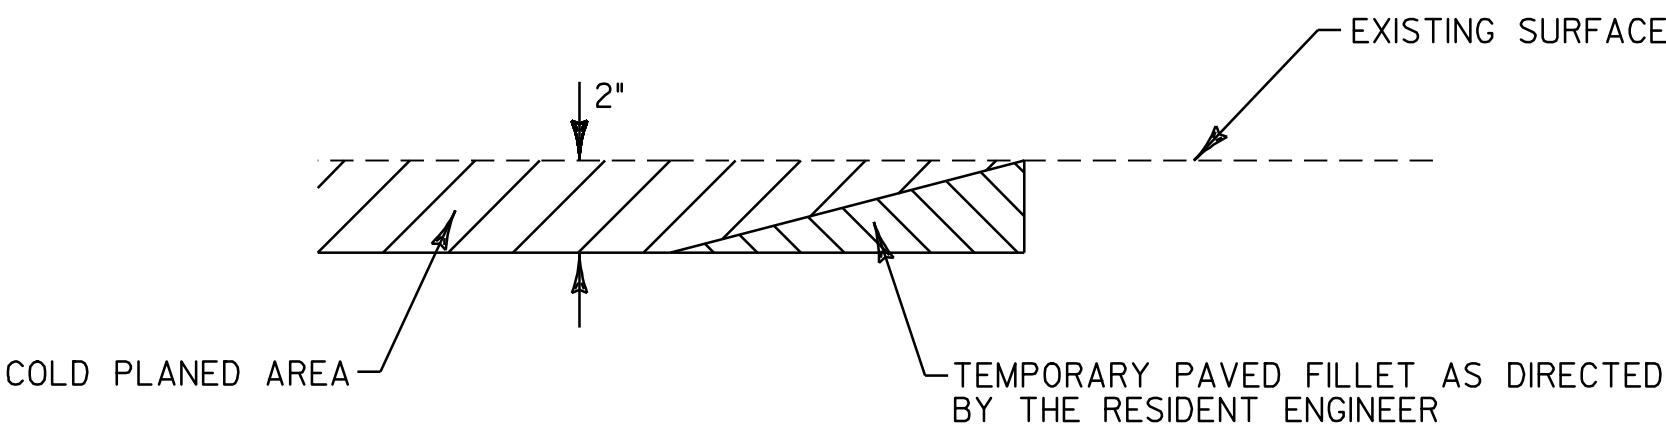

DETAIL AT VERTICAL COLD PLANE JOINTS

NOTE: THIS DETAIL SHALL BE USED FOR THE SIDE ROADS LISTED BELOW AND AT ALL DRIVES AS DIRECTED BY THE RESIDENT ENGINEER. PAYMENT SHALL BE INCIDENTAL TO ITEM 490.30.

FULL ROADWAY WIDTH

STA. 0+00.00 (BEGIN PROJECT)
STA. 29+81.8, LT (PACKARD ST.)
STA. 31+77.0, LT (FORD ST.)
STA. 41+11.2, LT (RICHARDSON RD.)
STA. 54+35.6, RT (WILLEY ST.)
STA. 55+67.6, LT (SIXTH ST.)
STA. 58+11.5, LT (FIFTH ST.)
STA. 60+52.4, LT (FOURTH ST.)
STA. 62+95.2, LT (THIRD ST.)
STA. 65+33.0, LT (SECOND ST.)
STA. 65+33.0, RT (WEST SECOND ST.)
STA. 67+76.4, LT (FIRST ST.)
STA. 68+95.6, RT (BERLIN ST.)
STA. 71+68.5, LT (BECKLEY ST.)
STA. 76+35.0, LT (N. SEMINARY ST.)
STA. 82+24.4, RT (BLACKWELL ST.)
STA. 84+74.1, LT (BROOK ST.)
STA. 86+17.7, RT (HORACE LANE)
STA. 87+51.0, RT (VT ROUTE 62)
STA. 87+57.4, LT (VT ROUTE 14)
STA. 89+43.5 (END PROJECT)




NOT TO SCALE

**PAVING
DETAIL
SHEET**

PROJECT NAME: BARRE CITY
PROJECT NUMBER: STP 2801(I)S

FILE NAME: p08d022.dgn	PLOT DATE: 14-APR-2010
PROJECT LEADER: JLL	DRAWN BY: STANTEC
DESIGNED BY: STANTEC	CHECKED BY: JLL
IPARM FILE: p08d022pds.i	SHEET 3 OF 19

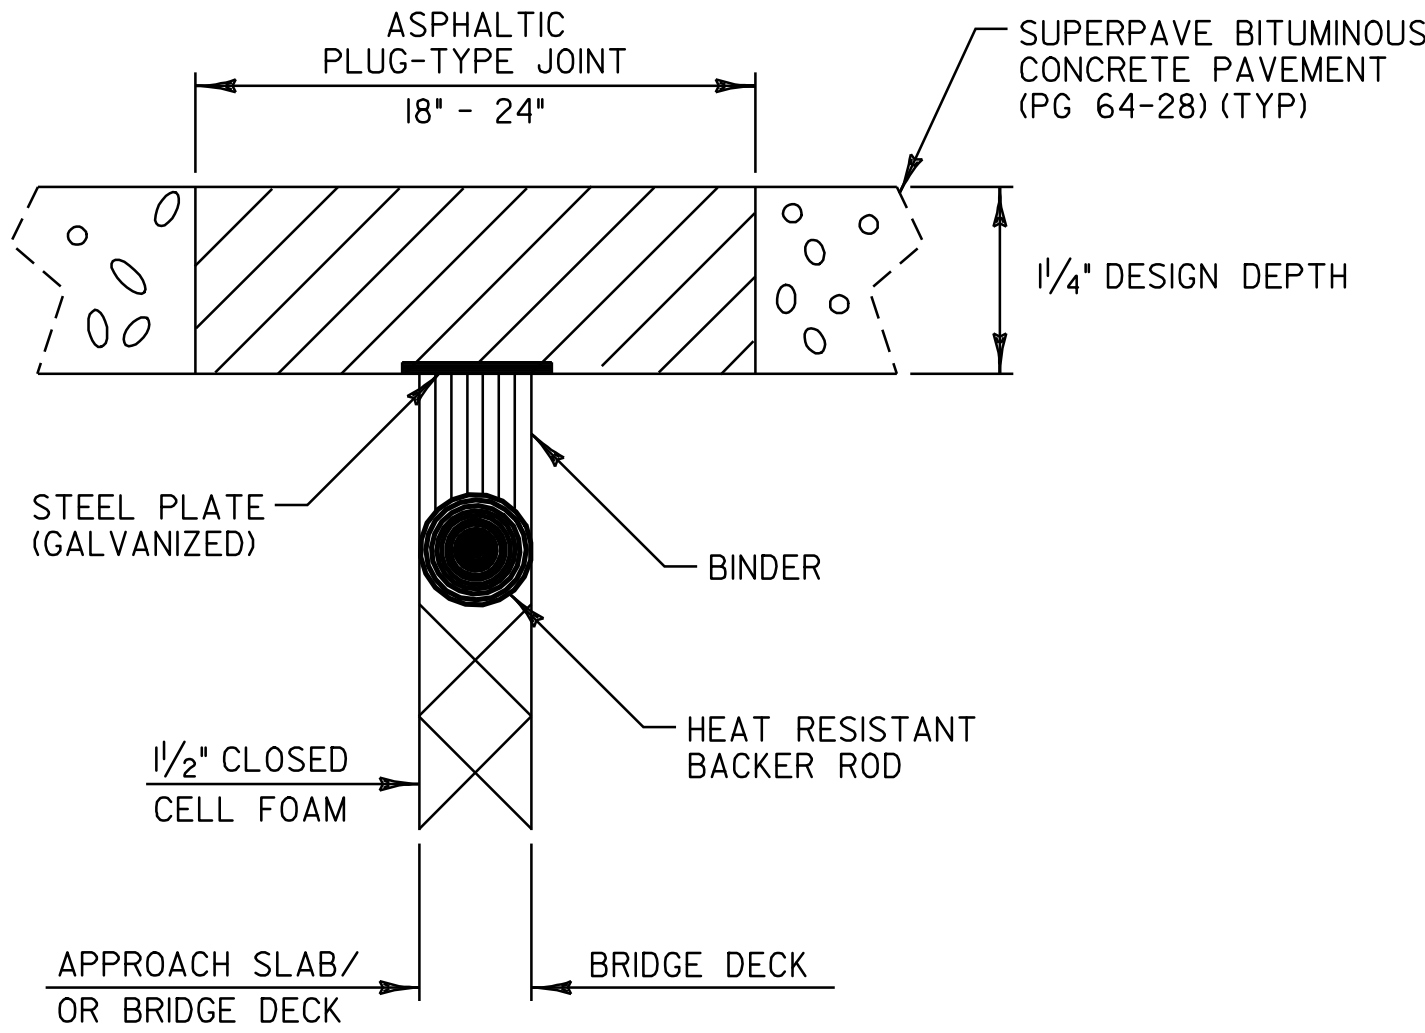

ASPHALTIC PLUG-TYPE JOINT DETAIL

BR 5 U.S. ROUTE 302 BARRE CITY STA. 8+16 (39 LF)
BR 5 U.S. ROUTE 302 BARRE CITY STA. 8+40 (39 LF)

NOTES:


- THE JOINT SHALL BE LOCATED CENTRALLY OVER THE DECK EXPANSION GAP OR FIXED JOINT MARKED OUT TO THE MANUFACTURER'S RECOMMENDED WIDTH.
- THE JOINT SHALL BE EXCAVATED AS SHOWN ON THE PLANS BY USE OF SAWS AND PNEUMATIC HAMMER OR A HAMMER AND CHISEL.
- THE JOINT AREA SHALL BE BLAST CLEANED OF DEBRIS AND ASPHALT. THE JOINT AREA SHALL BE THOROUGHLY DRIED USING HOT COMPRESSED AIR PRIOR TO APPLYING BINDER MATERIAL.
- SPALLED AND DEFECTIVE CONCRETE SHALL BE REPAIRED WITH AN APPROVED MATERIAL AS AGREED UPON BY THE RESIDENT ENGINEER.
- PROPERLY SIZED HEAT RESISTANT BACKER ROD SHALL BE PLACED IN THE MOVEMENT GAP ALLOWING FOR 1 INCH +/- OF BINDER ABOVE THE ROD.
- THE BINDER MATERIAL SHALL BE HEATED AND PLACED AS RECOMMENDED BY THE MANUFACTURER.
- PLACE 1/4 INCH THICK BY 8 INCH WIDE SECTIONS OF STEEL PLATE OVER THE CENTER OF THE MOVEMENT GAP. SECURE PLATES FROM MOVING BY INSERTING LOCATING PINS THROUGH THE PRESTAMPED HOLES INTO BACKER ROD AND COVER WITH HOT BINDER.

A. THE STEEL PLATES MAY BE OMITTED WHERE THE APPROACH SLAB IS COVERED WITH A STONE BASE OR BITUMINOUS PAVEMENT AND VERTICAL MOVEMENT OF THE PLATES MIGHT OCCUR.
- THE BINDER MATERIAL AND AGGREGATE SHALL BE HEATED AND MIXED AS RECOMMENDED BY THE MANUFACTURER.
- THE INSTALLATION OF MATERIAL, COMPACTION, AND TOPCOATING SHALL BE AS RECOMMENDED BY THE MANUFACTURER.
- IMMEDIATELY AFTER TOPCOATING, AN ANTI-SKID MATERIAL SHALL BE CAST OVER THE JOINT TO REDUCE THE RISK OF TRACKING.
- JOINT SHALL BE PROTECTED FROM TRAFFIC UNTIL THE MATERIAL HAS COOLED TO 125°F±.

WEATHER LIMITATIONS

BINDER MATERIAL SHALL BE APPLIED ONLY WHEN THE FOLLOWING CONDITIONS PREVAIL:


- THE AMBIENT AIR TEMPERATURE IS AT LEAST 50 F AND RISING.
- THE ROAD SURFACE IS SUFFICIENTLY DRY.
- WEATHER CONDITIONS OR OTHER CONDITIONS ARE FAVORABLE AND ARE EXPECTED TO REMAIN SO FOR THE PERFORMANCE OF SATISFACTORY WORK.

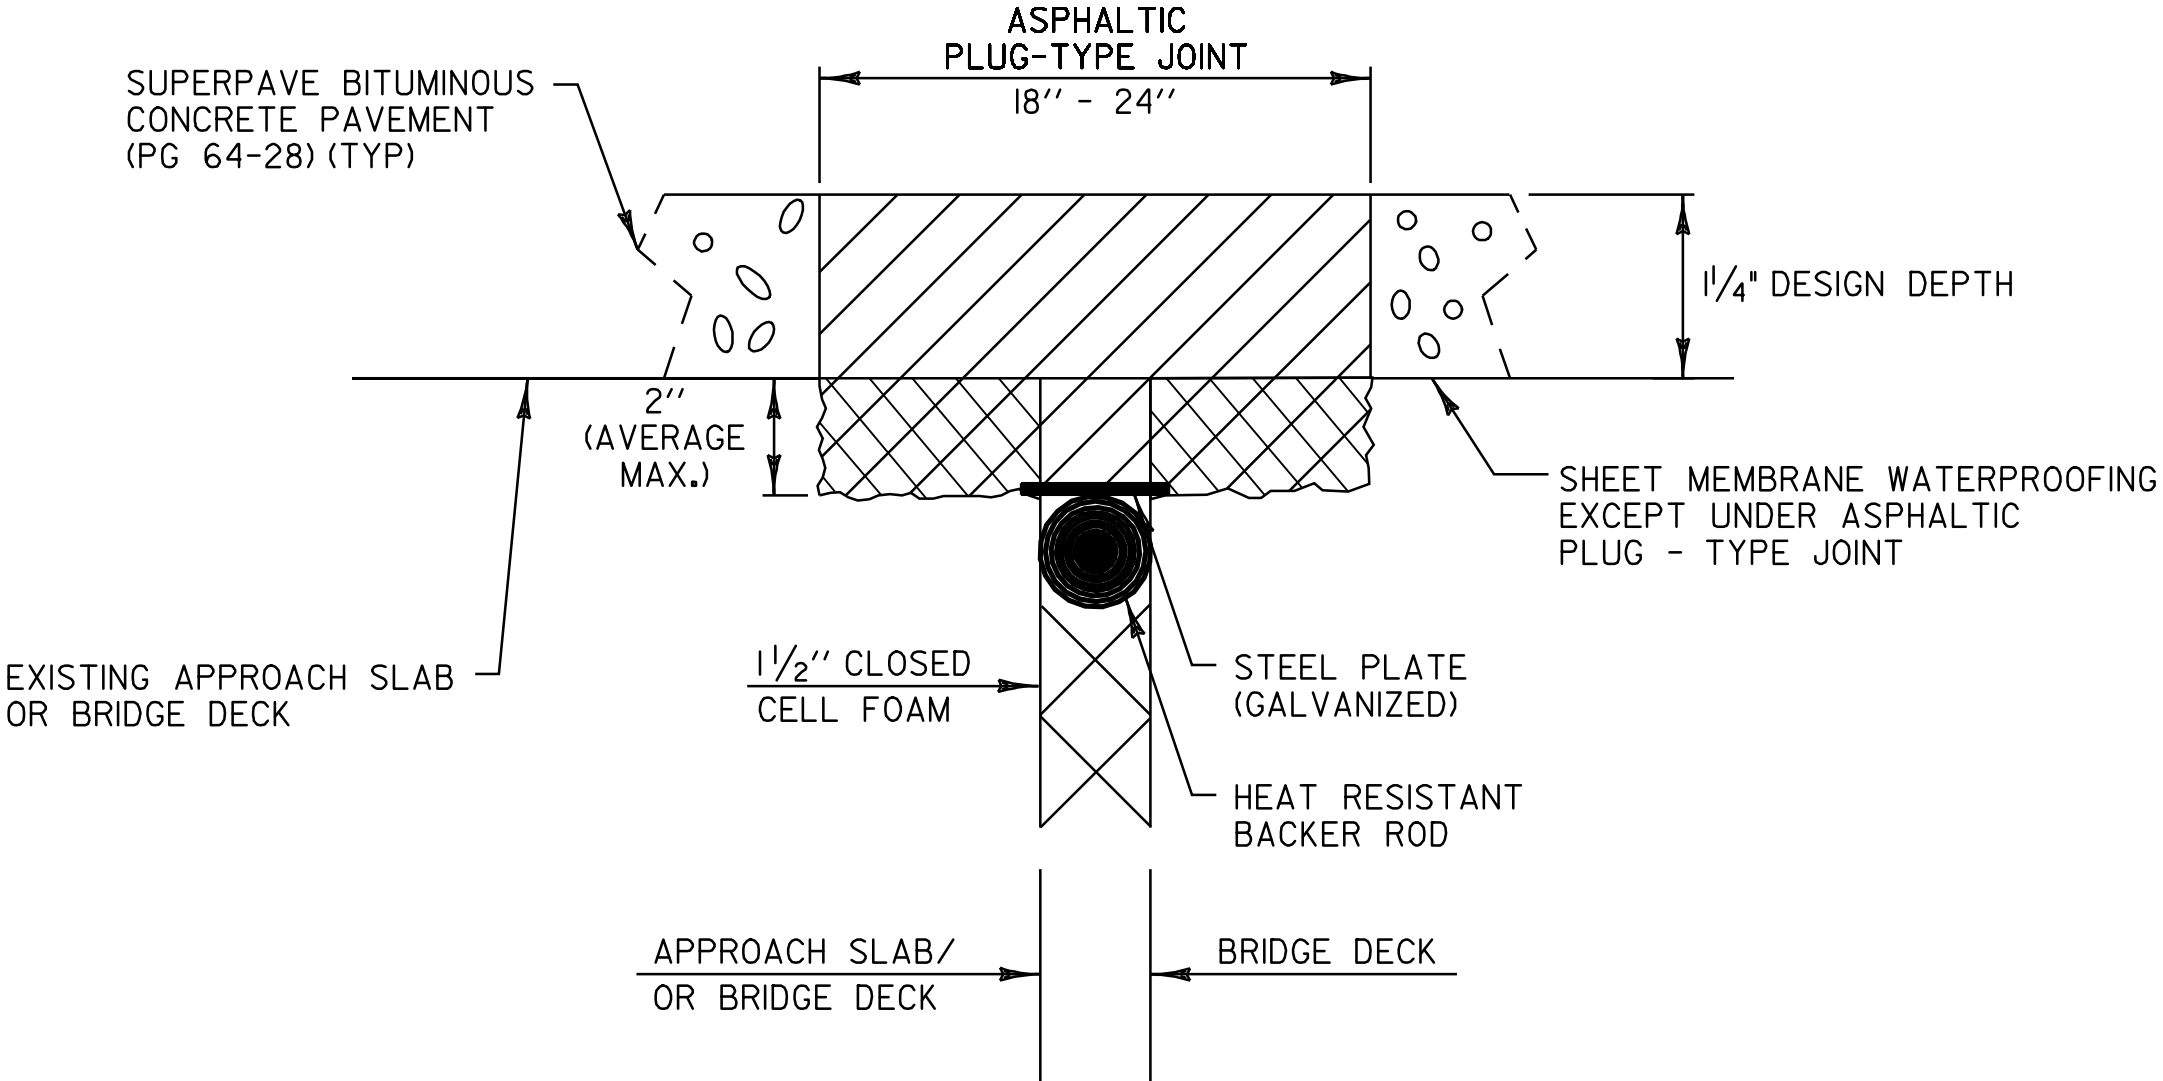

ASPHALTIC PLUG-TYPE JOINT DETAIL
REMOVAL OF UP TO
2" DETERIORATED CONCRETE

NOTES:

- UPON ENCOUNTERING UP TO 2" AVERAGE OF DETERIORATED CONCRETE, THE CONTRACTOR SHALL REMOVE THE DETERIORATED MATERIAL AND REPLACE IT WITH THE ASPHALTIC PLUG JOINT MATERIAL AS DIRECTED BY THE RESIDENT ENGINEER.
- REMOVAL OF THE DETERIORATED CONCRETE WILL NOT BE PAID SEPARATELY BUT WILL BE CONSIDERED INCIDENTAL TO THE UNIT BID PRICE FOR ITEM 516.10. THE ADDITIONAL PLUG JOINT MATERIAL BELOW THE DESIGN DEPTH REQUIRED TO REPLACE THE DETERIORATED CONCRETE WILL BE CONSIDERED INCIDENTAL TO THE UNIT BID PRICE FOR THE ITEM 516.10.
- THE STEEL PLATE IN THE ASPHALTIC PLUG JOINT MAY BE OMITTED ONLY IF THE REPAIRED SURFACE IS SO IRREGULAR IT WILL CAUSE VERTICAL MOVEMENT AND IT IS DIRECTED BY THE RESIDENT ENGINEER.

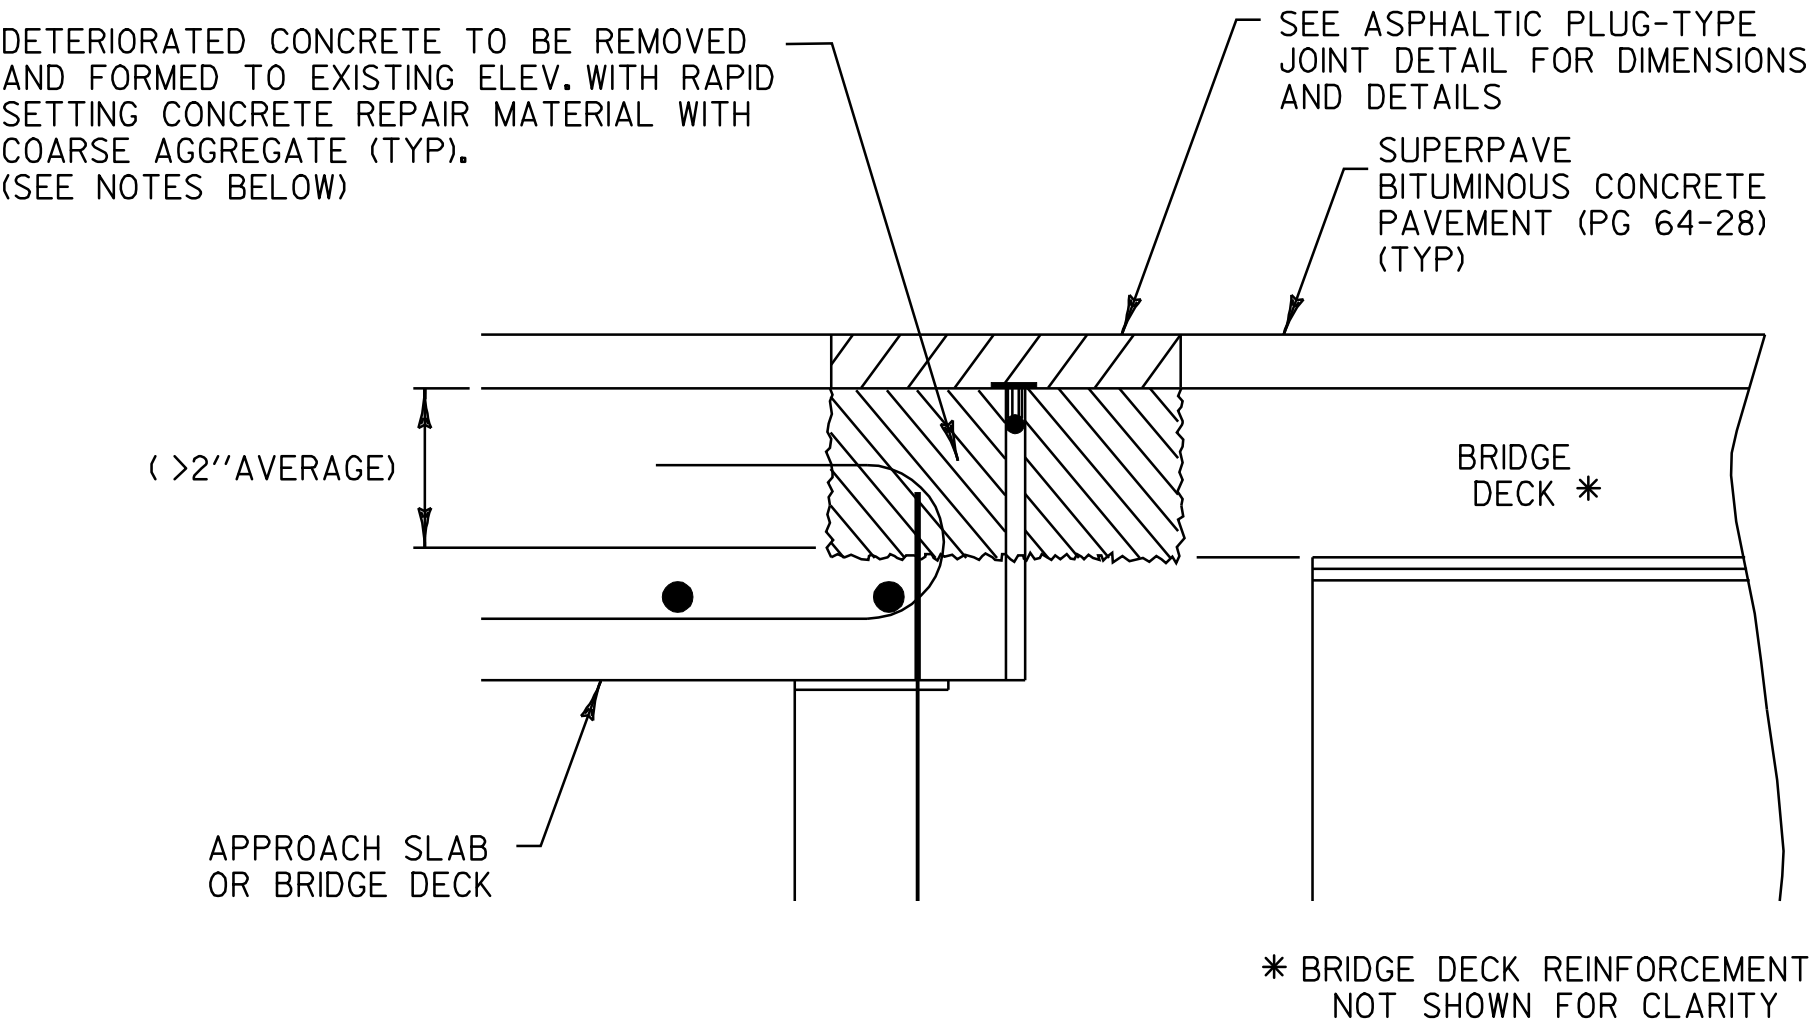

ASPHALTIC PLUG-TYPE JOINT DETAIL
REMOVAL OF >2"
DETERIORATED CONCRETE

NOTES:

- UPON ENCOUNTERING GREATER THAN 2" AVERAGE OF DETERIORATED CONCRETE, THE CONTRACTOR SHALL REMOVE THE DETERIORATED MATERIAL AND REPLACE IT WITH RAPID SETTING CONCRETE REPAIR MATERIAL WITH COARSE AGGREGATE.
- REMOVAL OF THE DETERIORATED CONCRETE WILL BE INCLUDED IN THE UNIT BID PRICE FOR ITEM 580.20 RAPID SETTING CONCRETE REPAIR MATERIAL WITH COARSE AGGREGATE.
- THE STEEL PLATE IN THE ASPHALTIC PLUG JOINT MAY BE OMITTED ONLY IF THE REPAIRED SURFACE IS SO IRREGULAR IT WILL CAUSE VERTICAL MOVEMENT AND IT IS DIRECTED BY THE RESIDENT ENGINEER.



NOT TO SCALE	
ASPHALTIC PLUG JOINT DETAILS SHEET	
PROJECT NAME: BARRE CITY PROJECT NUMBER: STP 2801(1)S	FILE NAME: p08d022.dgn PROJECT LEADER: JLL DESIGNED BY: STANTEC IPARM FILE: p08d022apjs.i
PLOT DATE: 14-APR-2010 DRAWN BY: STANTEC CHECKED BY: JLL SHEET 4 OF 19	

STATE OF VERMONT
AGENCY OF TRANSPORTATION

[illegible][illegible]

STATE OF VERMONT
AGENCY OF TRANSPORTATION

[illegible][illegible]

ITEM DETAIL SUMMARY SHEET


[illegible]

BEGIN STP 2801(1)S U.S. ROUTE 302
BARRE CITY STA 0+00=MM 0.000
BERLIN/BARRE TOWN LINE

646.20 4 INCH WHITE LINE
STA. 0+00.0 TO 5+00.0, SOLID LT & RT
(INCLUDING EDGE LINE BREAKS OR RADII FOR TOWN HIGHWAYS)
646.21 4 INCH YELLOW LINE
STA. 0+00.0 TO 5+00.0, SOLID LT & RT
(INCLUDING CENTERLINE BREAKS FOR TOWN HIGHWAYS)

646.602 TEMPORARY 4 INCH WHITE LINE, PAINT
STA. 0+00.0 TO 5+00.0, SOLID LT & RT
(INCLUDING EDGE LINE BREAKS OR RADII FOR TOWN HIGHWAYS)
646.612 TEMPORARY 4 INCH YELLOW LINE, PAINT
STA. 0+00.0 TO 5+00.0, SOLID LT & RT
(INCLUDING CENTERLINE BREAKS FOR TOWN HIGHWAYS)

604.40 CHANGING ELEVATION OF DI, CB, OR MH
STA. 0+04.5, LT
STA. 3+00.7, LT

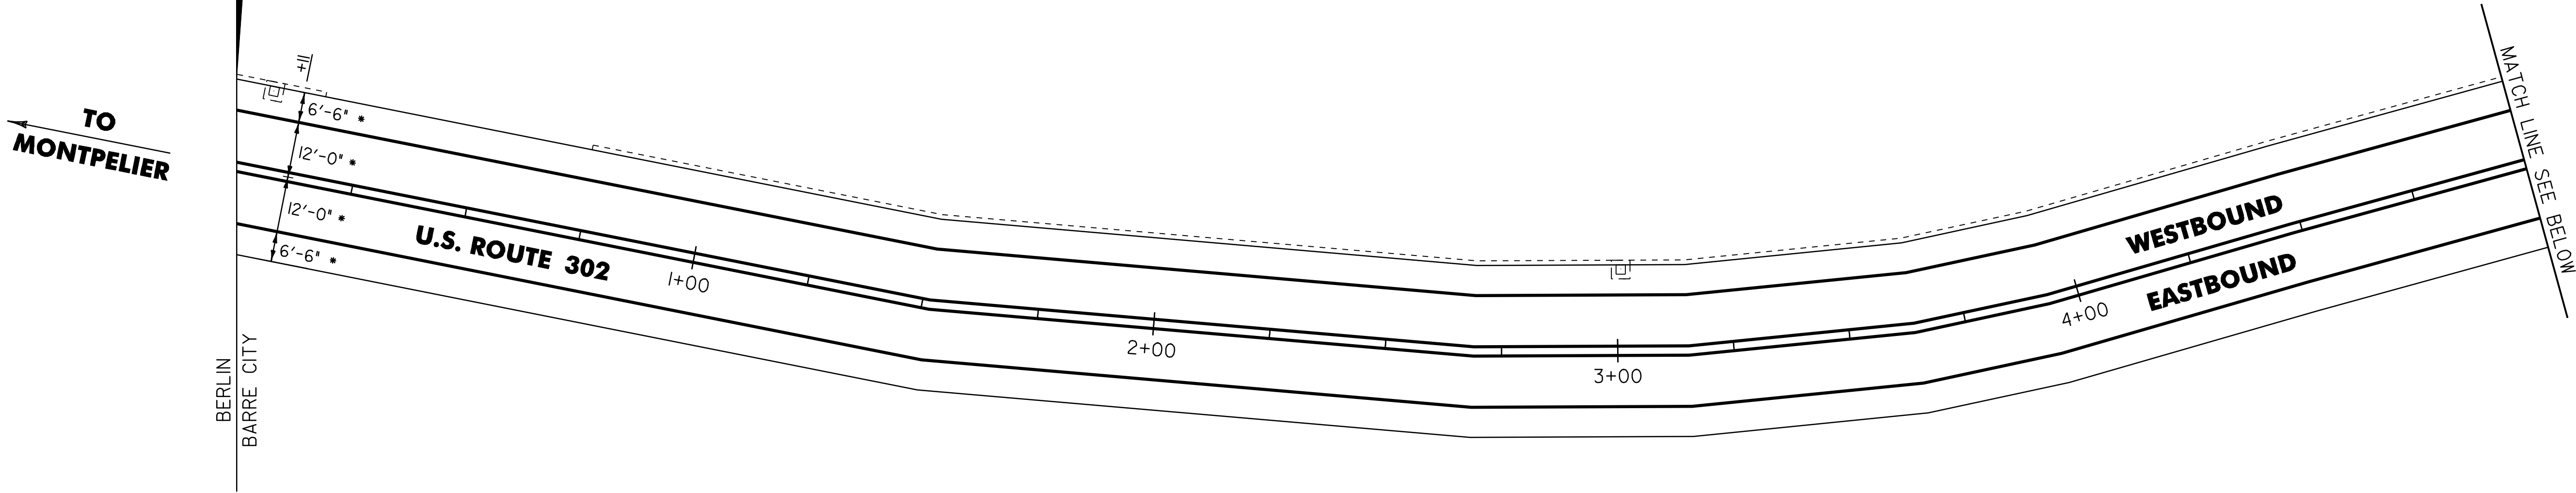


* MATCH EXISTING PAVEMENT MARKINGS

646.20 4 INCH WHITE LINE
STA. 5+00.0 TO 10+00.0, SOLID LT & RT
(INCLUDING EDGE LINE BREAKS OR RADII FOR TOWN HIGHWAYS)
646.21 4 INCH YELLOW LINE
STA. 5+00.0 TO 10+00.0, SOLID LT & RT
(INCLUDING CENTERLINE BREAKS FOR TOWN HIGHWAYS)

646.602 TEMPORARY 4 INCH WHITE LINE, PAINT
STA. 5+00.0 TO 10+00.0, SOLID LT & RT
(INCLUDING EDGE LINE BREAKS OR RADII FOR TOWN HIGHWAYS)
646.612 TEMPORARY 4 INCH YELLOW LINE, PAINT
STA. 5+00.0 TO 10+00.0, SOLID LT & RT
(INCLUDING CENTERLINE BREAKS FOR TOWN HIGHWAYS)

604.40 CHANGING ELEVATION OF DI, CB, OR MH
STA. 6+86.4, LT
~~STA. 8+77.3, LT~~

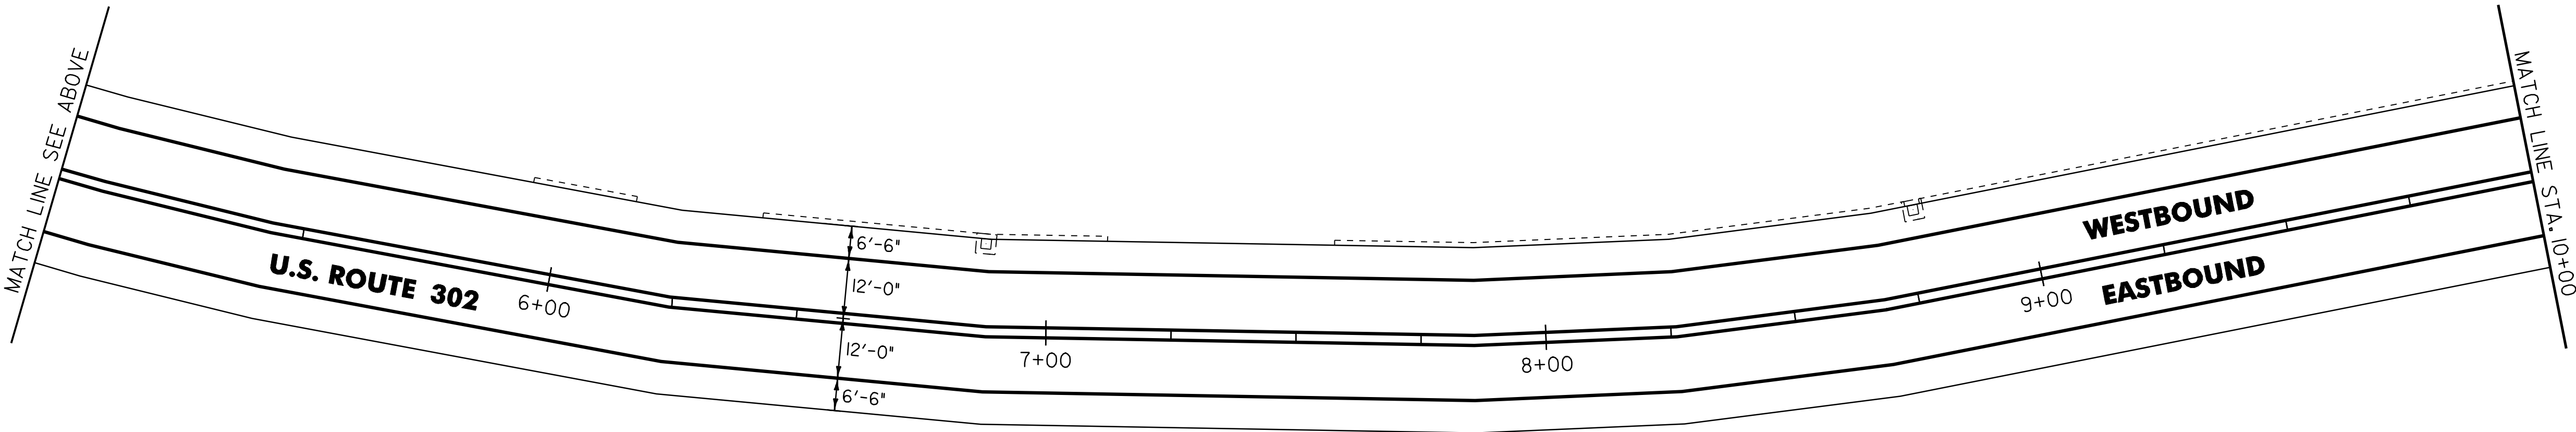

NOT TO SCALE

PROJECT
LAYOUT
SHEET #1

PROJECT NAME: BARRE CITY
PROJECT NUMBER: STP 2801(1)S

FILE NAME: p08d022.dgn
PROJECT LEADER: JLL
DESIGNED BY: STANTEC
IPARM FILE: p08d022101.1

PLOT DATE: 14-APR-2010
DRAWN BY: STANTEC
CHECKED BY: JLL
SHEET 8 OF 19


646.20 4 INCH WHITE LINE
STA.10+00.0 TO 15+00.0, SOLID LT & RT
(INCLUDING EDGE LINE BREAKS OR RADII FOR TOWN HIGHWAYS)

646.21 4 INCH YELLOW LINE
STA.10+00.0 TO 15+00.0, SOLID LT & RT
(INCLUDING CENTERLINE BREAKS FOR TOWN HIGHWAYS)

646.602 TEMPORARY 4 INCH WHITE LINE, PAINT
STA.10+00.0 TO 15+00.0, SOLID LT & RT
(INCLUDING EDGE LINE BREAKS OR RADII FOR TOWN HIGHWAYS)

646.612 TEMPORARY 4 INCH YELLOW LINE, PAINT
STA.10+00.0 TO 15+00.0, SOLID LT & RT
(INCLUDING CENTERLINE BREAKS FOR TOWN HIGHWAYS)

604.40 CHANGING ELEVATION OF DI, CB OR MH
STA.14+43.6, LT

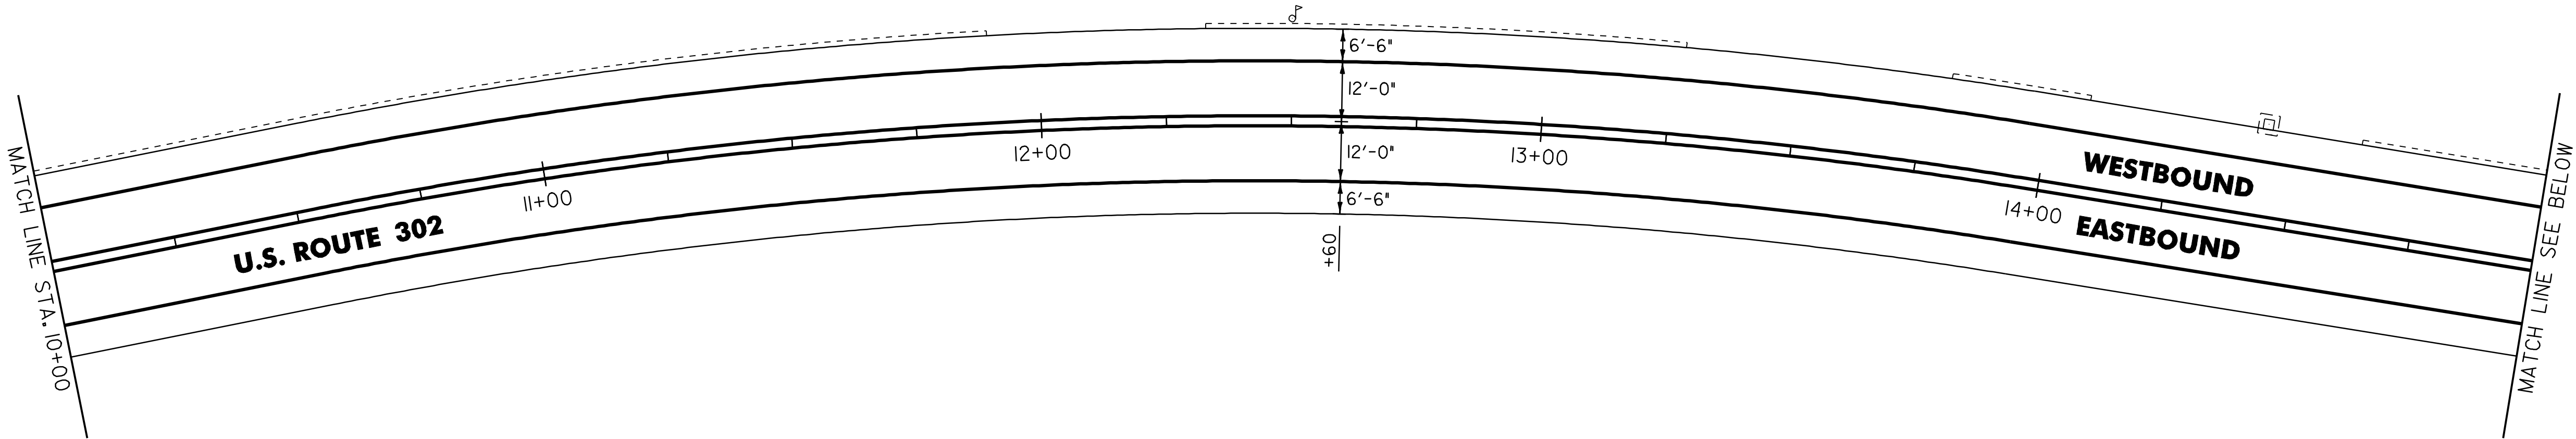

646.20 4 INCH WHITE LINE
STA.15+00.0 TO 20+00.0, SOLID LT & RT
(INCLUDING EDGE LINE BREAKS OR RADII FOR TOWN HIGHWAYS)


646.21 4 INCH YELLOW LINE
STA.15+00.0 TO 20+00.0, SOLID LT & RT
(INCLUDING CENTERLINE BREAKS FOR TOWN HIGHWAYS)

646.602 TEMPORARY 4 INCH WHITE LINE, PAINT
STA.15+00.0 TO 20+00.0, SOLID LT & RT
(INCLUDING EDGE LINE BREAKS OR RADII FOR TOWN HIGHWAYS)

646.612 TEMPORARY 4 INCH YELLOW LINE, PAINT
STA.15+00.0 TO 20+00.0, SOLID LT & RT
(INCLUDING CENTERLINE BREAKS FOR TOWN HIGHWAYS)

604.40 CHANGING ELEVATION OF DI, CB OR MH
~~STA.15+90.3, LT~~
~~STA.17+39.6, LT~~
~~STA.19+36.0, LT~~

604.47 C.I. GRATE W/ FRAME, TYPE D
17+39.6 LT

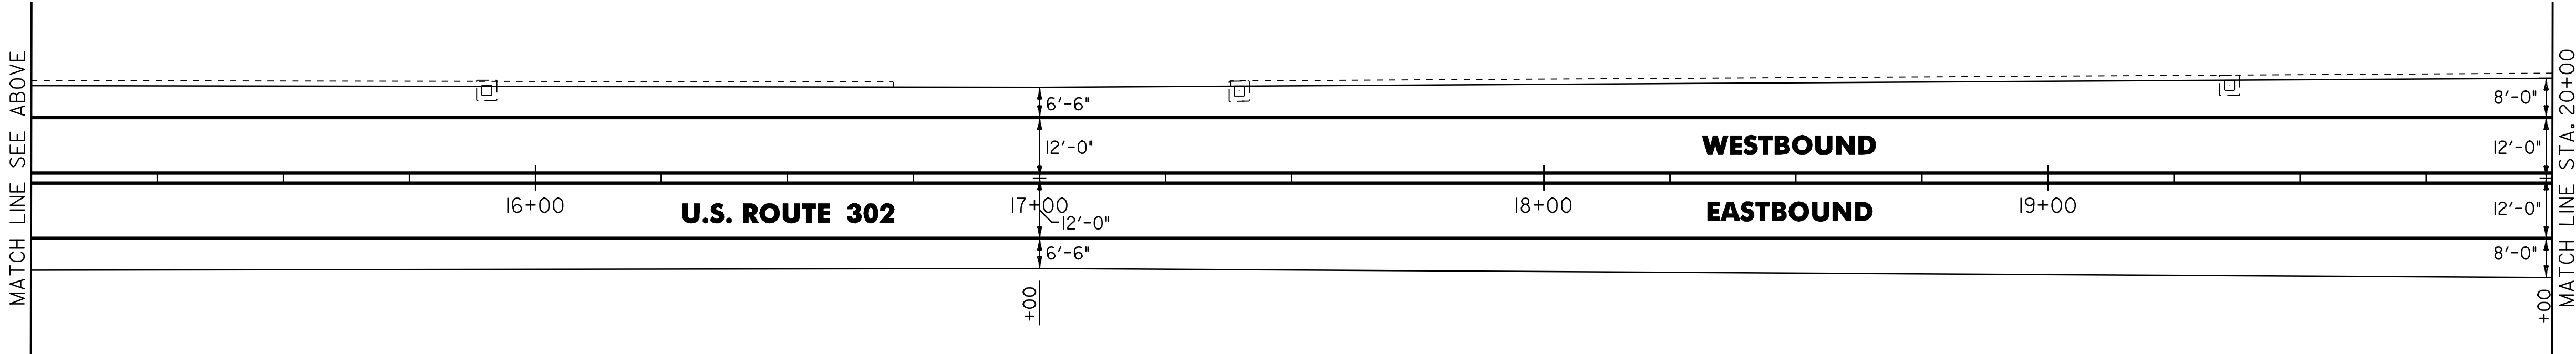

NOT TO SCALE	
PROJECT LAYOUT SHEET #2	PROJECT NAME: BARRE CITY
	PROJECT NUMBER: STP 2801(I)S
	FILE NAME: p08d022.dgn
	PROJECT LEADER: JLL
	DESIGNED BY: STANTEC
	IPARM FILE: p08d022102.i
PLOT DATE: 14-APR-2010	
DRAWN BY: STANTEC	
CHECKED BY: JLL	
SHEET 9 OF 19	


646.20 4 INCH WHITE LINE
STA. 20+00.0 TO 25+00.0, SOLID LT & RT
(INCLUDING EDGE LINE BREAKS OR RADII FOR TOWN HIGHWAYS)

646.21 4 INCH YELLOW LINE
STA. 20+00.0 TO 25+00.0, SOLID LT & RT
(INCLUDING CENTERLINE BREAKS FOR TOWN HIGHWAYS)

646.602 TEMPORARY 4 INCH WHITE LINE, PAINT
STA. 20+00.0 TO 25+00.0, SOLID LT & RT
(INCLUDING EDGE LINE BREAKS OR RADII FOR TOWN HIGHWAYS)

646.612 TEMPORARY 4 INCH YELLOW LINE, PAINT
STA. 20+00.0 TO 25+00.0, SOLID LT & RT
(INCLUDING CENTERLINE BREAKS FOR TOWN HIGHWAYS)

604.40 CHANGING ELEVATION OF DI, CB OR MH
~~STA. 21+87.0, LT~~
~~STA. 24+08.9, LT~~

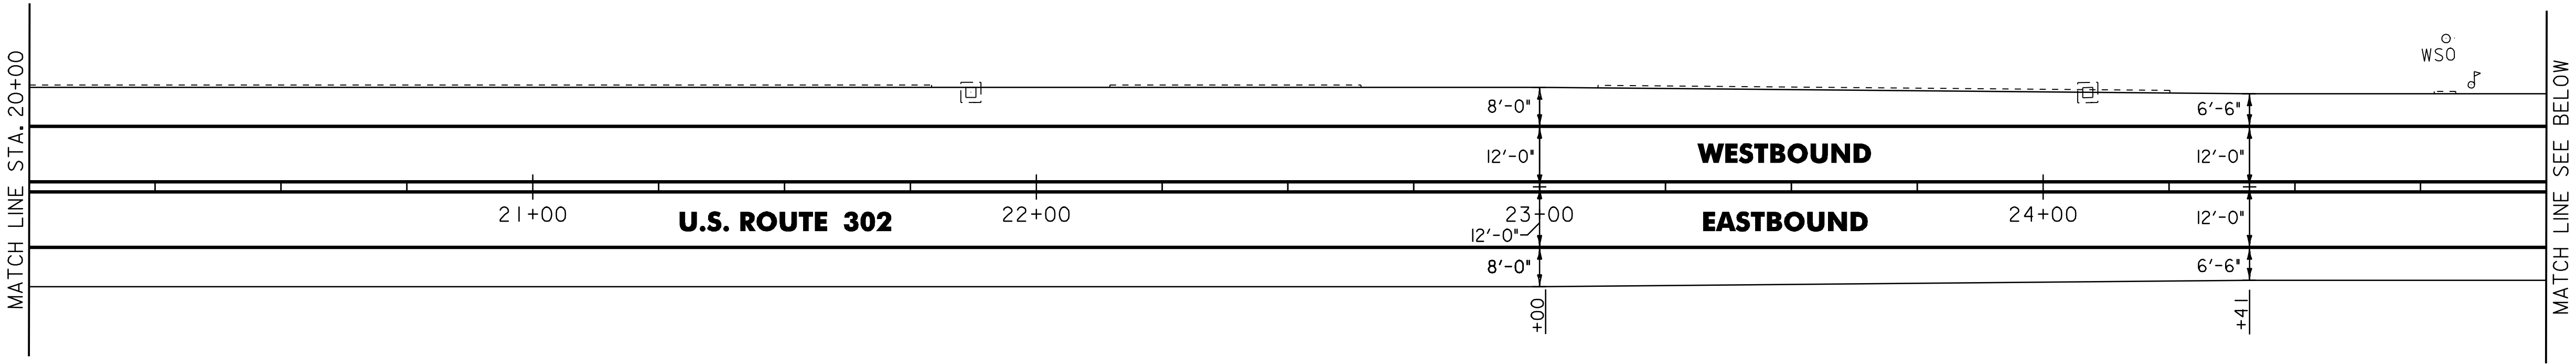

646.20 4 INCH WHITE LINE
STA. 25+00.0 TO 30+00.0, SOLID LT & RT
(INCLUDING EDGE LINE BREAKS OR RADII FOR TOWN HIGHWAYS)


646.21 4 INCH YELLOW LINE
STA. 25+00.0 TO 30+00.0, SOLID LT & RT
(INCLUDING CENTERLINE BREAKS FOR TOWN HIGHWAYS)

646.602 TEMPORARY 4 INCH WHITE LINE, PAINT
STA. 25+00.0 TO 30+00.0, SOLID LT & RT
(INCLUDING EDGE LINE BREAKS OR RADII FOR TOWN HIGHWAYS)

646.612 TEMPORARY 4 INCH YELLOW LINE, PAINT
STA. 25+00.0 TO 30+00.0, SOLID LT & RT
(INCLUDING CENTERLINE BREAKS FOR TOWN HIGHWAYS)

604.40 CHANGING ELEVATION OF DI, CB OR MH
STA. 25+58.3, LT
~~STA. 26+57.2, LT~~
~~STA. 27+09.2, LT~~
~~STA. 28+08.5, LT~~
~~STA. 29+30.8, LT~~

604.47 C.I. GRATE W/ FRAME, TYPE D
25+58.3 LT

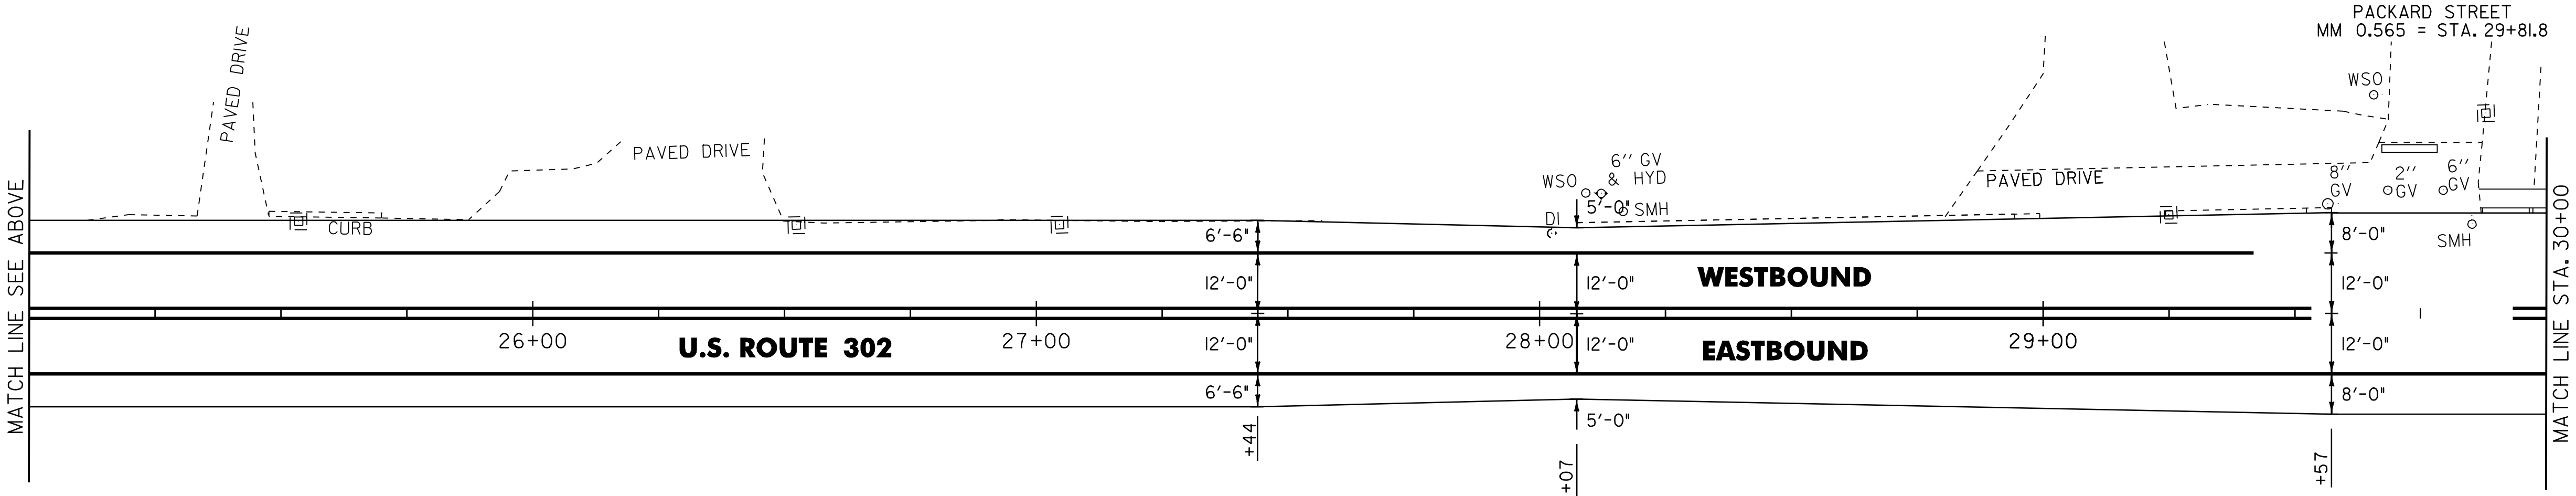

604.42 CHANGING ELEVATION OF SEWER MANHOLES
STA. 29+91.5, LT



NOT TO SCALE

PROJECT
LAYOUT
SHEET #3

PROJECT NAME: BARRE CITY
PROJECT NUMBER: STP 280(I)S

FILE NAME: p08d022.dgn
PROJECT LEADER: JLL
DESIGNED BY: STANTEC
IPARM FILE: p08d022103.I


PLOT DATE: 14-APR-2010
DRAWN BY: STANTEC
CHECKED BY: JLL
SHEET 10 OF 19

646.20 4 INCH WHITE LINE
STA. 30+00.0 TO 35+00.0, SOLID LT & RT
(INCLUDING EDGE LINE BREAKS OR RADII FOR TOWN HIGHWAYS)

646.21 4 INCH YELLOW LINE
STA. 30+00.0 TO 35+00.0, SOLID LT & RT
(INCLUDING CENTERLINE BREAKS FOR TOWN HIGHWAYS)

646.602 TEMPORARY 4 INCH WHITE LINE, PAINT
STA. 30+00.0 TO 35+00.0, SOLID LT & RT
(INCLUDING EDGE LINE BREAKS OR RADII FOR TOWN HIGHWAYS)

646.612 TEMPORARY 4 INCH YELLOW LINE, PAINT
STA. 30+00.0 TO 35+00.0, SOLID LT & RT
(INCLUDING CENTERLINE BREAKS FOR TOWN HIGHWAYS)

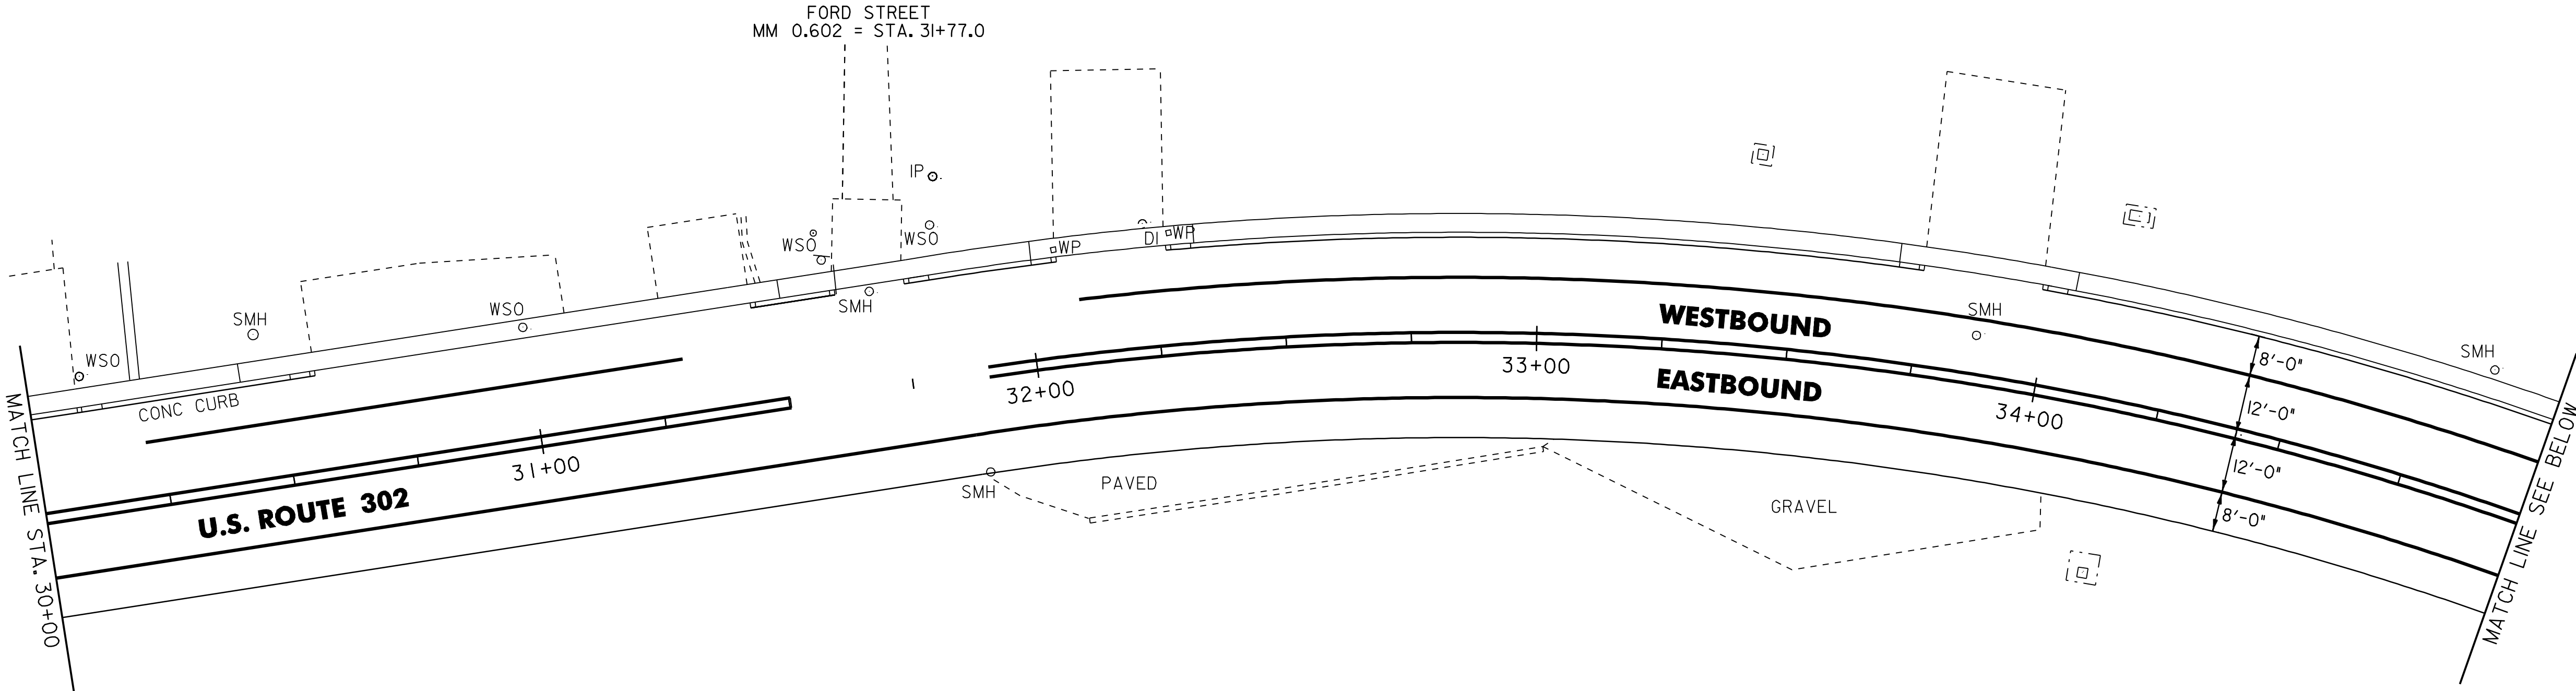

604.42 CHANGING ELEVATION OF SEWER MANHOLES
~~STA. 31+74.6, LT~~
~~STA. 31+95.5, RT~~
~~STA. 33+97.0, LT~~

646.20 4 INCH WHITE LINE
STA. 35+00.0 TO 40+00.0, SOLID LT & RT
(INCLUDING EDGE LINE BREAKS OR RADII FOR TOWN HIGHWAYS)

646.21 4 INCH YELLOW LINE
STA. 35+00.0 TO 40+00.0, SOLID LT & RT
STA. 35+05.0 TO 38+50.0, DOUBLE SOLID RT

646.23 8 INCH YELLOW LINE
STA. 35+05.0 TO 38+50.0, SOLID DIAGONALS RT

646.602 TEMPORARY 4 INCH WHITE LINE, PAINT
STA. 35+00.0 TO 40+00.0, SOLID LT & RT
(INCLUDING EDGE LINE BREAKS OR RADII FOR TOWN HIGHWAYS)



646.612 TEMPORARY 4 INCH YELLOW LINE, PAINT
STA. 35+00.0 TO 40+00.0, SOLID LT & RT
STA. 35+05.0 TO 38+50.0, DOUBLE SOLID RT

646.652 TEMPORARY 8 INCH YELLOW LINE, PAINT
STA. 35+05.0 TO 38+50.0, SOLID DIAGONALS RT

646.30 LETTER OR SYMBOL
STA. 38+54.0, RT - ARROW
STA. 39+08.3, RT - "ONLY"
STA. 39+62.5, RT - ARROW

675.50 REMOVING SIGNS
AS SHOWN - I

646.692 TEMPORARY LETTER OR SYMBOL, PAINT
STA. 38+54.0, RT - ARROW
STA. 39+62.5, RT - ARROW

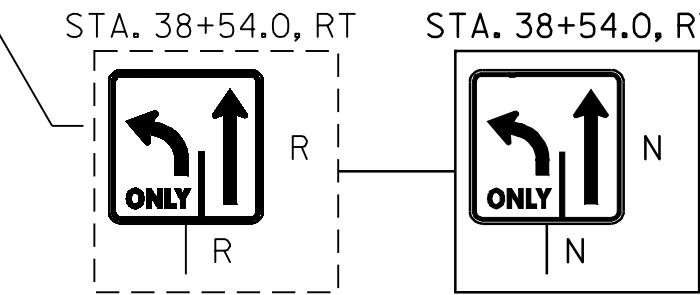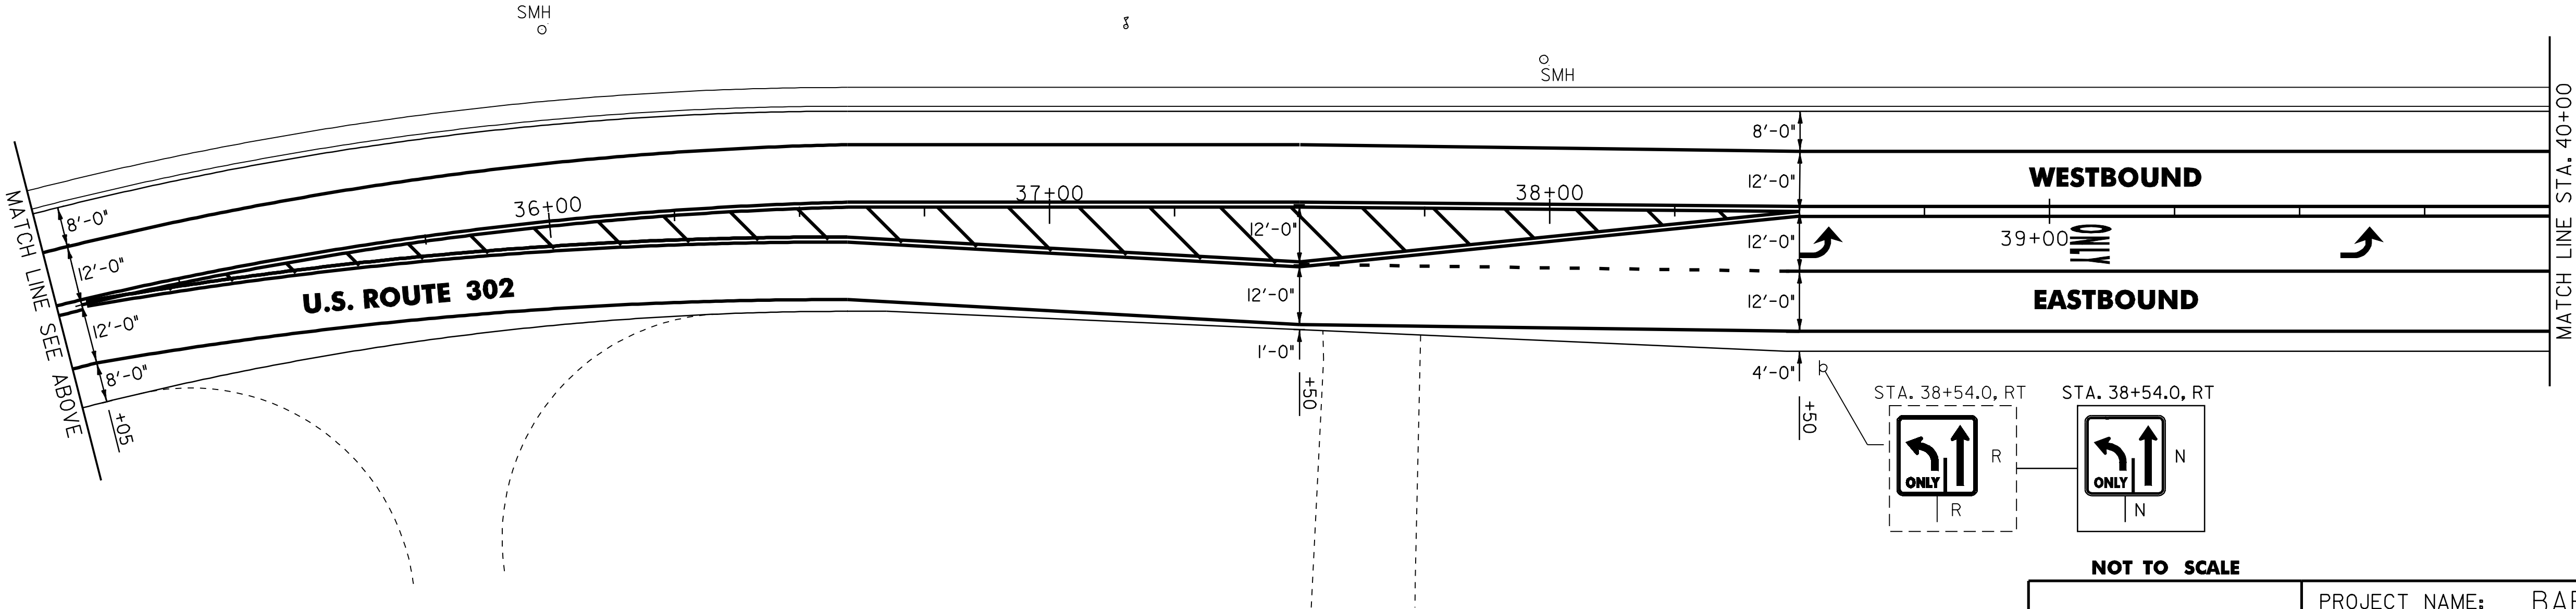

NOT TO SCALE



PROJECT
LAYOUT
SHEET #4

PROJECT NAME: BARRE CITY
PROJECT NUMBER: STP 280(I)S

FILE NAME: p08d022.dgn
PROJECT LEADER: JLL
DESIGNED BY: STANTEC
IPARM FILE: p08d022I04.I

PLOT DATE: 14-APR-2010
DRAWN BY: STANTEC
CHECKED BY: JLL
SHEET 11 OF 19

PLOT DATE: 14-APR-2010
DRAWN BY: STANTEC
CHECKED BY: JLL
SHEET 13 OF 19

646.20 4 INCH WHITE LINE
STA. 60+00.0 TO 65+00.0, SOLID LT & RT
(INCLUDING EDGE LINE BREAKS OR RADII FOR TOWN HIGHWAYS)


646.21 4 INCH YELLOW LINE
STA. 60+00.0 TO 65+00.0, SOLID LT & RT
(INCLUDING CENTERLINE BREAKS FOR TOWN HIGHWAYS)

646.602 TEMPORARY 4 INCH WHITE LINE, PAINT
STA. 60+00.0 TO 65+00.0, SOLID LT & RT
(INCLUDING EDGE LINE BREAKS OR RADII FOR TOWN HIGHWAYS)


646.612 TEMPORARY 4 INCH YELLOW LINE, PAINT
STA. 60+00.0 TO 65+00.0, SOLID LT & RT
(INCLUDING CENTERLINE BREAKS FOR TOWN HIGHWAYS)

604.40 CHANGING ELEVATION OF DI, CB, OR MH
~~STA. 60+02.3, RT~~
~~STA. 60+52.4, LT~~
~~STA. 60+76.0, LT~~
~~STA. 61+00.0, RT~~
~~STA. 61+73.1, LT~~
~~STA. 61+99.5, RT~~
~~STA. 63+24.4, RT~~
~~STA. 64+22.5, RT (2)~~
~~STA. 64+33.0, LT~~
60+72 LT

604.42 CHANGING ELEVATION OF SEWER MANHOLES
STA. 60+02.3, RT
STA. 62+93.0, RT
61+73 LT
60+64 RT
62+83 RT
63+24 RT
64+24 RT

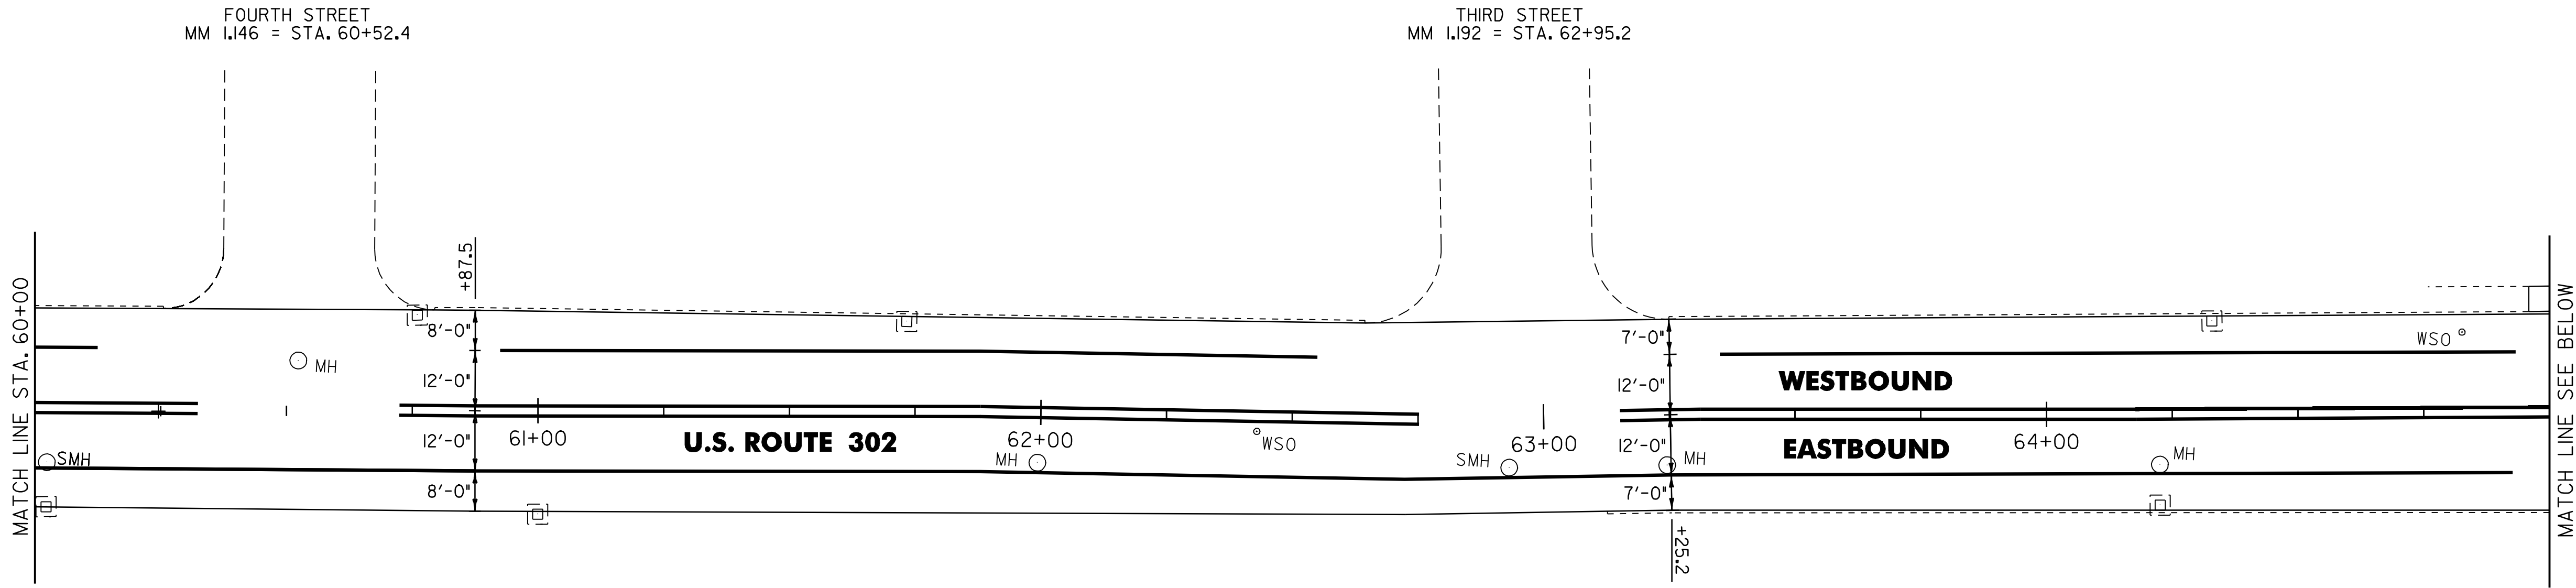

629.20 ADJUST ELEVATION OF VALVE BOX
STA. 62+43.0, RT
STA. 64+82.7, LT

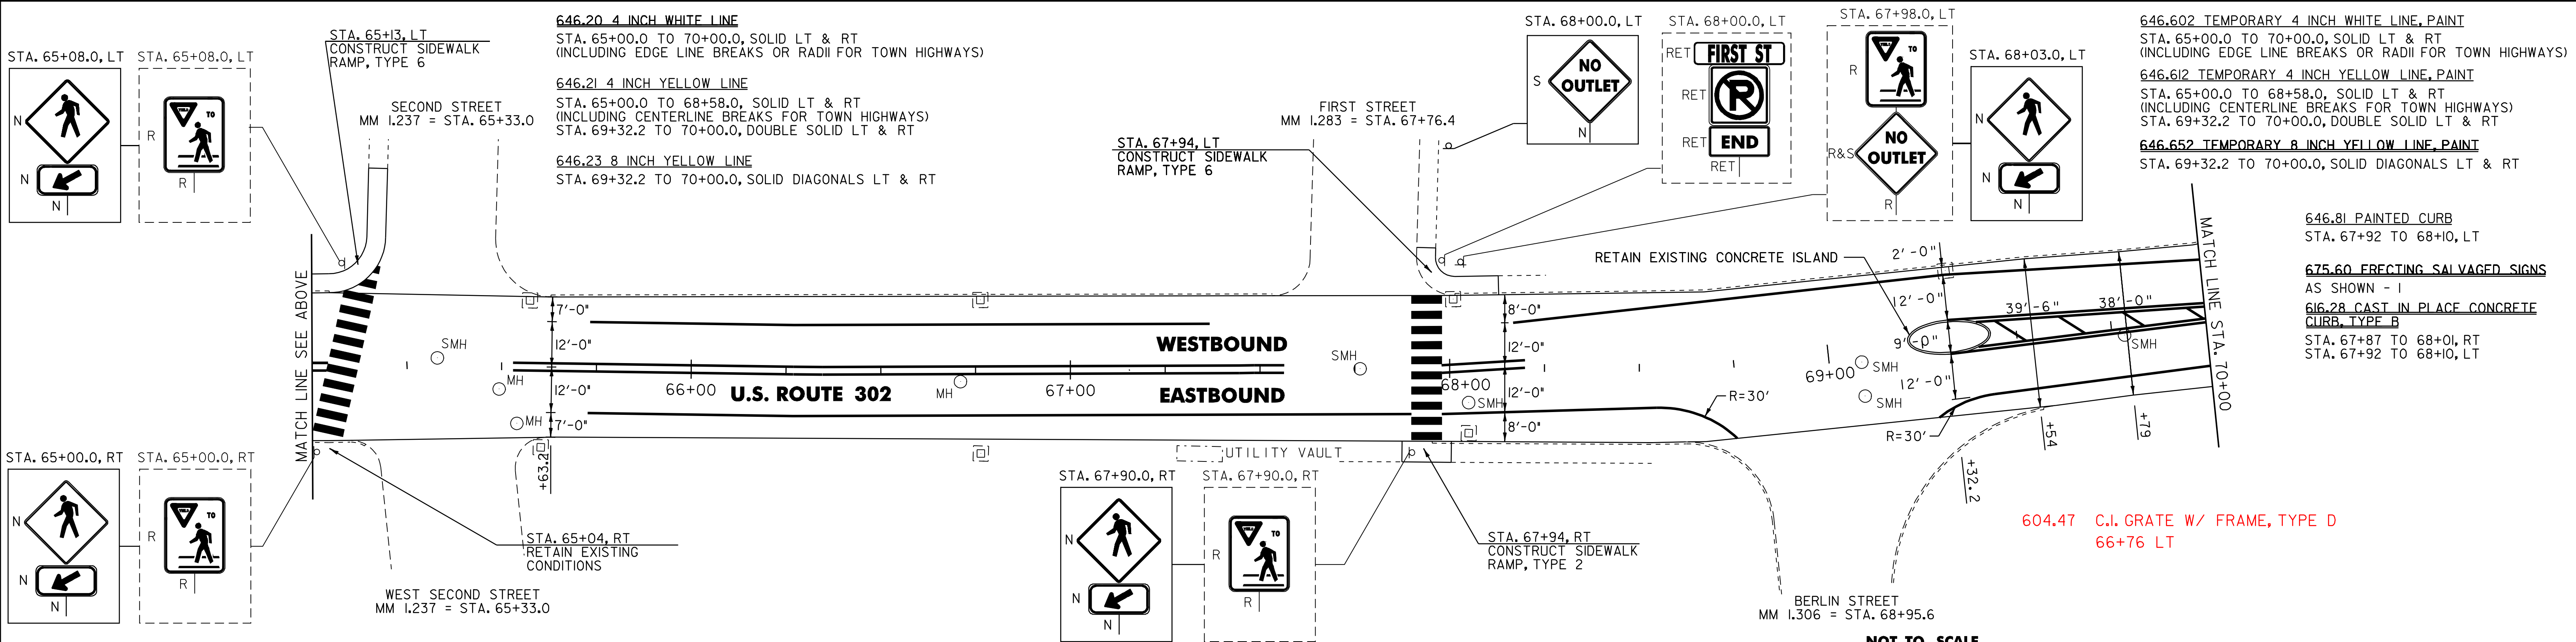

646.31 CROSSWALK MARKING
STA. 65+04.0, RT TO 65+13.0, LT
STA. 67+93.8, LT/RT

675.50 REMOVING SIGNS
AS SHOWN - 5

646.702 TEMPORARY CROSSWALK MARKING, PAINT
STA. 65+04.0, RT TO 65+13.0, LT
STA. 67+93.8, LT/RT

604.40 CHANGING ELEVATION OF DI, CB, OR MH

~~STA. 65+49.4, RT~~
~~STA. 65+54.2, RT~~
~~STA. 65+57.2, LT~~
~~STA. 66+71.0, RT~~
~~STA. 66+76.3, LT~~
~~STA. 68+01.0, RT~~
~~STA. 68+05.0, RT~~
~~STA. 69+33.0, LT~~

604.42 CHANGING ELEVATION OF SEWER MANHOLES

~~STA. 65+33.0, LT~~
~~STA. 67+76.4, C~~
~~STA. 68+05.0, RT~~
~~STA. 69+08.6, RT (2)~~
~~STA. 69+78.3, RT~~
65+54 RT
65+49 RT
66+71 CL
65+93 LT



NOT TO SCALE

PROJECT
LAYOUT
SHEET #7

PROJECT NAME: BARRE CITY
PROJECT NUMBER: STP 280(I)S

FILE NAME: p08d022.dgn
PROJECT LEADER: JLL
DESIGNED BY: STANTEC
IPARM FILE: p08d022107.1

PLOT DATE: 14-APR-2010
DRAWN BY: STANTEC
CHECKED BY: JLL
SHEET 14 OF 19

646.20 4 INCH WHITE LINE
STA. 80+00.0 TO 85+00.0, SOLID LT & RT
(INCLUDING EDGE LINE BREAKS OR RADII FOR TOWN HIGHWAYS)

646.21 4 INCH YELLOW LINE
STA. 80+00.0 TO 85+00.0, SOLID LT & RT
(INCLUDING CENTERLINE BREAKS FOR TOWN HIGHWAYS)

646.81 PAINTED CURB
STA. 84+86.0 TO 85+00.0, RT

646.602 TEMPORARY 4 INCH WHITE LINE, PAINT
STA. 80+00.0 TO 85+00.0, SOLID LT & RT
(INCLUDING EDGE LINE BREAKS OR RADII FOR TOWN HIGHWAYS)

646.612 TEMPORARY 4 INCH YELLOW LINE, PAINT
STA. 80+00.0 TO 85+00.0, SOLID LT & RT
(INCLUDING CENTERLINE BREAKS FOR TOWN HIGHWAYS)

675.50 REMOVING SIGNS
AS SHOWN - 1


646.31 CROSSWALK MARKING
STA. 84+74.1, LT (BROOK ST.)
STA. 84+90.0, LT TO 84+96.0, RT

646.702 TEMPORARY CROSSWALK MARKING, PAINT
STA. 84+74.1, LT (BROOK ST.)
STA. 84+90.0, LT TO 84+96.0, RT

646.26 24 INCH STOP BAR
STA. 84+74.1, LT (BROOK ST. - ON EXIST. PAVEMENT)

646.682 TEMPORARY 24 INCH STOP BAR, PAINT
STA. 84+74.1, LT (BROOK ST. - ON EXIST. PAVEMENT)

604.40 CHANGING ELEVATION OF DI, CB, OR MH
~~STA. 80+06.9, LT~~
~~STA. 80+06.9, RT~~
~~STA. 80+43.5, LT~~
STA. 83+10.2, RT
STA. 83+14.3, LT
STA. 83+36.6, LT
~~STA. 83+36.6, RT~~
~~STA. 83+95.0, RT~~
~~STA. 84+14.4, LT~~
STA. 84+38.0, C
STA. 84+90.6, LT
80+13 LT
82+24 LT
83+90 LT
604.47 CAST IRON GRATE WITH FRAME, TYPE D
STA. 83+95.0, RT
83+36 LT
83+45 LT

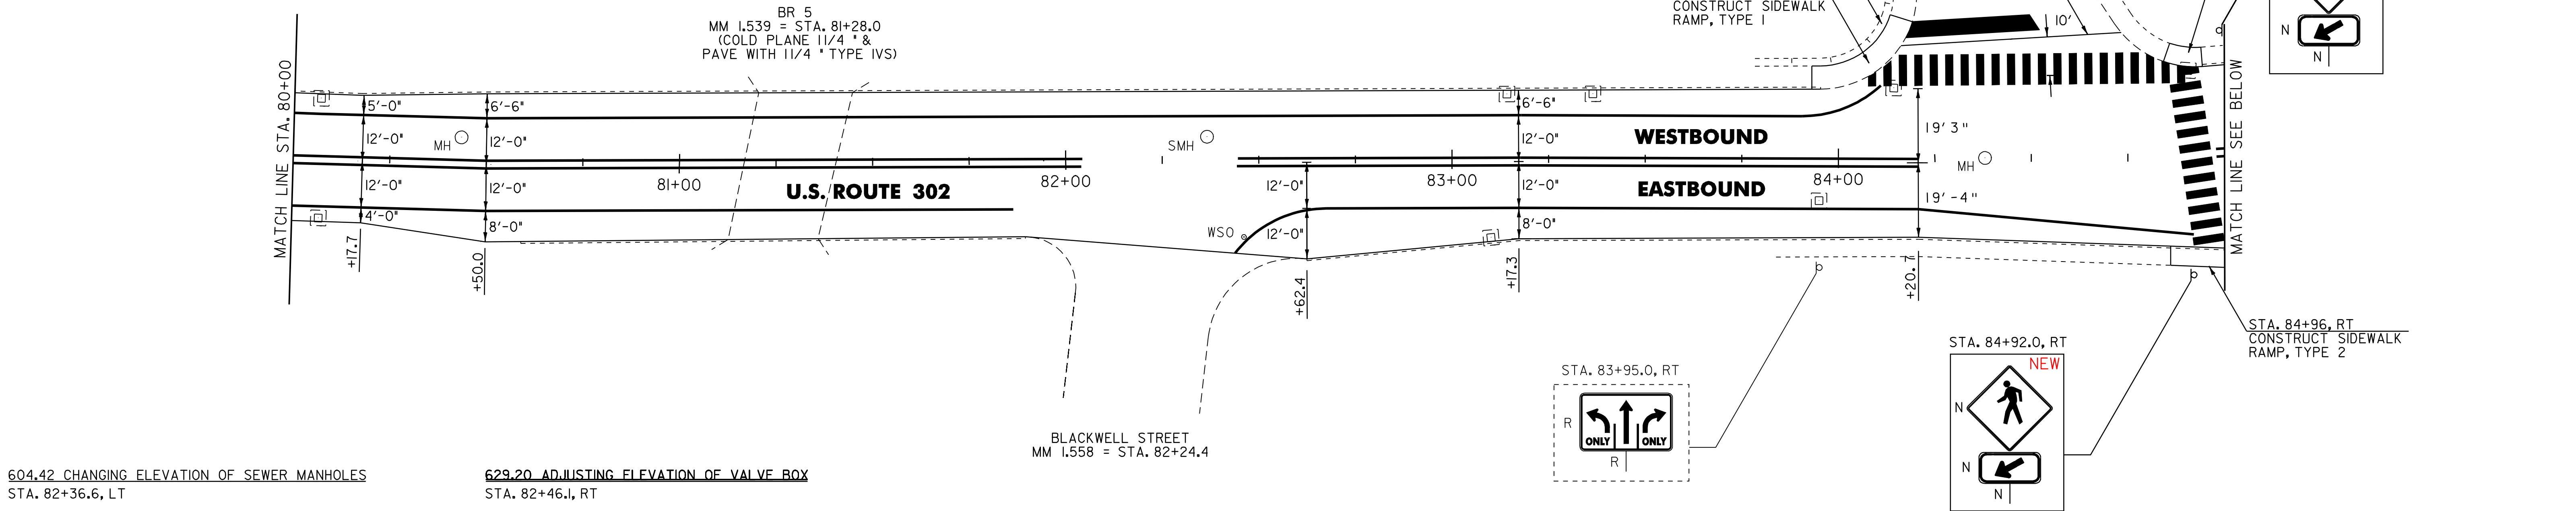

646.20 4 INCH WHITE LINE
STA. 85+00.0 TO 86+91.0, SOLID LT & RT
STA. 85+00.0 TO 86+20.0, DOTTED RT (LANE LINE)
STA. 85+00.0 TO 86+91.0, SOLID RT (LANE LINE)
STA. 86+20.0 TO 86+91.0, SOLID RT (LANE LINE)
STA. 88+17.5 TO 89+43.5, SOLID LT & RT
STA. 88+17.5 TO 89+43.5, SOLID LT (LANE LINE)
STA. 88+17.5 TO 89+43.5, SOLID LT (LANE LINE)

(INCLUDING EDGE LINE BREAKS OR RADII FOR TOWN HIGHWAYS AND CROSSWALKS)


646.21 4 INCH YELLOW LINE
STA. 85+00.0 TO 86+91.0, DOUBLE SOLID LT
STA. 88+17.5 TO 89+43.5, DOUBLE SOLID RT
(INCLUDING CENTERLINE BREAKS FOR TOWN HIGHWAYS AND CROSSWALKS)

646.81 PAINTED CURB
STA. 85+00.0, TO 85+06.0, RT
STA. 86+90.0, TO 87+10.0, RT

604.47 CAST IRON GRATE WITH FRAME, TYPE D

~~STA. 85+82.2, LT~~
~~STA. 88+39.5, LT~~
~~STA. 88+39.5, RT~~
~~STA. 89+25.0, RT~~
STA. 89+41.0, LT
89+30 RT
85+26 RT



STA. 85+26.0, RT

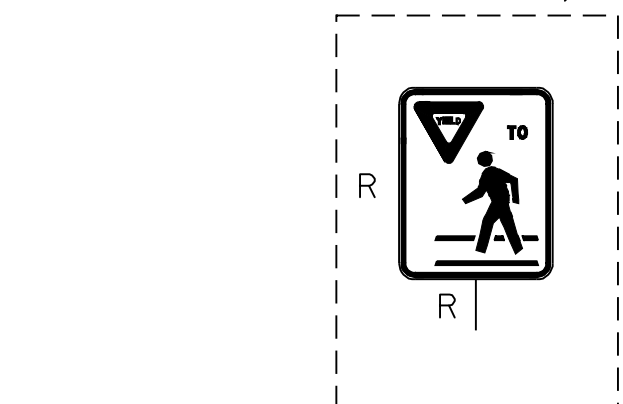

604.40 CHANGING ELEVATION OF DI, CB, OR MH

~~STA. 85+26.0, RT~~
~~STA. 85+82.2, LT~~
~~STA. 87+95.0, LT~~
~~STA. 88+39.5, LT~~
STA. 88+39.5, RT
~~STA. 89+25.0, RT~~
STA. 89+30.0, RT
~~STA. 89+41.0, LT~~

STA. 89+41.0, LT

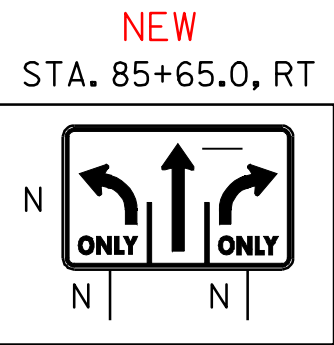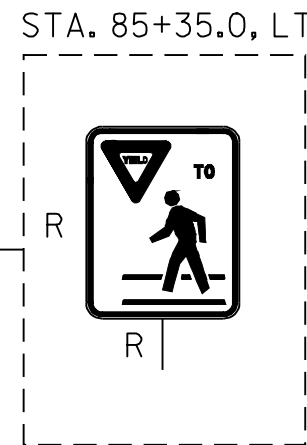

646.602 TEMPORARY 4 INCH WHITE LINE, PAINT
STA. 85+00.0 TO 86+91.0, SOLID LT & RT
STA. 85+00.0 TO 86+20.0, DOTTED RT (LANE LINE)
STA. 85+00.0 TO 86+91.0, SOLID RT (LANE LINE)
STA. 86+20.0 TO 86+91.0, SOLID RT (LANE LINE)
STA. 88+17.5 TO 89+43.5, SOLID LT & RT
STA. 88+17.5 TO 89+43.5, SOLID LT (LANE LINE)
STA. 88+17.5 TO 89+43.5, SOLID LT (LANE LINE)

(INCLUDING EDGE LINE BREAKS OR RADII FOR TOWN HIGHWAYS AND CROSSWALKS)


646.612 TEMPORARY 4 INCH YELLOW LINE, PAINT
STA. 85+00.0 TO 86+91.0, DOUBLE SOLID LT
STA. 88+17.5 TO 89+43.5, DOUBLE SOLID RT
(INCLUDING CENTERLINE BREAKS FOR TOWN HIGHWAYS AND CROSSWALKS)

646.81 PAINTED CURB
STA. 85+00.0, TO 85+06.0, RT
STA. 86+90.0, TO 87+10.0, RT

604.47 CAST IRON GRATE WITH FRAME, TYPE D

~~STA. 85+82.2, LT~~
~~STA. 88+39.5, LT~~
~~STA. 88+39.5, RT~~
~~STA. 89+25.0, RT~~
STA. 89+41.0, LT
89+30 RT
85+26 RT

STA. 85+26.0, RT

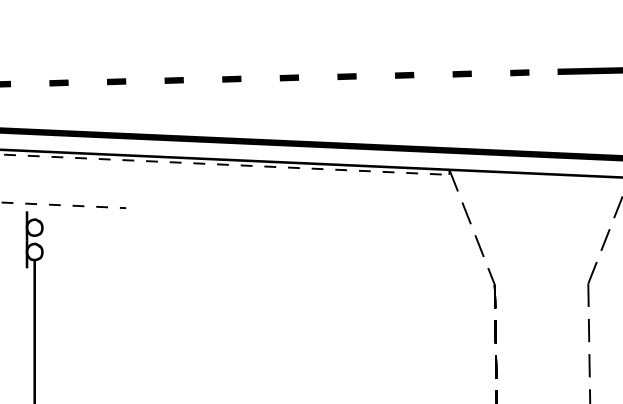


604.40 CHANGING ELEVATION OF DI, CB, OR MH

~~STA. 85+26.0, RT~~
~~STA. 85+82.2, LT~~
~~STA. 87+95.0, LT~~
~~STA. 88+39.5, LT~~
STA. 88+39.5, RT
~~STA. 89+25.0, RT~~
STA. 89+30.0, RT
~~STA. 89+41.0, LT~~

STA. 89+41.0, LT

675.50 REMOVING SIGNS
AS SHOWN - 2

STA. 87+11, LT
CONSTRUCT SIDEWALK
LANDING AND
DETECTABLE
WARNING SURFACE
R=40'

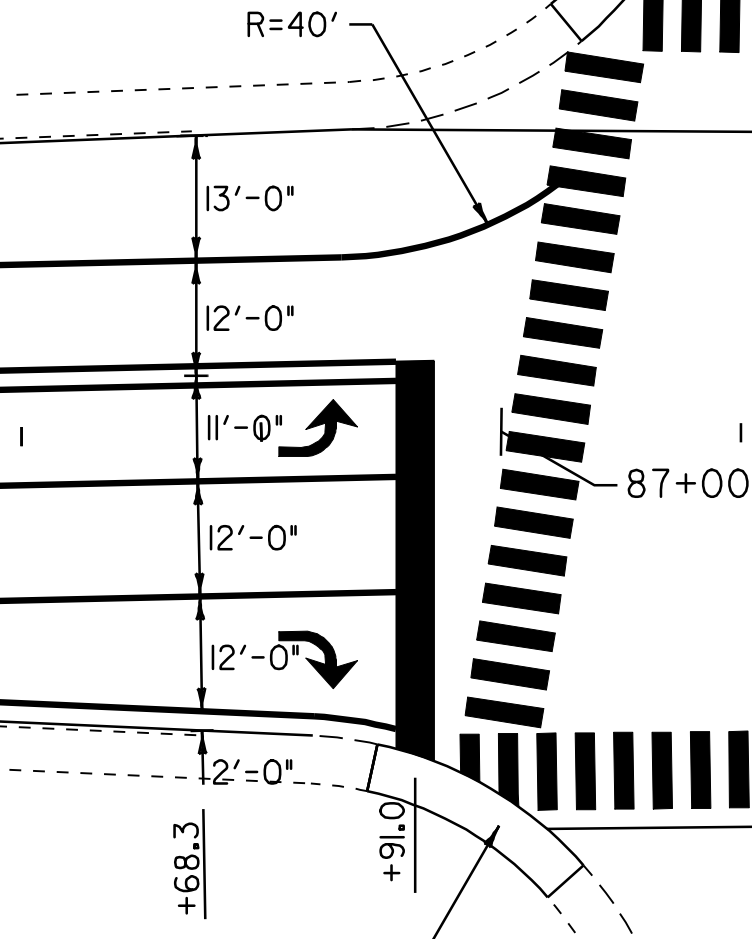

STA. 87+00, RT
CONSTRUCT SIDEWALK
RAMP, TYPE 6

604.42 CHANGING ELEVATION OF SEWER MANHOLES


STA. 85+52.3, LT

629.20 ADJUST ELEVATION OF VALVE BOX

STA. 89+04, LT

STA. 89+25, LT

VT ROUTE 14
MM 1.659 = STA. 87+57.4

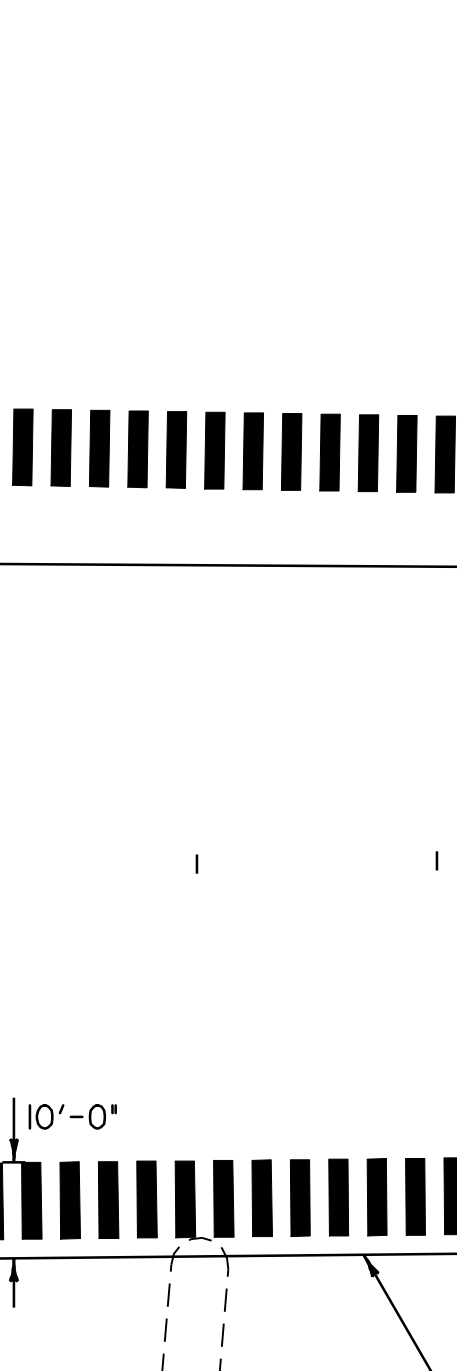

STA. 87+00, RT
CONSTRUCT SIDEWALK
RAMP, TYPE 6

604.42 CHANGING ELEVATION OF SEWER MANHOLES


STA. 85+52.3, LT

629.20 ADJUST ELEVATION OF VALVE BOX


STA. 89+04, LT

STA. 89+25, LT

646.30 LETTER OR SYMBOL
STA. 86+82.0, C - ARROW
STA. 86+82.0, RT - ARROW
STA. 88+26.5, LT - ARROW
STA. 88+26.5, C - ARROW

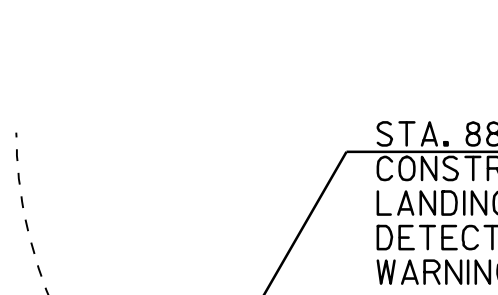

STA. 88+07, LT
CONSTRUCT SIDEWALK
LANDING AND
DETECTABLE
WARNING SURFACE

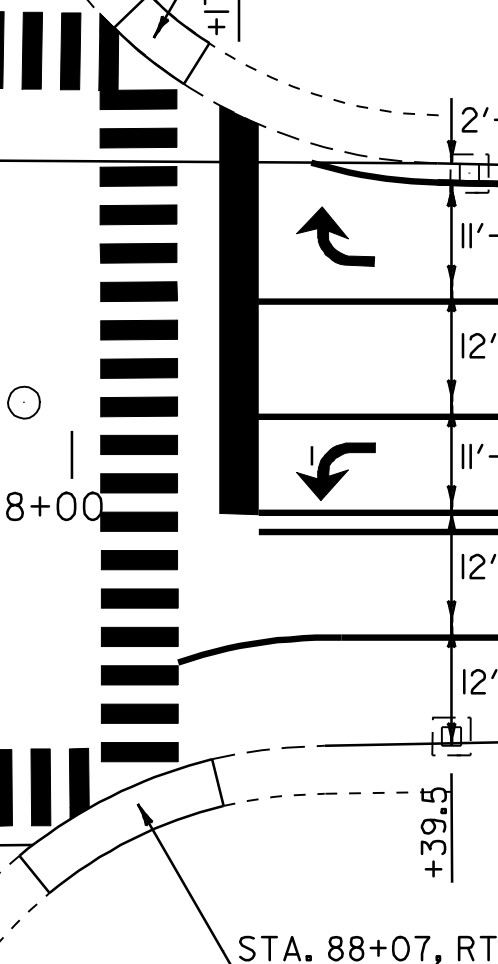

STA. 88+07, RT
CONSTRUCT SIDEWALK
RAMP, TYPE 6

604.42 CHANGING ELEVATION OF SEWER MANHOLES


STA. 85+52.3, LT

629.20 ADJUST ELEVATION OF VALVE BOX


STA. 89+04, LT

STA. 89+25, LT

646.692 TEMPORARY LETTER OR SYMBOL, PAINT
STA. 86+82.0, C - ARROW
STA. 86+82.0, RT - ARROW
STA. 88+26.5, LT - ARROW
STA. 88+26.5, C - ARROW

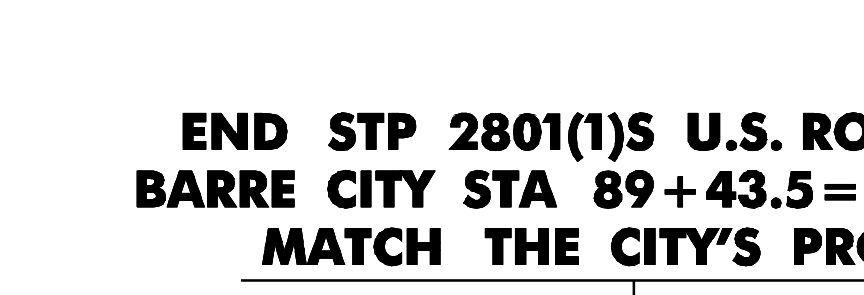

STA. 88+07, LT
CONSTRUCT SIDEWALK
LANDING AND
DETECTABLE
WARNING SURFACE

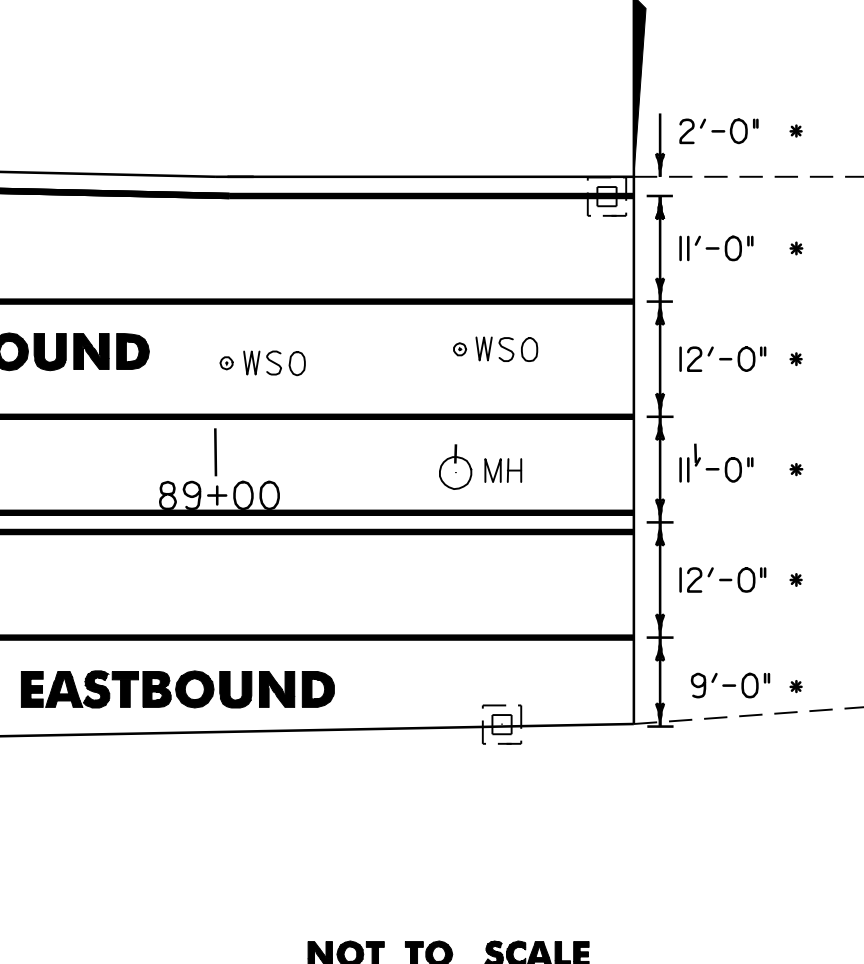

STA. 88+07, RT
CONSTRUCT SIDEWALK
RAMP, TYPE 6

604.42 CHANGING ELEVATION OF SEWER MANHOLES


STA. 85+52.3, LT

629.20 ADJUST ELEVATION OF VALVE BOX


STA. 89+04, LT

STA. 89+25, LT

646.31 CROSSWALK MARKING
STA. 87+00.0, RT TO 87+11.0, LT
STA. 87+51.0, RT (VT 62)
STA. 87+57.4, LT (VT 14-ON EXISTING PAVEMENT)
STA. 88+07.0, LT/RT

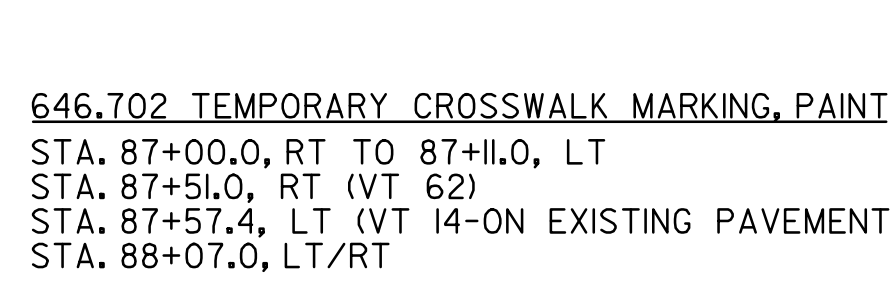

STA. 88+07, LT
CONSTRUCT SIDEWALK
LANDING AND
DETECTABLE
WARNING SURFACE

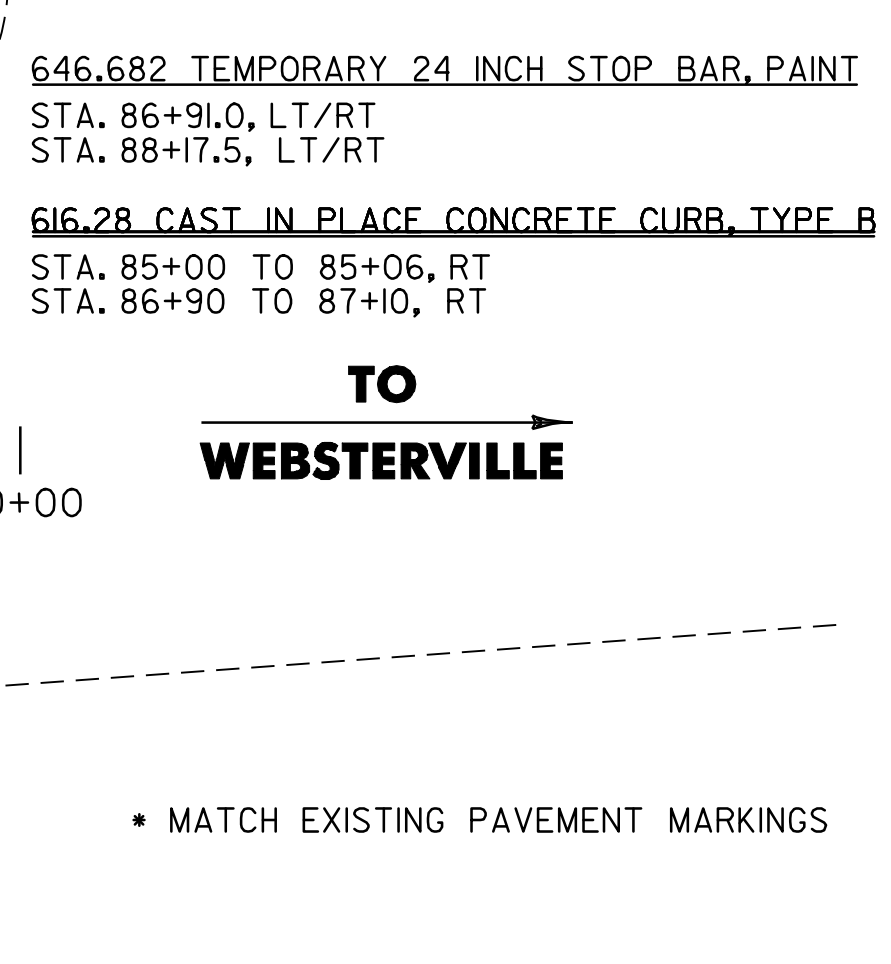

STA. 88+07, RT
CONSTRUCT SIDEWALK
RAMP, TYPE 6

604.42 CHANGING ELEVATION OF SEWER MANHOLES

STA. 85+52.3, LT

629.20 ADJUST ELEVATION OF VALVE BOX

STA. 89+04, LT

STA. 89+25, LT

STA. 89+25, LT

END STP 2801(1)S U.S. ROUTE 302
BARRE CITY STA 89+43.5=MM 1.694
MATCH THE CITY'S PROJECT

646.702 TEMPORARY CROSSWALK MARKING, PAINT
STA. 87+00.0, RT TO 87+11.0, LT
STA. 87+51.0, RT (VT 62)
STA. 87+57.4, LT (VT 14-ON EXISTING PAVEMENT)
STA. 88+07.0, LT/RT

646.26 24 INCH STOP BAR
STA. 86+91.0, LT/RT
STA. 88+17.5, LT/RT

646.682 TEMPORARY 24 INCH STOP BAR, PAINT
STA. 86+91.0, LT/RT
STA. 88+17.5, LT/RT

616.28 CAST IN PLACE CONCRETE CURB, TYPE B
STA. 85+00 TO 85+06, RT
STA. 86+90 TO 87+10, RT

TO
WEBSTERVILLE

* MATCH EXISTING PAVEMENT MARKINGS



NOT TO SCALE

PROJECT
LAYOUT
SHEET #9

PROJECT NAME: BARRE CITY
PROJECT NUMBER: STP 2801(1)S



FILE NAME: p08d022.dgn
PROJECT LEADER: JLL
DESIGNED BY: STANTEC
IPARM FILE: p08d022i09.1


PLOT DATE: 14-APR-2010
DRAWN BY: STANTEC
CHECKED BY: JLL
SHEET 16 OF 19

STATE OF VERMONT AGENCY OF TRANSPORTATION					TRAFFIC SIGN SUMMARY SHEET 1																																																																																																																																																																																																																																																																																																																																																																																																																																																																																																																																																																																																																																																																																																																																																																																																																																																																																																																																																																																																																																																																																																																																																																																																																																								
MILEMARKER, STATION, OR SIGN NUMBER	SIGN LEGEND	SIGN DIMENSIONS			NEW & SALVAGED SIGNS				EXIST POST RETAIN	SALVAGE	NO. OF POSTS	NEW SIGN POSTS																			REMARKS	SIGN DETAIL																																																																																																																																																																																																																																																																																																																																																																																																																																																																																																																																																																																																																																																																																																																																																																																																																																																																																																																																																																																																																																																																																																																																																																																																													
												FLANGED CHANNEL			SQUARE STEEL (In)				TUBULAR ALUMINUM Ø (In)			TUBULAR STEEL Ø (In)				W-SHAPE STEEL			DETAIL ON DWG. NUMBER	STD. SHEET NUMBER																																																																																																																																																																																																																																																																																																																																																																																																																																																																																																																																																																																																																																																																																																																																																																																																																																																																																																																																																																																																																																																																																																																																																																																																															
		1.75	2.0	2.5	ANCHOR	SLEEVE	3.0	4.0							4.0 MOD	FOUND- ATION	3.0	3.5	4.0	5.0	FTG. SIZE		WEIGHT	POST SIZE	REQUIRE D SIGN MATERIAL																																																																																																																																																																																																																																																																																																																																																																																																																																																																																																																																																																																																																																																																																																																																																																																																																																																																																																																																																																																																																																																																																																																																																																																																																				
		EA	WIDTH (In)	HEIGHT (In)			"A"	"B"				SALV SIGN	SALV TIS	lb/ft	lb/ft		lb/ft	lb/ft	lb/ft	lb/ft	lb/ft	24"				30"																																																																																																																																																																																																																																																																																																																																																																																																																																																																																																																																																																																																																																																																																																																																																																																																																																																																																																																																																																																																																																																																																																																																																																																																																			

STATE OF VERMONT
AGENCY OF TRANSPORTATION

TRAFFIC SIGN SUMMARY SHEET 2

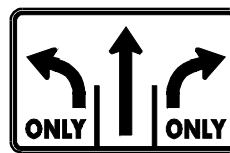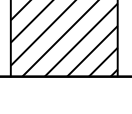MILEMARKER, STATION, OR SIGN NUMBER	SIGN LEGEND	SIGN DIMENSIONS			NEW & SALVAGED SIGNS				EXIST POST RETAI N S ALV AGE	NO. OF POST S	FLANGED CHANNEL			SQUARE STEEL					TUBULAR ALUMINUM			TUBULAR STEEL				W-SHAPE STEEL			RE FO R M I N G M E T E R	REMARKS	SIGN DETAIL		
					"A"	"B"	SALV SIGN	SALV TIS			lb/ft			lb/ft			FOUND- ATION	lb/ft			FTG. SIZE		WEIGHT	POST SIZE	DETAIL ON DWG. NUMBER	STD. SHEET NUMBER							
		1.12	2.0	3.0							1.75	2.0	2.5	1.3	1.7	1.7		3.0	3.5	4.0	5.0	24"					30"						
BARRE CITY		I	30	30	6.25					I					X		X													SIGN ID CODE WII-2		E-I52	
71+07.0, RT		I	24	12	2.0																									SIGN ID CODE W16-7p		E-I52	
71+13.0, LT	  						2																							NEW STOP SIGN (RI-I) AND SALVAGED MILEMARKER SIGNS MOUNTED BACK TO BACK. SALVAGED STREET SIGNS INSTALLED 6" ABOVE THE "STOP" SIGN USING POST TOP MOUNTING BRACKET ON NEW POST.		E-I43	
		I	30	30	6.25			2			I				X		X																
71+14.0, LT		I	30	30	6.25						I				X		X													SIGN ID CODE WII-2		E-I52	
		I	24	12	2.0																									SIGN ID CODE W16-7p		E-I52	
74+70.6, RT		I	30	30	6.25						I				X		X													SIGN ID CODE VR-92I		E-I45A	
84+92.0, RT	 	I	30	30	6.25						I				X		X													SIGN ID CODE WII-2		E-I52	
		I	24	12	2.0																									SIGN ID CODE W16-7p		E-I52	
85+00.0, LT	 	I	30	30	6.25						I				X		X													SIGN ID CODE WII-2		E-I52	
		I	24	12	2.0																									SIGN ID CODE W16-7p		E-I52	
85+65.0, RT		I	48	30	10.0						2				X		X													SIGN ID CODE VR-932		E-I45B	
	SHEET I7 TOTALS SHEET I8 TOTALS				62.00 55.5			I 4							I27 I14																		
	SUBTOTALS ROUNDING				I17.5 2.5			5 -							24I 4																		
FINAL POST LENGTHS ARE TO BE DETERMINED IN THE FIELD. POST SIZES ARE COMPUTED BASED ON INFORMATION FURNISHED ON THE STANDARD SHEETS AND THE ROADWAY, TRAFFIC AND SAFETY SECTION'S "SIGN POST DESIGN GUIDELINE."												LF	LF	LF	LF	LF	LF		EA.	LB	LB	LB		LB	LB	LB	LB						
												LF			LF				LB		EA.	LB				EA.	EA.	LB	TRAFFIC SIGN SUMMARY SHEET #2		PROJECT NAME: BARRE CITY PROJECT NUMBER: STP 280(I)S		
												LF			LF				LB		EA.	LB				EA.	EA.	LB	FILE NAME: p08d022.dgn PROJECT LEADER: JLL DESIGNED BY: STANTEC IPARM FILE: p08d022ss2.1		PLOT DATE: 14-APR-2010 DRAWN BY: STANTEC CHECKED BY: JLL SHEET 18 OF 19		

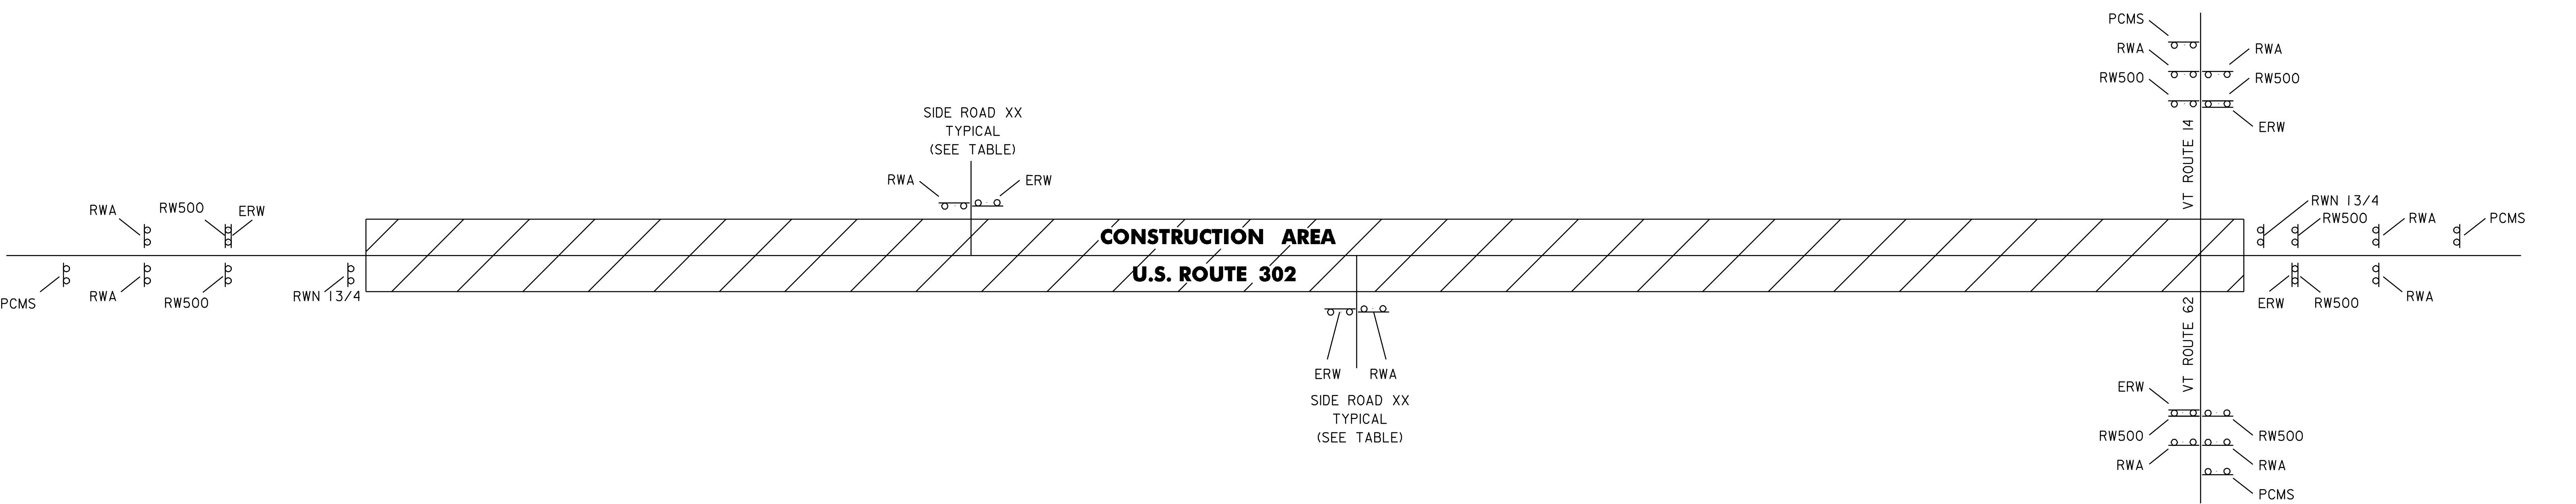

SEE VTrans STANDARD E-100 AND E-100A FOR SIGN PLACEMENT.

LOCATION	ERW	RW500	RWA	RWN 1 3/4	PCMS
BARRE CITY					
BEGIN PROJECT	1	2	2	1	1
PACKARD ST.	1		1		
FORD ST.	1		1		
RICHARDSON RD.	1		1		
WILLEY ST.	1		1		
SIXTH ST.	1		1		
FIFTH ST.	1		1		
FOURTH ST.	1		1		
THIRD ST.	1		1		
SECOND ST.	1		1		
W. SECOND ST.	1		1		
FIRST ST.	1		1		
BERLIN ST.	1		1		
BECKLEY ST.	1		1		
N. SEMINARY ST.	1		1		
BLACKWELL ST.	1		1		
BROOK ST.	1		1		
HORACE LN.	1		1		
MAPLE ST. (VT ROUTE 14)	1	2	2		1
VT ROUTE 62	1	2	2		1
END PROJECT	1	2	2	1	1
TOTAL	19	8	25	2	4

NOTE: PAYMENT FOR TEMPORARY CONSTRUCTION SIGNING WILL BE INCLUDED IN THE UNIT PRICE BID FOR CONTRACT ITEM 641.10

LEGEND

- ERW = END ROAD WORK
- RW500 = ROAD WORK 500 FT
- RWA = ROAD WORK AHEAD
- RWN 1 3/4 = ROAD WORK NEXT 1 3/4 MILES
- PCMS = PORTABLE CHANGEABLE MESSAGE SIGN



TEMPORARY TRAFFIC CONTROL PLAN

PROJECT NAME: BARRE CITY	
PROJECT NUMBER: STP 2801(1)S	
FILE NAME: p08d022.dgn	PLOT DATE: 14-APR-2010 15:51
PROJECT LEADER: JLL	DRAWN BY: STANTEC
DESIGNED BY: STANTEC	CHECKED BY: JLL
IPARM FILE: p08d022cas.1	SHEET 19 OF 19