

30

- IN SHEETS
1. Title Page
2. General Cross Section of Improvement - Item 361-BMCD.3711, Conc. Pav't.
3. Details (Drainage)
4. Details (Grading)
5. Details (Signs)
6. Details (Lighting)
7. Details (Fencing)
8. Details (Guard Rail)
9. Details (Roadway)
10. Details (Shoulders)
11. Details (Ditches)
12. Details (Culverts)
13. Details (Bridges)
14. Details (Tunnels)
15. Details (Interchanges)
16. Details (Overpasses)
17. Details (Underpasses)
18. Details (Retaining Walls)
19. Details (Erosion Control)
20. Details (Landscaping)
21. Details (Noise Abatement)
22. Details (Traffic Control)
23. Details (Safety Features)
24. Details (Construction Methods)
25. Details (Materials)
26. Details (Labor)
27. Details (Equipment)
28. Details (Costs)
29. Details (Schedule)
30. Details (Miscellaneous)

Dated MARCH 17, 1965


Walter Bros.
Woodward Bros.
By: Patrick Contractor
Commissioner of Highways
By Order of Commissioner of Highways

STATE OF VERMONT
DEPARTMENT OF HIGHWAYS
PROPOSED IMPROVEMENT


FEDERAL AID PROJECT

TOWN OF DORSET
COUNTY OF BENNINGTON
U.S. ROUTE #7
MANCHESTER - DANBY ROAD

BEGINNING AT A POINT APPROXIMATELY 3.322 MILES NORTH OF THE DORSET-
MANCHESTER TOWN LINE AND EXTENDING NORTHERLY 1.601 MILES
INCLUDING BRIDGES
LENGTH OF ROADWAY 3,306.6 FEET = 1.973 MILES
LENGTH OF BRIDGES 144.6 FEET = 0.028 MILE
LENGTH OF CONTRACT 3,451.2 FEET = 1.601 MILES

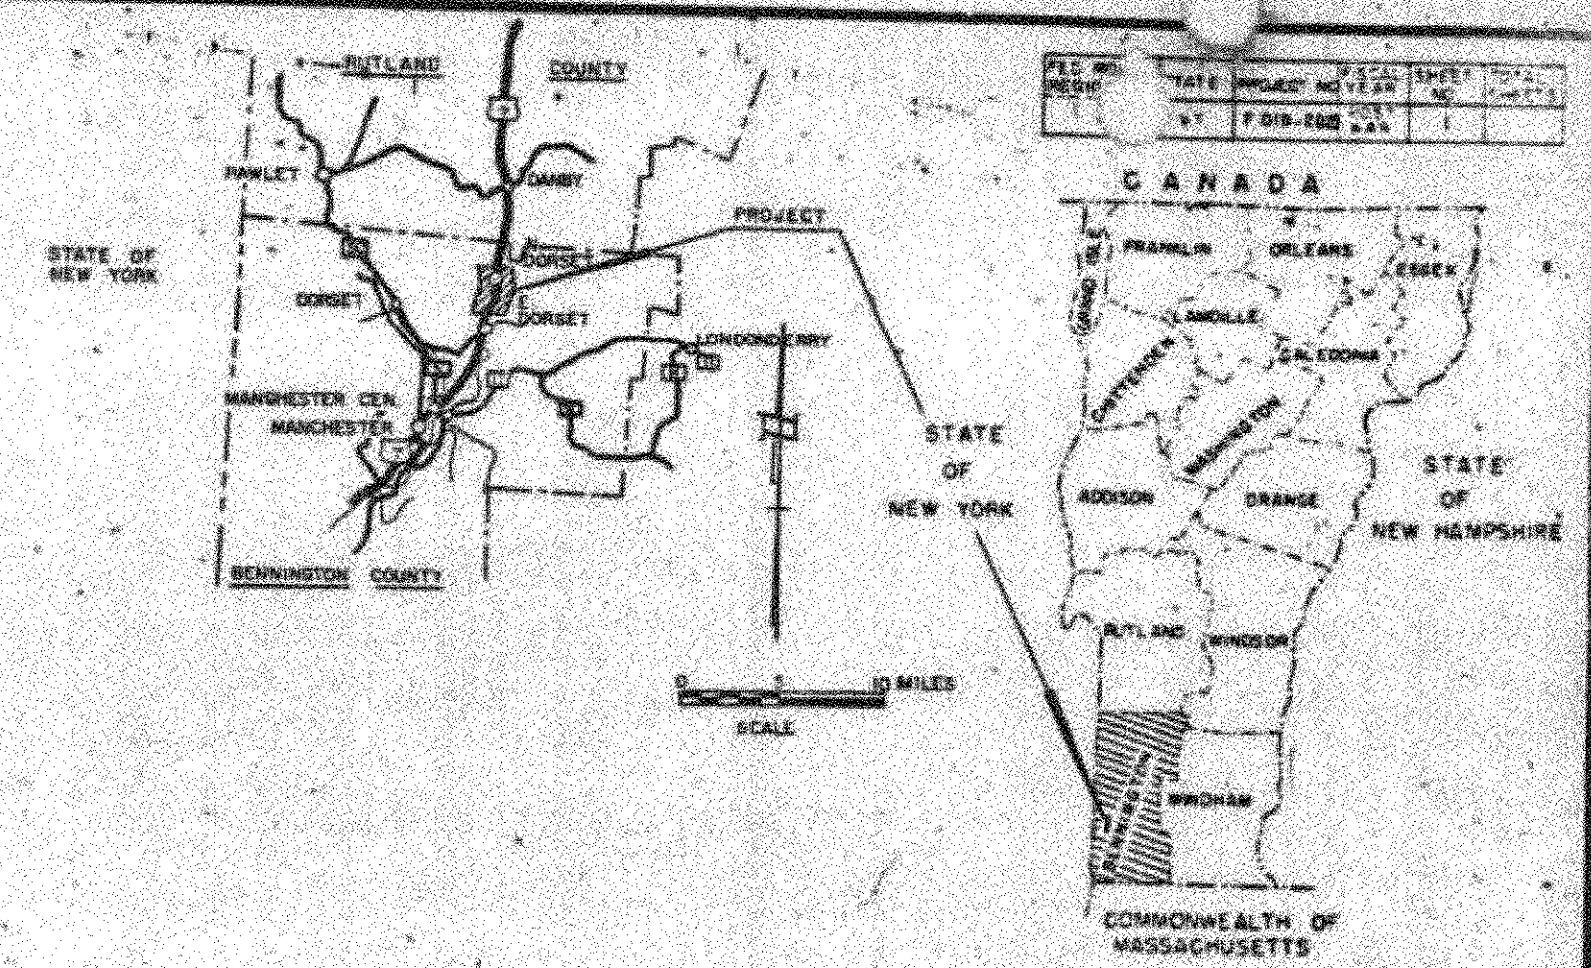

THESE PLANS HAVE BEEN REDUCED PHOTOGRAPHICALLY
TO APPROXIMATELY 1/2 SCALE

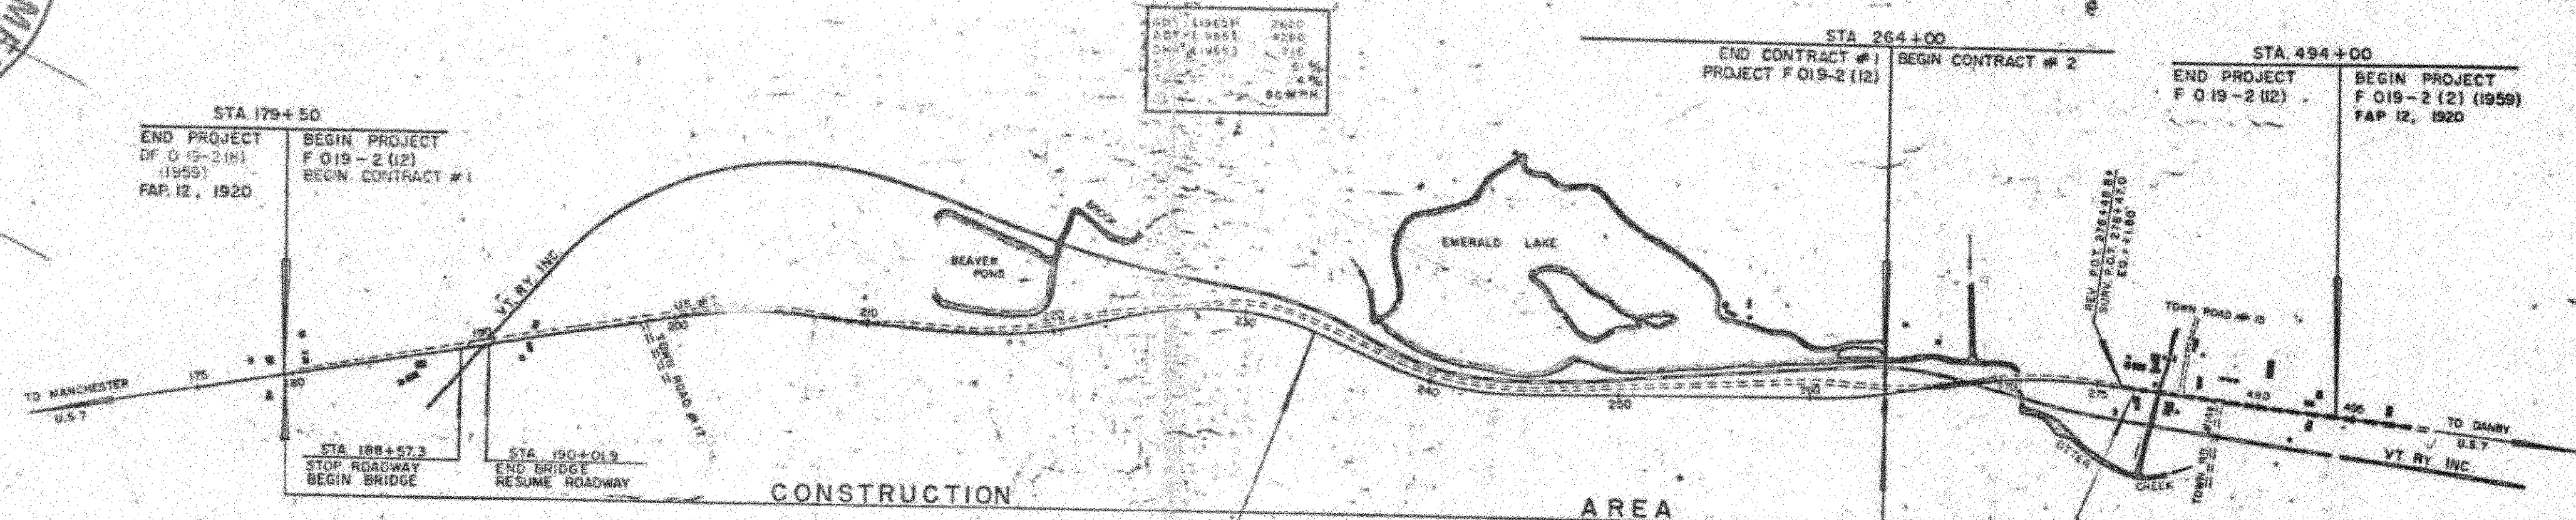

- CONSTRUCTION IDENTIFICATION SIGNS & CONVENTIONAL SIGNS
- NEW LINE
 - COUNTY LINE
 - TOWN LINE
 - FENCE LINE
 - STONE WALL
 - UNFENCED PROPERTY
 - GUARD RAIL
 - TRAVELED WAY
 - RAILROAD
 - RETAINING WALL
 - CENTER LINE
 - SURVEY LINE
 - CULVERT
 - DROP INLET
 - TACILEY POLE
 - POWER POLE
 - TELEPHONE POLE
 - TREES
 - WEDGE
 - ELONG RIGHTS

GROUND ELEVATION
GRADE ELEVATION
CURVE DATA
DEFLECTION OF ANGLE
DEGREE OF CURVE
RADIUS OF CURVE
TANGENT DISTANCE
LENGTH OF CURVE
EXTERNAL DISTANCE
POINT OF INTERSECTION
POINT OF CURVE
POINT OF TANGENT
POINT ON TANGENT
POINT ON SUB-TANGENT



APPROVED DATE 10/3/65	APPROVED DATE 10/3/65	APPROVED DATE 10/3/65	APPROVED DATE 10/3/65	APPROVED DATE 10/3/65	APPROVED DATE 10/3/65
CONTRACT #1					
DEPARTMENT OF COMMERCE BUREAU OF PUBLIC ROADS					
DIVISION ENGINEER					
PROJECT F NO. 019-2(12)					
SHEET 1 OF 130 SHEETS					

BRIDGE 52
FOR REFERENCE ONLY
SHEET 6 OF 14

THESE PLANS ARE SUBJECT TO SUCH REVISIONS AS MAY BE
REQUIRED BY THE BUREAU OF PUBLIC ROADS OR THE COMMISSIONER
OF HIGHWAYS.
CONSTRUCTION IS TO BE CARRIED ON IN ACCORDANCE WITH
THE PLANS AND THE STANDARD SPECIFICATIONS FOR HIGHWAY AND BRIDGE
CONSTRUCTION OF JANUARY 1958 SUBMITTED TO THE BUREAU OF
PUBLIC ROADS AS APPROVED JULY 5, 1958, INCLUDING ALL SUBSEQUENT
APPROVED REVISIONS AND SUCH REVISED SPECIFICATIONS AND SPECIAL
PROVISIONS AS ARE SUBMITTED WITH THE PLANS.

30