



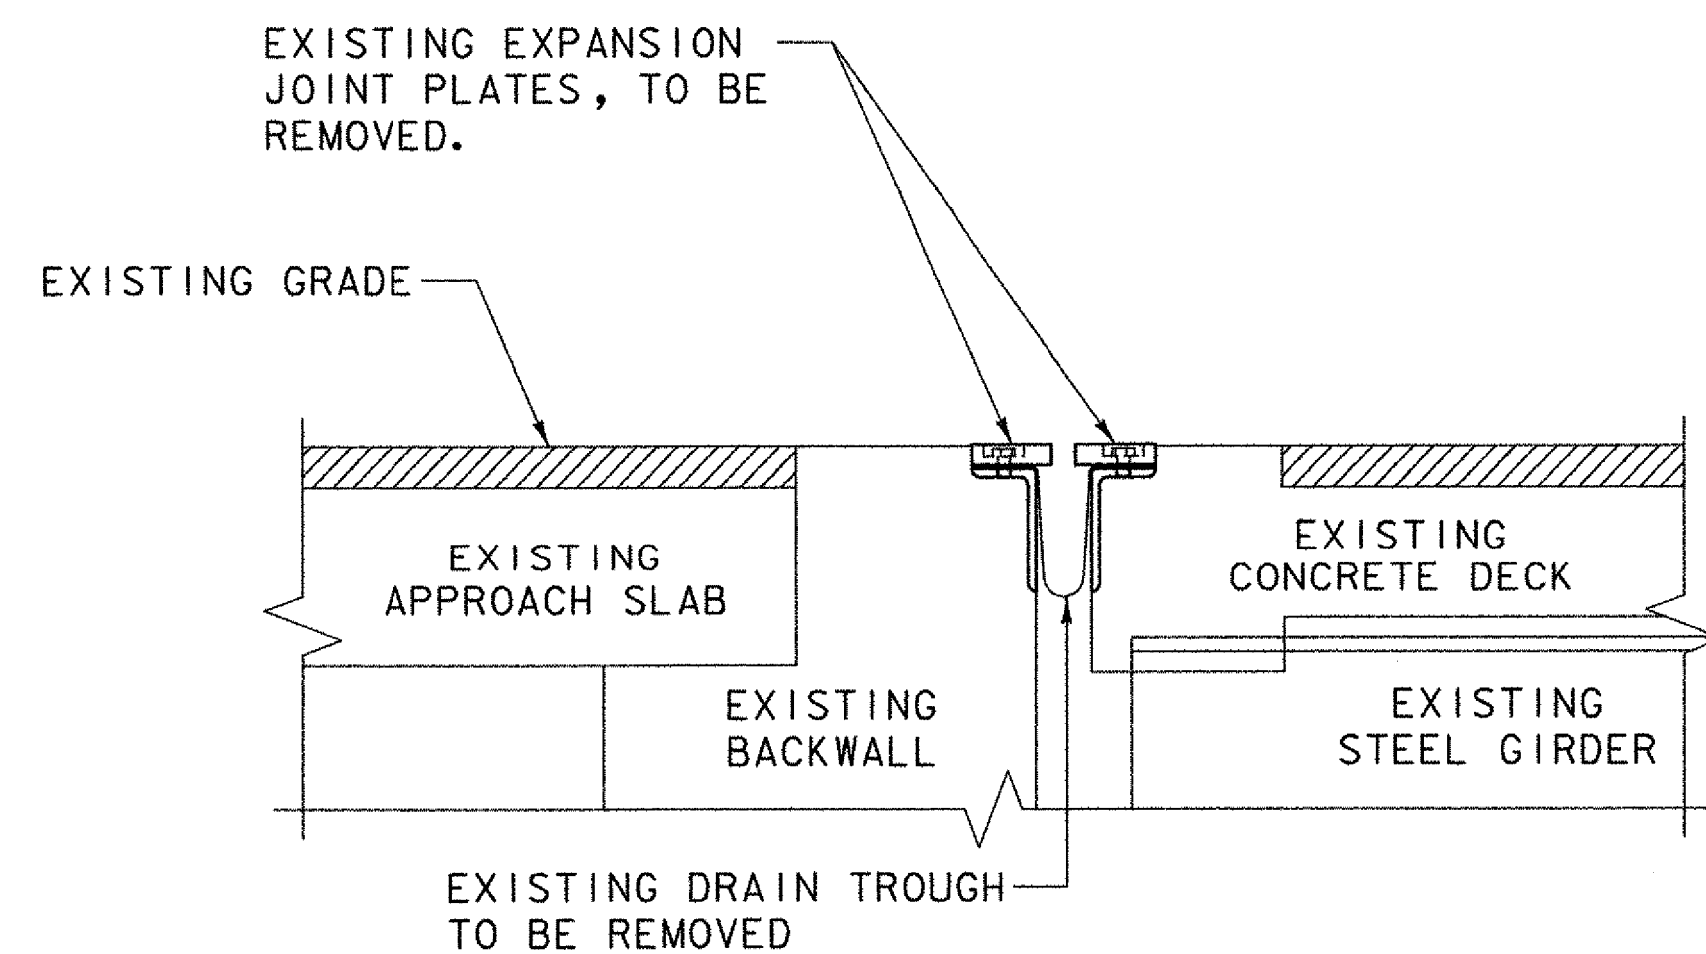


BRIDGE NO. 11
EXISTING EXPANSION JOINT

SCALE 1" = 1'-0"
1 9 6 3 0 1 2

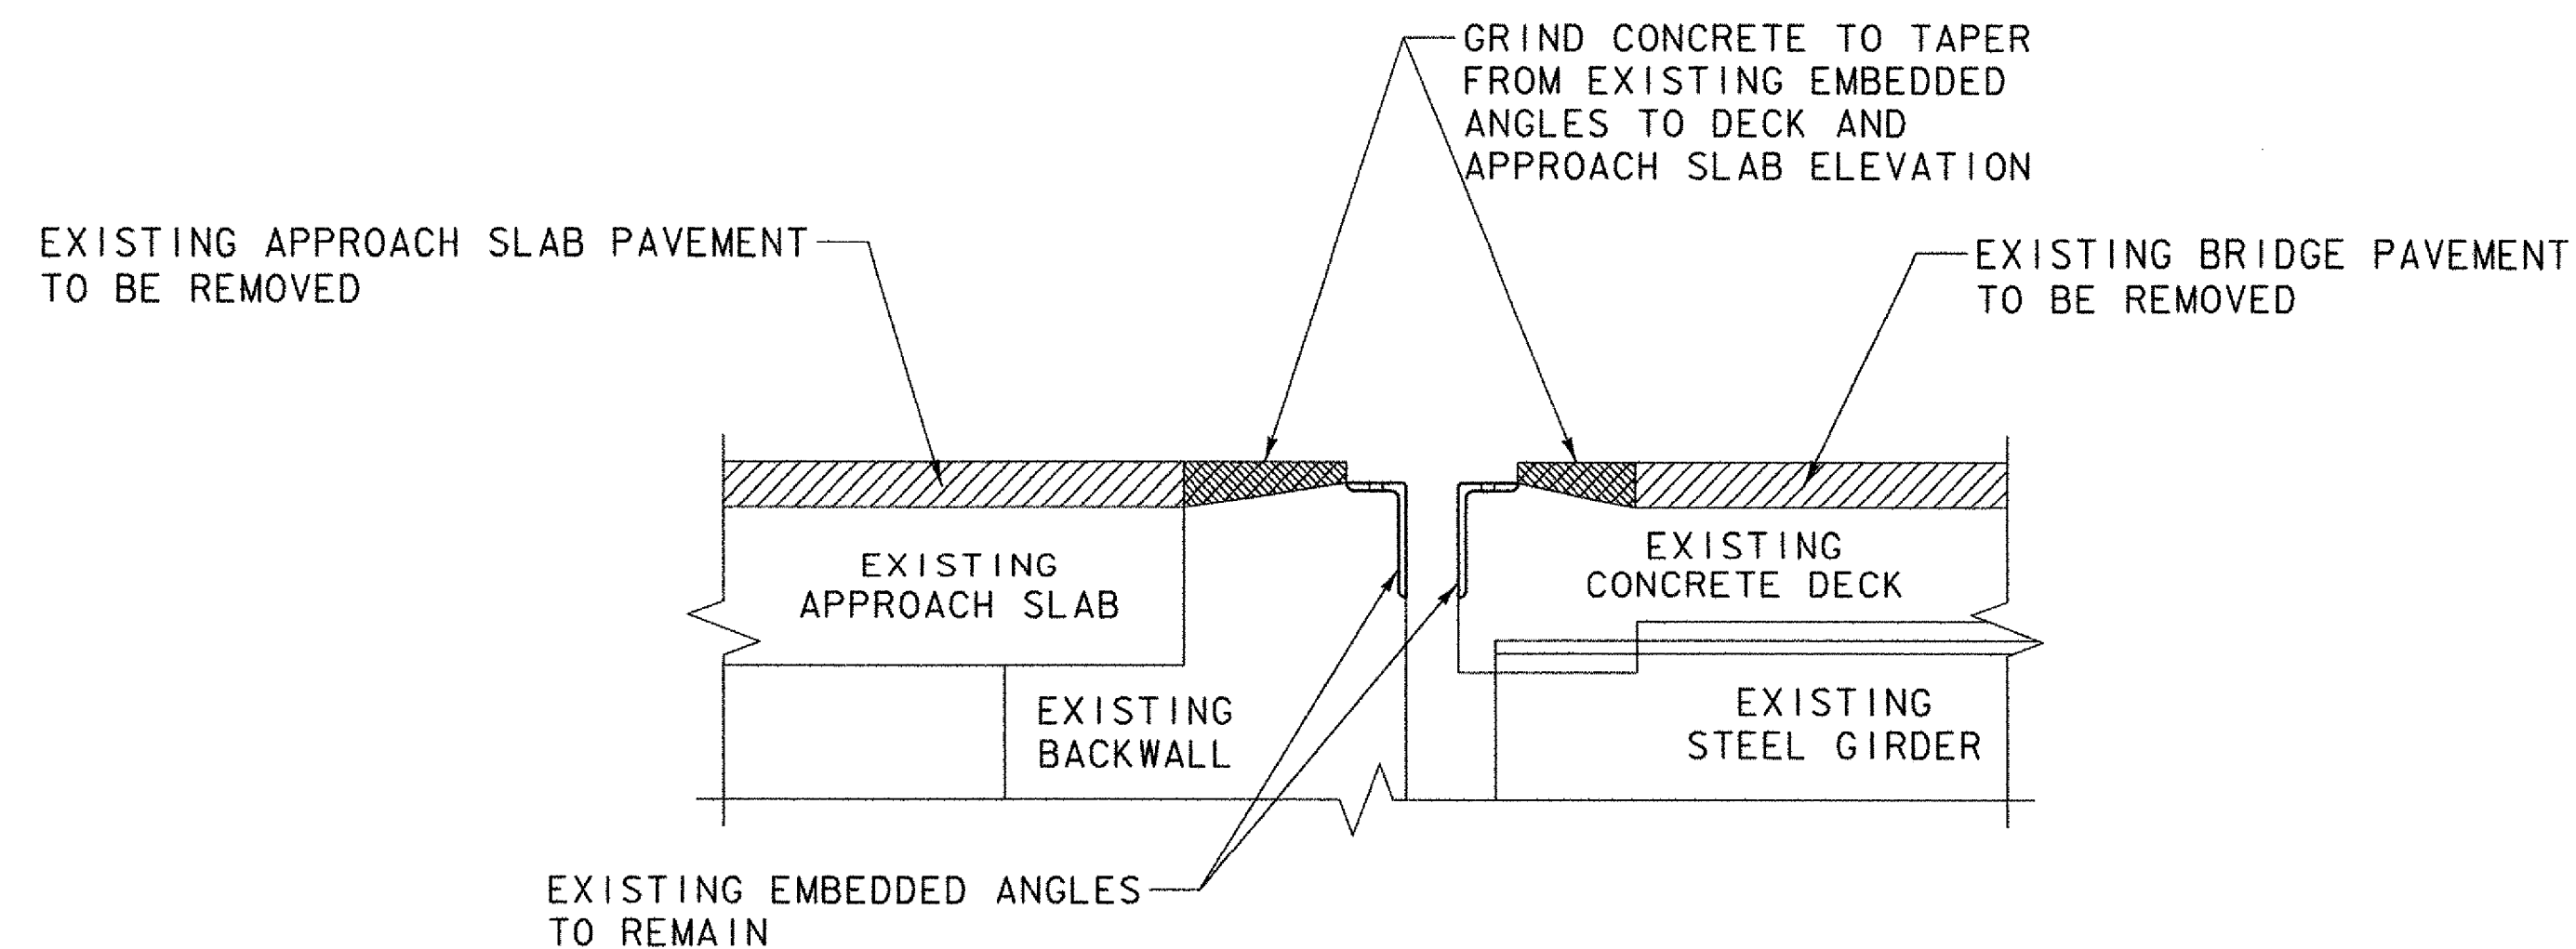


BRIDGE NO. 11
EXPANSION JOINT REMOVAL

SCALE 1" = 1'-0"
1 9 6 3 0 1 2

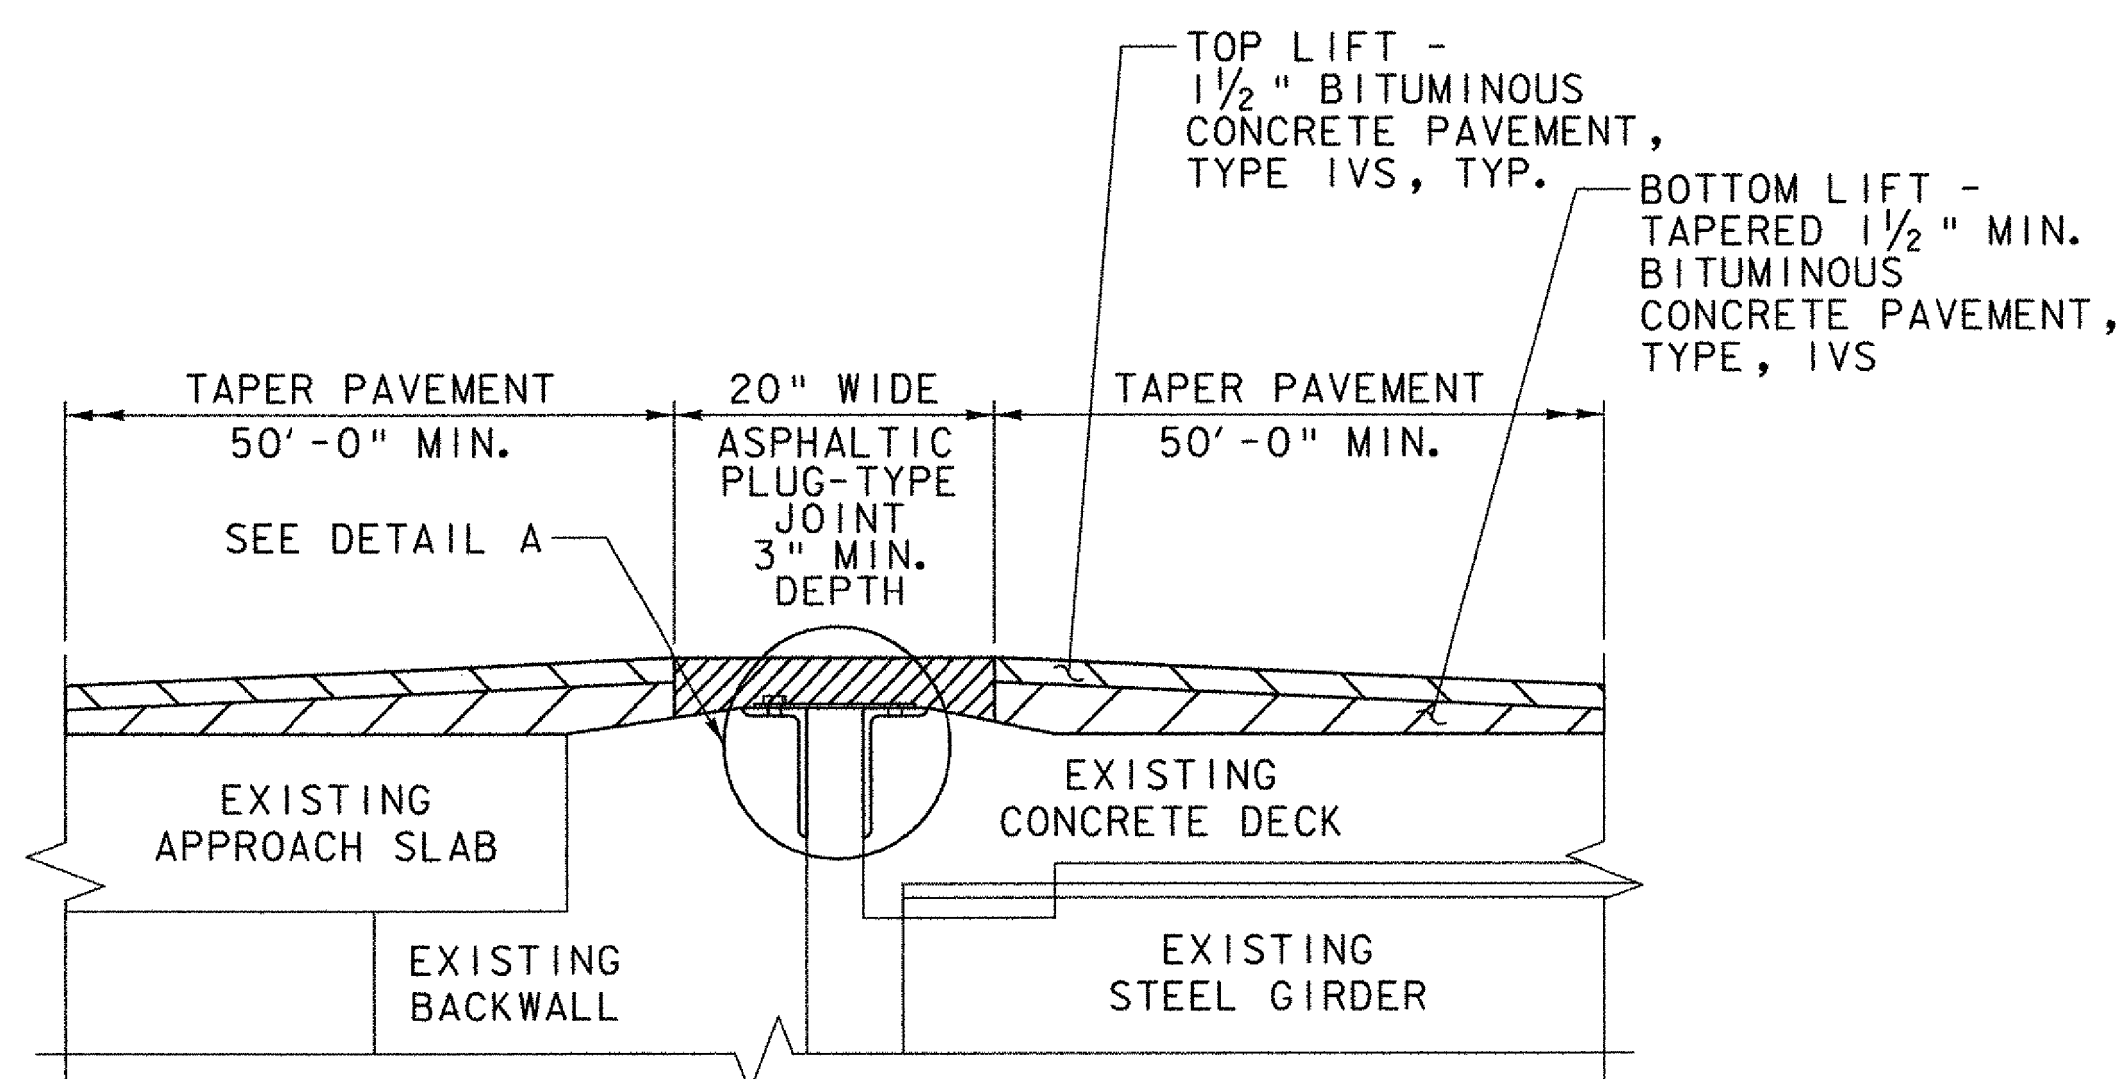

BRIDGE NO. 11
ASPHALTIC PLUG-TYPE JOINT

SCALE 1" = 1'-0"
1 9 6 3 0 1 2

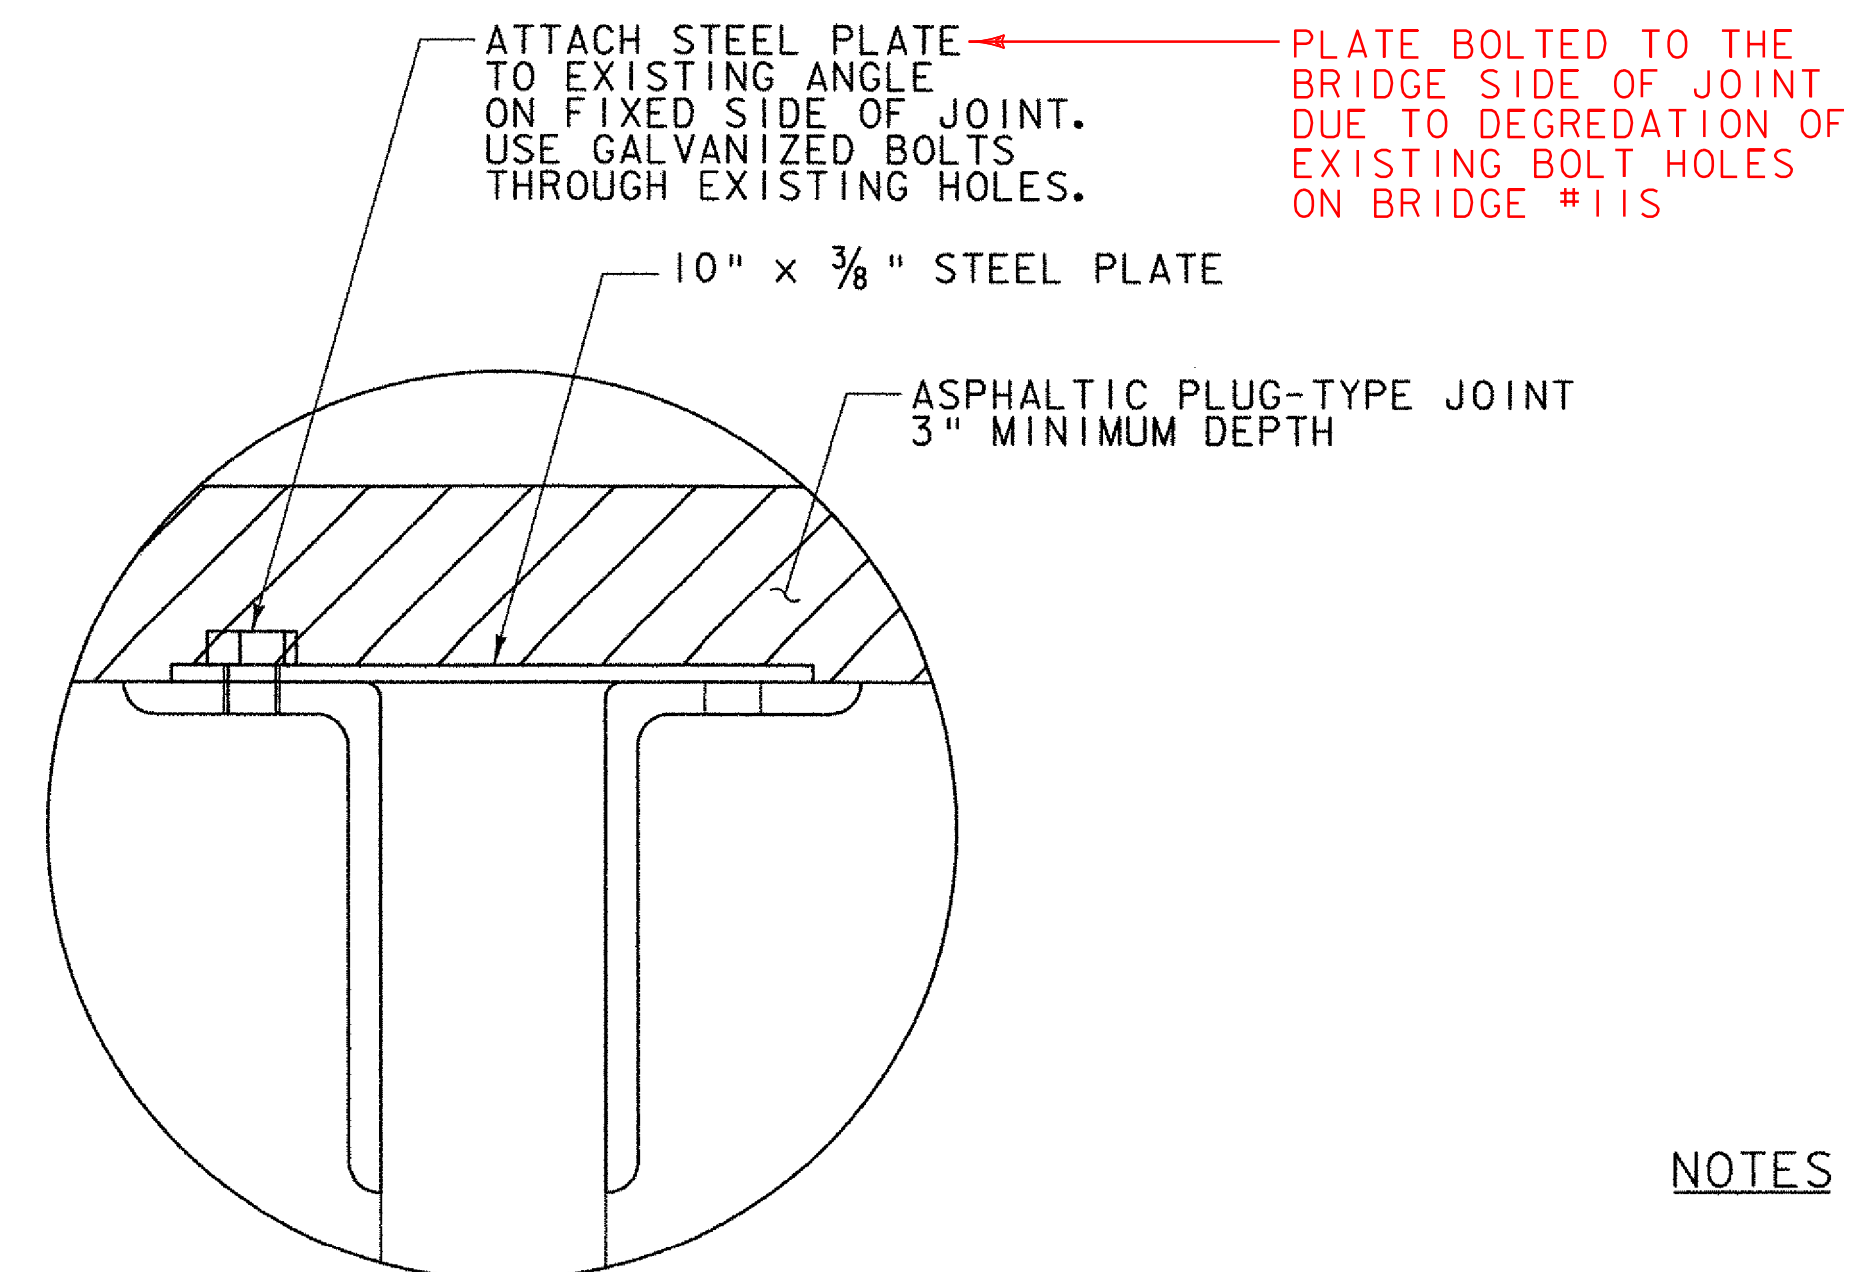

DETAIL A

NTS

NOTES

1. ALL HARDWARE AND MATERIALS SHALL BE IN ACCORDANCE WITH SECTION 516 OF THE SPECIFICATIONS.
2. REFER TO ASPHALTIC PLUG JOINT NOTES ON SHEET 6.

PROJECT NAME:	BENNINGTON - SHAFTSBURY
PROJECT NUMBER:	BHF MEMB(3)
FILE NAME:	z08e054detail.dgn
PROJECT LEADER:	APG
DESIGNED BY:	APG
DETAIL SHEET 2	
PLOT DATE:	7/15/2008
DRAWN BY:	RHB
CHECKED BY:	EPD
SHEET 7	OF 45

