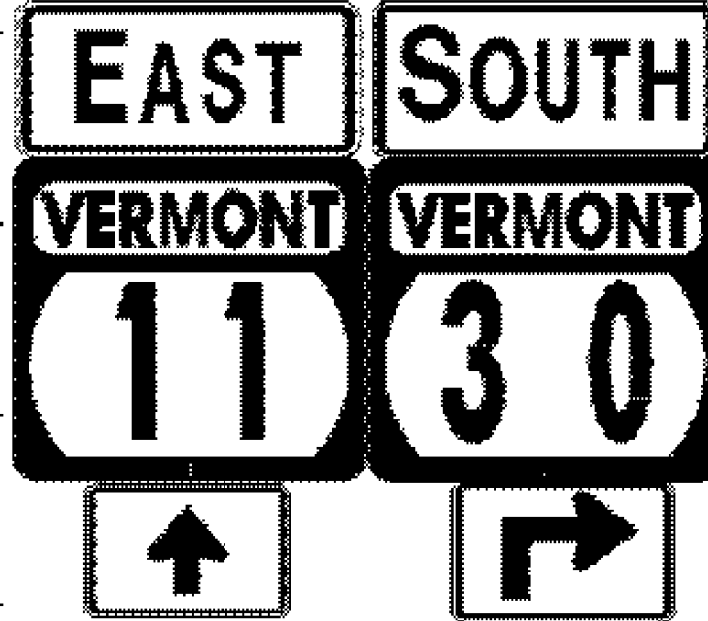


DIR	MILEPOINT	LOCATION CODE (SHEET 2)	MUTCD CODE	WIDTH (IN)	HEIGHT (IN)	SHEETING REMARKS	SIGN LEGEND FOR POST LENGTHS AND INSTALLATION DATES SEE ORIGINAL RECORD PLANS	NEW SIGNS		EXISTING SIGNS				EXIST POST		NUMBER OF NEW POSTS	SQUARE STEEL (in)			TUBULAR STEEL Ø (IN)				SIGN FRAME REQUIRED	REMARKS	SIGN DETAIL		
								"A"	"B"	RETAIN	SALVAGE FROM	SALVAGE TO	REMOVE	RETAIN	REMOVE		2.00	2.00	2.50	3.00	3.50	4.00	5.00					
																	(LB / FT)			(LB / FT)								
																	2.16	2.42	3.35	FOUNDATION	7.60	9.00	10.80			14.60		
WINHALL VT11						"FY"-FLUORESCENT YELLOW "FYG"-FLUORESCENT YELLOW GREEN																"SHS"-STANDARD HIGHWAY SIGNS						
			A	M6-3	21	15							1															
			A	M3-3	24	12							1															
			A	M1-5A	24	24							1															
			A	M5-1R	21	15					1		1															
			A	M3-2	24	12		2.00				1			2		X					#2	GREEN ON WHITE SHEETING	X	7			
			A	M1-5A	24	24		4.00																	E-136B			
			A	M6-3	21	15		2.19																GREEN ON WHITE SHEETING	X			
			A	M3-3	24	12		2.00																GREEN ON WHITE SHEETING	X			
			A	M1-5A	24	24		4.00																		E-136B		
			A	M5-1R	21	15		2.19																GREEN ON WHITE SHEETING	X			
EB	3.040		A	VR-921R	36	36						1		X														
			A	VR-921R	36	36		9.00							2		X									E-145A		
EB	3.090		A	D1-1S	72	10						1	0 2	2														
			A	D1-1A	72	10						1																
			A	D1-1S	72	10						1																
SIGN SUMMARY SHEET							SHEET TOTALS	25.38	0.00	0	0	0	8	2	0	4	60							PROJECT NAME: Manchester-Springfield VT11				
								SF	SF	EA	EA	EA	EA	EA	EA	EA	FT							PROJECT NUMBER: STPG SIGN(25)				
																										FILE NAME: Winhall VT11.xls		
VERMONT AGENCY OF TRANSPORTATION																							PROJECT MANAGER: N. Avery					
																										PLOT DATE: 4/6/2009		
																										DRAWN BY: T. Guazzoni		
																							DESIGNED BY: A. Gamble					
																										CHECKED BY: S. Menard		
																							WINHALL SHEET 4					
																										SHEET 15 OF 115		