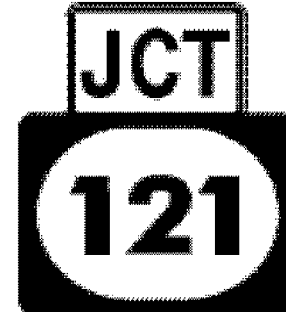


DIR	MILEPOINT	LOCATION CODE (SHEET 2)	MUTCD CODE	WIDTH (IN)	HEIGHT (IN)	SHEETING REMARKS	SIGN LEGEND FOR POST LENGTHS AND INSTALLATION DATES SEE ORIGINAL RECORD PLANS	NEW SIGNS		EXISTING SIGNS				EXIST POST		NUMBER OF NEW POSTS	SQUARE STEEL (in)			TUBULAR STEEL Ø (IN)				SIGN FRAME REQUIRED	REMARKS	SIGN DETAIL				
								"A"	"B"	RETAIN	SALVAGE FROM	SALVAGE TO	REMOVE	RETAIN	REMOVE		2.00	2.00	2.50	FOUNDATION	3.00	3.50	4.00			5.00	DETAIL IN SHS	DETAIL ON SHEET NUMBER	DETAIL ON STD SHEET NUMBER	
																	(LB / FT)				(LB / FT)									
																	2.16	2.42	3.35		7.60	9.00	10.80			14.60				
LONDONDERRY VT11							"FY"-FLUORESCENT YELLOW "FYG"-FLUORESCENT YELLOW GREEN															"SHS"-STANDARD HIGHWAY SIGNS								
		D	R1-1	30	30			6.25							1		X							X						
EB	4.732	A	M3-2	24	12			2.00							1		X						INSTALL 150 FT ± EAST OF JUNCTION WITH MAGIN MTN RD. "EAST" IS GREEN ON WHITE SHEETING.	X						
		A	M1-5	24	24			4.00																		E-136B				
	5.316	C	VR-017	24	30			5.00							1		X						CROMACK LANE (TH-30)			E-141				
EB	5.324	D	R1-1	24	24		STOP AND LEGAL LOAD LIMIT 24000 POUNDS, MOUNTED BACK-TO-BACK				1		X										CROMACK LANE (TH-30)							
		C	VR-017	24	24																									
		D	R1-1	30	30			6.25							1		X							X						
EB	5.983	A	VW-060	30	30		HIDDEN DRIVES			X																				
EB	6.148	A	VW-133L	30	30		HIDDEN DRIVES LEFT			X																				
EB	6.270	A	W7-1B	30	30		HILL 5%	6.25					1		1		X						INSTALL SIGN 100'+- EAST OF "SCHOOL BUS STOP AHEAD" SIGN IN WESTBOUND LANE, 10 FT ± IN FRONT OF POLE.	X						
		A	W7-3A	24	18		NEXT 1/2 MILE	3.00																X						
EB	6.448	A	M2-1	21	15								1			X														
		A	M1-6	30	24								1																	
		A	M2-1	21	15			2.19							1		X						BLACK ON WHITE SHEETING	X						
		A	M1-6	30	24			5.00															BLACK ON WHITE SHEETING			E-136C				
SIGN SUMMARY SHEET							SHEET TOTALS	39.94	0.00	0	10	10	54	0	0	6	90							PROJECT NAME: Manchester-Springfield VT11						
								SF	SF	EA	EA	EA	EA	EA	EA	EA	FT							PROJECT NUMBER: STPG SIGN(25)						
																												FILE NAME: Londonderrv.xls		
VERMONT AGENCY OF TRANSPORTATION																								PROJECT MANAGER: N. Avery						
																											PLOT DATE: 4/6/2009			
																											DRAWN BY: T. Guazzoni			
																							DESIGNED BY: D. Crossley							
																											CHECKED BY: S. Menard			
																								LONDONDERRY SHEET 12						
																											SHEET 53 OF 115			