


RIGHT - OF - WAY DETAIL SHEET

TABLE OF PROPERTY ACQUISITION

PARCEL NO.	PROPERTY OWNER	SHEET NO.	BEGINNING STATION	ENDING STATION	TAKE	REMAINDER	RIGHT			RECORDING DATA					REMARKS
					AREA±	AREA±	TYPE	(T)/(P)	AREA ±	TITLE	DATE	TOWN / CITY	BOOK	PAGE	
2	PEARSON, KENNETH M. & BARBARA J. TRUSTEES OF PEARSON LIVING TRUST	24,25	MAPLE AVE. 24+78.99 RT. MAPLE AVE. 24+80.51 RT. SUMMER ST. 400+64.96 LT. SUMMER ST. 400+78.00 LT. SUMMER ST. 400+66.56 LT.	SUMMER ST. 400+66.56 LT. SUMMER ST. 400+88.43 LT.	390.4 SF		 WALK WALK DRIVE INSTALL & MAINT.	 (T) (T) (T) (P)		WD		BARRE CITY			 3' CONCRETE 3' CONCRETE 19' PAVED SIDEWALK
3	THOMPSON, ROBERT F. & BRENDA J.	24,25	MAPLE AVE. 23+70.86 RT. MAPLE AVE. 23+66.51 RT. MAPLE AVE. 23+70.86 RT. MAPLE AVE. 23+15.00 RT.	SUMMER ST. 400+81.84 RT. SUMMER ST. 400+79.12 RT. SUMMER ST. 400+88.38 RT. MAPLE AVE. 23+70.86 RT.	159.8 SF		 SLOPE INSTALL	 (T) (T)	114 SF	WD		BARRE CITY			 CHAIN LINK FENCE FENCE, EXCEPT & RESERVE
5	VENMAR, MARIANNE S. - TRUSTEE OF THE MARIANNE S. VENMAR REVOCABLE FAMILY LIVING TRUST w/a JUNE 2, 2008	24	MAPLE AVE. 24+79.48 LT. MAPLE AVE. 24+38.68 LT. MAPLE AVE. 24+42.30 LT. MAPLE AVE. 24+36.44 LT.	MAPLE AVE. 24+72.46 LT. MAPLE AVE. 24+92.00 LT.			 WALK INSTALL & MAINT. DRIVE INSTALL & MAINT.	 (T) (P) (T) (P)		COND	02/11/10	BARRE CITY	257	638-643	 4' CONCRETE PED POLE & UNDERGROUND POWER EQUIPMENT 12' PAVED SIDEWALK
6	WATKINS, THOMAS V. II & CROWLEY-WATKINS, JOANNE	24	MAPLE AVE. 23+75.29 LT. MAPLE AVE. 24+02.02 LT. MAPLE AVE. 24+22.93 LT. MAPLE AVE. 23+76.18 LT.	MAPLE AVE. 23+85.83 LT. MAPLE AVE. 24+36.24 LT.			 INSTALL & MAINT. WALK WALK INSTALL & MAINT.	 (P) (T) (T) (P)	70 SF						 SIGNAL EQUIPMENT & STRAIN POLE 5' CONCRETE 5' CONCRETE SIDEWALK
7	MOORE, W. GLENN & HERSCHEL, LUCILLE J.	24	SUMMER ST. 400+88.43 LT. SUMMER ST. 400+88.43 LT. SUMMER ST. 401+00.00 LT. SUMMER ST. 400+91.00 LT.	SUMMER ST. 401+28.24 LT. SUMMER ST. 401+28.24 LT. 			 SLOPE INSTALL & MAINT. WALK INSTALL & MAINT.	 (T) (P) (T) (P)	246 SF	WD	01/13/10	BARRE CITY	257	244-245	 CURB 3' CONCRETE SIGN
8	KEATON, WILLIAM H. & MARIE Z.	24	SUMMER ST. 401+28.24 LT. SUMMER ST. 401+41.65 LT. SUMMER ST. 401+67.70 LT. SUMMER ST. 401+28.24 LT. SUMMER ST. 401+86.15 LT.	SUMMER ST. 402+15.76 LT. SUMMER ST. 402+15.76 LT. 			 SLOPE WALK WALK INSTALL & MAINT. INSTALL & MAINT.	 (T) (T) (T) (P) (P)	258 SF	WD	12/14/09	BARRE CITY	256	723-724	 3' CONCRETE 3' CONCRETE CURB CONCRETE SIGN
9	NORWAY BARRE REAL ESTATE, LLC	23,24	112+02.82 LT. MAPLE AVE. 21+60.83 LT.	113+10.95 LT. MAPLE AVE. 22+44.62 LT.			 D & C SLOPE	 (T) (T)	251 SF						SEWER, WATER & DRAINAGE IF APPLICABLE
62	IB PROPERTY HOLDINGS, LLC	29	138+67.29 LT. 137+34.47 LT. 137+23.02 LT. 137+23.02 LT.	138+78.88 LT. 138+67.29 LT. 138+78.88 LT. 138+78.88 LT.	42 SF±		 INSTALL & MAINT. D & C WALK	 (P) (T) (T)							 UNDERGROUND UTILITIES & PULL BOX SEWER, WATER & DRAINAGE IF APPLICABLE SIDEWALK

TABLE OF REVISIONS

REVISION NO.	SHEET NO.	DESCRIPTION	DATE
1	21, 24	PARCEL NO. 83 VENMAR, RICHARD S. - TRUSTEE OF THE RICHARD S. VENMAR REVOCABLE FAMILY TRUST - ADDED NEW PARCEL, ONLY ONE RIGHT NEEDED. MAPLE AVE. 25+93.00 LT. INSTALL & MAINT. (P) SIGN. MADE BY: MT PER C.O. 9574 APPROVED BY: HP	11/05/09
2	21, 24	PARCEL NO. 5 VENMAR, MARIANNE S. - DELETE MAPLE AVENUE 25+93.00 LT. INSTALL & MAINT. (P) SIGN AND CHANGE NAME FROM VENMAR, MARIANNE S. TO VENMAR, MARIANNE S. - TRUSTEE OF THE MARIANNE S. VENMAR REVOCABLE FAMILY LIVING TRUST w/a JUNE 9, 2008 PER C.O. 9575 MADE BY: MT APPROVED BY: HP	11/05/09
3	22, 32	PARCEL NO. 73 DRURY, MARIE L. - CORRECT INSTALL (P) TO READ INSTALL & MAINT. (P) ON DETAIL SHEET AND LAYOUT SHEET. MADE BY: MT PER C.O. 9579 APPROVED BY: HP	12/07/09
4	1,22,33	PARCEL NO. 84 BARRE HOUSING AUTHORITY. CREATE NEW PARCEL #84. PROPOSED SIGN AT STA. 604+61.64 LT WAS MOVED SOUTHERLY ONTO BARRE HOUSING AUTHORITY PROPERTY. ADD INSTALL AND MAINTAIN (P) FOR SIGN AT STA. 605+95 LT. ELIMATE PARCEL #76 FROM PROJECT. CHANGE ENDING STATION OF PROJECT. PER C.O. 9581 MADE BY: MR APPROVED BY: HP	12/14/09
		CONTRACT PLANS IN PDF FORMAT TO VHB	04/14/10

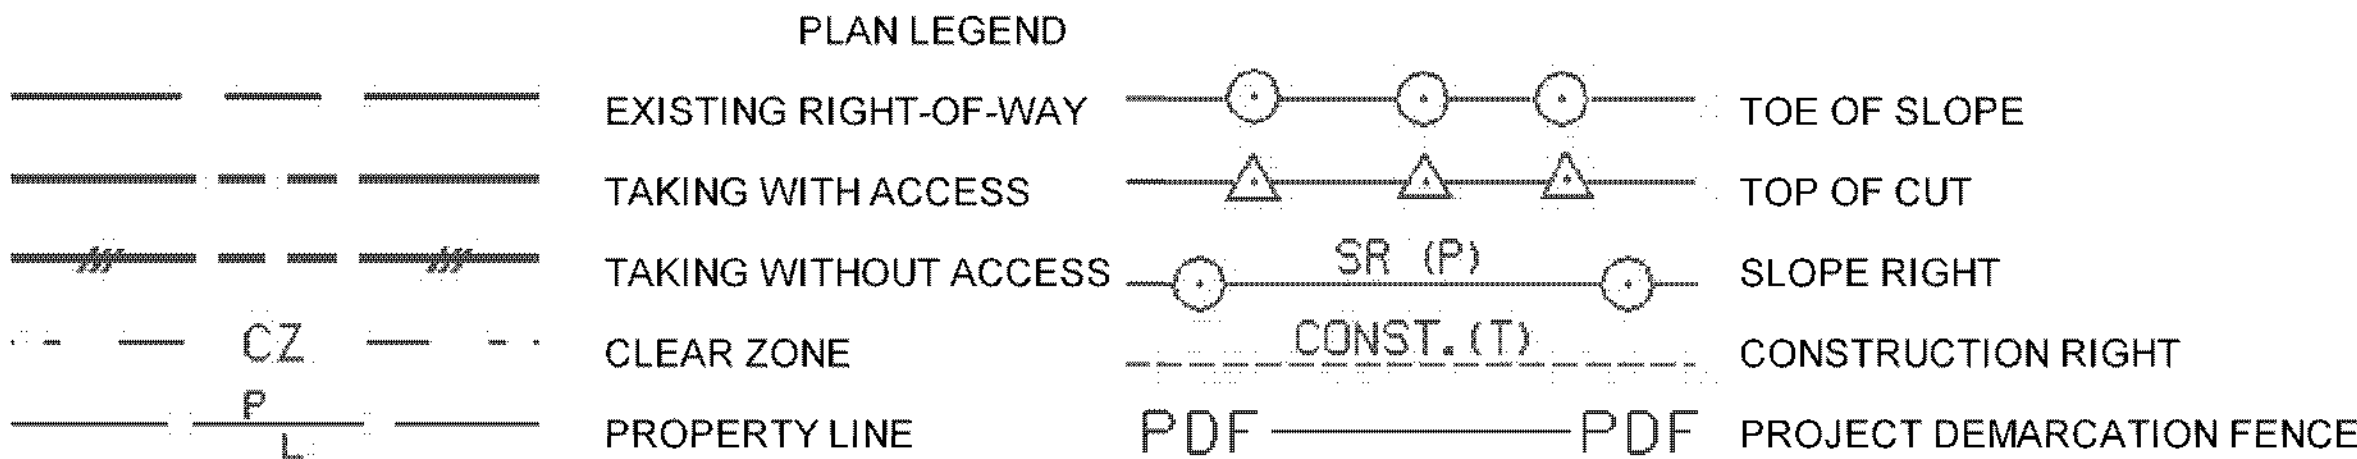

- D&C
- EC
- (P)
- (T)
- DR.
- DIT.
- CH.
- DRIVE
- CUL.
- C&T
- SR
- UE
- DISCONNECT & CONNECT
- EROSION CONTROL
- PERMANENT
- TEMPORARY
- DRAINAGE RIGHT
- DITCHING RIGHT
- CHANNEL RIGHT
- DRIVE RIGHT
- CULVERT RIGHT
- CLEARING & TRIMMING RIGHT
- SLOPE RIGHT
- UTILITY EASEMENT

APPROVED: HARRY PETROVS DATE: 09-10-09
CHIEF, PLANS & TITLES

PLOT DATE 04/13/10

PROJECT NAME:	BARRE CITY	PLOT DATE:	
PROJECT NUMBER:	FEGC F 026-1(34) C/1	DRAWN BY:	MT
FILE NAME:	Contract 1 DetailSheet.xls	CHECKED BY:	FM
PROJECT LEADER:	G. BAKOS	SHEET	11 OF 95
DESIGNED BY:	D. PECK		
ROW SHEET 21 OF 33			