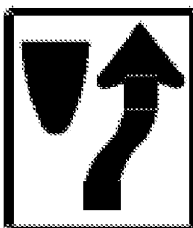
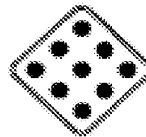


DIRECTION	MILEPOINT	LOCATION CODE (SHEET 2)	SIGN CODE	WIDTH (IN)	HEIGHT (IN)	SHEETING REMARKS	SIGN LEGEND FOR ALL POST LENGTHS AND INSTALLATION DATES SEE ORIGINAL RECORD PLANS	NEW SIGNS		EXISTING SIGNS				EXIST POST		NUMBER OF NEW POSTS	SQUARE STEEL (IN)			TUBULAR STEEL Ø (IN)				SIGN FRAME REQUIRED	REMARKS	SIGN DETAIL			
								"A"	"B"	RETAIN	SALVAGE FROM	SALVAGE TO	REMOVE	RETAIN	REMOVE		1.75	2.00	2.50	FOUNDATION	3.00	3.50	4.00			5.00	DETAIL IN SHS	DETAIL ON SHEET NUMBER	DETAIL ON STD SHEET NUMBER
																	(LB / FT)				(LB / FT)								
																	1.88	2.42	3.35		7.60	9.00	10.80			14.60			
WILLIAMSTOWN VT 14							FY-FLUORESCENT YELLOW FYG-FLUORESCENT YELLOW GREEN															"SHS"-STANDARD HIGHWAY SIGNS							
			M1-5	24	24		VERMONT 14			1																			
			M6-1 L	21	15		<---			1																			
			M3-3	24	12		SOUTH			1																			
			M1-5	24	24		VERMONT 14			1																			
			M6-1 R	21	15		--- >																						
NB	4.490	A	W11-2	30	30		PEDESTRIAN						1		X														
NB	4.515	A	D1-1	54	7.5		GRANITEVILLE4						1		X														
		A	D1-1A	72	12			6.00								2		X								6			
NB	4.540	C	VR-017	24	30		LEGAL LOAD LIMIT 24000 LBS			1				X										TH-1, MEADOW ST					
NB	4.550	C	R4-7	24	30		 						1		X														
		C	OM1-1	18	18																								
		C	R4-7	24	30			5.00									1		X						ISLAND ON MEADOW ST, PARALLEL TO VT 14	X			
		C	OM1-1	18	18			2. 25 2.25						1											PAINTBALL DAMAGE REDO	X			
NB	4.560	D	R1-1	30	30		STOP			1				X										TH-1, MEADOW ST					
NB	4.565	A	M3-1	24	12								1		X														
SIGN SUMMARY SHEET							SHEET TOTALS	15.50 13.25	0.00	6	0	0	5	0	0	3	45							PROJECT NAME: Hartford-East Montpelier VT14					
								SF	SF	EA	EA	EA	EA	EA	EA	EA		FT						PROJECT NUMBER: SIGN STPG(21)					
																								FILE NAME: Williamstown.xls					
VERMONT AGENCY OF TRANSPORTATION																						PROJECT MANAGER: N. Avery			PLOT DATE: 6/18/2009				
							TOWN TOTALS	501.1	0.0	67.0	0.0	0.0	94	0.0	0.0	109	1635.0							DESIGNED BY: A. Gamble			DRAWN BY: T. Guazzoni		
																						WILLIAMSTOWN SHEET 6			CHECKED BY: S. Menard				
																						SHEET 102 OF 162							